

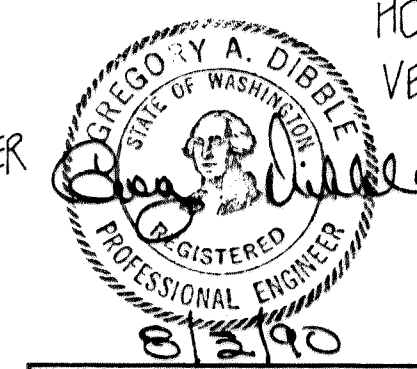
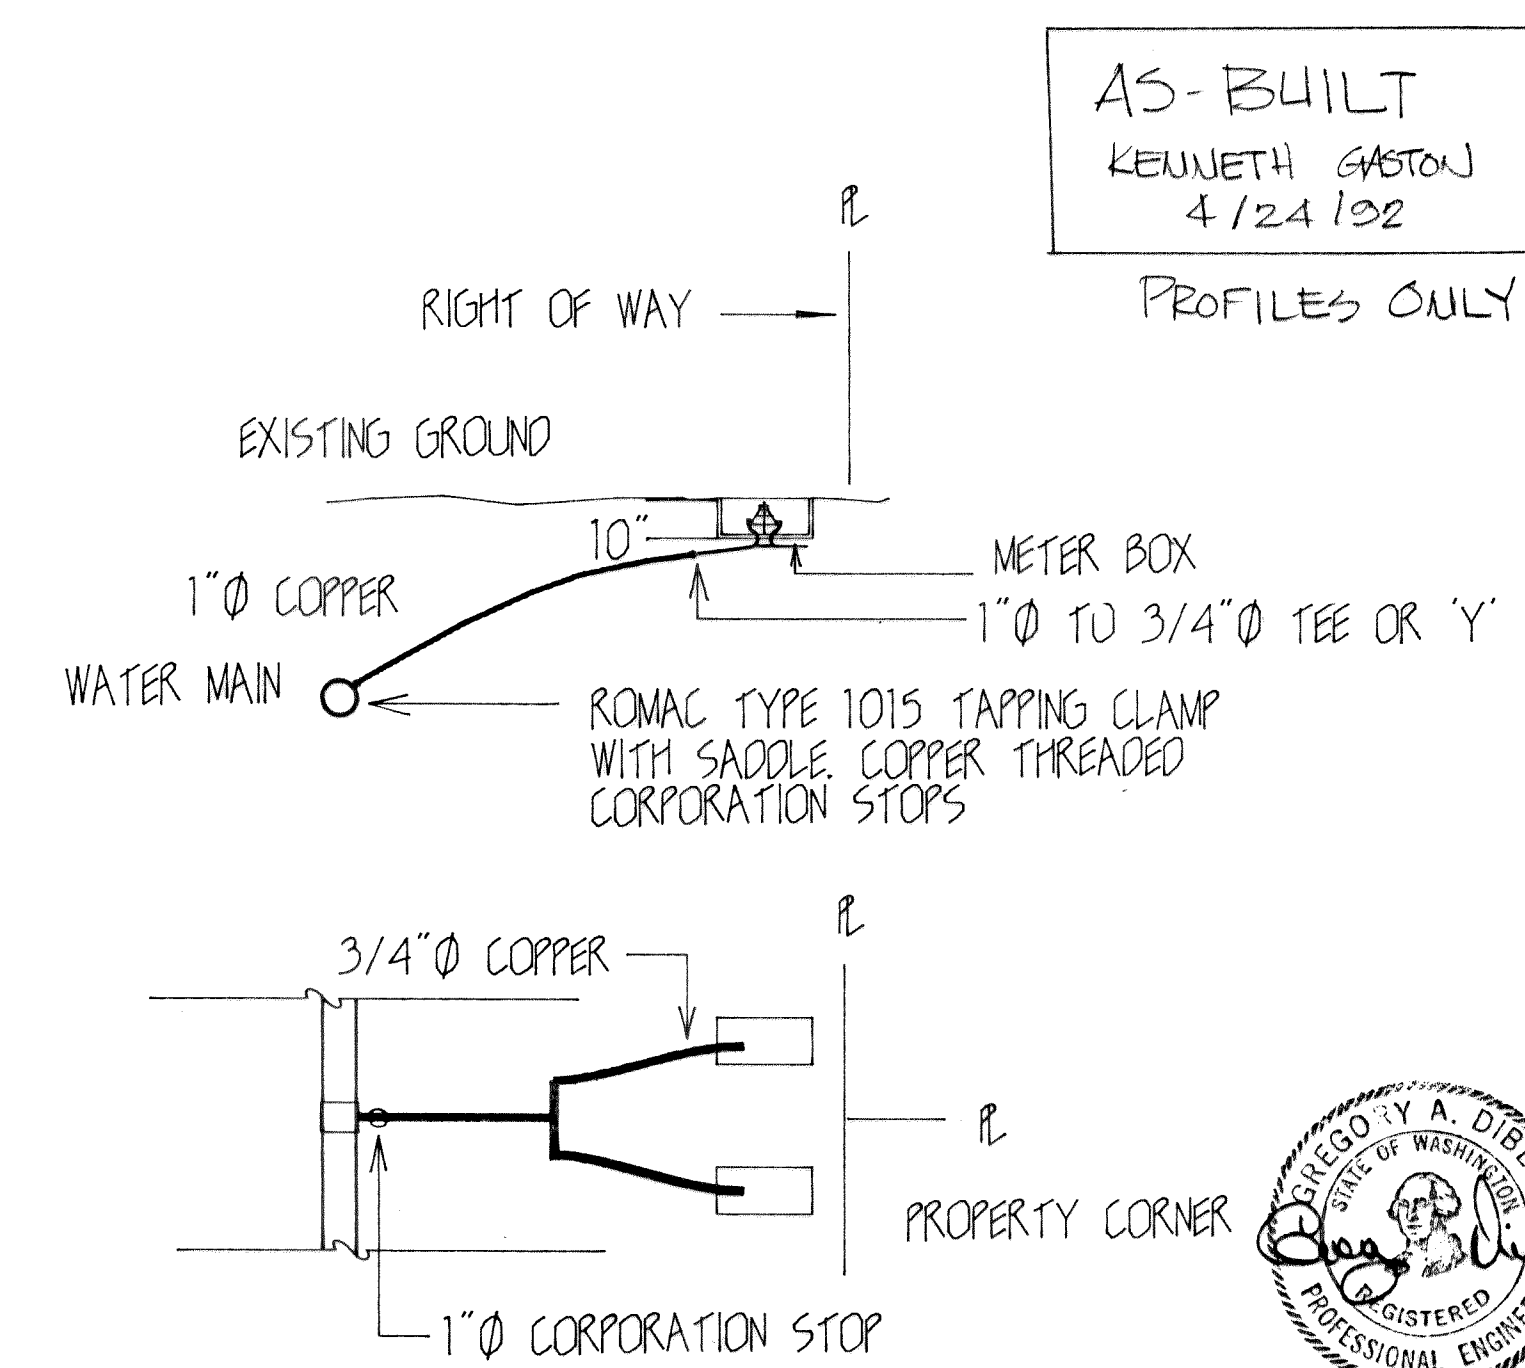
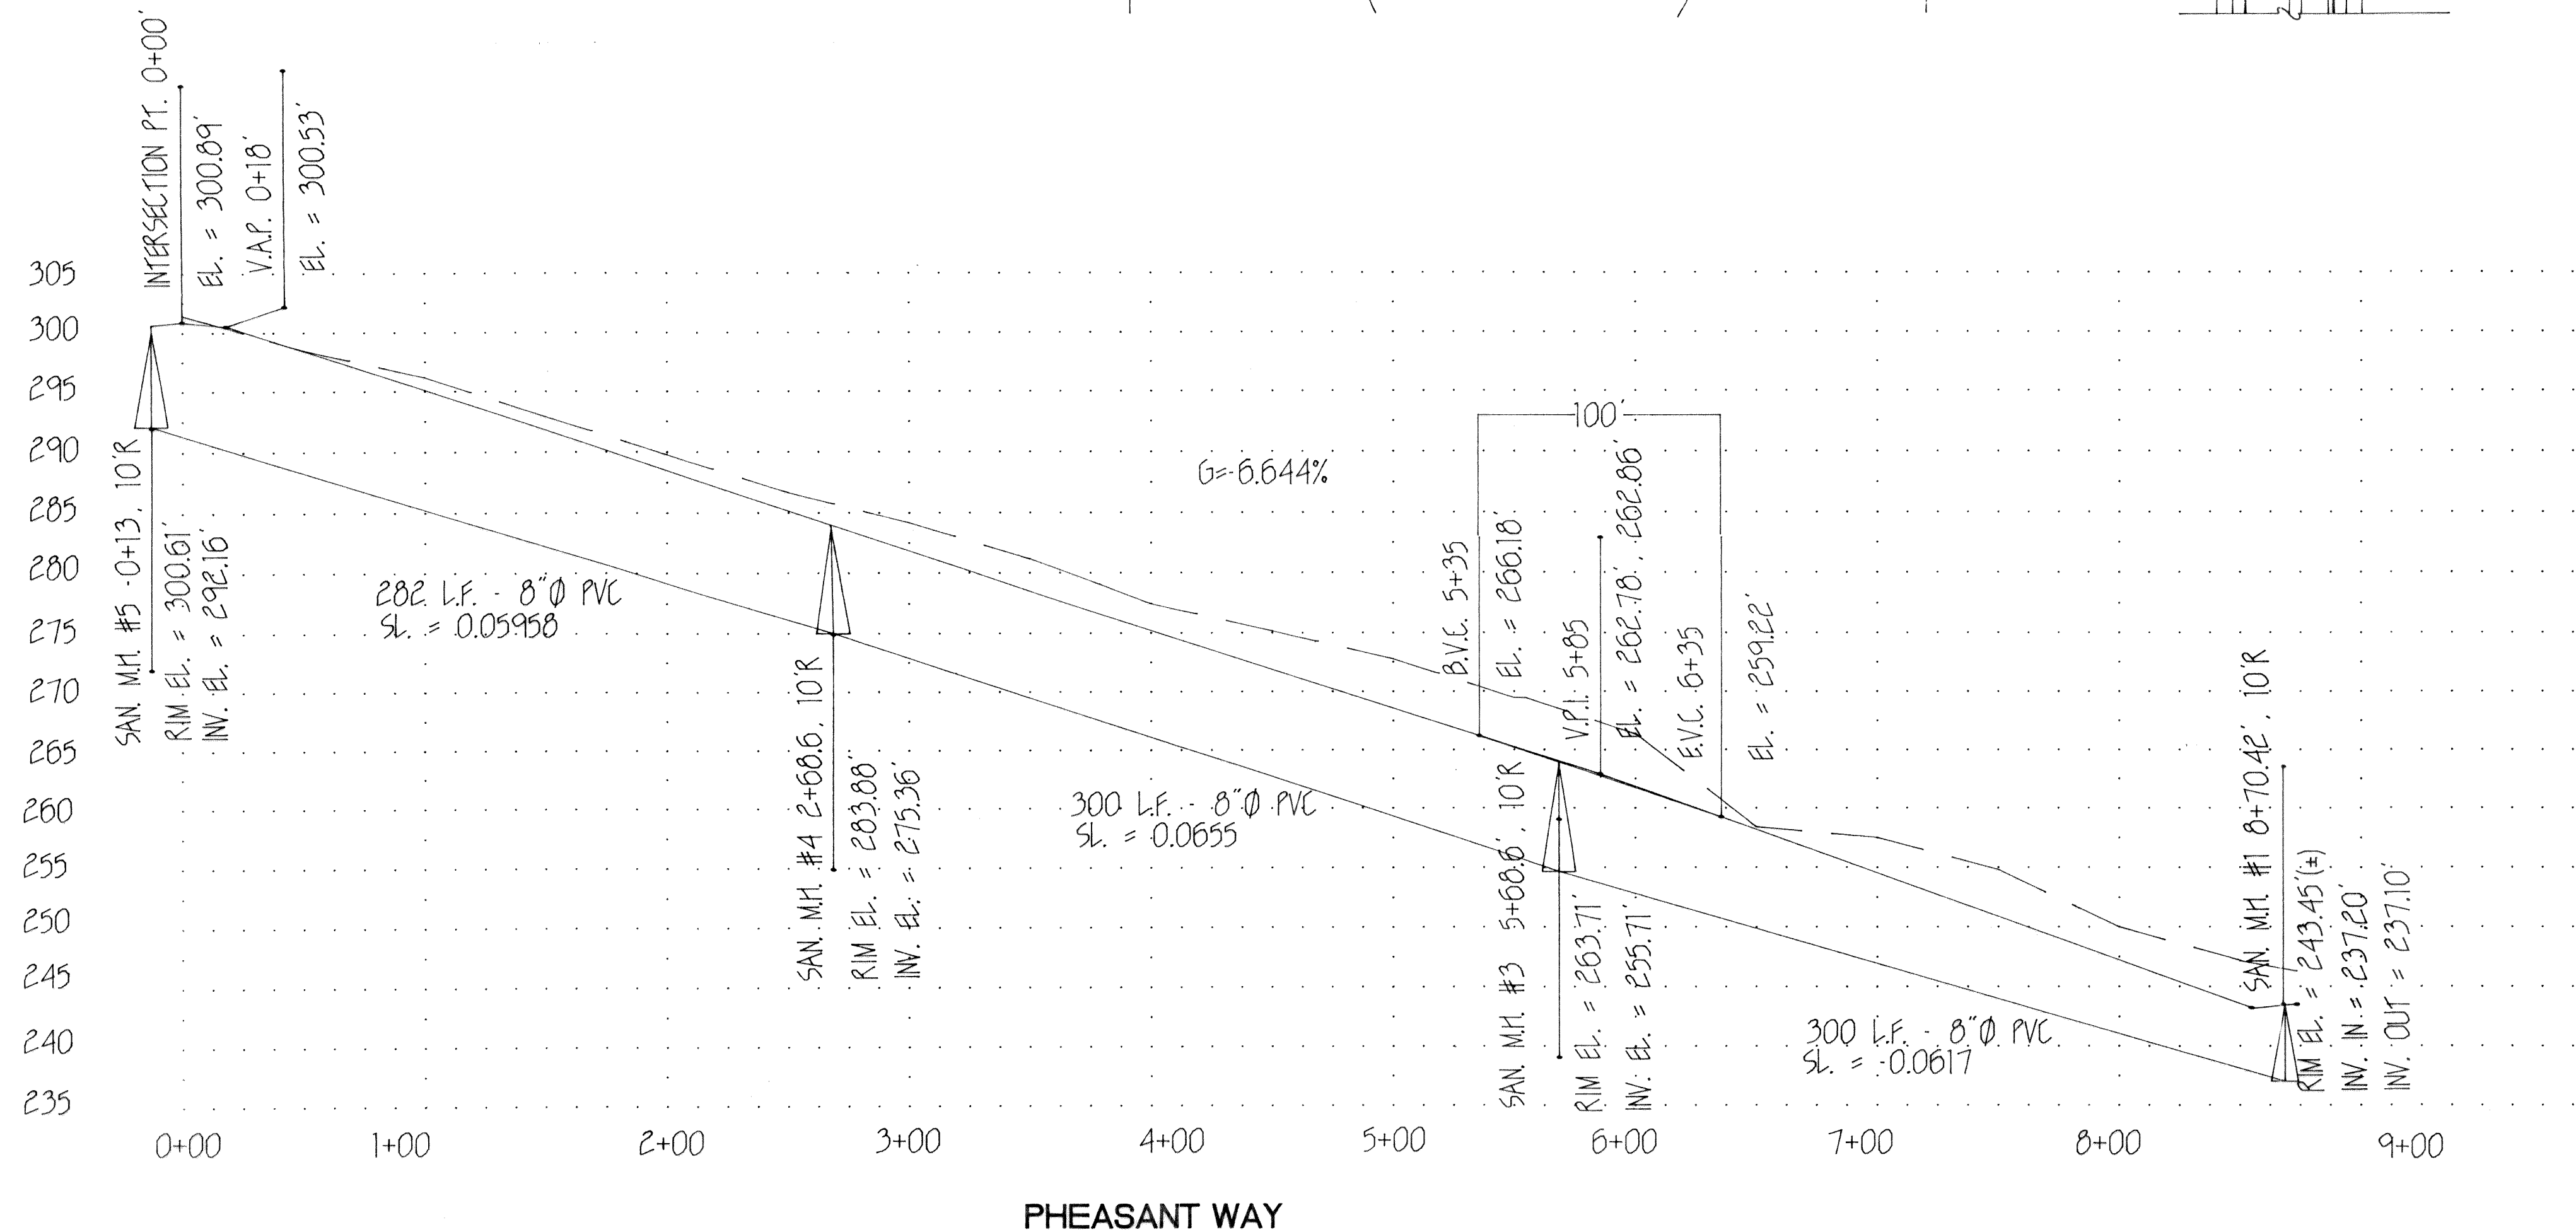
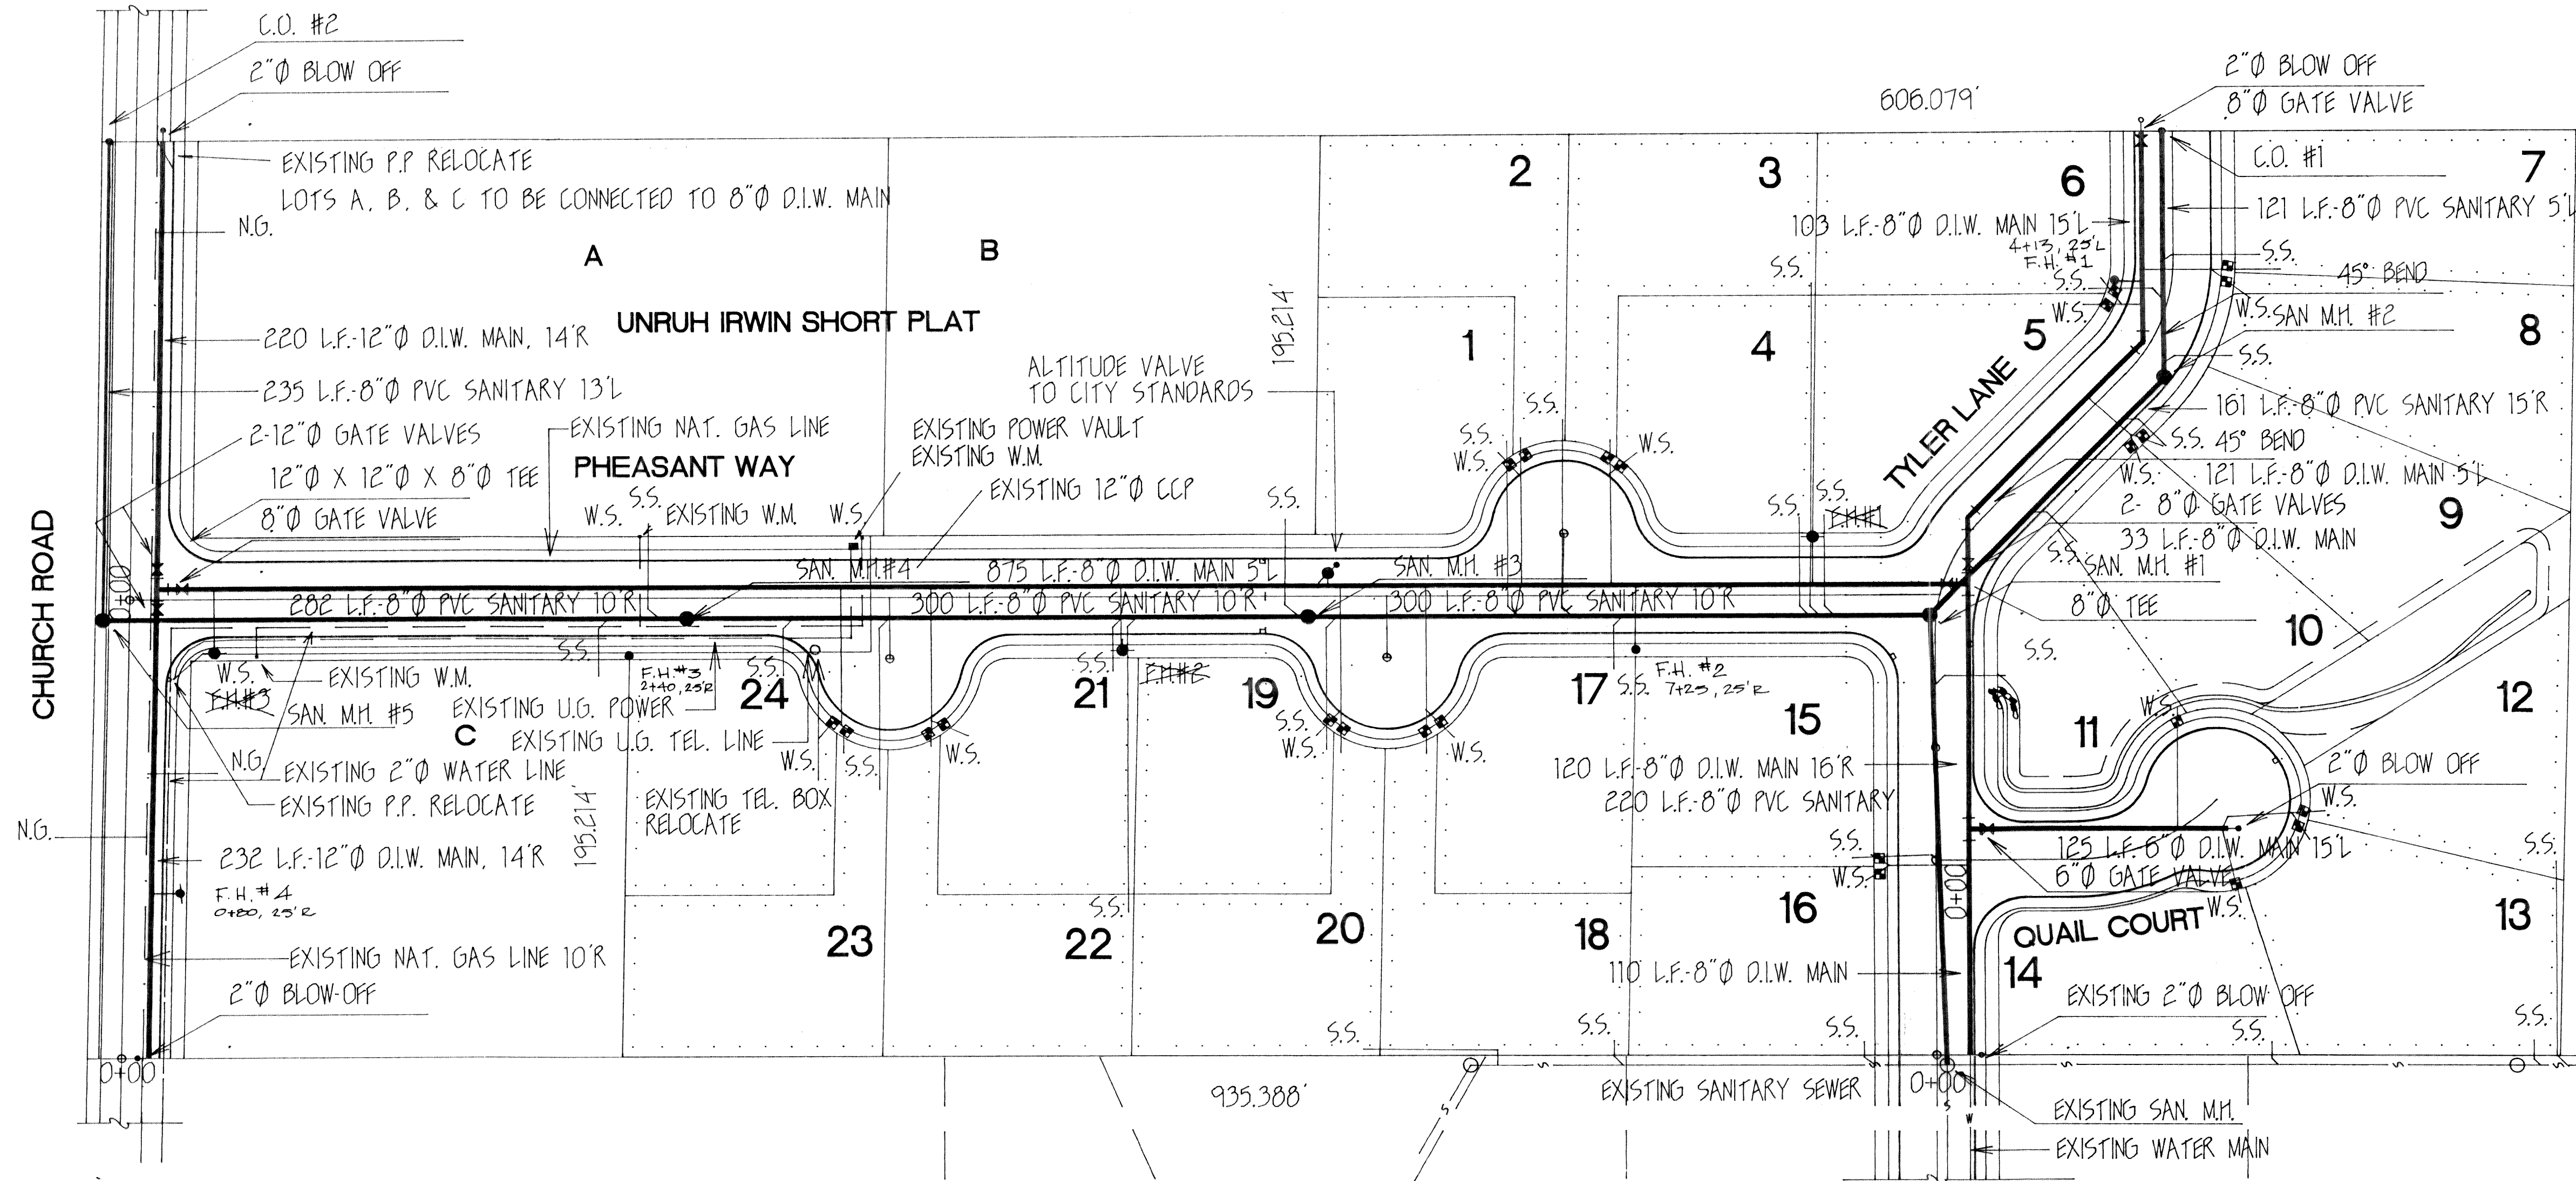
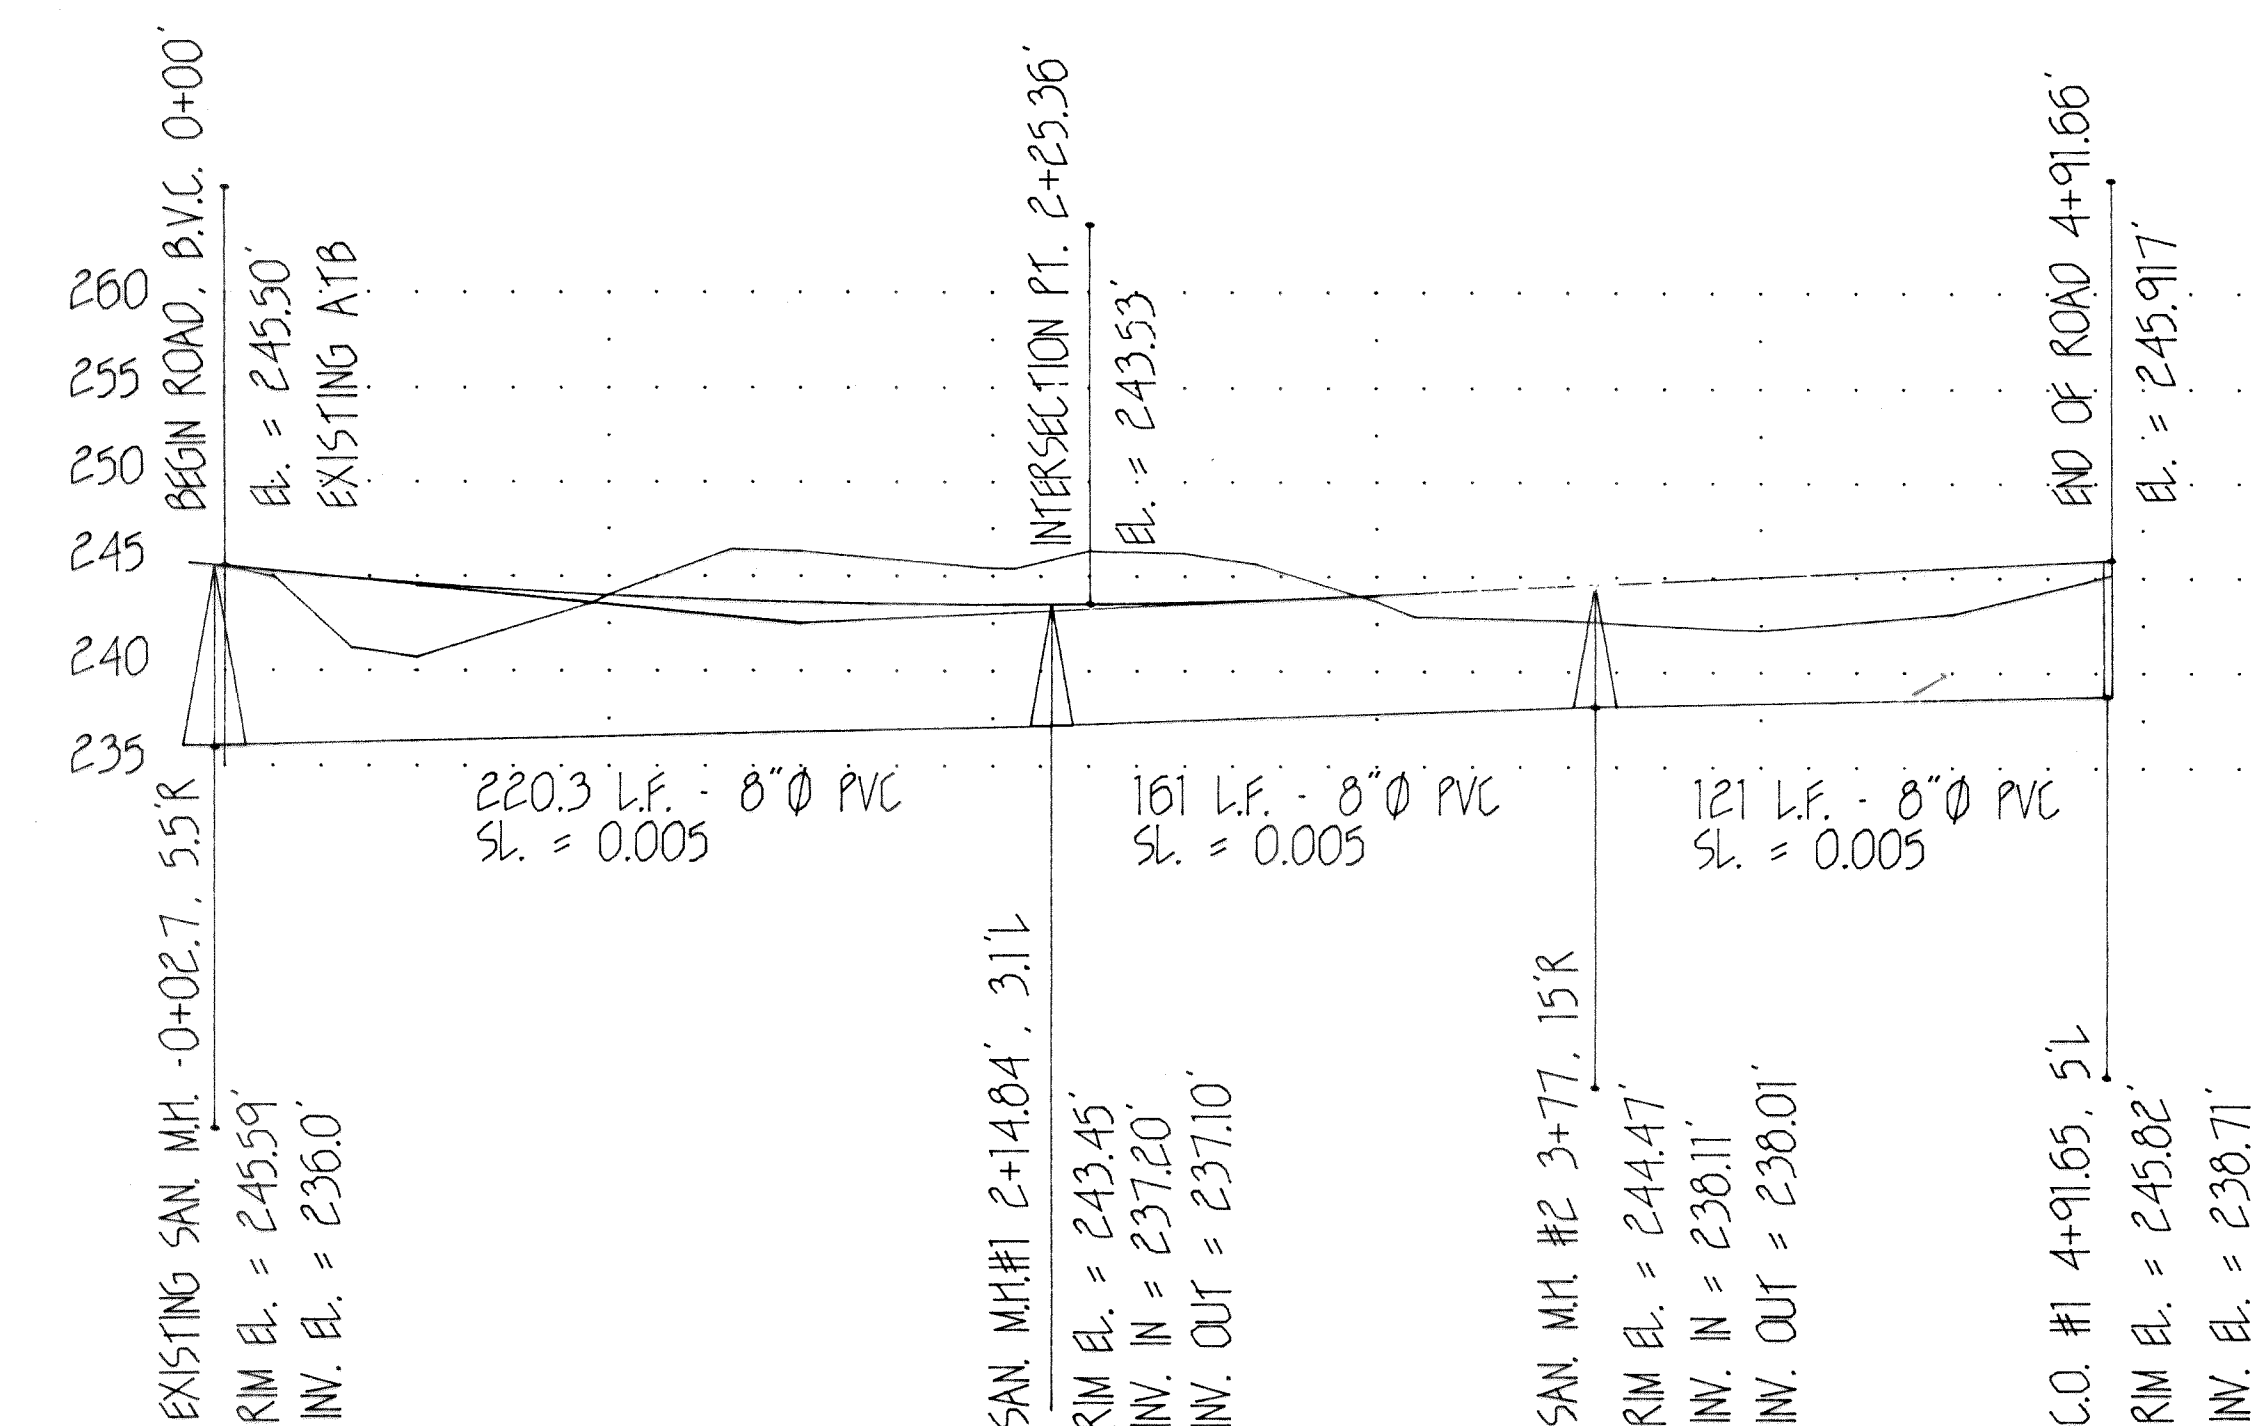


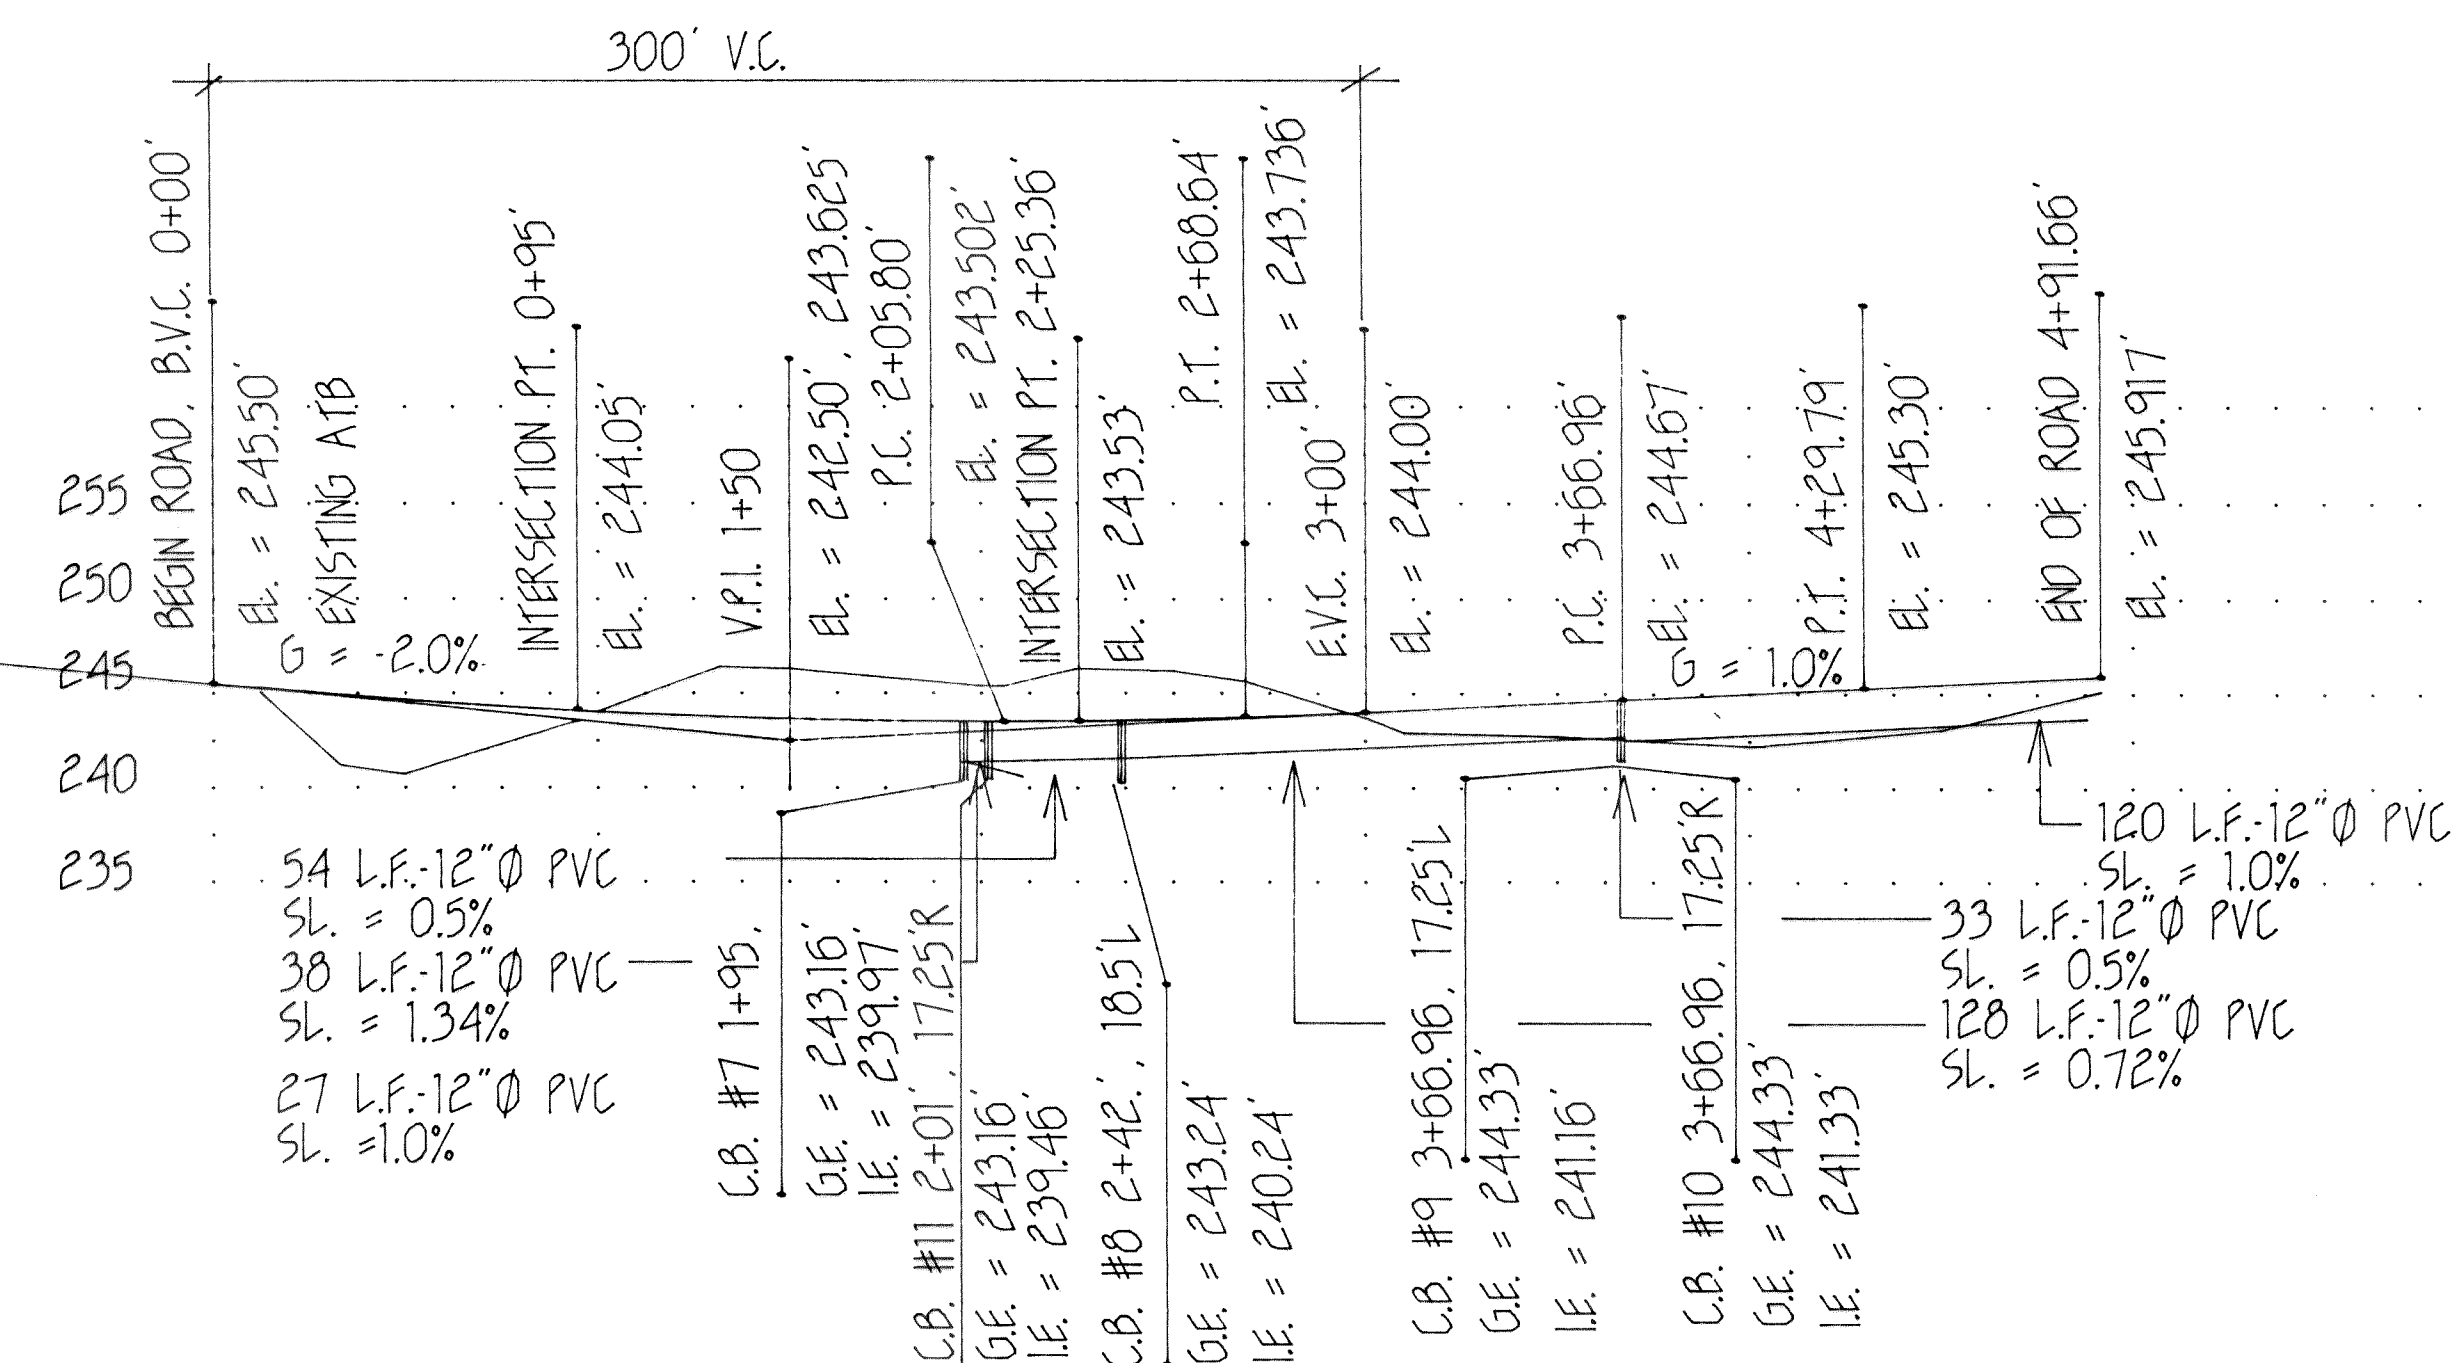


MARVEL CONST.			
SCALE: 1" = 50'	APPROVED BY:		DRAWN BY: KG
DATE: 7/8/90			REVISED: 8/2/90
PHEASANT RIDGE PLAT			
WATER + SEWER			DRAWING NUMBER 42289 2/45

00155.002 2-14-66 KJR


TYLER LANE

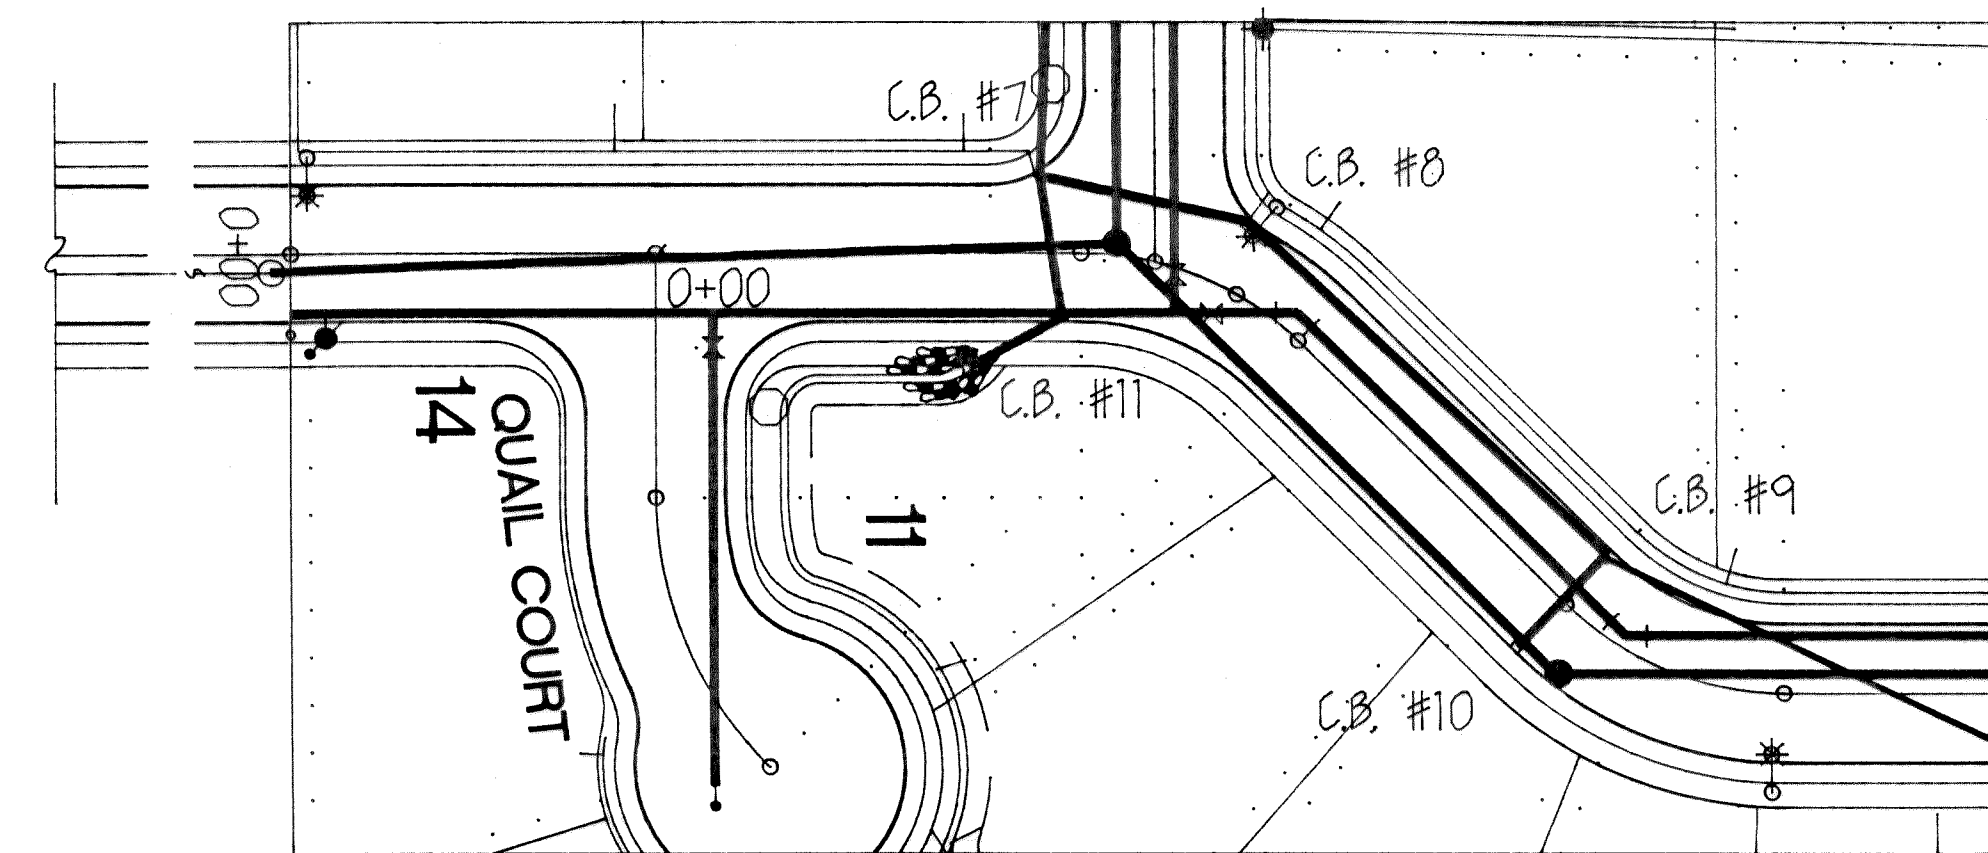

As-Built
Greg Dibble
10/2/91

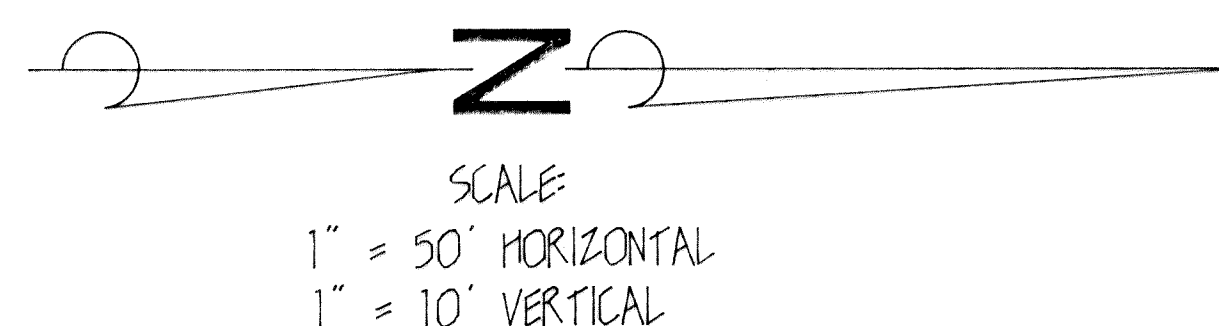

3/4 STREET SECTION (CHURCH ROAD)

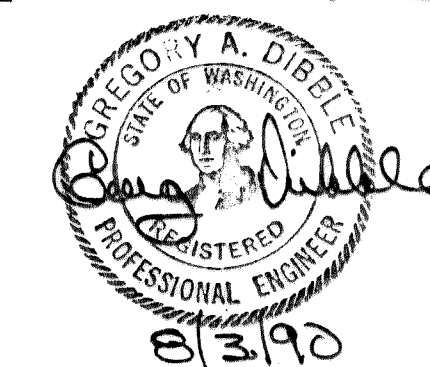

MARVEL CONSTRUCTION		
SCALE: <u>NOTED</u>	APPROVED BY:	DRAWN BY: <u>K.G.</u>
DATE: <u>7/8/90</u>		REVISED: <u>8/2/90</u>
PHEASANT RIDGE PLAT		
ROAD PROFILES		DRAWING NUMBER <u>42289 3/45</u>