
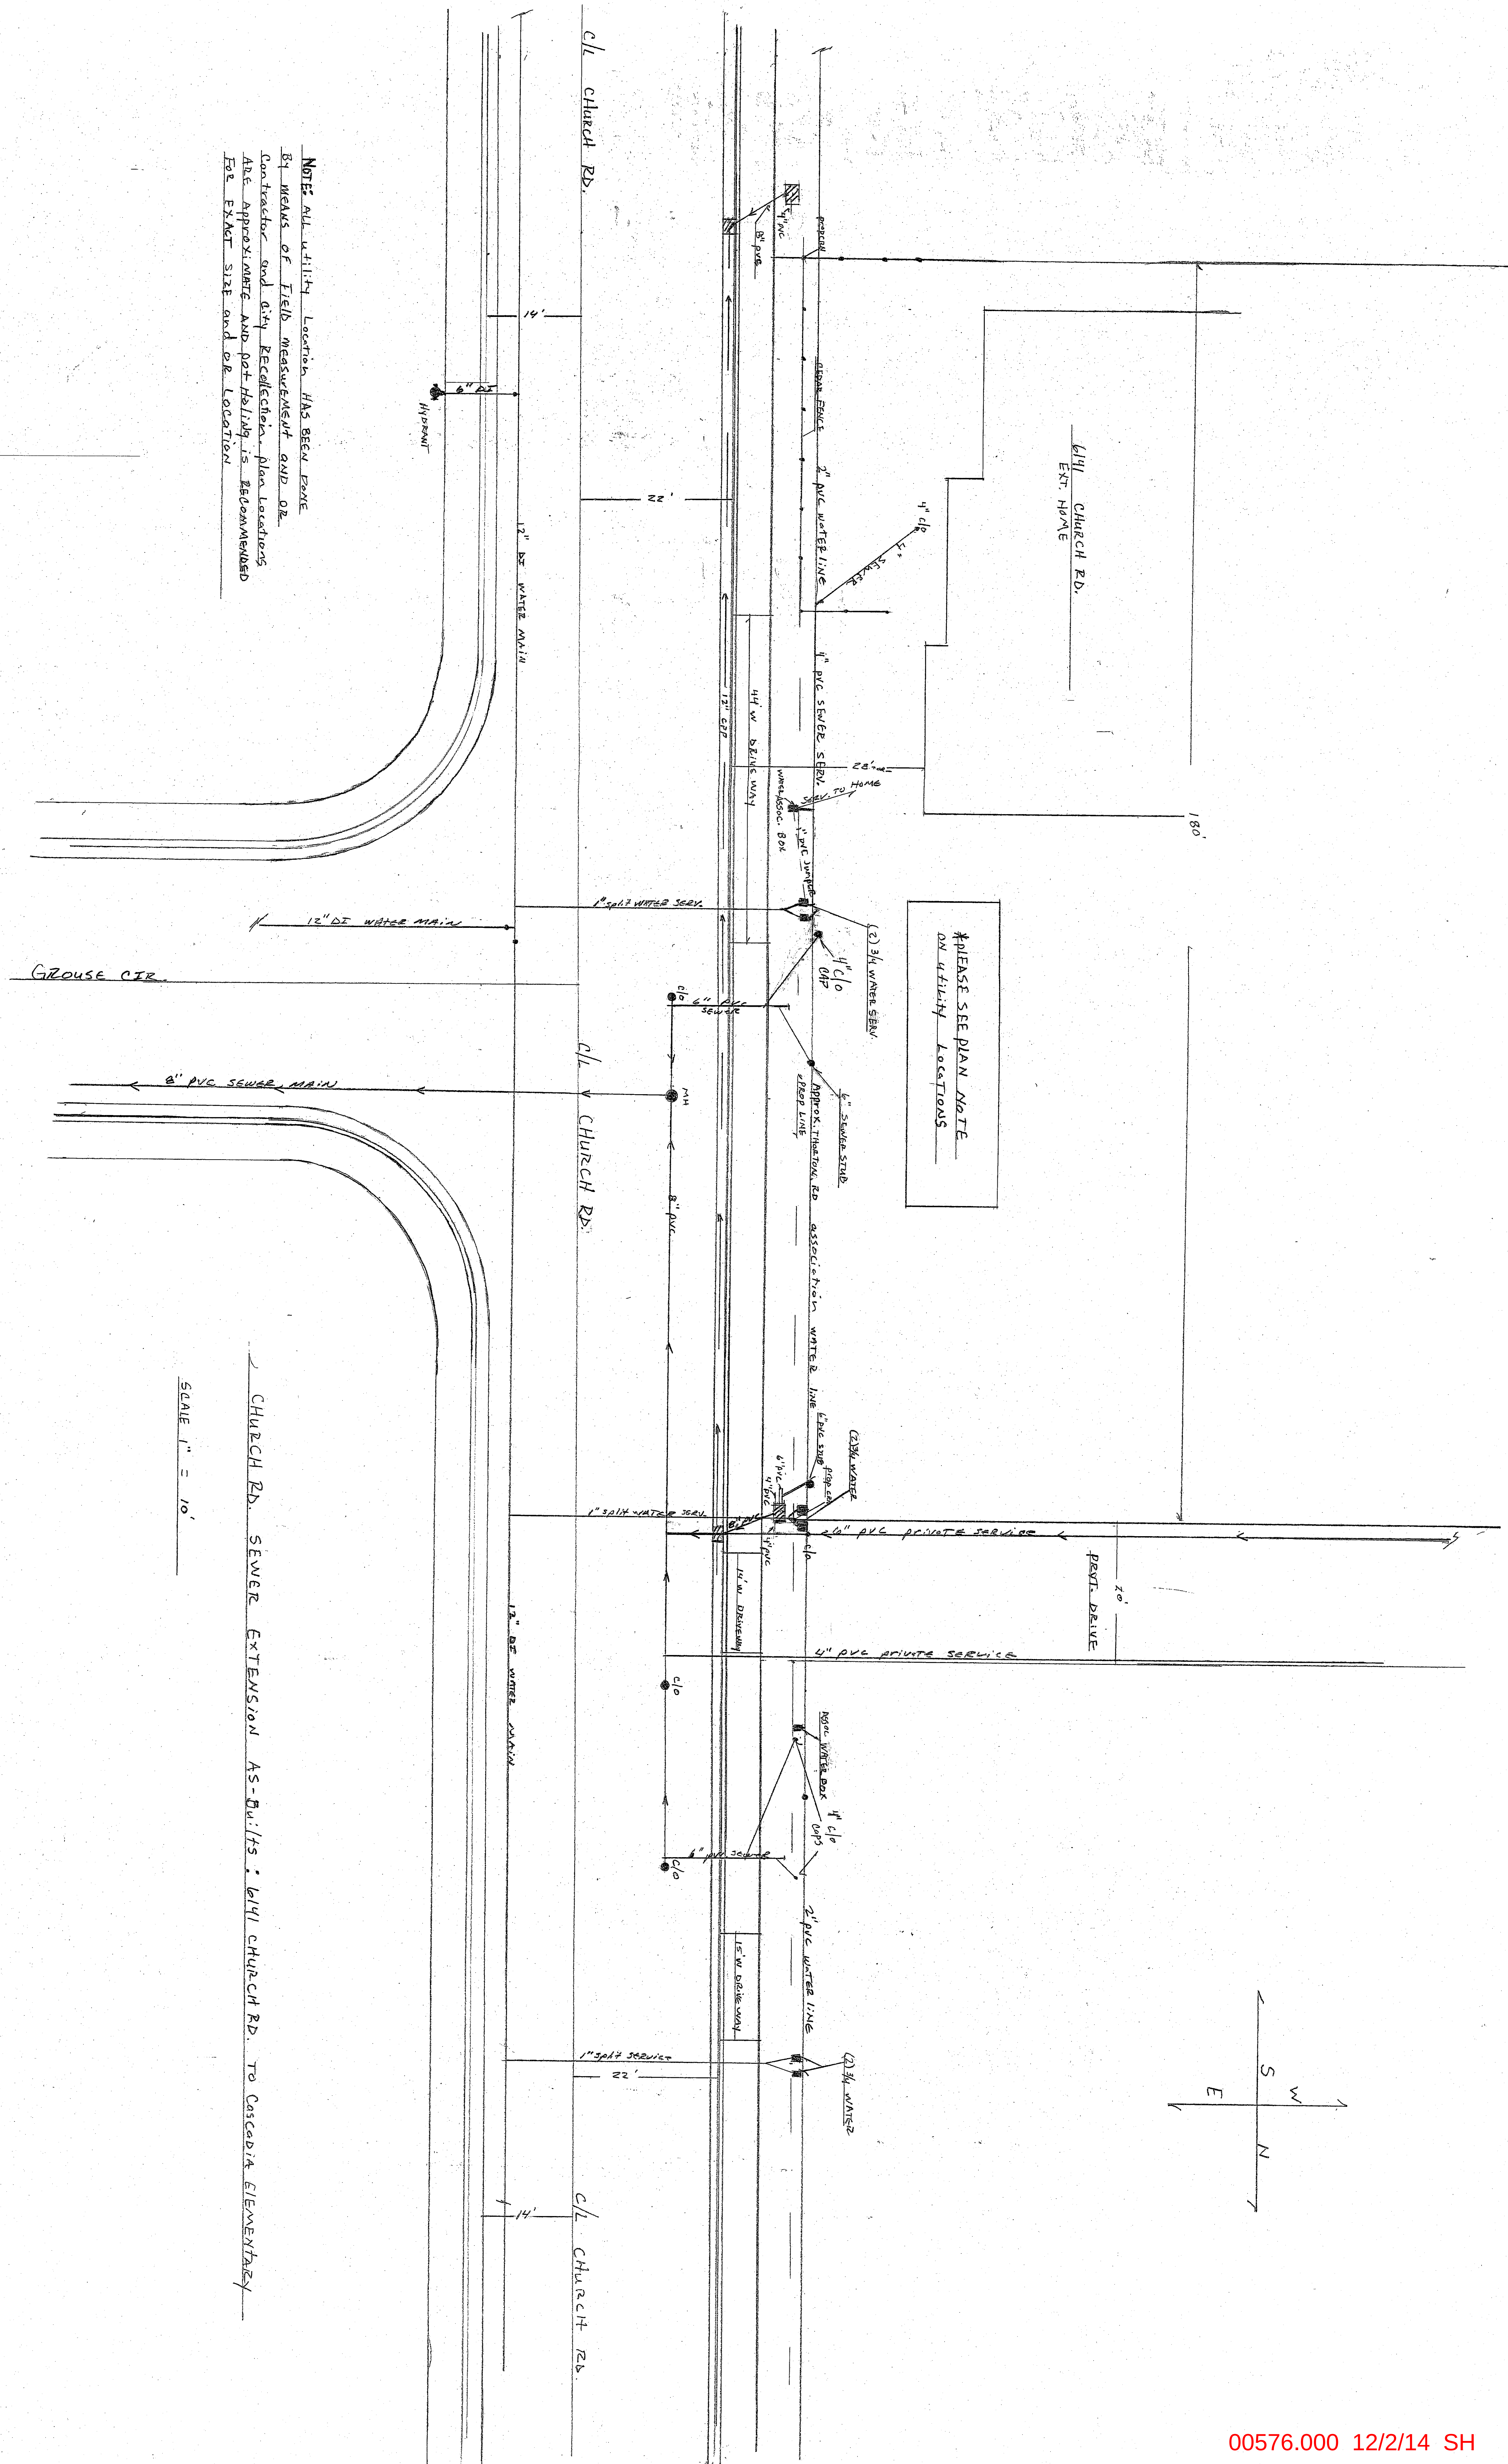


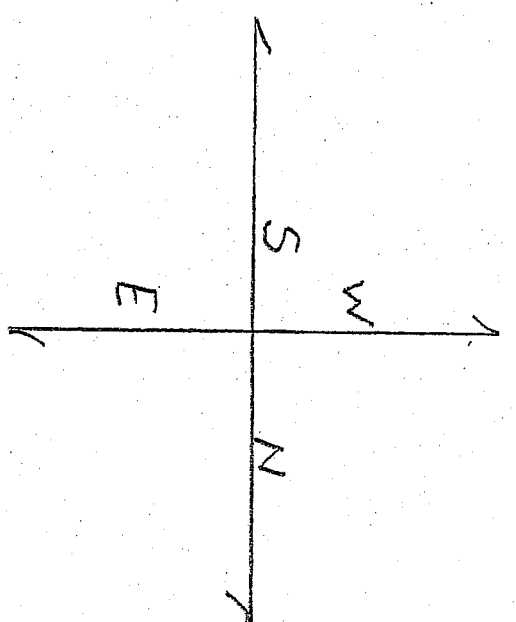

NOTE: ALL UTILITY LOCATION HAS BEEN DONE BY MEANS OF FIELD MEASUREMENT AND OR CONTRACTOR AND CITY RECOLLECTION. PLAN LOCATIONS ARE APPROXIMATE AND NOT HOLY. IS RECOMMENDED FOR EXACT SIZE AND OR LOCATION

CHURCH RD. SEWER EXTENSION AS-BUILTS: 1614 CHURCH RD. TO CASCADE ELEMENTARY

SCALE 1" = 10'

DRAWN BY L.H. 12/1/14