


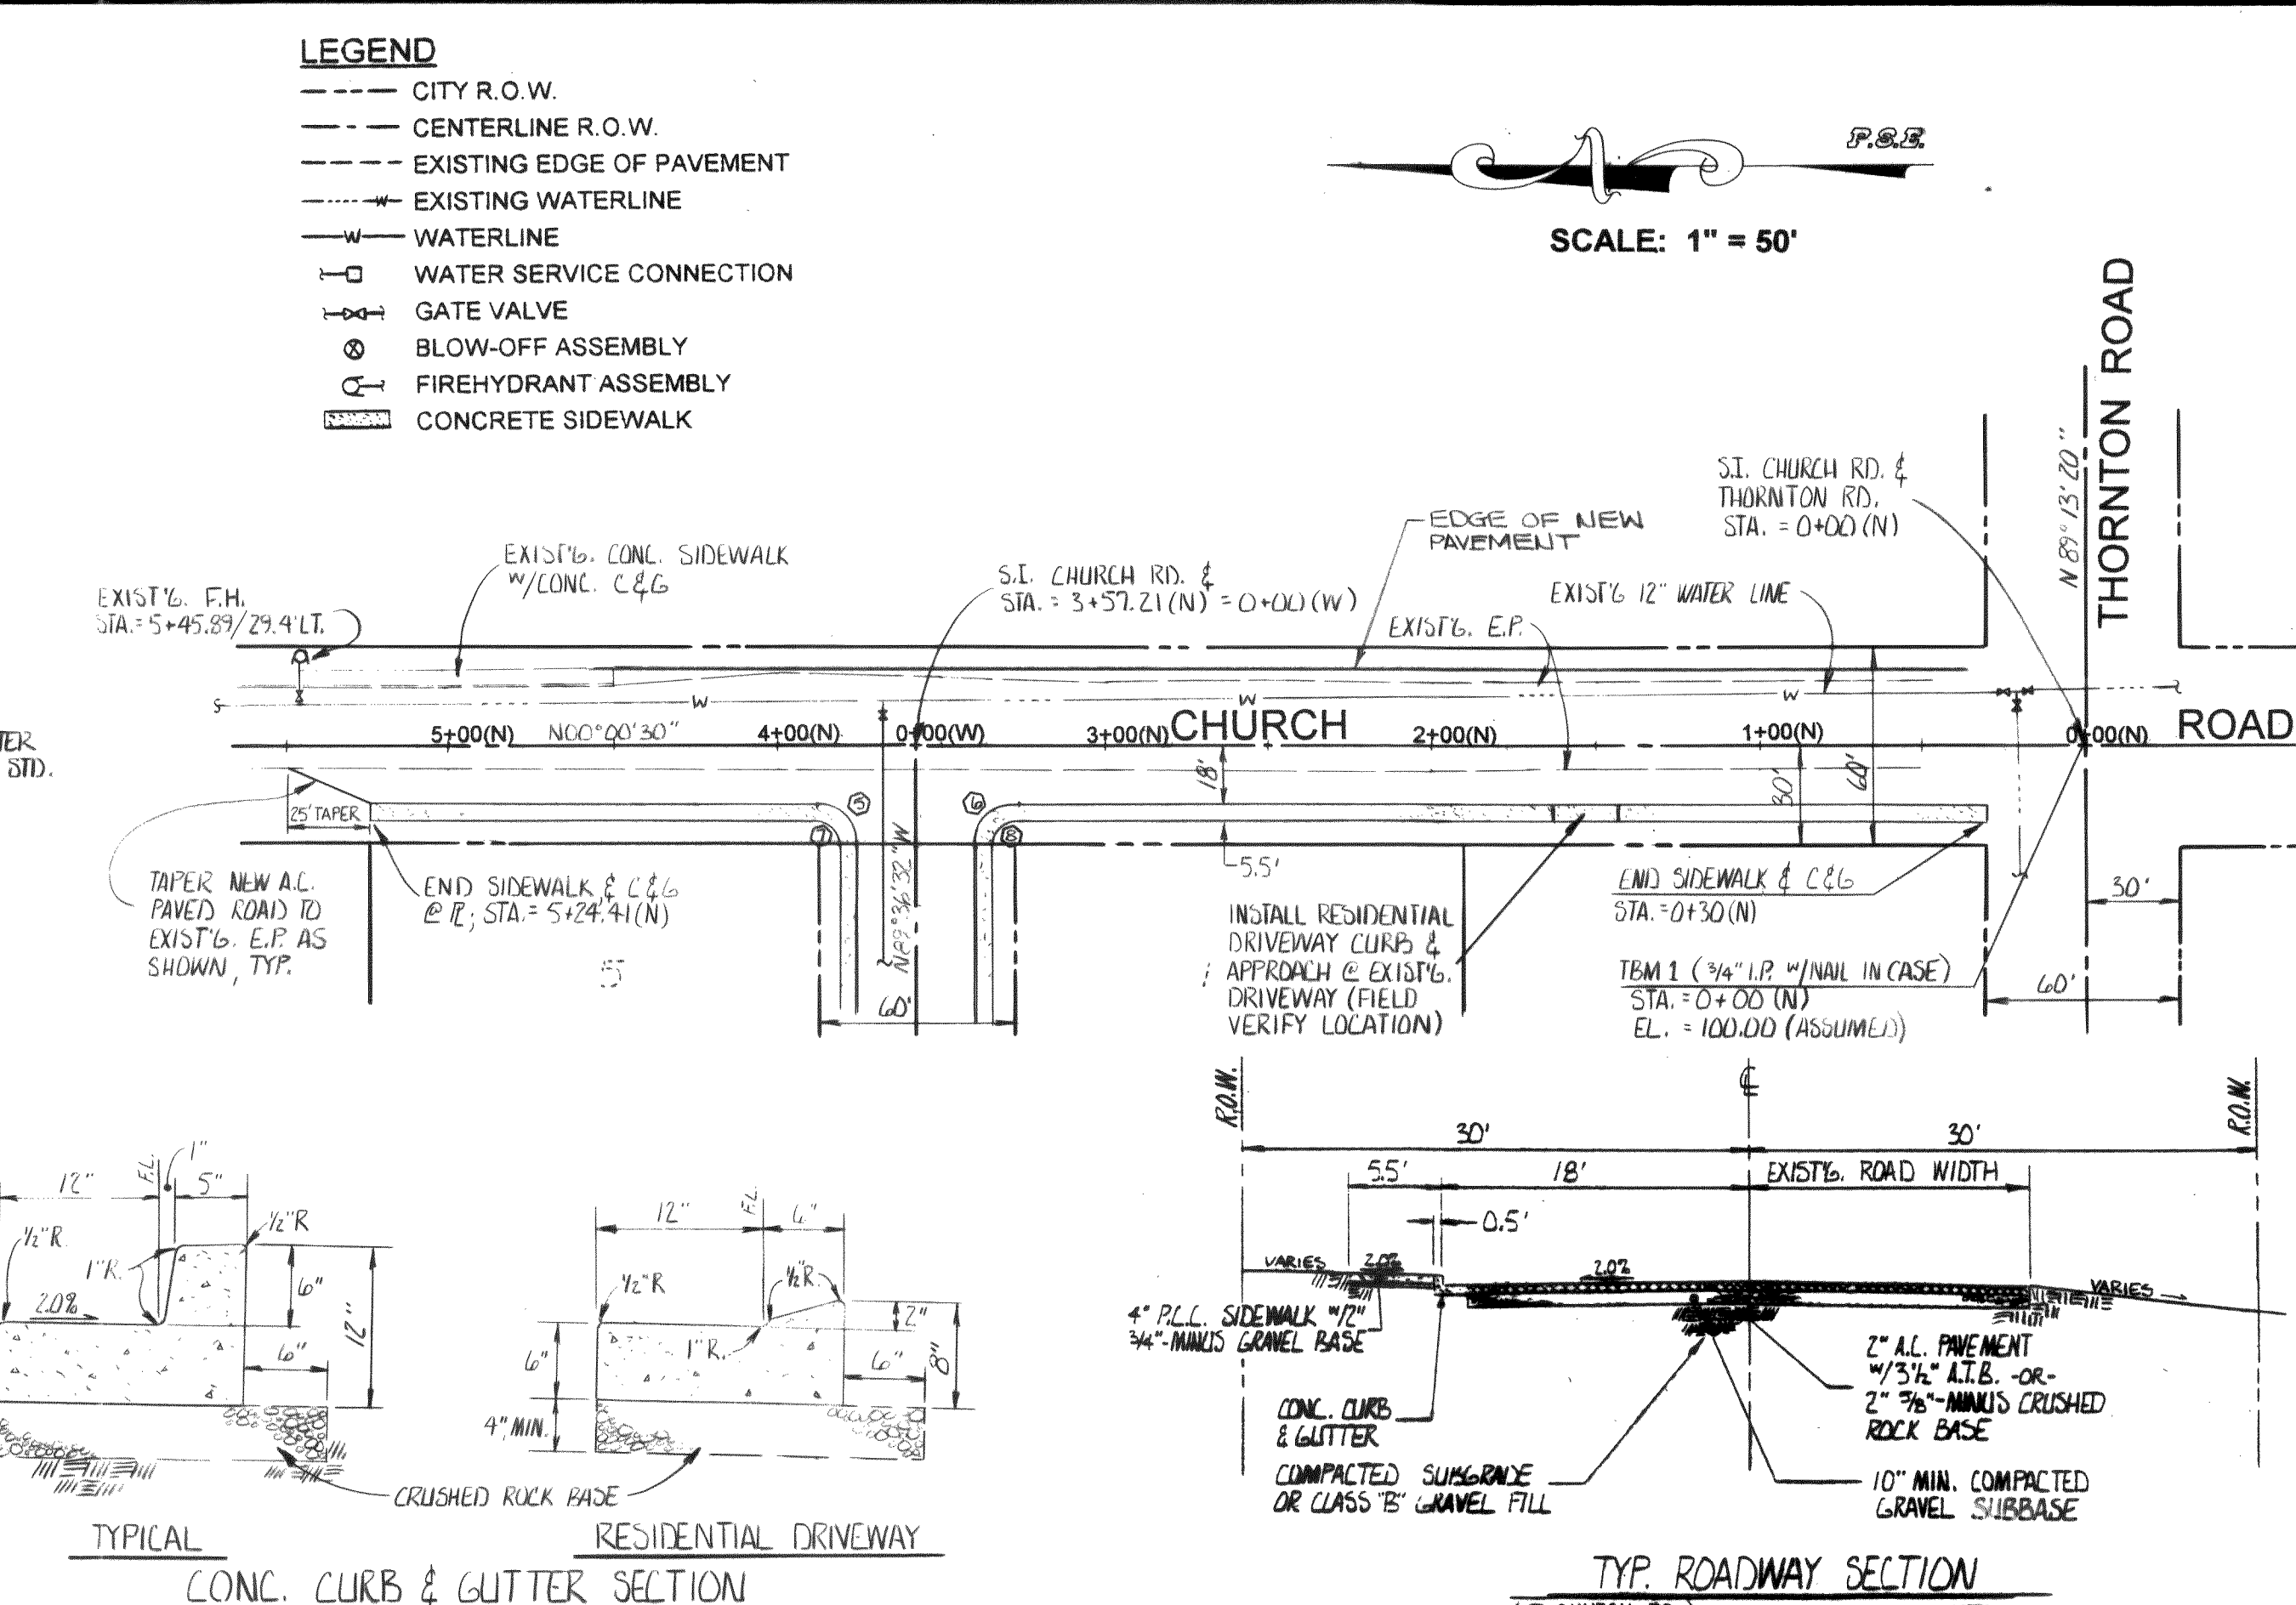
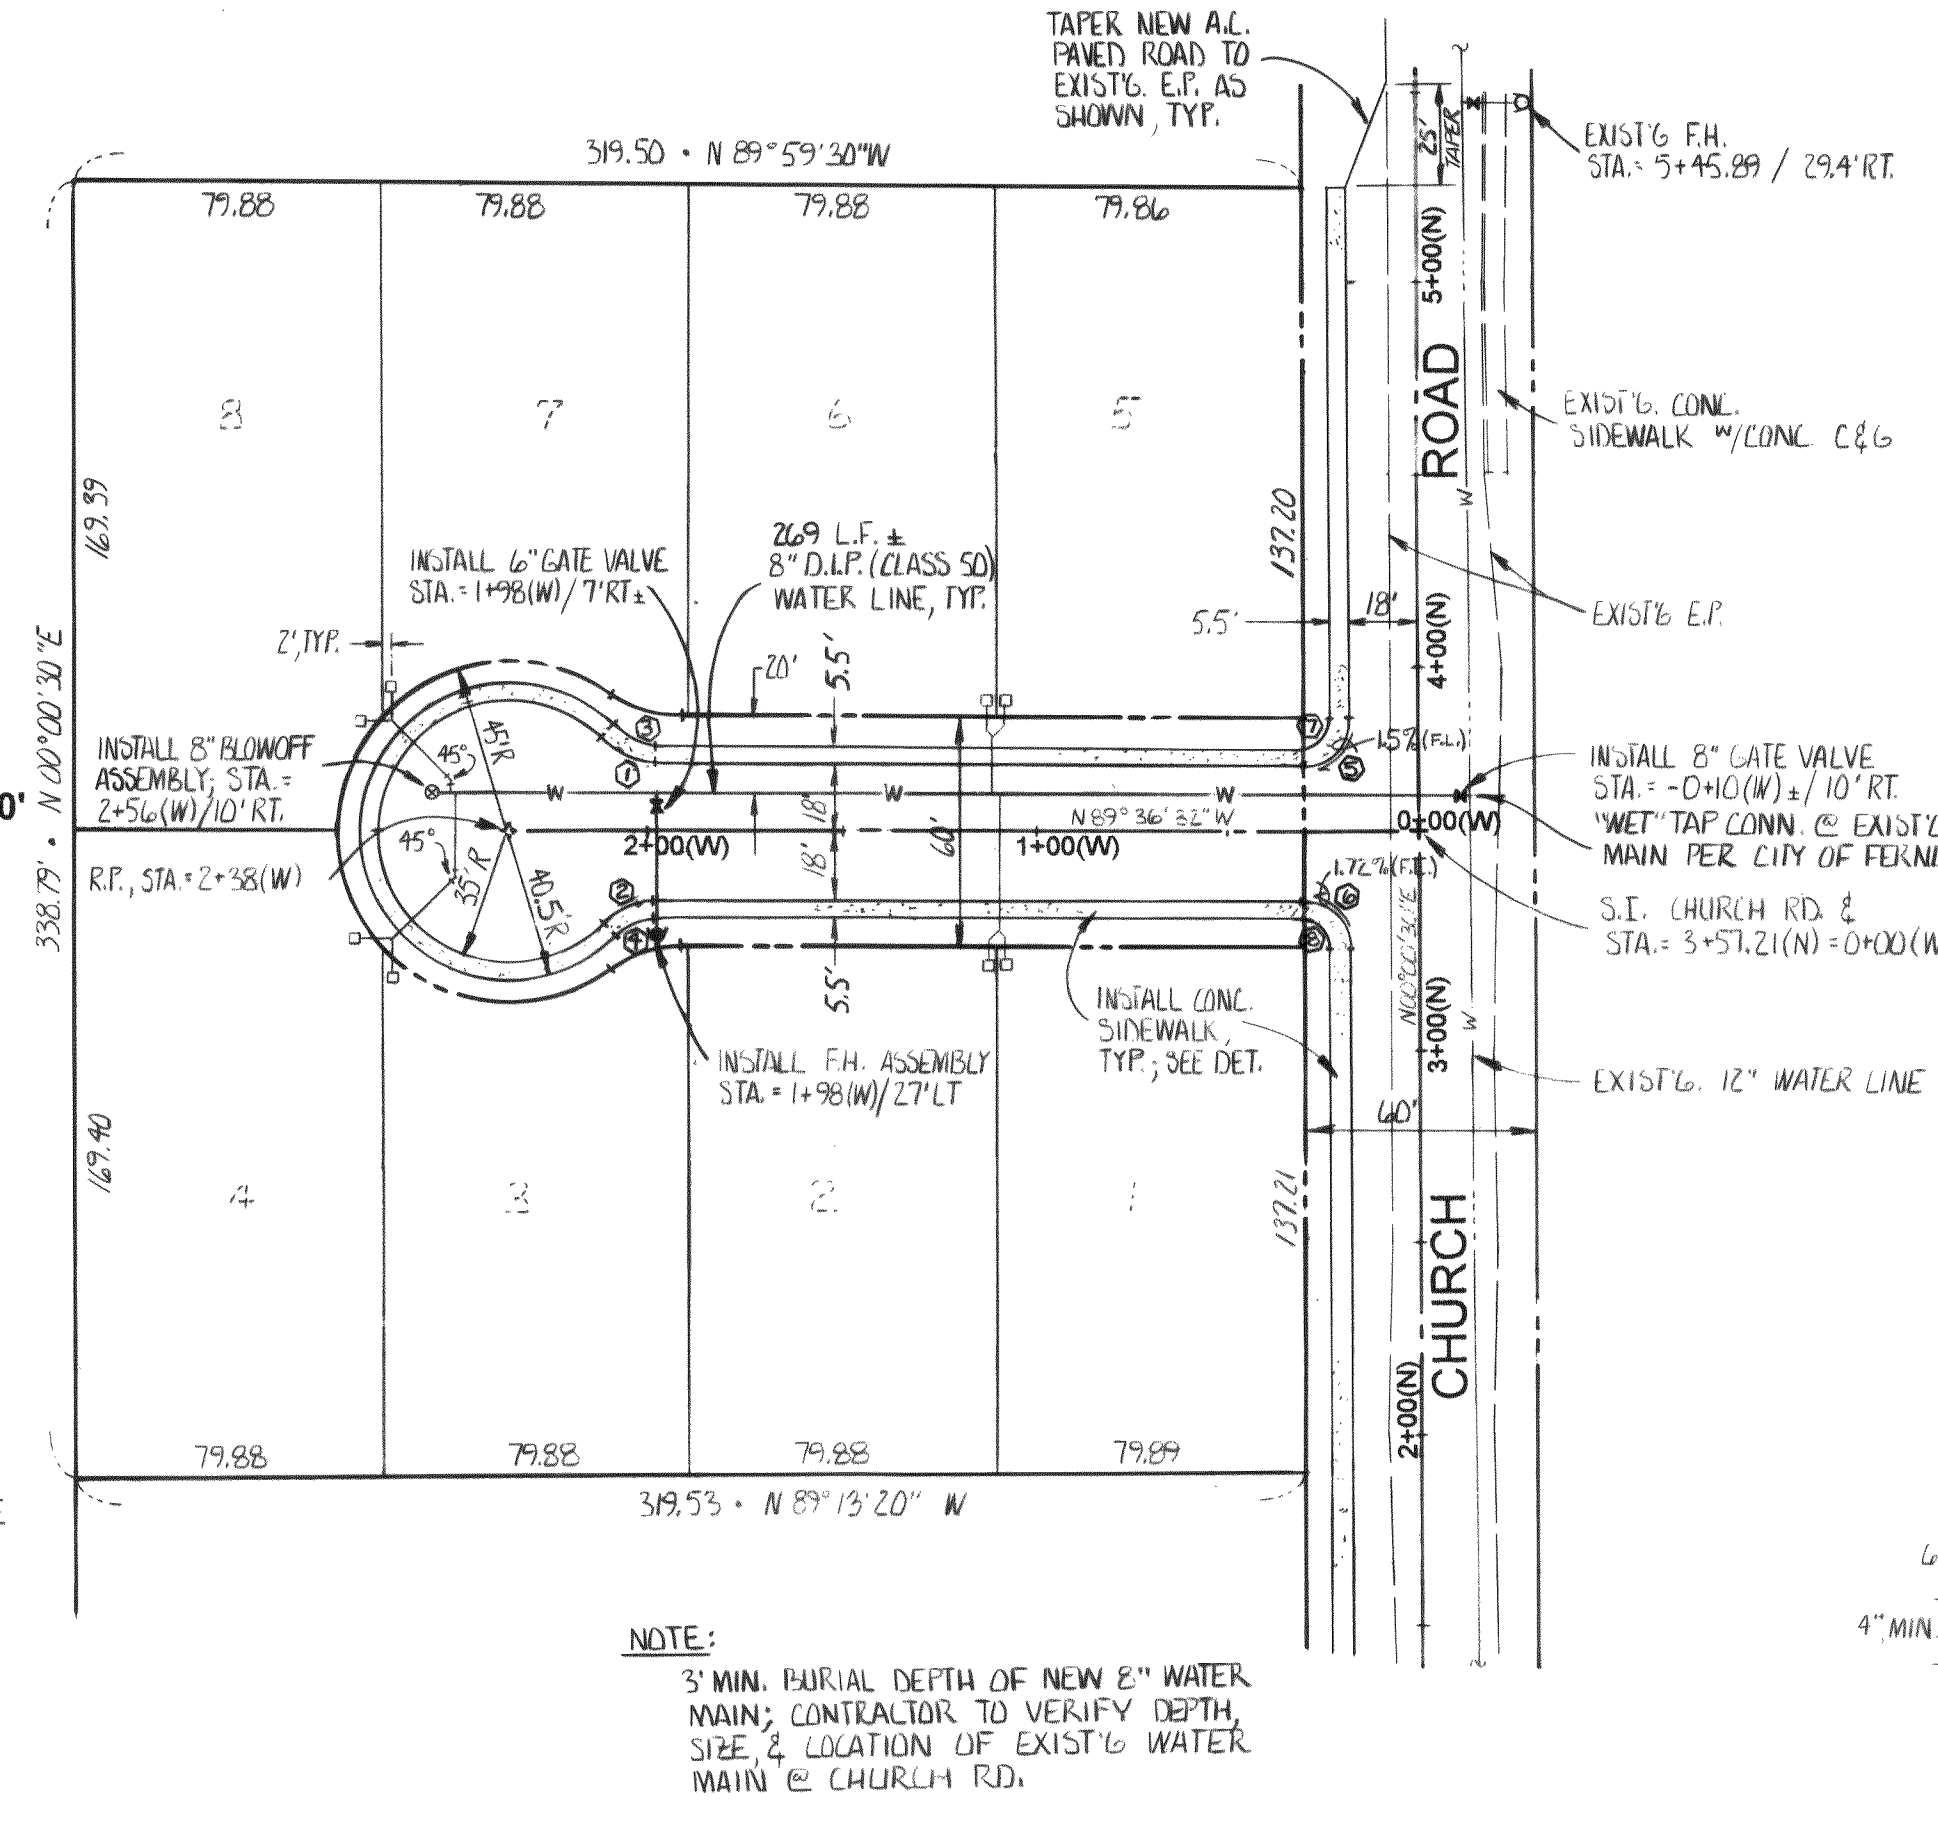
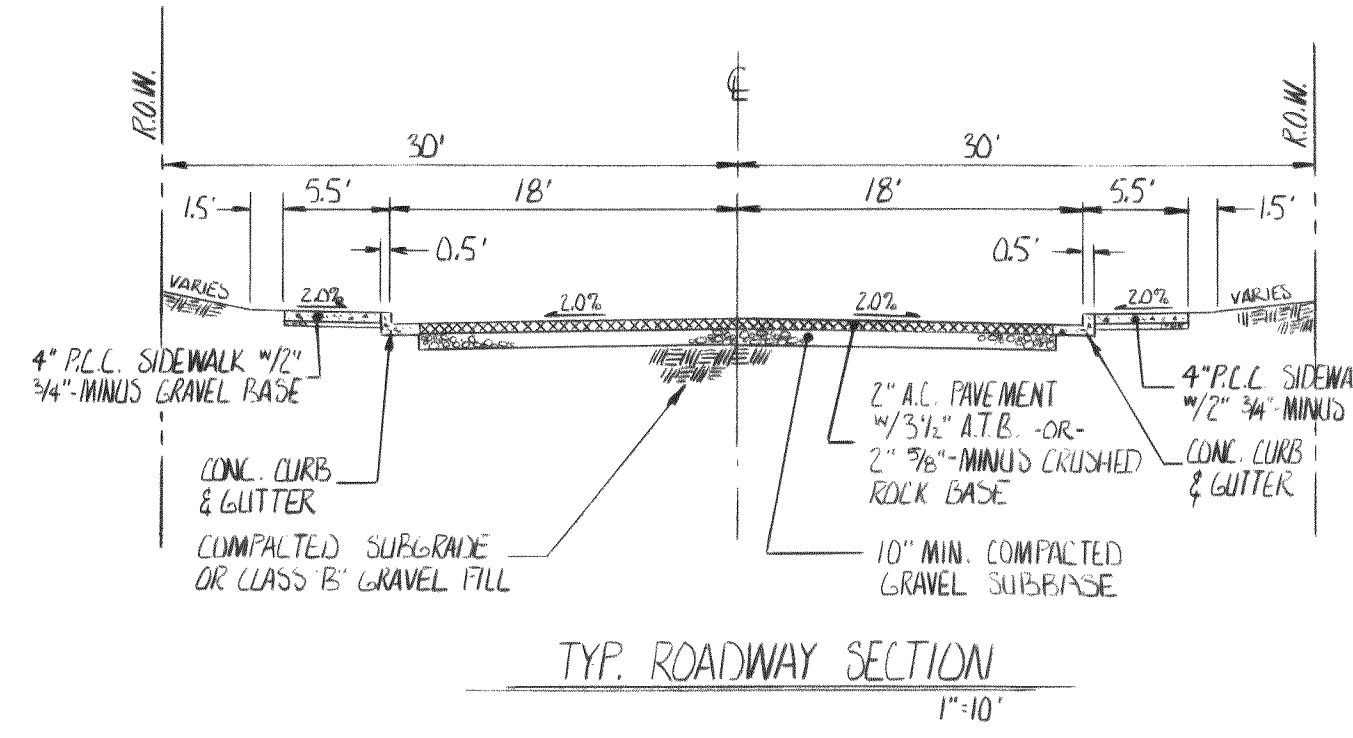


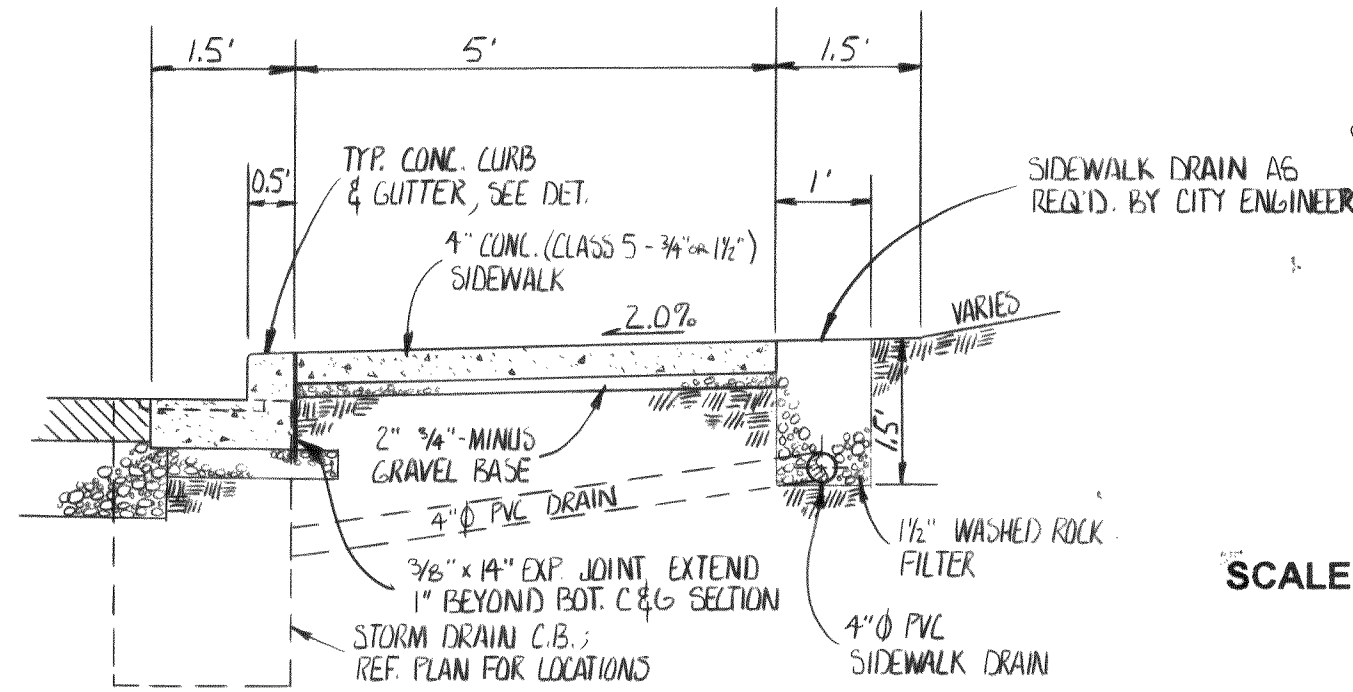

HORIZONTAL CURVE DATA					
CURVE NO.	ANGLE, Δ	RADIUS, R (ft.)	LENGTH, L (ft.)	DESCRIPTION	STATION (W) / OFFSET
1	48° 17' 52"	19.5	15.76	TOP BACK OF CURB (TBC)	2+12.34 / 24.53' RT. (PC)
2	48° 17' 52"	19.5	15.76	TOP BACK OF CURB (TBC)	1+98.24 / 18.5' RT. (PT)
3	48° 17' 52"	14.5	11.72	BACK OF WALK	2+08.72 / 27.98' RT. (PC)
4	48° 17' 52"	14.5	11.72	BACK OF WALK	1+98.24 / 23.5' LT. (PT)
5	90° 00' 00"	11.5	18.06	TOP BACK OF CURB (TBC)	0+30 / 18.5' RT. (PC)
6	90° 00' 00"	11.5	18.06	TOP BACK OF CURB (TBC)	0+18.5 / 30' RT. (PT)
7	90° 00' 00"	6.5	10.21	BACK OF WALK	0+30 / 23.5' RT. (PC)
8	90° 00' 00"	6.5	10.21	BACK OF WALK	0+23.5 / 30' LT. (PT)

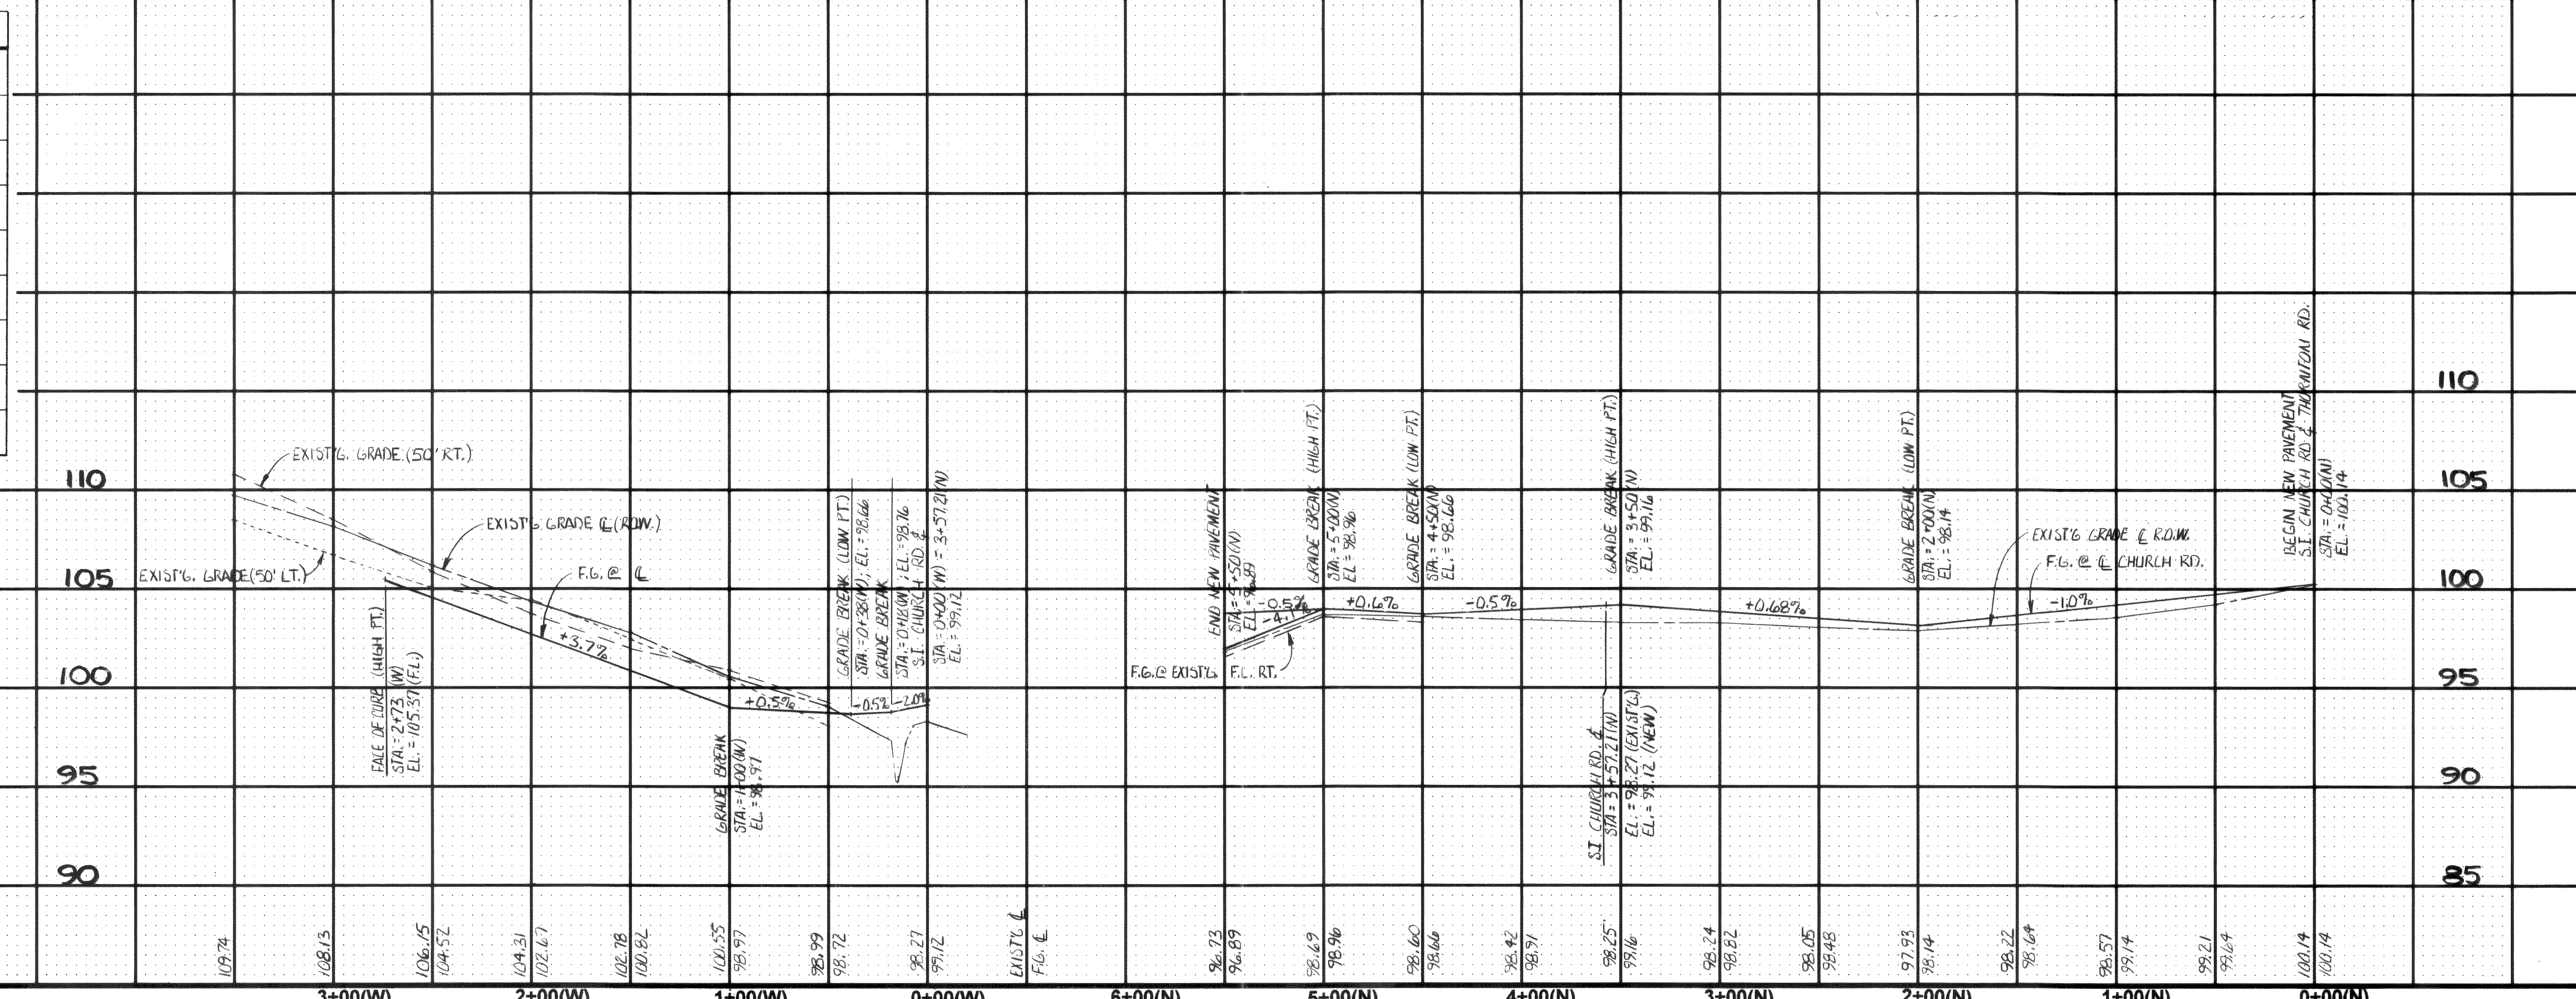

FIELD BOOKS		TBM NO.	LOCATION	ELEV.	DATA	DATE	DESCRIPTION	BY
DESIGN		1	ST. CHURCH & THORNTON 0+00(N)	100.00 (ASSUMED)	BASE	9/28/93	ASBUILT	
STAKING					TOPOGRAPHY			
ASBUILT					PROFILE			
CONTRACTOR					SANITARY SEWER			
INSPECTOR					STORM SEWER			
CONSTRUCTION RECORD					WATER			
					GAS			

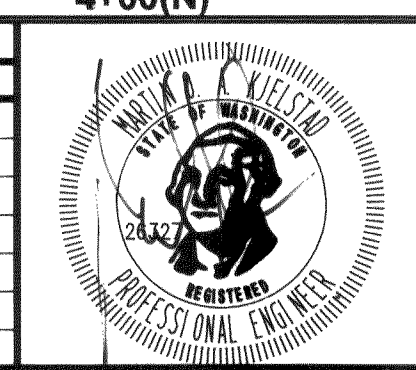

PACIFIC
SURVEYING/ENGINEERING
SERVICES, INC.
215 WEST HOLLY, SUITE B-25 (BAY ST.)
BELLINGHAM, WASHINGTON 98225
PHONE 671-7387
FAX LINE 671-4685

MOUNTAIN RANGE VIEW SHORT PLAT
FERDALE, WASHINGTON
STREET & WATER IMPROVEMENTS

