


WHATCOM COUNTY FIRE DISTRICT NO. 7

THORNTON AND CHURCH FRONTAGE IMPROVEMENTS

RECORD DRAWINGS

002866.dwg 2-10-06 KK

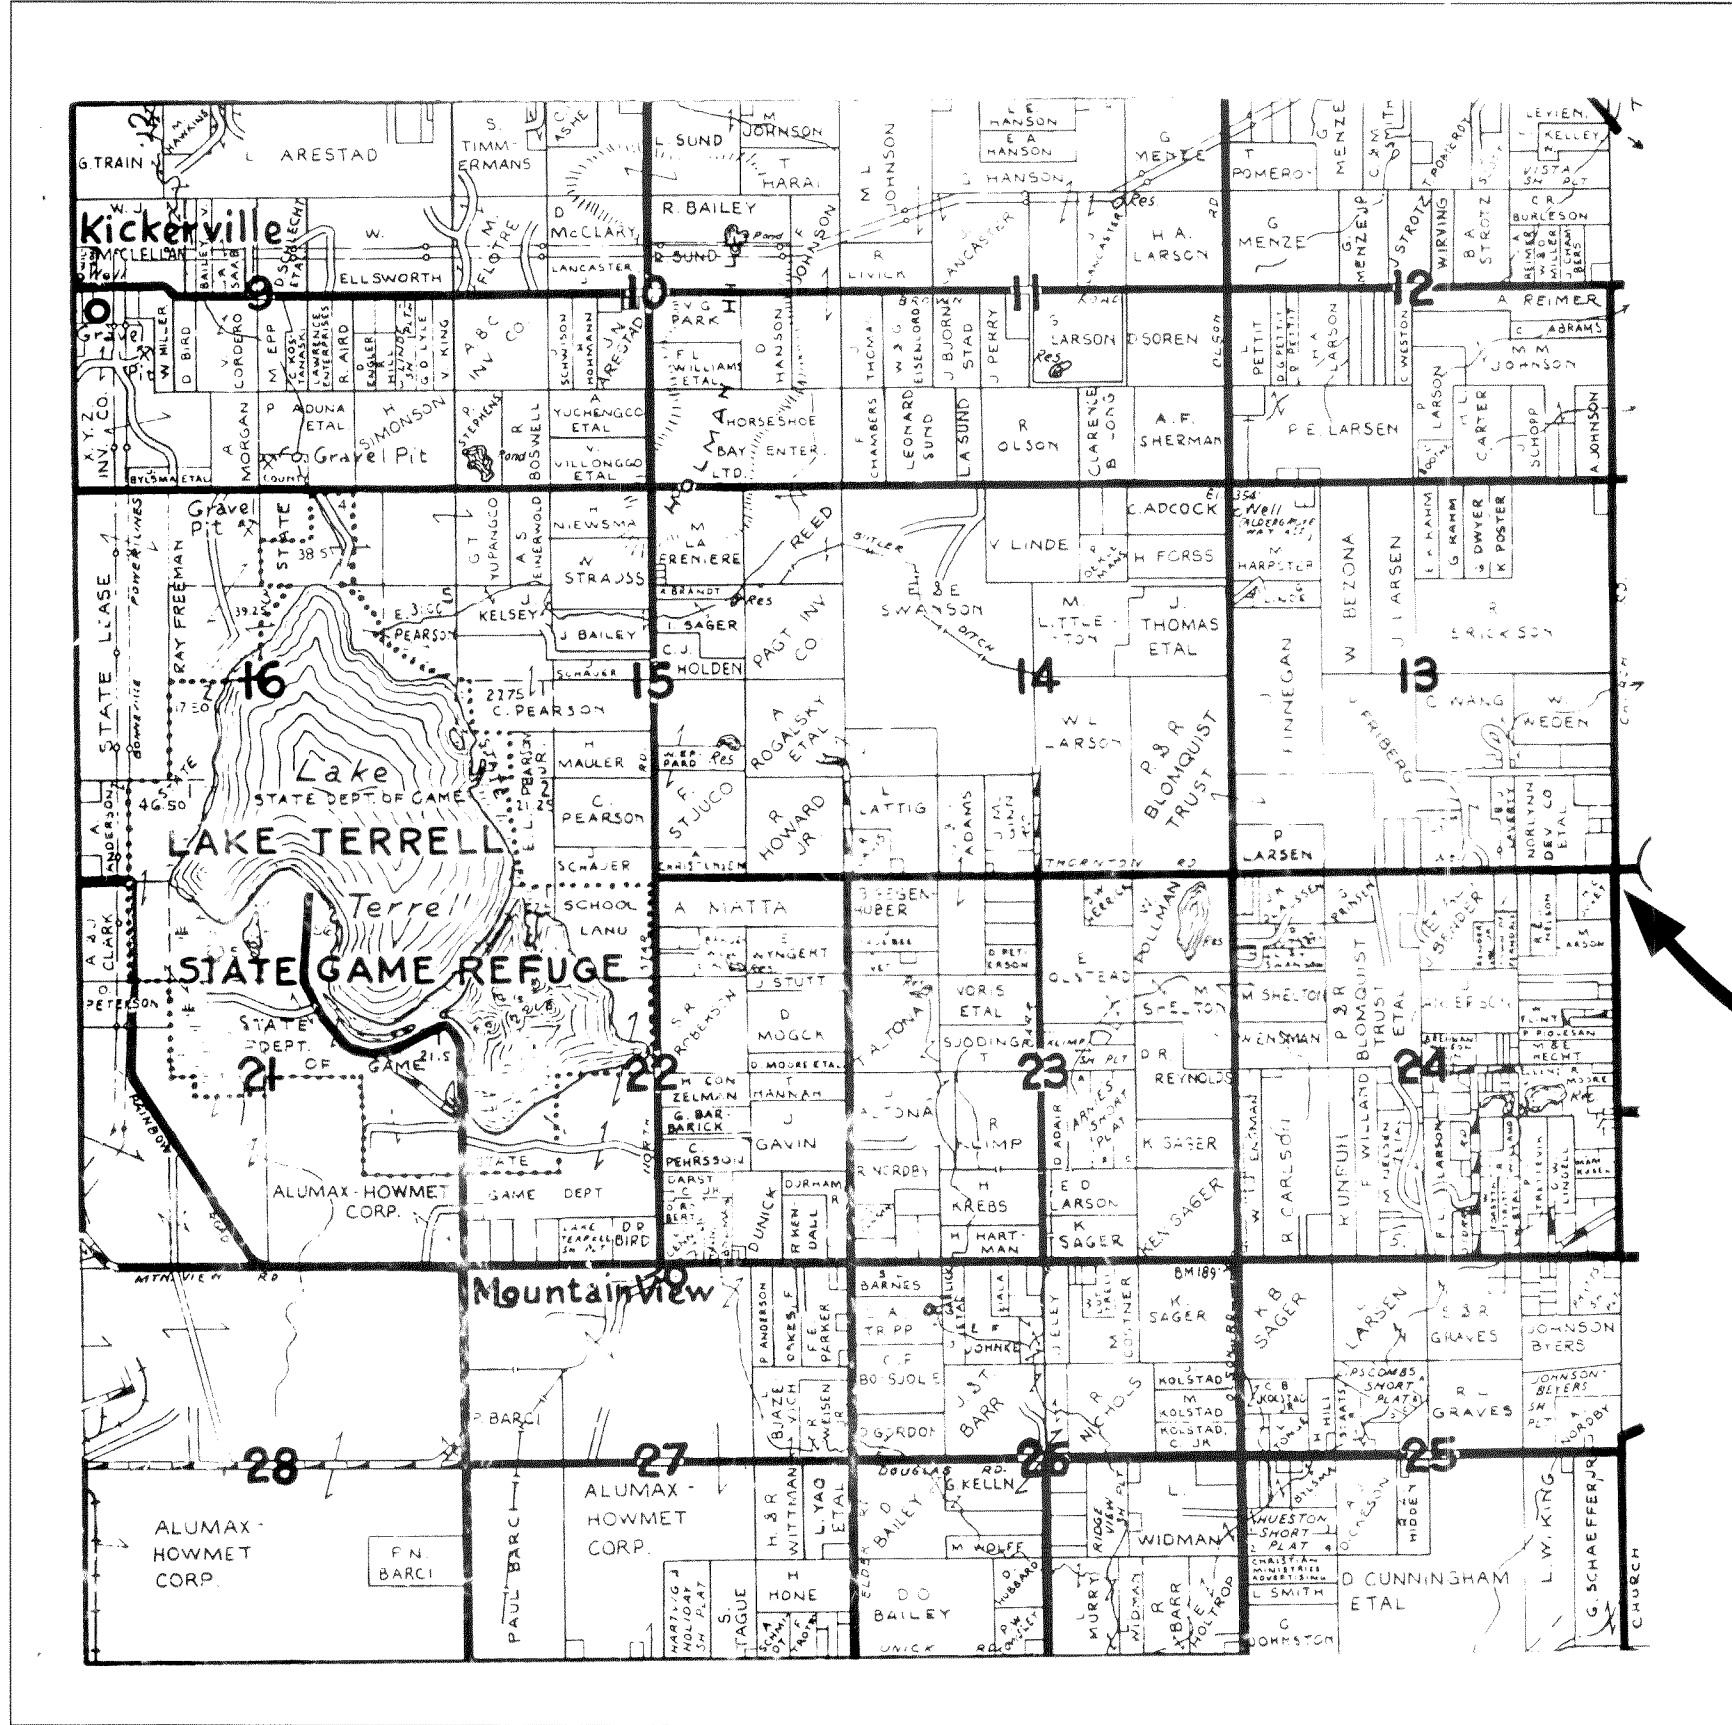

PROJECT
SITE

VICINITY MAP


APPROVED

APR 24 2000

BY *Raven Sperry*
CITY OF FERNDALE

RECORD DRAWING

REVISIONS					DRAWN BY					DATE	CHECKED BY	DATE	SEAL:	12-23-98 ASSOCIATED PROJECT CONSULTANTS, INC., P.S. PROFESSIONAL CONSULTING ENGINEERS 1401 ASTOR STREET BELLINGHAM, WASHINGTON 98225 (360) 671-1146					HORIZONTAL SCALE: N.T.S.		CLIENT: WHATCOM COUNTY FIRE DISTRICT NO. 7		JOB NO.: 97-119	
1														VERTICAL SCALE: N.T.S.		PROJECT: CHURCH AND THORNTON IMPROVEMENTS		ACAD FILE: COVER.DWG						
2														DATE: 12/23/98		SHEET: CS								
3														APPROVED BY:		TITLE: RECORD DRAWINGS								
4														NORTH ROTATION:				6						

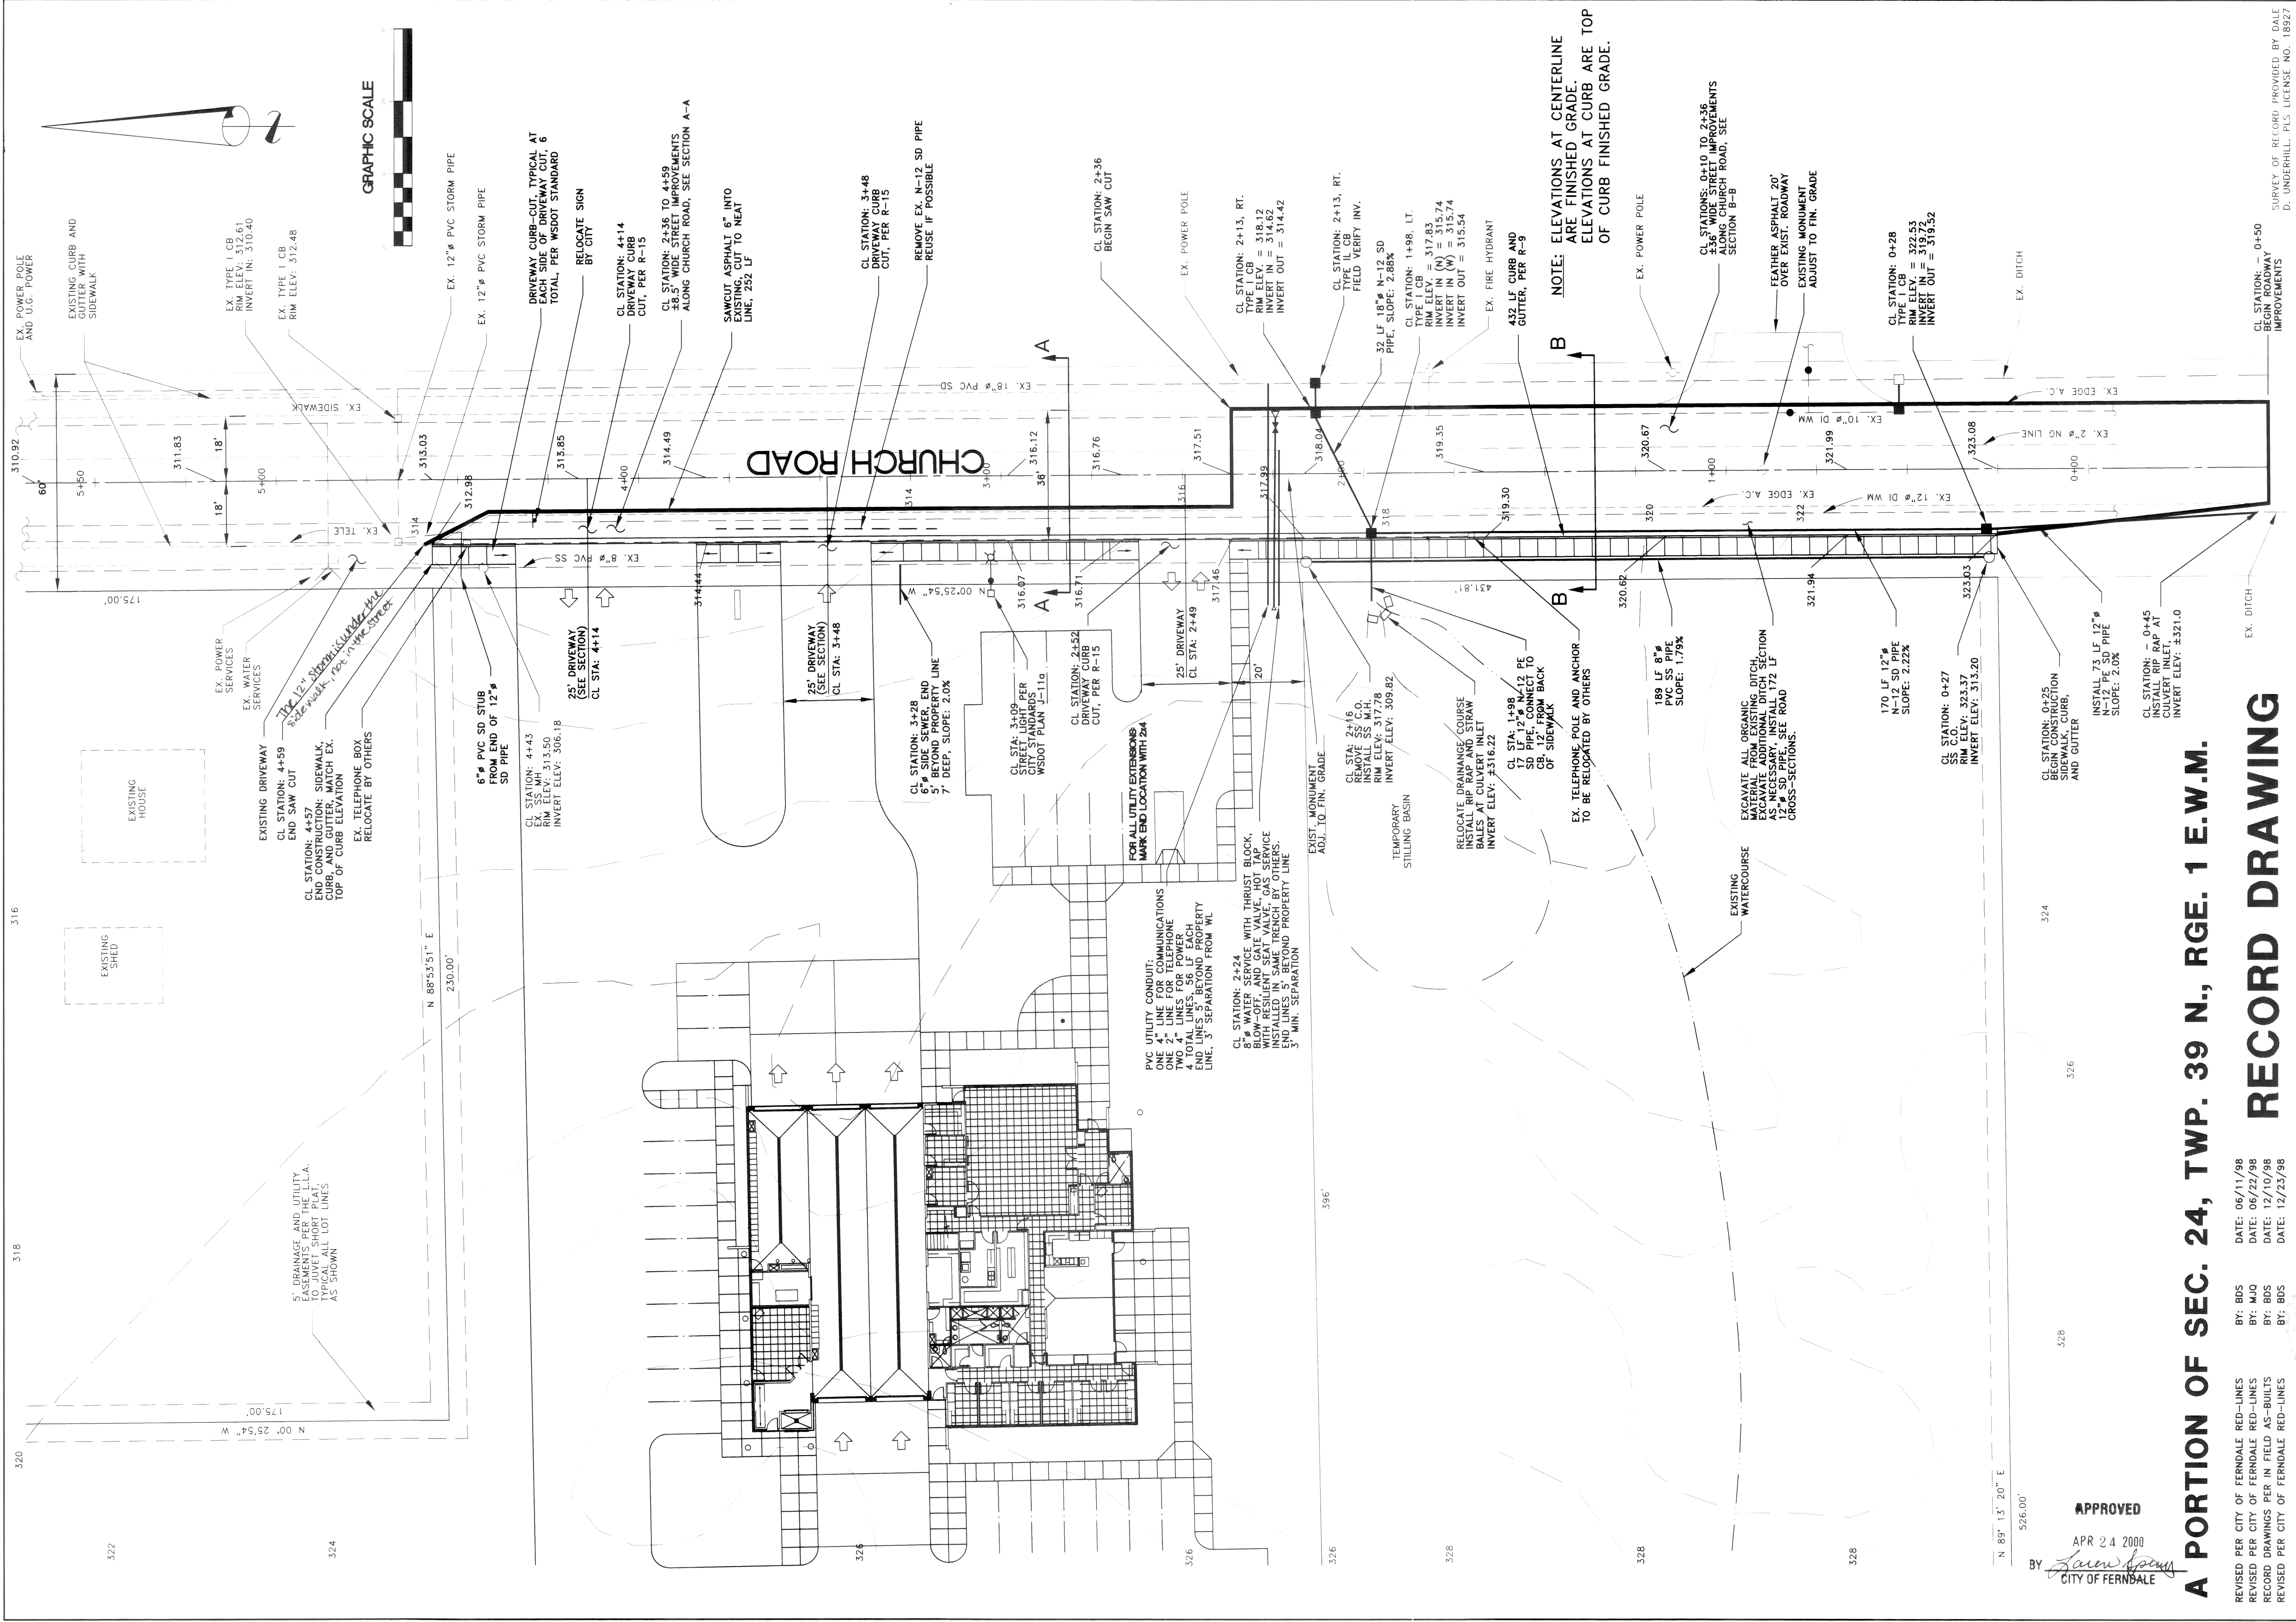

A PORTION OF SEC. 24, TWP. 39 N., RGE. 1 E.W.M.

RECORD DRAWING

REVISED PER CITY OF FERDALE RED-LINES
REVISED PER CITY OF FERDALE RED-LINES
RECORD DRAWINGS PER IN FIELD AS-BUILTS
REVISED PER CITY OF FERDALE RED-LINES

DATE: 06/11/98
BY: BDS
DATE: 06/22/98
BY: MJO
DATE: 12/10/98
BY: BDS
DATE: 12/23/98
BY: BDS

APPROVED
APR 24 2000
CITY OF FERDALE

HORIZONTAL SCALE: 1"=20'
VERTICAL SCALE: DRAWN BY: BDS
DATE: 04/25/98
NORTH ARROW: & BASE POINT:

SEAL: *DW Layton*
7-23-98


ASSOCIATED
PROJECT CONSULTANTS, INC., P.S.
PROFESSIONAL CONSULTING ENGINEERS
1401 ASTOR STREET BELLINGHAM WASHINGTON 98225 (206) 671-1146 FAX 671-1169

CLIENT: WHATCOM COUNTY FIRE DISTRICT NO. 7
PROJECT: CHURCH AND THORNTON IMPROVEMENTS
TITLE: CHURCH ROAD CONSTRUCTION PLANS

JOB NO.: 97-111
ACAD FILE: 1111111111
SHEET: 1
OF: 6
SURVEY OF RECORD PROVIDED BY DALE D. UNDERHILL, PLS LICENSE NO. 18927

00286.002 82-10-06 K12

A PORTION OF SEC. 24, TWP. 39 N., RGE. 1 E.W.M.

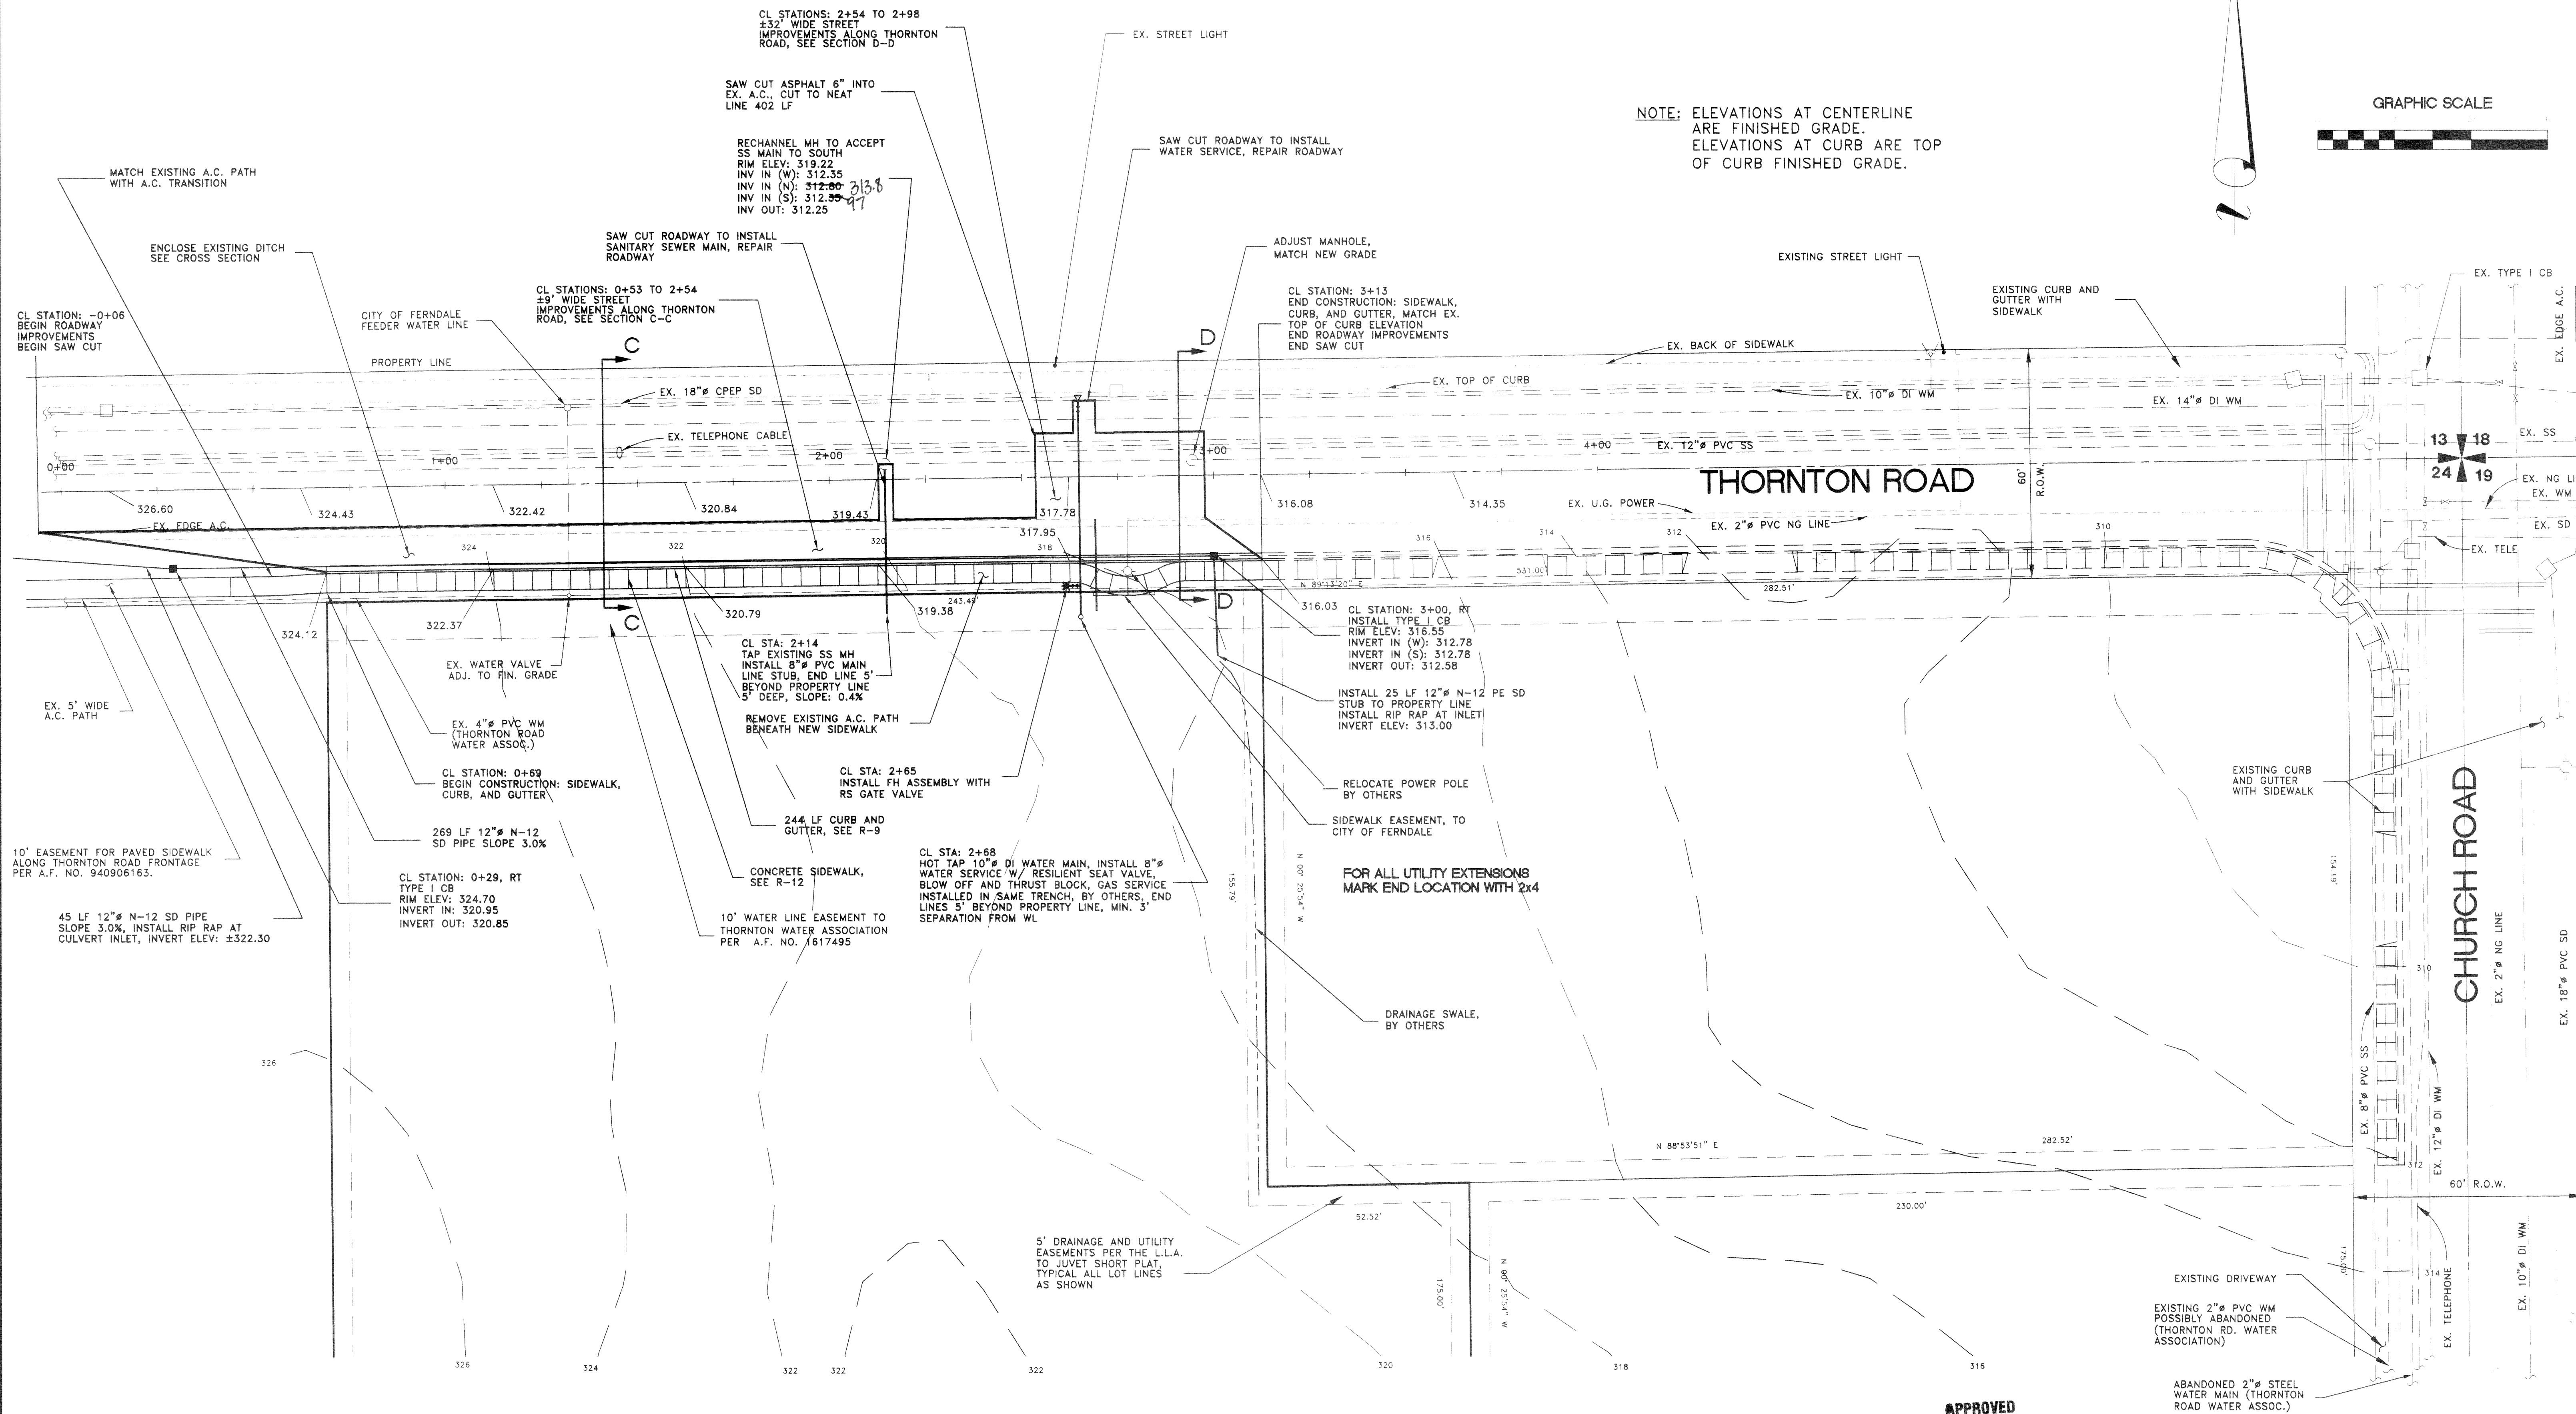

SURVEY OF RECORD
PROVIDED BY DALE
D. UNDERHILL, PLS
LICENSE NO. 18927

REVISIONS	DRAWN BY	DATE	CHECKED BY	DATE
1	BDS	06/11/98		
2	BDS	12/10/98		
3	BDS	12/23/98		
4				

SEAL:

ASSOCIATED
PROJECT CONSULTANTS, INC., P.S.
PROFESSIONAL CONSULTING ENGINEERS
1401 ASTOR STREET BELLINGHAM, WASHINGTON 98225 (360) 671-1146


HORIZONTAL SCALE: 1"=20'
VERTICAL SCALE: DRAWN BY: BDS
DATE: 04/24/98
NORTH ROTATION:

CLIENT: WHATCOM COUNTY FIRE DISTRICT NO. 7
PROJECT: CHURCH AND THORNTON IMPROVEMENTS
TITLE: THORNTON ROAD CONSTRUCTION PLAN

JOB NO.: 97-119
ACAD FILE: THORNTN.DWG
SHEET: 2
OF: 6

RECORD DRAWING

00280.003 2-10-00 KLR

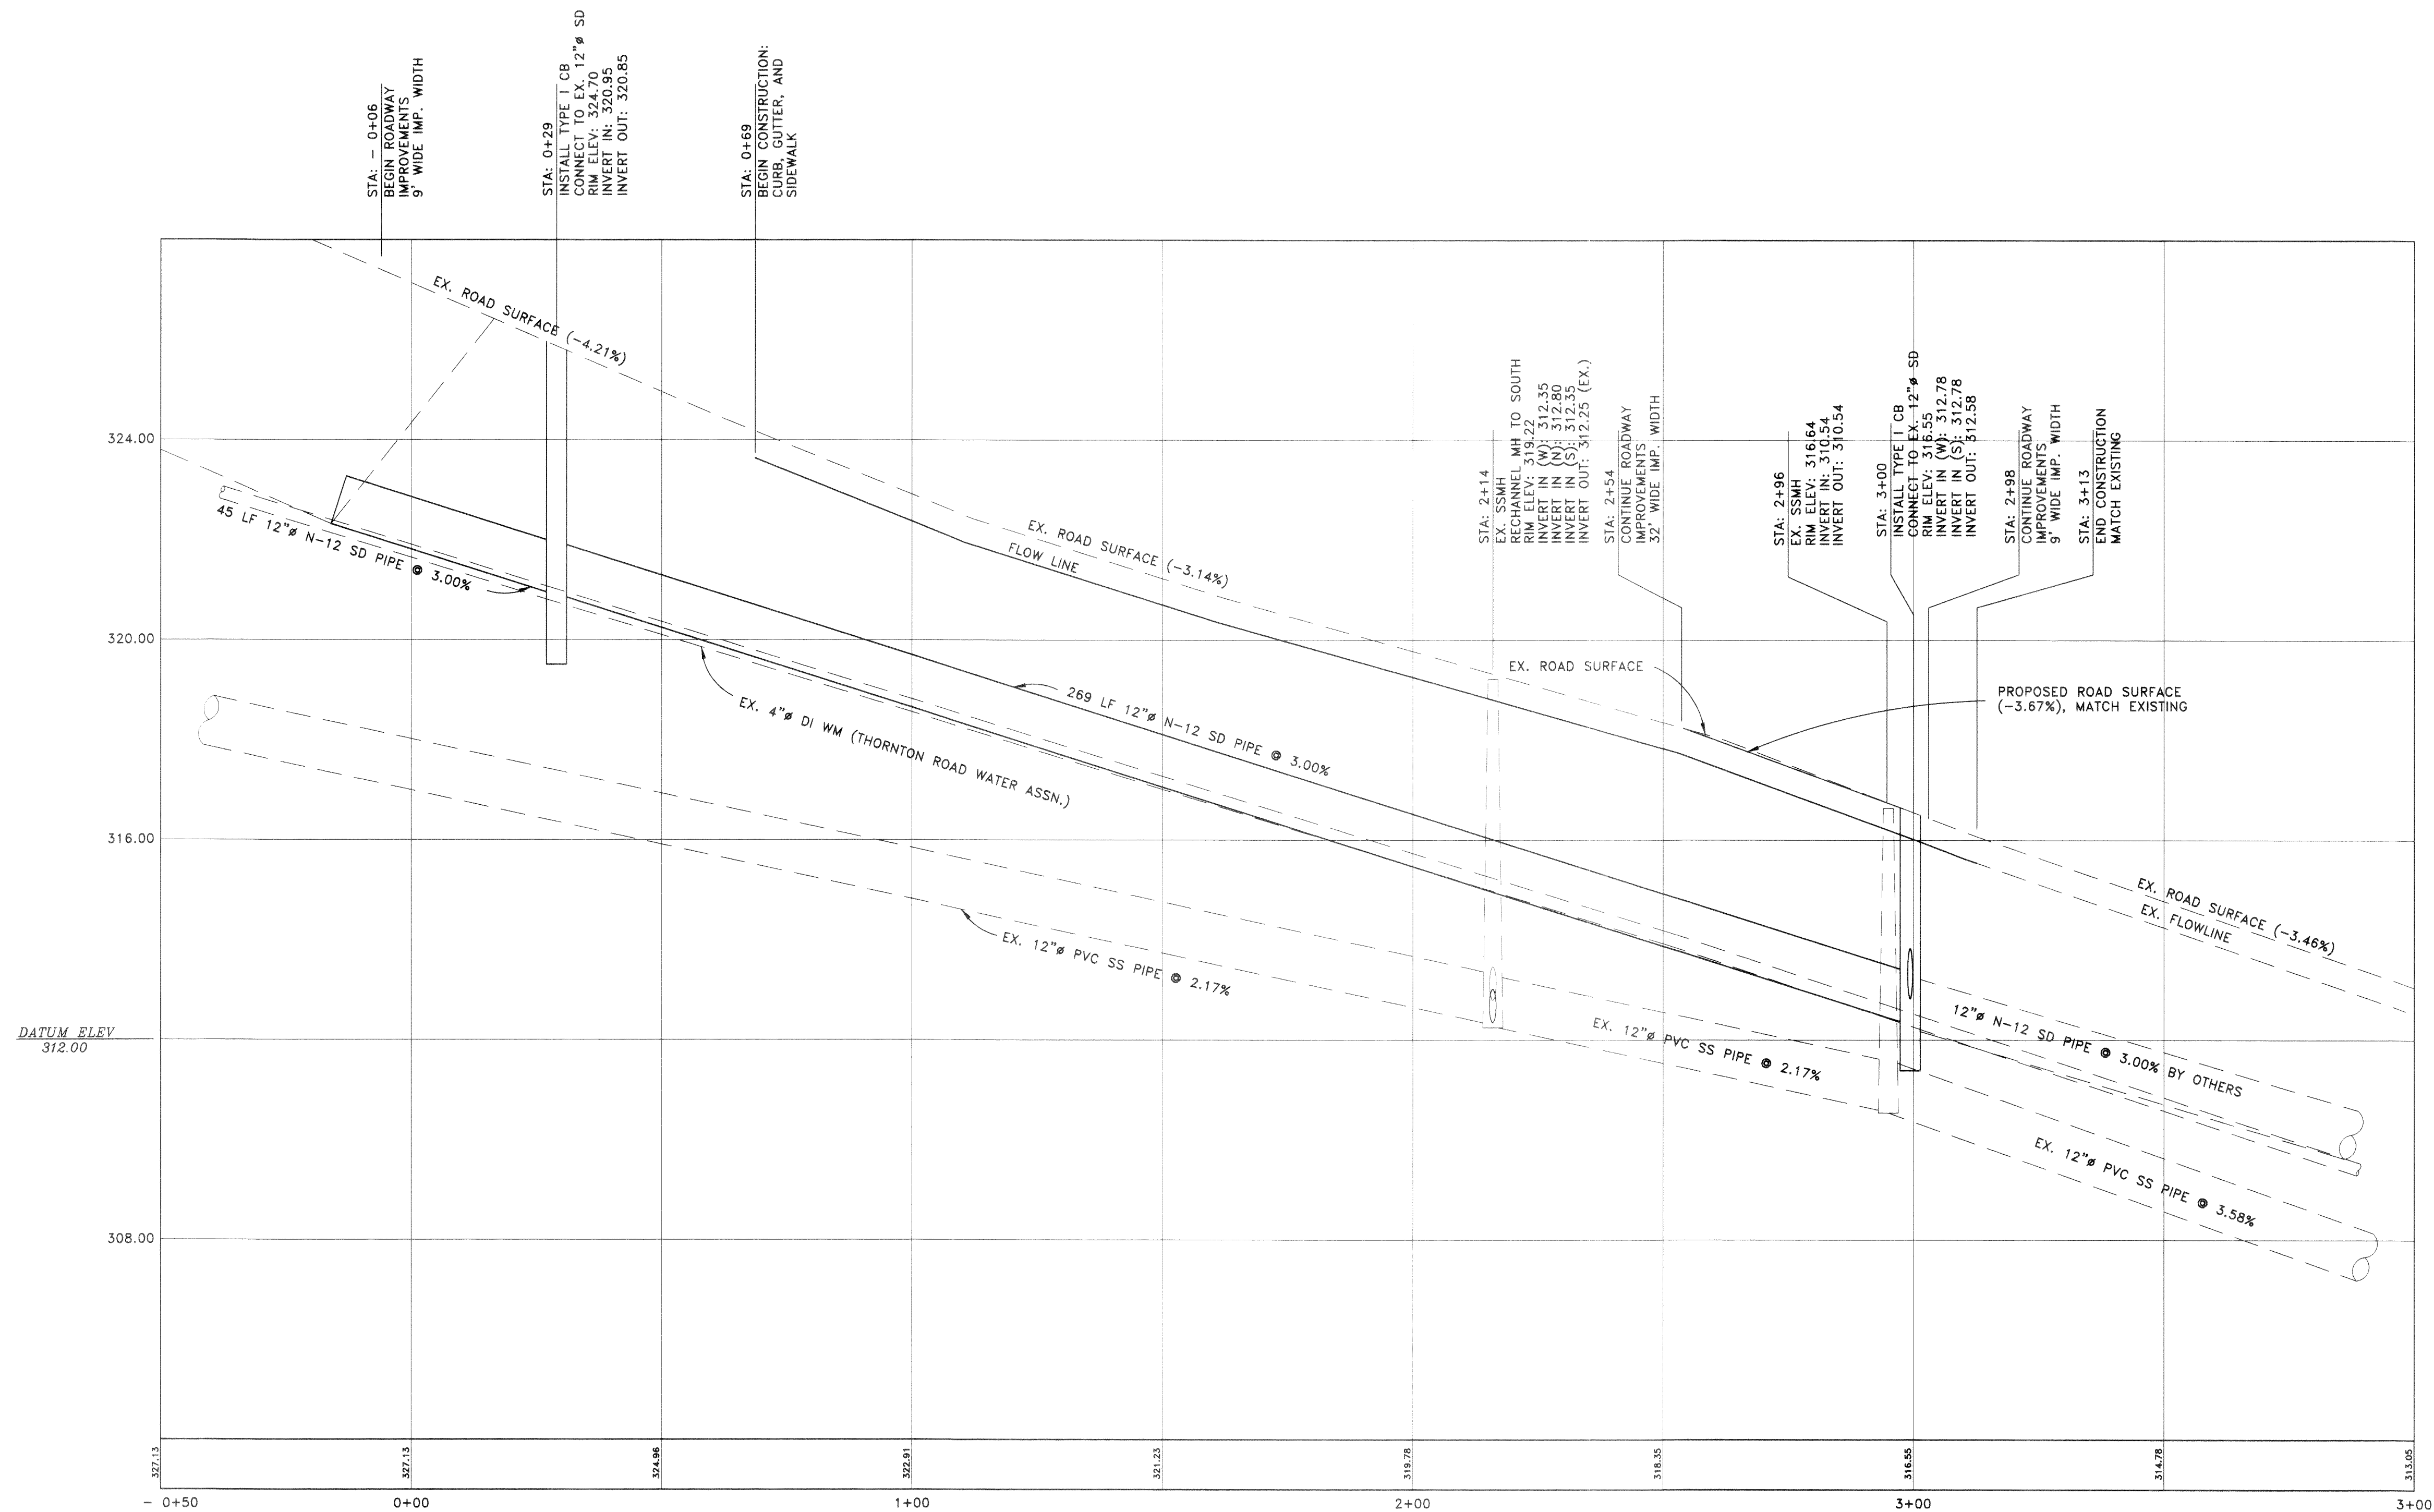

THORNTON ROAD PROFILE

SCALE:
HORIZ. 1"=20'
VERT. 1"=2'

APPROVED
APR 24 2000
BY *[Signature]*
CITY OF FERNDALE

RECORD DRAWING

REVISIONS:		DRAWN BY	DATE	CHECKED BY	DATE	SEAL:	HORIZONTAL SCALE: 1"=20'		CLIENT: WHATCOM COUNTY FIRE DISTRICT NO. 7		JOB NO.: 97-119
1	RECORD DRAWING FOR FINAL REVIEW	BDS	12/13/98				VERTICAL SCALE: 1"=2'	DRAWN BY: BDS	PROJECT: CHURCH AND THORNTON IMPROVEMENTS		ACAD FILE: THORPROF.DWG
2	REVISED PER CITY OF FERNDALE REQUEST	BDS	12/23/98				DATE: 05/07/98	APPROVED BY:	SHEET: 4		
3							NORTH ROTATION:		OF: 6		
4									TITLE: THORNTON ROAD PROFILE		

ASSOCIATED
PROJECT CONSULTANTS, INC., P.S.
PROFESSIONAL CONSULTING ENGINEERS
1401 ASTOR STREET BELLINGHAM, WASHINGTON 98225 (360) 671-1146

002846.005 2-10-06 KR

60286 00% 2:10:00 VP


GENERAL NOTES

1. ALL WORK AND MATERIALS SHALL BE IN ACCORDANCE WITH CURRENT WSDOT/APWA STANDARD SPECIFICATIONS, CITY OF FERNDALE DEVELOPMENT STANDARDS, AND SHALL BE SUBJECT TO APPROVAL BY CITY OF FERNDALE PUBLIC WORKS DEPARTMENT
2. A REVOCABLE ENCROACHMENT PERMIT SHALL BE OBTAINED PRIOR TO COMMENCING WORK IN THE RIGHT OF WAY
3. CONTRACTOR SHALL CONTACT UTILITY LOCATION SERVICE 48 HOURS PRIOR TO STARTING CONSTRUCTION AT 1-800-424-5555
4. ANY TESTING REQUIRED FOR THE IMPROVEMENTS SHALL BE THE RESPONSIBILITY TO THE OWNER AND SHALL BE IN CONFORMANCE WITH THE CITY OF FERNDALE DEVELOPMENT STANDARDS.
5. ALL WORK MUST BE INSPECTED AND APPROVED BY A REPRESENTATIVE OF THE CITY OF FERNDALE PUBLIC WORKS, AND 24 HOURS MUST BE GIVEN PRIOR TO STARTING WORK OR TO SCHEDULE INSPECTIONS.
6. THE CONTRACTOR SHALL BE RESPONSIBLE FOR PROVIDING ADEQUATE SAFEGUARDS, SAFETY DEVICES, PROTECTIVE EQUIPMENT, FLAGGERS, AND ANY OTHER NEEDED ACTIONS TO PROTECT THE LIFE, HEALTH, AND SAFETY OF THE PUBLIC, AND TO PROTECT PROPERTY IN CONNECTION WITH THE PERFORMANCE OF WORK COVERED BY THE CONTRACTOR.
7. TRAFFIC CONTROL TO BE MAINTAINED IN ACCORDANCE WITH STANDARD SPECIFICATIONS 1-07.23.
8. LOCATIONS SHOWN ON EXISTING UTILITIES ARE APPROXIMATE. IDENTIFICATION, LOCATION, MARKING, AND RESPONSIBILITY FOR UNDERGROUND FACILITIES OR UTILITIES IS GOVERNED BY THE PROVISIONS OF CHAPTER 19.122, REVISED CODE OF WASHINGTON. SEE SECTION 1-07.17 OF STANDARDS SPECIFICATIONS.
9. ALL SIGNING SHALL BE IN ACCORDANCE WITH THE MANUAL OF UNIFORM TRAFFIC CONTROL DEVICES.
10. CATCH BASINS AND COVERS TO BE MAINTAINED IN ACCORDANCE WITH THE CITY OF FERNDALE DEVELOPMENT STANDARDS SECTIONS 1011 AND 1012.
11. STORM DRAIN MATERIALS AND INSTALLATION TO BE MAINTAINED IN ACCORDANCE WITH THE CITY OF FERNDALE DEVELOPMENT STANDARDS SECTIONS 1007 AND 1013.
12. STORM PIPE AND DRAINAGE STRUCTURES SHALL BE OF AN APPROVED MATERIAL AND OF THE SIZE NOTED ON THE PLANS.
13. CONTRACTOR SHALL RIP RAP ALL CULVERT INLETS AND OUTLETS.
14. ALL TRENCHES SHALL BE BACKFILLED WITH GRANULAR MATERIAL AND COMPACTED TO 95% OF OPTIMUM DENSITY.
15. WATER DISTRIBUTION, WATER SERVICES, TO BE MAINTAINED IN ACCORDANCE WITH THE CITY OF FERNDALE DEVELOPMENT STANDARDS SECTIONS 702 AND 705.
16. SANITARY SEWER, SIDE SEWER, TO BE MAINTAINED IN ACCORDANCE WITH THE CITY OF FERNDALE DEVELOPMENT STANDARDS SECTIONS 702 AND 708.
17. STREET ILLUMINATION TO BE MAINTAINED IN ACCORDANCE WITH THE CITY OF FERNDALE DEVELOPMENT STANDARDS SECTIONS 702 AND 707.
18. CONCRETE SIDEWALK TO BE MAINTAINED IN ACCORDANCE WITH THE CITY OF FERNDALE DEVELOPMENT STANDARDS SECTION 803.
19. CEMENT CONCRETE CURB AND GUTTER TO BE MAINTAINED IN ACCORDANCE WITH THE CITY OF FERNDALE DEVELOPMENT STANDARDS SECTIONS 615 AND 1010.
20. STREET BASE AND SUBSURFACING TO BE MAINTAINED IN ACCORDANCE WITH THE CITY OF FERNDALE DEVELOPMENT STANDARDS SECTION 611.
21. GRAVEL BASE TO BE MAINTAINED IN ACCORDANCE WITH THE STANDARD SPECIFICATIONS SECTION 4-02.
22. CRUSHED ROCK TO BE MAINTAINED IN ACCORDANCE WITH THE STANDARD SPECIFICATIONS SECTION 4-04.
23. ASPHALT TREATED BASE TO BE MAINTAINED IN ACCORDANCE WITH THE STANDARD SPECIFICATIONS SECTION 4-06.
24. CLASS B ASPHALT CONCRETE TO BE MAINTAINED IN ACCORDANCE WITH THE STANDARD SPECIFICATIONS 5-04.
25. ALL EXCAVATED MATERIAL SHALL BE THE RESPONSIBILITY OF THE CONTRACTOR TO DISPOSE OF IN THE PROPER MANNER. THE CITY OF FERNDALE TAKES NO RESPONSIBILITY FOR ANY OF THE REMOVED MATERIAL.
26. CONTRACTOR SHALL RESTORE ALL PRIVATE AND PUBLIC PROPERTY DISRUPTED BY THE PROJECT IMMEDIATELY AFTER CONSTRUCTION.
27. ALL HARD SURFACED PAVEMENTS MUST BE REPAIRED AT THE CLOSE OF EACH WORK DAY. THE REPAIRS CAN BE TEMPORARY WITH ASPHALT COLD MIX OR PERMANENT WITH HOT MIX ASPHALT OR CONCRETE. ALL REPAIRS SHALL BE ACCORDING TO THE CITY OF FERNDALE SPECIFICATION ST-3.
28. ALL CUT AND FILL SLOPES SHALL BE SEEDDED AND FERTILIZED FOR EROSION CONTROL. CONTRACTOR SHALL BE RESPONSIBLE FOR SLOPE EROSION UNTIL VEGETATION IS FIRMLY ESTABLISHED.
29. INSTALLATION OF FILTER FABRIC FENCE PER THE STANDARD SPECIFICATIONS IS REQUIRED WHEREVER RUNOFF AND EROSION CAN OCCUR OR AS DIRECTED BY THE ENGINEER.
30. UPON COMPLETION OF THE PROJECT A CERTIFIED MYLAR AS-BUILT PRINT SHALL BE PROVIDED THE CITY.
31. A COPY OF THESE APPROVED PLANS MUST BE ON THE JOB SITE WHENEVER CONSTRUCTION IS IN PROGRESS.

THORNTON ROAD IMPROVEMENTS, SECTIONS C-C AND D-D

HORIZONTAL SCALE: 1"=6'
VERTICAL SCALE: N.T.S.


SECTION C-C APPLIES TO CL STATIONS 0+53 TO 2+54 AND 2+98 TO 3+13
SECTION D-D APPLIES TO CL STATIONS 2+54 TO 2+98

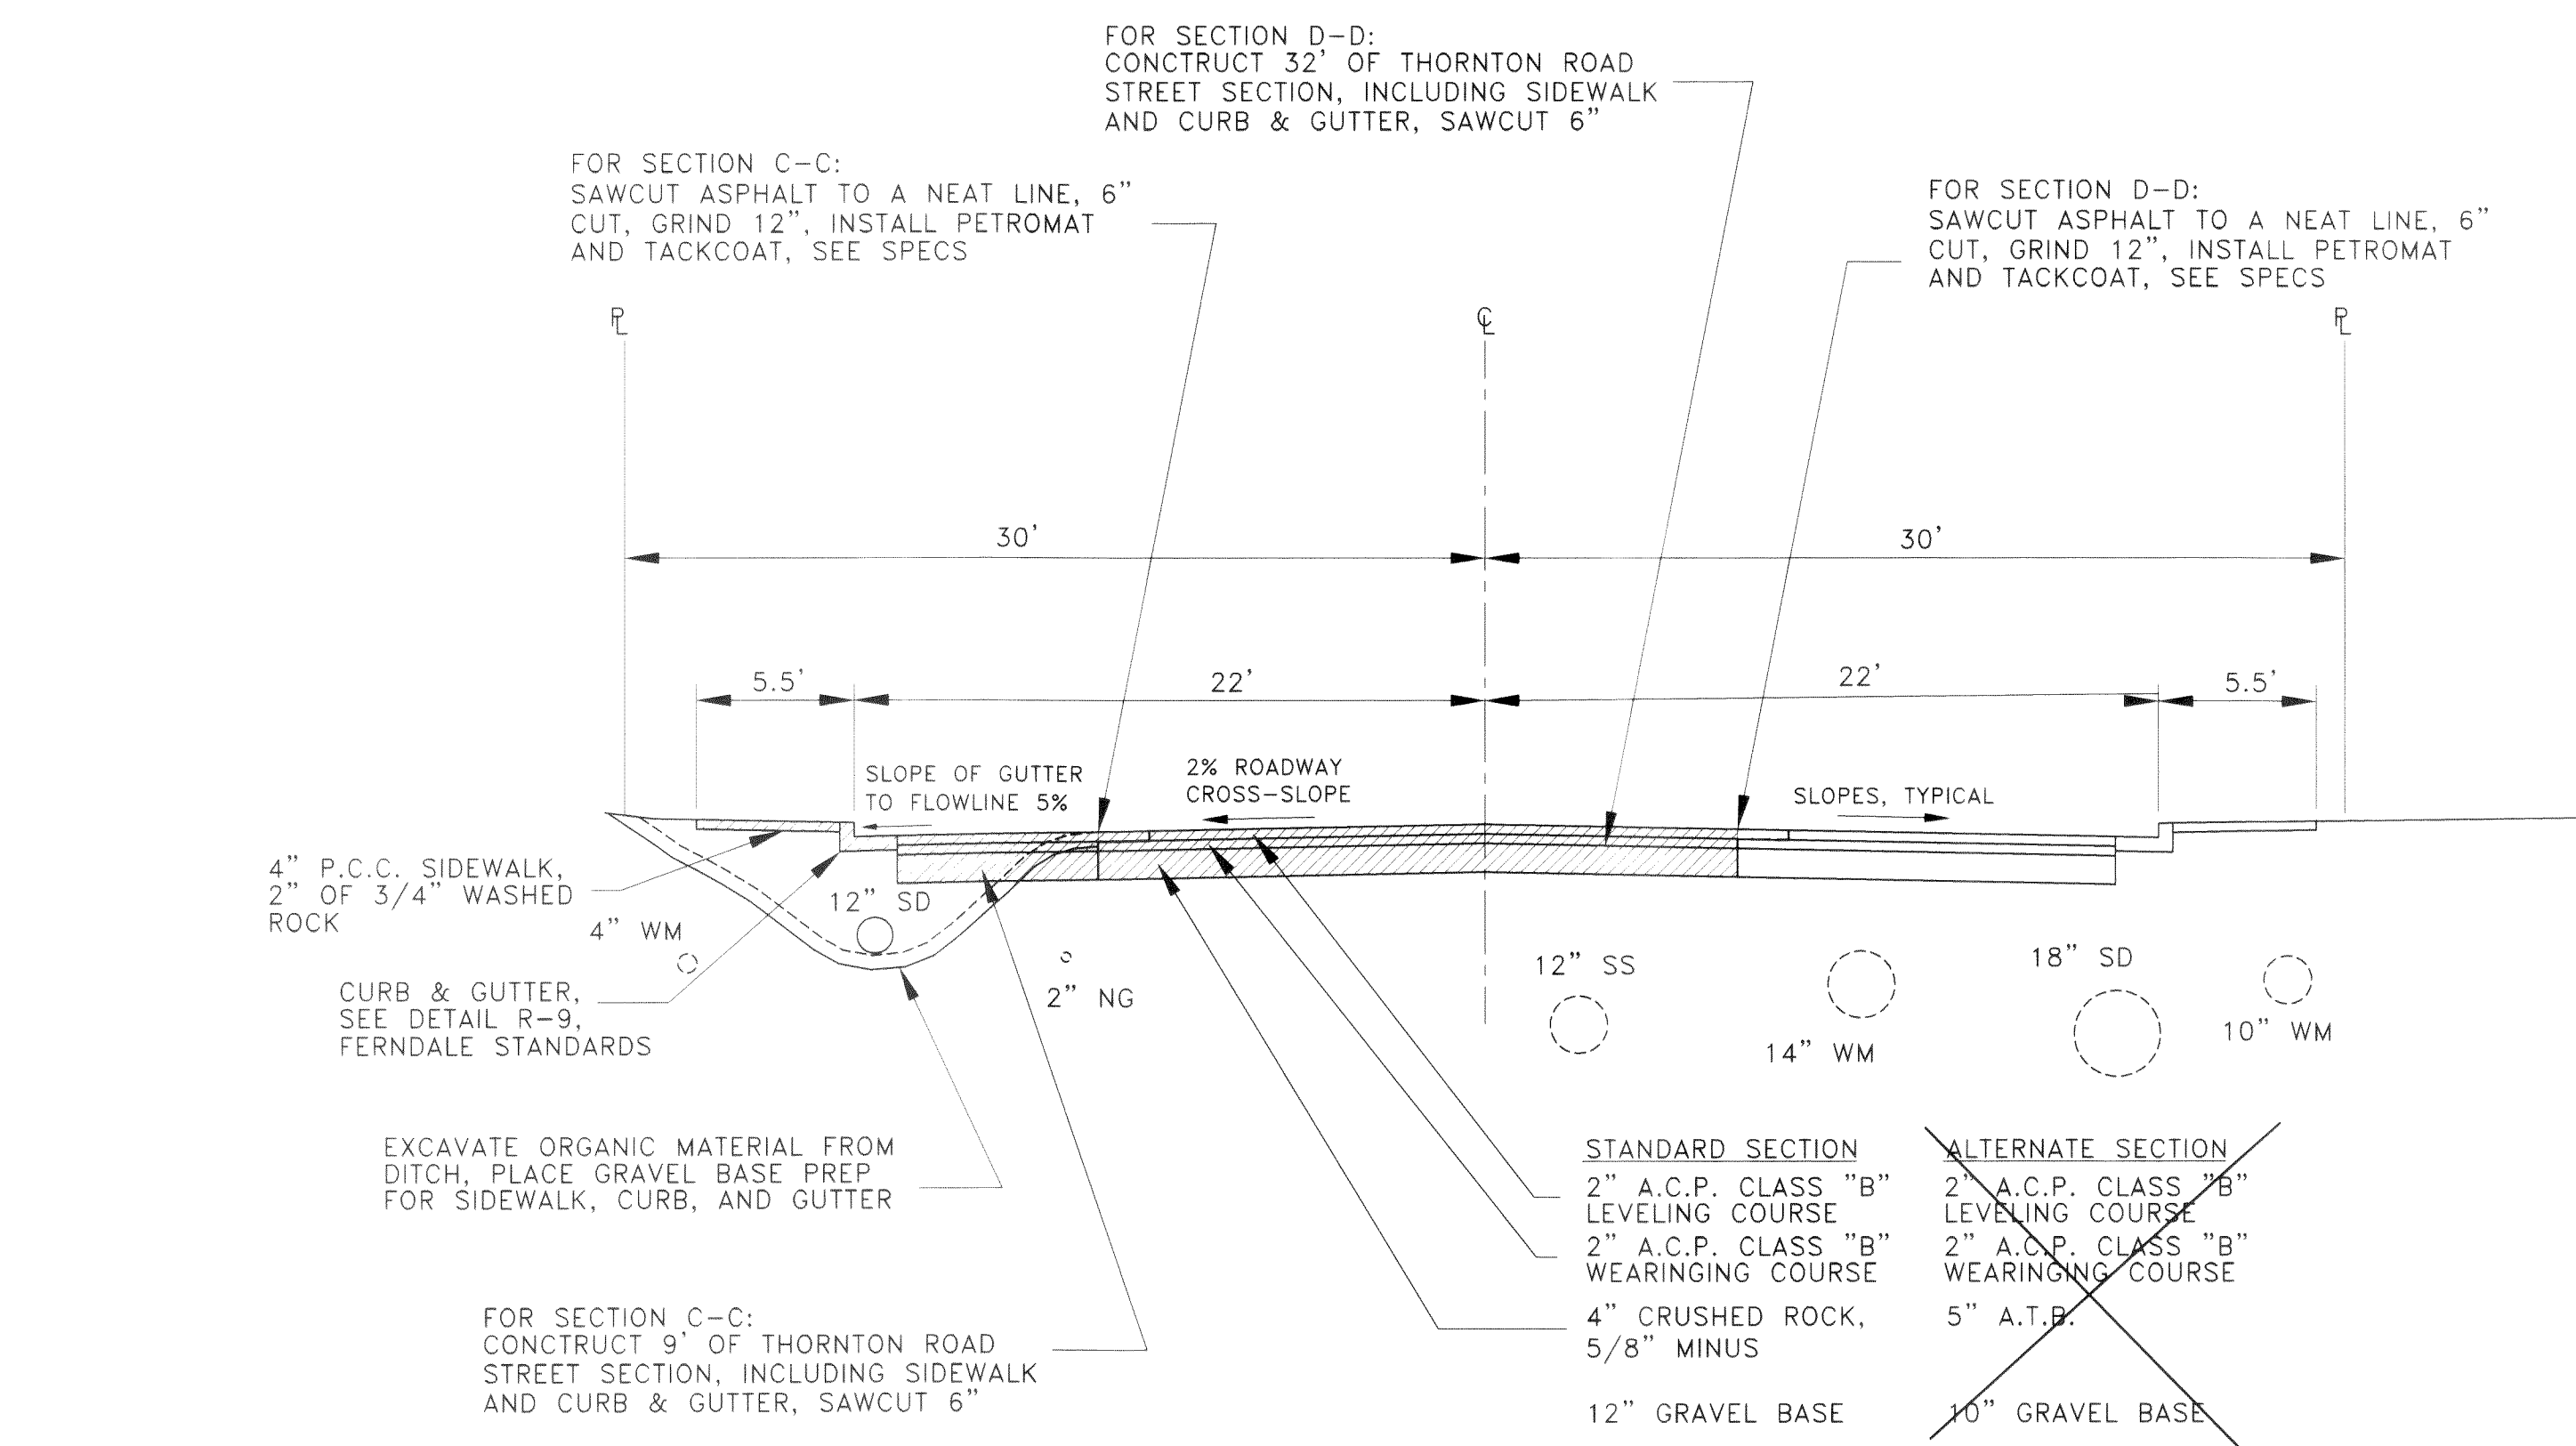

CHURCH ROAD IMPROVEMENTS, SECTION A-A

HORIZONTAL SCALE: 1"=6'
VERTICAL SCALE: N.T.S.


SECTION A-A APPLIES TO CL STATIONS 2+36 TO 4+59

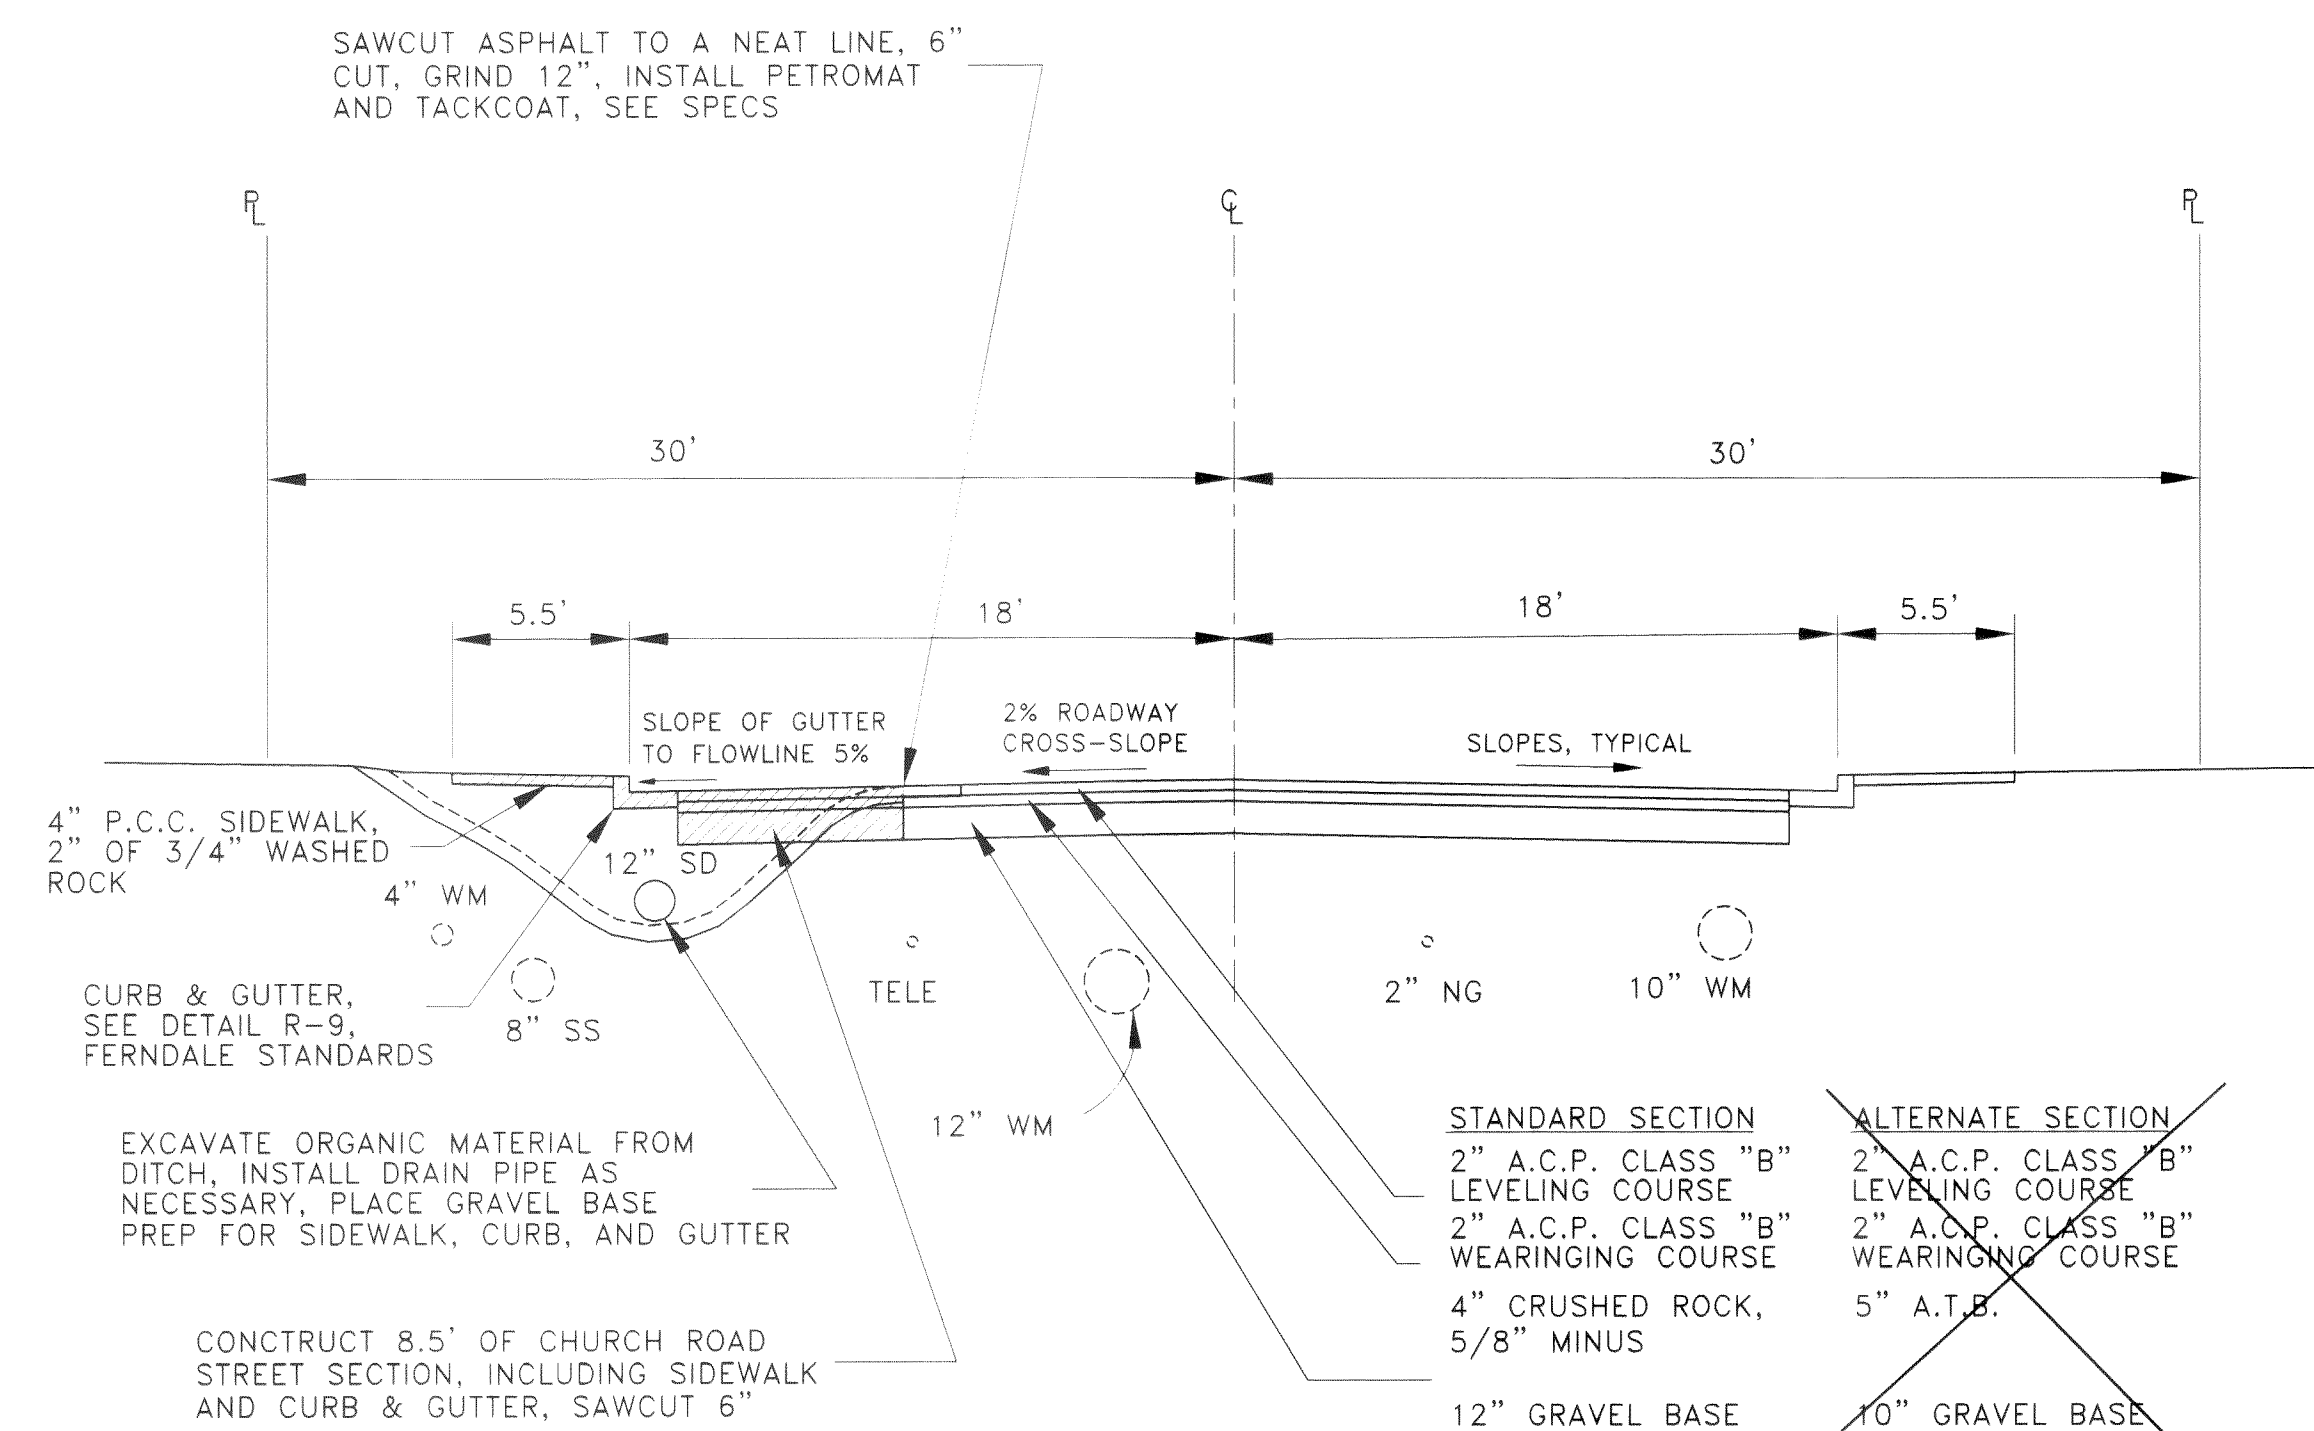

CHURCH ROAD IMPROVEMENTS, SECTION B-B


HORIZONTAL SCALE: 1"=6'
VERTICAL SCALE: N.T.S.

SECTION B-B APPLIES TO CL STATIONS 0+10 TO 2+36

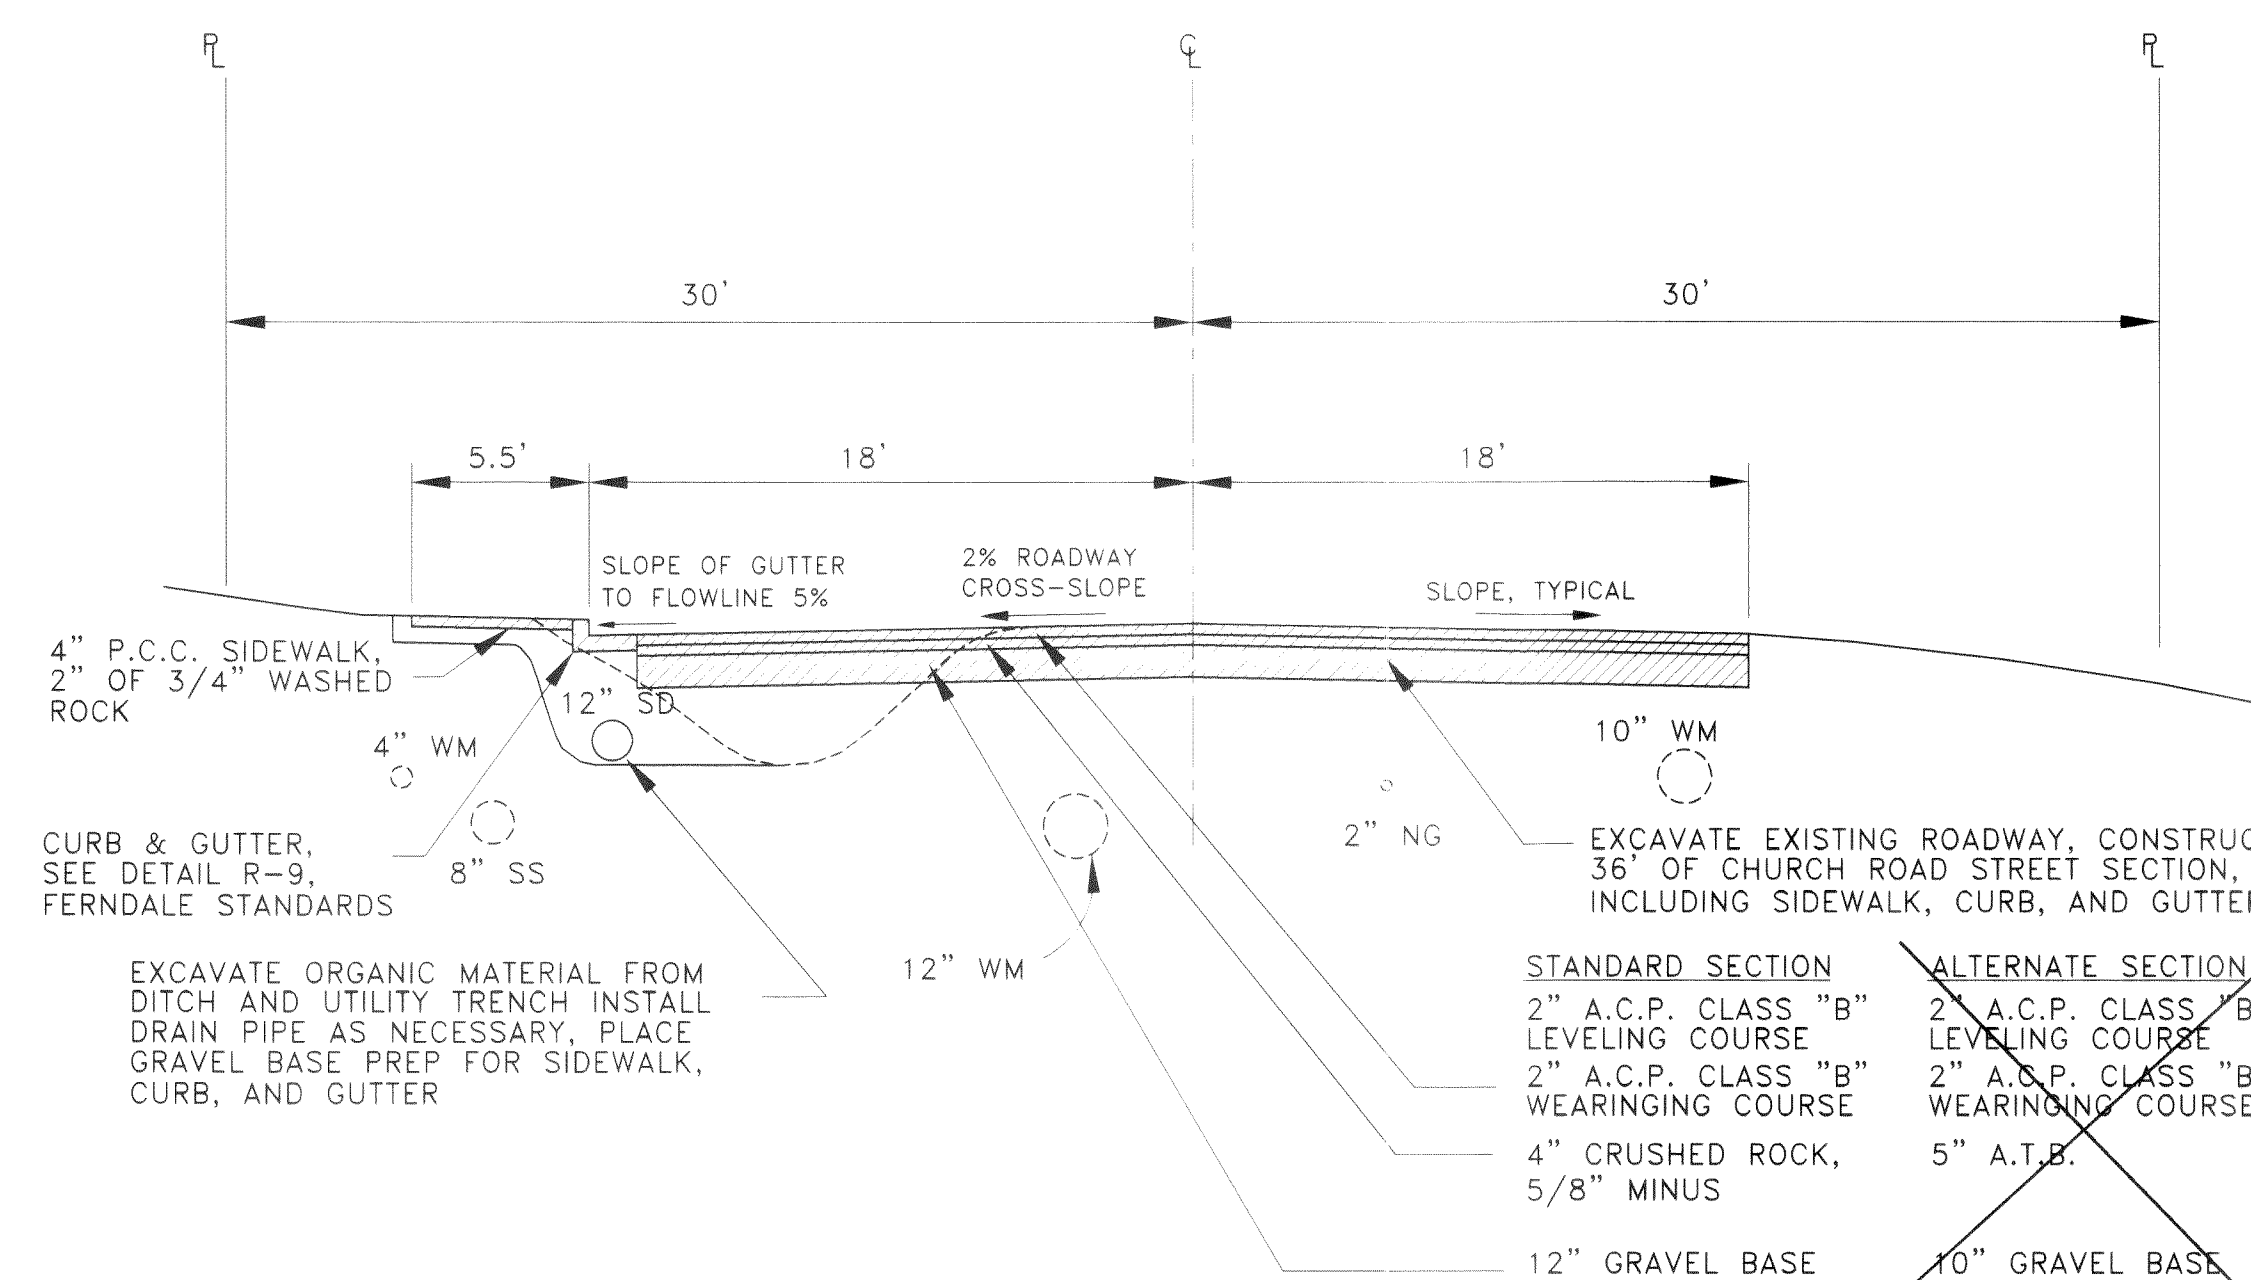

DEPRESSED DRIVEWAY SECTION

NOT TO SCALE

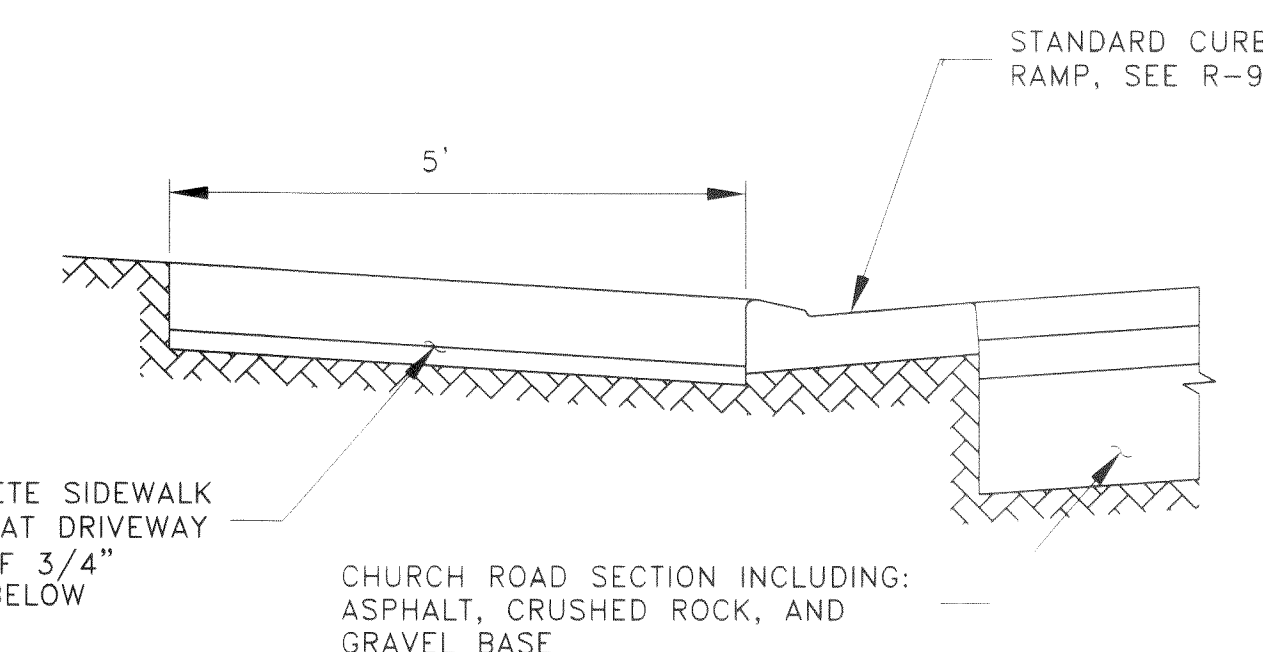

APPROVED









APR 24 2000

BY Larry Spear
CITY OF FERDALE

RECORD DRAWING

REVISIONS: 1 REVISED PER CITY OF PUYALLUP REQUEST 2 RECORD DRAVING PER FIELD MEASUREMENTS 3 REVISED PER CITY OF PUYALLUP REQUEST 4				DRAWN BY: SDS DATE: 06-11-98 CHECKED BY: SDS DATE: 12-10-98 DATE: 12-23-98 DATE:				SEAL: 				ASSOCIATED PROJECT CONSULTANTS, INC., P.S. PROFESSIONAL CONSULTING ENGINEERS 1401 ASTOR STREET BELLINGHAM, WASHINGTON 98225 (360) 671-1146				HORIZONTAL SCALE: 1"=20' VERTICAL SCALE: DRAWN BY: BDS DATE: 04/27/98 APPROVED BY: NORTH ROTATION:				CLIENT: WHATCOM COUNTY FIRE DISTRICT NO. 7 PROJECT: CHURCH AND THORNTON IMPROVEMENTS TITLE: CONSTRUCTION DETAILS AND NOTES				JOB NO.: 97-119 ASAD FILE: DETAIL DWG SHEET: 5 OF: 6			
--	--	--	--	---	--	--	--	--	--	--	--	---	--	--	--	---	--	--	--	--	--	--	--	---	--	--	--

Cadd No. 007 2-10-08 KR

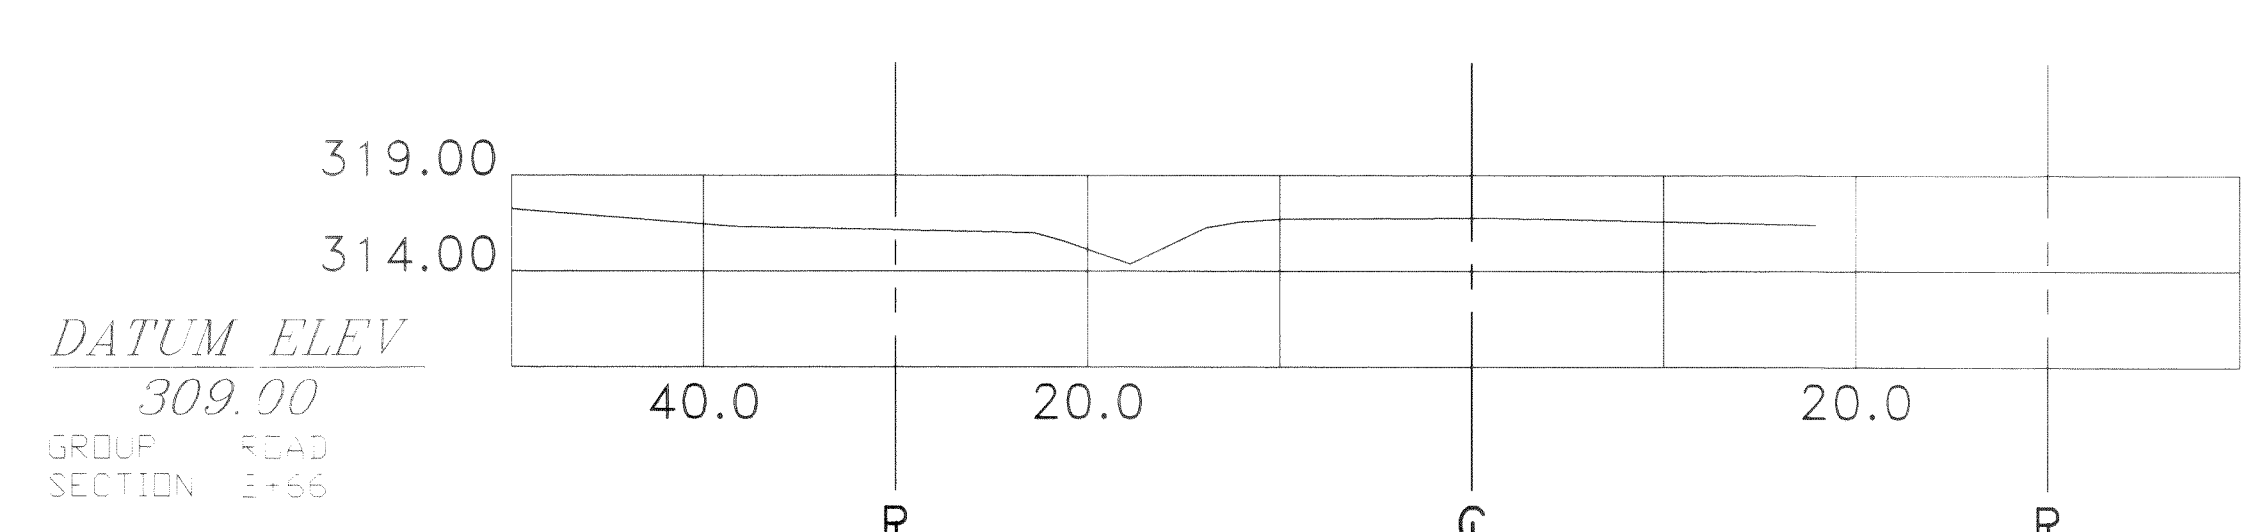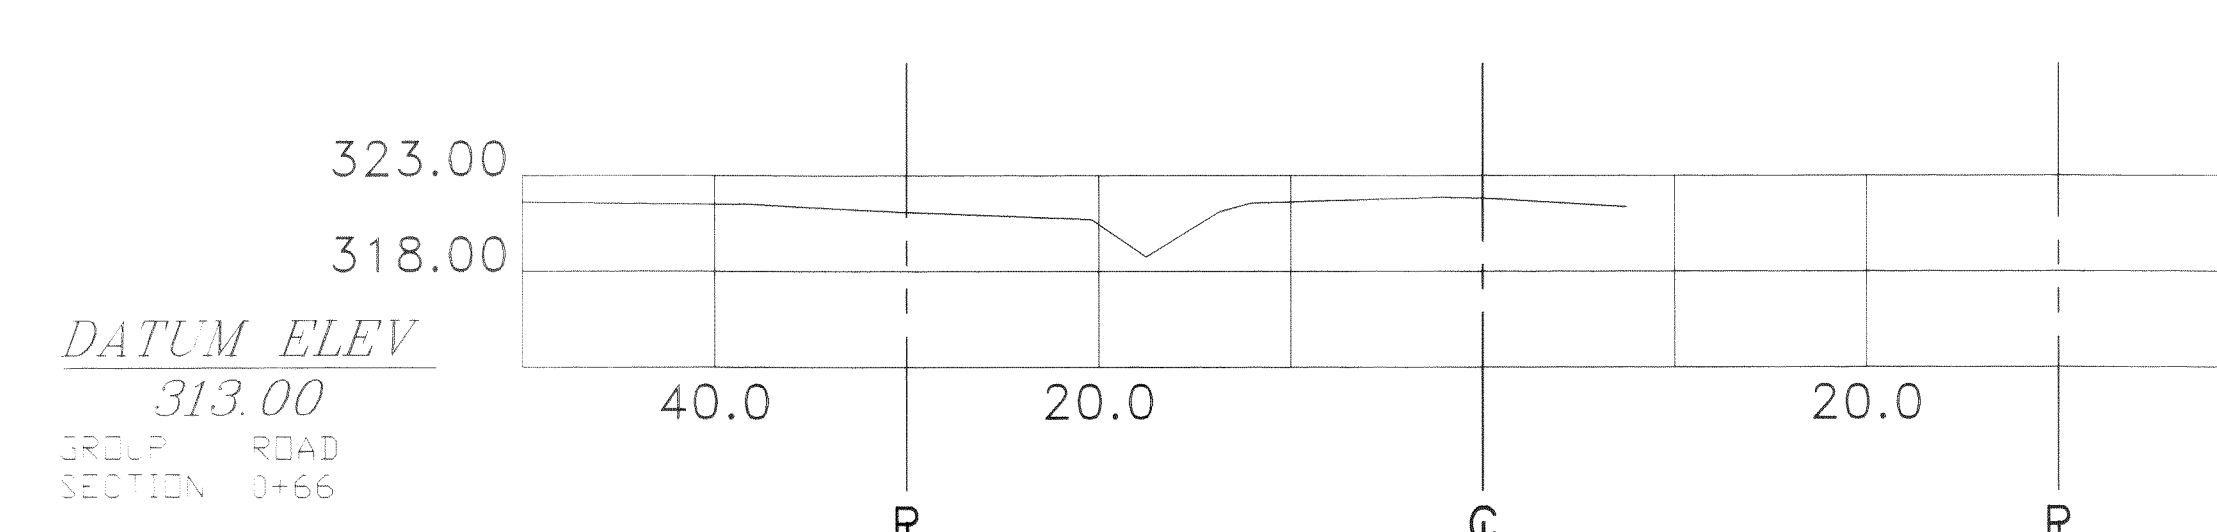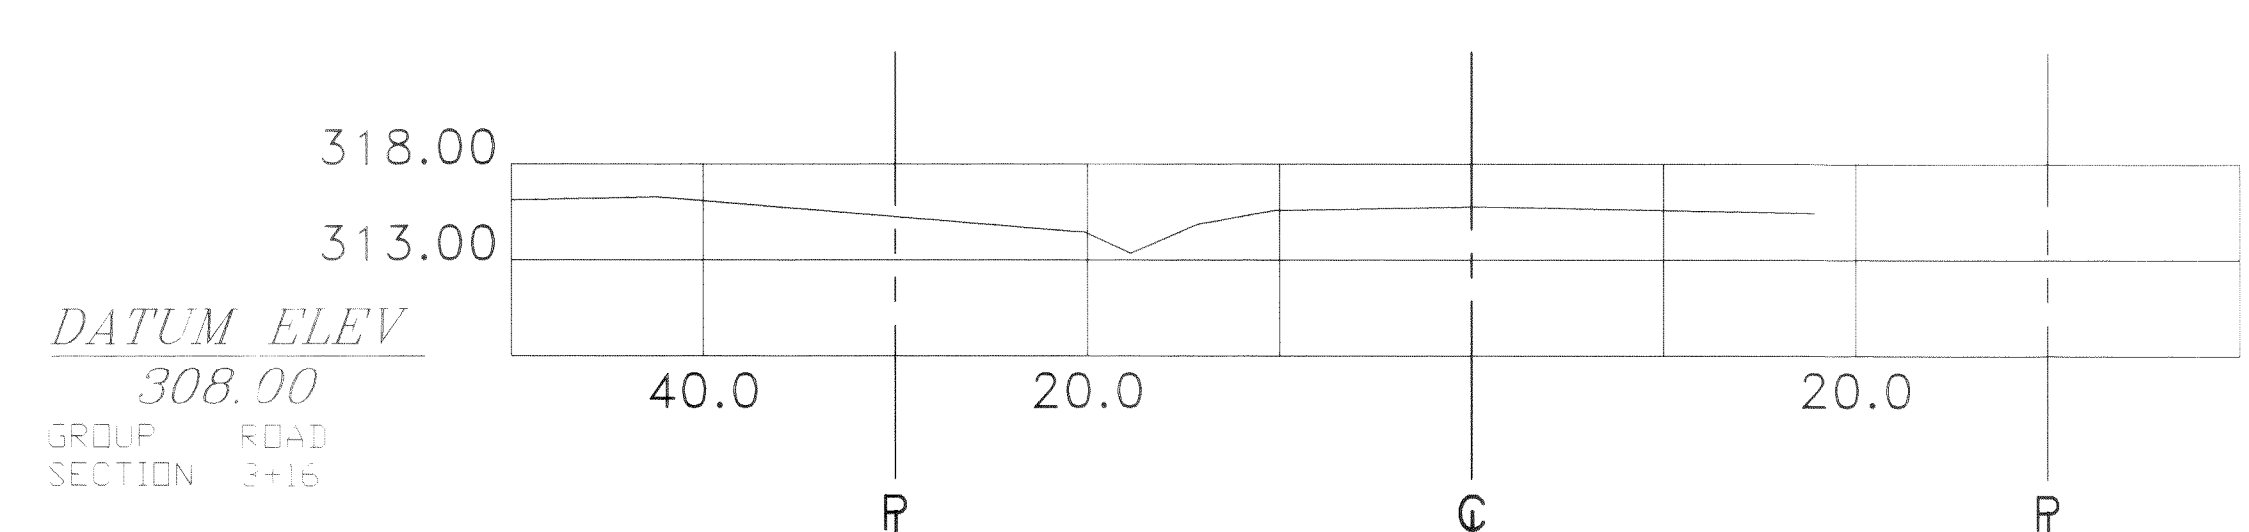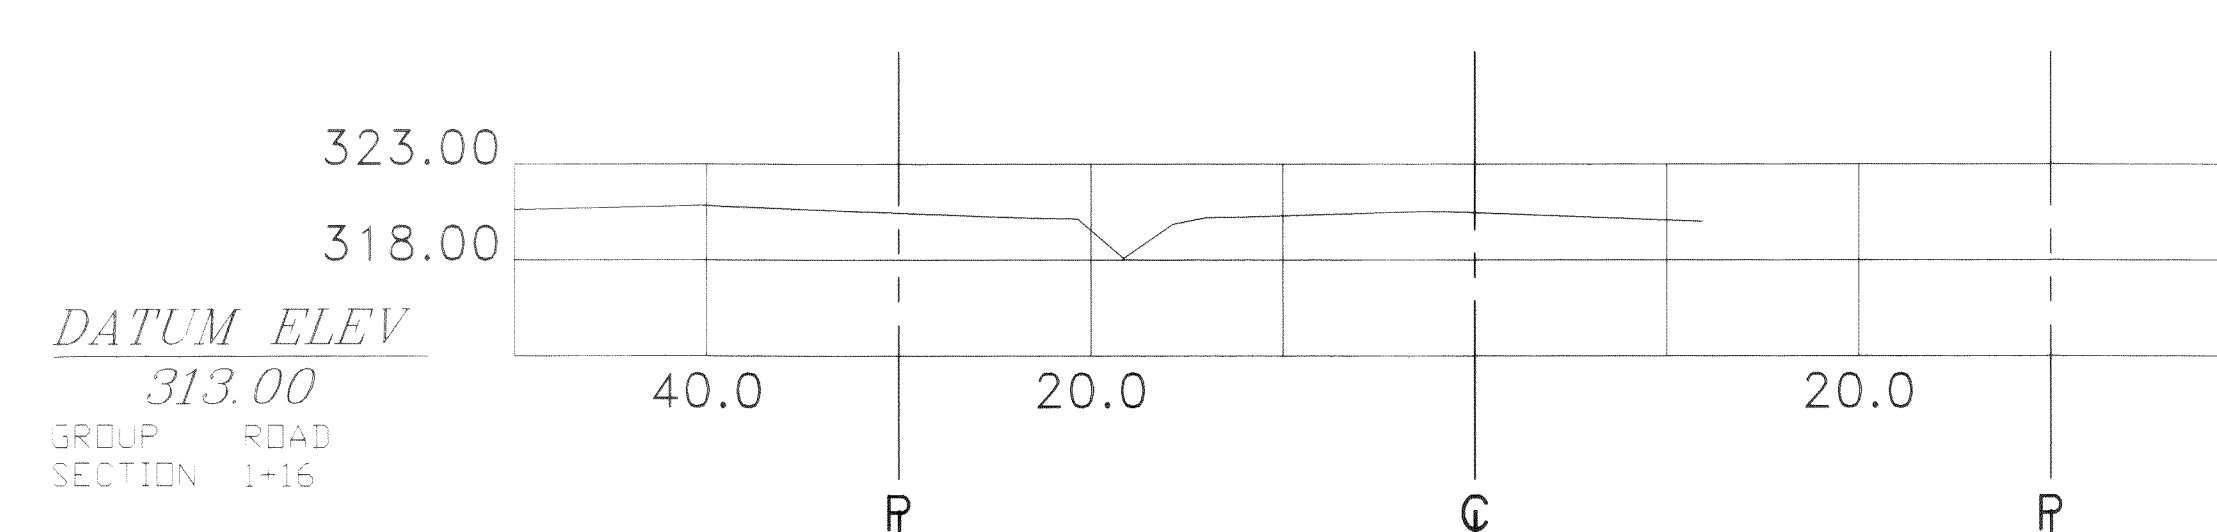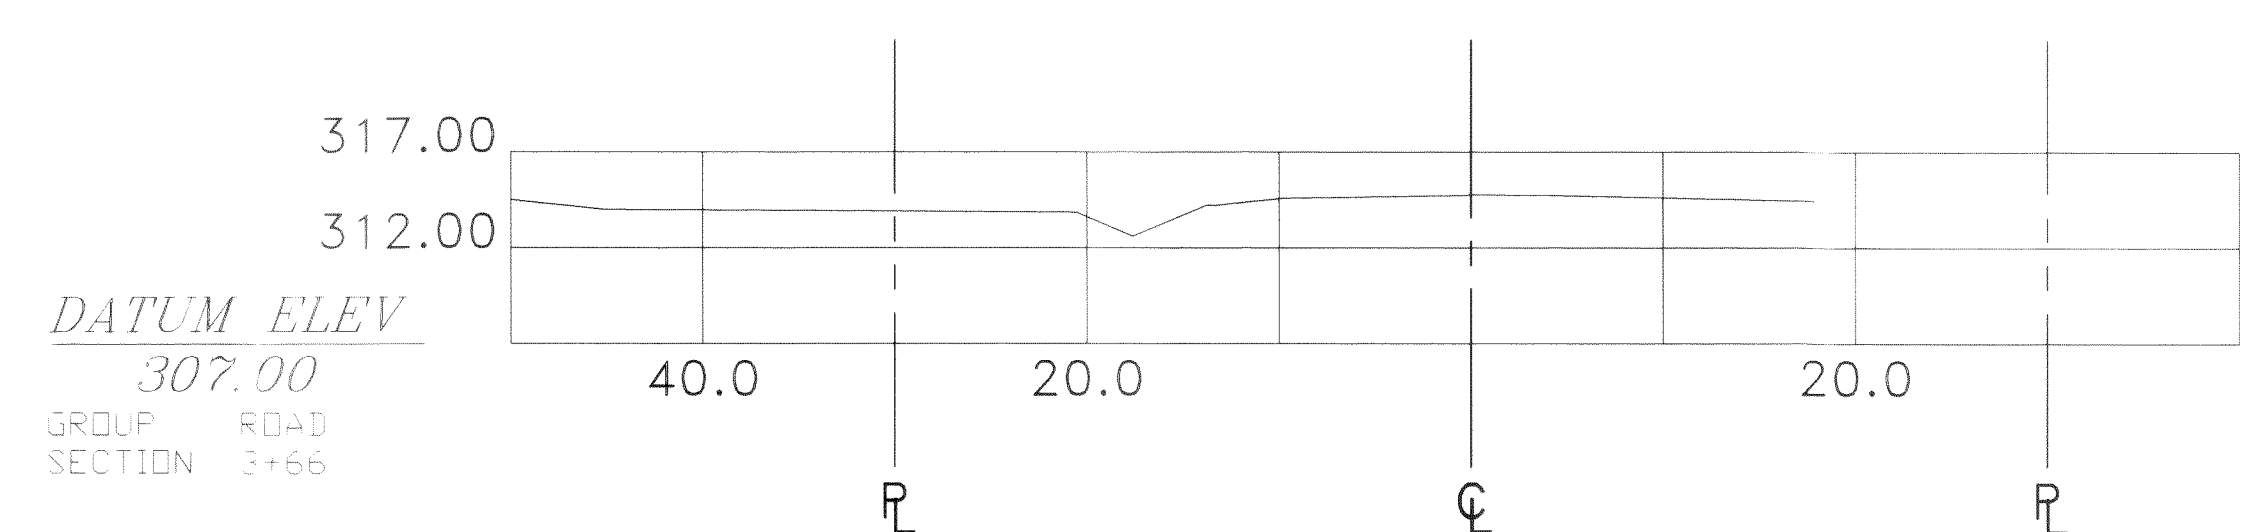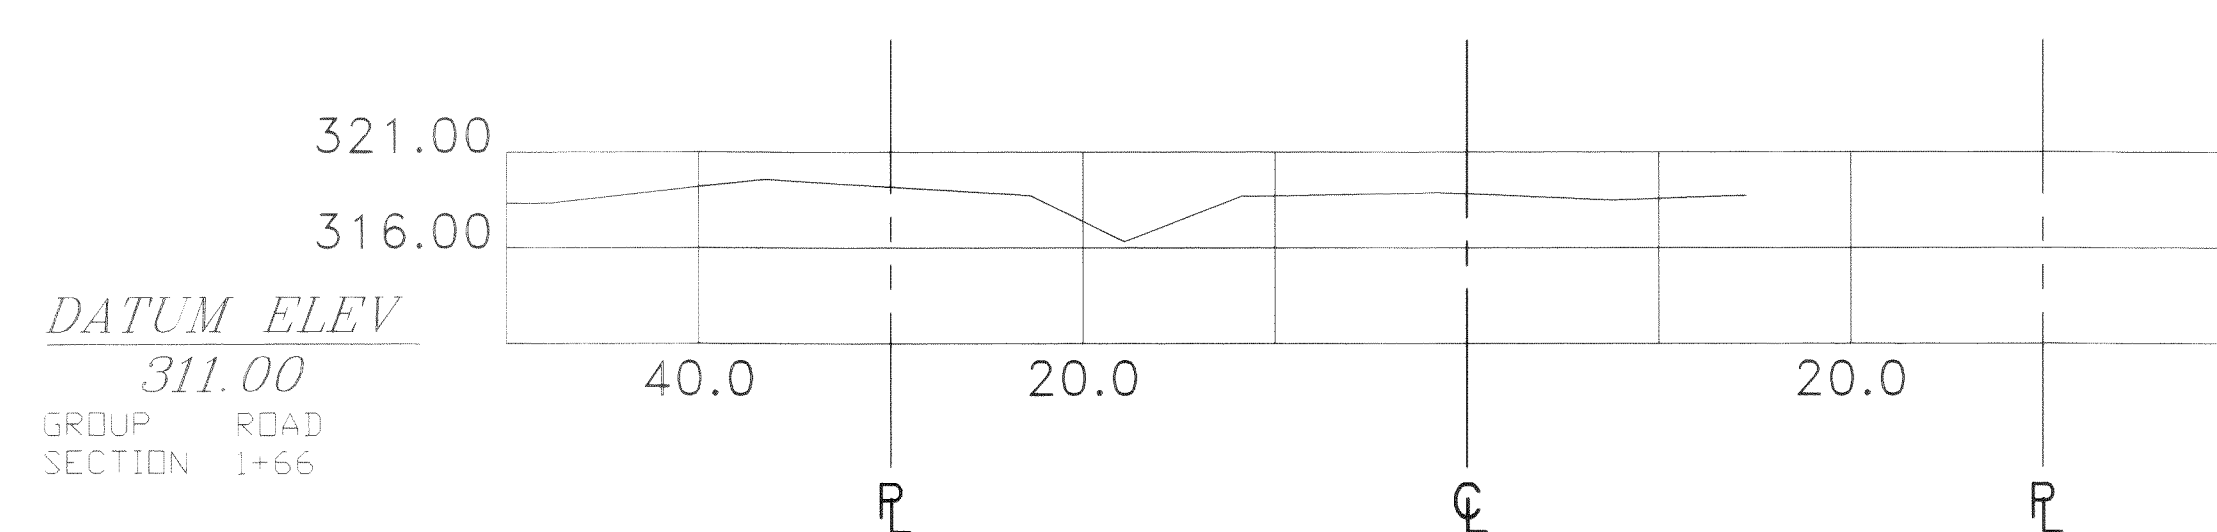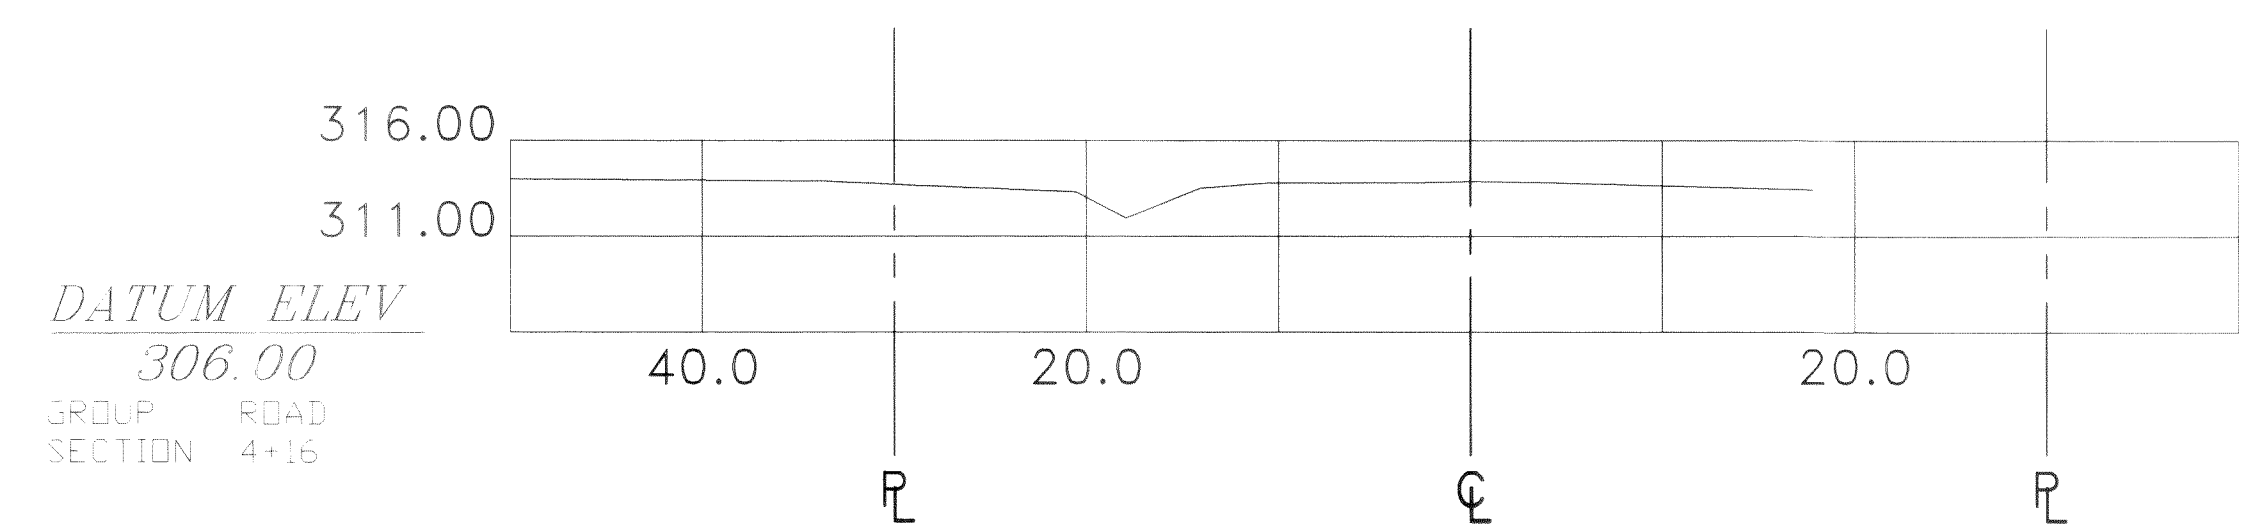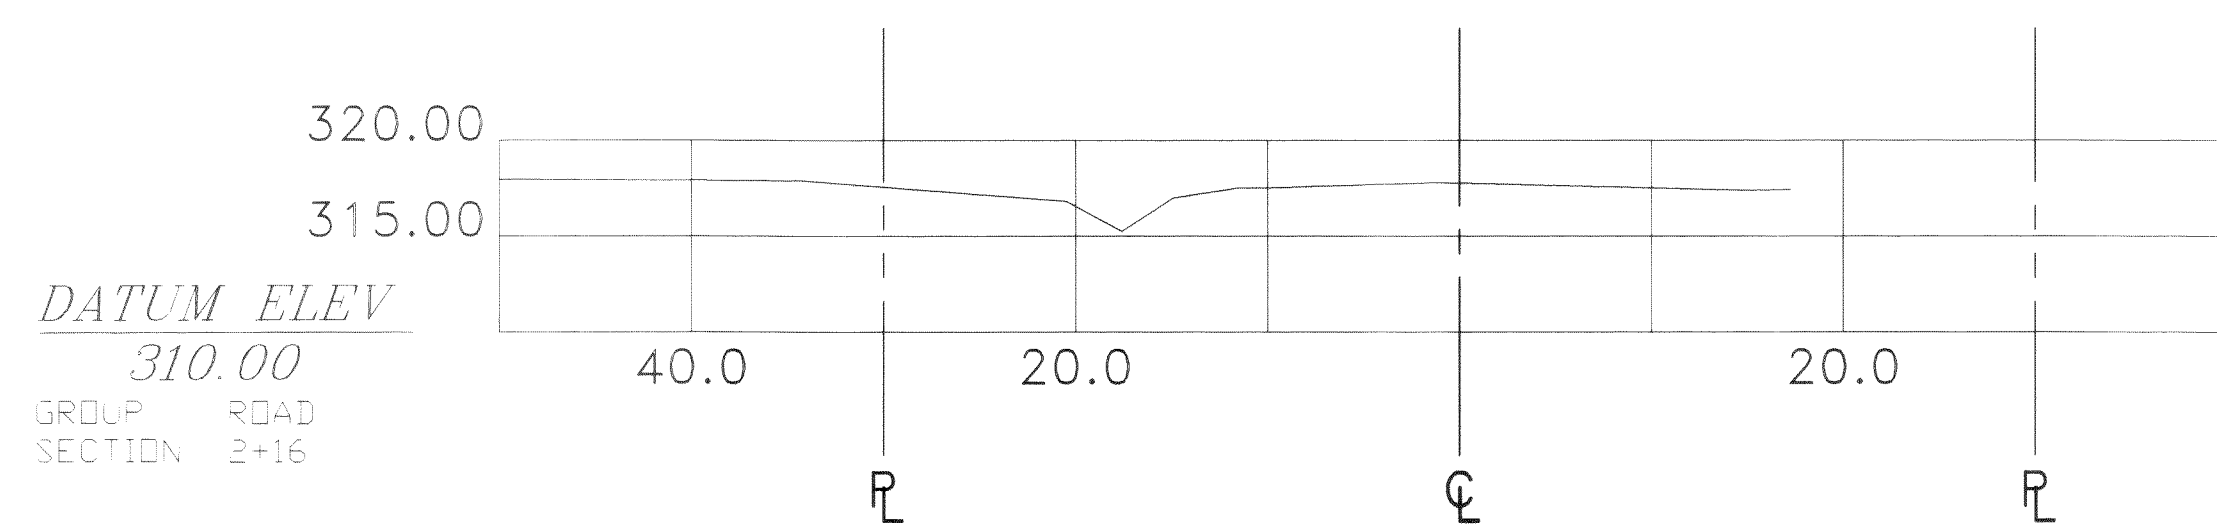

APPROVED
APR 24 2000
BY *Steven Sperry*
CITY OF FERDALE

RECORD DRAWING

REVISIONS:		DRAWN BY	DATE	CHECKED BY	DATE	SEAL	ASSOCIATED PROJECT CONSULTANTS, INC., P.S. PROFESSIONAL CONSULTING ENGINEERS 1401 ASTOR STREET BELLINGHAM, WASHINGTON 98225 (360) 671-1146		HORIZONTAL SCALE:	1"=10'	CLIENT:	WHATCOM COUNTY FIRE DISTRICT NO. 7	JOB NO.:	97-119
1	REVISED PER CITY OF FERDALE REQUESTS	BDS	6/11/98			VERTICAL SCALE:			DRAWN BY:	BDS	PROJECT:	CHURCH AND THORNTON IMPEOVEMENTS	SHEET:	6
2	RECORD DRAWING PER CITY OF FERDALE REQUESTS	BDS	12/10/98			DATE:			APPROVED BY:		TITLE:	CHURCH ROAD CROSS-SECTIONS	OF:	6
3	REVISED PER CITY OF FERDALE REQUESTS	BDS	12/23/98			NORTH ROTATION:			NA					
4														