


PACIFIC HEIGHTS
PHASE II
CONTRACT DRAWINGS
FOR
ROADWAY AND UTILITIES IMPROVEMENTS
FERNDALE, WASHINGTON
SECTION 13, T 39 N, R 1 E

DRAWING INDEX


SHT.NO.	TITLE
1.	COVER SHEET – VICINITY, NOTES, LEGEND
2.	ROADWAY & DRAINAGE IMPROVEMENTS
3.	SANITARY SEWER & WATER IMPROVEMENTS
4.	DETAILS
5.	DETAILS

EXISTING	PLAN	PROPOSED
	CATCH BASIN	
	CULVERT INVERT	
	DETAIL NUMBER SHEET FOUND	
	WATER LINE	
	STRAW BALE DAM	
	GATE VALVE	
	HYDRANT	
	THRUST BLOCK	
	CURB CUT	
	EASEMENT	
	LIGHTING	
	LIGHTING TRENCH	
	ELECTRICAL & UTILITIES TRENCH	
	PROFILE EXISTING GROUND	
	FINISHED GRADE	
	MANHOLE / SANITARY SEWER	
	CATCH BASIN / STORM PIPE	
	EXISTING PIPING	

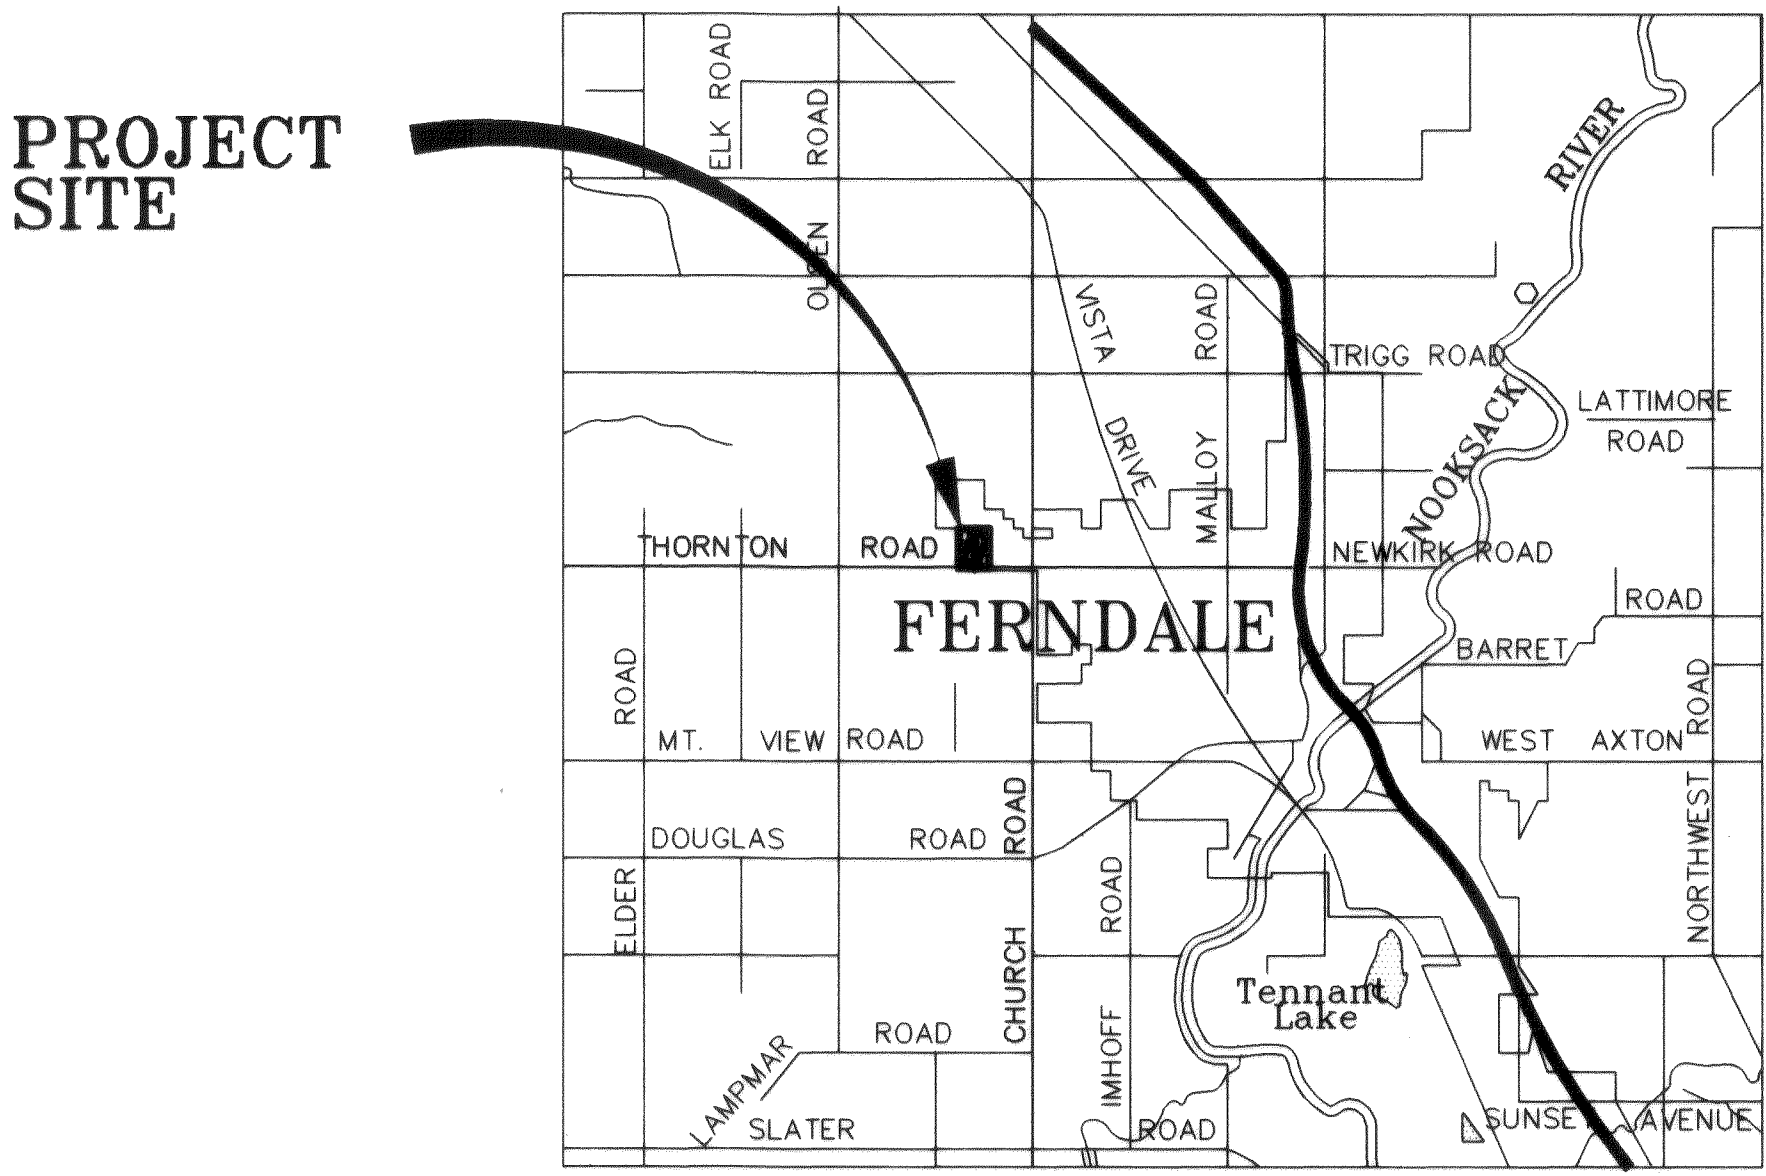

- GENERAL NOTES
1. THE LOCATION OF EXISTING UTILITIES SHOWN IS APPROXIMATE. IT IS THE RESPONSIBILITY OF THE CONTRACTOR TO FIELD VERIFY THESE LOCATIONS PRIOR TO CONSTRUCTION.
 2. ALL WORK SHALL CONFORM TO THE STANDARD PLANS AND SPECIFICATIONS OF THE WASHINGTON STATE DEPARTMENT OF TRANSPORTATION (WSDOT), 1995, AND CITY OF FERNDALE STANDARDS UNLESS INDICATED OTHERWISE BY THE CONTRACT DOCUMENTS. IN CASE OF A CONFLICT BETWEEN THE REGULATORY STANDARDS OR SPECIFICATIONS, THE MORE STRINGENT REQUIREMENT WILL PREVAIL.
 3. UNDERGROUND UTILITIES ARE KNOWN TO EXIST IN THE AREA OF CONSTRUCTION. IT IS THE RESPONSIBILITY OF THE CONTRACTOR TO CONTACT THE UTILITY OWNERS FOR LOCATIONS AND TO NOTIFY THE ENGINEER PROMPTLY OF ANY CONFLICT.
 4. THE CONTRACTOR SHALL BE RESPONSIBLE FOR MAINTAINING THE INTEGRITY OF ADJACENT UTILITIES WHICH INCLUDE, BUT ARE NOT LIMITED TO, WATER, SEWER, STORM SEWER, POWER, TELEPHONE, CABLE, T.V., IRRIGATION, AND STREET LIGHTING.
 5. THE CONTRACTOR SHALL BE RESPONSIBLE FOR MAINTAINING ALL EROSION CONTROL MEASURES THROUGHOUT THE DURATION OF THE PROJECT.

WARNING!
UTILITIES IN AREA
CALL UTILITY LOCATORS
PRIOR TO ANY EXCAVATION.

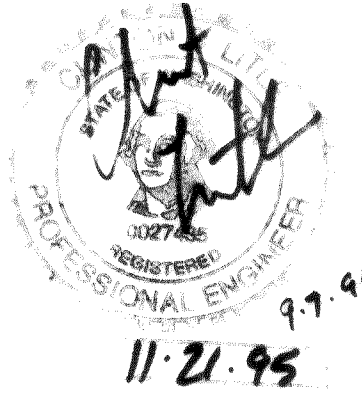

RECORD DRAWING

C:\DWG\5034RD1A 09/07/95 08:16

1	XX	XXX	XXX
---	----	-----	-----



1911 "C" STREET
BELLINGHAM, WA 98225
PHONE: (360) 671-8200
COUNTY: (360) 354-3723
FAX: (360) 738-9387
Ayers Professional Group, Inc.

DESIGNED BY	DATE
DRAWN BY	DATE
CHECKED BY	DATE

PACIFIC HEIGHTS
PHASE II
TITLE, VICINITY MAP, LEGEND, NOTES, AND SHEET INDEX


DATE	SHEET
04/18/95	1
SCALE:	OF
AS NOTED	5
JOB NO.	
95034	




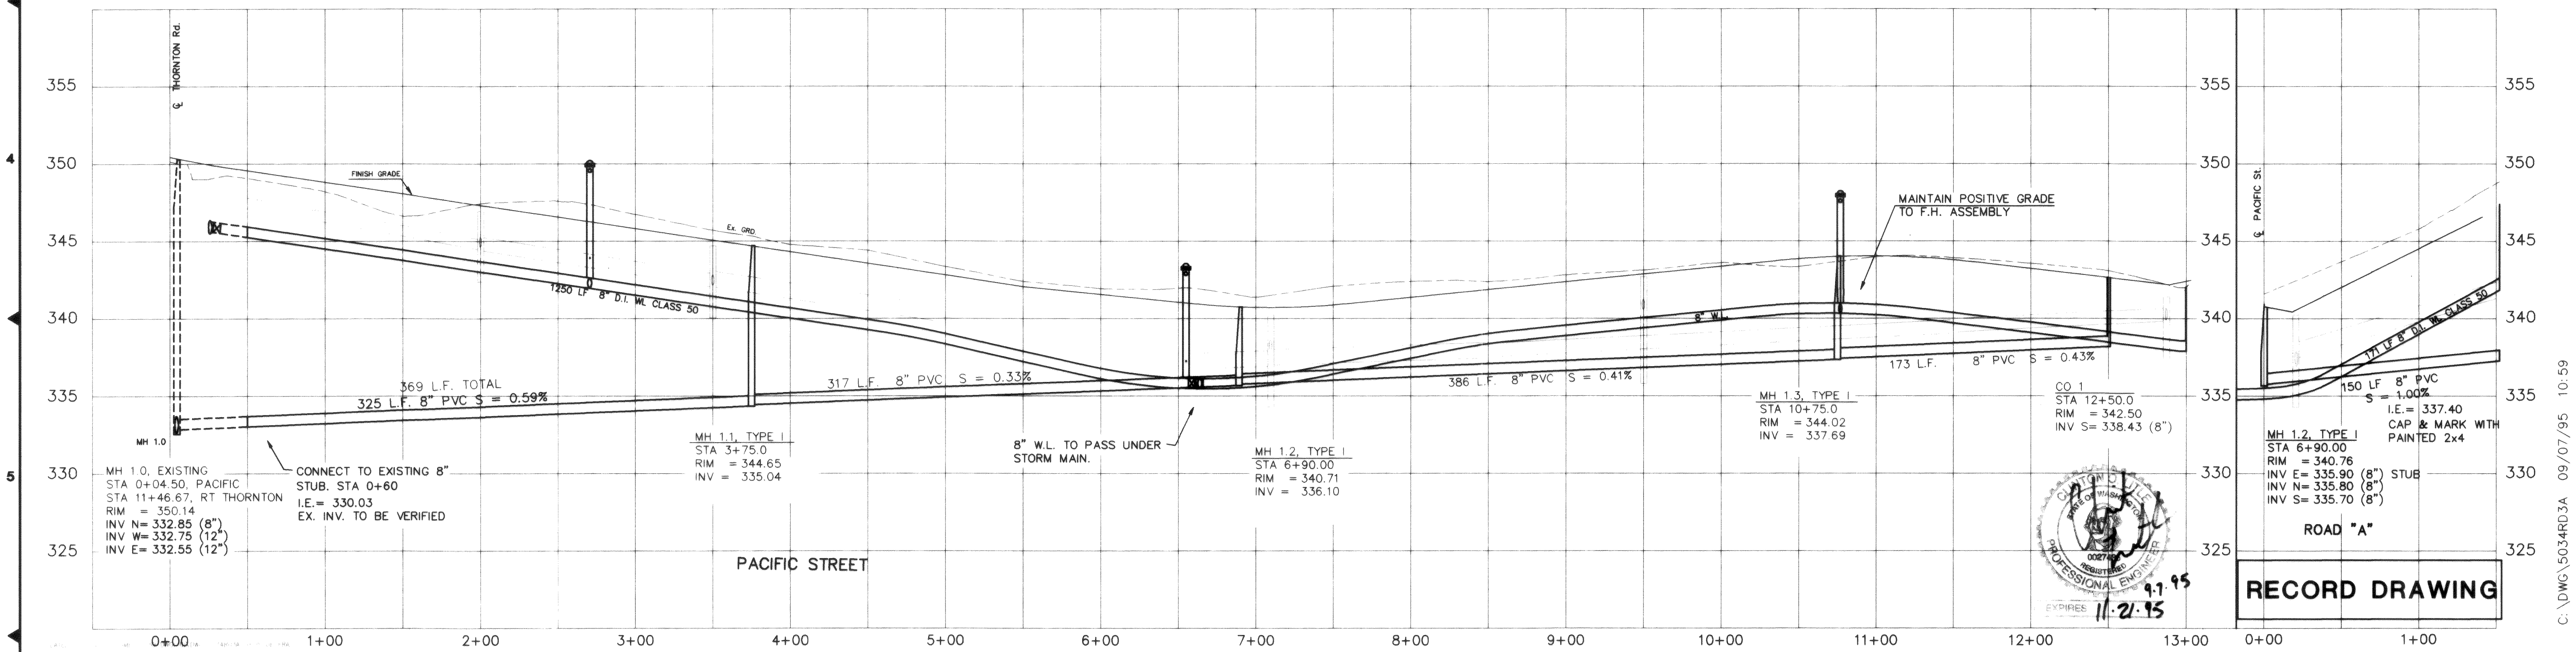
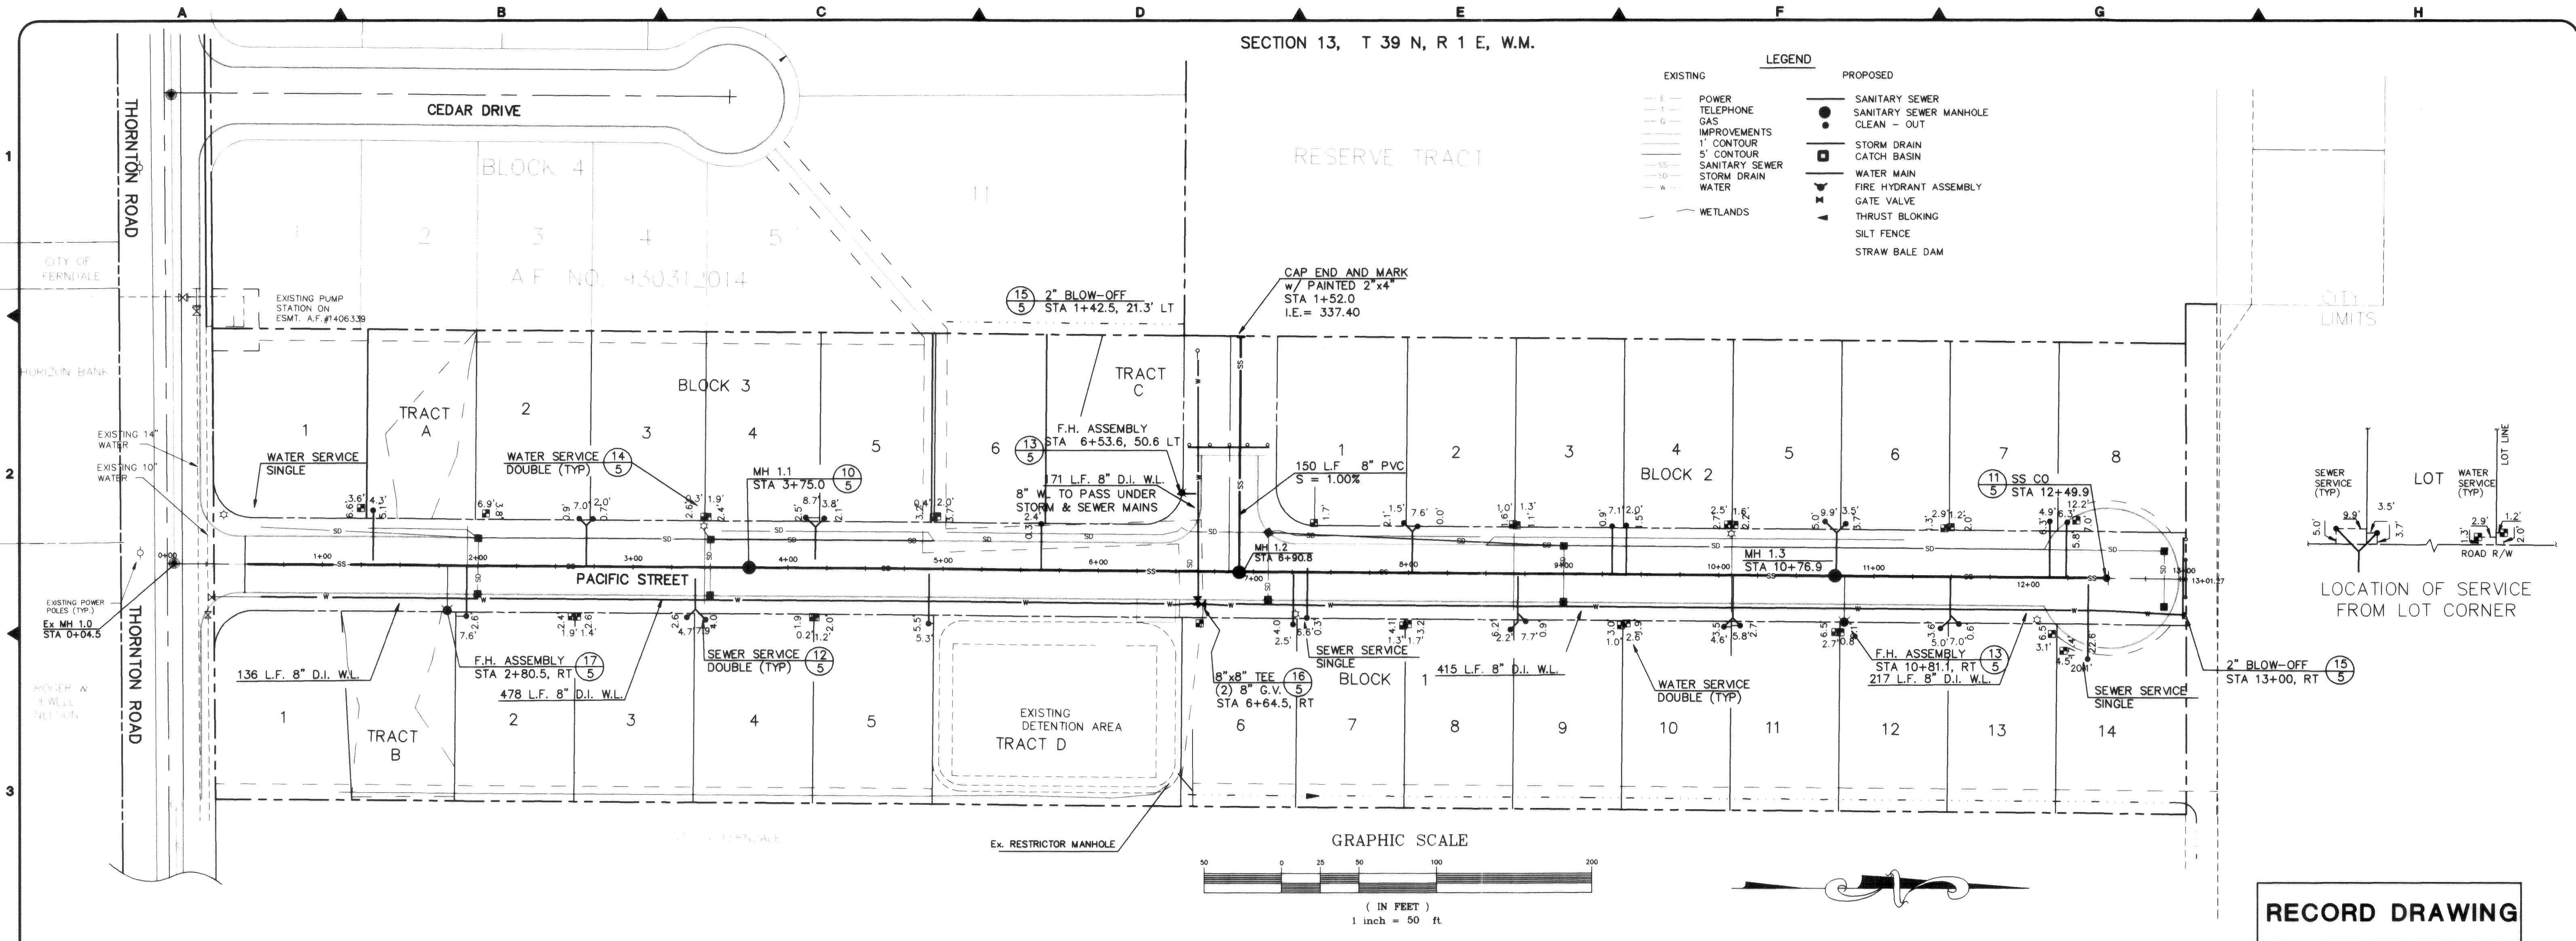


00141.003 2-13-00 KR



C:\DWG\5034RD3A 09/07/95 10:59

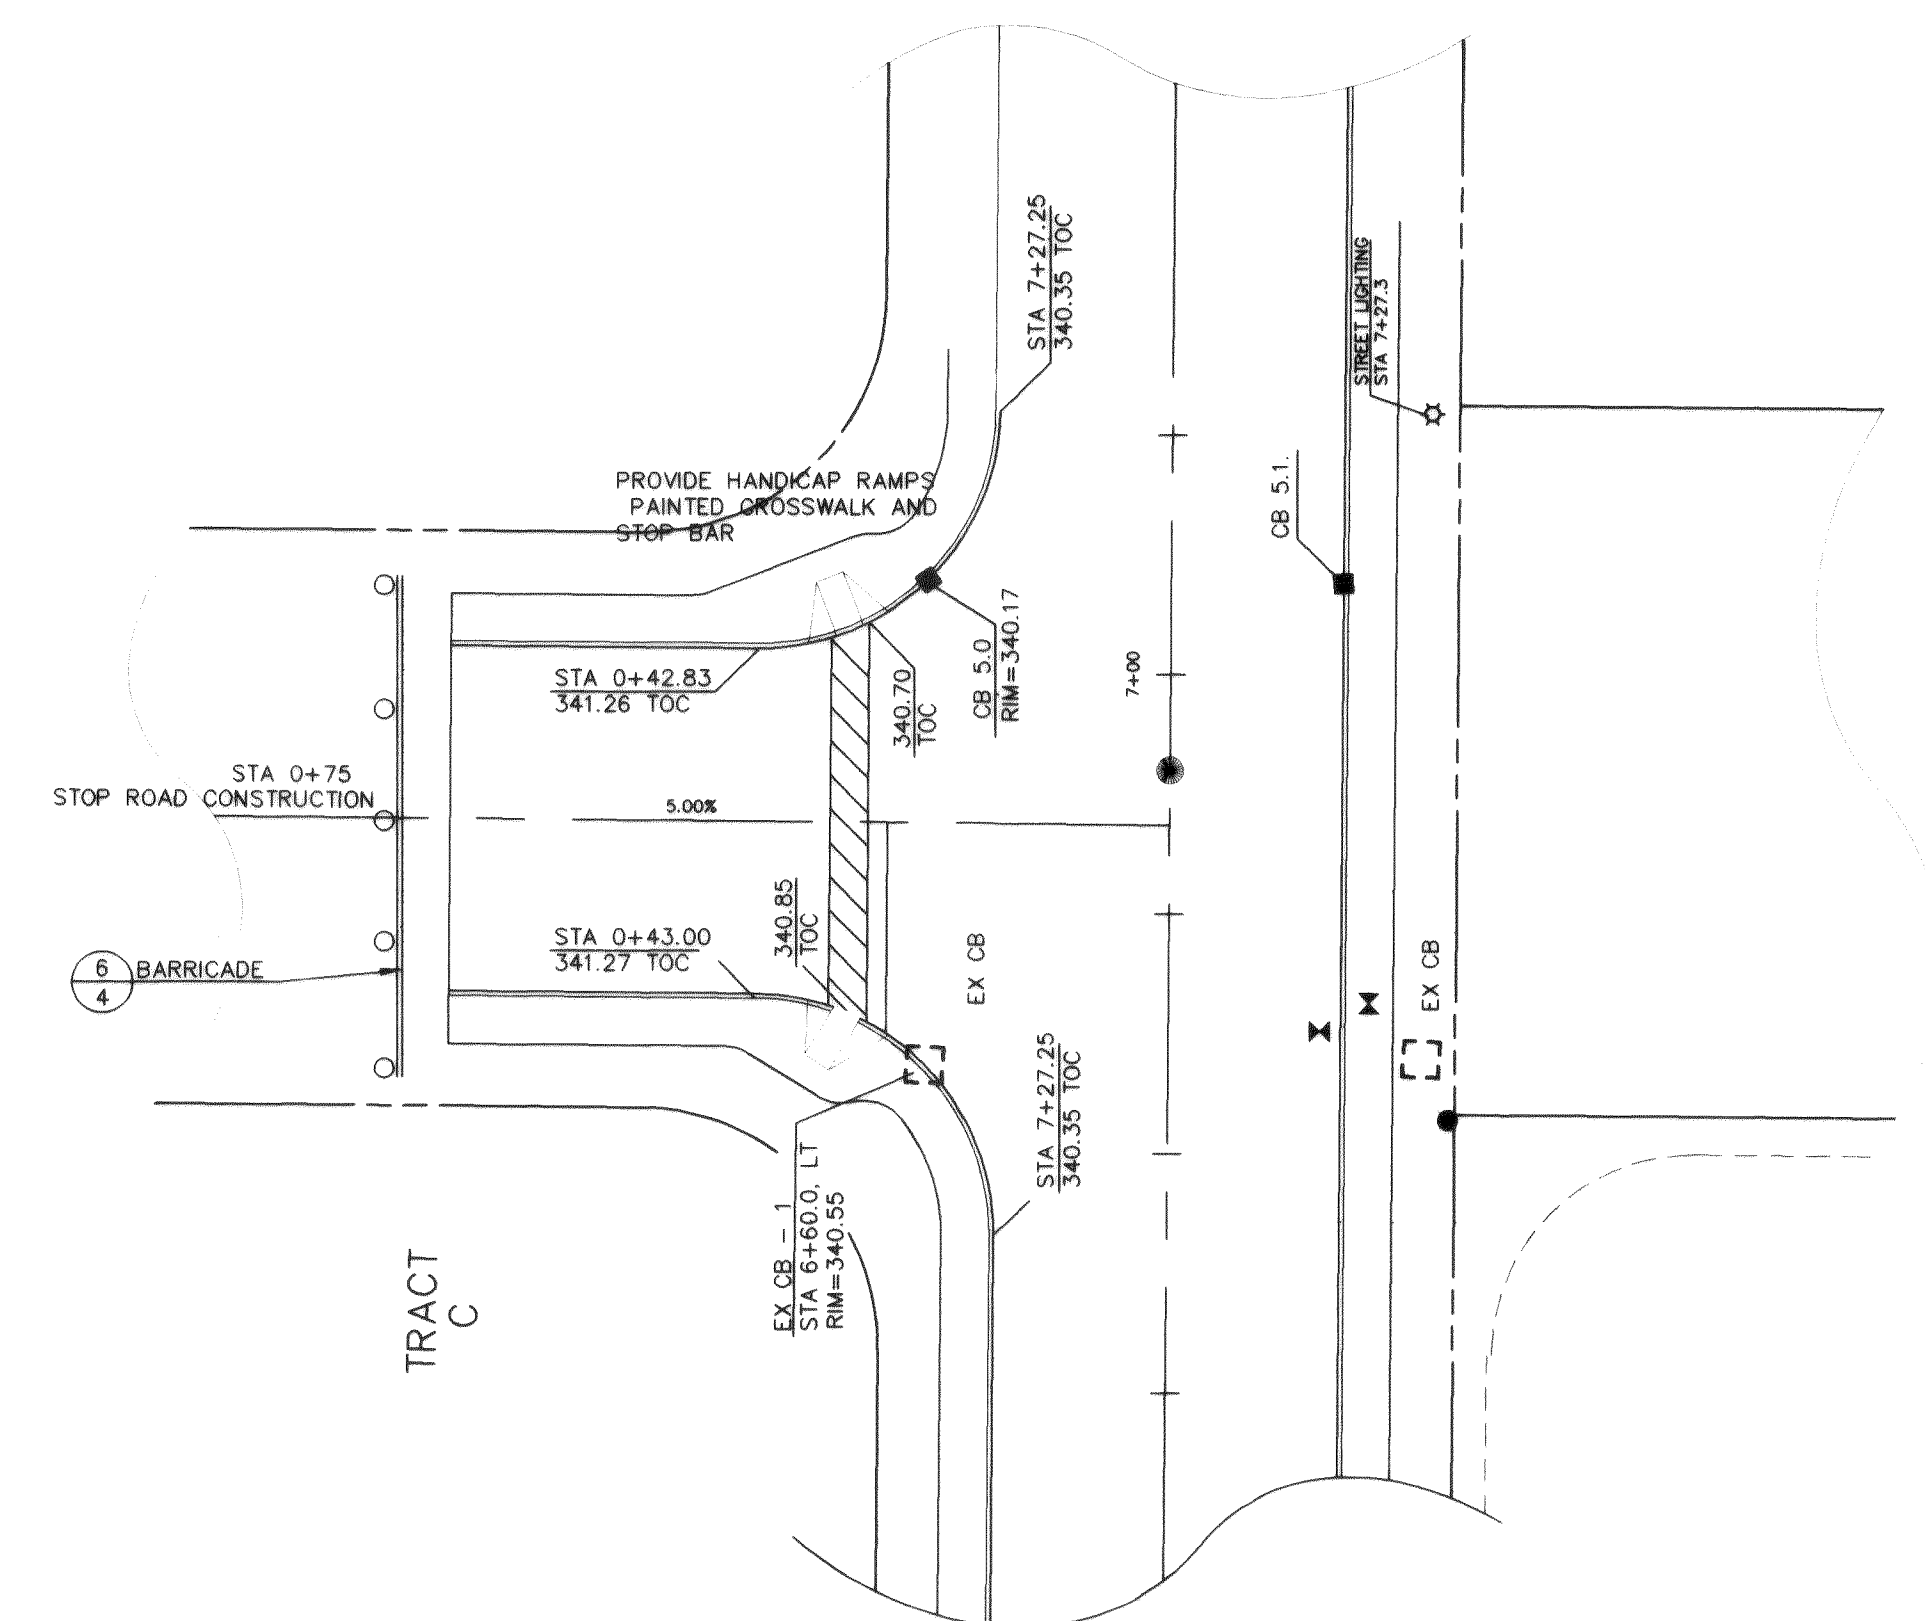


ROAD INTERSECTION -
PACIFIC STREET AND FUTURE ROAD

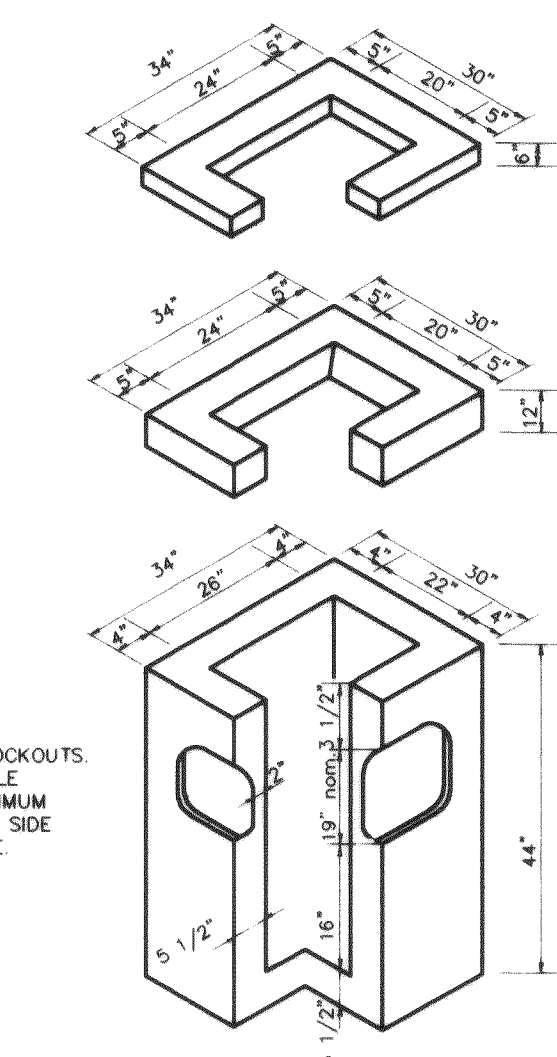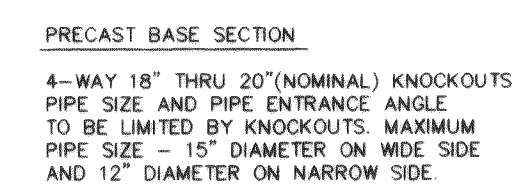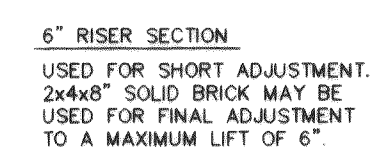


CATCH BASIN TYPE 1

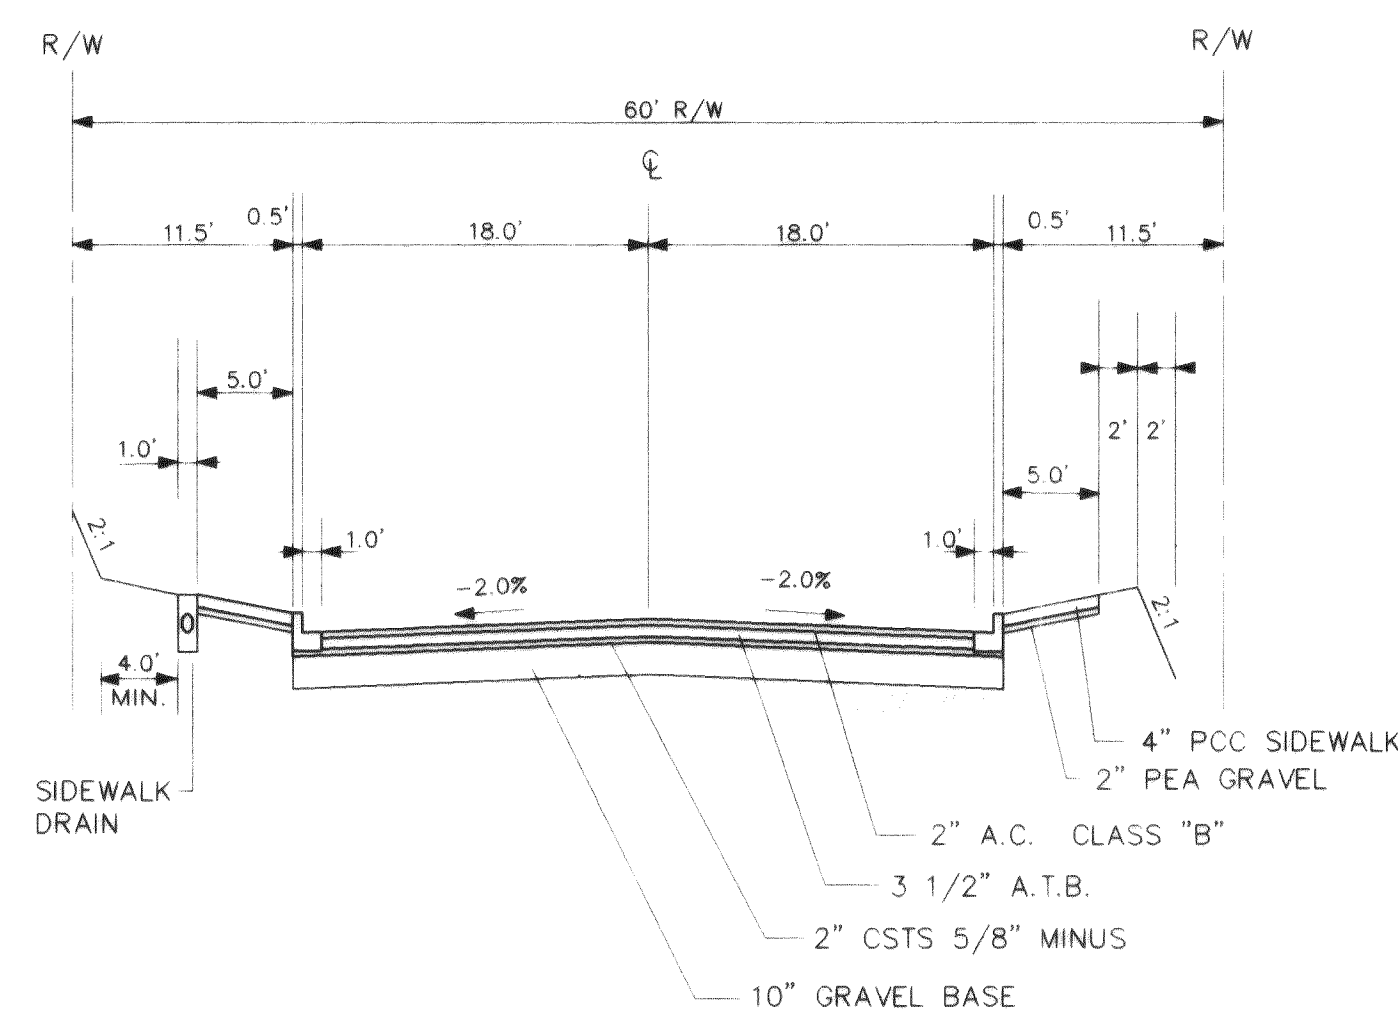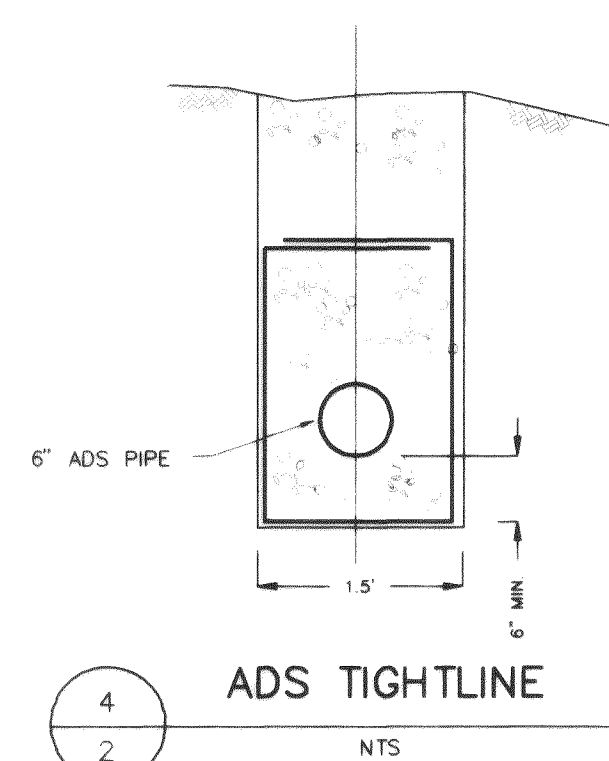


STANDARD ROADWAY SECTION
N.T.S.

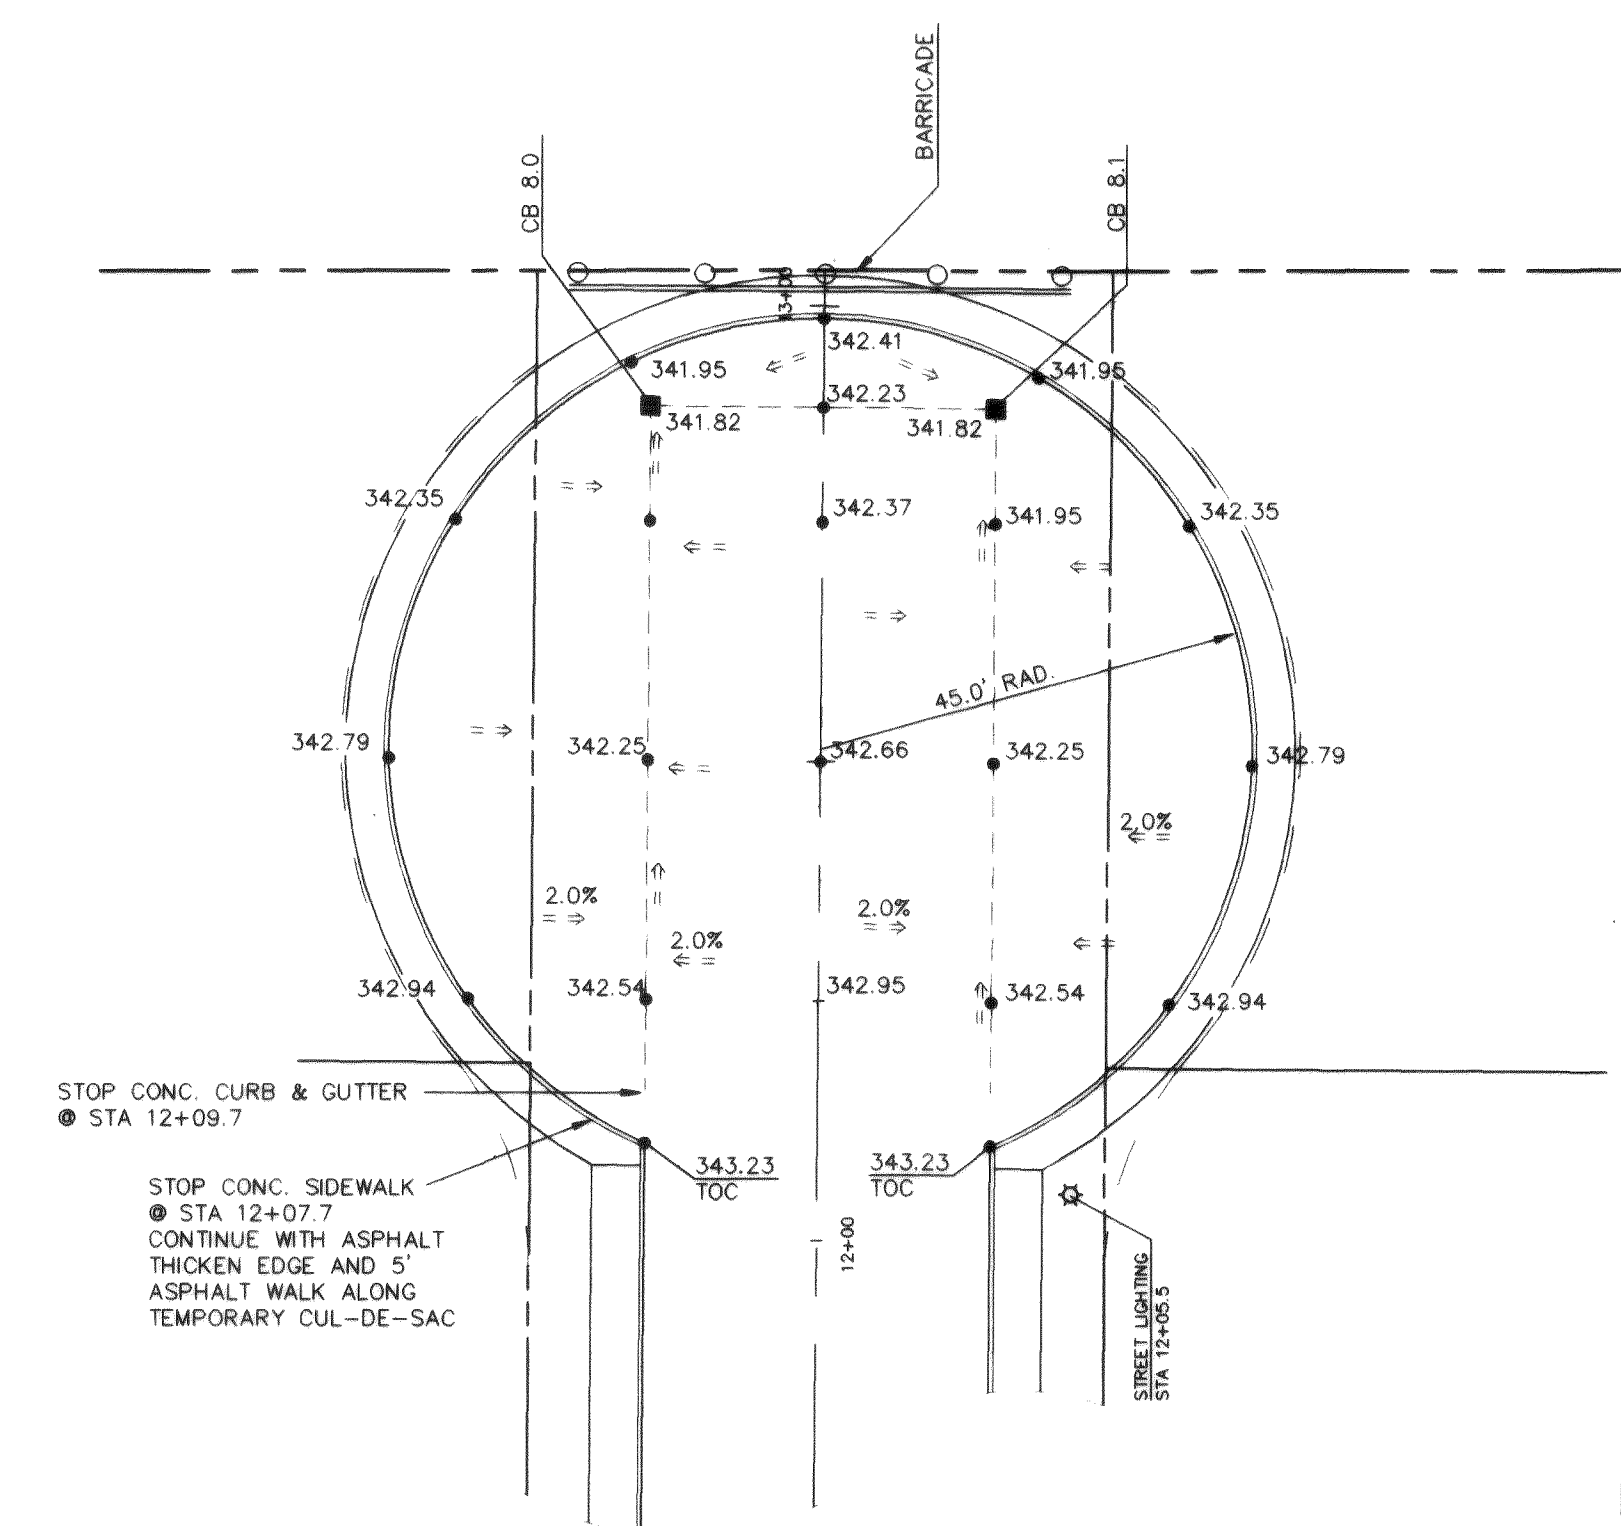


TEMPORARY CUL-DE-SAC
PACIFIC STREET

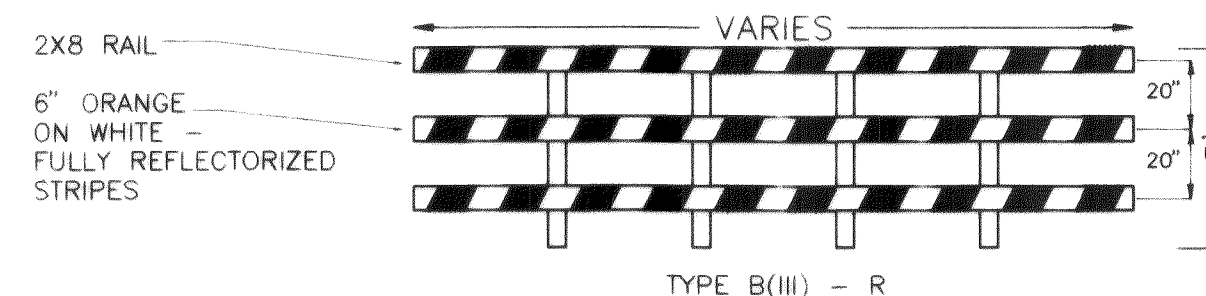

BARRICADE DETAIL

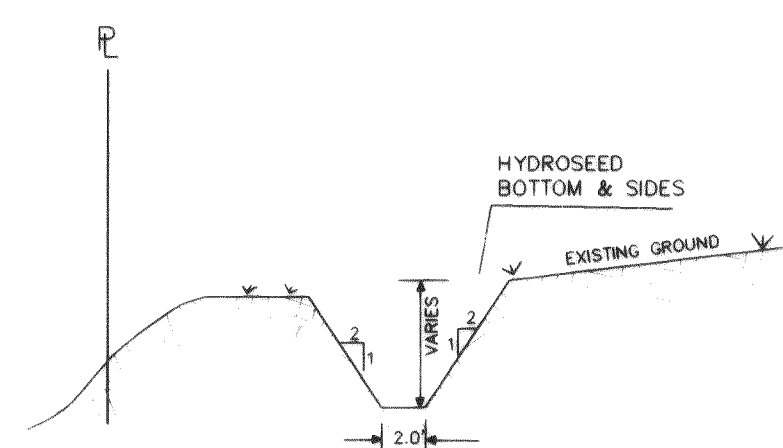

STANDARD DITCH SECTION

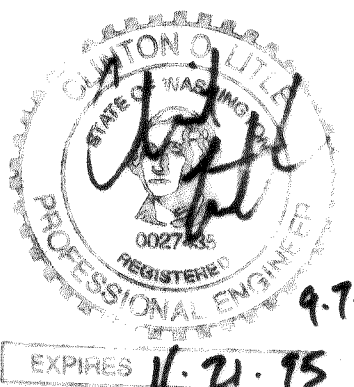

RECORD DRAWING

C:\DWG\5034RD4A 09/07/95 11:09

DATE	SHEET
04/18/95	4
SCALE	OF
AS NOTED	5
JOB NO.	
95034	




PACIFIC HEIGHTS PHASE II STORM, ROADWAY, & EROSION DETAILS



1911 "C" STREET
BELLINGHAM, WA 98225
PHONE: (360) 671-8200
COUNTY: (360) 354-3723
FAX: (360) 738-9367

Ayers Professional Group, Inc.

DESIGNED BY		DATE
DRAWN BY		DATE
CHECKED BY		DATE

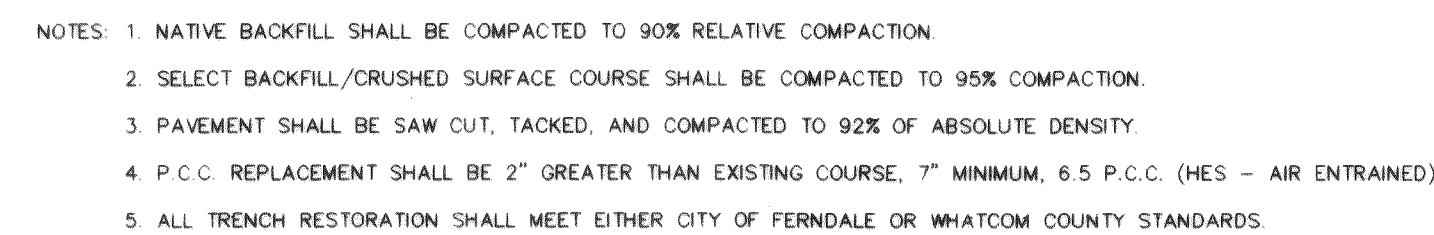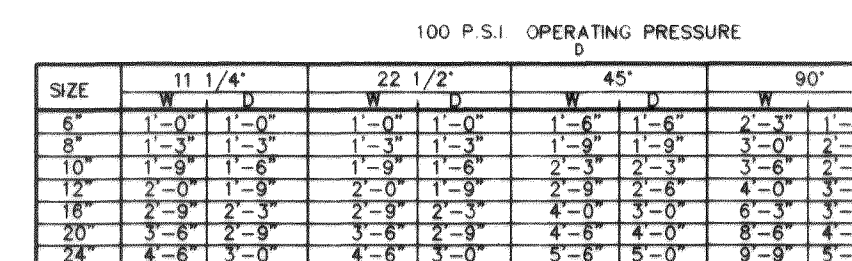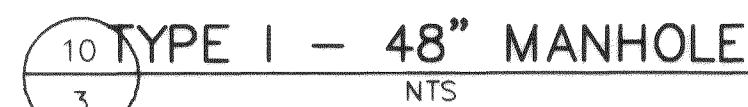

DATE	SHEET
04/18/95	5
SCALE:	OF
AS NOTED	5
JOB NO.	
95034	