

THORNTON ROAD ROADWAY IMPROVEMENTS

CITY OF FERNDALE


LEGEND

	= EXISTING TREE
	= EXISTING GRASSY AREA
	= EXISTING RIP RAP
	= EXISTING GRAVEL SHOULDER
	= EXISTING CULVERT
	= EXISTING WATER METER
	= EXISTING POWER VAULT
	= EXISTING CATCH BASIN
	= EXISTING SEWER MANHOLE
	= EXISTING POWER POLE
	= EXISTING GUY WIRE
	= EXISTING TELEPHONE VAULT
	= EXISTING WATER VALVE
	= EXISTING WATER VALVE
	= EXISTING STOM DRAINAGE
	= EXISTING SANITARY SEWER
	= EXISTING GAS LINE
	= EXISTING PROPERTY BOUNDARY
	= EXISTING RIGHT-OF-WAY (ROW)
	= EXISTING ROAD CENTERLINE
	= EXISTING EDGE OF PAVEMENT (EOP)
	= PROPOSED ROAD CENTERLINE
	= PROPOSED STORM LINE
	= PROPOSED STORM CATCH BASIN
	= PROPOSED WATER METER


SHEET INDEX

- 1.) COVER SHEET
- 2.) ROADWAY IMPROVEMENTS
STA 11+50 TO 17+00
- 3.) ROADWAY IMPROVEMENTS
STA 17+00 TO 21+00
- 4.) STORM DRAIN IMPROVEMENTS
CAPTAIN'S WAY
- 5.) DETAIL SHEET

VICINITY MAP

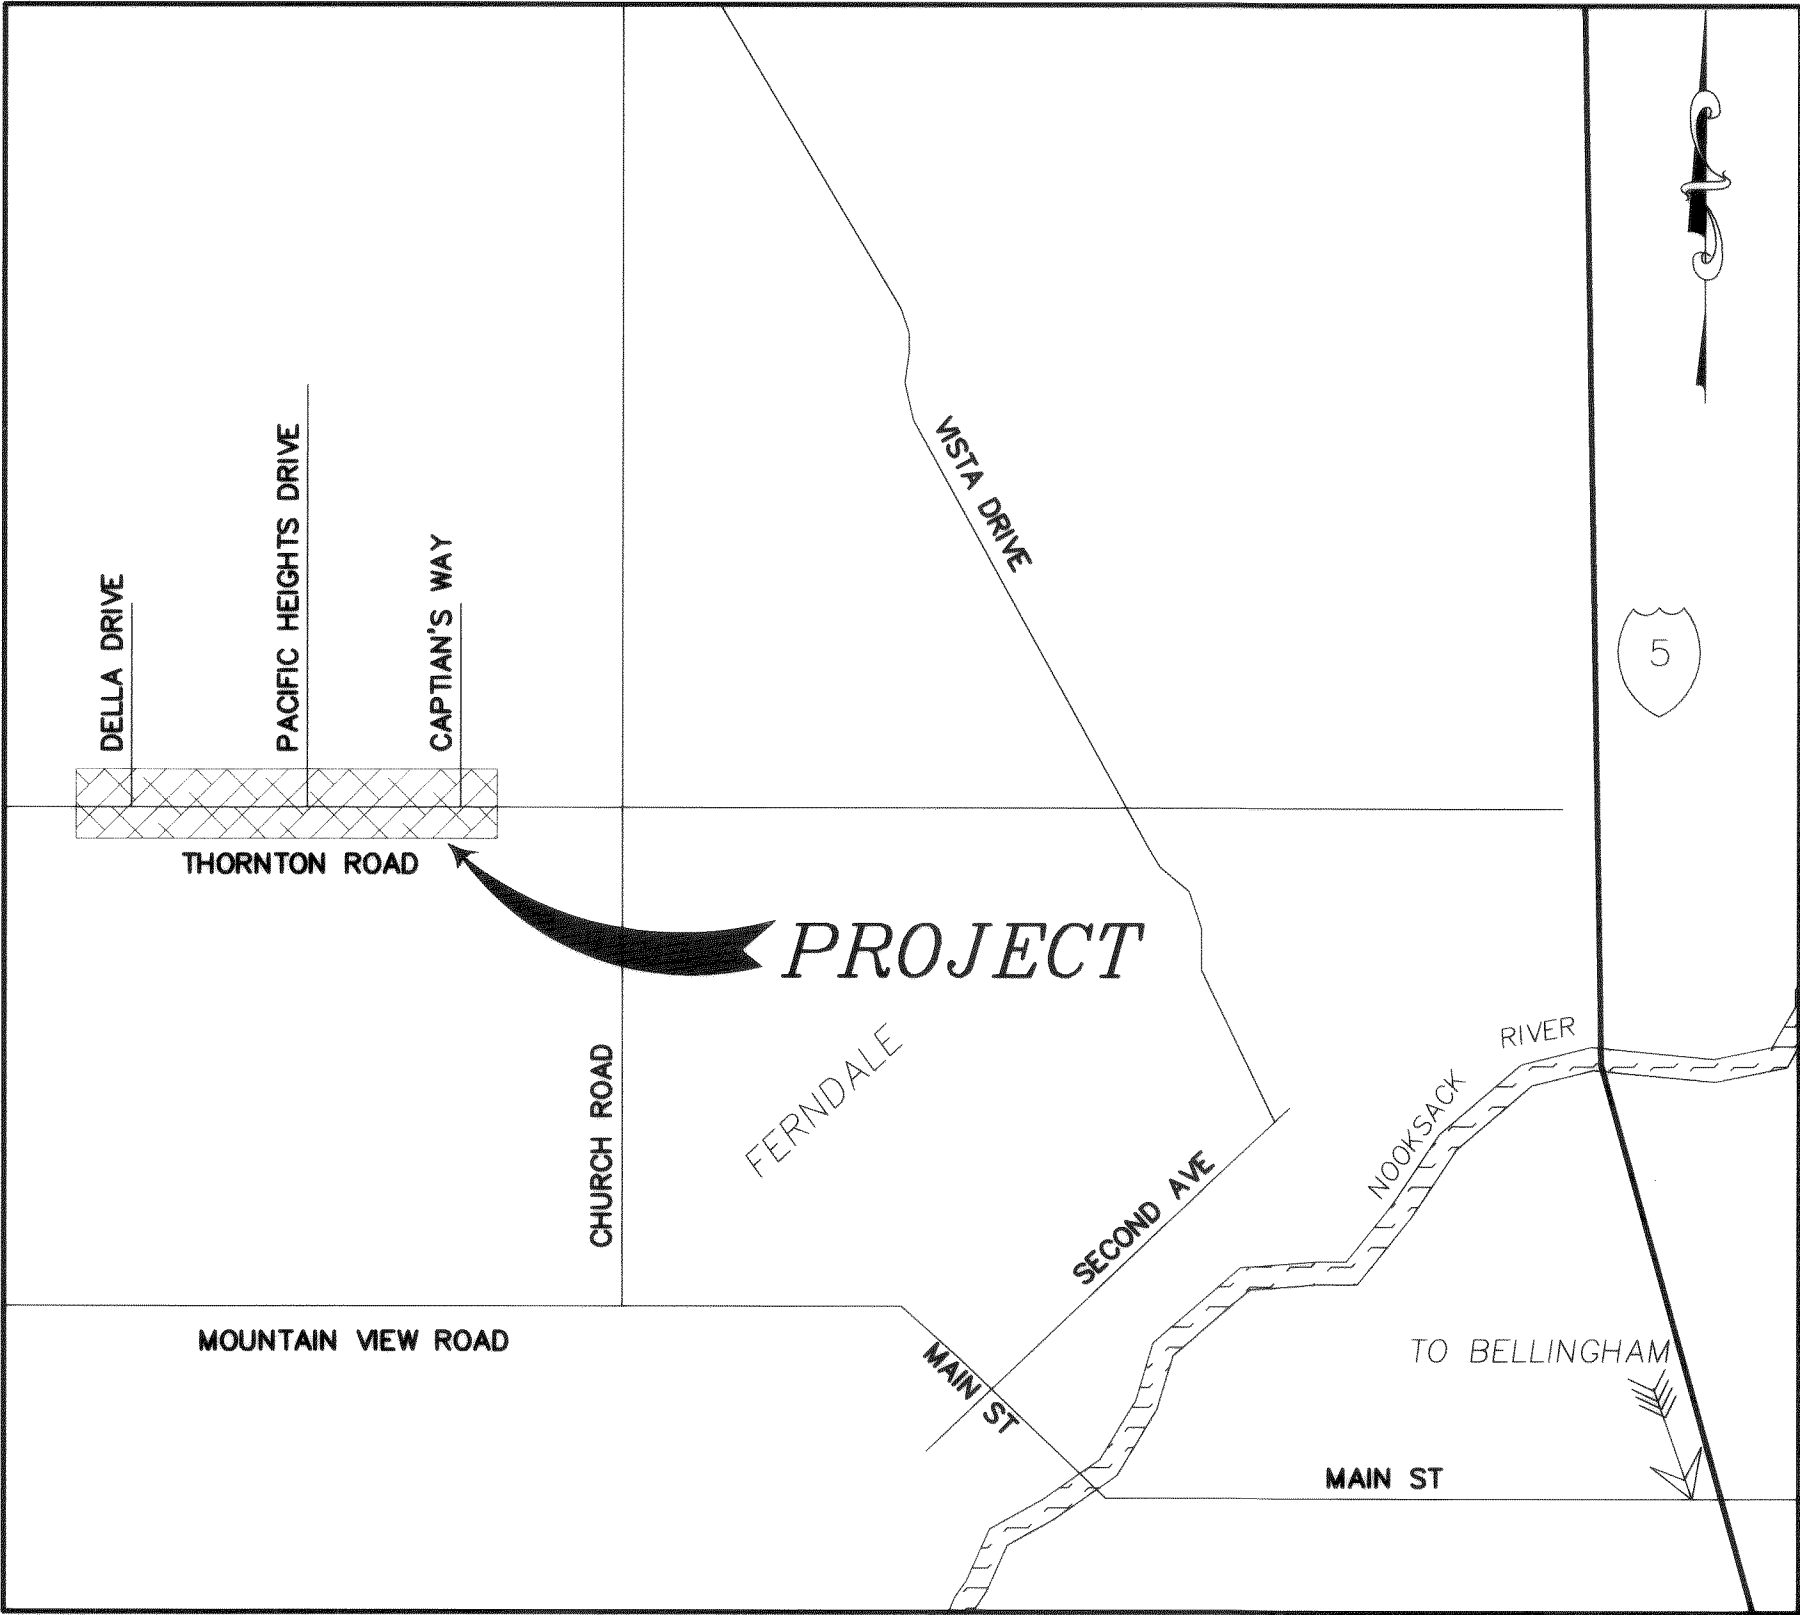


DATE: 8-13-03
AS-BUILT

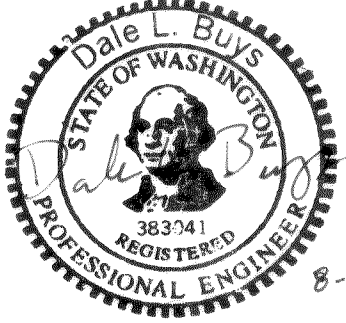



DESIGNED BY DLB	REICHHARDT & EBE ENGINEERING, INC. CONSULTING ENGINEERS PO Box 978 423 Front St., Ste 201 Ph (360) 354-3687 Lynden, Washington 98264 Fax (360) 354-0407	1	4/29/02	Addition of WSHH curb returns	DLB	CITY OF FERNDALE 2095 MAIN STREET FERNDAL, WA 98248	THORNTON ROAD IMPROVEMENTS COVER SHEET FERNDAL, WA FEDERAL-AID NO. AC-6TPE-8044(001)	JOB# / DWG 00009 009SP2AB	DATE 4-29-02
DRAWN BY LMC								SCALE H: N/A V: N/A	SHEET 1 of 5
CHECKED BY GDE		NO.	DATE	REVISION	BY				

00185.001 8-16-06 KR


000096wv00008SP2.AE.dwg, 08/13/2003 01:37:02 PM, HP DesignJet 500, 42, HPGL2, Color, pc3

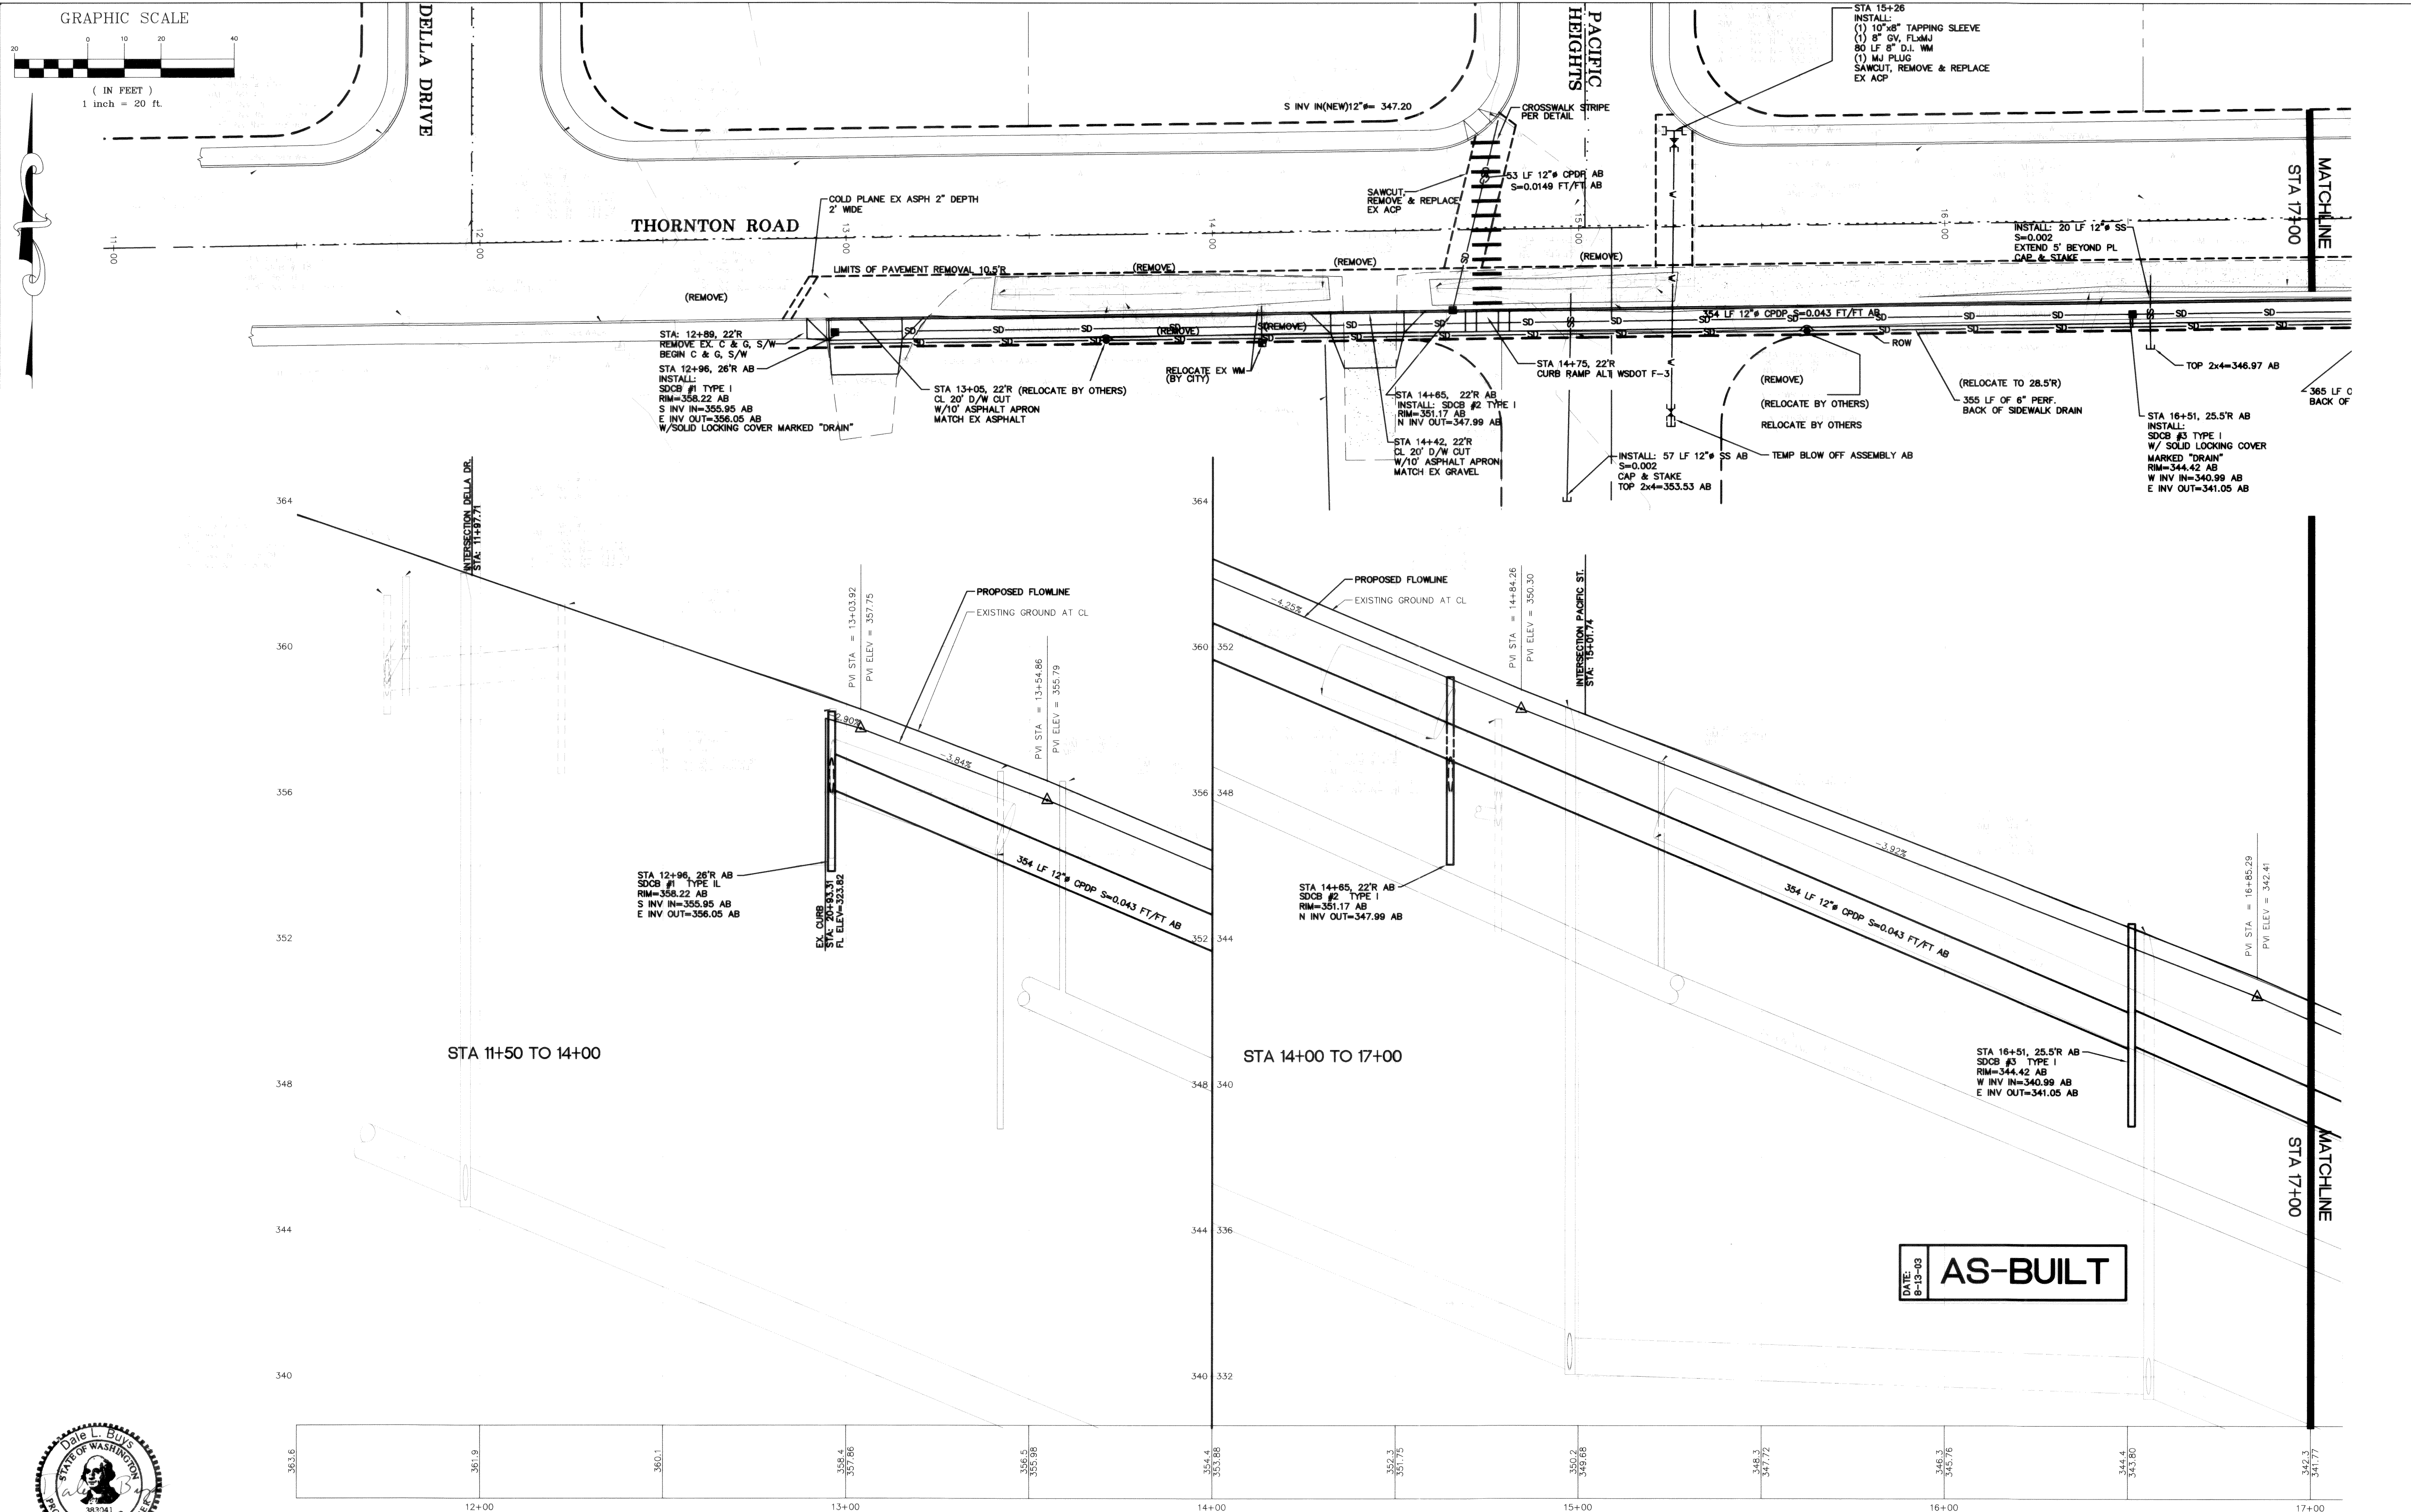



00185.002 2-16-06 KR

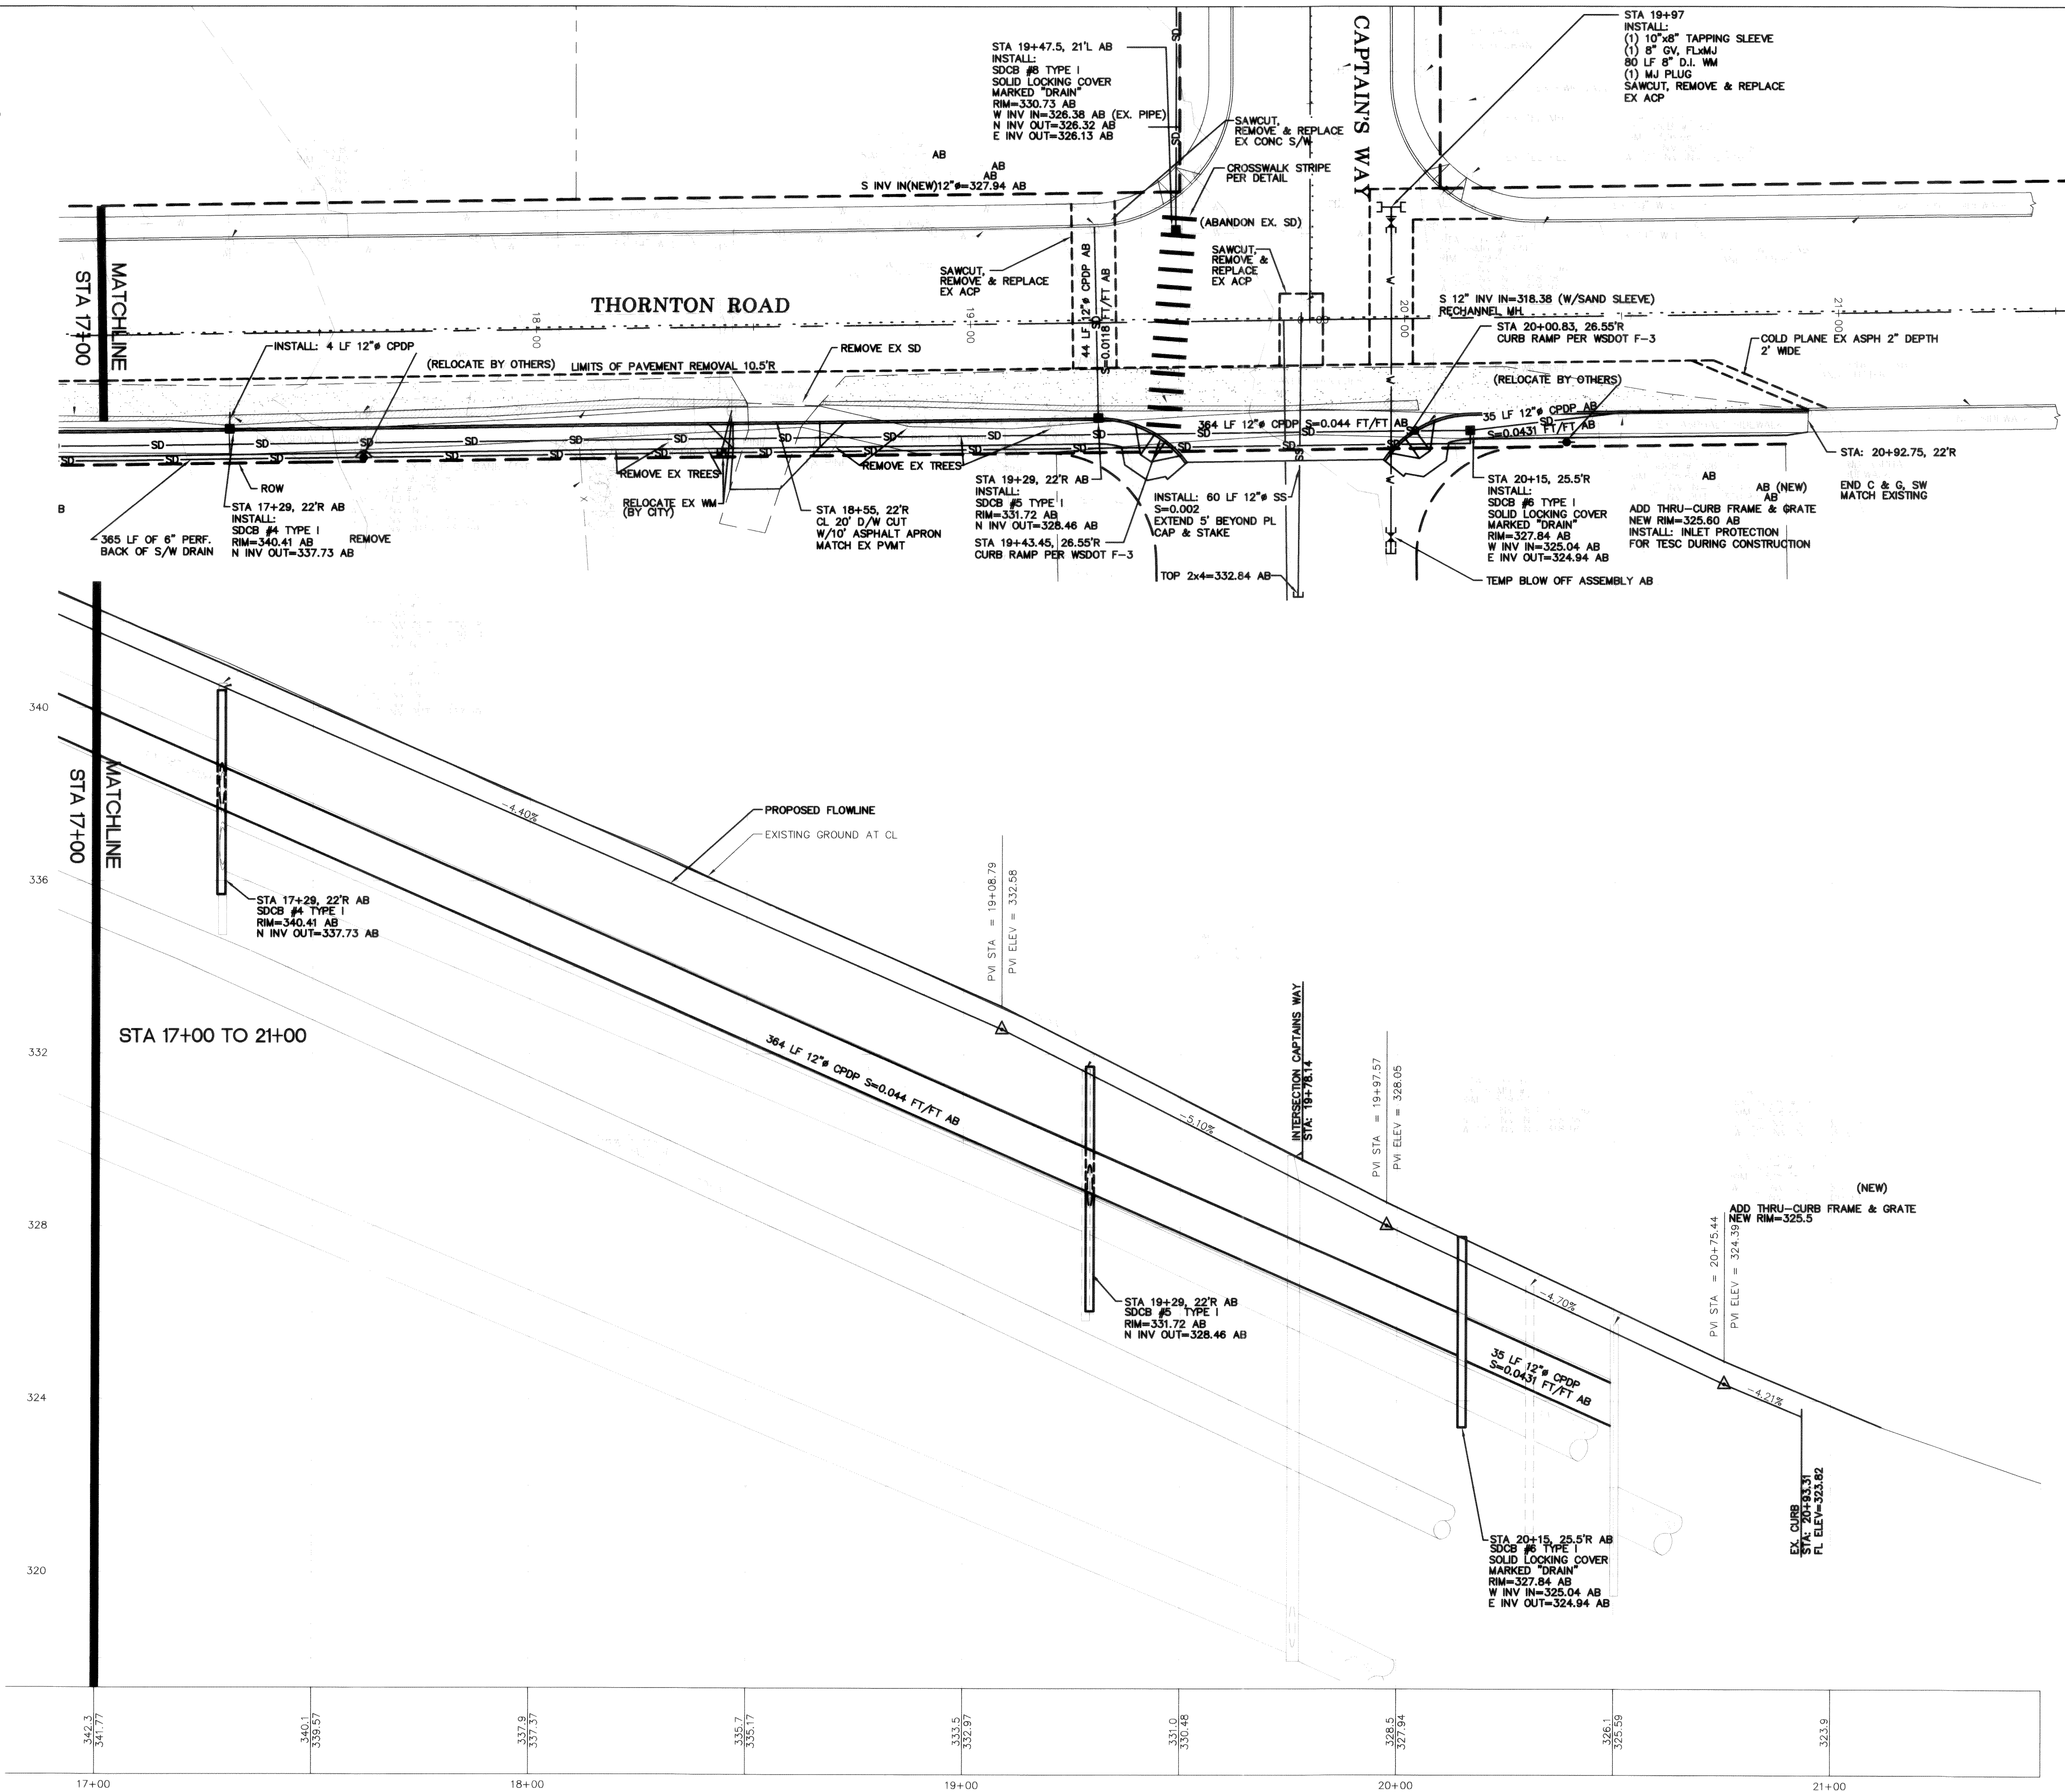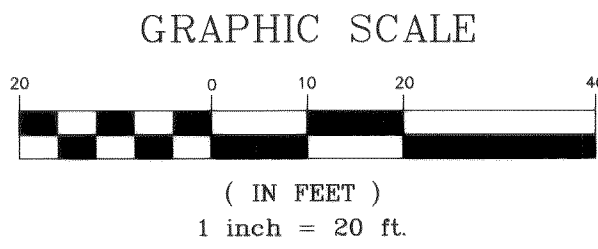

DATE: 8-15-03
AS-BUILT

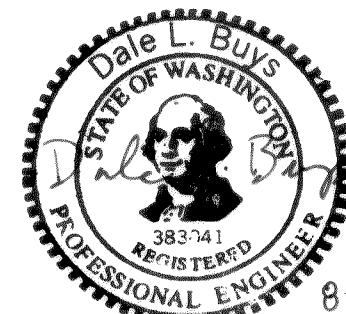


DESIGNED BY DLB	REICHHARDT & EBE ENGINEERING, INC. CONSULTING ENGINEERS PO Box 978 423 Front St., Ste 201 Lynden, Washington 98264 Ph (360) 354-3687 Fax (360) 354-0407	1	4/29/02	Addition of WSH curb returns	DLB	CITY OF FERDALE 2095 MAIN STREET FERDALE, WA 98248	THORNTON ROAD IMPROVEMENTS STA 17+00 TO 21+00 FERDALE, WA FEDERAL-AID NO. AC-SIPE-8044(000)	JOB# / DWG 00009 009SP2 AB	DATE 4-22-02
DRAWN BY LMC/JGS		NO.	DATE	REVISION	BY			SCALE H: 1"=20' V: 1"=2'	SHEET 3 of 5
CHECKED BY GDE									

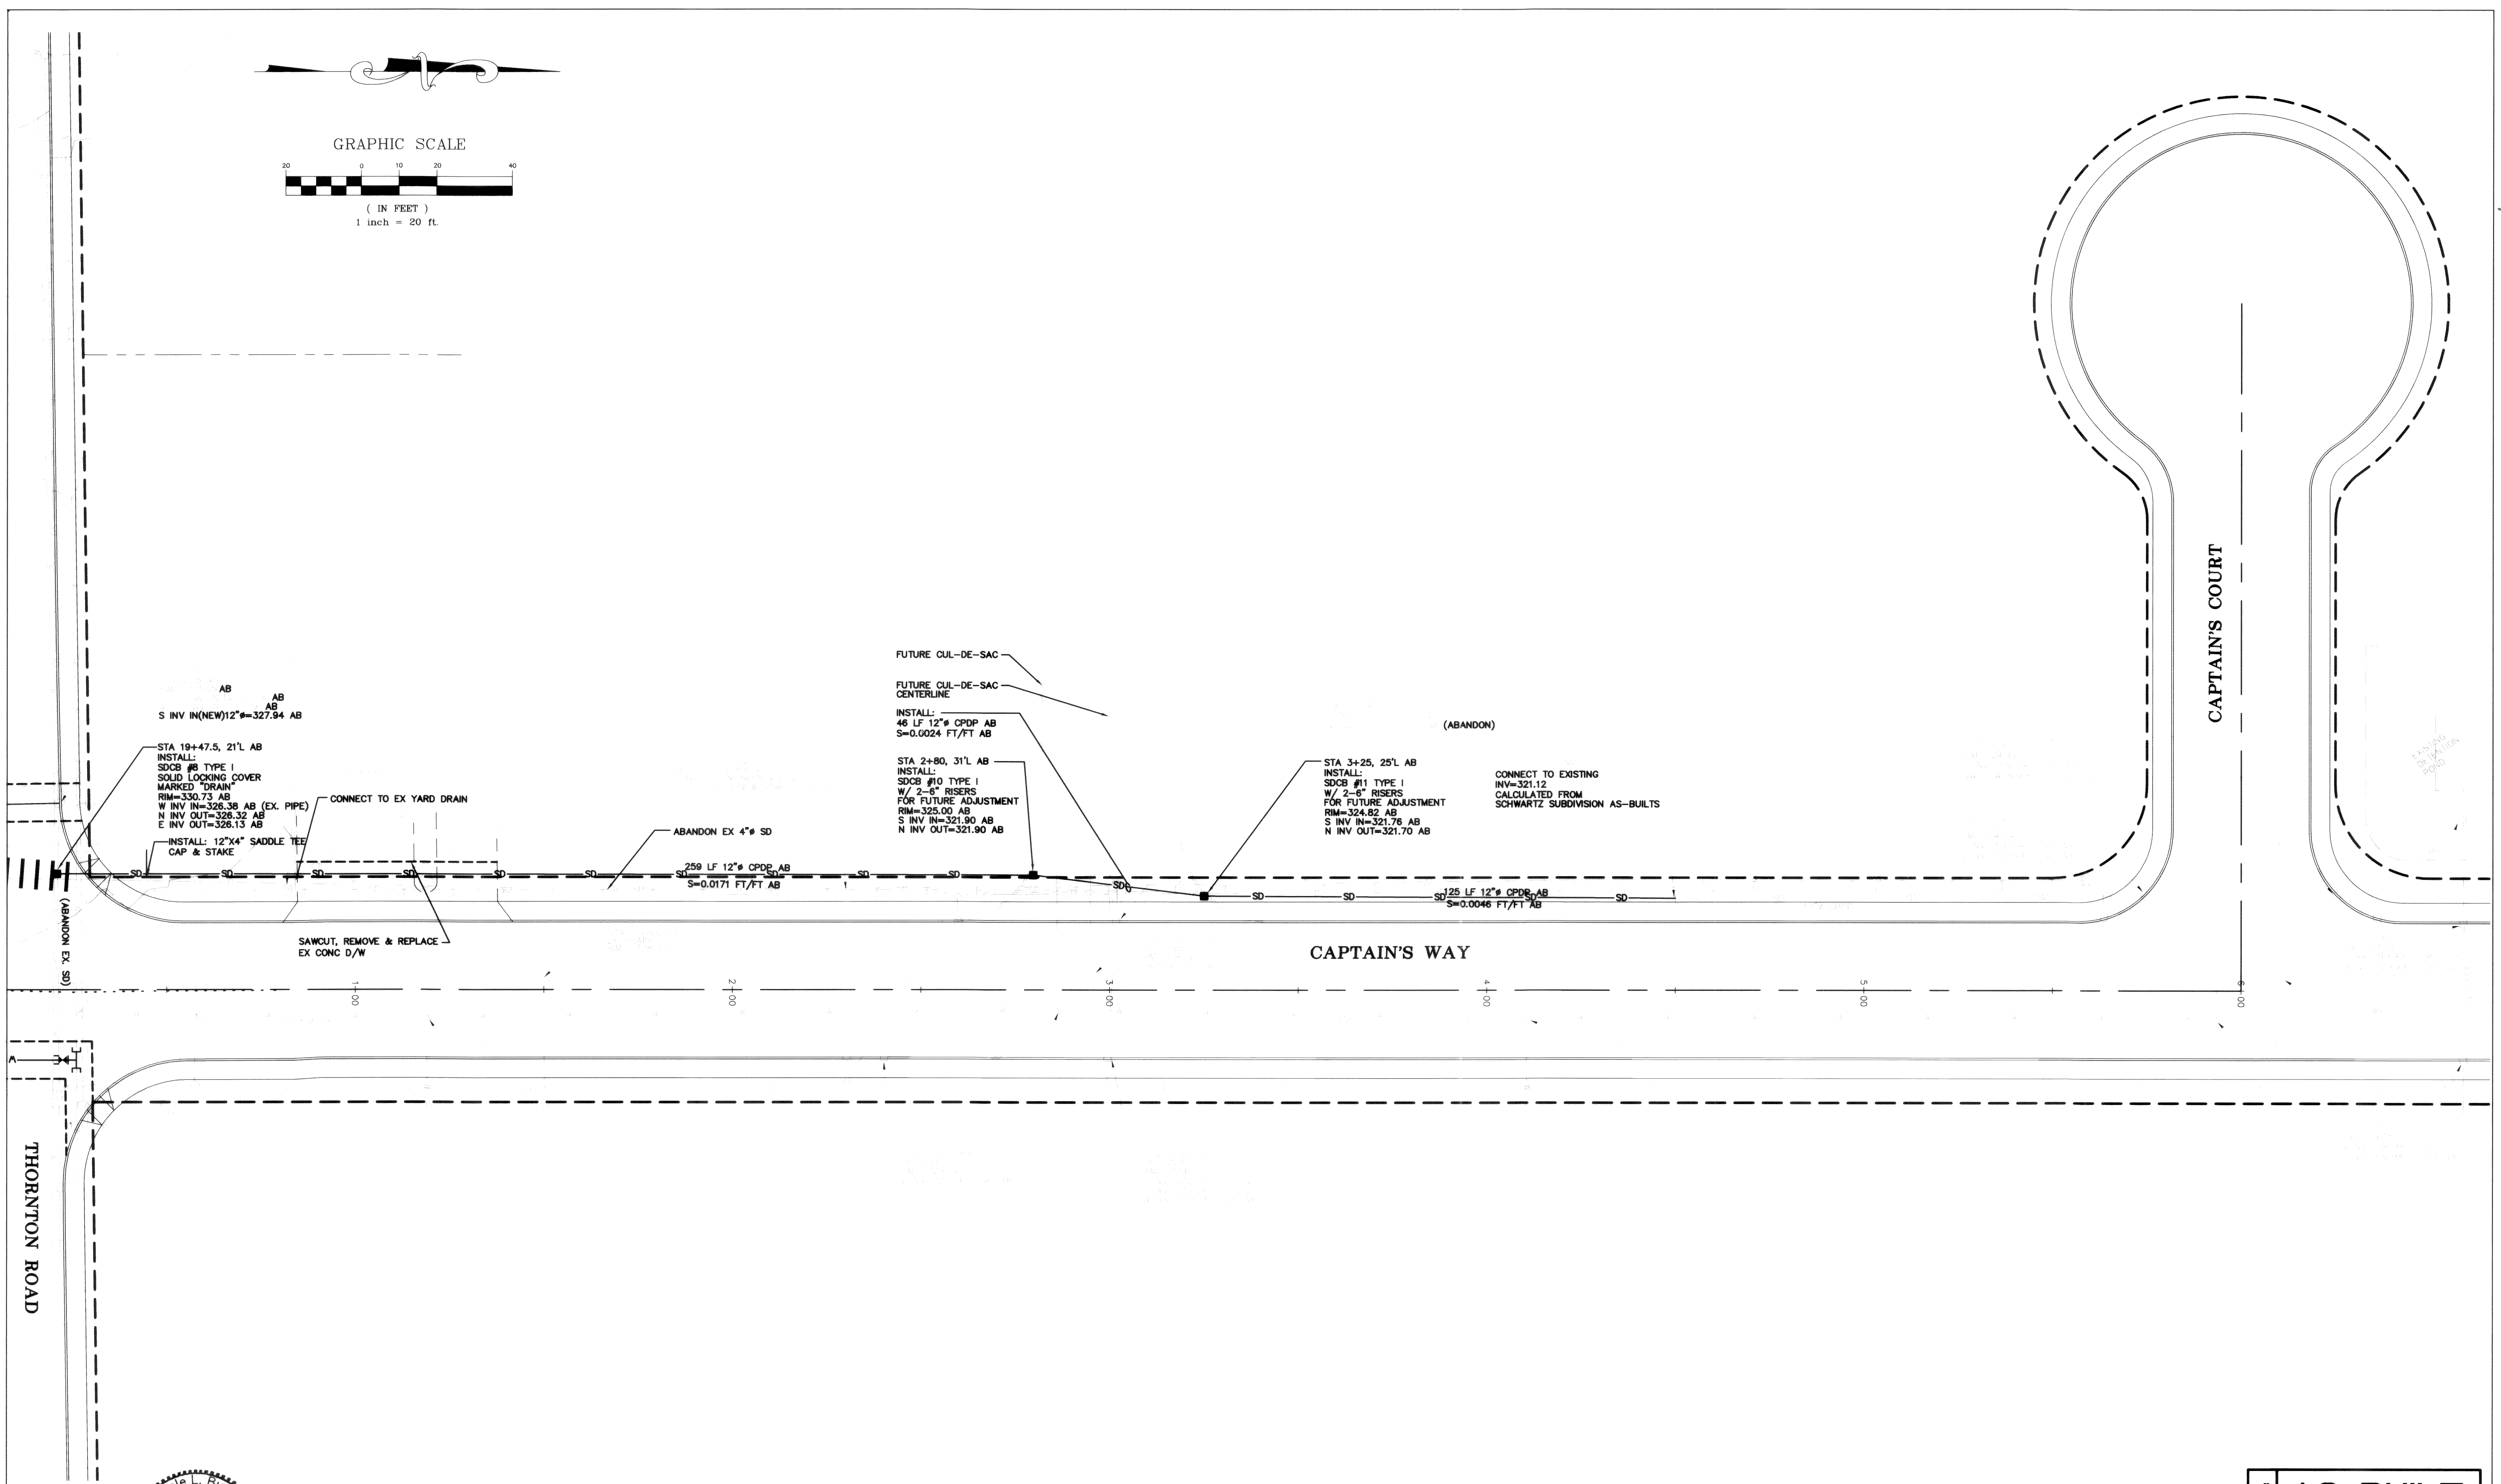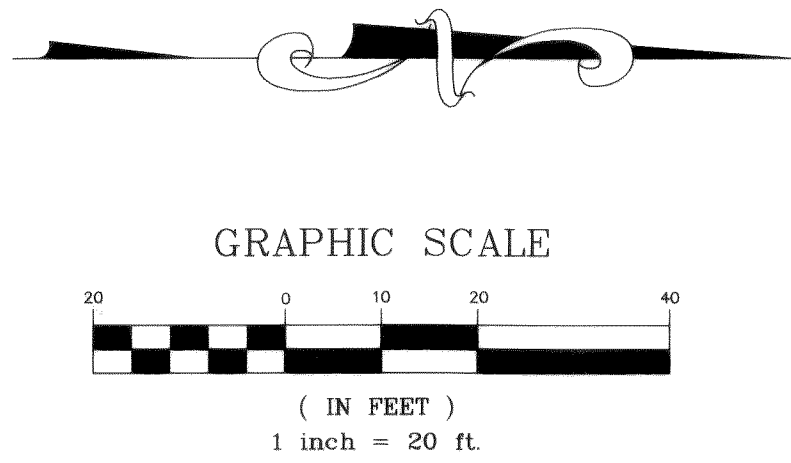

THORNTON ROAD


CAPTAIN'S COURT

CAPTAIN'S WAY

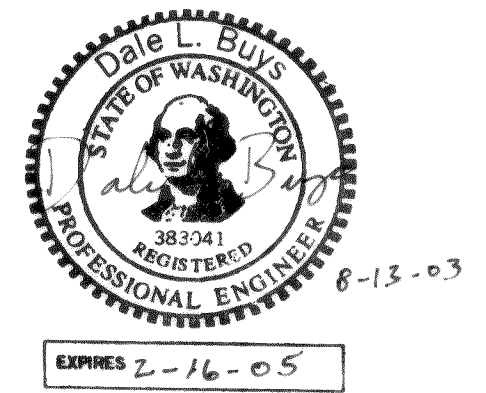


DESIGNED BY DLB	 REICHHARDT & EBE ENGINEERING, INC. CONSULTING ENGINEERS PO Box 978 423 Front St., Ste 201 Ph (360) 354-3687 Lynden, Washington 98264 Fax (360) 354-0407	1	4/29/02	Addition of WSHI curb returns	DLB	CITY OF FERNDAL 2095 MAIN STREET FERNDAL, WA 98248	THORNTON ROAD IMPROVEMENTS CAPTAIN'S WAY FERNDAL, WA FEDERAL-AID NO. AC-6TPE-8044(001)	JOB# / DWG 00009 009SP2AB	DATE 4-29-02
DRAWN BY LMC/JGS								SCALE H: 1" = 20' V: 1" = 2'	SHEET 4 of 5
CHECKED BY GDE		NO.	DATE	REVISION	BY				


00105.004 2-16-06 KL

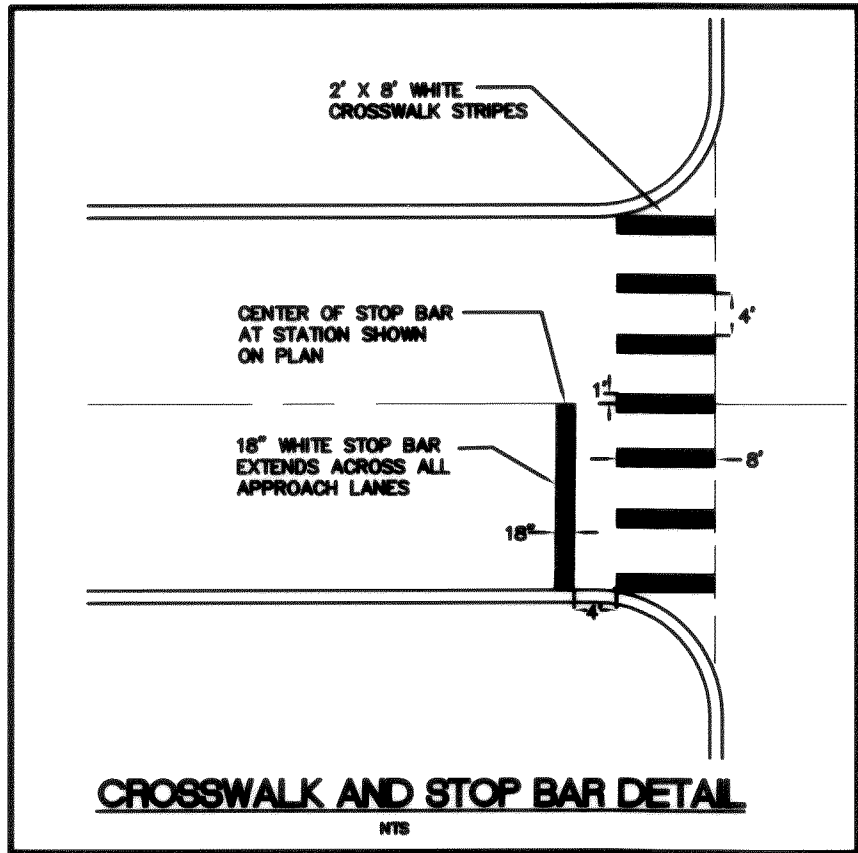

CROSSWALK AND STOP BAR DETAIL
NTS

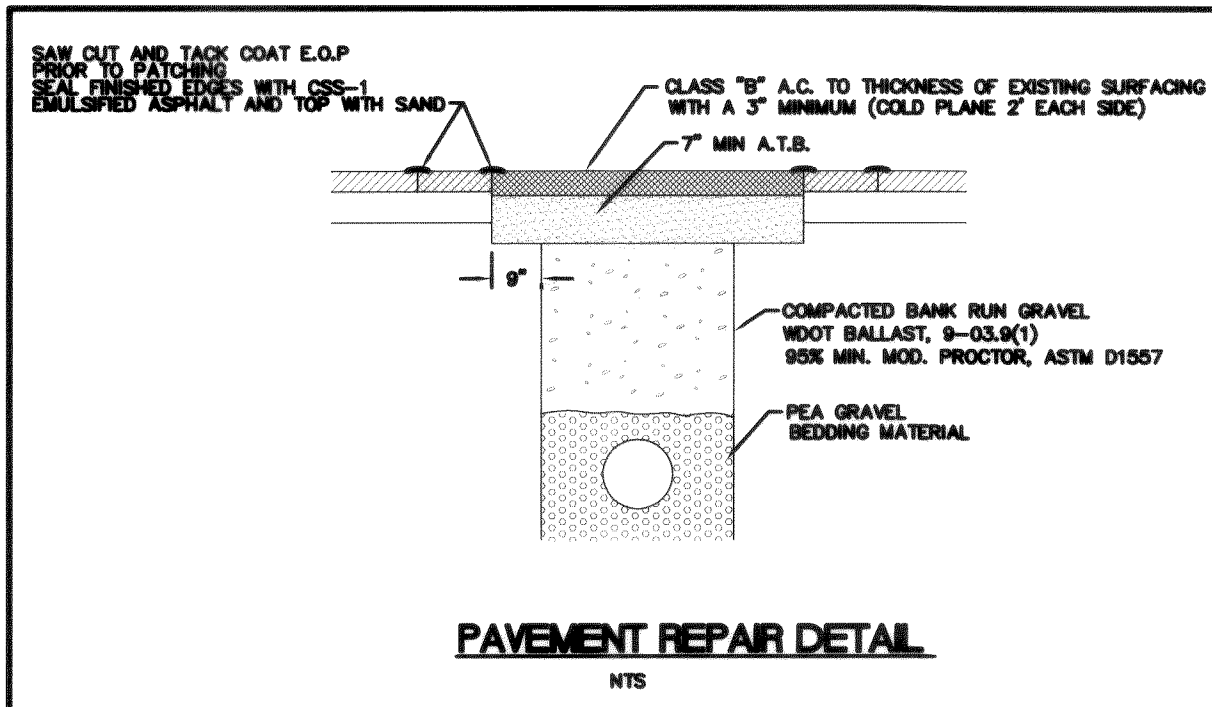


PAVEMENT REPAIR DETAIL
NTS

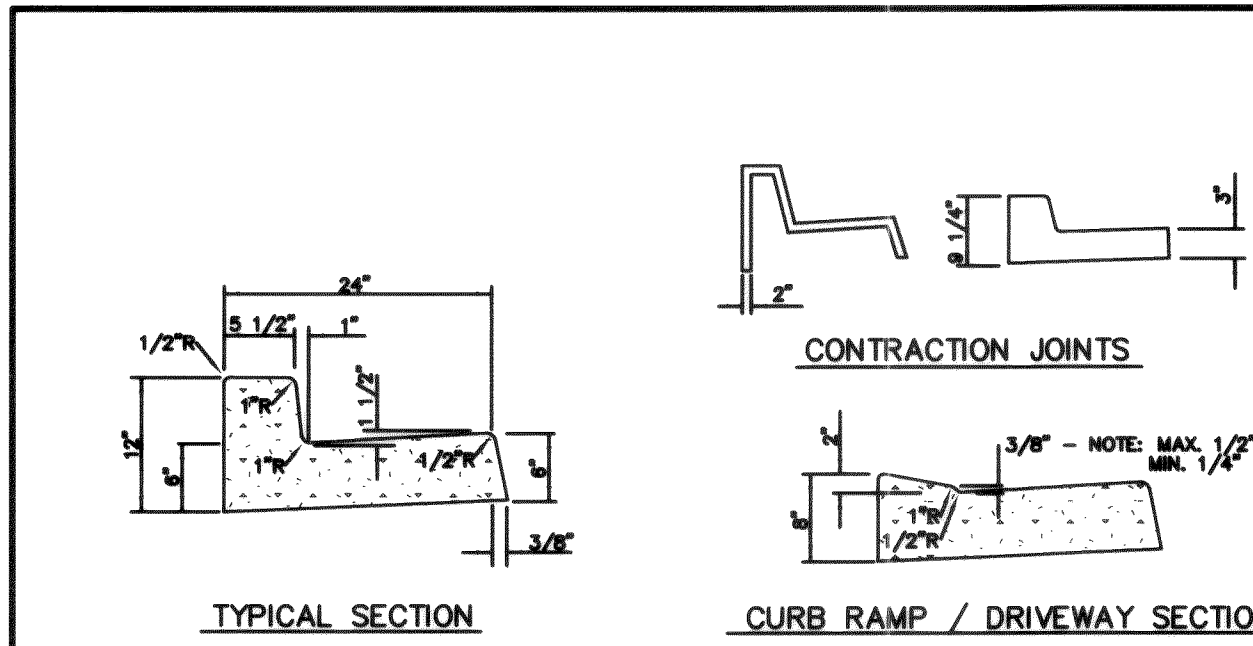


TYPICAL SECTION CURE RAMP / DRIVEWAY SECTION

NOTES:
CONTRACTION JOINTS OF ONE OF THE TYPES SHOWN ABOVE TO BE PLACED 10' C/C. JOINTS COMPLETELY SEVER THE STRUCTURE TO THE POINTS SHOWN. JOINTS MAY BE MADE BY INSERTING MIN. 3/16" BITUMINOUS FILLER DUMMY JOINTS. JOINTS SHALL BE CLEANED AND EDED.
3/4" EXPANSION JOINTS TO BE PLACED AT DRIVEWAY SECTIONS, CURB RETURNS, CURB RAMPS AND COLD JOINTS OR A MAX. OF 80' C/C. EXPANSION JOINTS SHALL PROTRUDE 1" BELOW THE BOTTOM OF THE GUTTER.


TYPE A MODIFIED CURB AND GUTTER
NTS

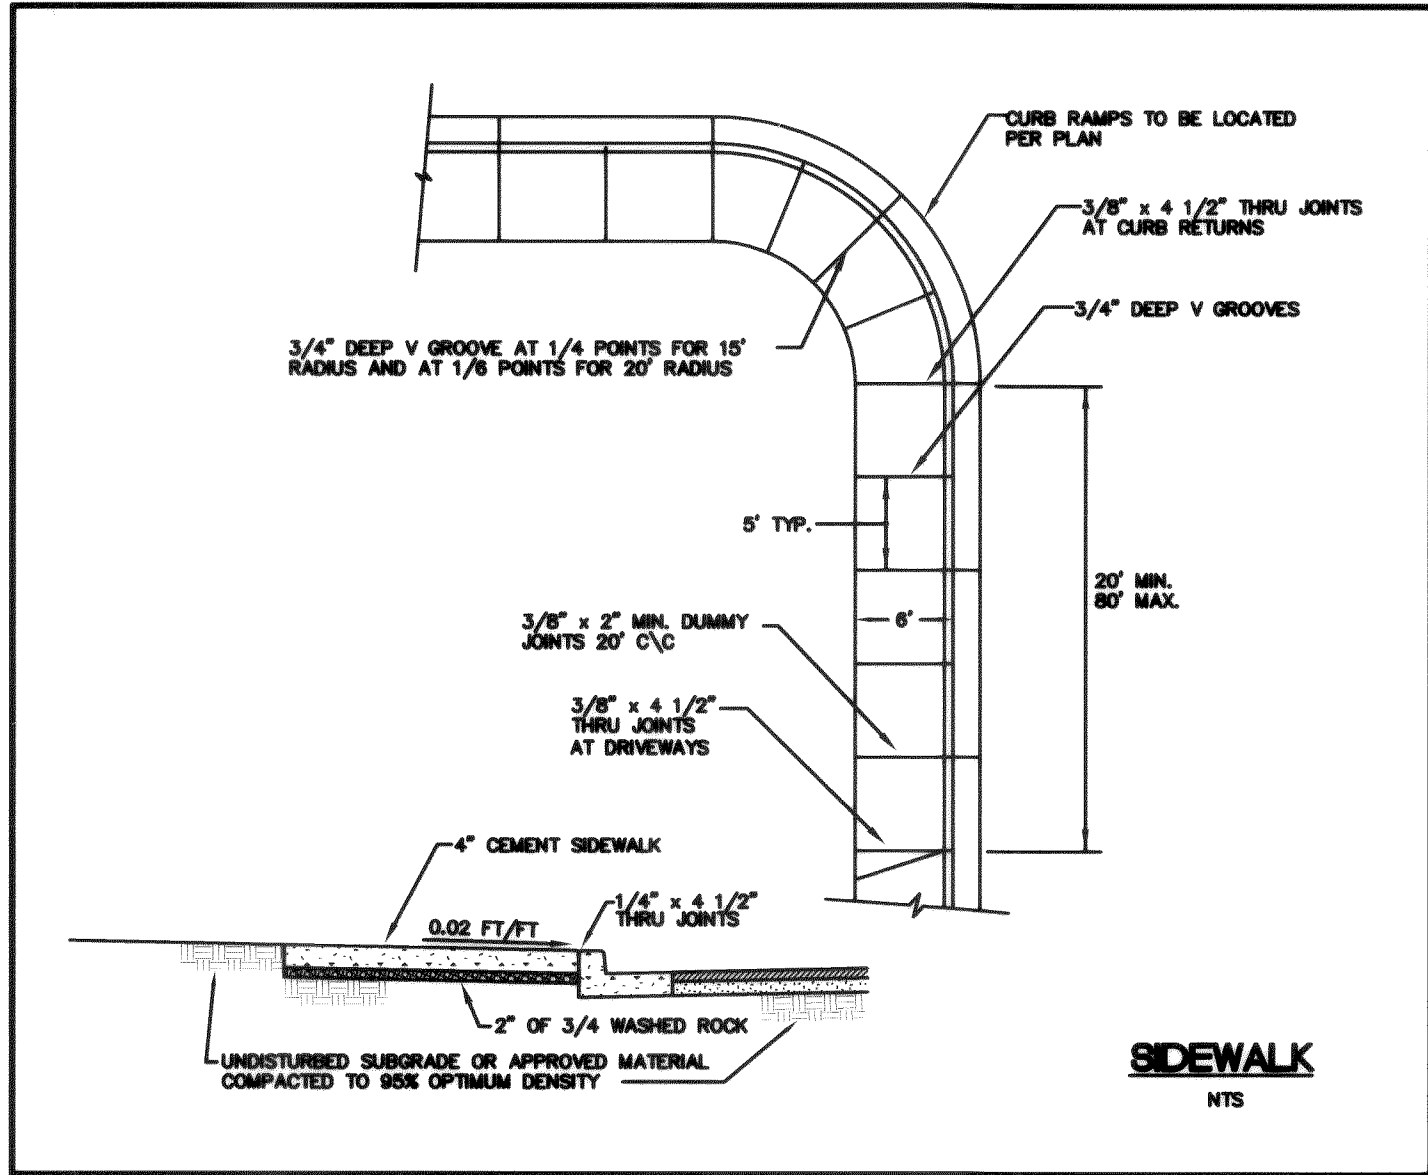


SIDEWALK
NTS

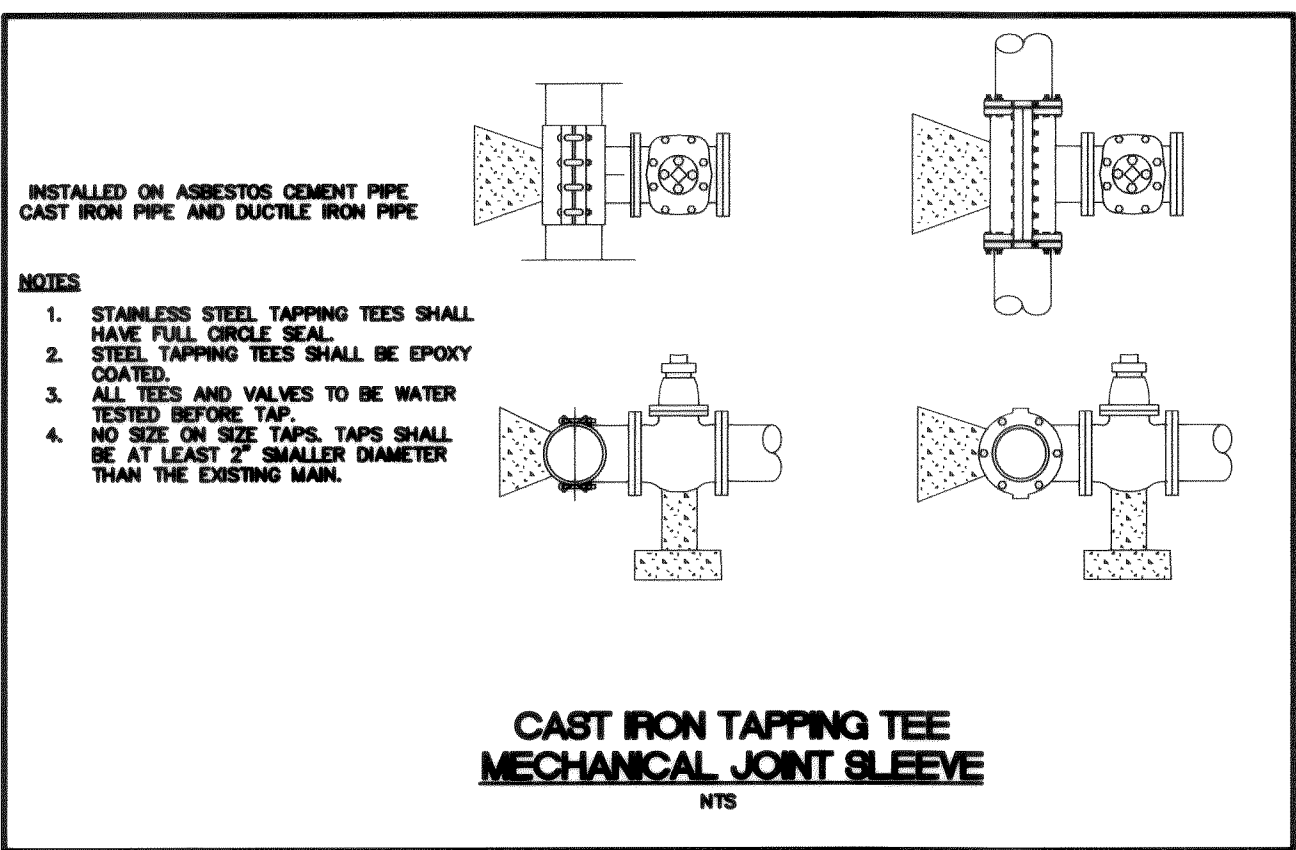


CAST IRON TAPPING TEE
MECHANICAL JOINT SLEEVE
NTS

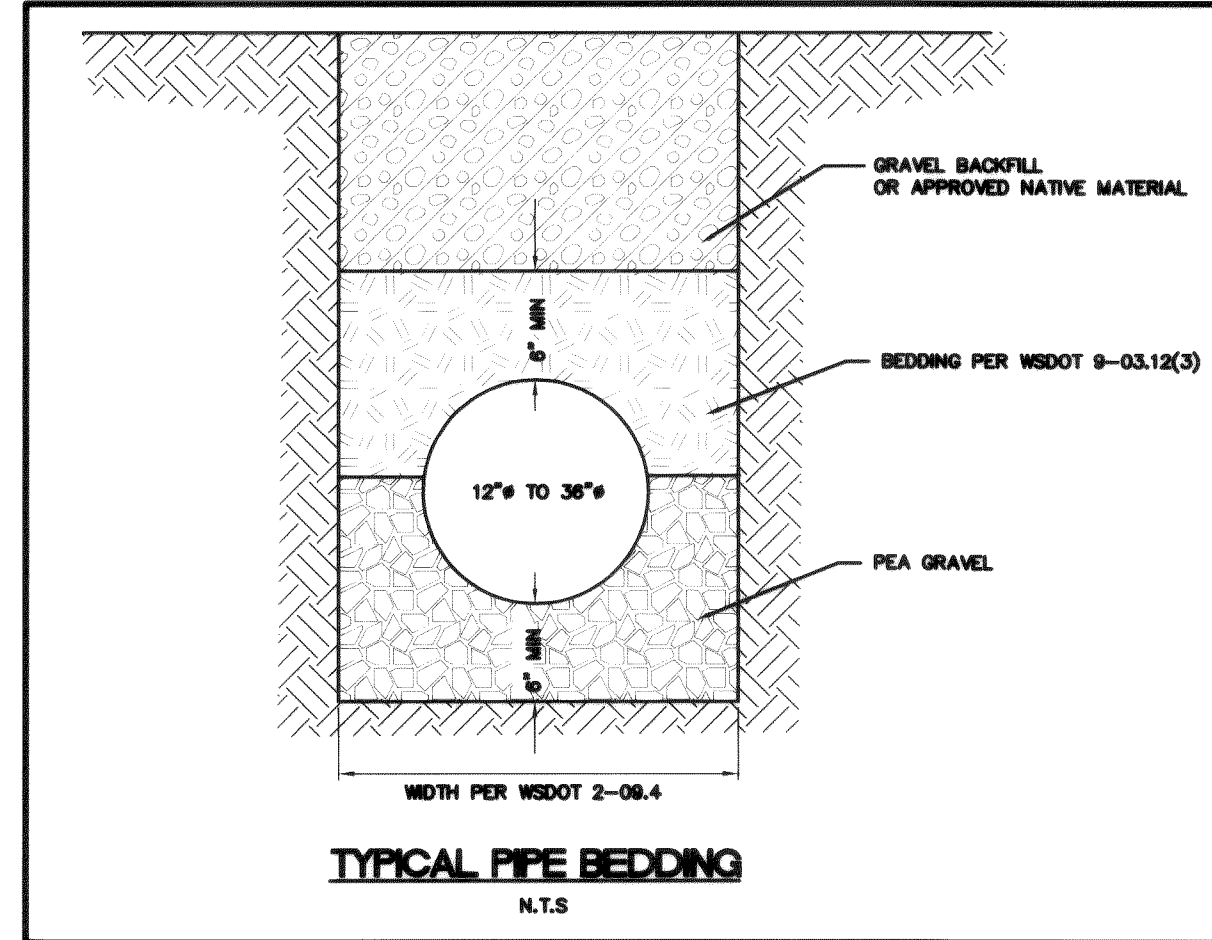


TYPICAL PIPE BEDDING
NTS

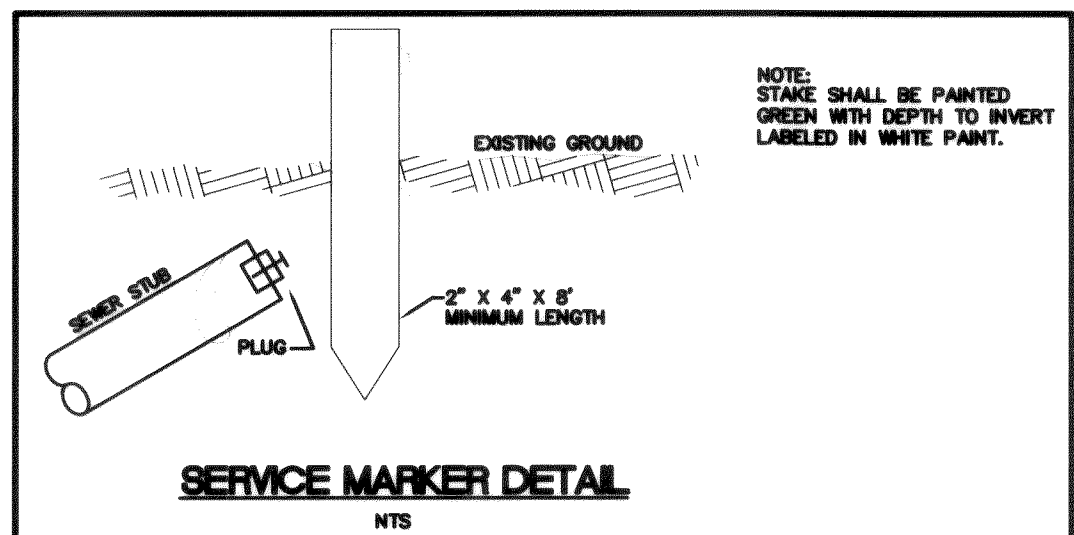


SERVICE MARKER DETAIL
NTS

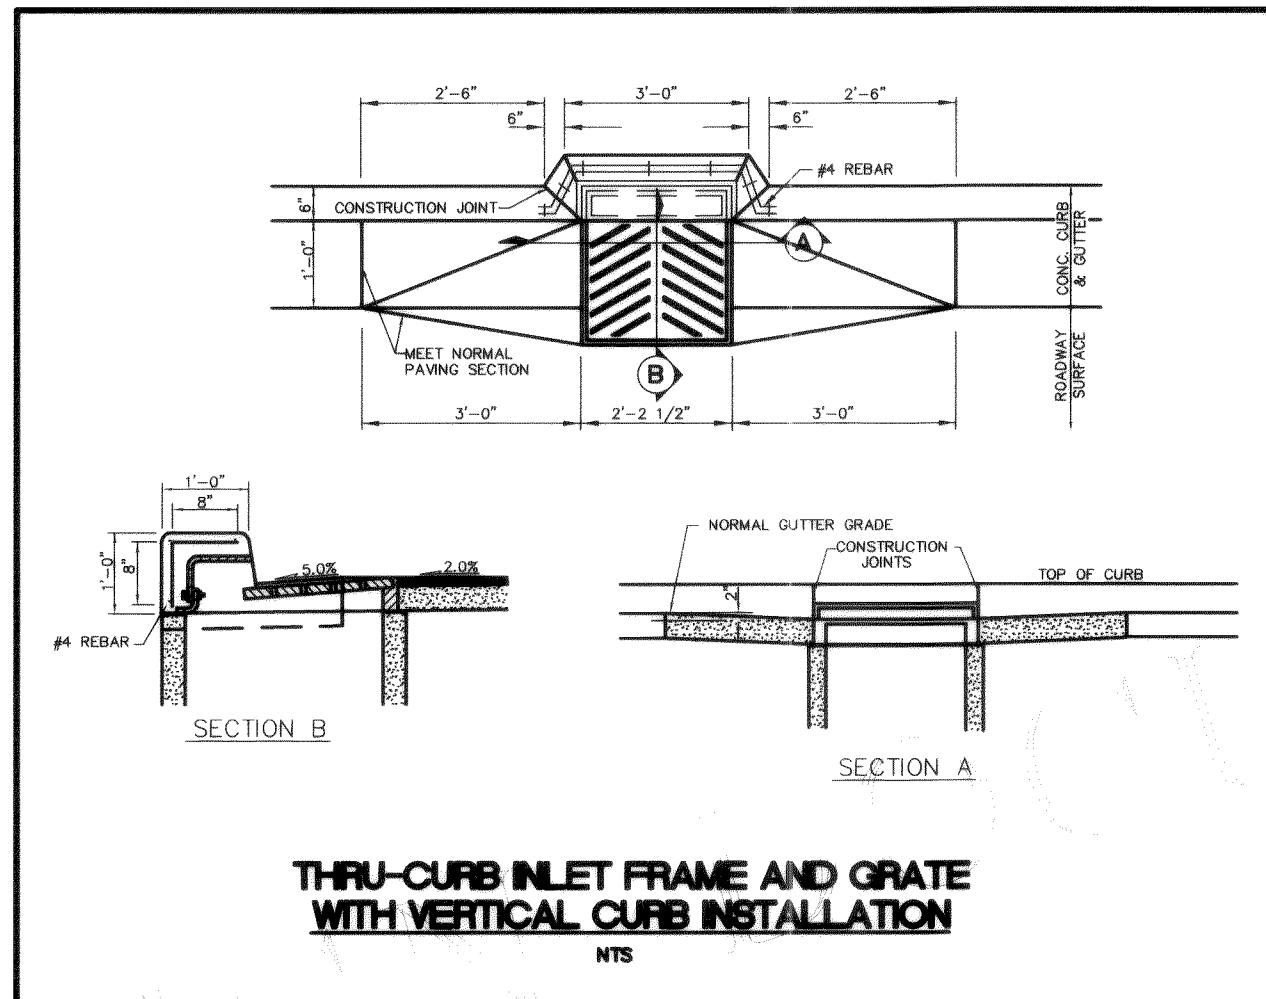


THRU-CURB INLET FRAME AND GRATE
WITH VERTICAL CURB INSTALLATION
NTS

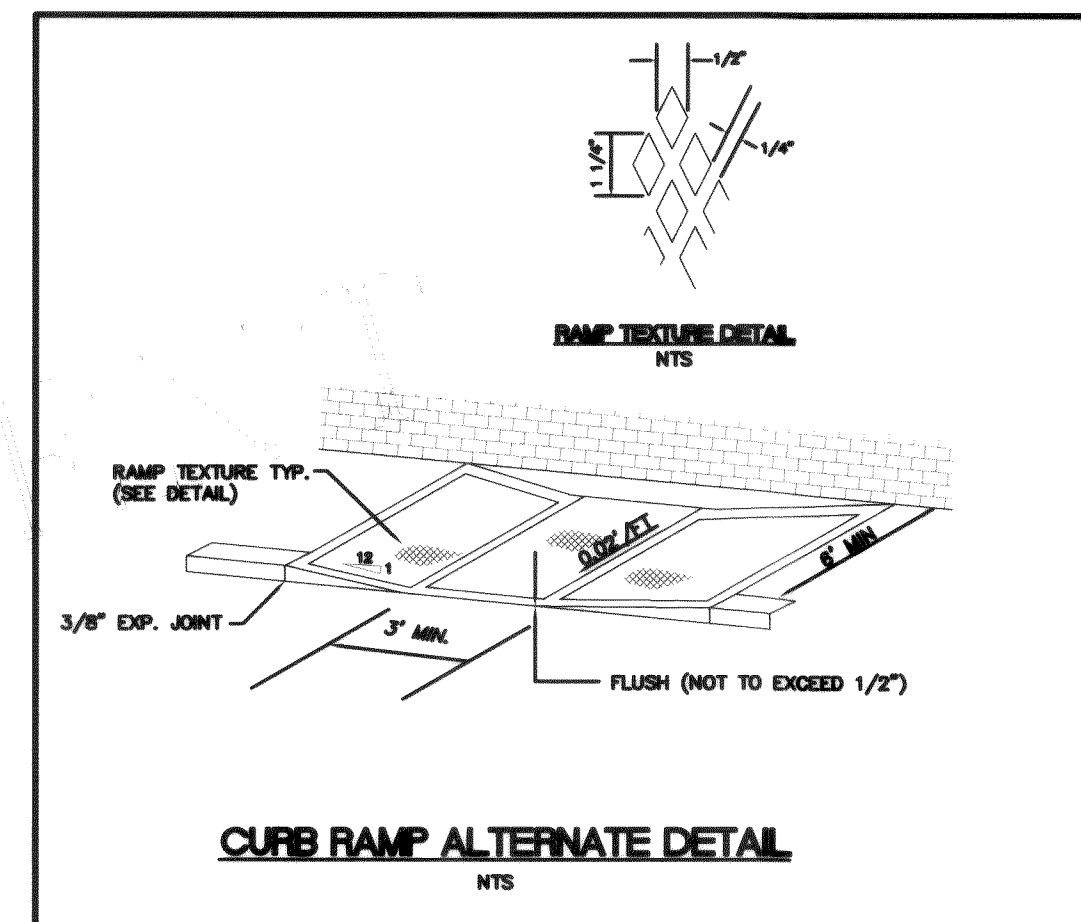


CURB RAMP ALTERNATE DETAIL
NTS

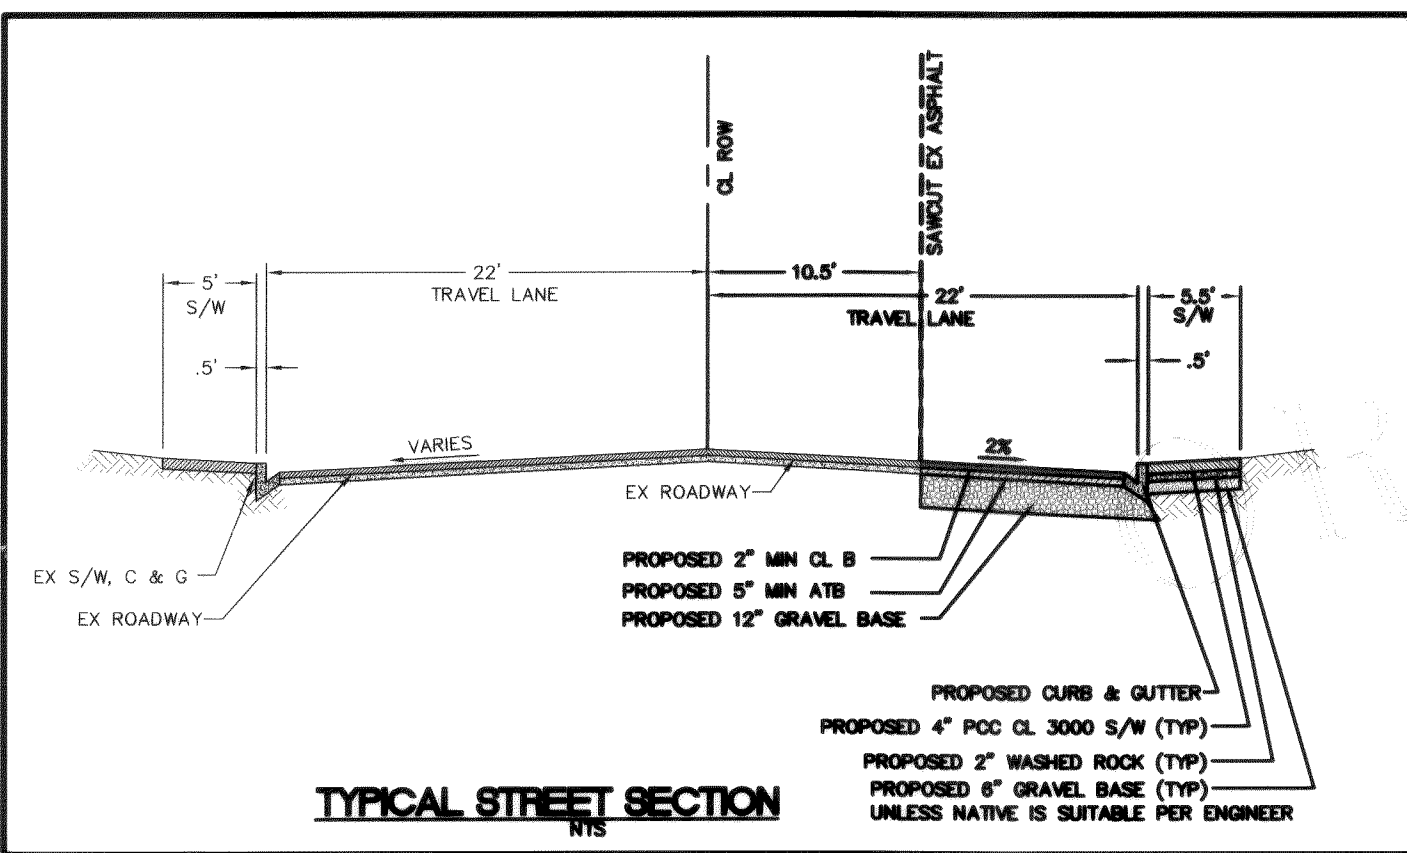


TYPICAL STREET SECTION
NTS

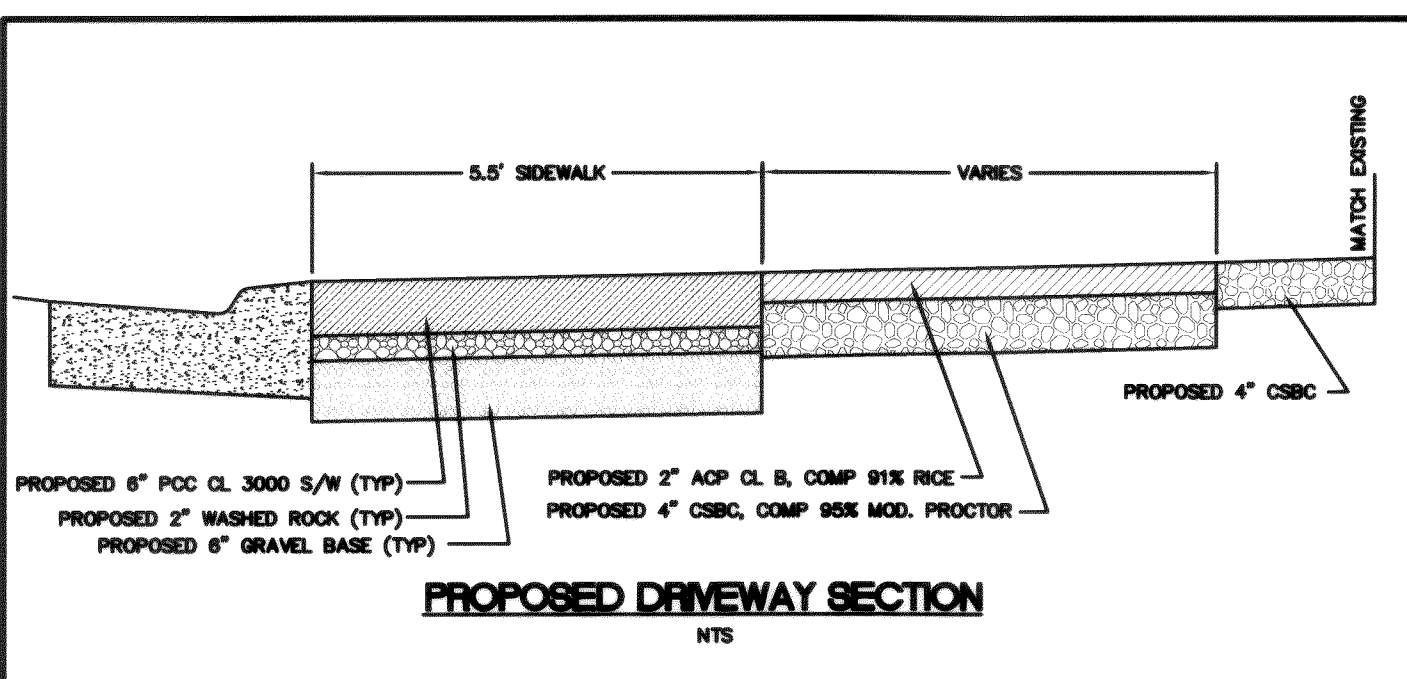


PROPOSED DRIVEWAY SECTION
NTS

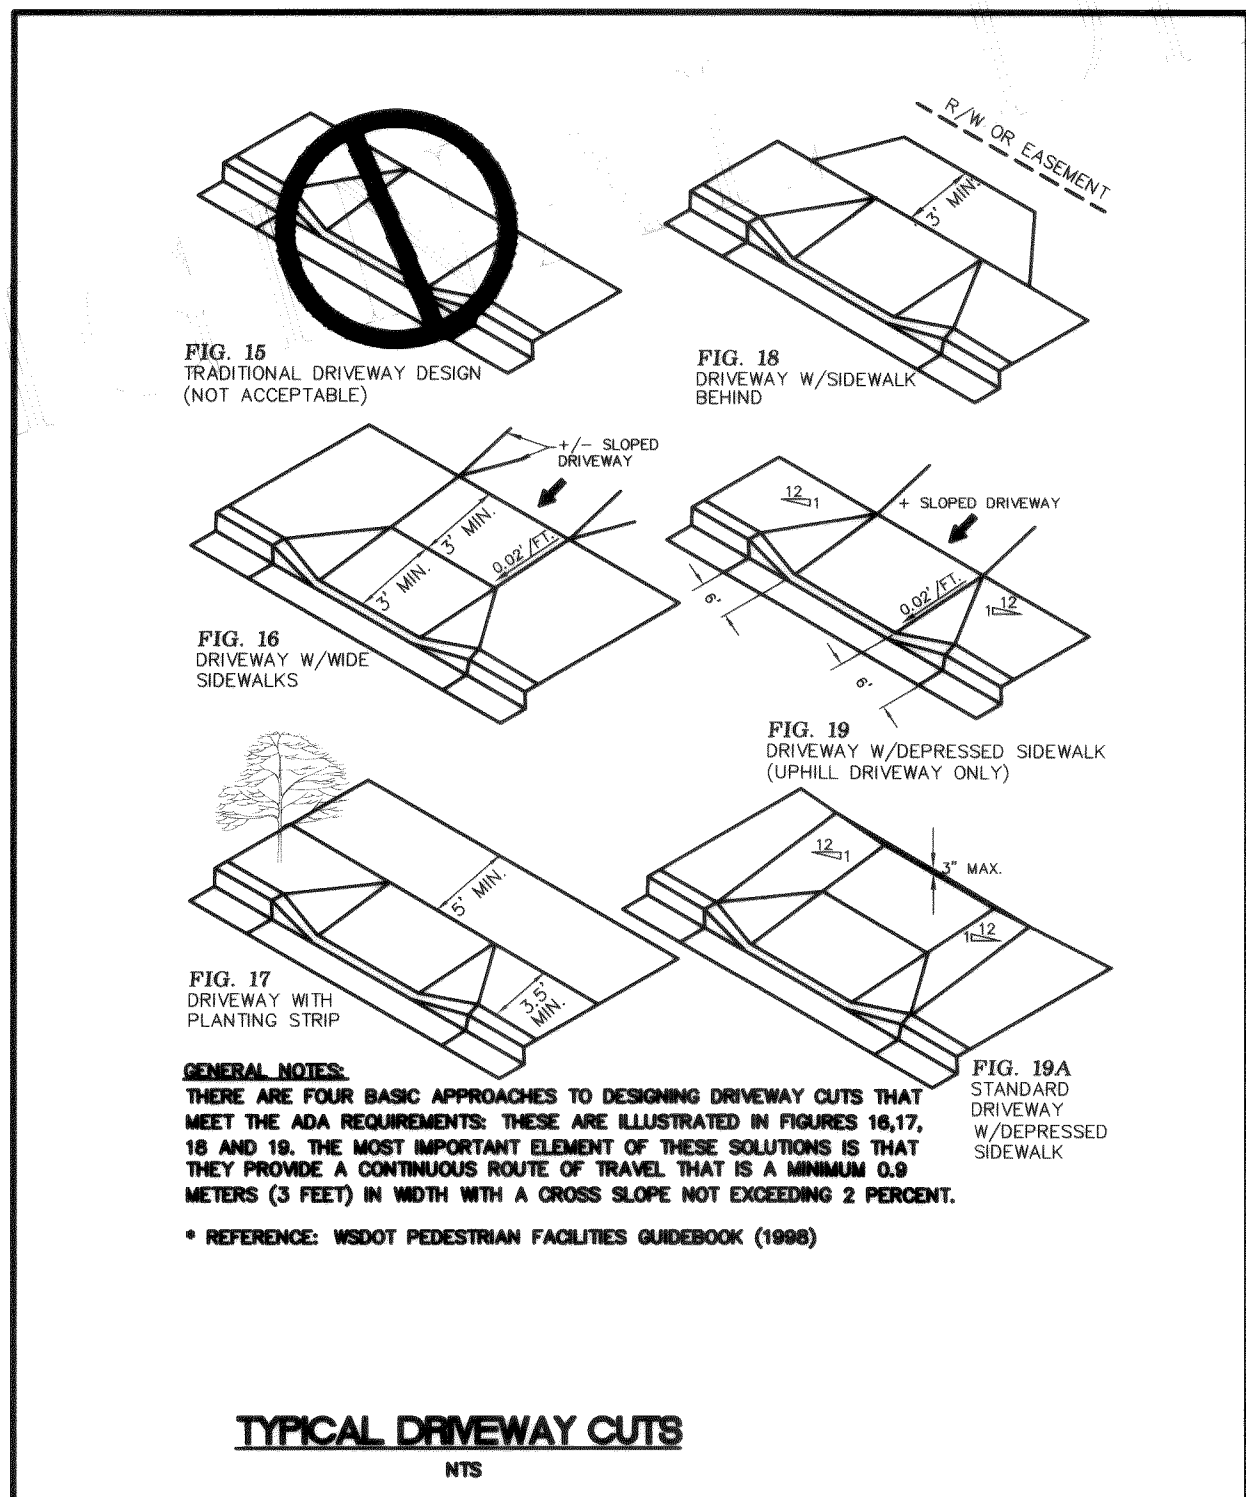

TYPICAL DRIVEWAY CUTS
NTS

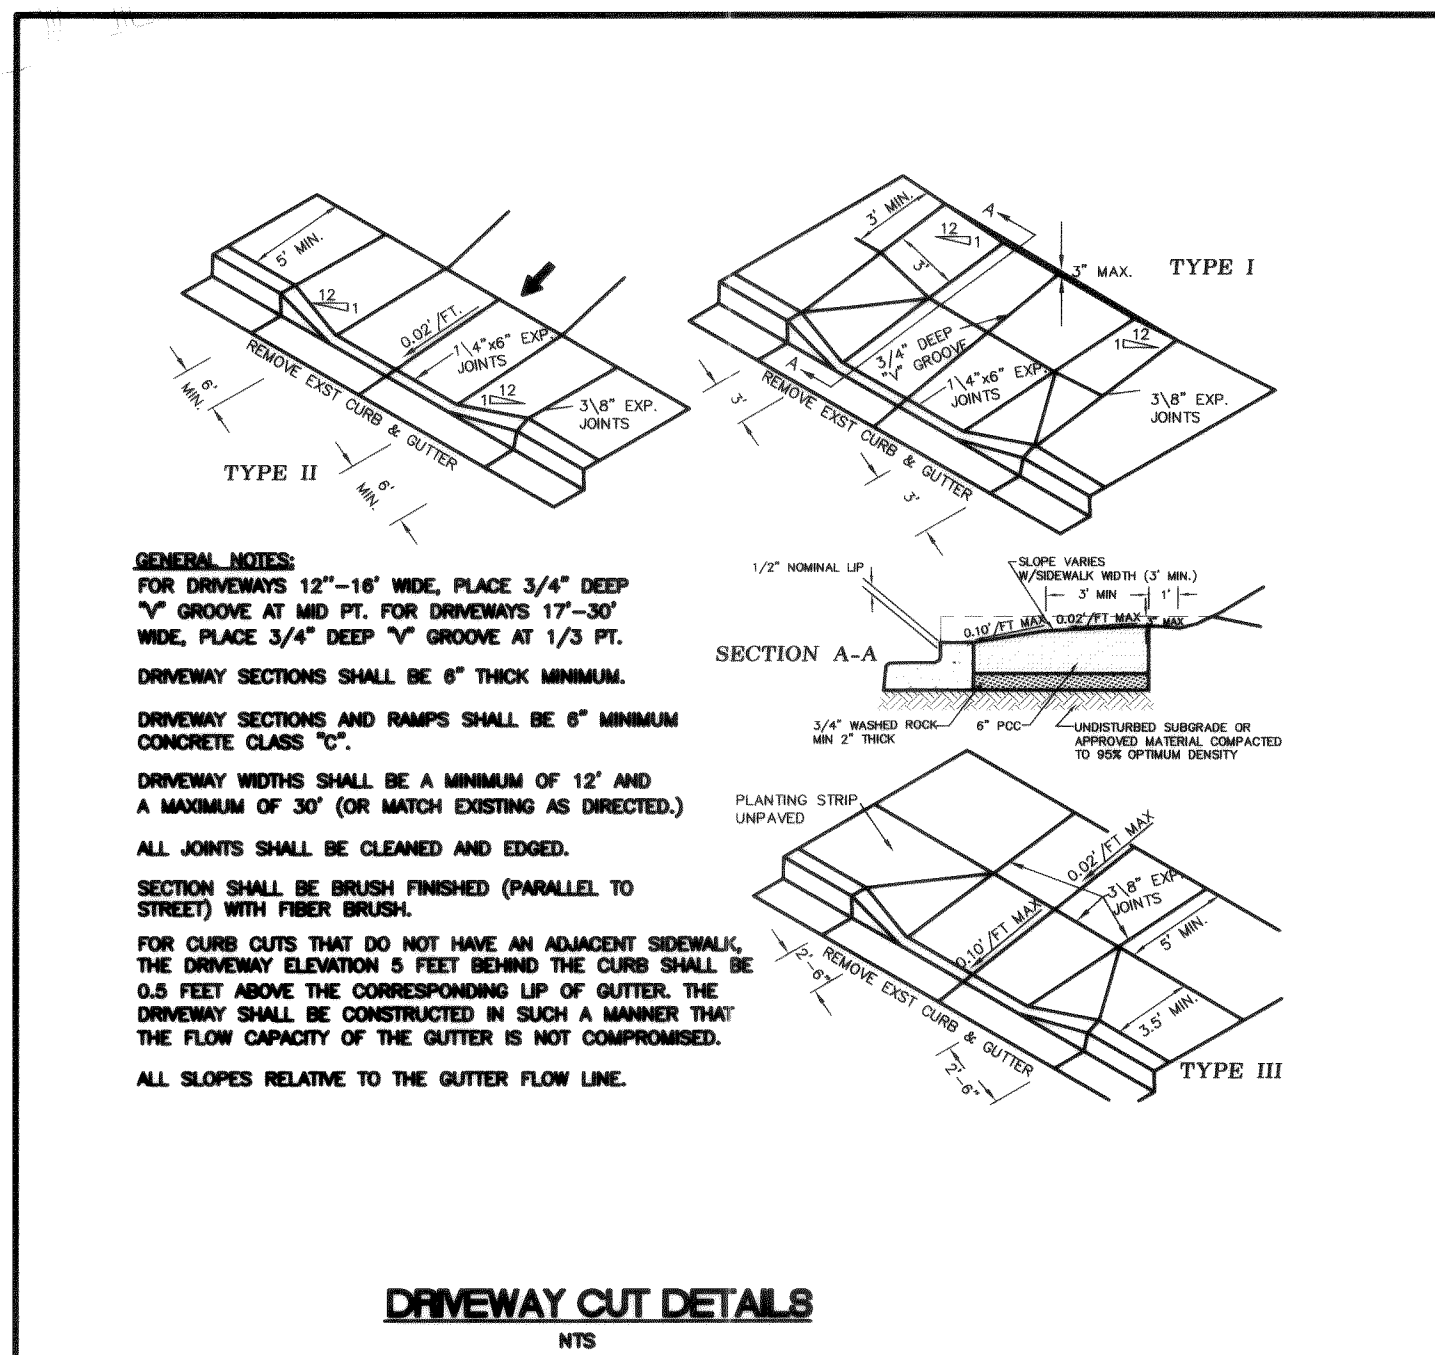

DRIVEWAY CUT DETAILS
NTS

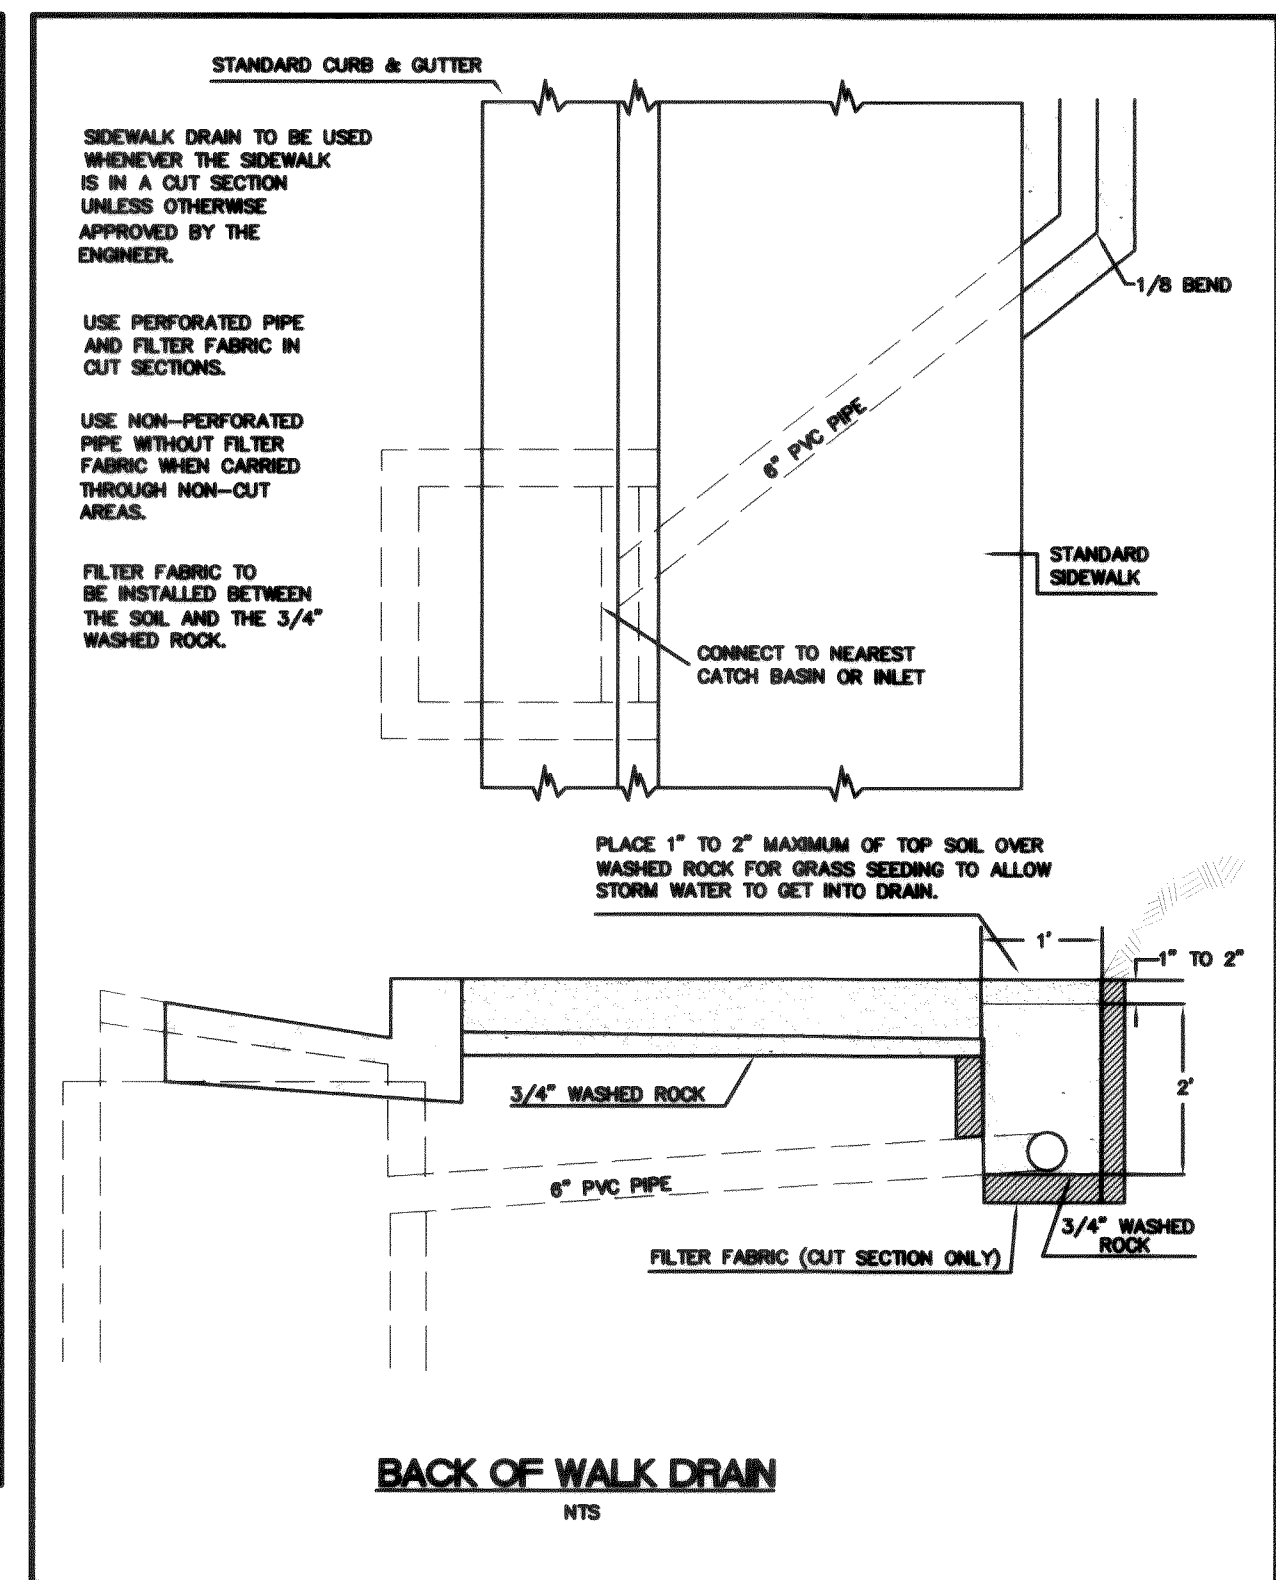

BACK OF WALK DRAIN
NTS

DESIGNED BY
DLB
DRAWN BY
LMC
CHECKED BY
GDE



REICHARDT & EBE
ENGINEERING, INC.
CONSULTING ENGINEERS
PO Box 978 423 Front St., Ste 201 Ph (360) 354-3687
Lynden, Washington 98264 Fax (360) 354-0407

NO.	DATE	REVISION	BY

CITY OF FERDALE
2095 MAIN STREET
FERDALE, WA 98248

THORNTON ROAD IMPROVEMENTS
DETAIL SHEET
FERDALE, WA
FEDERAL-AID NO. AC-81PE-8044(001)

JOB# / DWG 00009	DATE 12-28-01
SCALE H: N/A V: N/A	SHEET 5 of 5

00185.005 2-16-06 KE