



SCHWARTZ SUBDIVISION







AS-BUILTS



VICINITY MAP

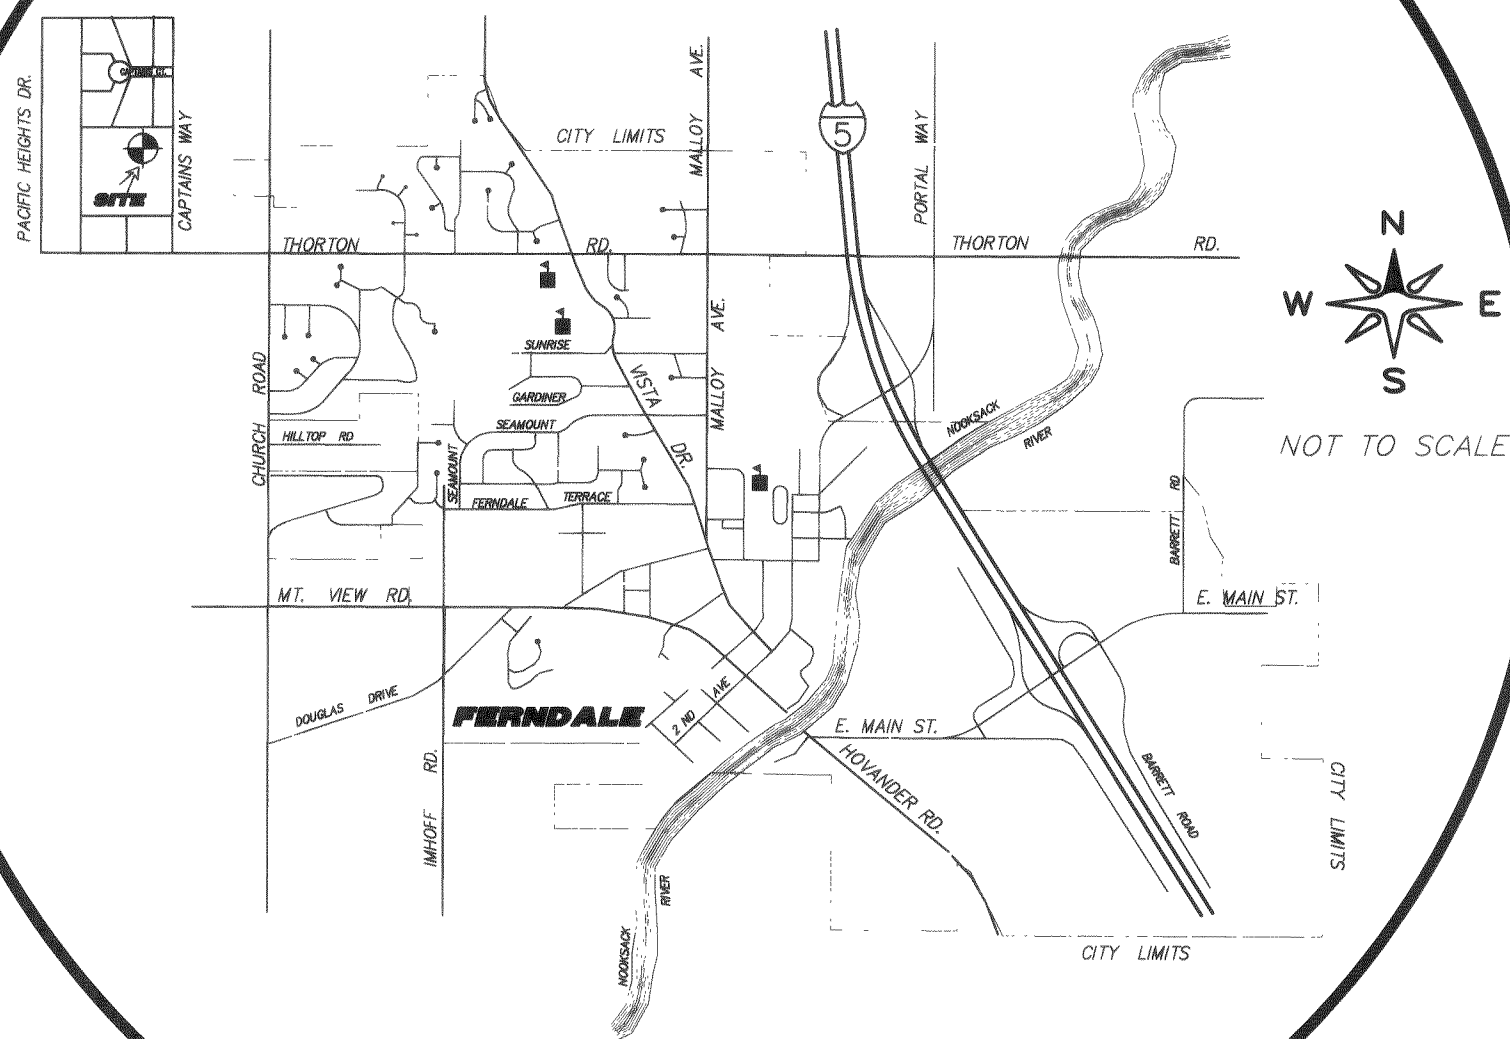

1. COVER SHEET
2. STREET PLAN, PROFILES & UTILITIES
3. WATER & SANITARY SEWER PLANS & PROFILES
4. SHEET 8 OF 9 DIBBLE DETAILS PER AS-BUILTS 10-18-99
5. SHEET 9 OF 9 DIBBLE DETAILS PER AS-BUILTS 10-18-99



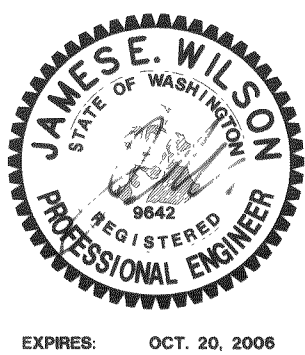
DRAWN BY CHECKED BY	DATE DATE	SCHWARTZ SUBDIVISION FOR: CAPTAIN ROGERS T. SCHWARTZ	PROFESSIONAL CERTIFICATION I HEREBY CERTIFY THAT THE IMPROVEMENTS IN THE SCHWARTZ SUBDIVISION HAVE BEEN INSPECTED BY JONES ENGINEERS INC. AND CONSTRUCTED IN CONFORMANCE WITH THE PLANS APPROVED BY THE PUBLIC WORKS DIRECTOR FOR SAID DEVELOPMENT AND THE GENERAL SPECIFICATIONS ADOPTED BY THE CITY OF FERNDALE DEPARTMENT OF PUBLIC WORKS. <i>James E. Wilson</i> 11/22/05 JAMES E. WILSON, P.E., PLS. DATE		 ENGINEERS phone 360 733.8888 fax 360 671.6666 web jeiwa.com 4164 Meridian Street • Suite 200 • Bellingham, Washington 98226	SCHWARTZ SUBDIVISION AS-BUILTS COVER SHEET	APPROVED FEB 22 2006 BY <i>[Signature]</i> CITY OF FERNDALE	SHEET 1 OF 5
JOB # 04029								

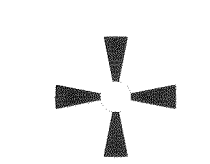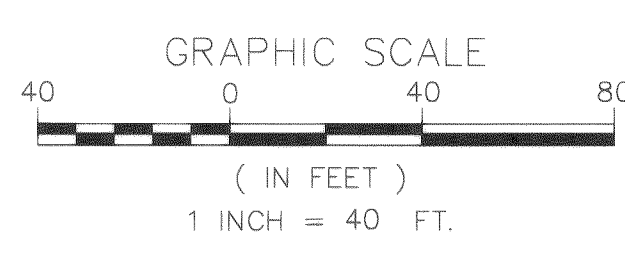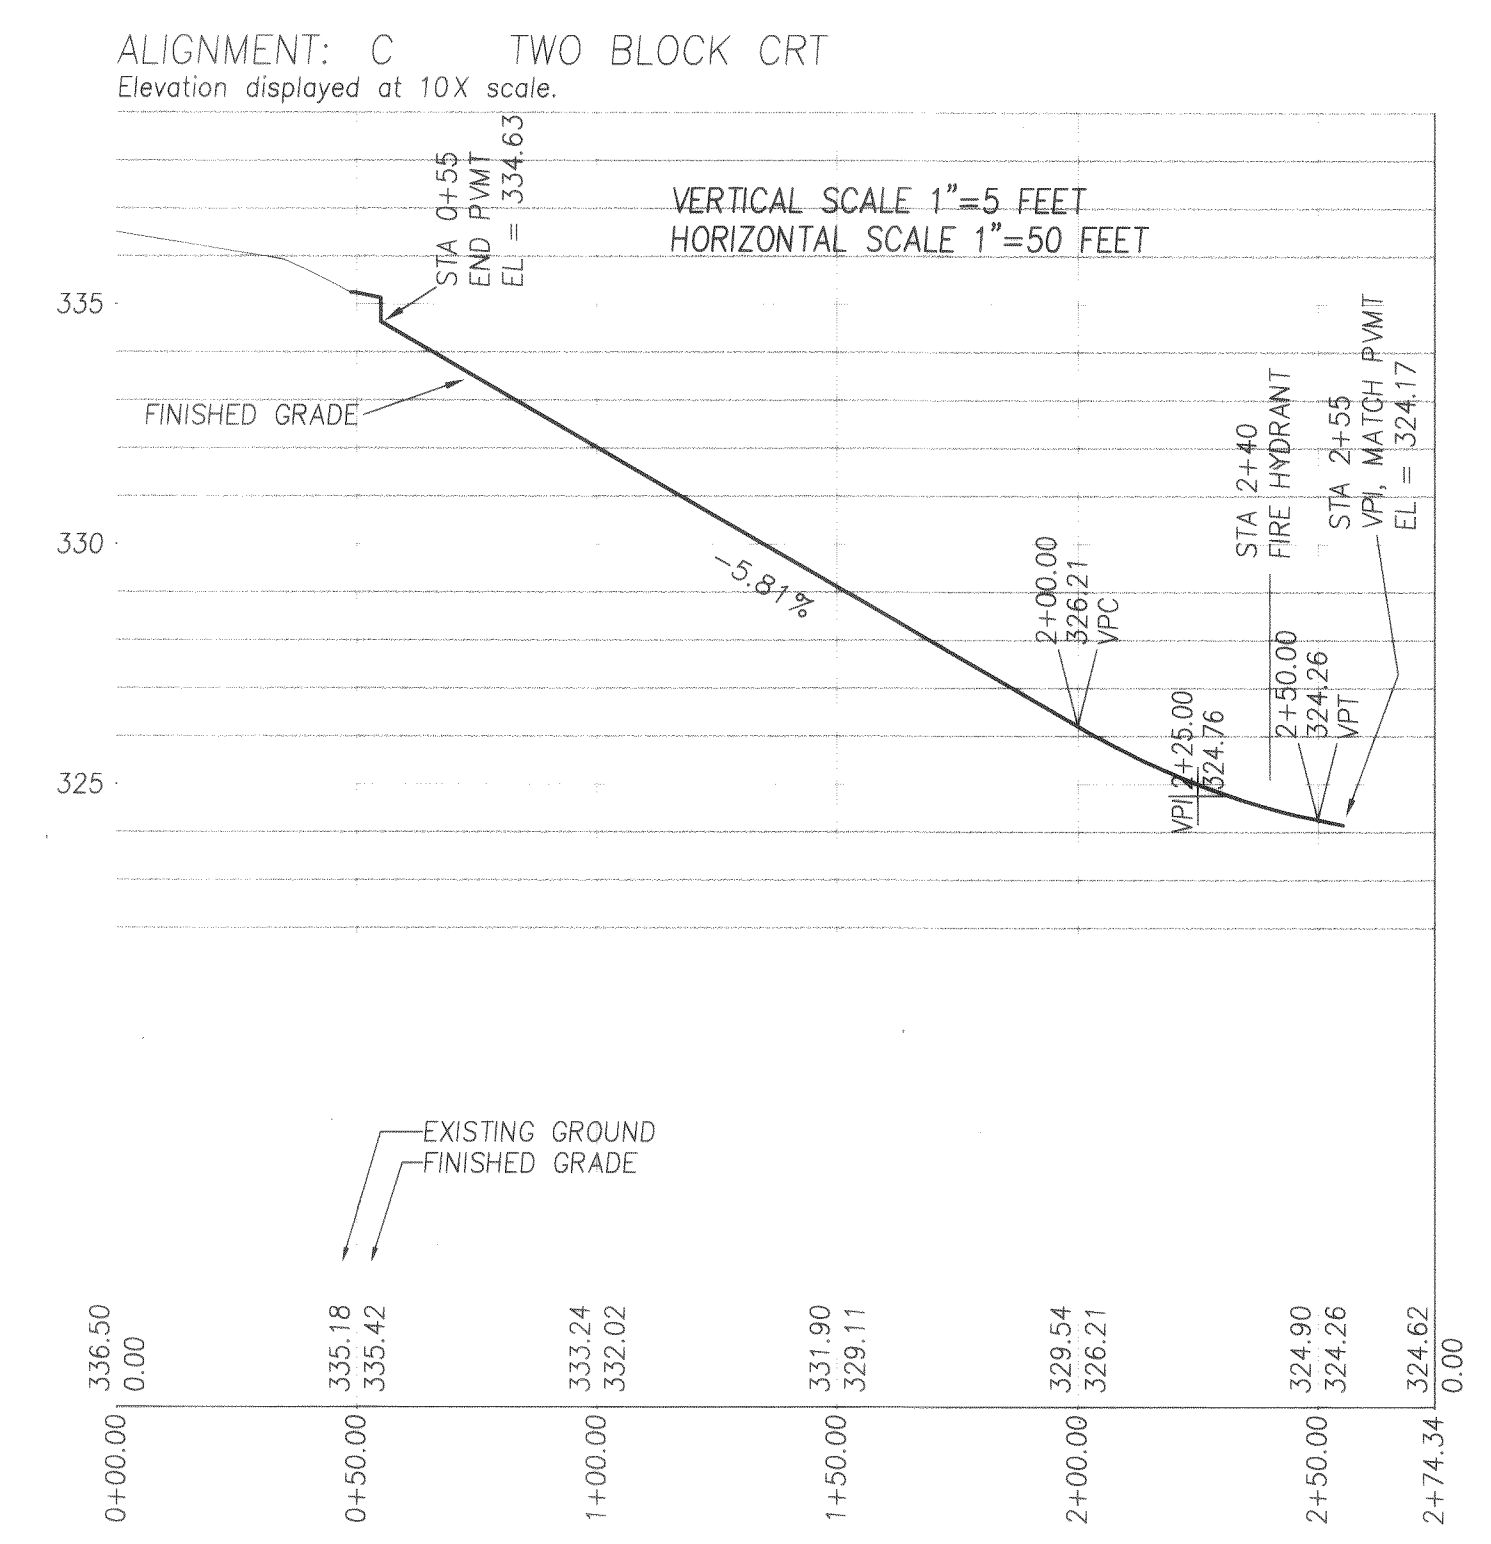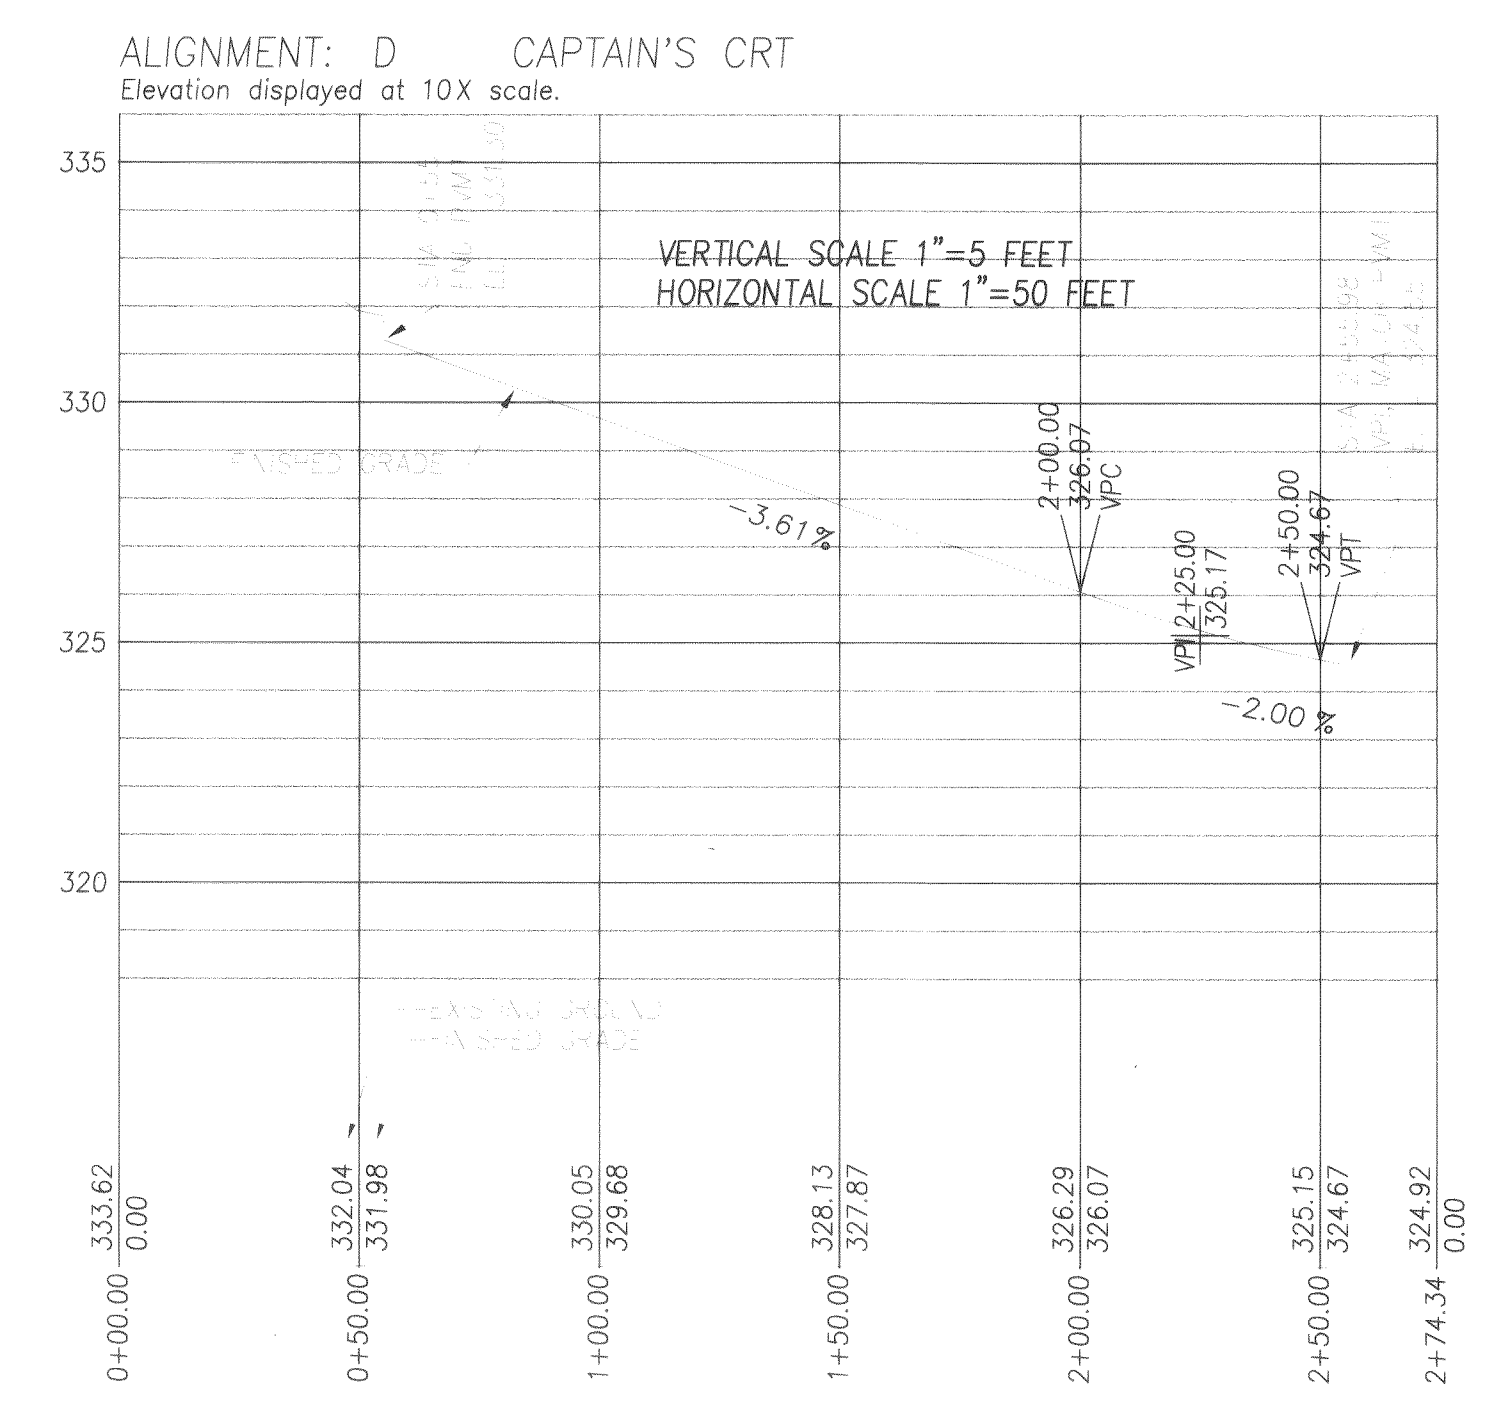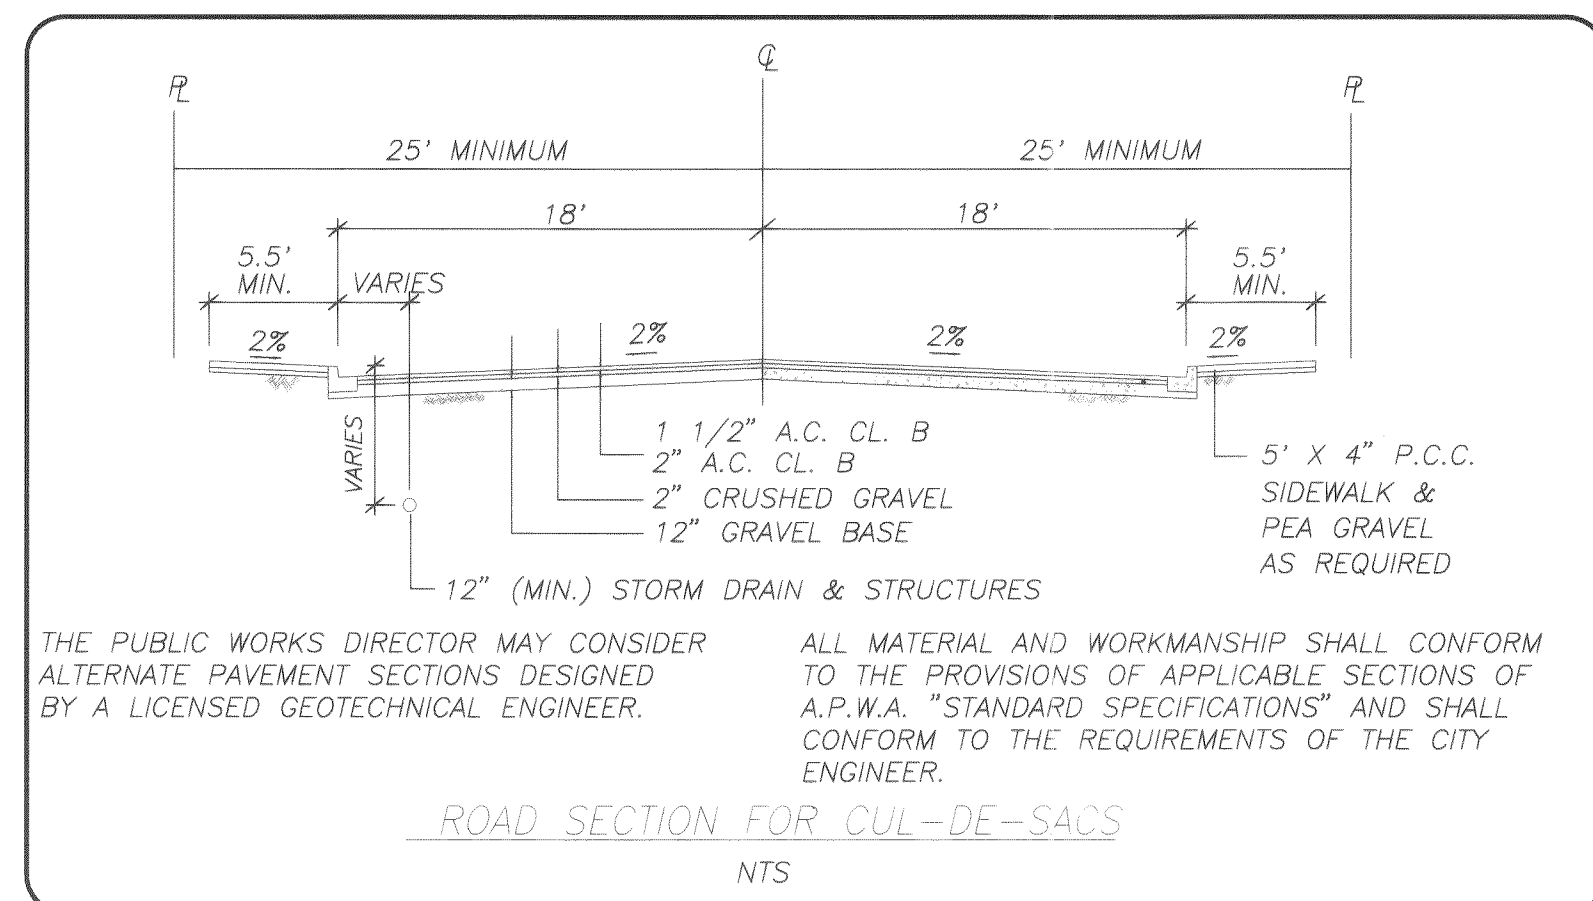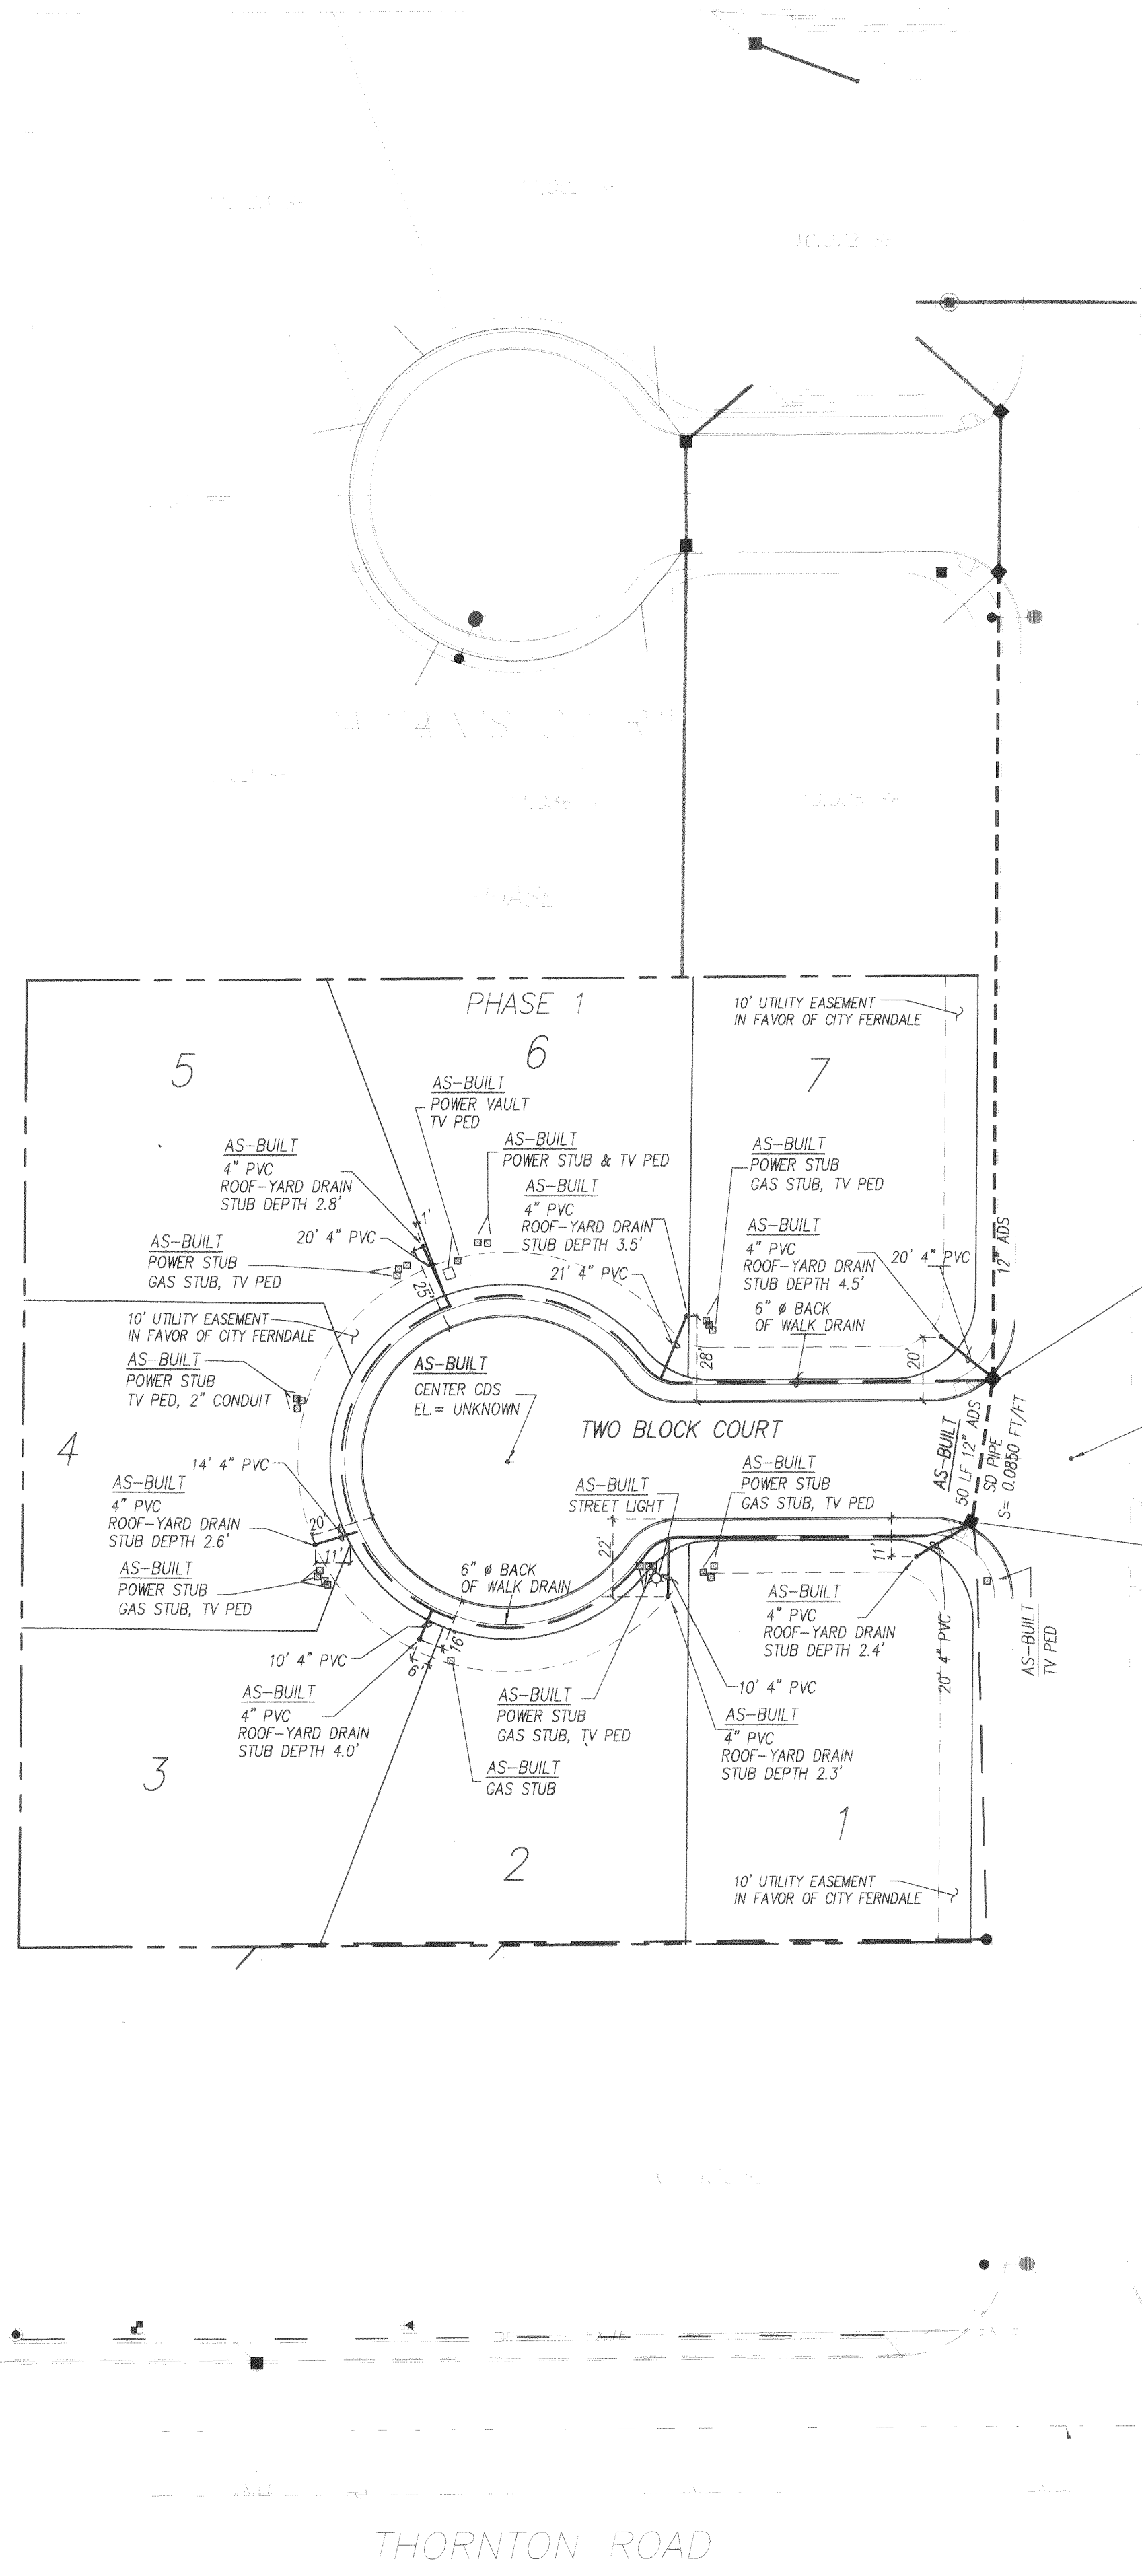


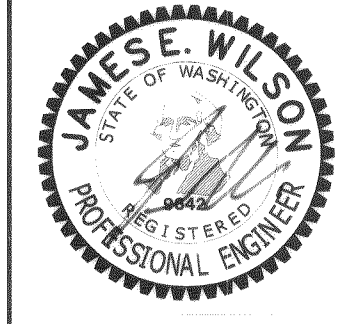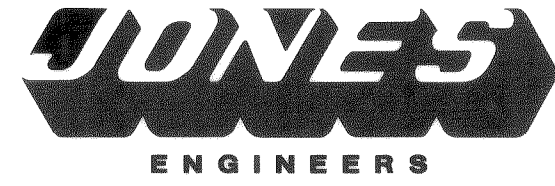DRAWN BY _____ DATE _____	SCHWARTZ PRELIMINARY PLAT	PROFESSIONAL CERTIFICATION I HEREBY CERTIFY THAT THIS DOCUMENT, CONSISTING OF PLANS, DESIGNS, AND SPECIFICATIONS, WAS PREPARED UNDER MY PERSONAL SUPERVISION, THAT IT IS THE SAME AS THE PLAN APPROVED BY THE CITY OF FERNDALE ENGINEERING DIVISION ON 4-28-05, AND THAT IT MEETS THE CITY OF FERNDALE CODES AND STANDARDS AND FURTHER THAT SAID PLANS MEET THE GENERALLY ACCEPTED STANDARDS OF PRACTICE WITHIN THE STATE OF WASHINGTON. <i>James E. Wilson</i> 11/22/05 JAMES E. WILSON, P.E., P.S.		 phone 360 733 8888 fax 360 671 6666 web jeliwa.com 4164 Meridian Street • Suite 200 • Bellingham, Washington 98226	SCHWARTZ SUBDIVISION AS-BUILT STREET PLAN, PROFILE AND UTILITIES	APPROVED FEB 22 2006 BY <i>[Signature]</i> CITY OF FERNDALE	SHEET 2 OF 5
CHECKED BY _____ DATE _____							
JOB # 04029	FOR: CAPTAIN ROGERS, T. SCHWARTZ						


U:\0-VR-04\04029-Schwartz\AS-Built\11-10-05\11-10-05-01\0101e AB-Sheet3 4-5.DWG Mod Nov 23 08:15:14 2005 J. Cox

00321.002 5:9:06 RL

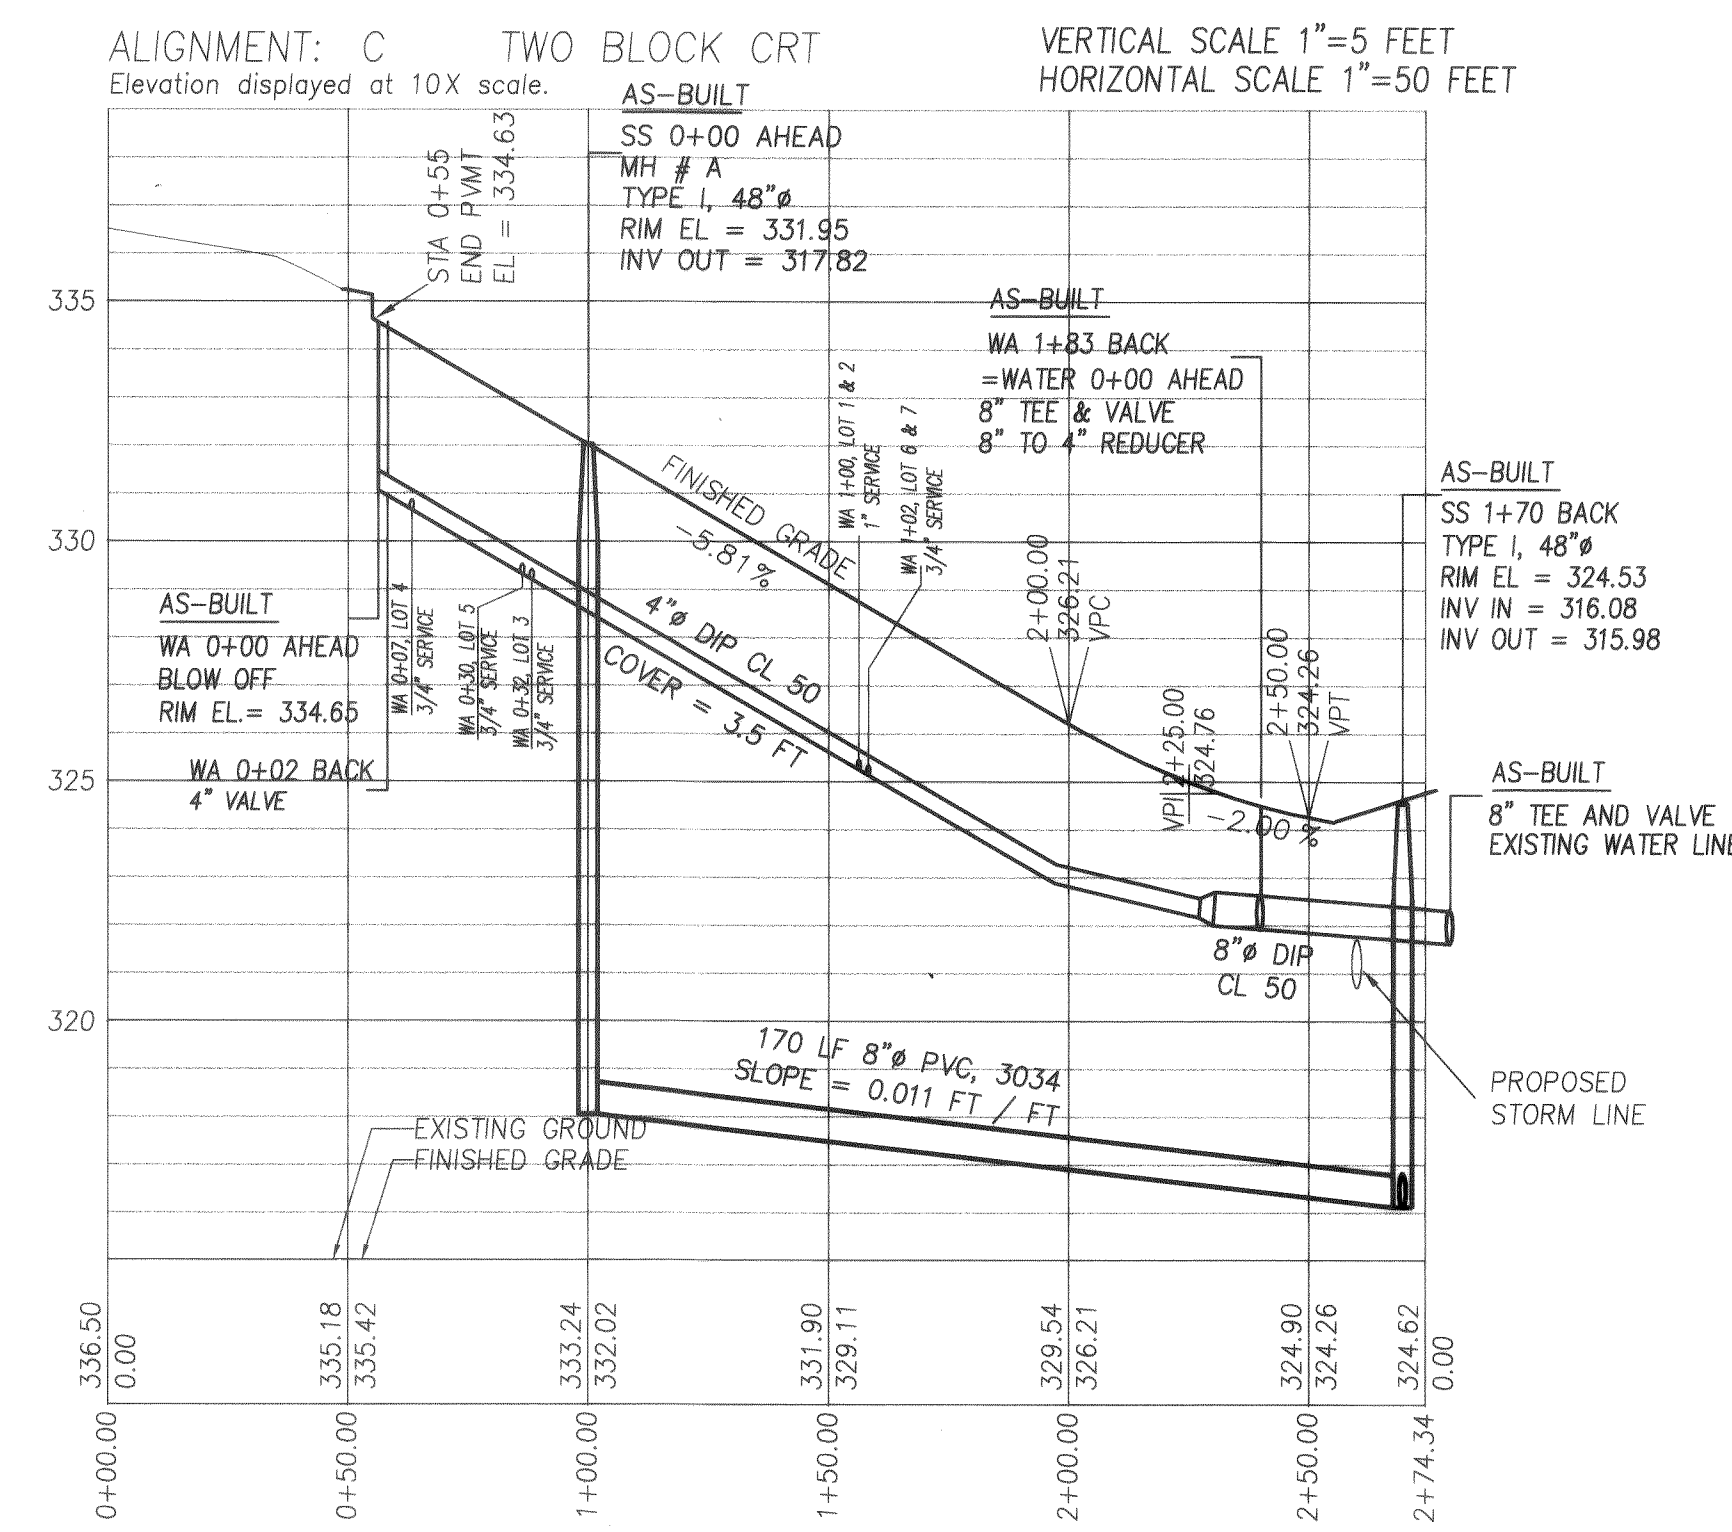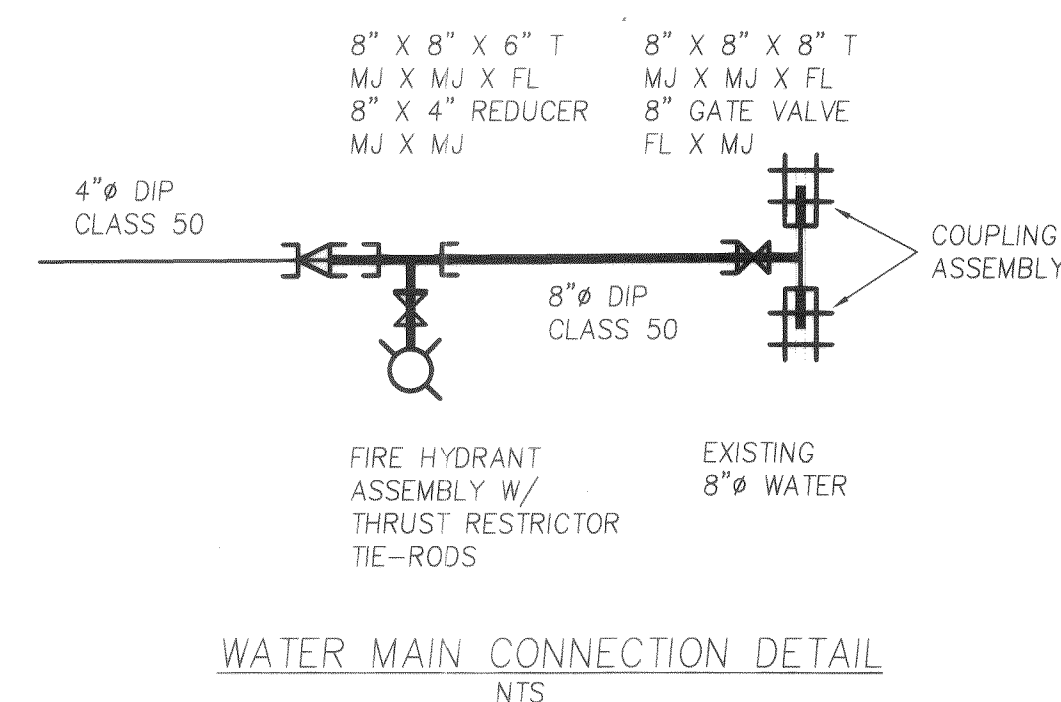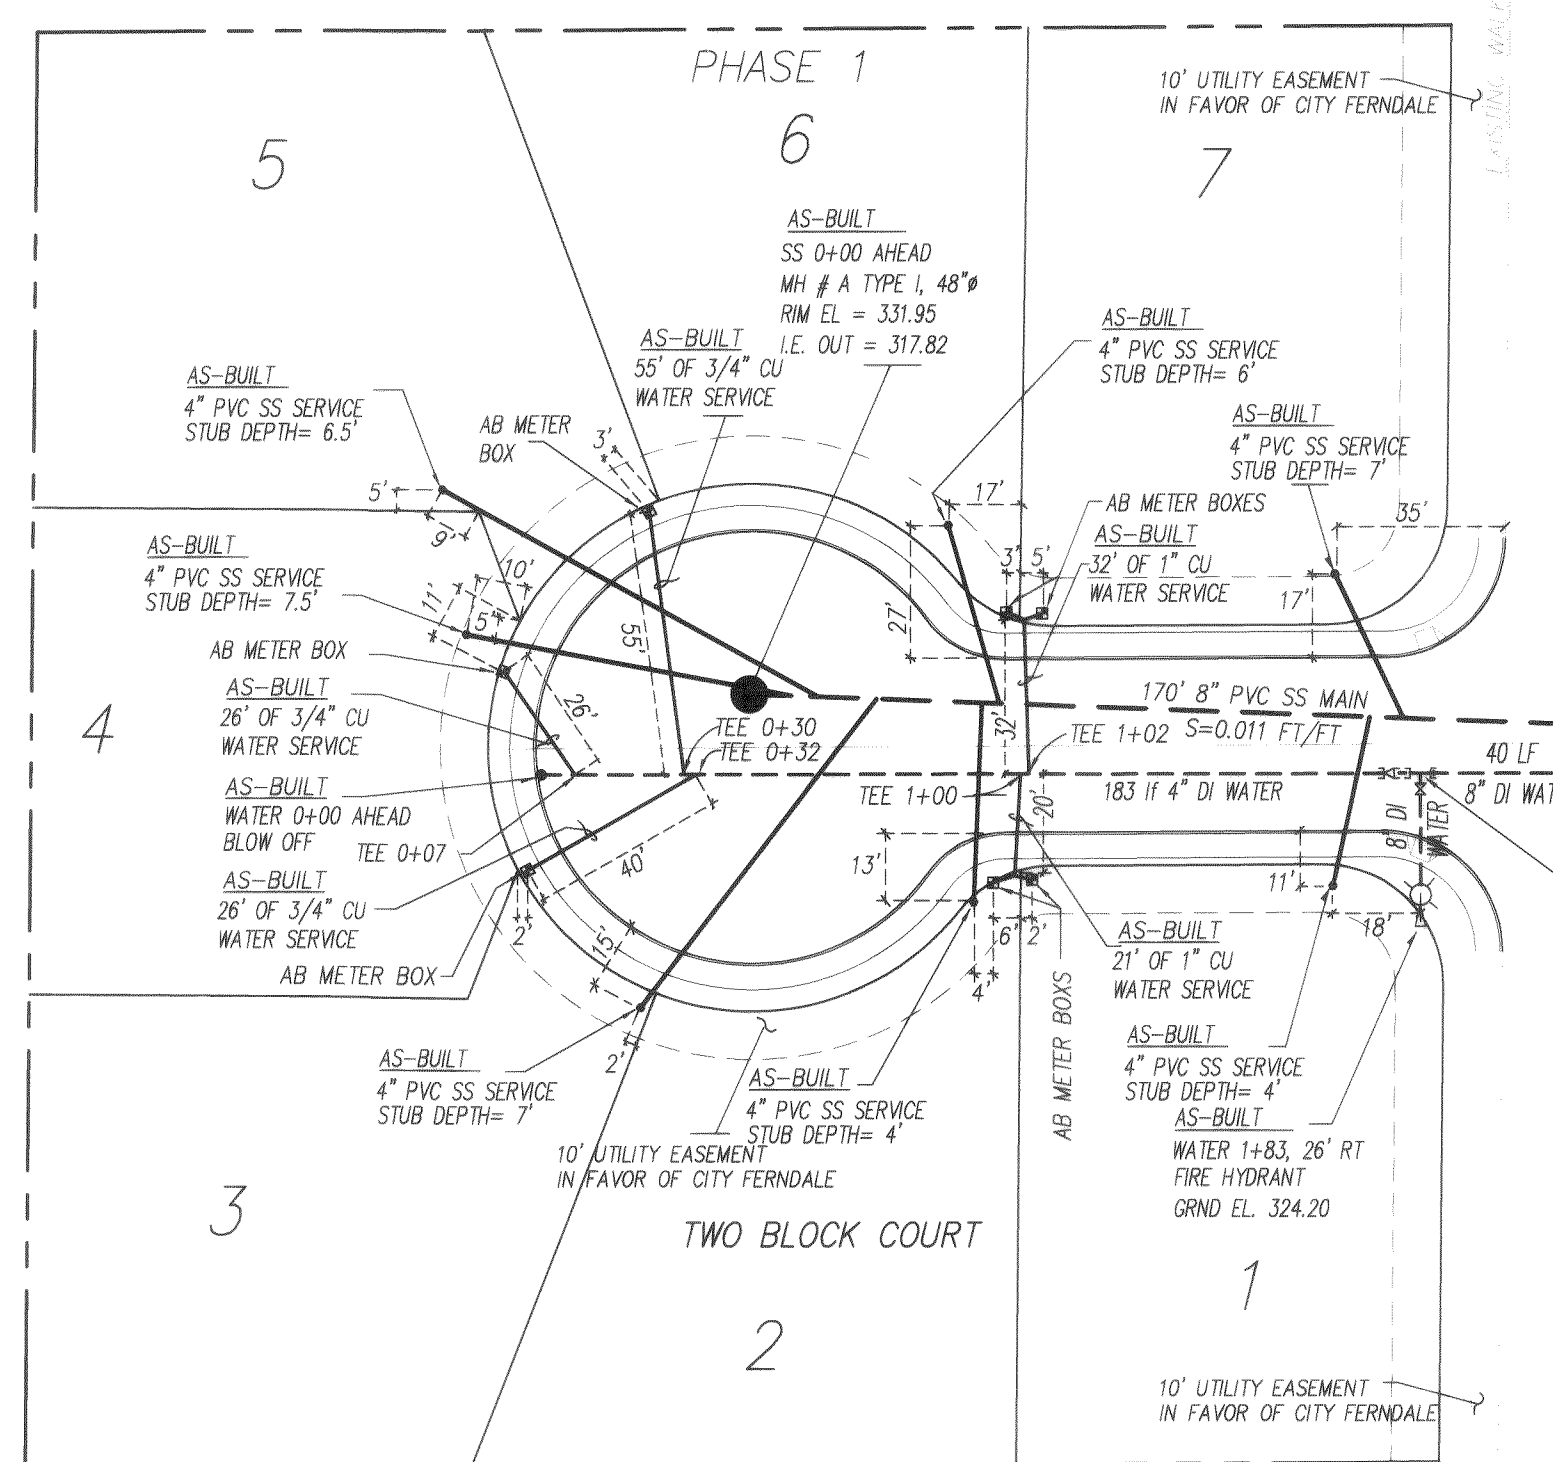


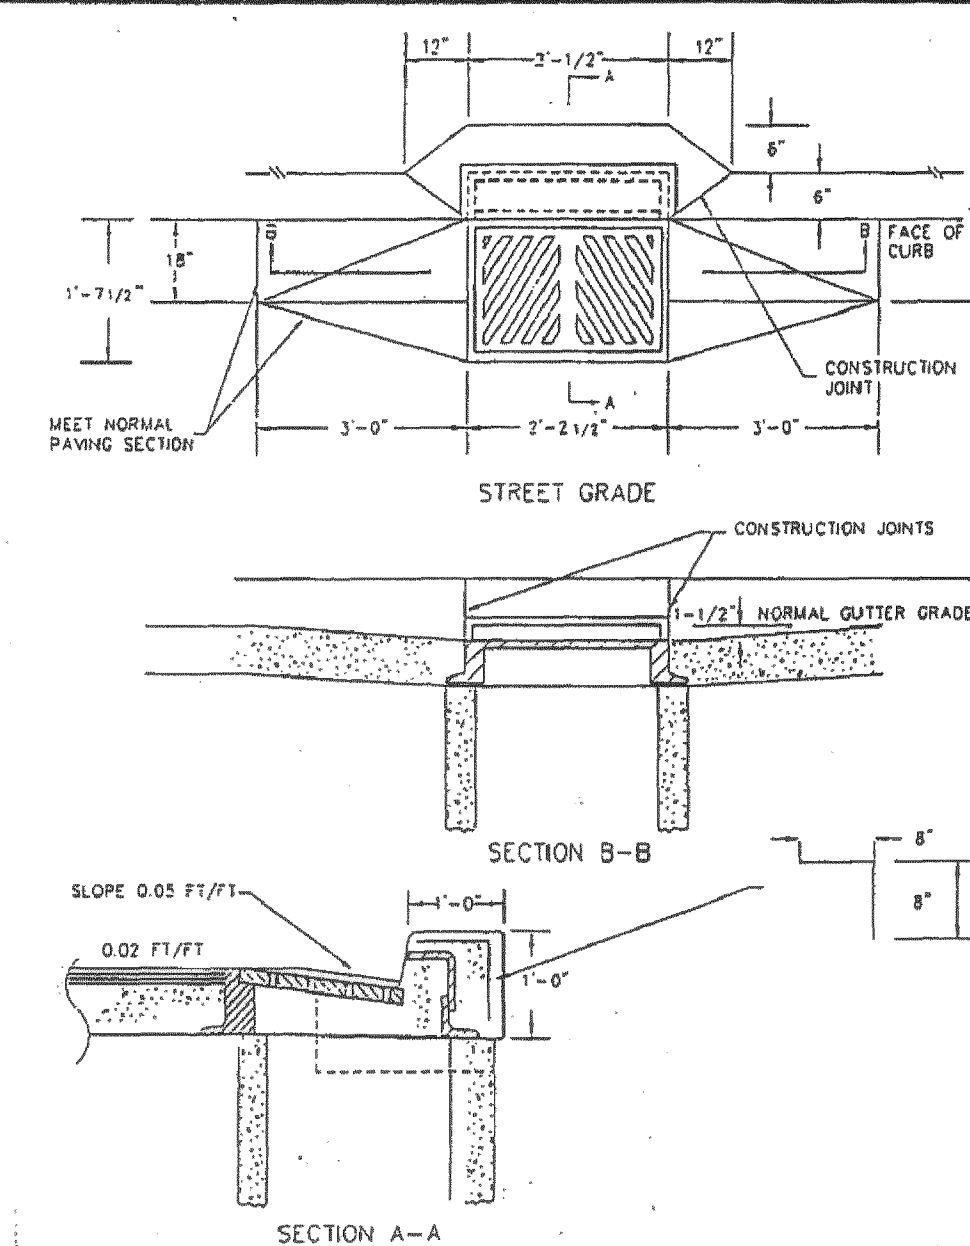


APPROVED
Public Works Director
CITY OF FERNDALE
THRU-CURB INLET FRAME & GRATE
WITH VERTICAL CURB INSTALLATION
DRAWING
R-8

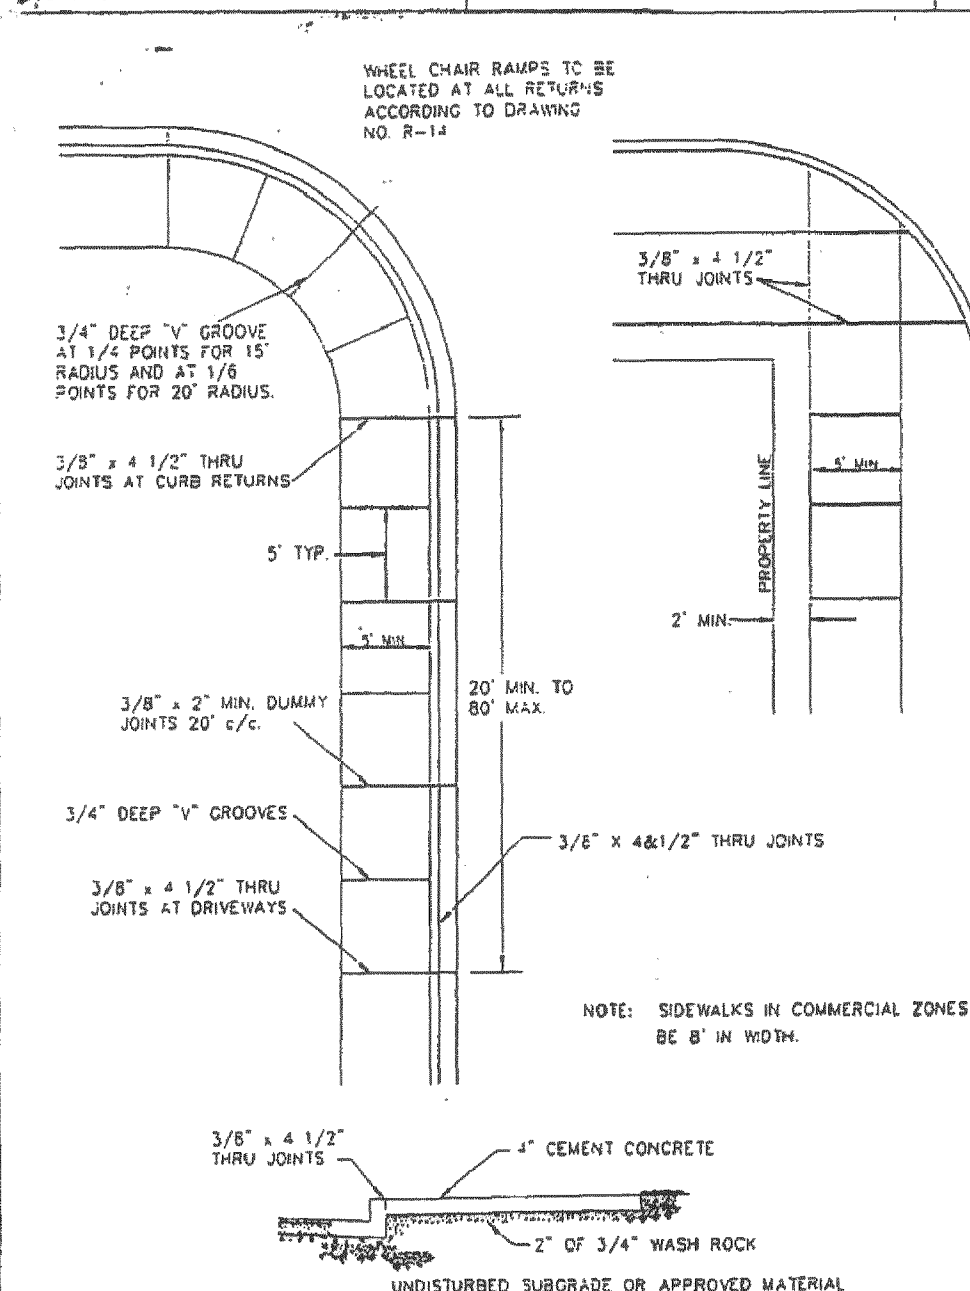


APPROVED
Public Works Director
CITY OF FERNDALE
TYPICAL SIDEWALK PLAN
AND CROSS SECTION
DRAWING
R-12

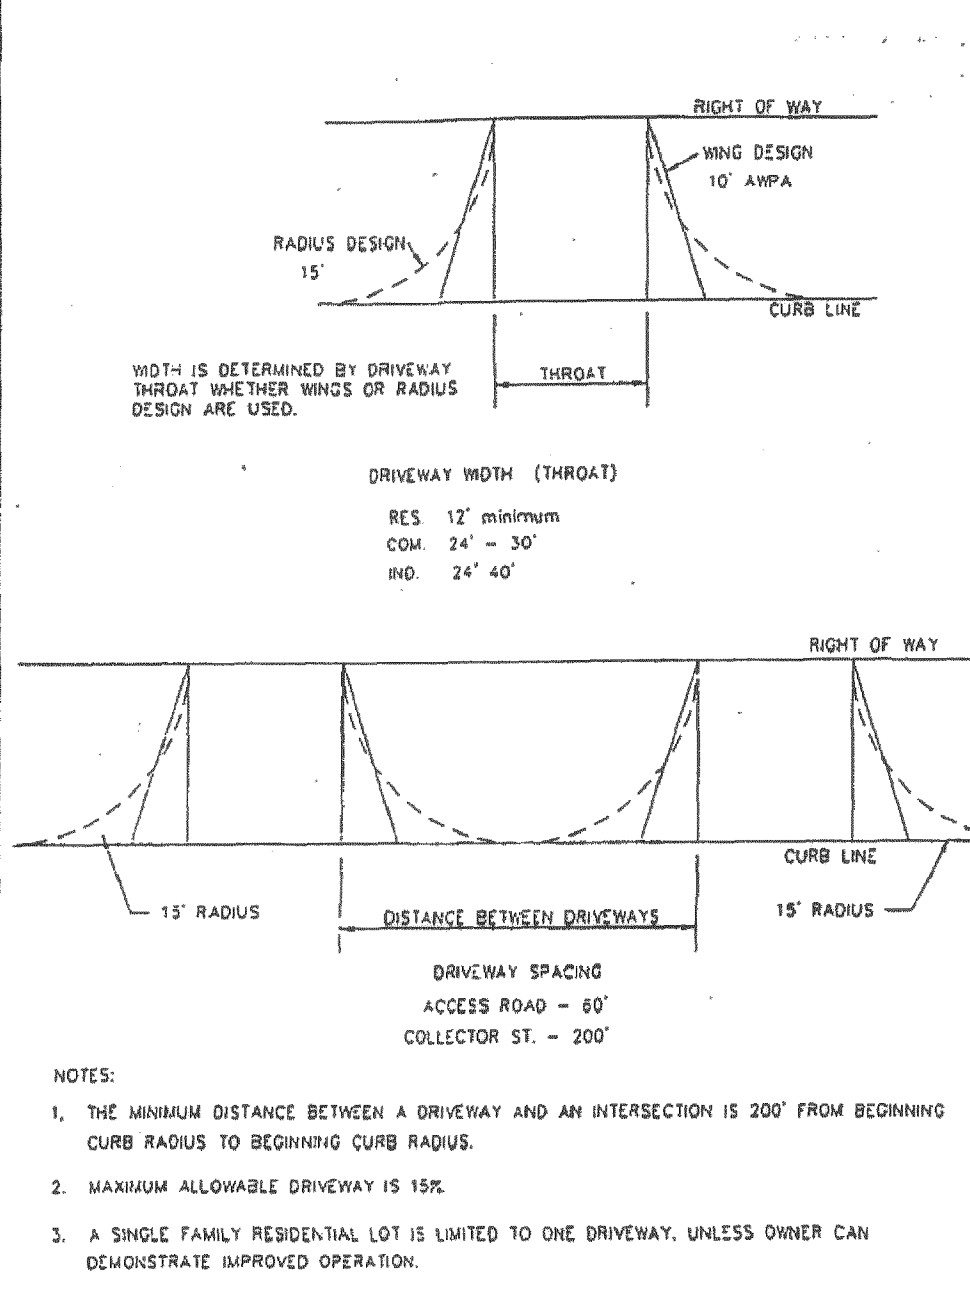


APPROVED
Public Works Director
CITY OF FERNDALE
DRIVEWAY WIDTH AND SPACING
DRAWING
R-16

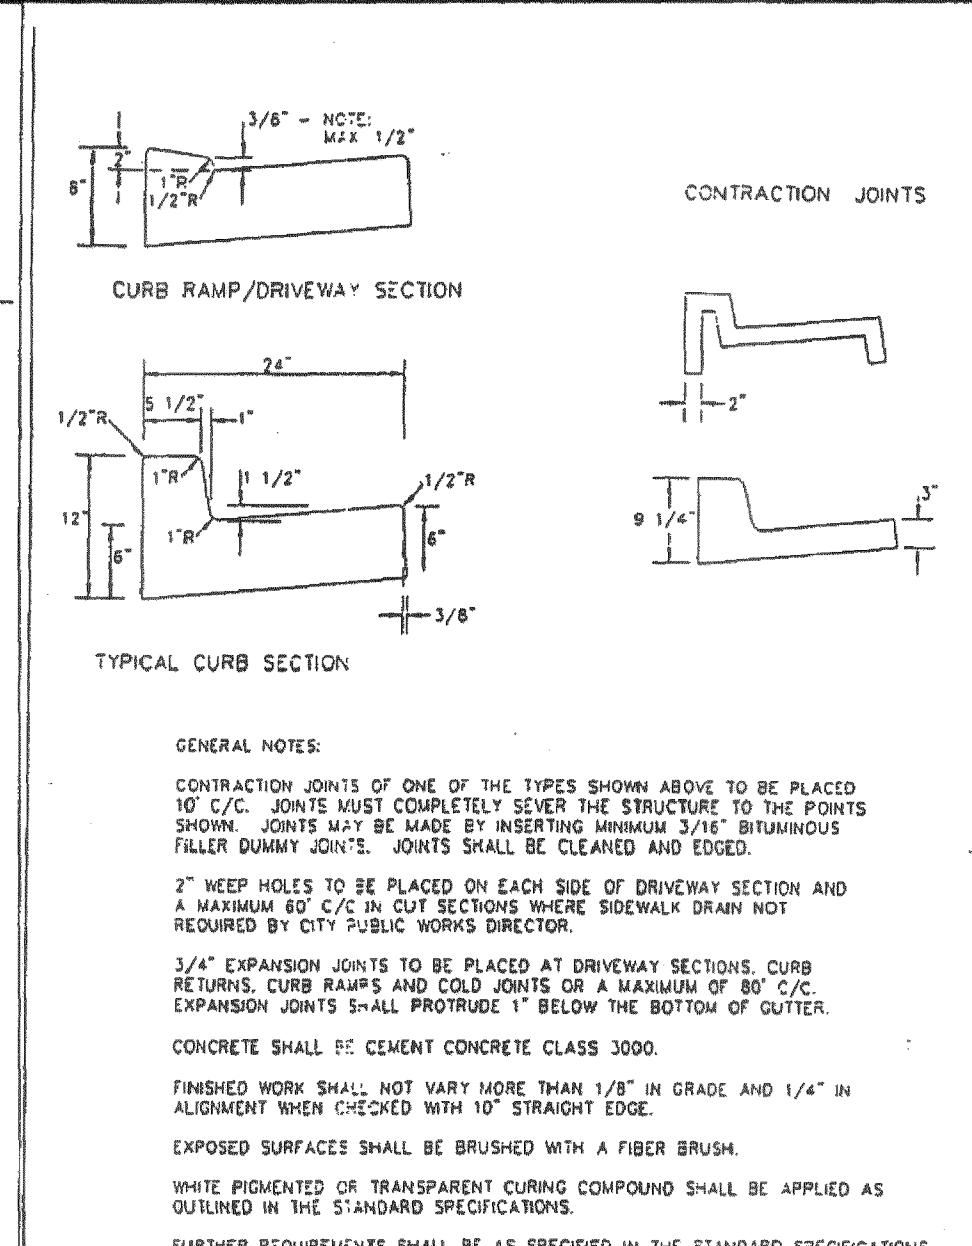


APPROVED
Public Works Director
CITY OF FERNDALE
CURB AND GUTTER
DRAWING
R-9

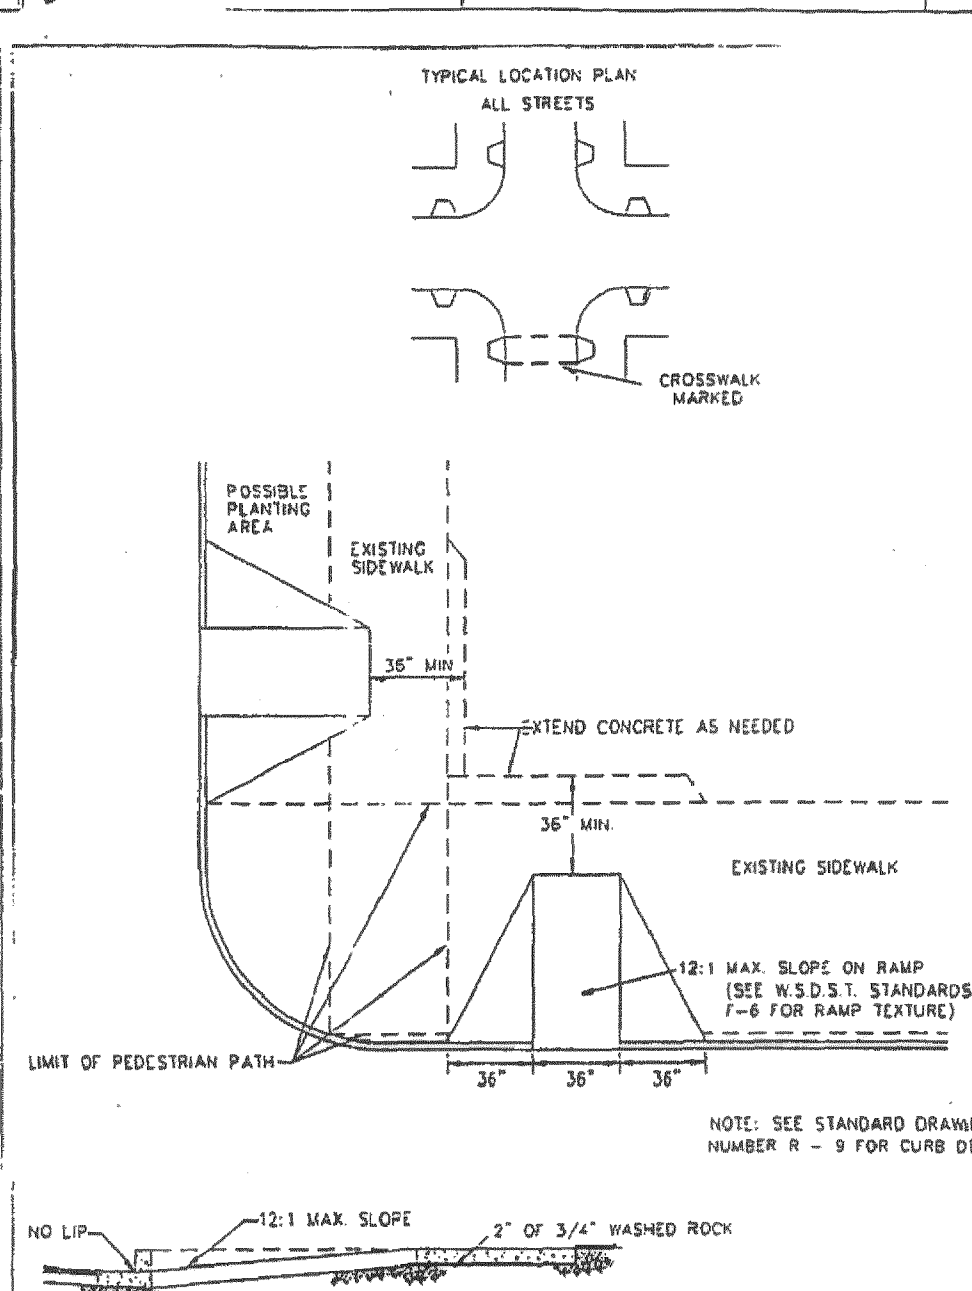


APPROVED
Public Works Director
CITY OF FERNDALE
MINIMUM STANDARD
CURB RAMP
DRAWING
R-14

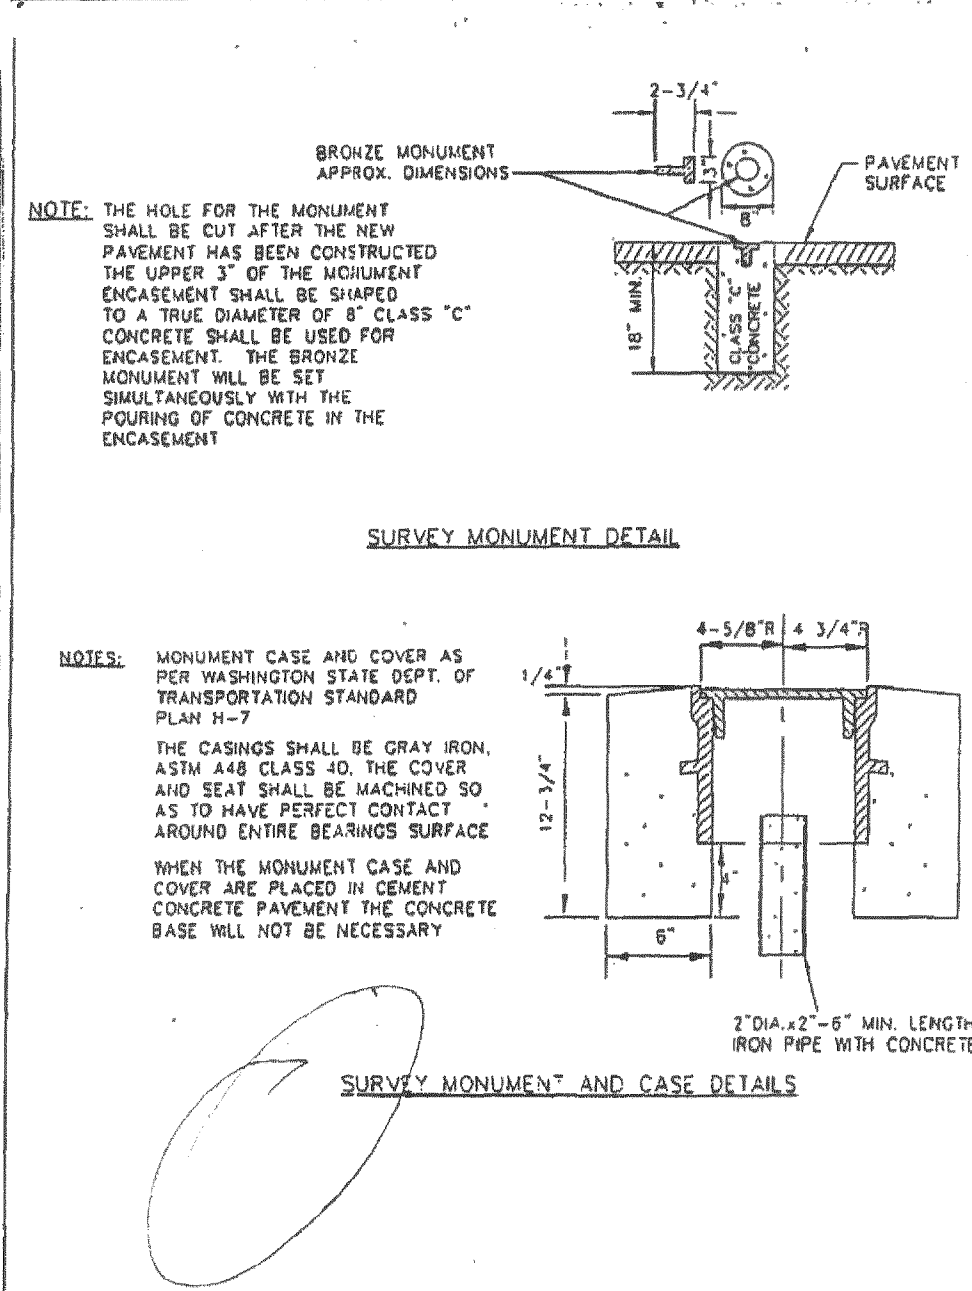


APPROVED
Public Works Director
CITY OF FERNDALE
SURVEY MONUMENTS
FOR ON-ROAD USE
DRAWING
S-2

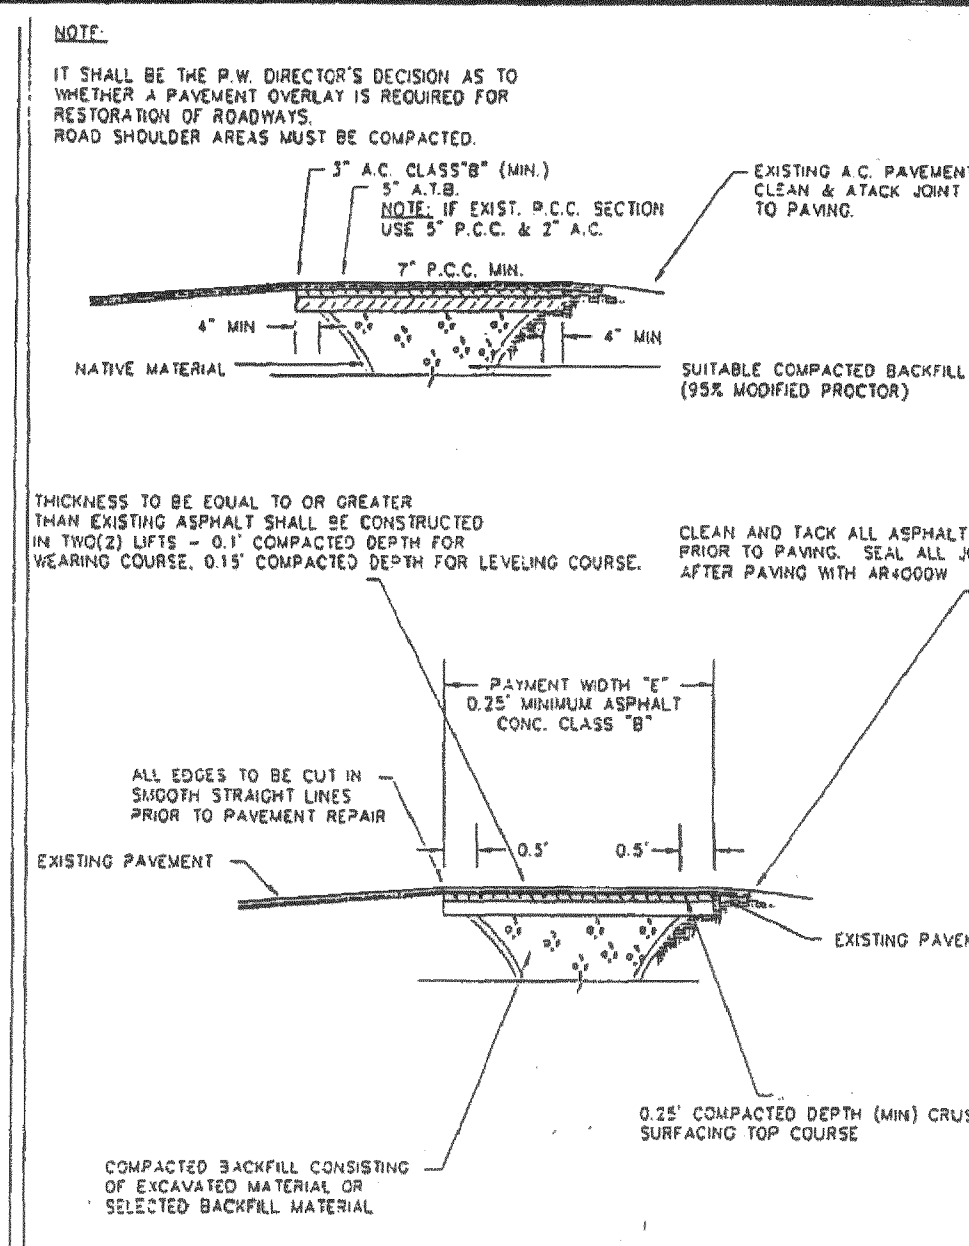


APPROVED
Public Works Director
CITY OF FERNDALE
EXISTING ROADWAY
RESTORATION REPAIR
DRAWING
R-11

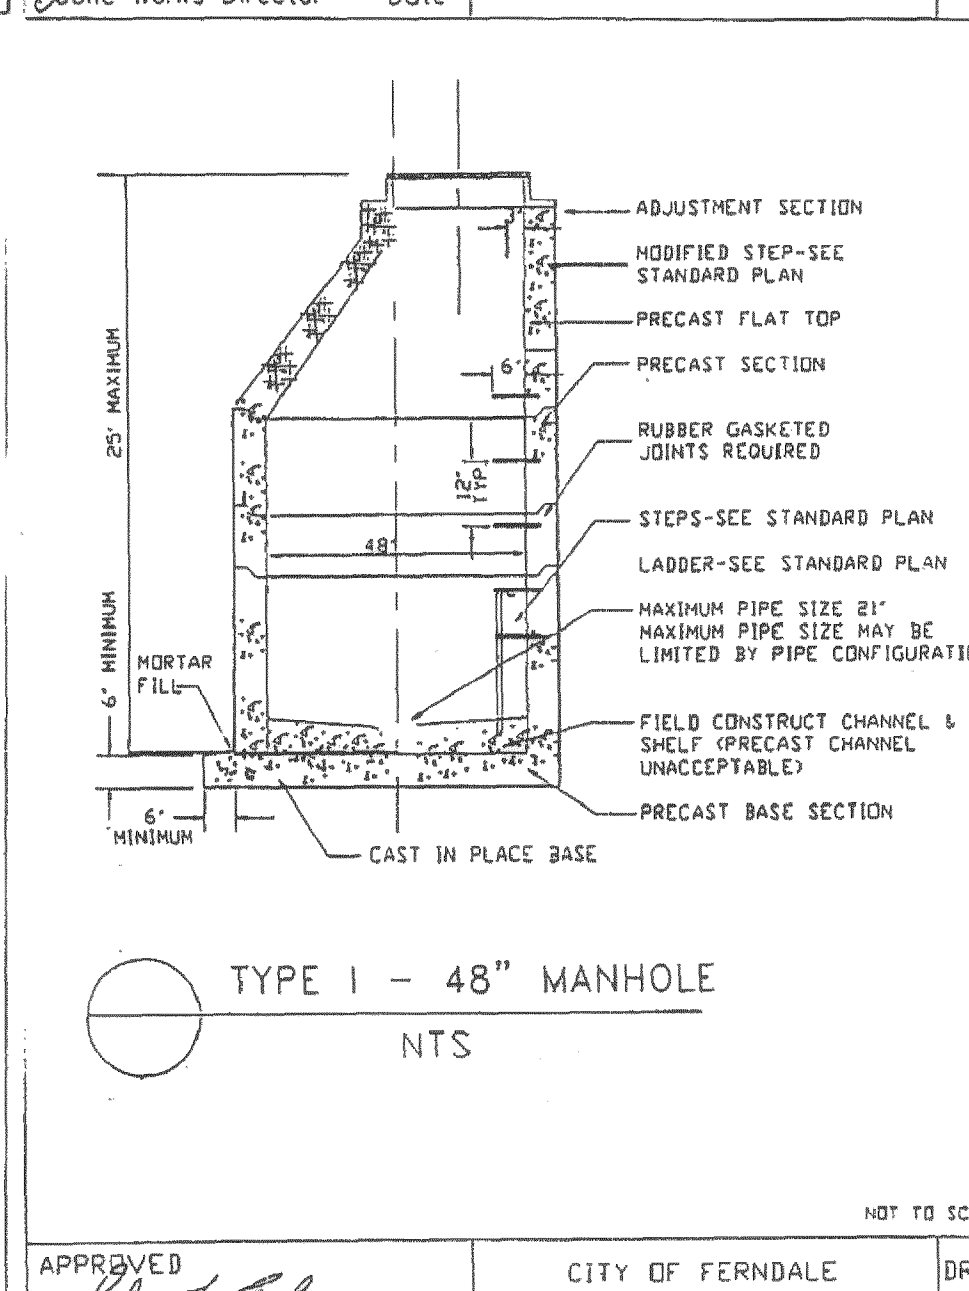


APPROVED
Public Works Director
CITY OF FERNDALE
TYPE I 48\"/>

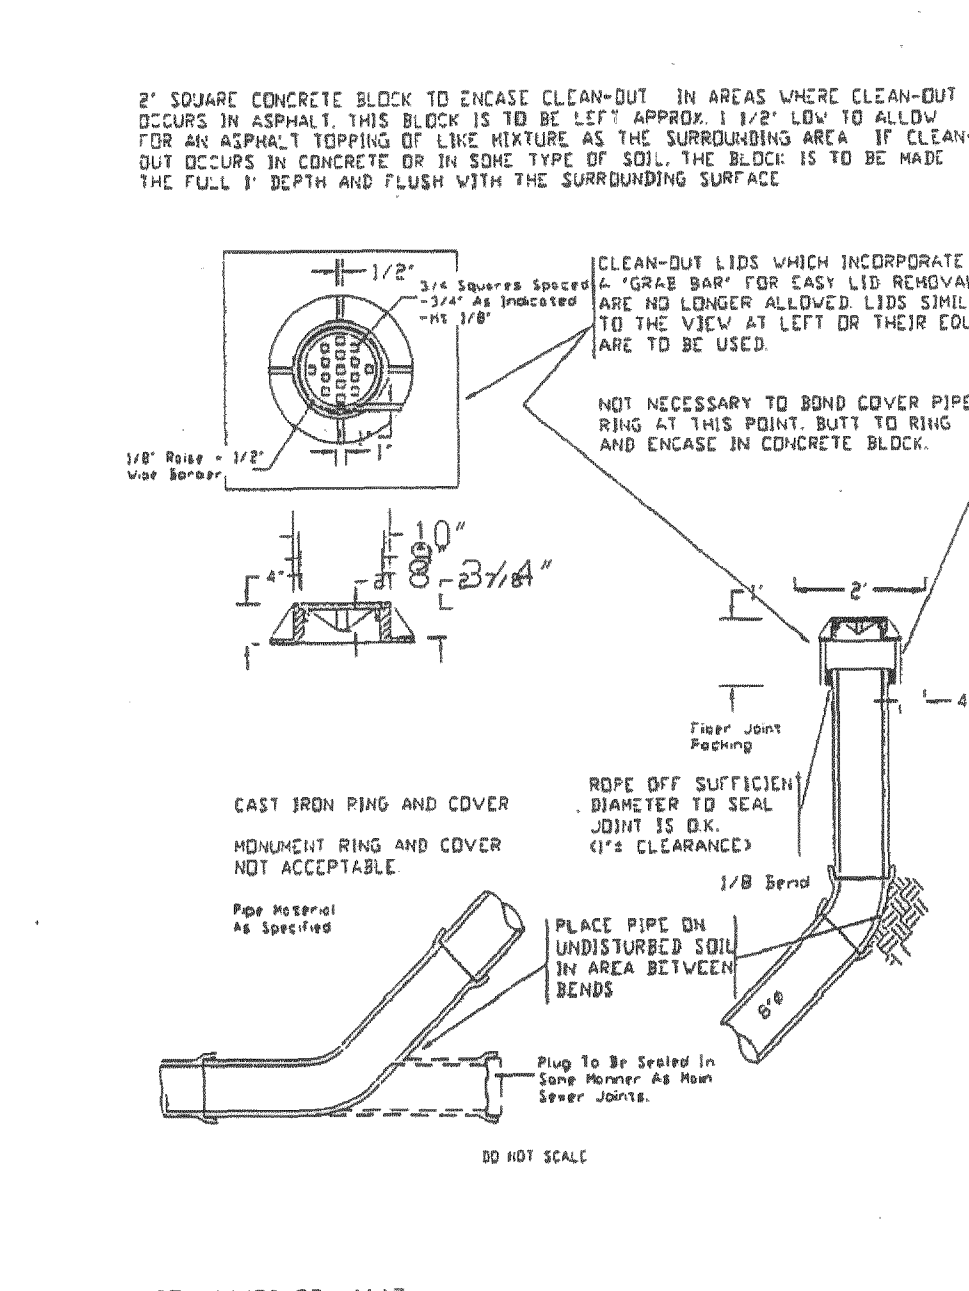


APPROVED
Public Works Director
CITY OF FERNDALE
8\"/>

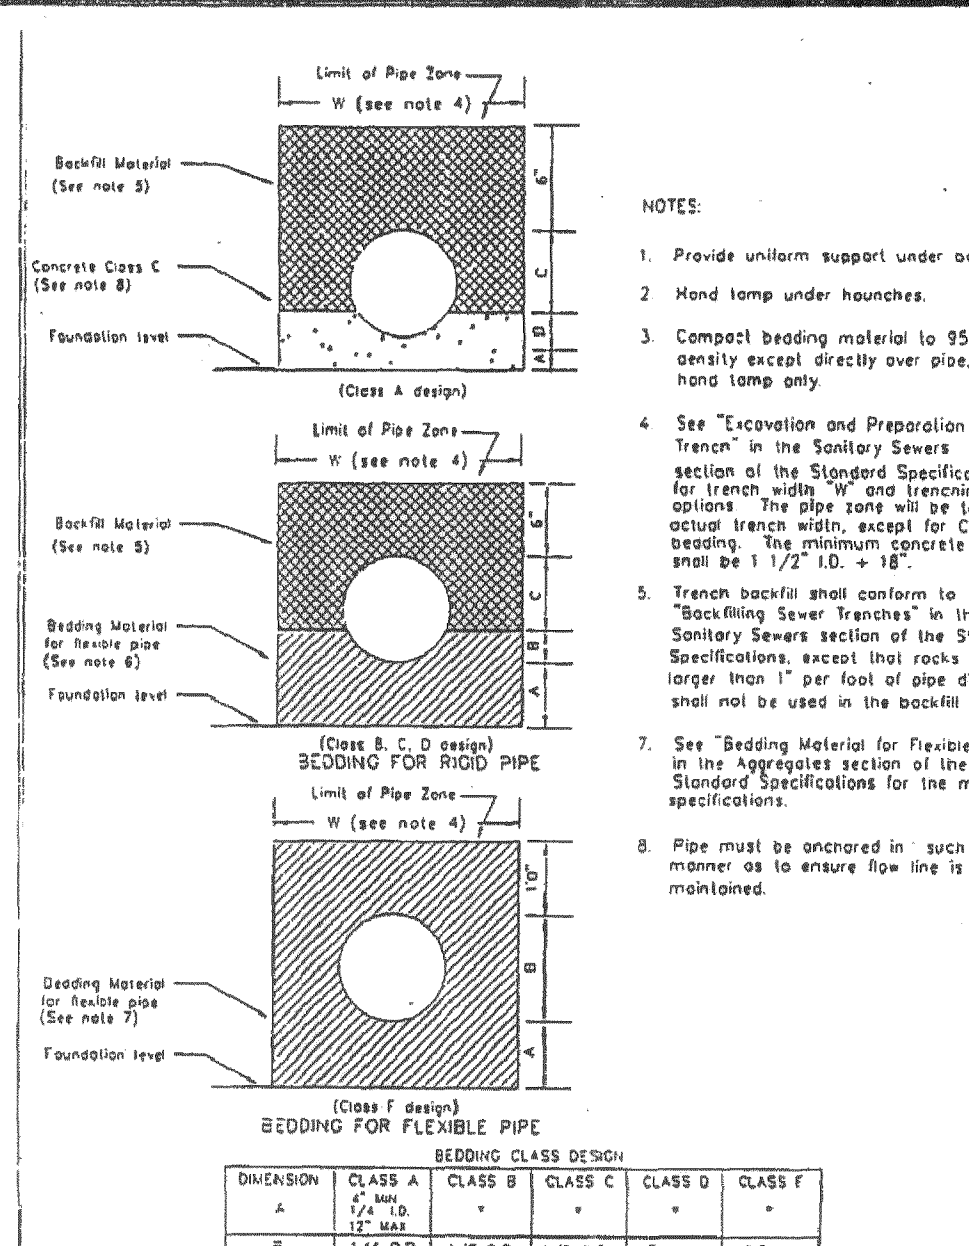


APPROVED
Public Works Director
CITY OF FERNDALE
PIPE BEDDING FOR
SANITARY SEWERS
DRAWING
SS-1

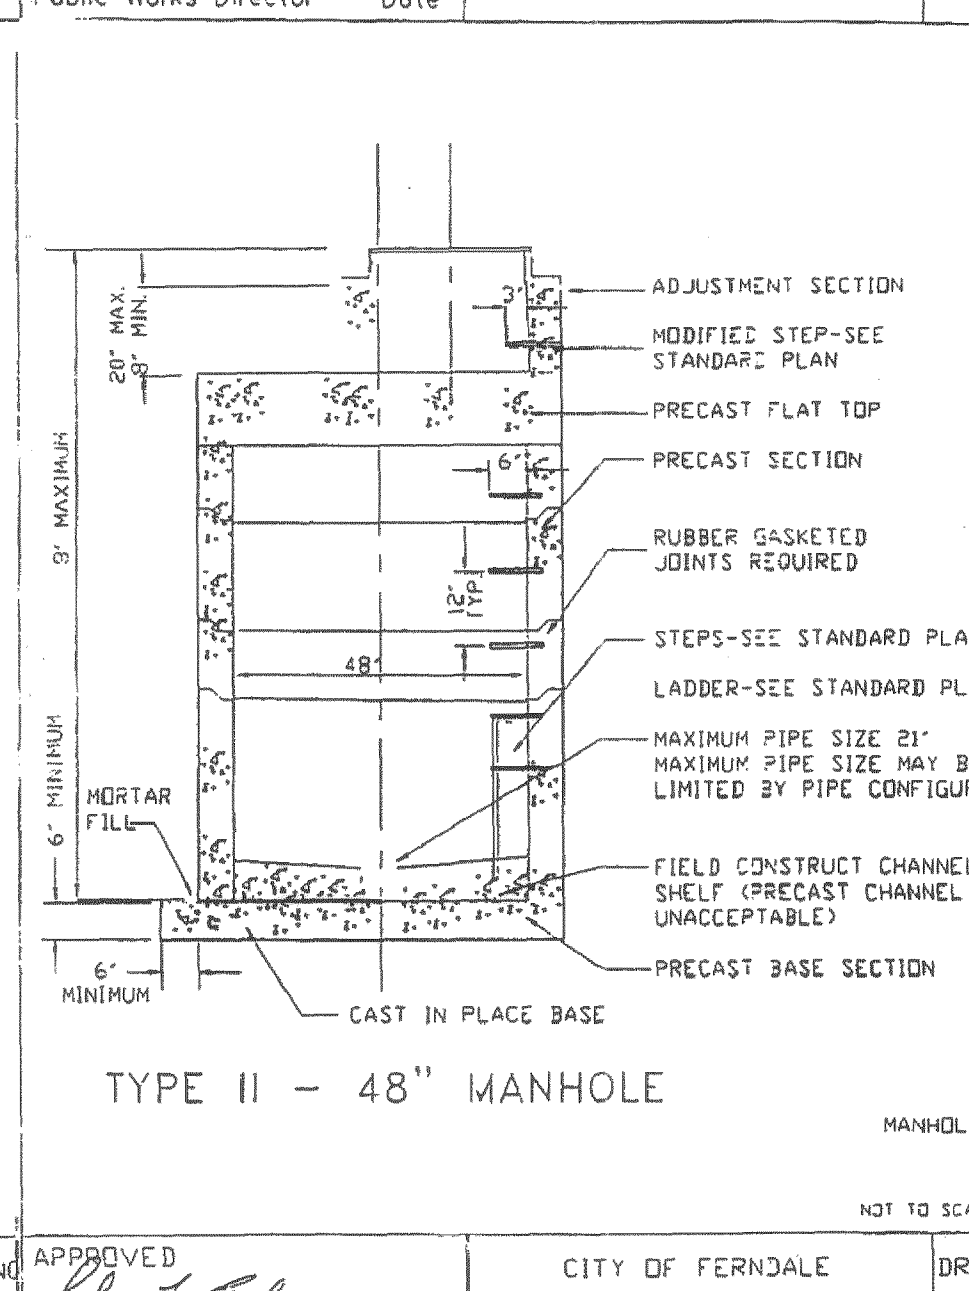


APPROVED
Public Works Director
CITY OF FERNDALE
TYPE II 48\"/>

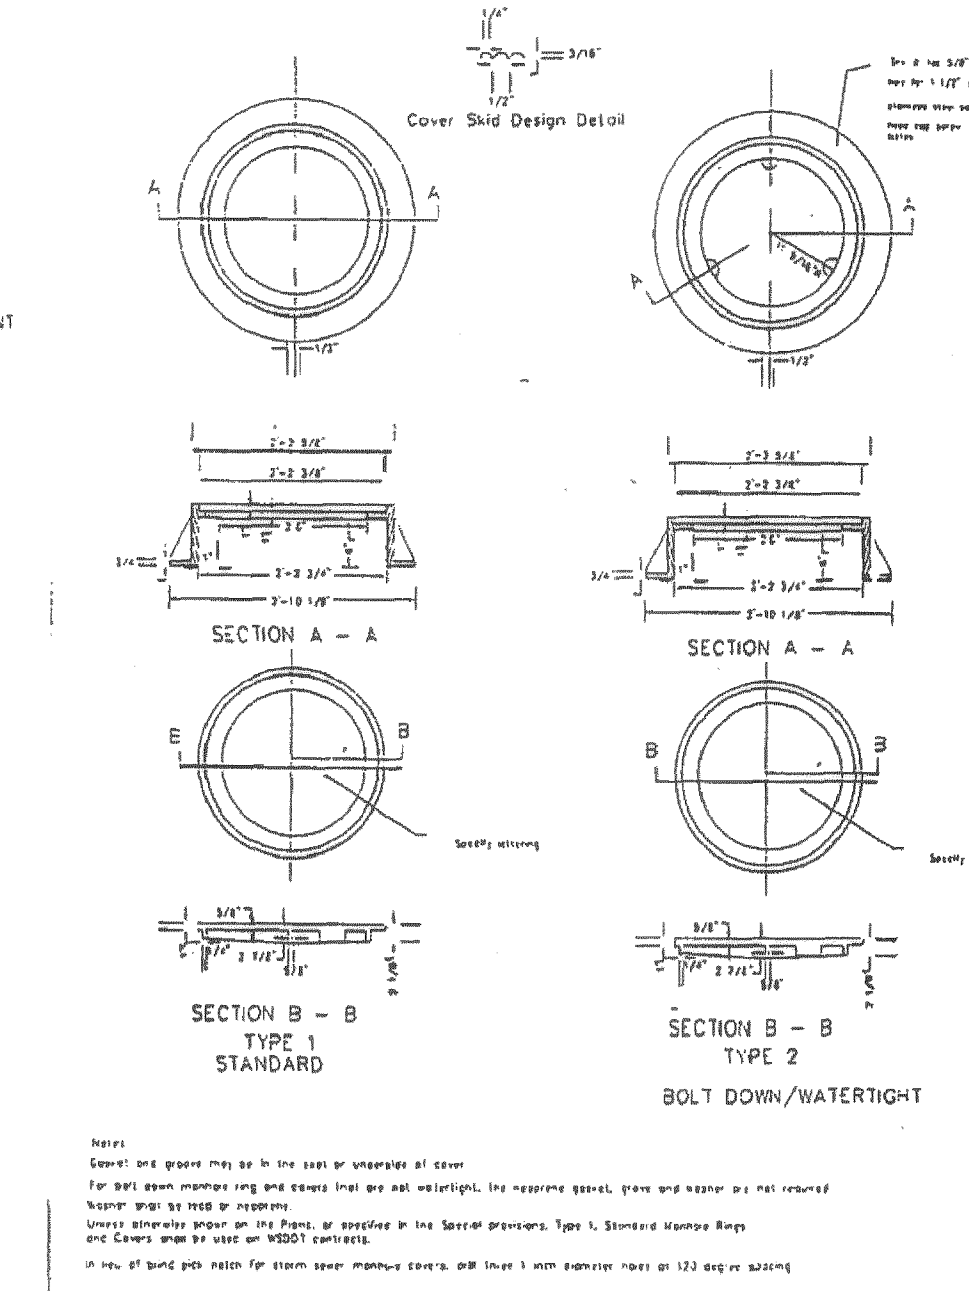


APPROVED
Public Works Director
CITY OF FERNDALE
MANHOLE RING & COVER
DRAWING
SS-9

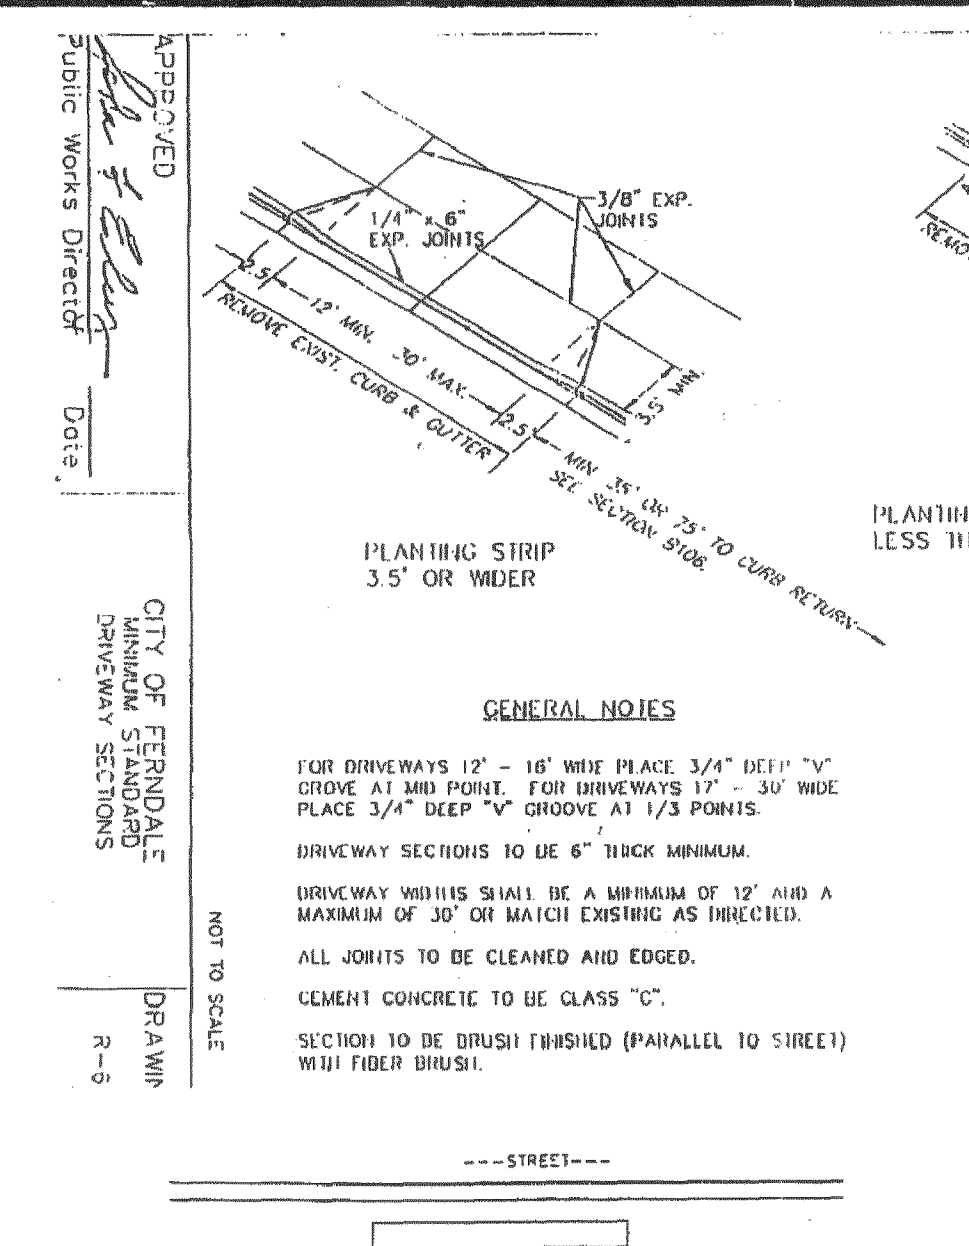


APPROVED
Public Works Director
CITY OF FERNDALE
MAILBOX STANDARD
DRAWING
M-1

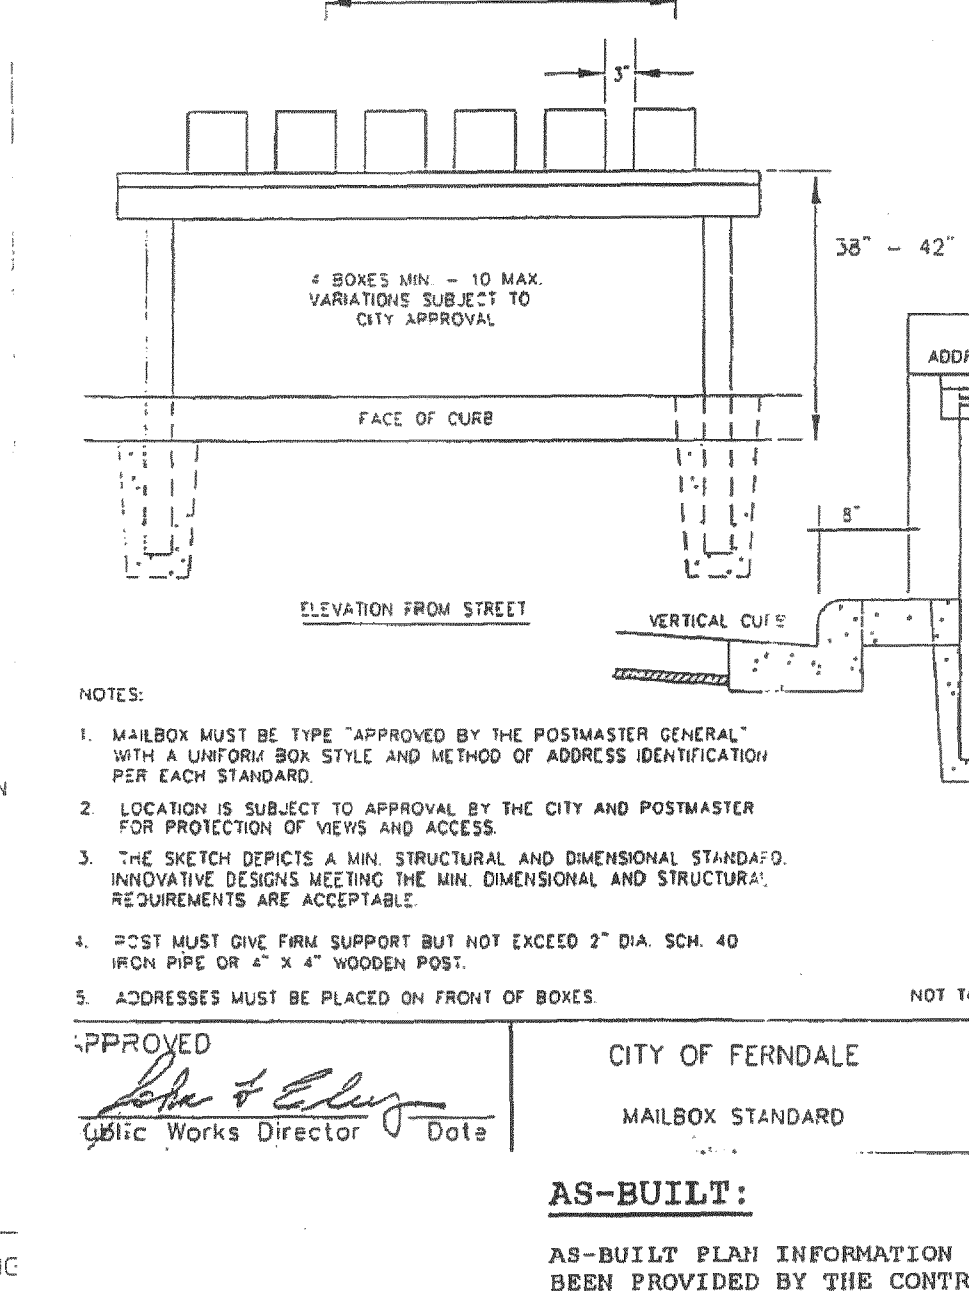


APPROVED
Public Works Director
CITY OF FERNDALE
SIDEWALK DRAIN
DRAWING
ST-15

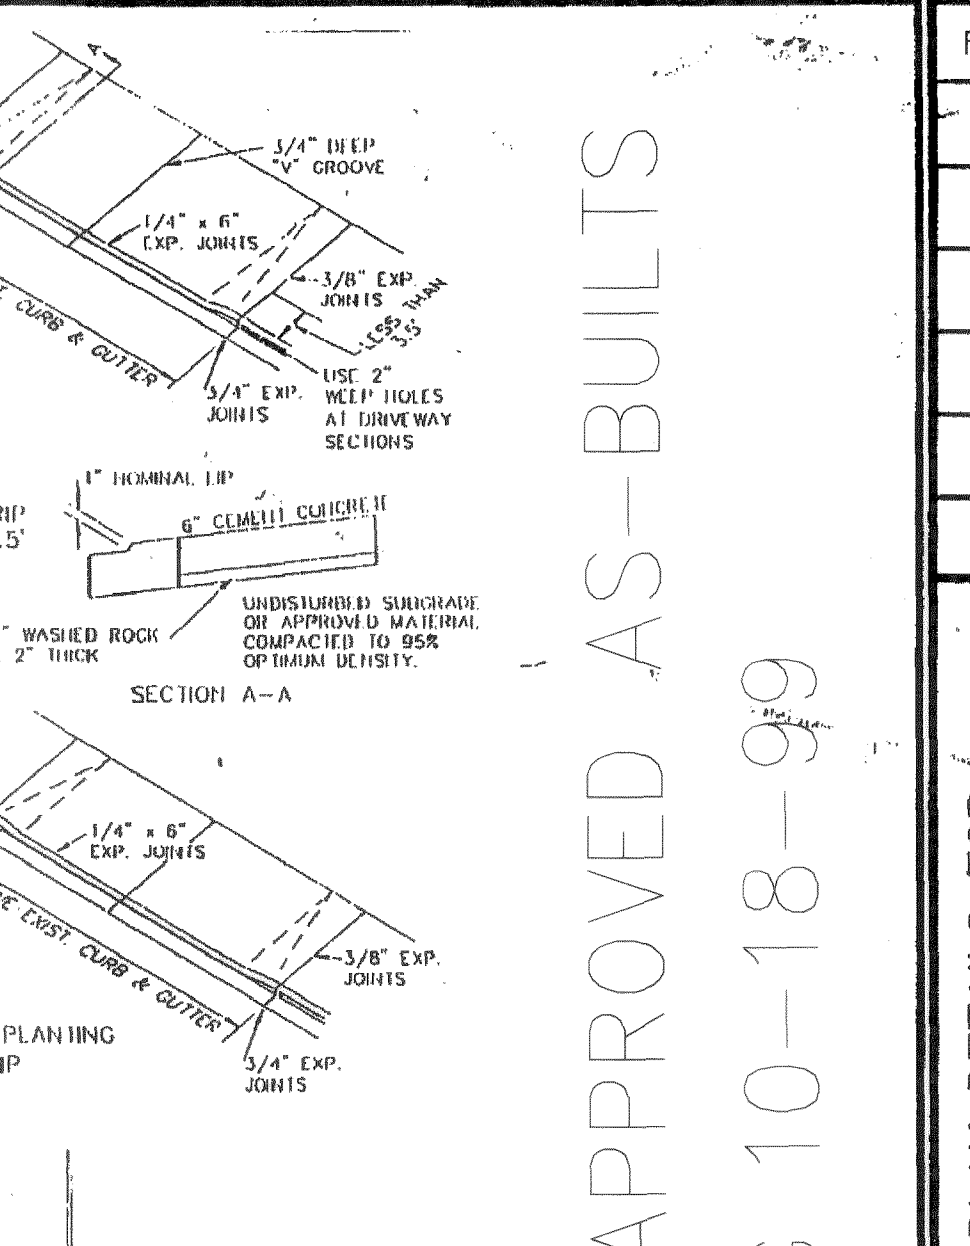


APPROVED
Public Works Director
CITY OF FERNDALE
SIDEWALK DRAIN
DRAWING
ST-15

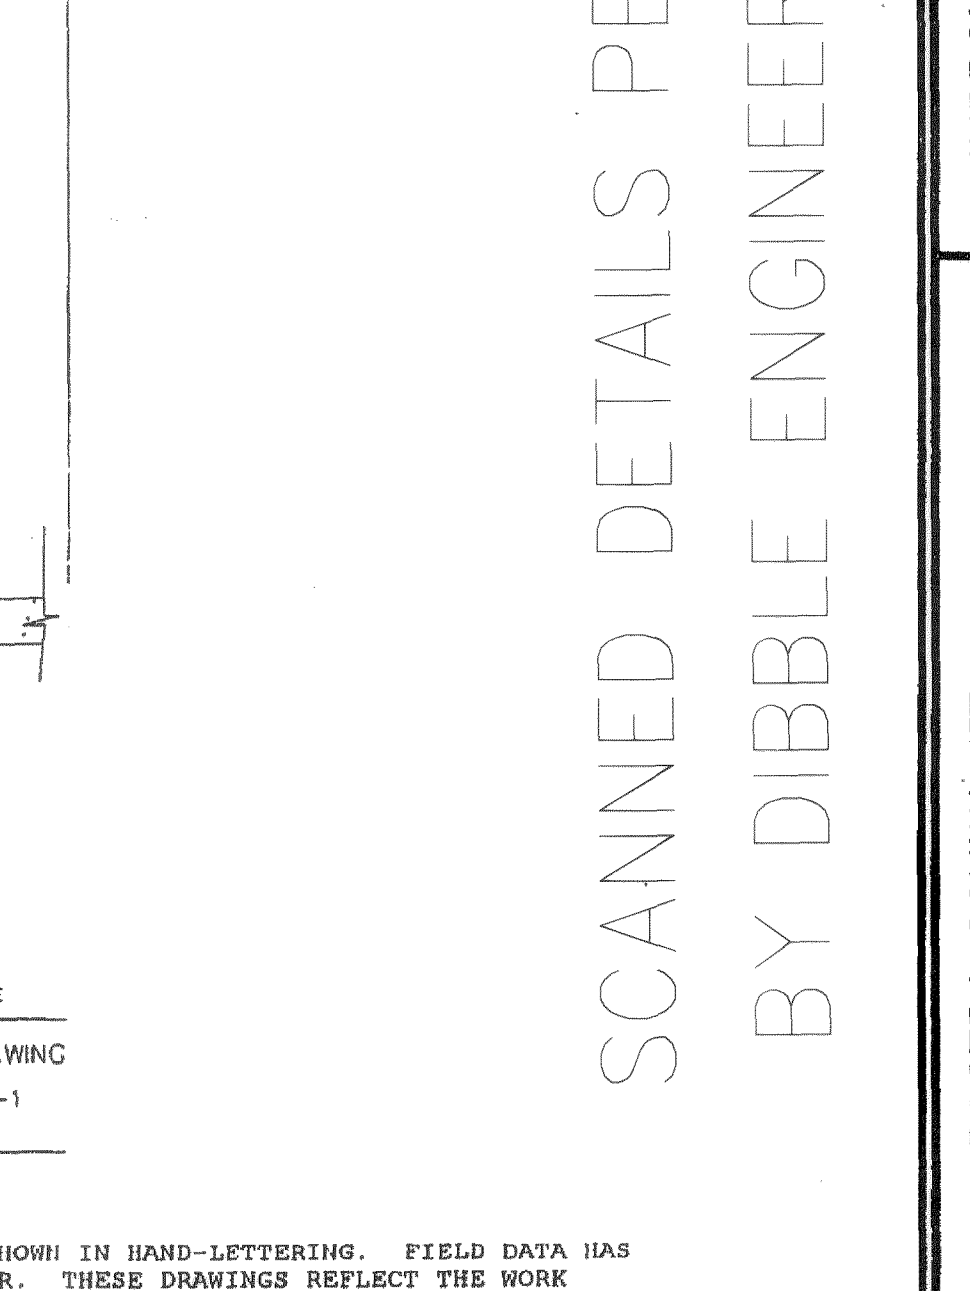


APPROVED
Public Works Director
CITY OF FERNDALE
SIDEWALK DRAIN
DRAWING
ST-15

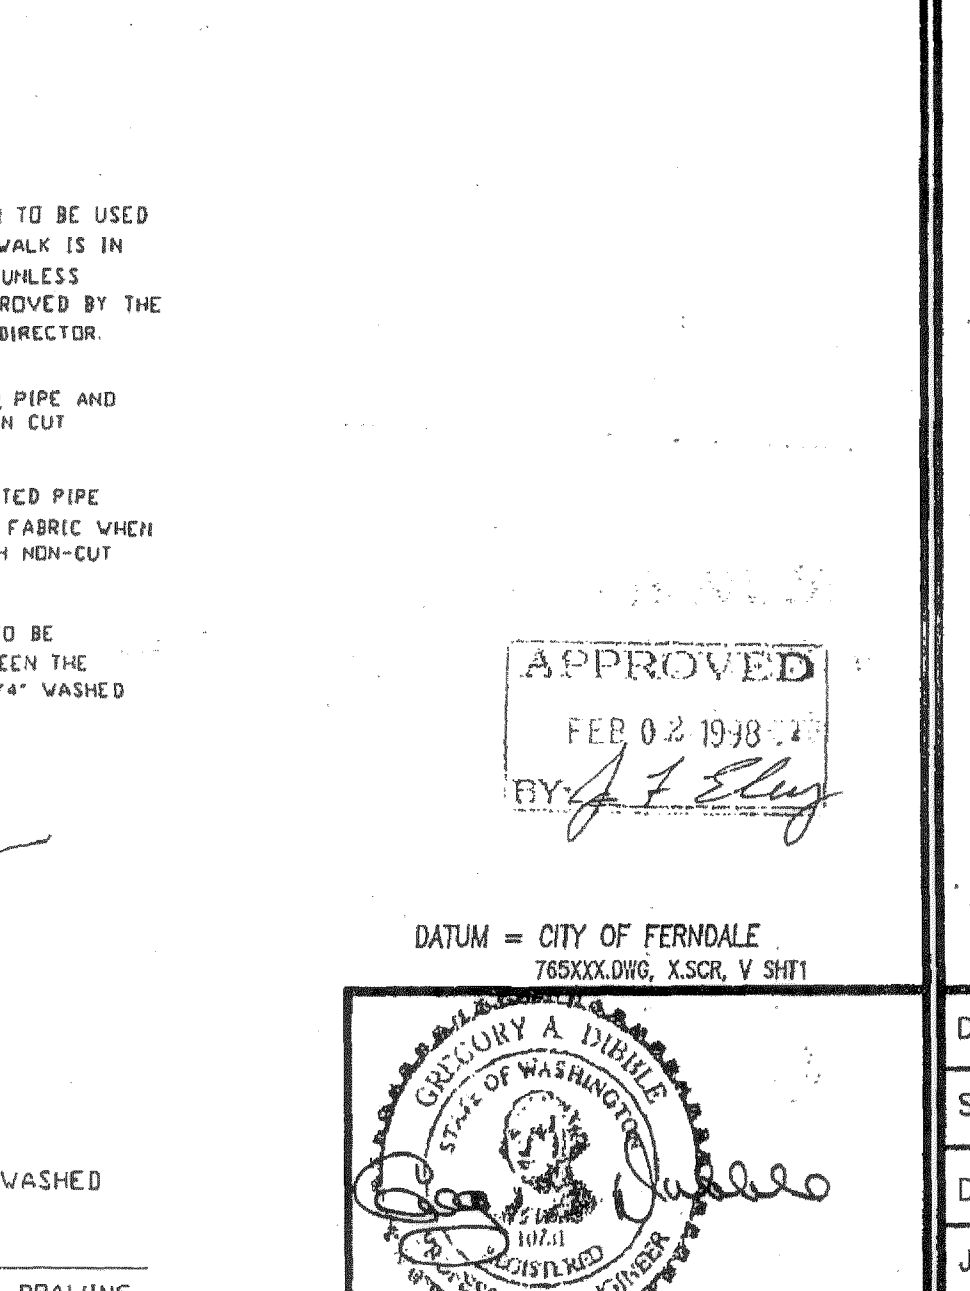


APPROVED
Public Works Director
CITY OF FERNDALE
SIDEWALK DRAIN
DRAWING
ST-15

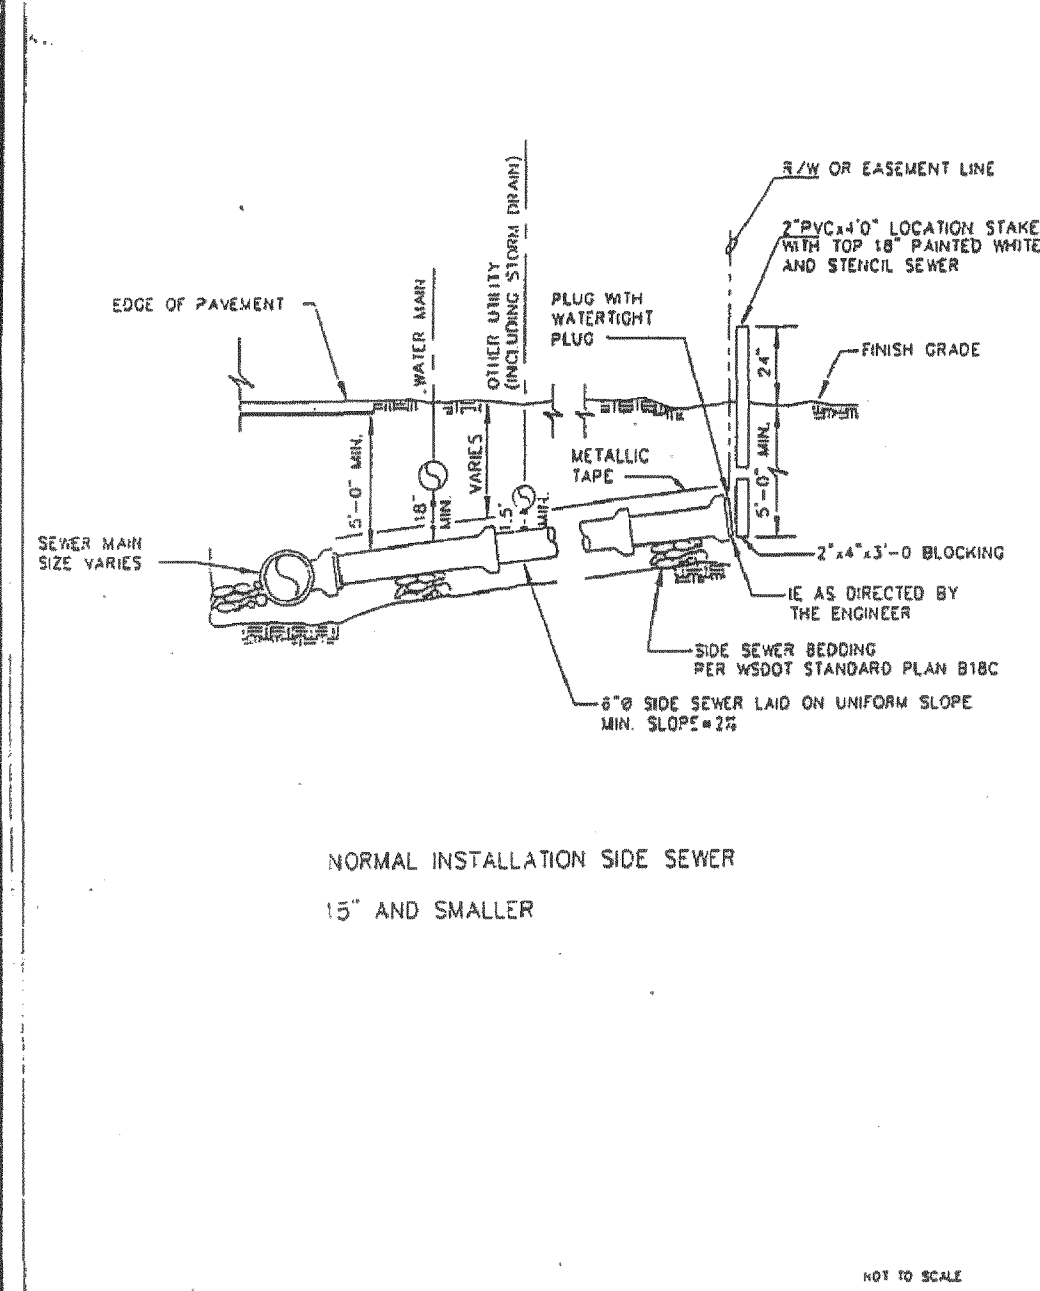


APPROVED *John & Elly* CITY OF FERNDALE DRAWING SS-8
Public Works Director Date 15" AND SMALLER SEWER MAINS

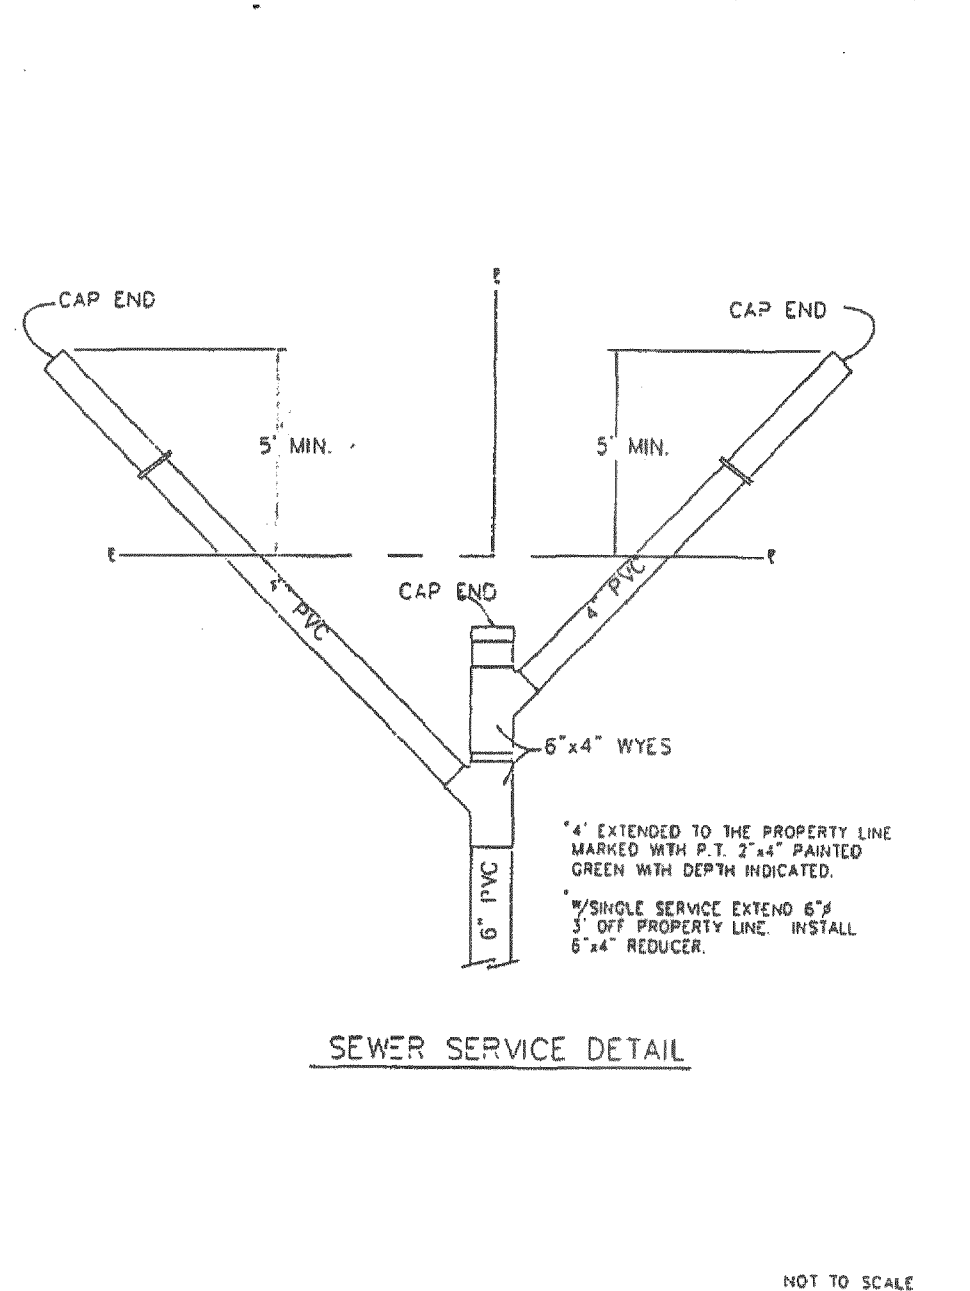


APPROVED *John & Elly* CITY OF FERNDALE DRAWING SS-13
Public Works Director Date DOUBLE SANITARY SEWER SERVICE

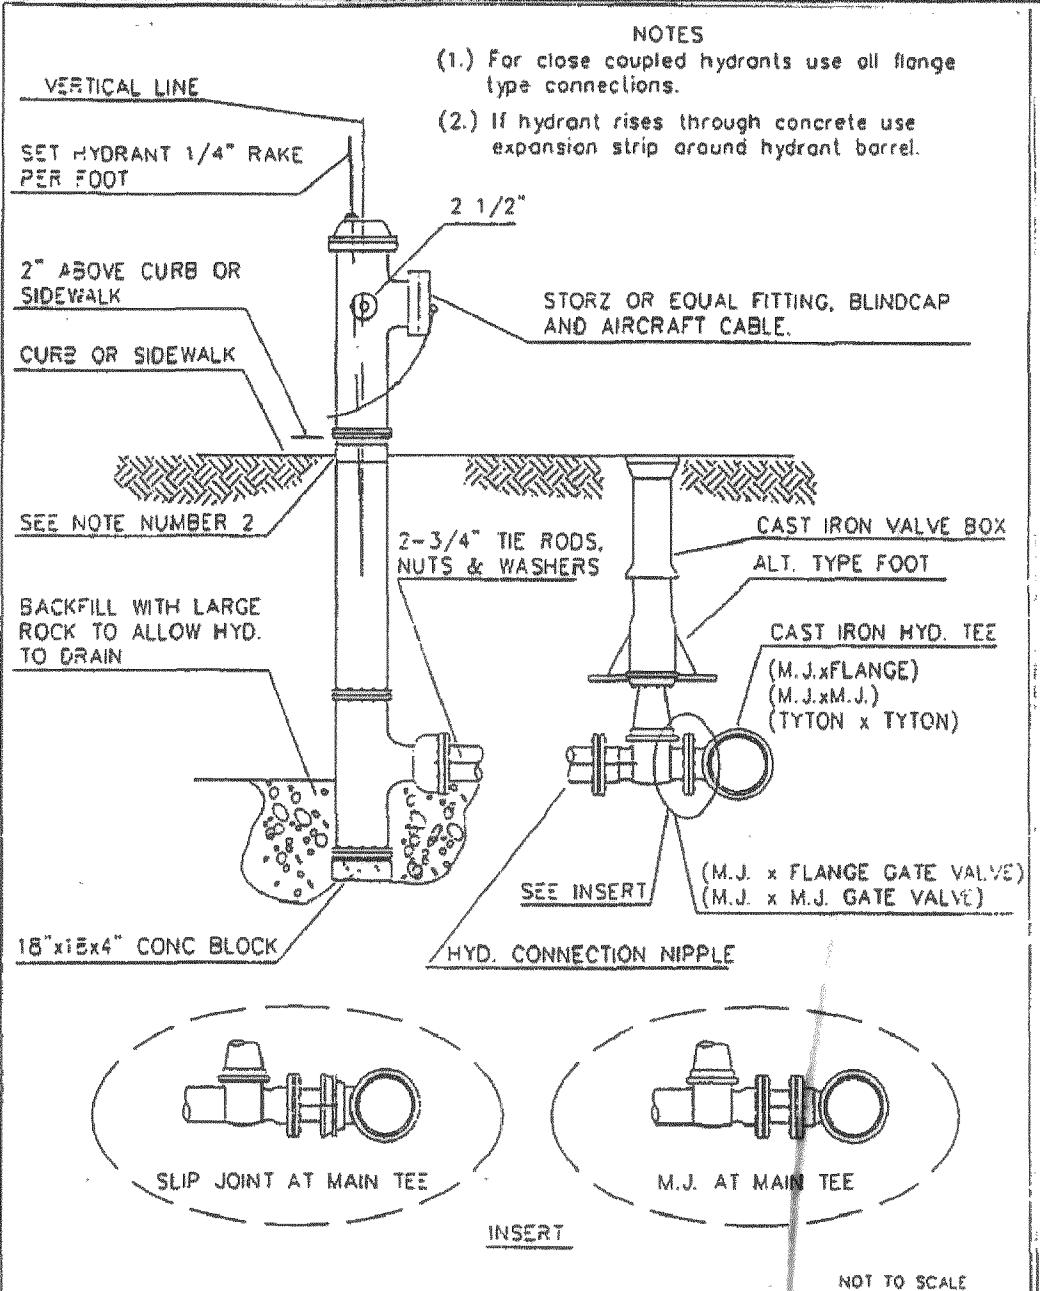


APPROVED *John & Elly* CITY OF FERNDALE DRAWING W-1
Public Works Director Date FIRE HYDRANT ASSEMBLY

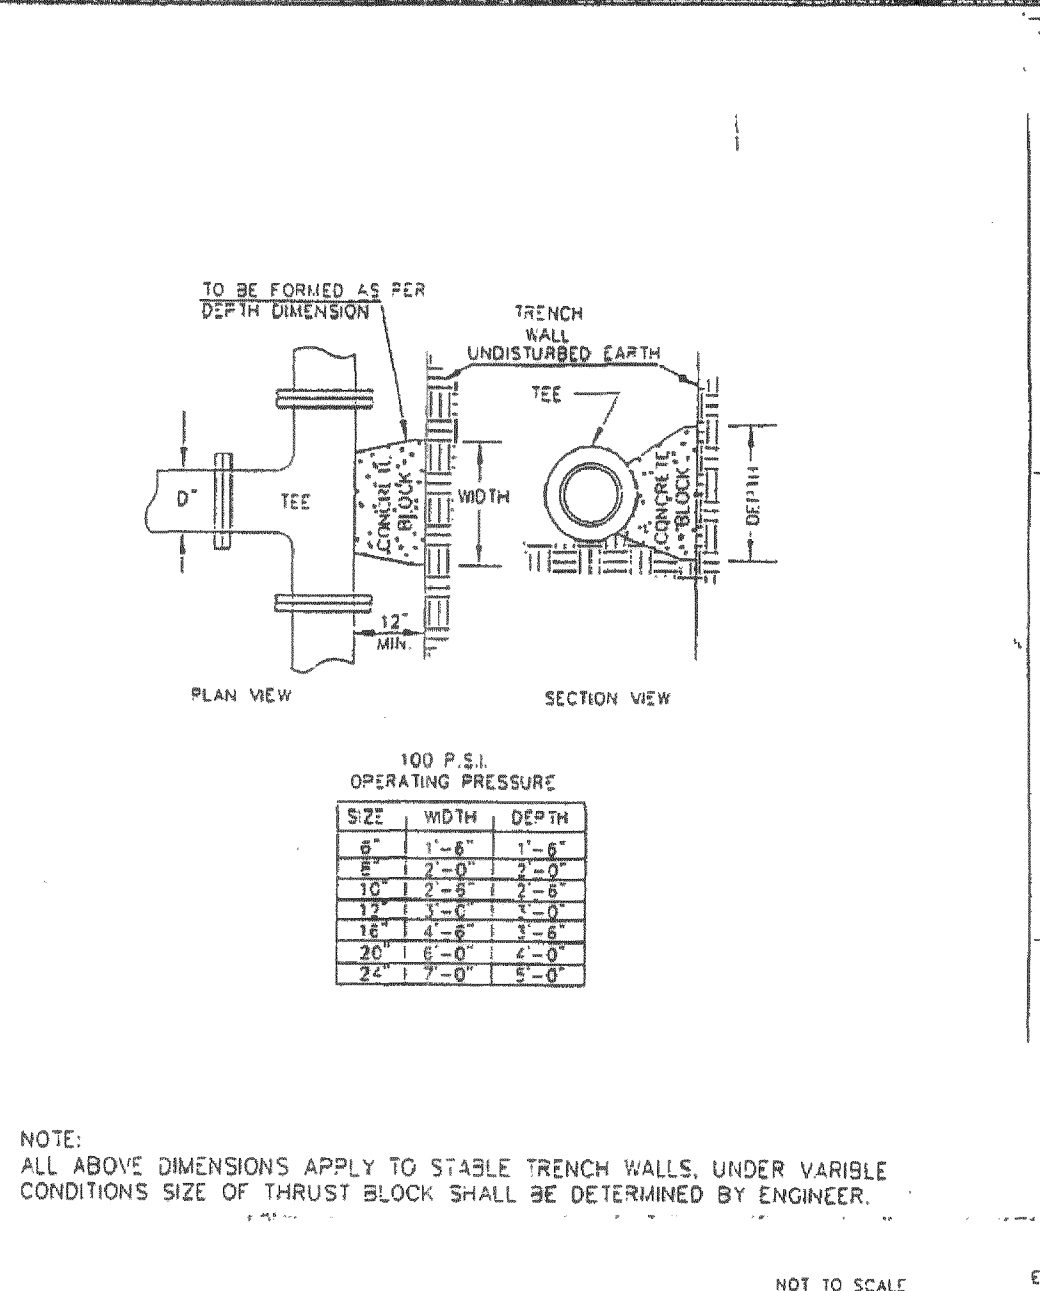


APPROVED *John & Elly* CITY OF FERNDALE DRAWING W-3
Public Works Director Date THRUST BLOCKING TEES

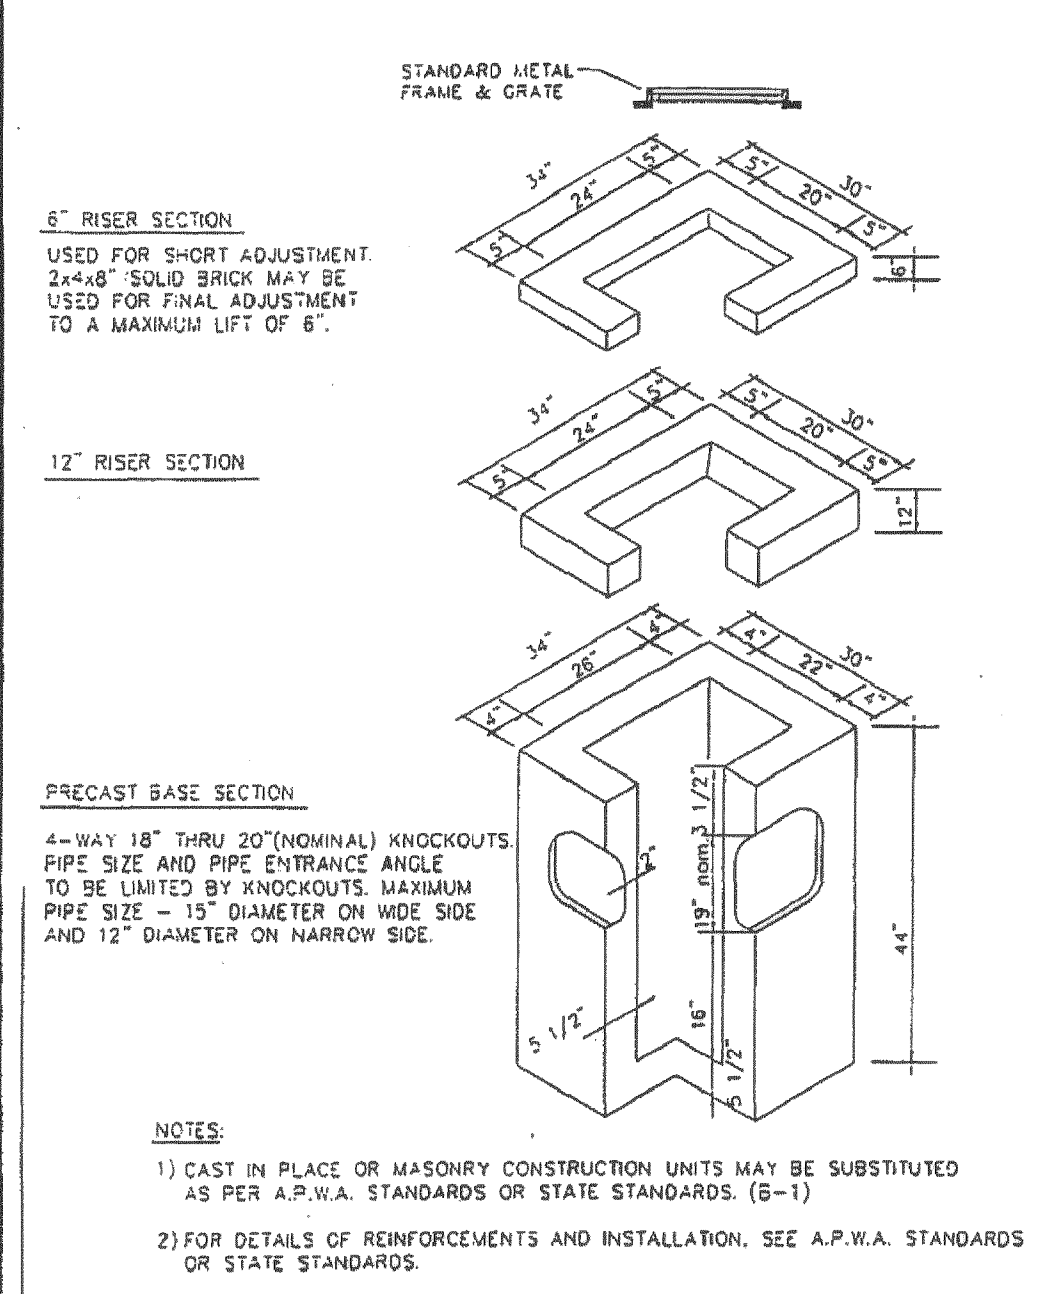


APPROVED *John & Elly* CITY OF FERNDALE DRAWING ST-1
Public Works Director Date CATCH BASIN TYPE I

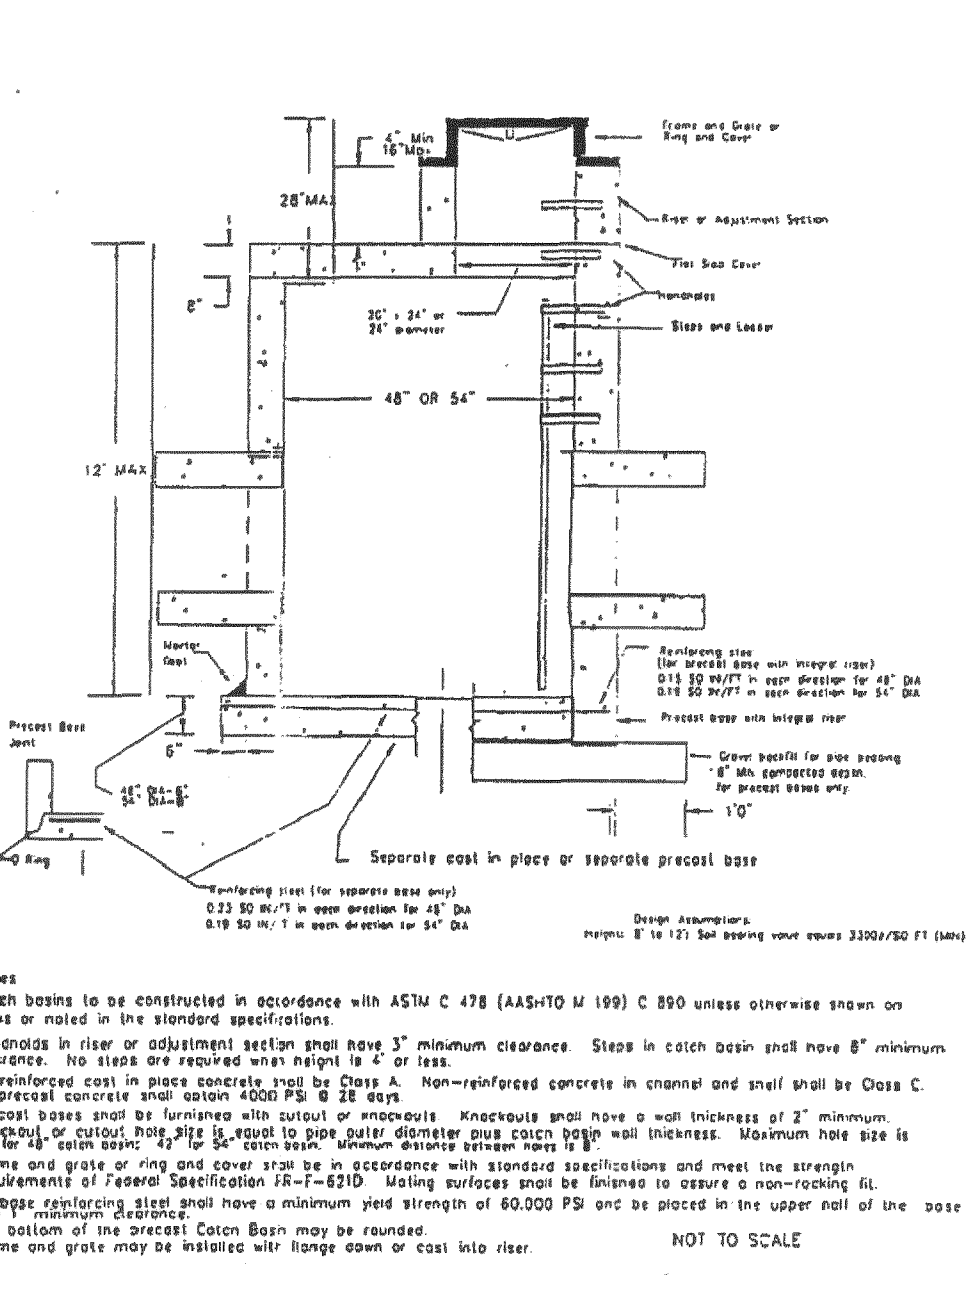


APPROVED *John & Elly* CITY OF FERNDALE DRAWING ST-2
Public Works Director Date CATCH BASIN TYPE II

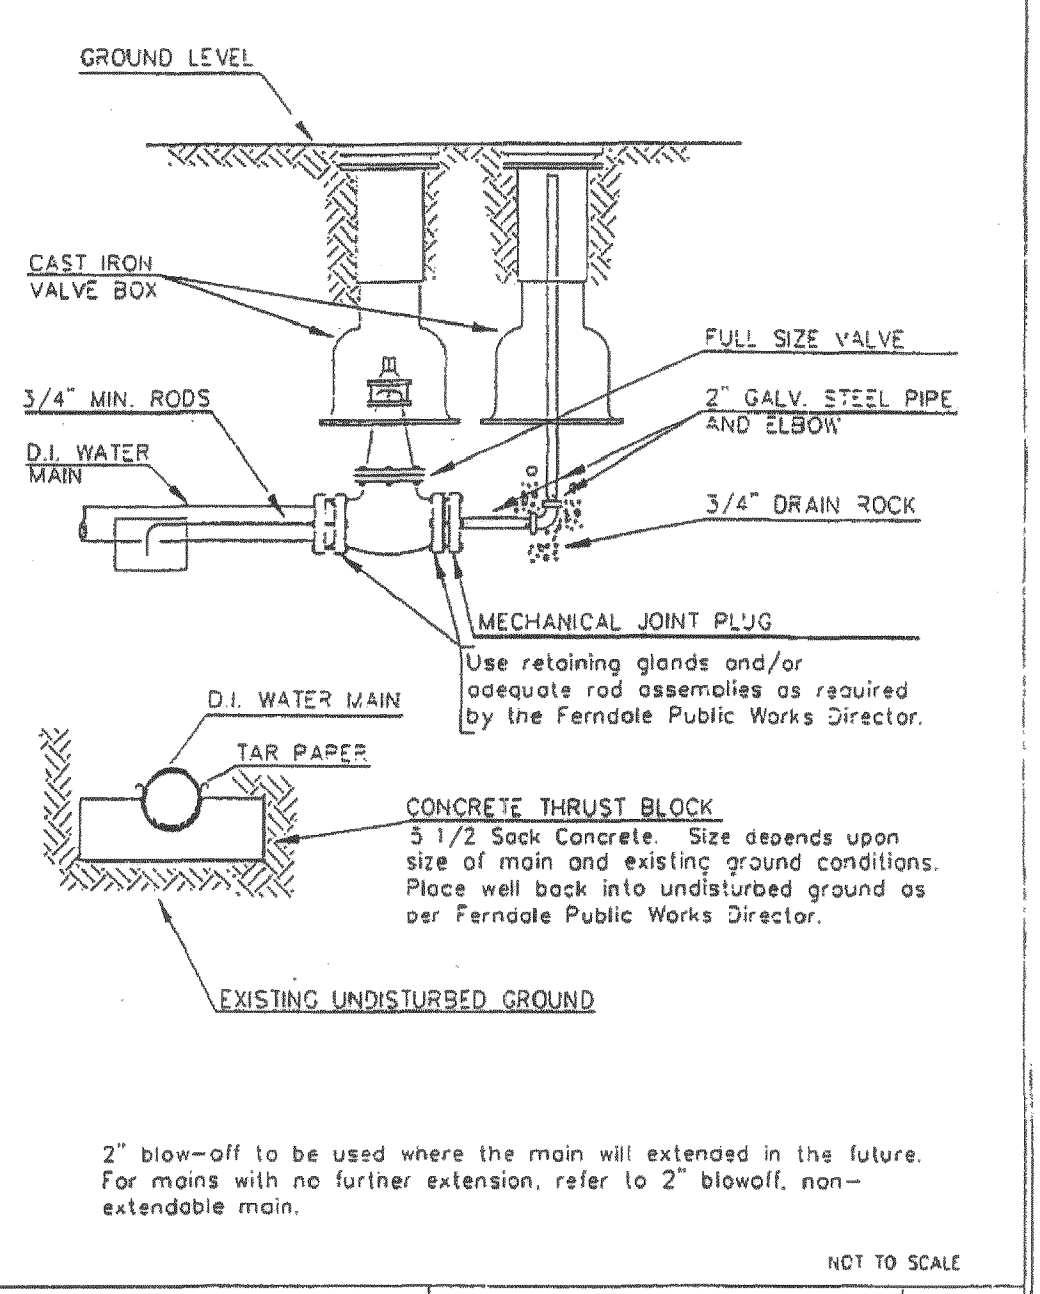


APPROVED *John & Elly* CITY OF FERNDALE DRAWING W-9
Public Works Director Date 2" BLOW-OFF WATER MAIN EXTENSION

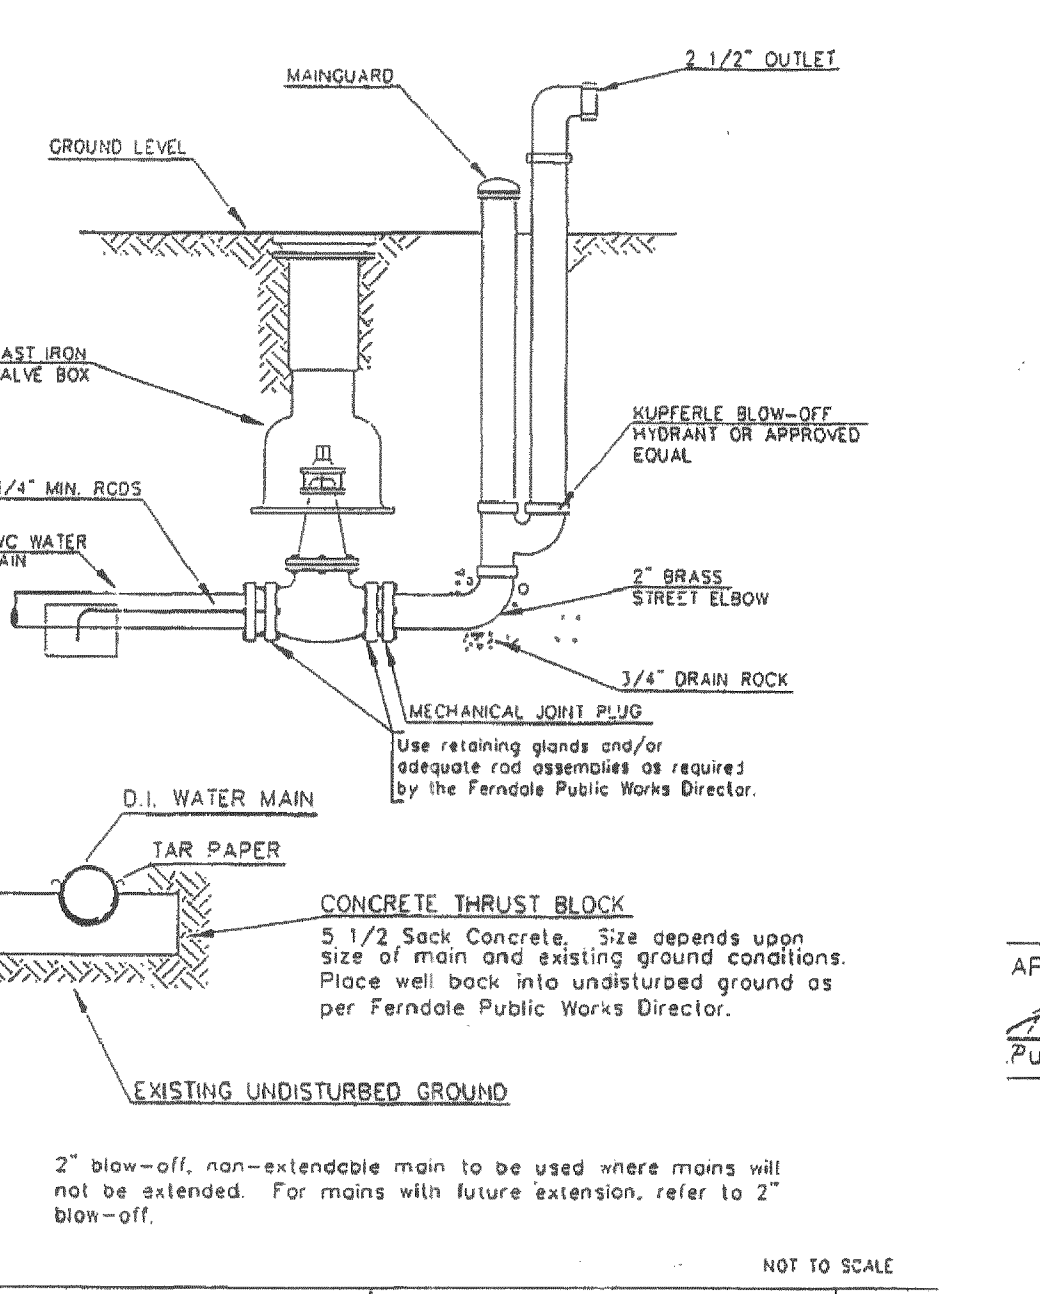


APPROVED *John & Elly* CITY OF FERNDALE DRAWING W-10
Public Works Director Date 2" BLOW-OFF NON-EXTENSIBLE MAIN

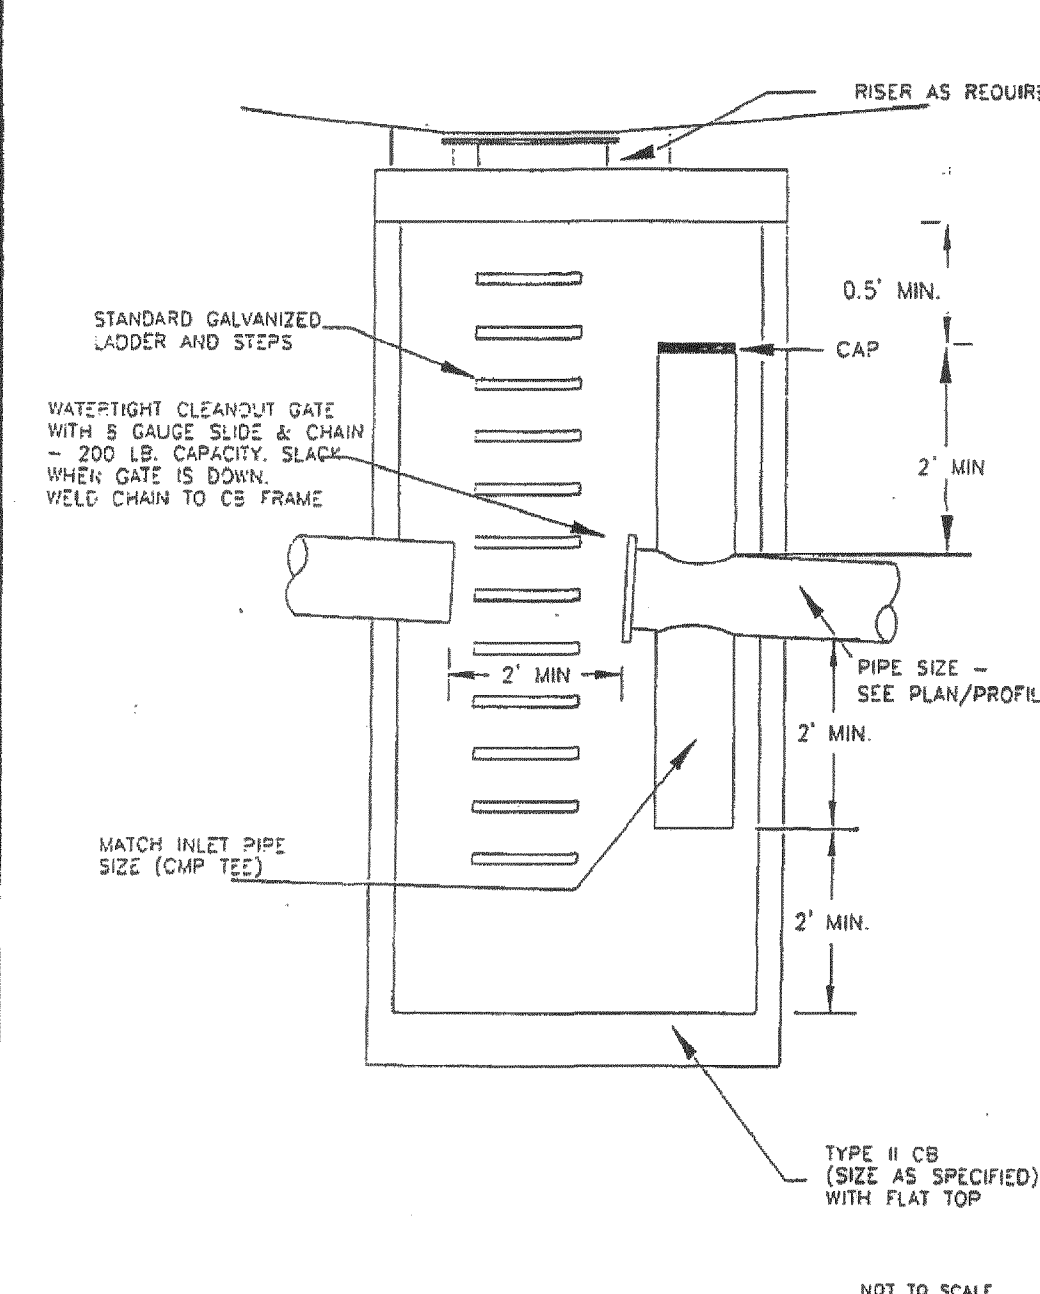


APPROVED *John & Elly* CITY OF FERNDALE DRAWING ST-14
Public Works Director Date OIL SEPARATOR MAINHOLE

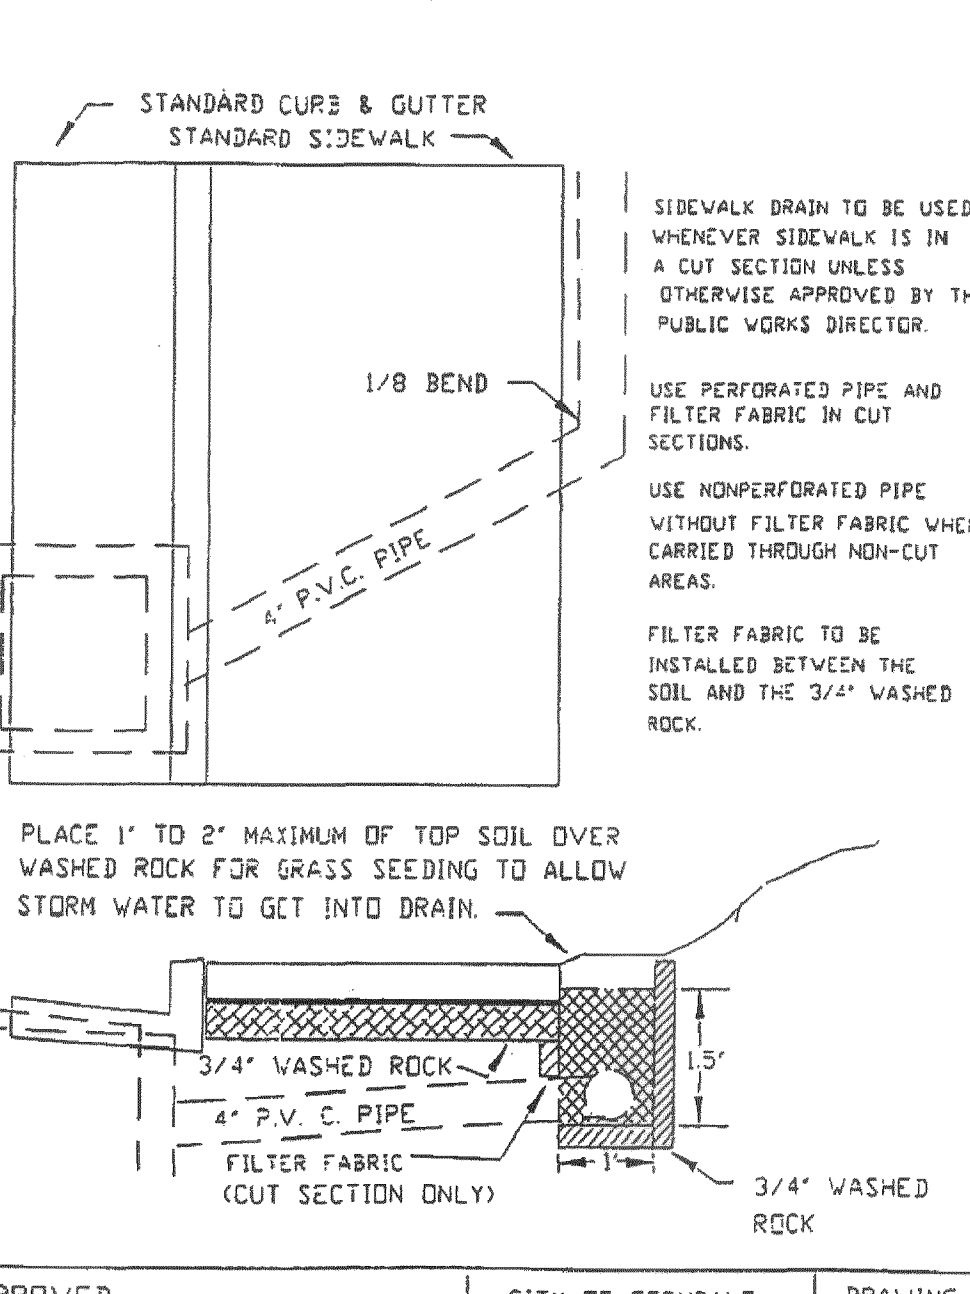


APPROVED *John & Elly* CITY OF FERNDALE DRAWING ST-15
Public Works Director Date SIDEWALK DRAIN

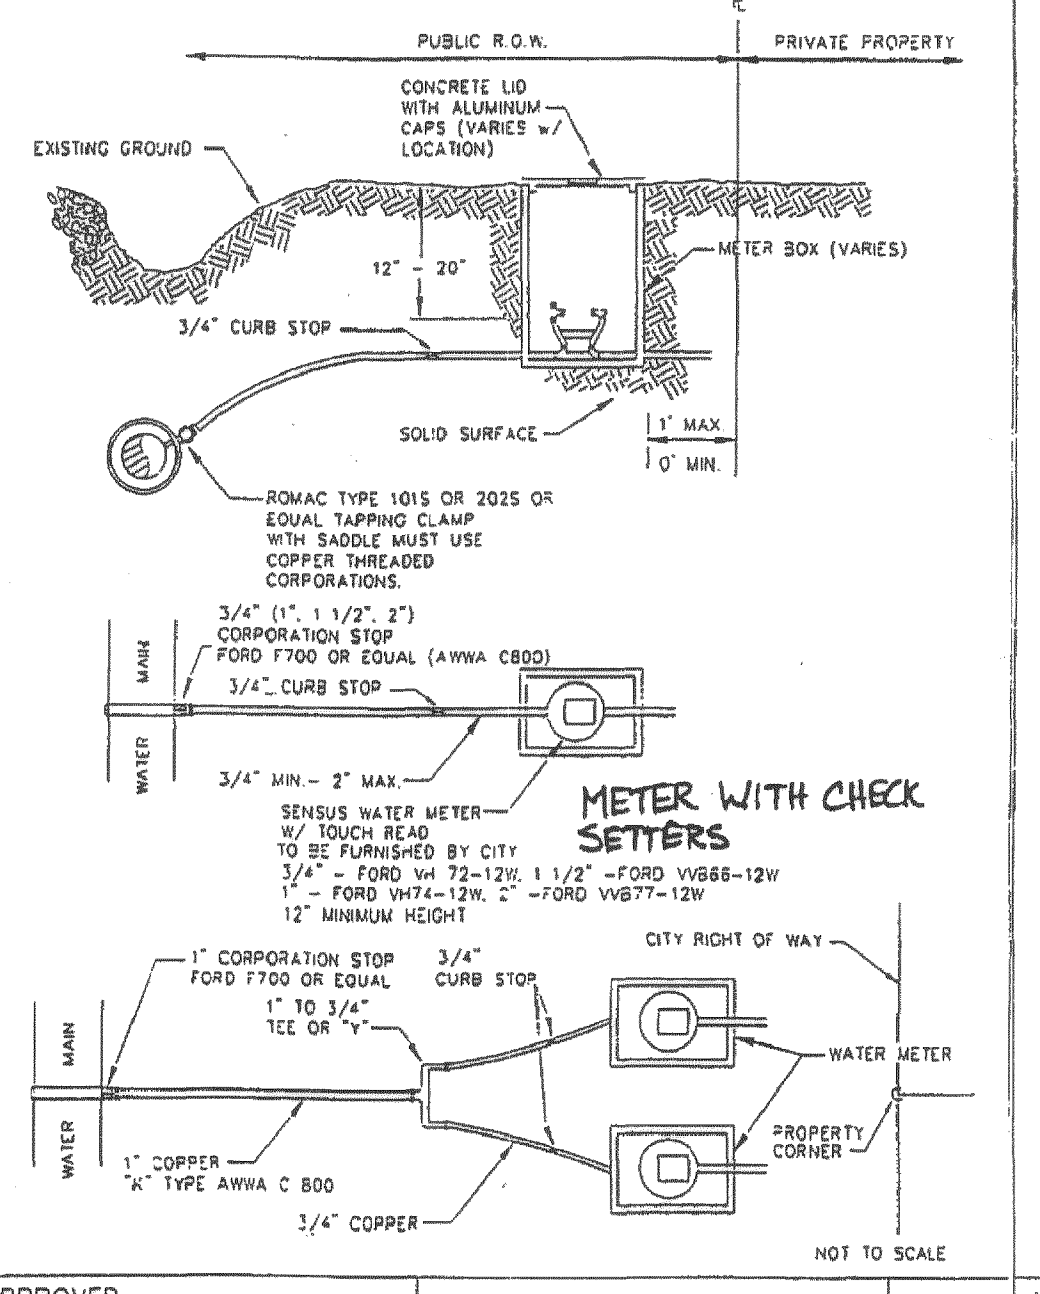


APPROVED *John & Elly* CITY OF FERNDALE DRAWING W-5
Public Works Director Date TYPICAL WATER SERVICE (3/4" TO 2")

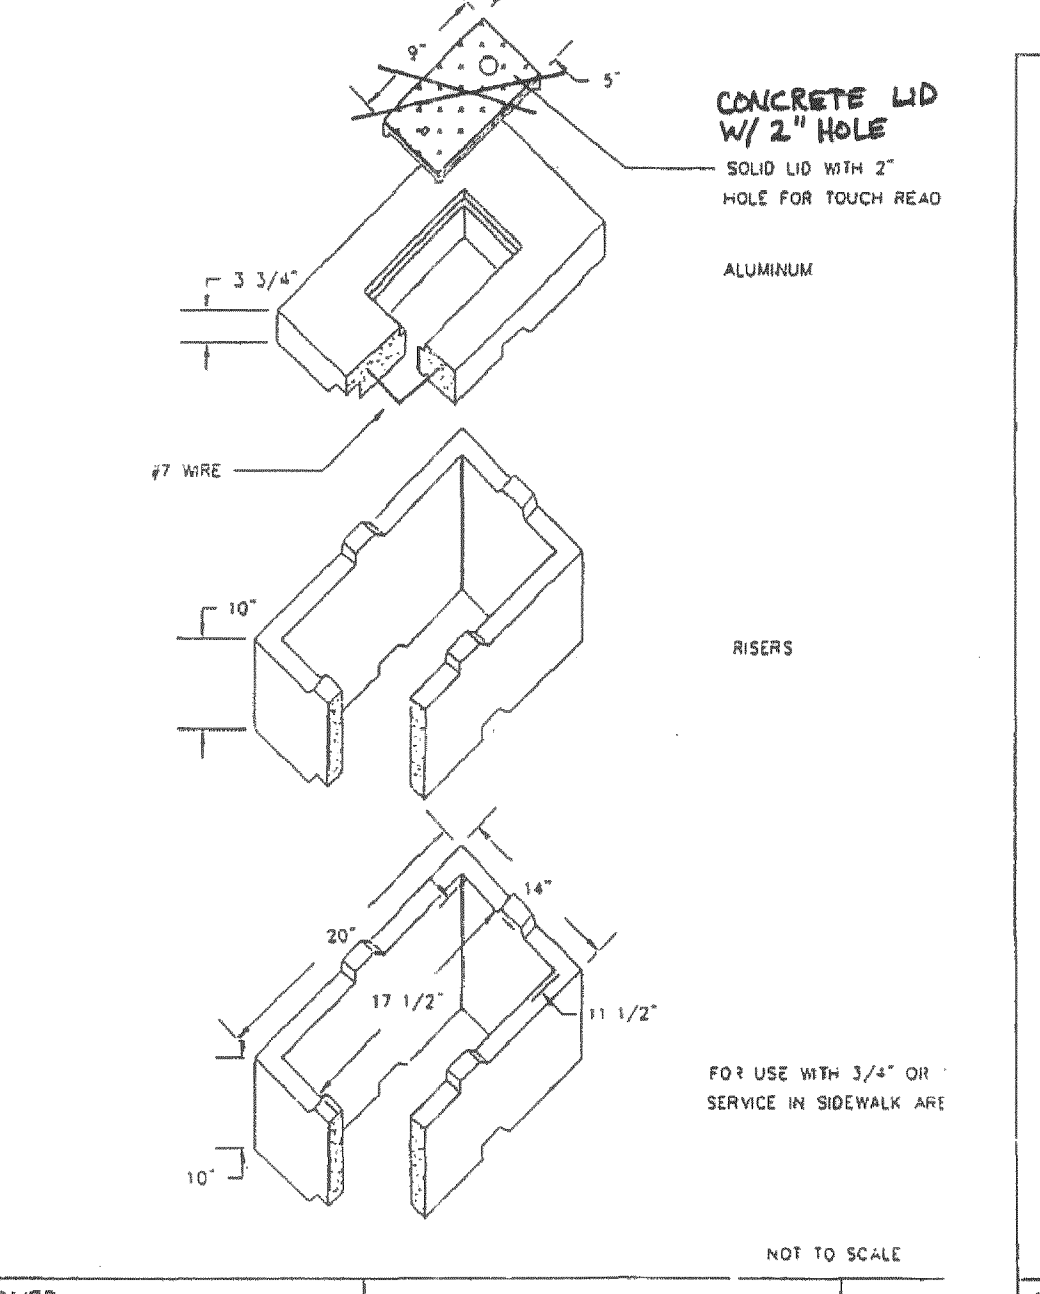


APPROVED *John & Elly* CITY OF FERNDALE DRAWING W-6
Public Works Director Date 1 METER BOX FOG TITLE

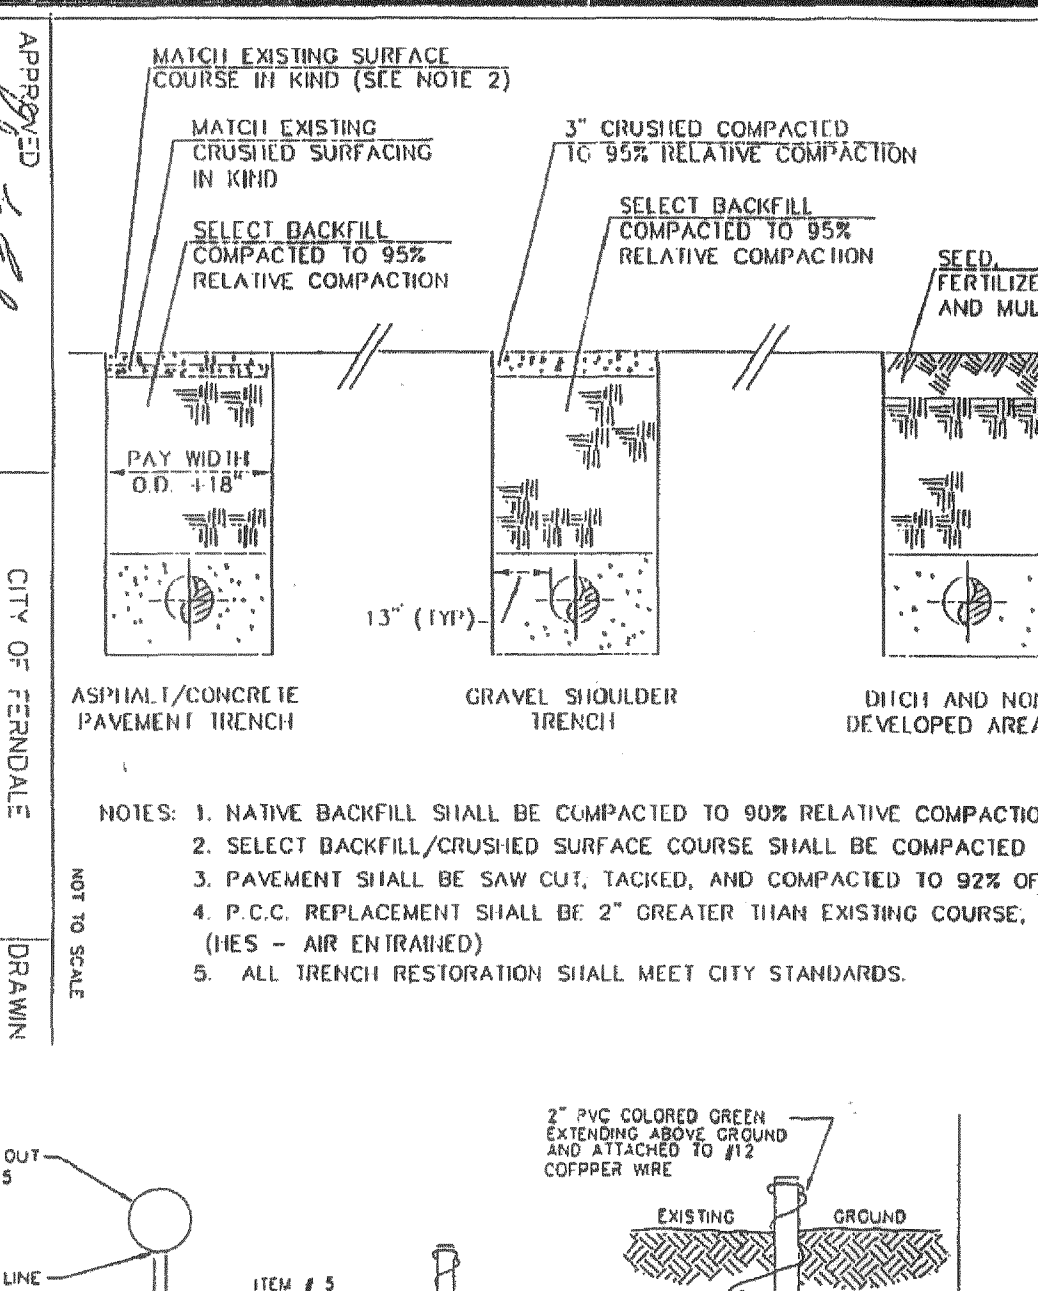

APPROVED *John & Elly* CITY OF FERNDALE DRAWING SS-12
Public Works Director Date TRENCH RESTORATION

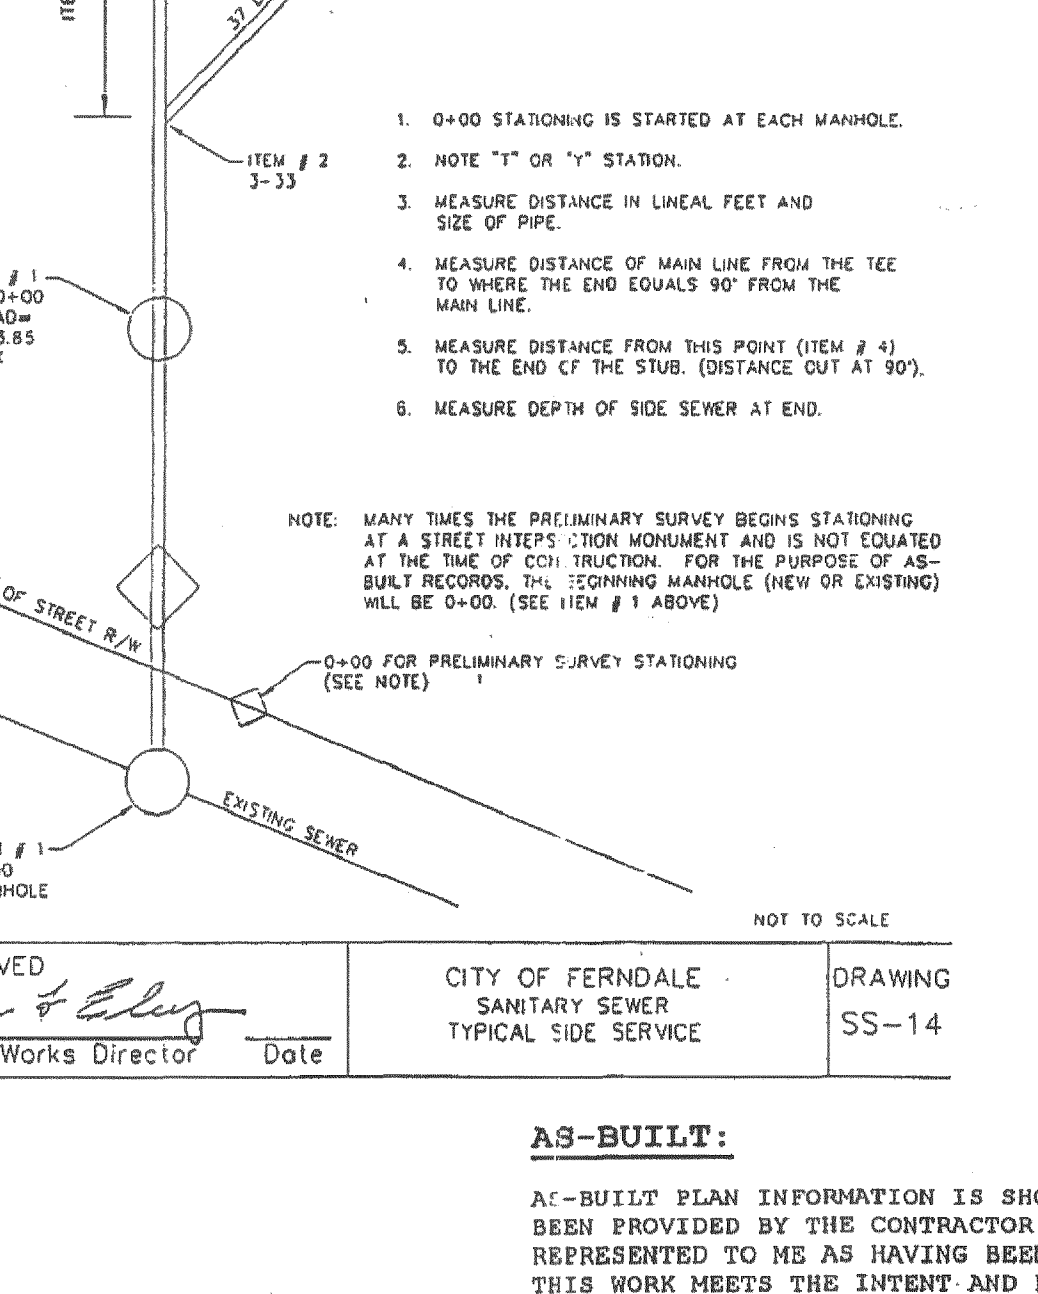

APPROVED *John & Elly* CITY OF FERNDALE DRAWING SS-14
Public Works Director Date TYPICAL SIDE SERVICE

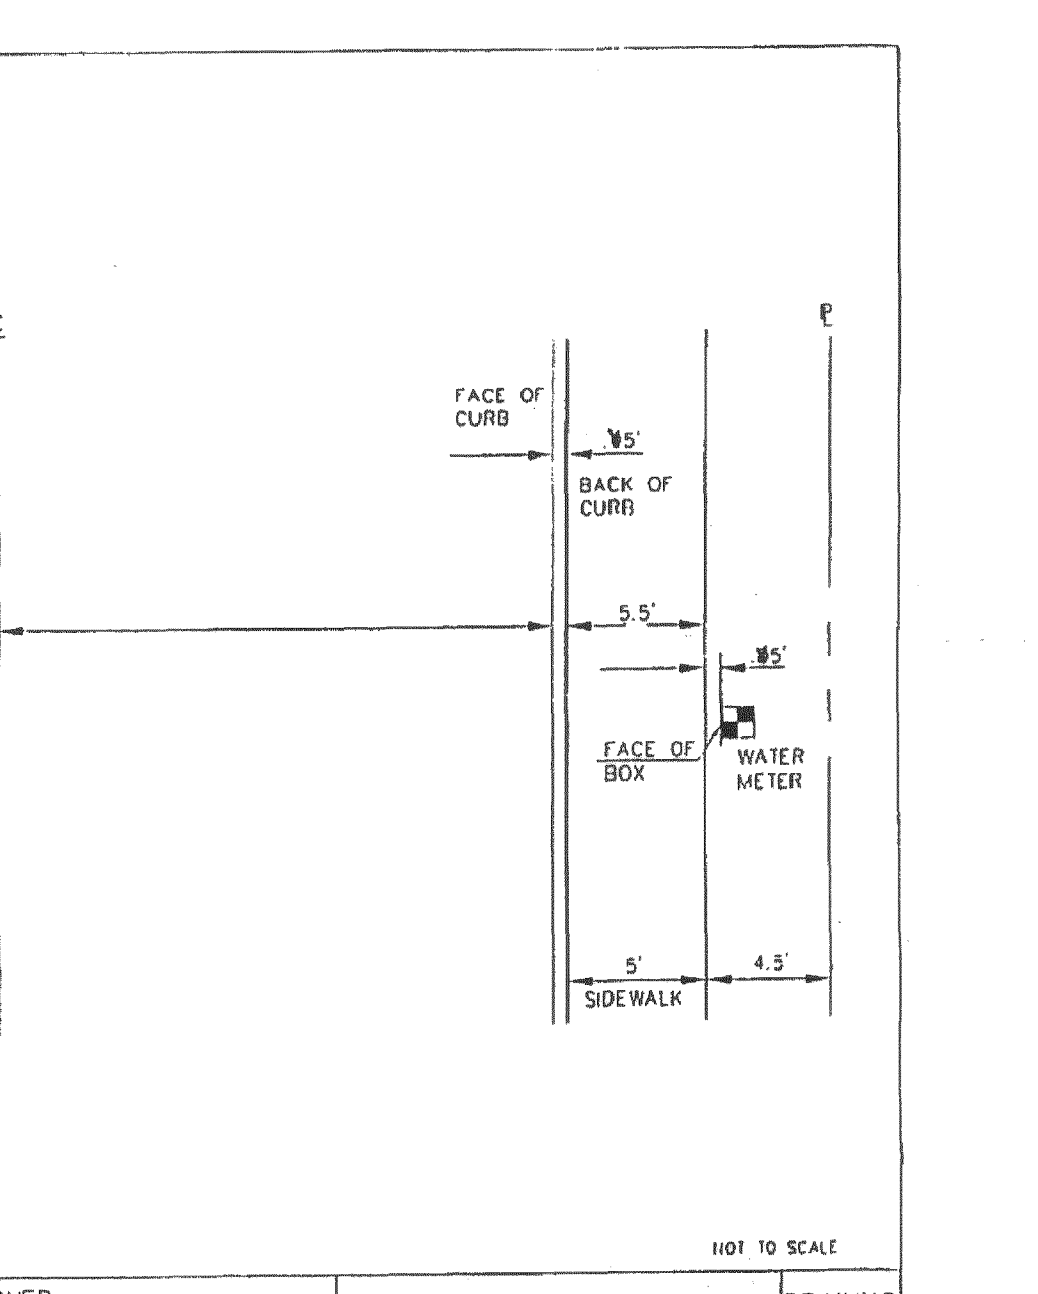

APPROVED *John & Elly* CITY OF FERNDALE DRAWING W-14
Public Works Director Date WATER METER LOCATION DETAIL

REVISIONS

BY

DATE

SCALE

DRAWN

JOB

SHEET

OF

9

SHEETS

IMPROVEMENT PLAN DETAILS FOR

SCHWARTZ SUBDIVISION

NORTHWEST OF FERNDALE

S 13, T 39 N., R 1 E

ROGERS SCHWARTZ

P. O. BOX 2054

FERNDALE, WA 98248

(360) 384 8170

DIBBLE ENGINEERING

100 DUPONT STREET

BELLINGHAM, WA 98225

(360) 734 1288, FAX 738 7798

DATE: 9/16/96

SCALE: 1" = 40'

DRAWN: GAWW

JOB: 96 785

SHEET: 9

OF 9 SHEETS

APPROVED

FEB 02 1998

BY: *John & Elly*

GREGORY A. DIBBLE

STATE OF WASHINGTON

REGISTERED PROFESSIONAL ENGINEER

EXPIRES 2/1/02

GREG DIBBLE, PE