


NORTHSHORE CORPORATION

THORNTON AND CHURCH IMPROVEMENTS


RECORD DRAWINGS

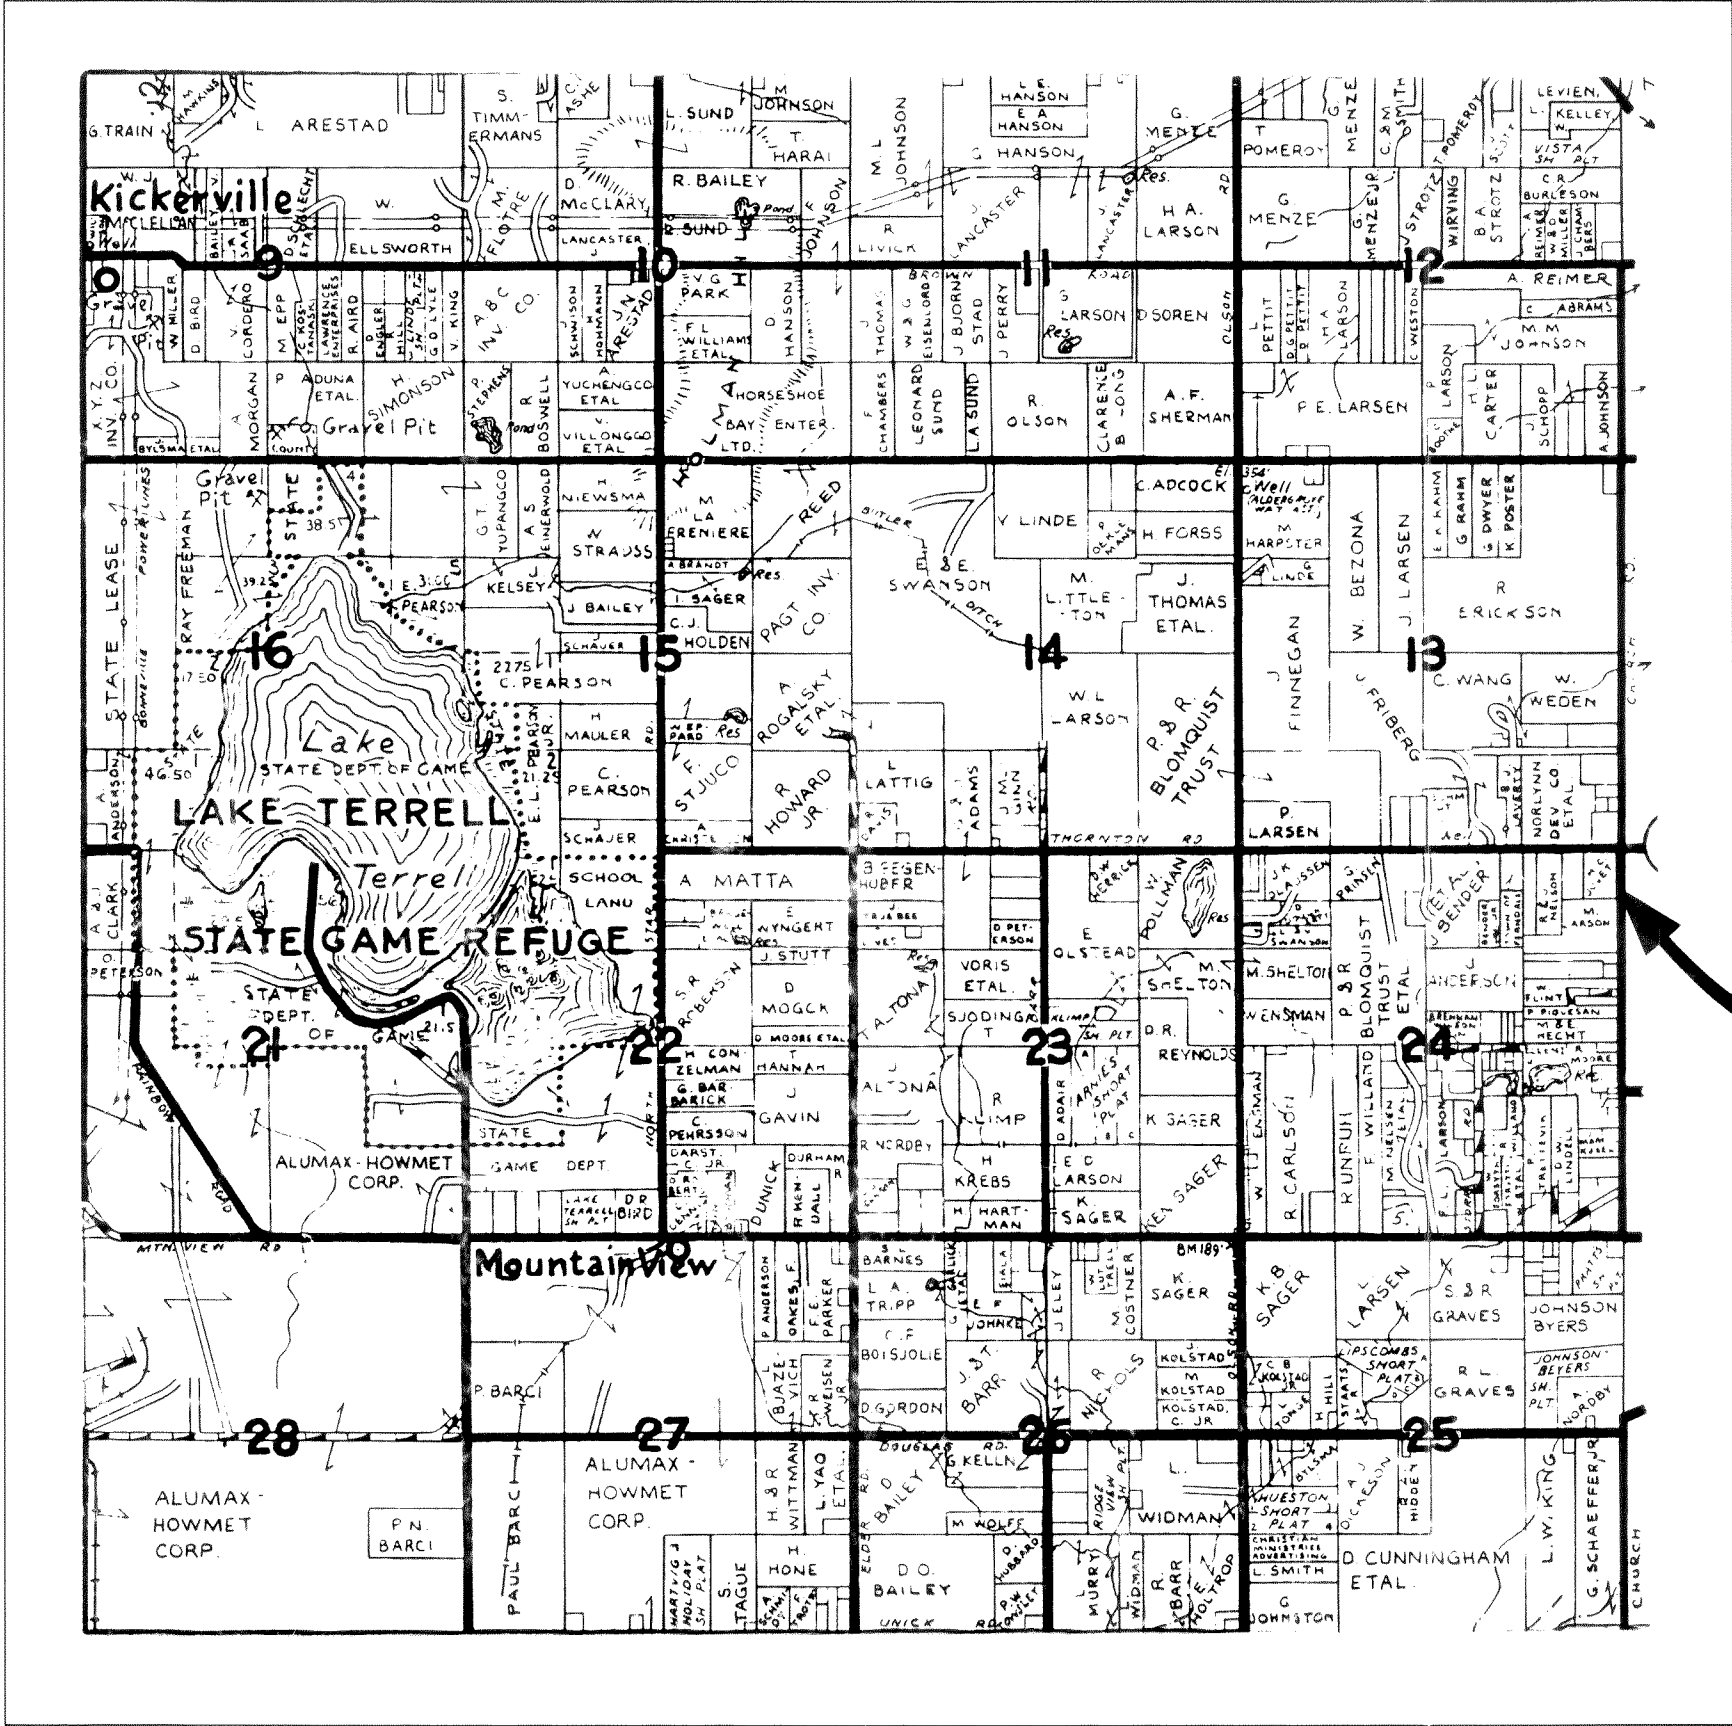


PROJECT
SITE

VICINITY MAP

RECORD DRAWING

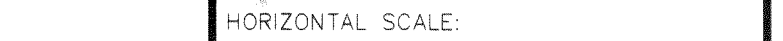REVISIONS:				DRAWN BY: DATE: CHECKED BY: DATE:				SEAL:		HORIZONTAL SCALE: N.T.S.		CLIENT: NORTHSHORE CORPORATION		JOB NO.: 97-109	
1								12-23 18  99	VERTICAL SCALE: DRAWN BY: BDS		PROJECT: CHURCH AND THORNTON IMPROVEMENTS		ACAD FILE: COVER.DWG		
2							DATE: 12/23/98 APPROVED BY:		TITLE: RECORD DRAWINGS		SHEET: A				
3							NORTH ROTATION:				OF: 4				
4															
								ASSOCIATED PROJECT CONSULTANTS, INC., P.S. PROFESSIONAL CONSULTING ENGINEERS 1401 ASTOR STREET BELLINGHAM, WASHINGTON 98225 (360) 671-1146							

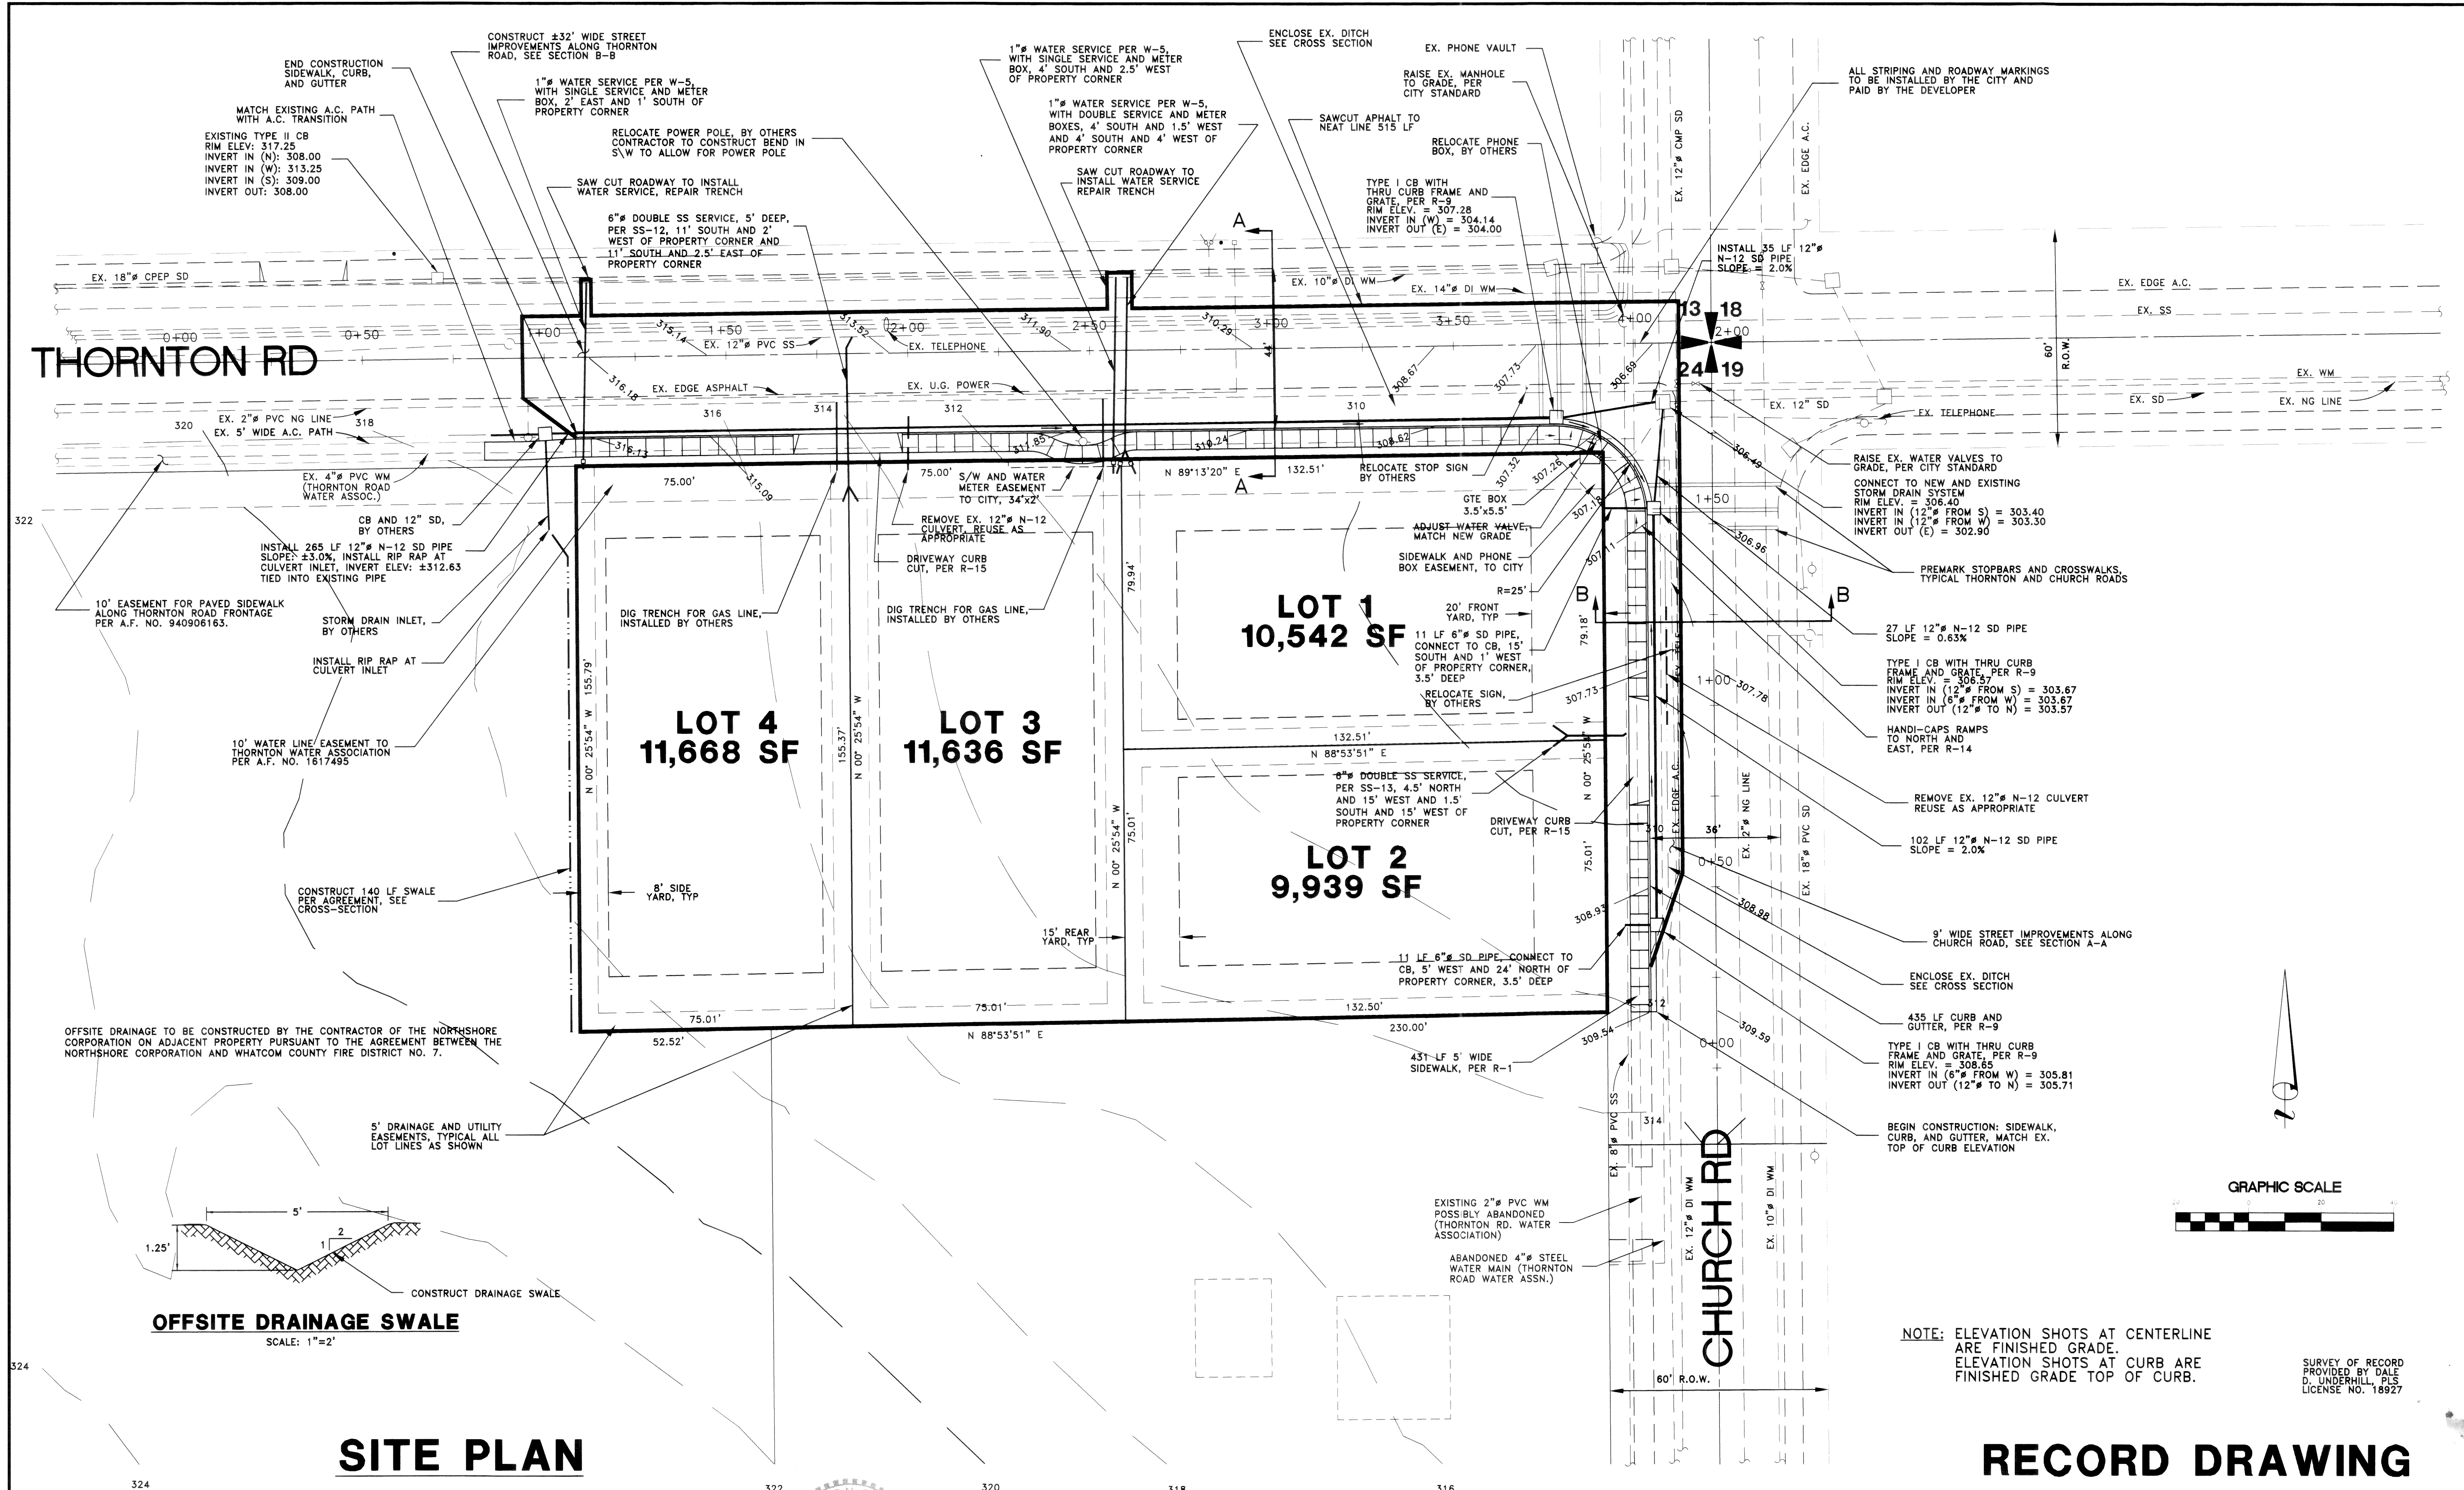


SITE PLAN

RECORD DRAWING

REVISIONS:		DRAWN BY	DATE	CHECKED BY	DATE	SEAL	HORIZONTAL SCALE: 1"=20'		CLIENT: NORTHSHORE CORPORATION	JOB NO.: 97-109
1	REDLINES PER CITY OF FERDALE	BDS	07-21-98				VERTICAL SCALE:	DRAWN BY: BDS	PROJECT: THORNTON AND CHURCH IMPROVMENTS	ACAD FILE: STREET.DWG
2	REDLINES PER CITY OF FERDALE	BDS	08-11-98				DATE: 02/18/98	APPROVED BY:	SHEET: 1	
3	RECORD DRAWING PER IN FIELD AS-BUILTS	BDS	11-12-98				NORTH ROTATION:		TITLE: CONSTRUCTION PLANS	OF: 4
4	REDLINES PER CITY OF FERDALE	BDS	12-23-98				ASSOCIATED PROJECT CONSULTANTS, INC., P.S. PROFESSIONAL CONSULTING ENGINEERS 1401 ASTOR STREET BELLINGHAM, WASHINGTON 98225 (360) 671-1146			



REVISIONS: 1 RED-LINES PER CITY OF PERRIS 2 RECORD DRAWING PER IN FIELD AS-BUILTS 3 REDLINES PER CITY OF PERRIS 4		DRAWN BY: BDS DATE: 07-21-98 CHECKED BY: [Signature] DATE: 11-12-98 DATE: 12-23-98	SEAL: [Stamp] EXPIRES 10/19/99	ASSOCIATED PROJECT CONSULTANTS, INC., P.S. PROFESSIONAL CONSULTING ENGINEERS 1401 ASTOR STREET BELLINGHAM, WASHINGTON 98225 (360) 671-1146		HORIZONTAL SCALE: 1"=10' VERTICAL SCALE: [Blank] DATE: 03/05/98 NORTH ROTATION:	CLIENT: NORTHSHORE CORPORATION PROJECT: THORNTON AND CHURCH IMPROVMENTS TITLE: CONSTRUCTION DETAILS	JOB NO.: 97-109 ACAD FILE: NSDETAIL.DWG SHEET: 2 OF: 4
---	--	--	-----------------------------------	--	--	--	---	---

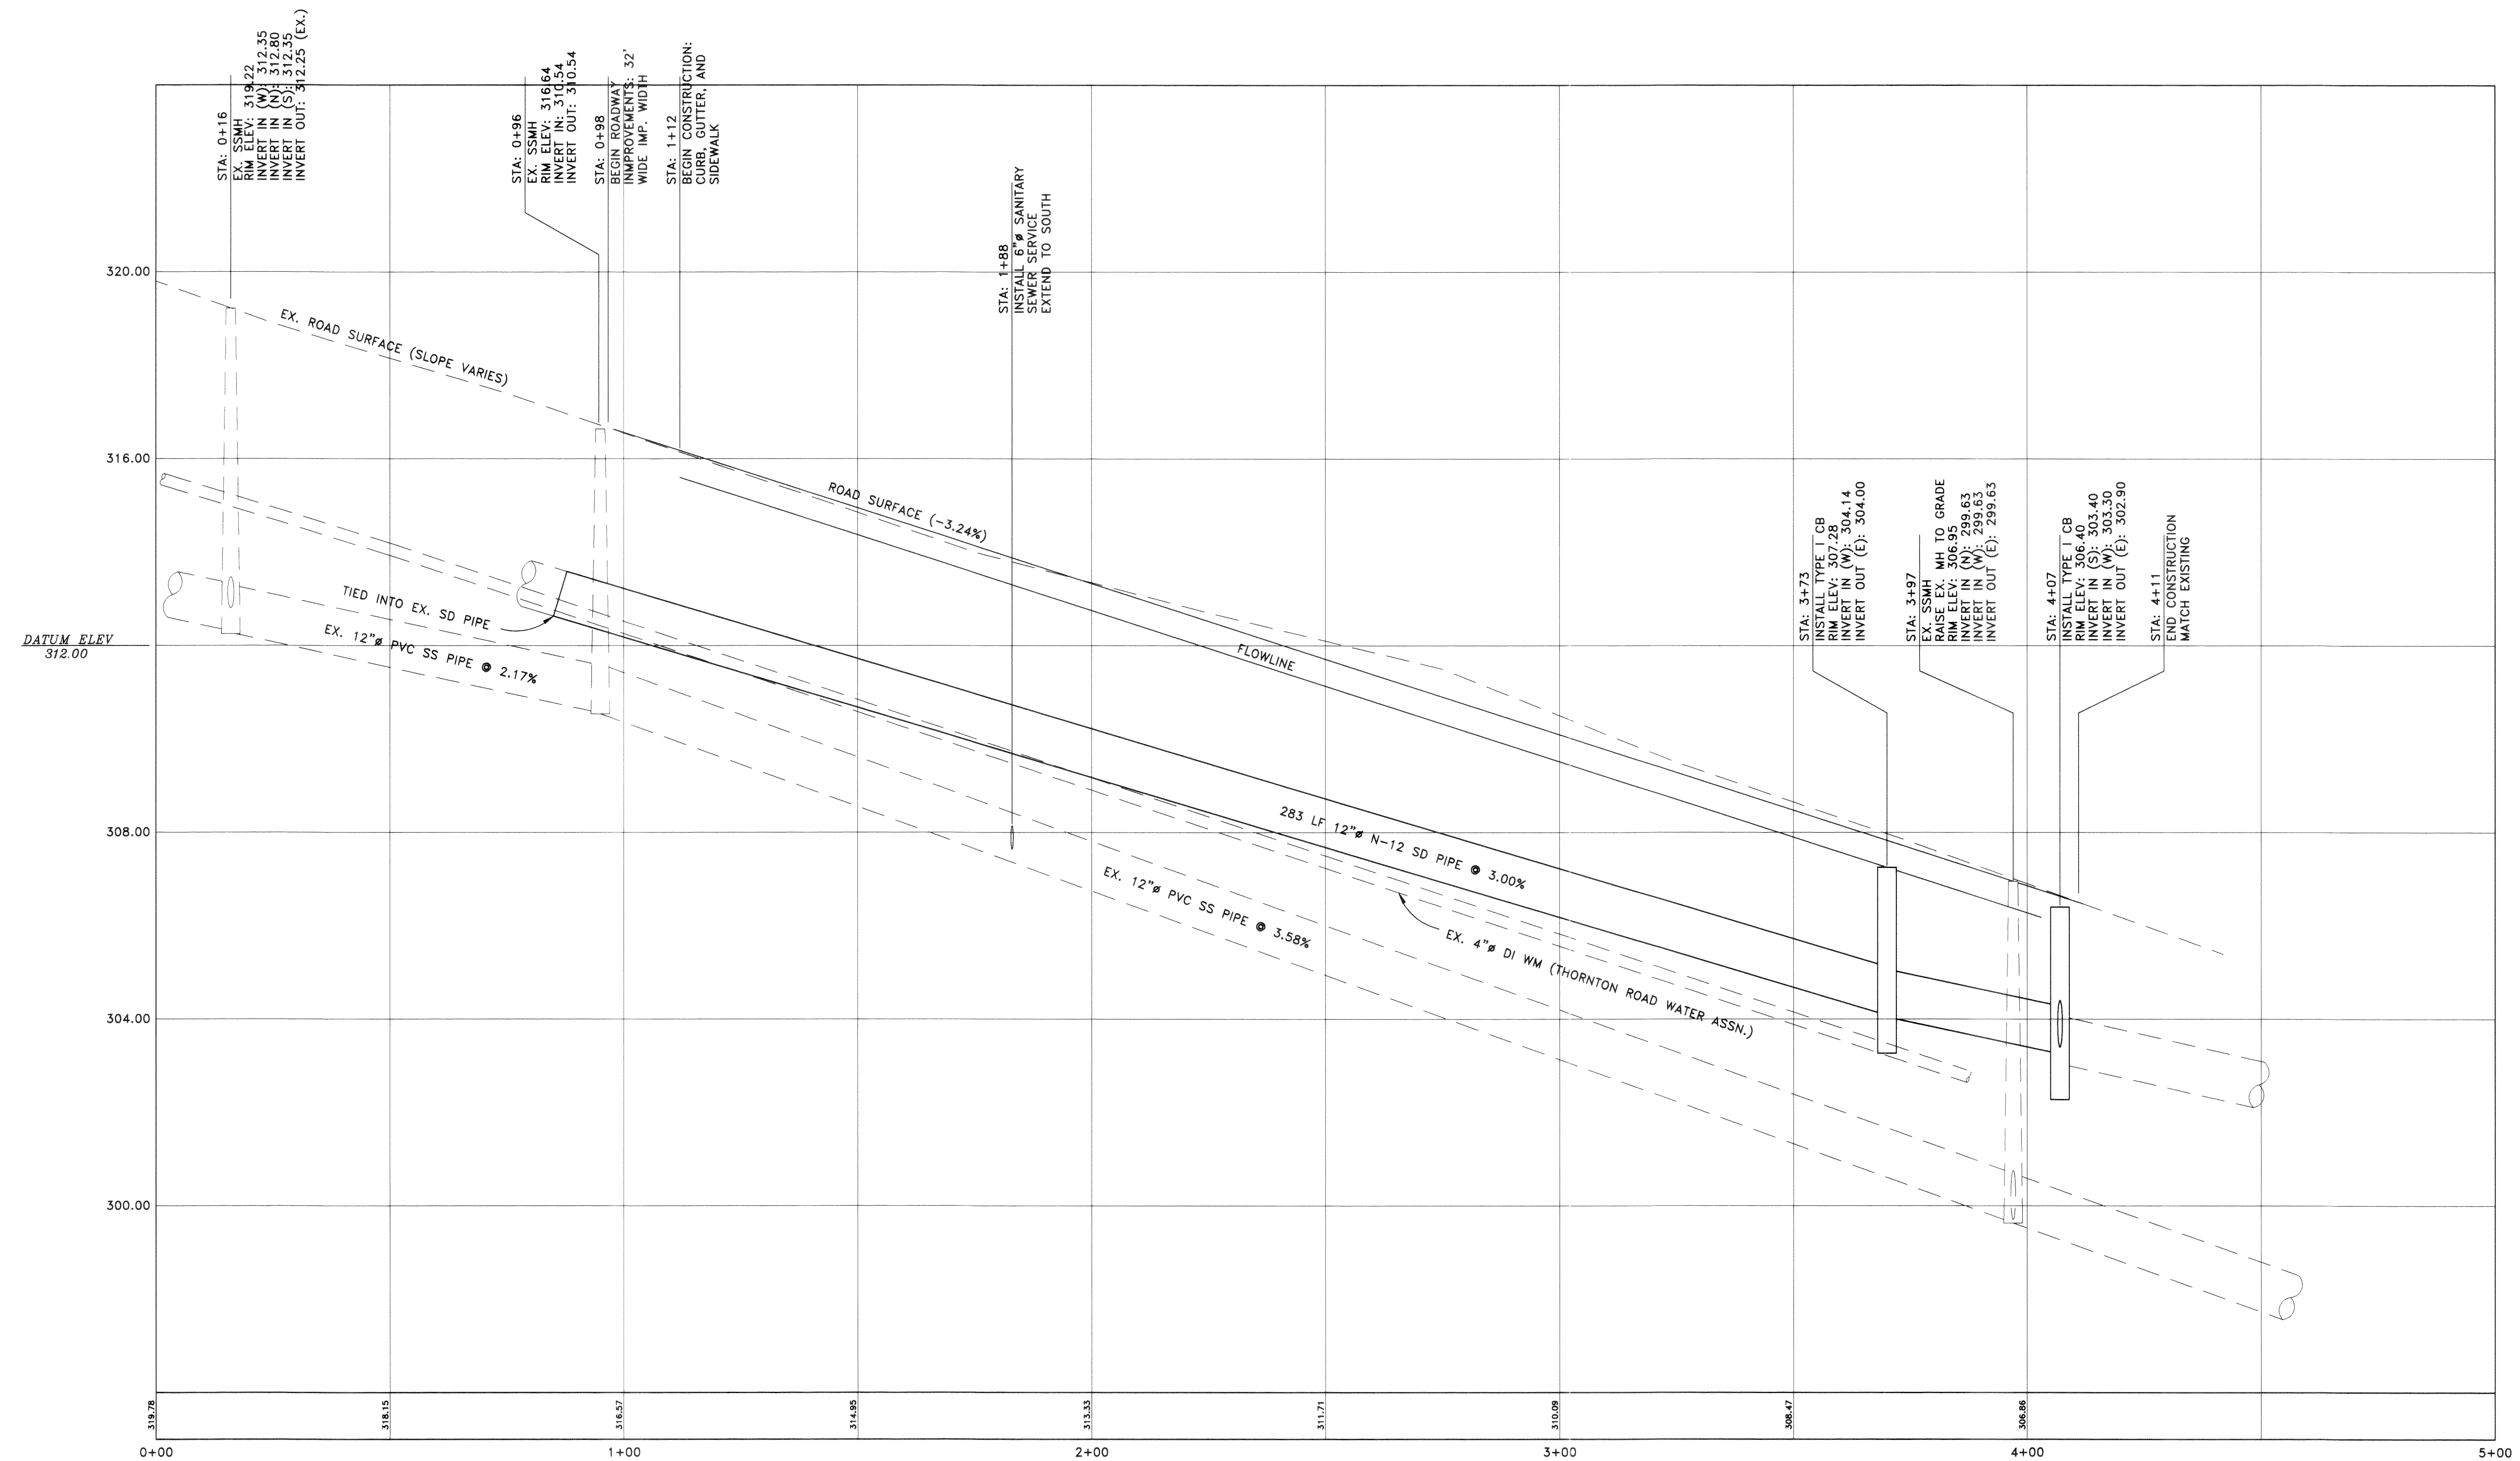


THORNTON ROAD PROFILE

SCALE:
HORIZ. 1"=20'
VERT. 1"=2'

RECORD DRAWING

REVISIONS:	DRAWN BY	DATE	CHECKED BY	DATE
1 REDLINES PER CITY OF FERIDALE	BDS	07-21-98		
2 REDLINES PER CITY OF FERIDALE	BDS	08-11-98		
3 RECORD DRAWING PER IN. FIELD AS-BUILTS	BDS	11-12-98		
4 REDLINES PER CITY OF FERIDALE	BDS	12-23-98		

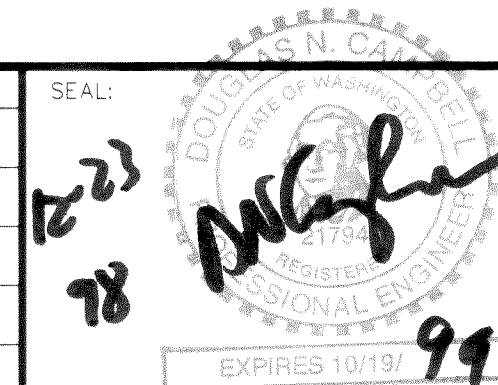


ASSOCIATED
PROJECT CONSULTANTS, INC., P.S.
PROFESSIONAL CONSULTING ENGINEERS
1401 ASTOR STREET BELLINGHAM, WASHINGTON 98225 (360) 671-1146

HORIZONTAL SCALE:	1"=20'
VERTICAL SCALE:	1"=2'
DATE:	07/21/98
NORTH ROTATION:	

CLIENT:	NORTHSHORE CORPORTATION
PROJECT:	CHURCH AND THORNTON IMPROVEMENTS
TITLE:	THORNTON ROAD PROFILE

JOB NO.:	97-109
ACAD FILE:	THORPROF.DWG
SHEET:	3
OF:	4

001291.004 2-13-06 RL

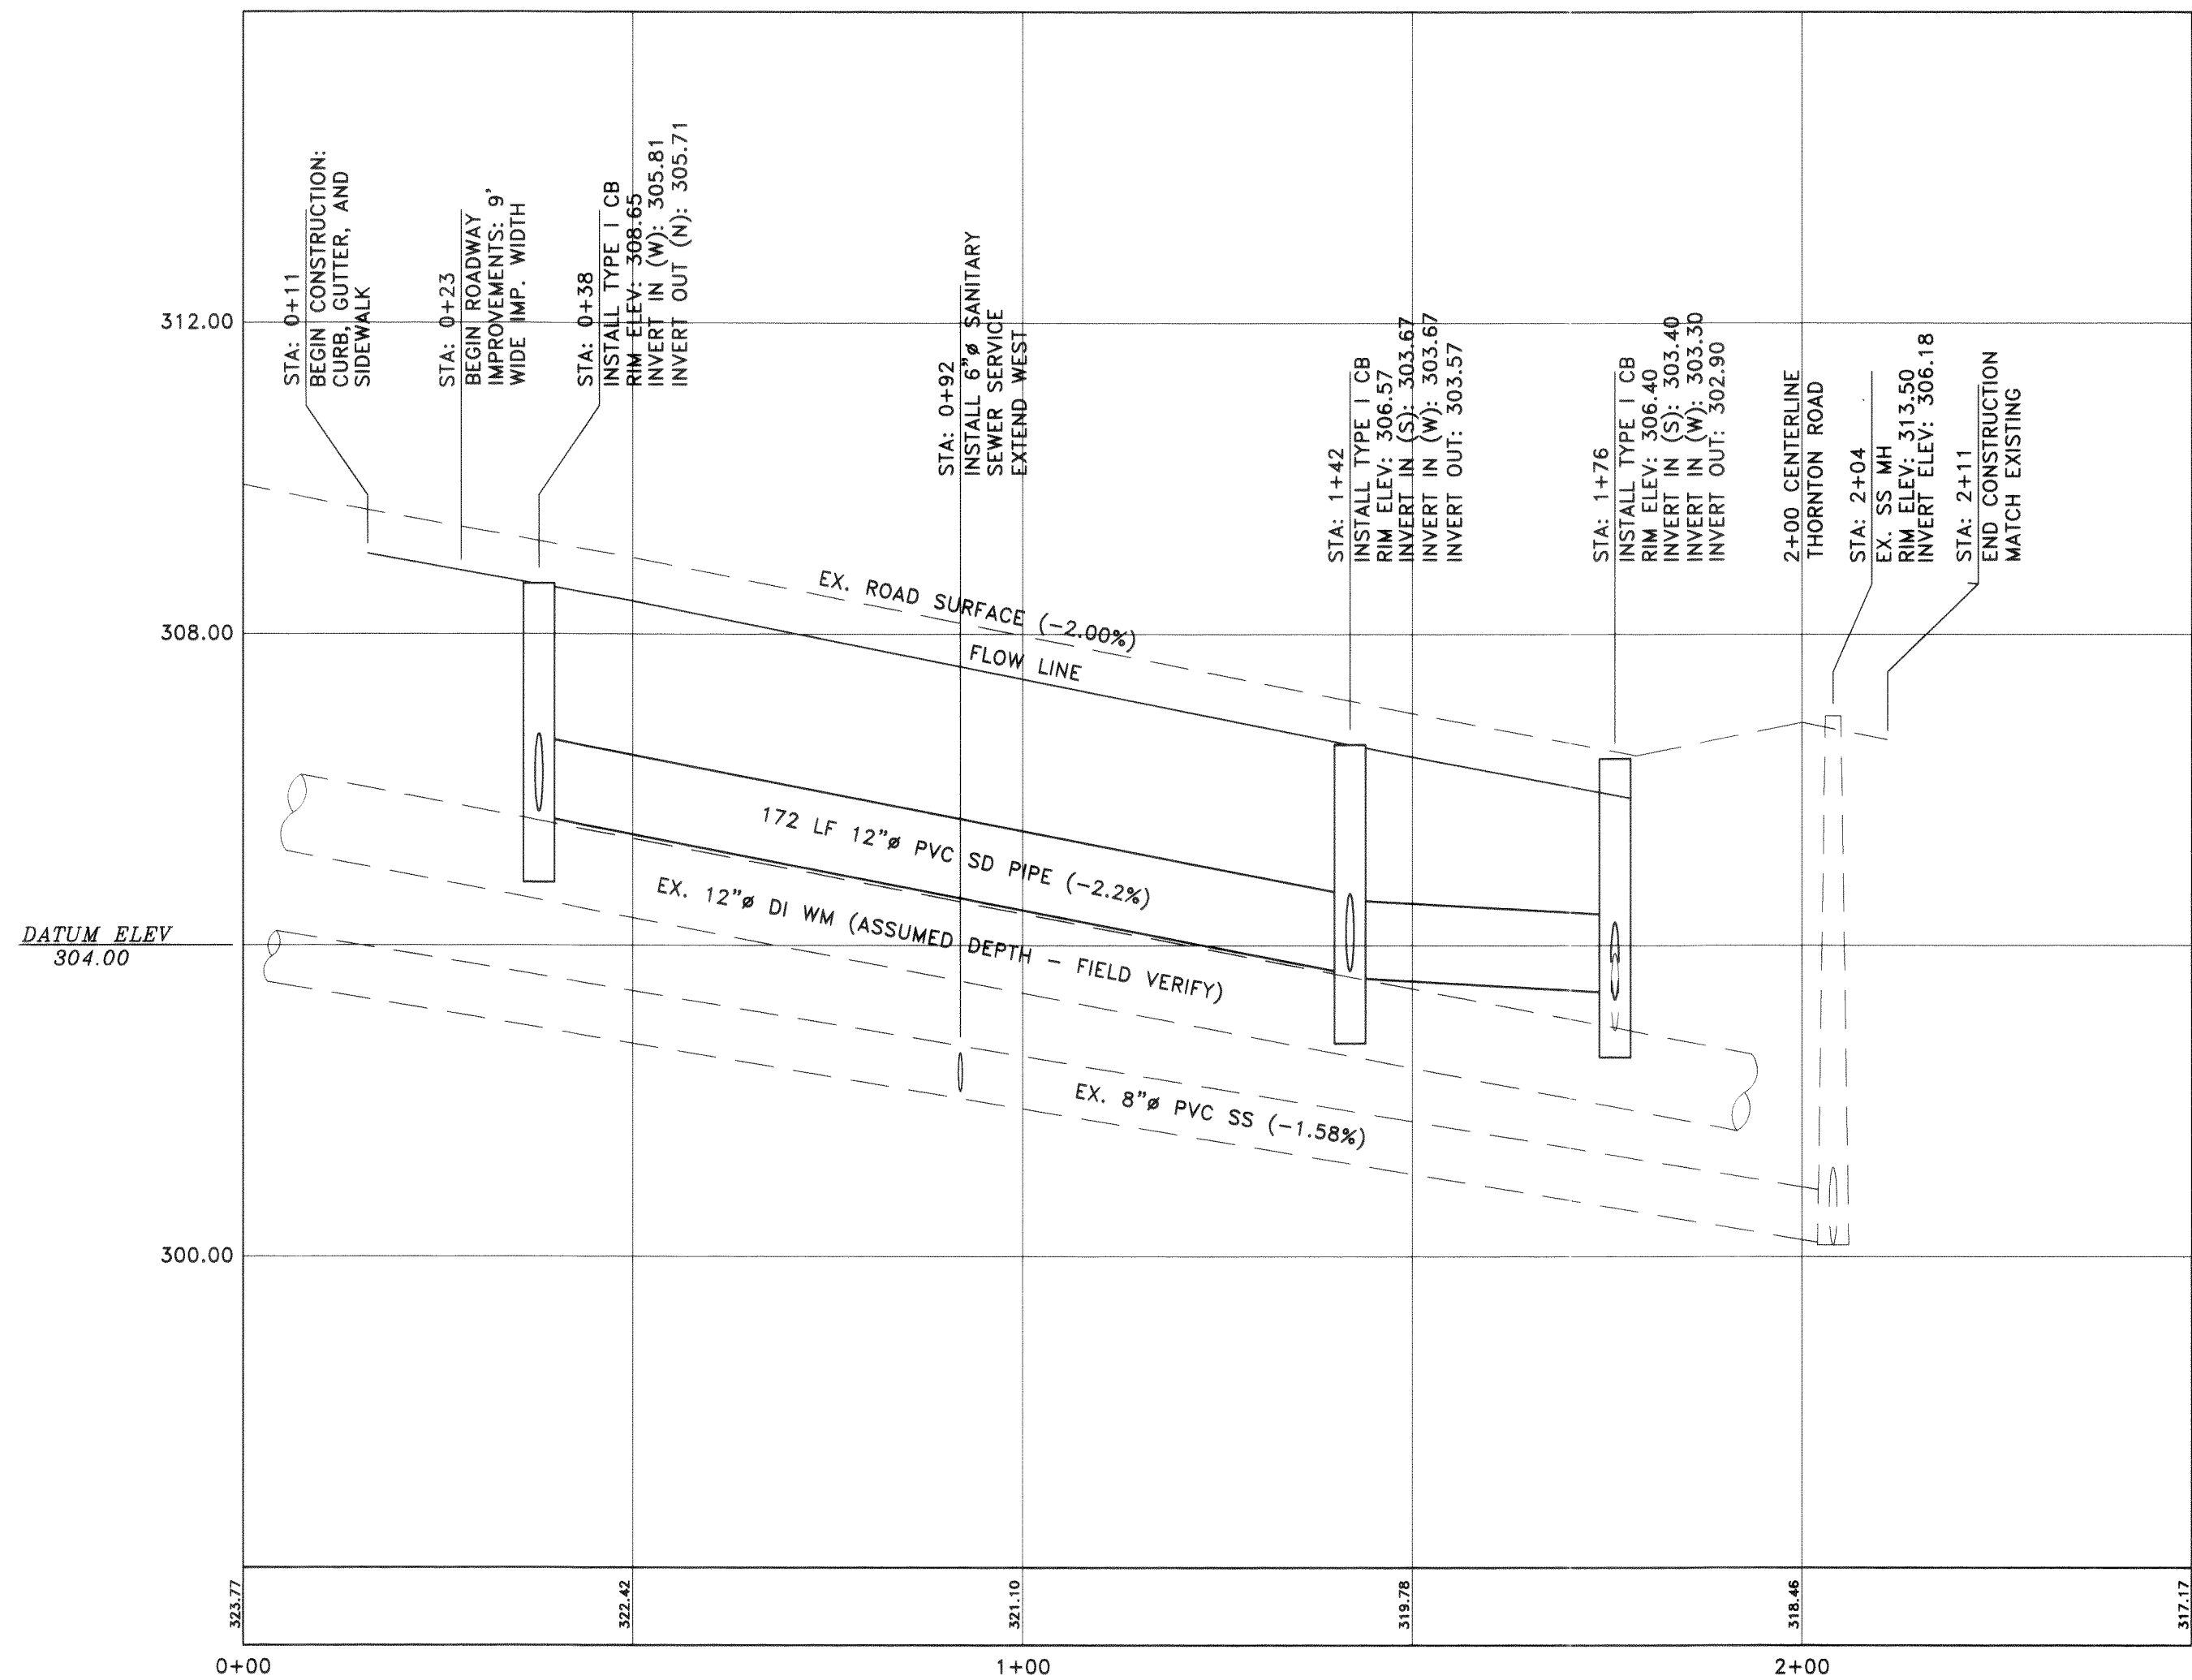

CHURCH ROAD PROFILE

SCALE:
HORIZ. 1"=20'
VERT. 1"=2'

RECORD DRAWING

REVISIONS:				DRAWN BY	DATE	CHECKED BY	DATE	SEAL:	HORIZONTAL SCALE: 1"=20'		CLIENT:	JOB NO.: 97-109	
1	REDLINES PER CITY OF PERINGALE	BDS	07-21-98					12-23-98 98  99	VERTICAL SCALE: 1"=2'	DRAWN BY: BDS	NORTHSHORE CORPORATION		ACAD FILE: CHURPROF.DWG
2	REDLINES PER CITY OF PERINGALE	BDS	08-11-98						DATE: 07-21-98	APPROVED BY:	PROJECT: CHURCH AND THORNTON IMPROVEMENTS		SHEET: 4
3	RECORD DRAWING PER IN FIELD AS-BUILTS	BDS	11-12-98								TITLE: CHURCH ROAD PROFILE		OF: 4
4	REDLINES PER CITY OF PERINGALE	BDS	12-23-98										
									NORTH ROTATION:				
									ASSOCIATED PROJECT CONSULTANTS, INC., P.S. PROFESSIONAL CONSULTING ENGINEERS 1401 ASTOR STREET BELLINGHAM, WASHINGTON 98225 (360) 671-1148				

ASSOCIATED
PROJECT CONSULTANTS, INC., P.S.
PROFESSIONAL CONSULTING ENGINEERS
1401 ASTOR STREET BELLINGHAM, WASHINGTON 98225 (360) 671-1146