


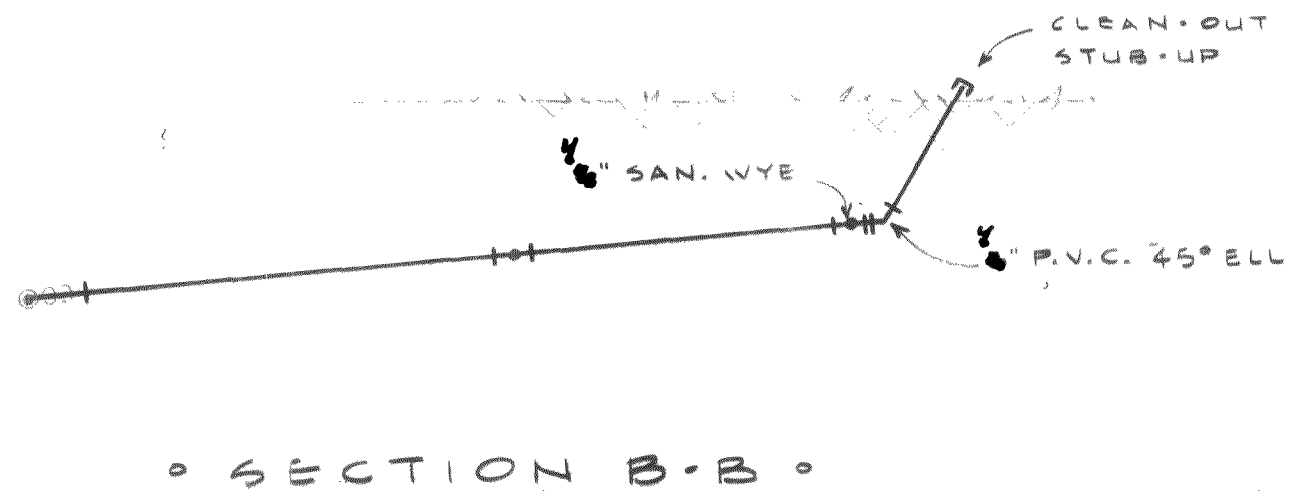
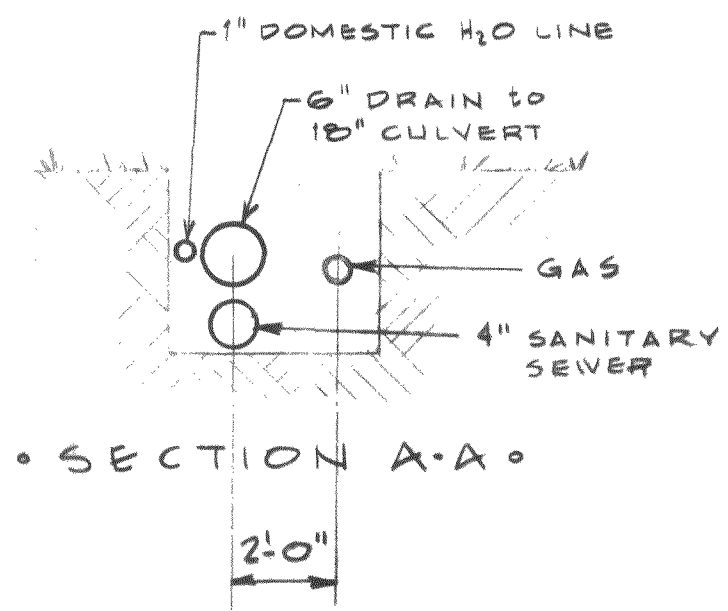
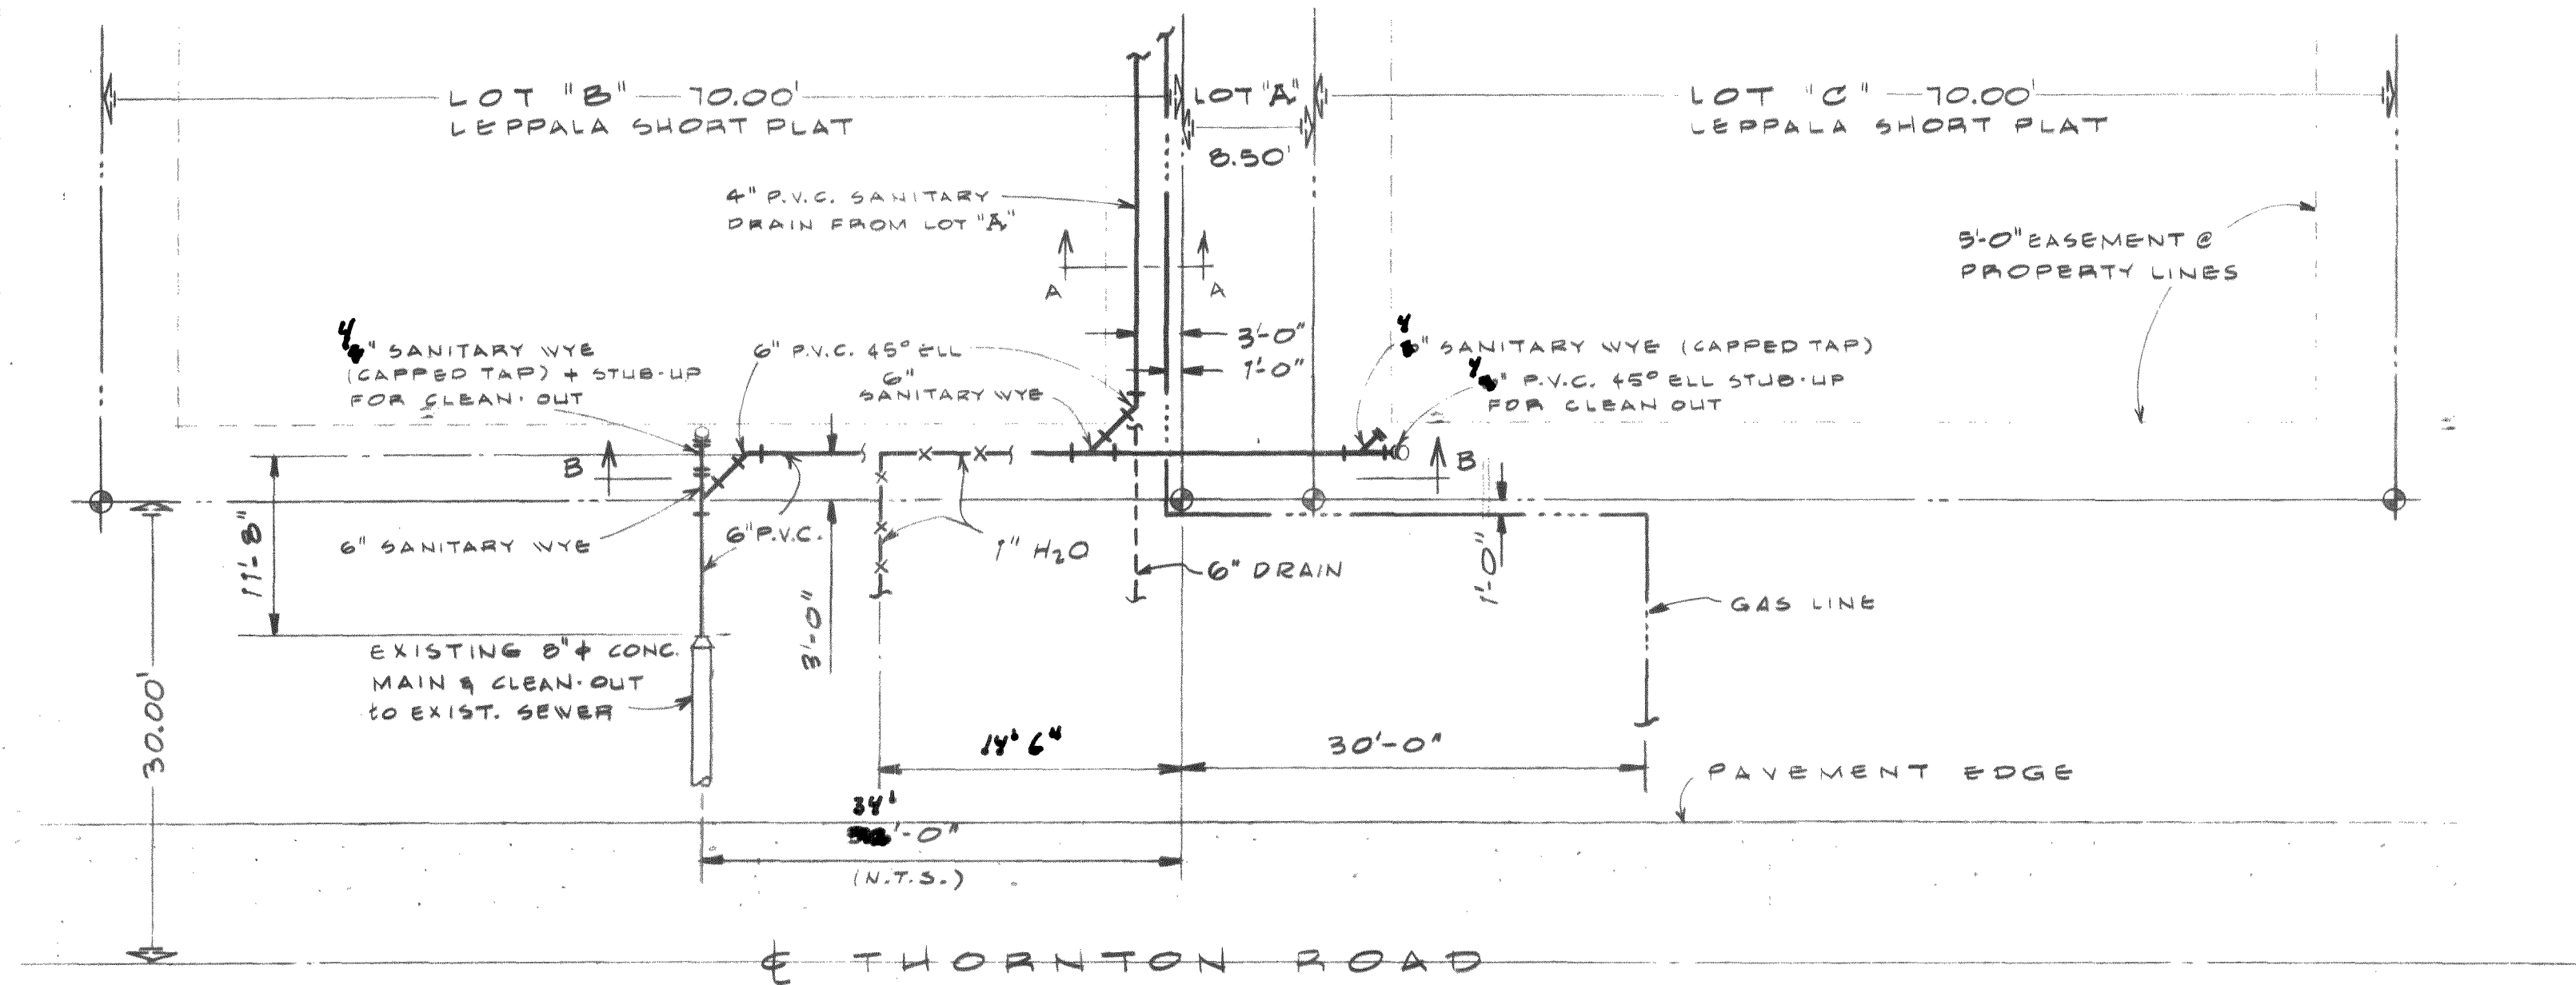


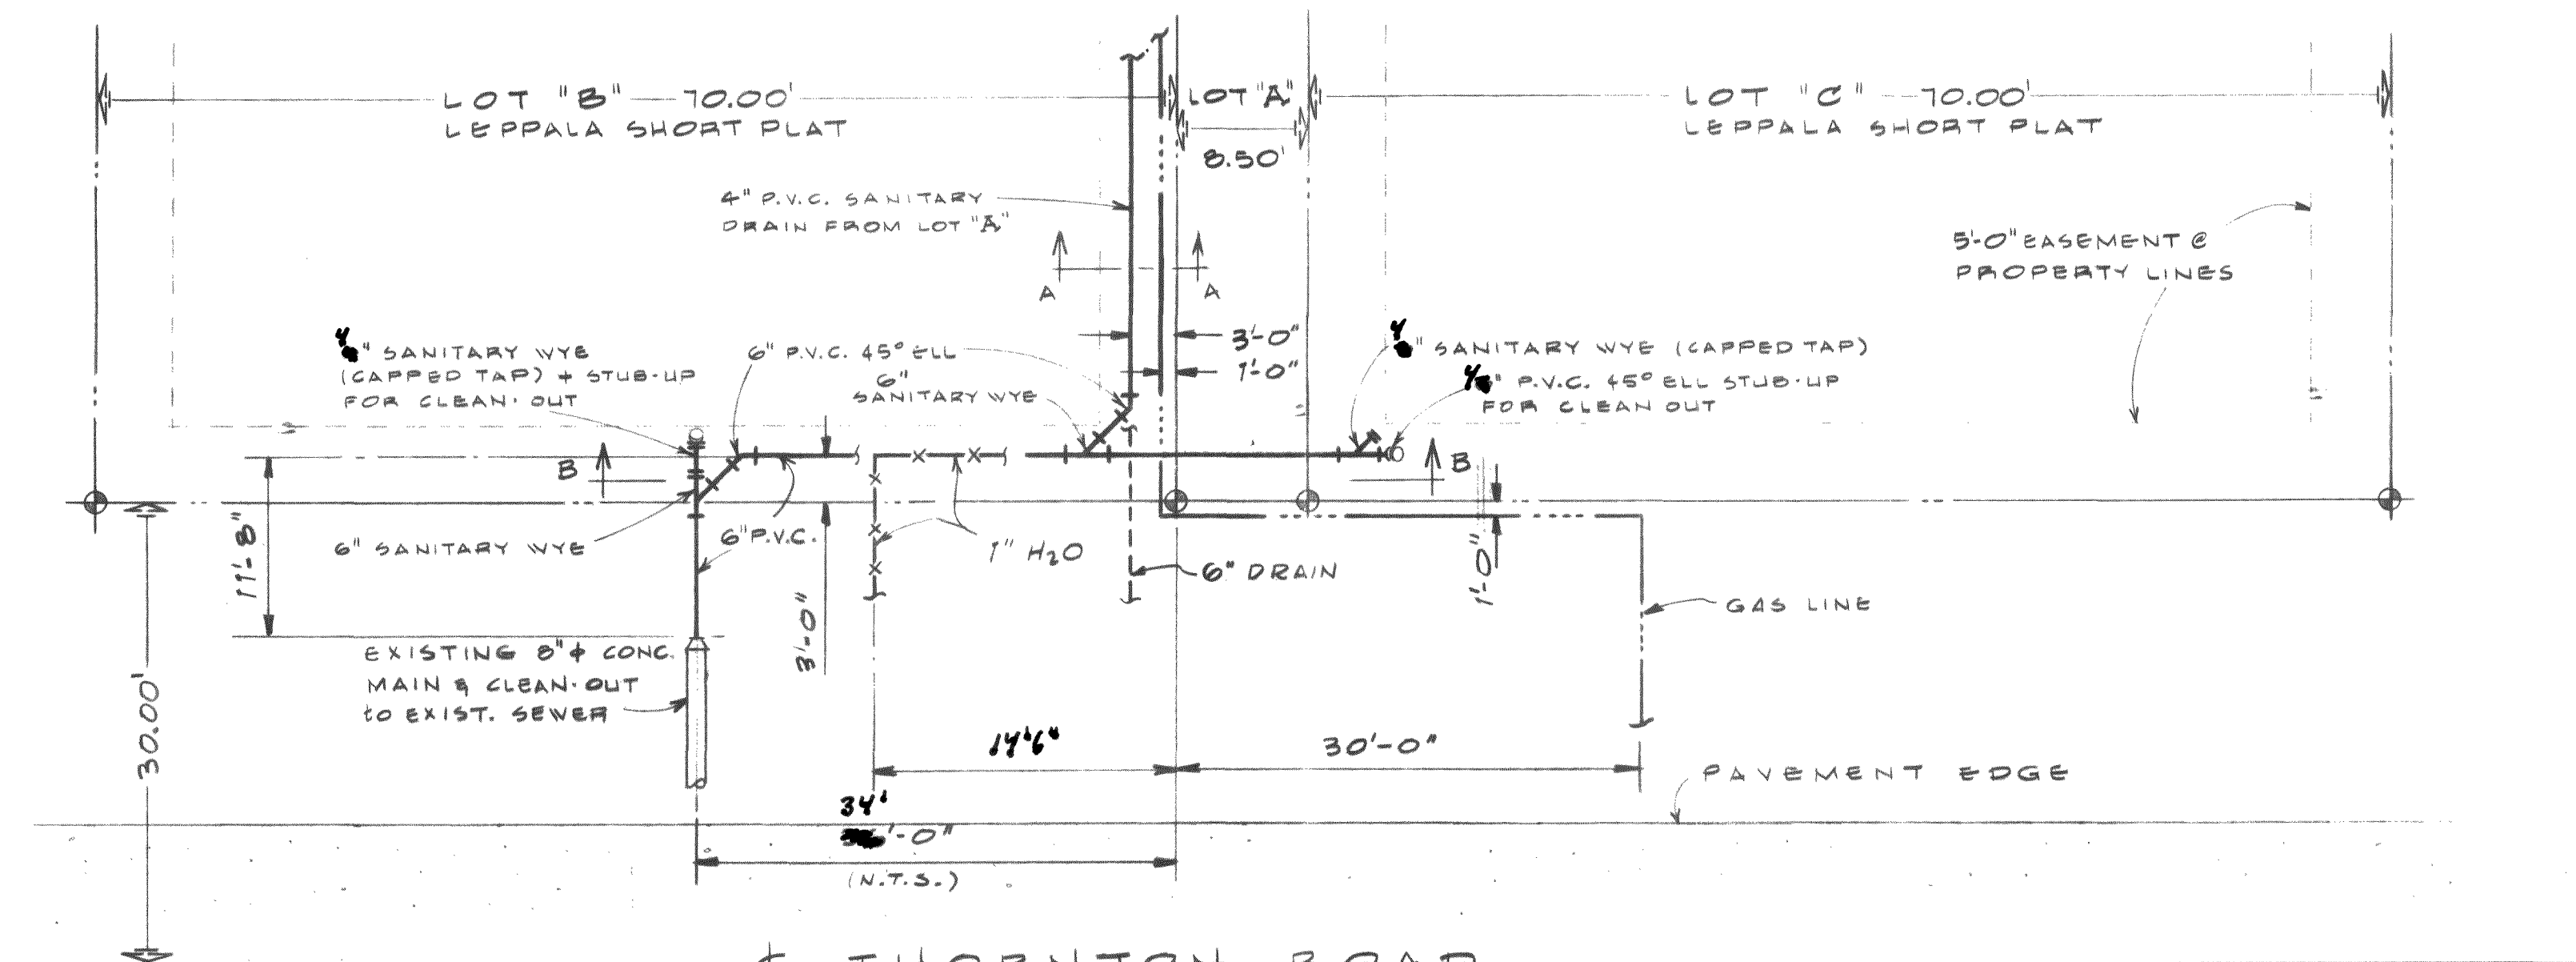

6" SEWER LINE FOR LOTS "A", "B" & "C"
LEPPALA SHORT PLAT
AS RECORDED AUG 30, 1978
1361 THORNTON RD.
FERNDAL, WASHINGTON

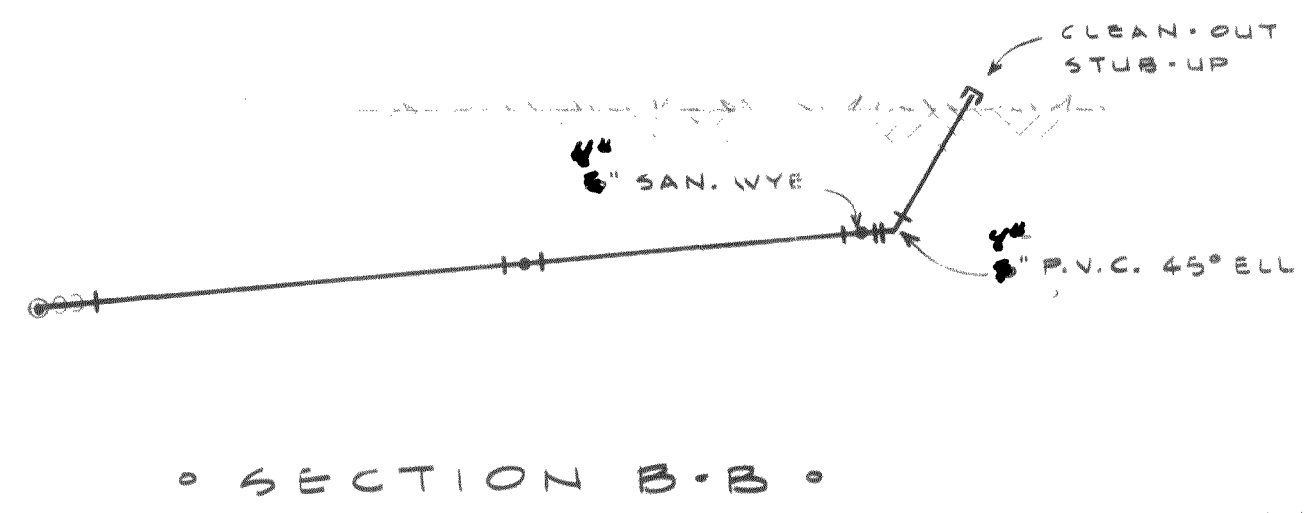

PLAN VIEW - NORTH
SCALE @ 1" = 10.00'

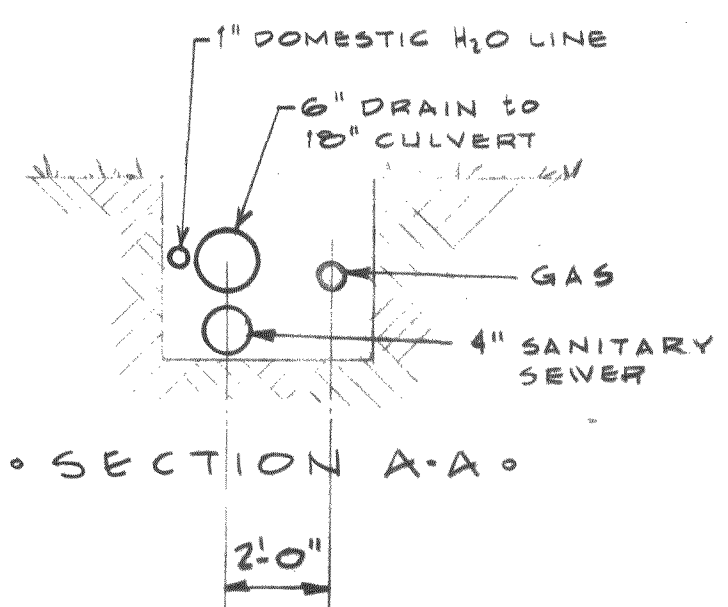

6" SEWER LINE FOR LOTS "A", "B" & "C"
LEPPALA SHORT PLAT
AS RECORDED AUG 30, 1978
1361 THORNTON RD.
FERNOALE, WASHINGTON