


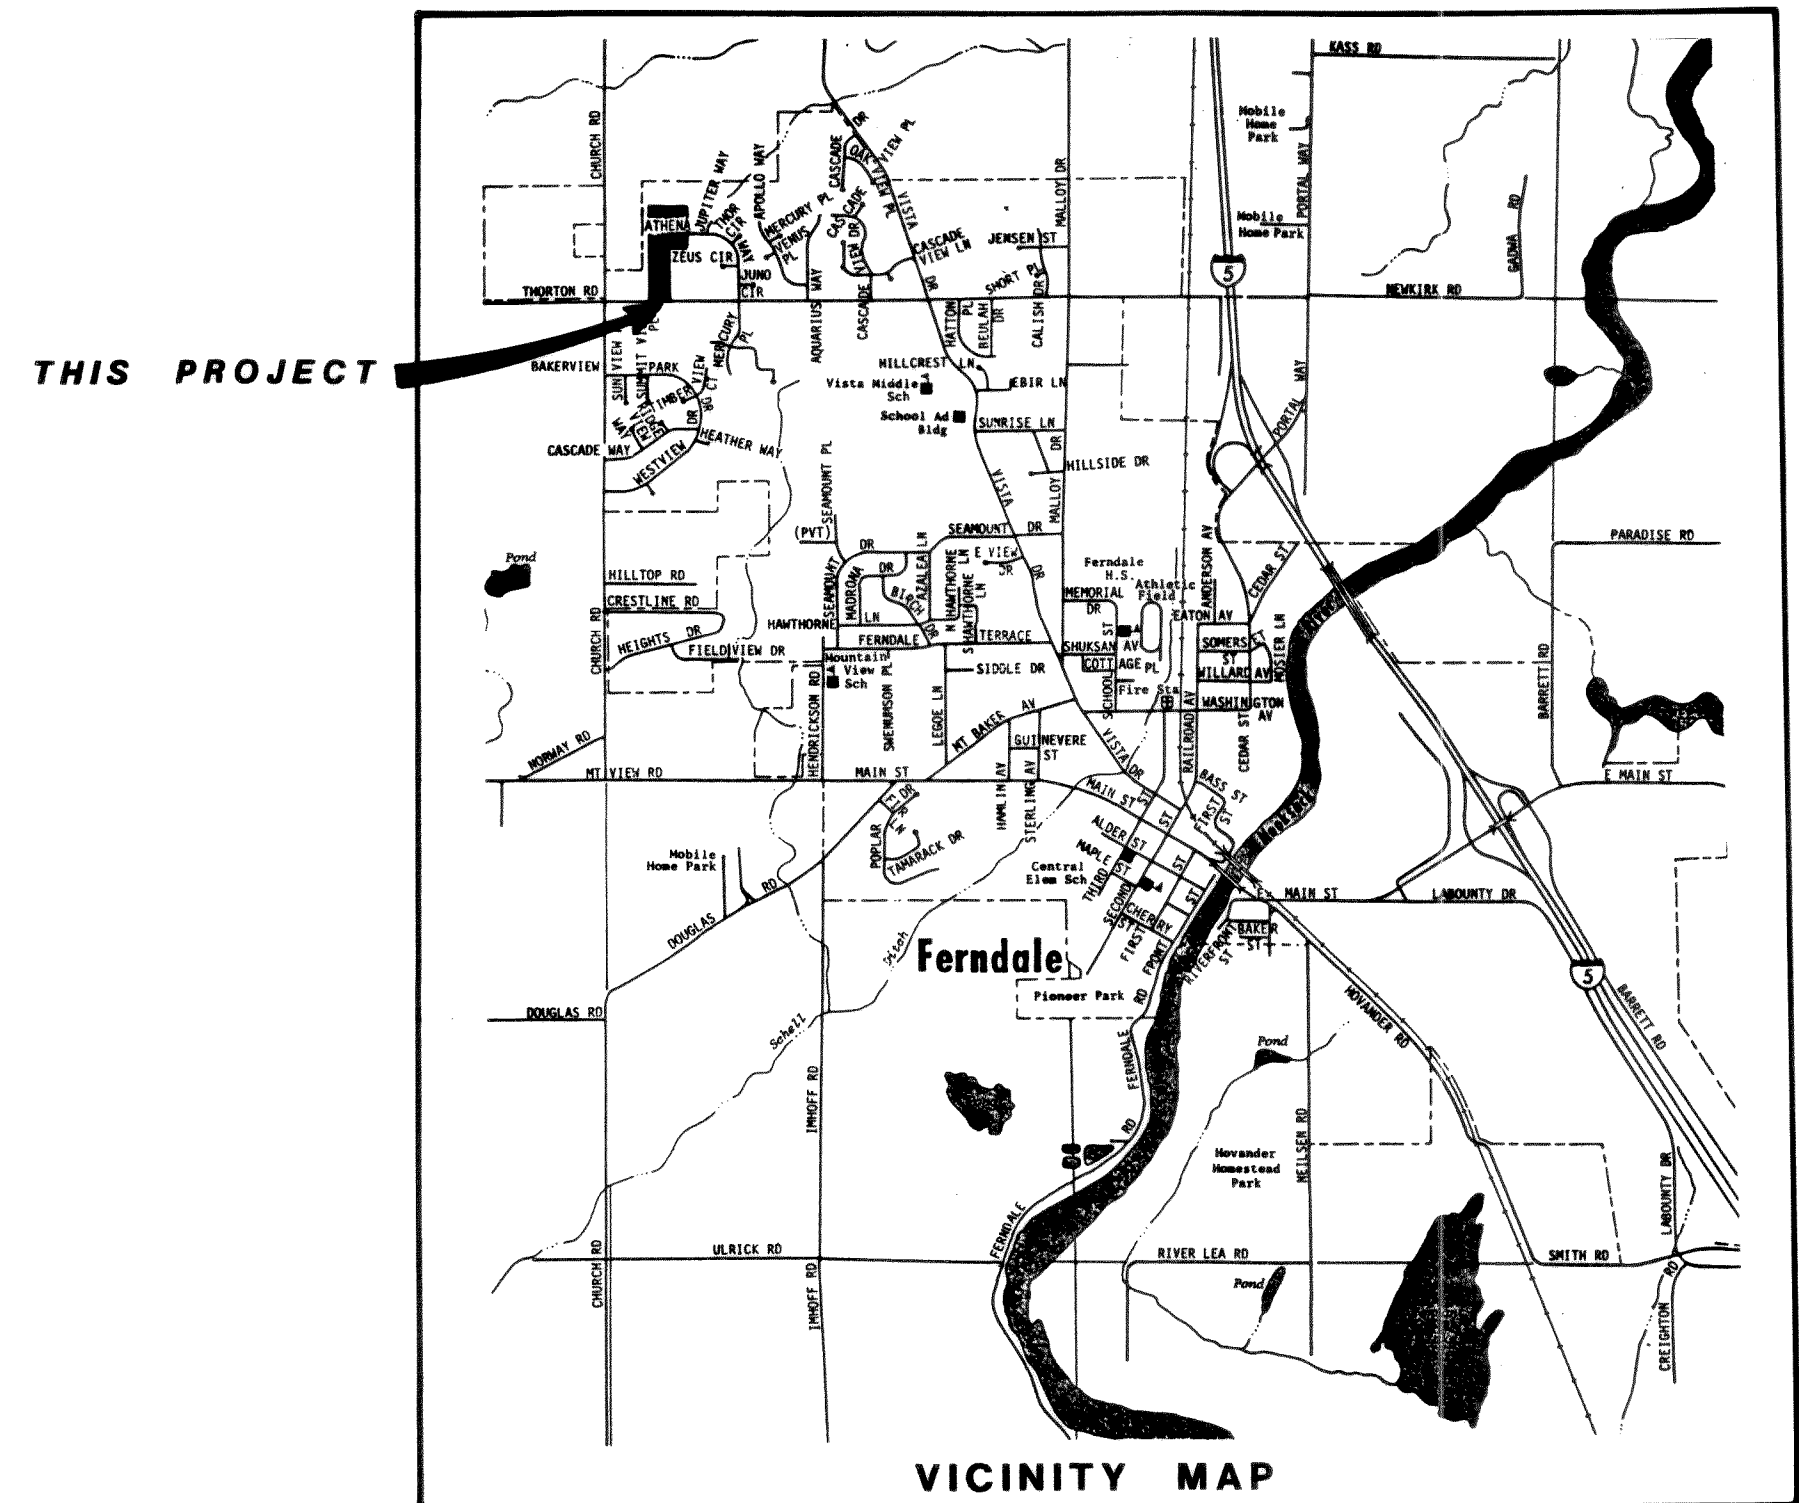


CONSTRUCTION PLANS AND SPECIFICATIONS

FOR

EVERGREEN PLACE


INDEX OF SHEETS

1. ROAD AND DRAINAGE PLAN
2. SANITARY SEWER PLAN
3. WATER DISTRIBUTION SYSTEM PLAN
4. ROAD AND DRAINAGE PROFILES
5. ROAD AND DRAINAGE PROFILES
6. SANITARY SEWER PROFILES
7. SANITARY SEWER PROFILES





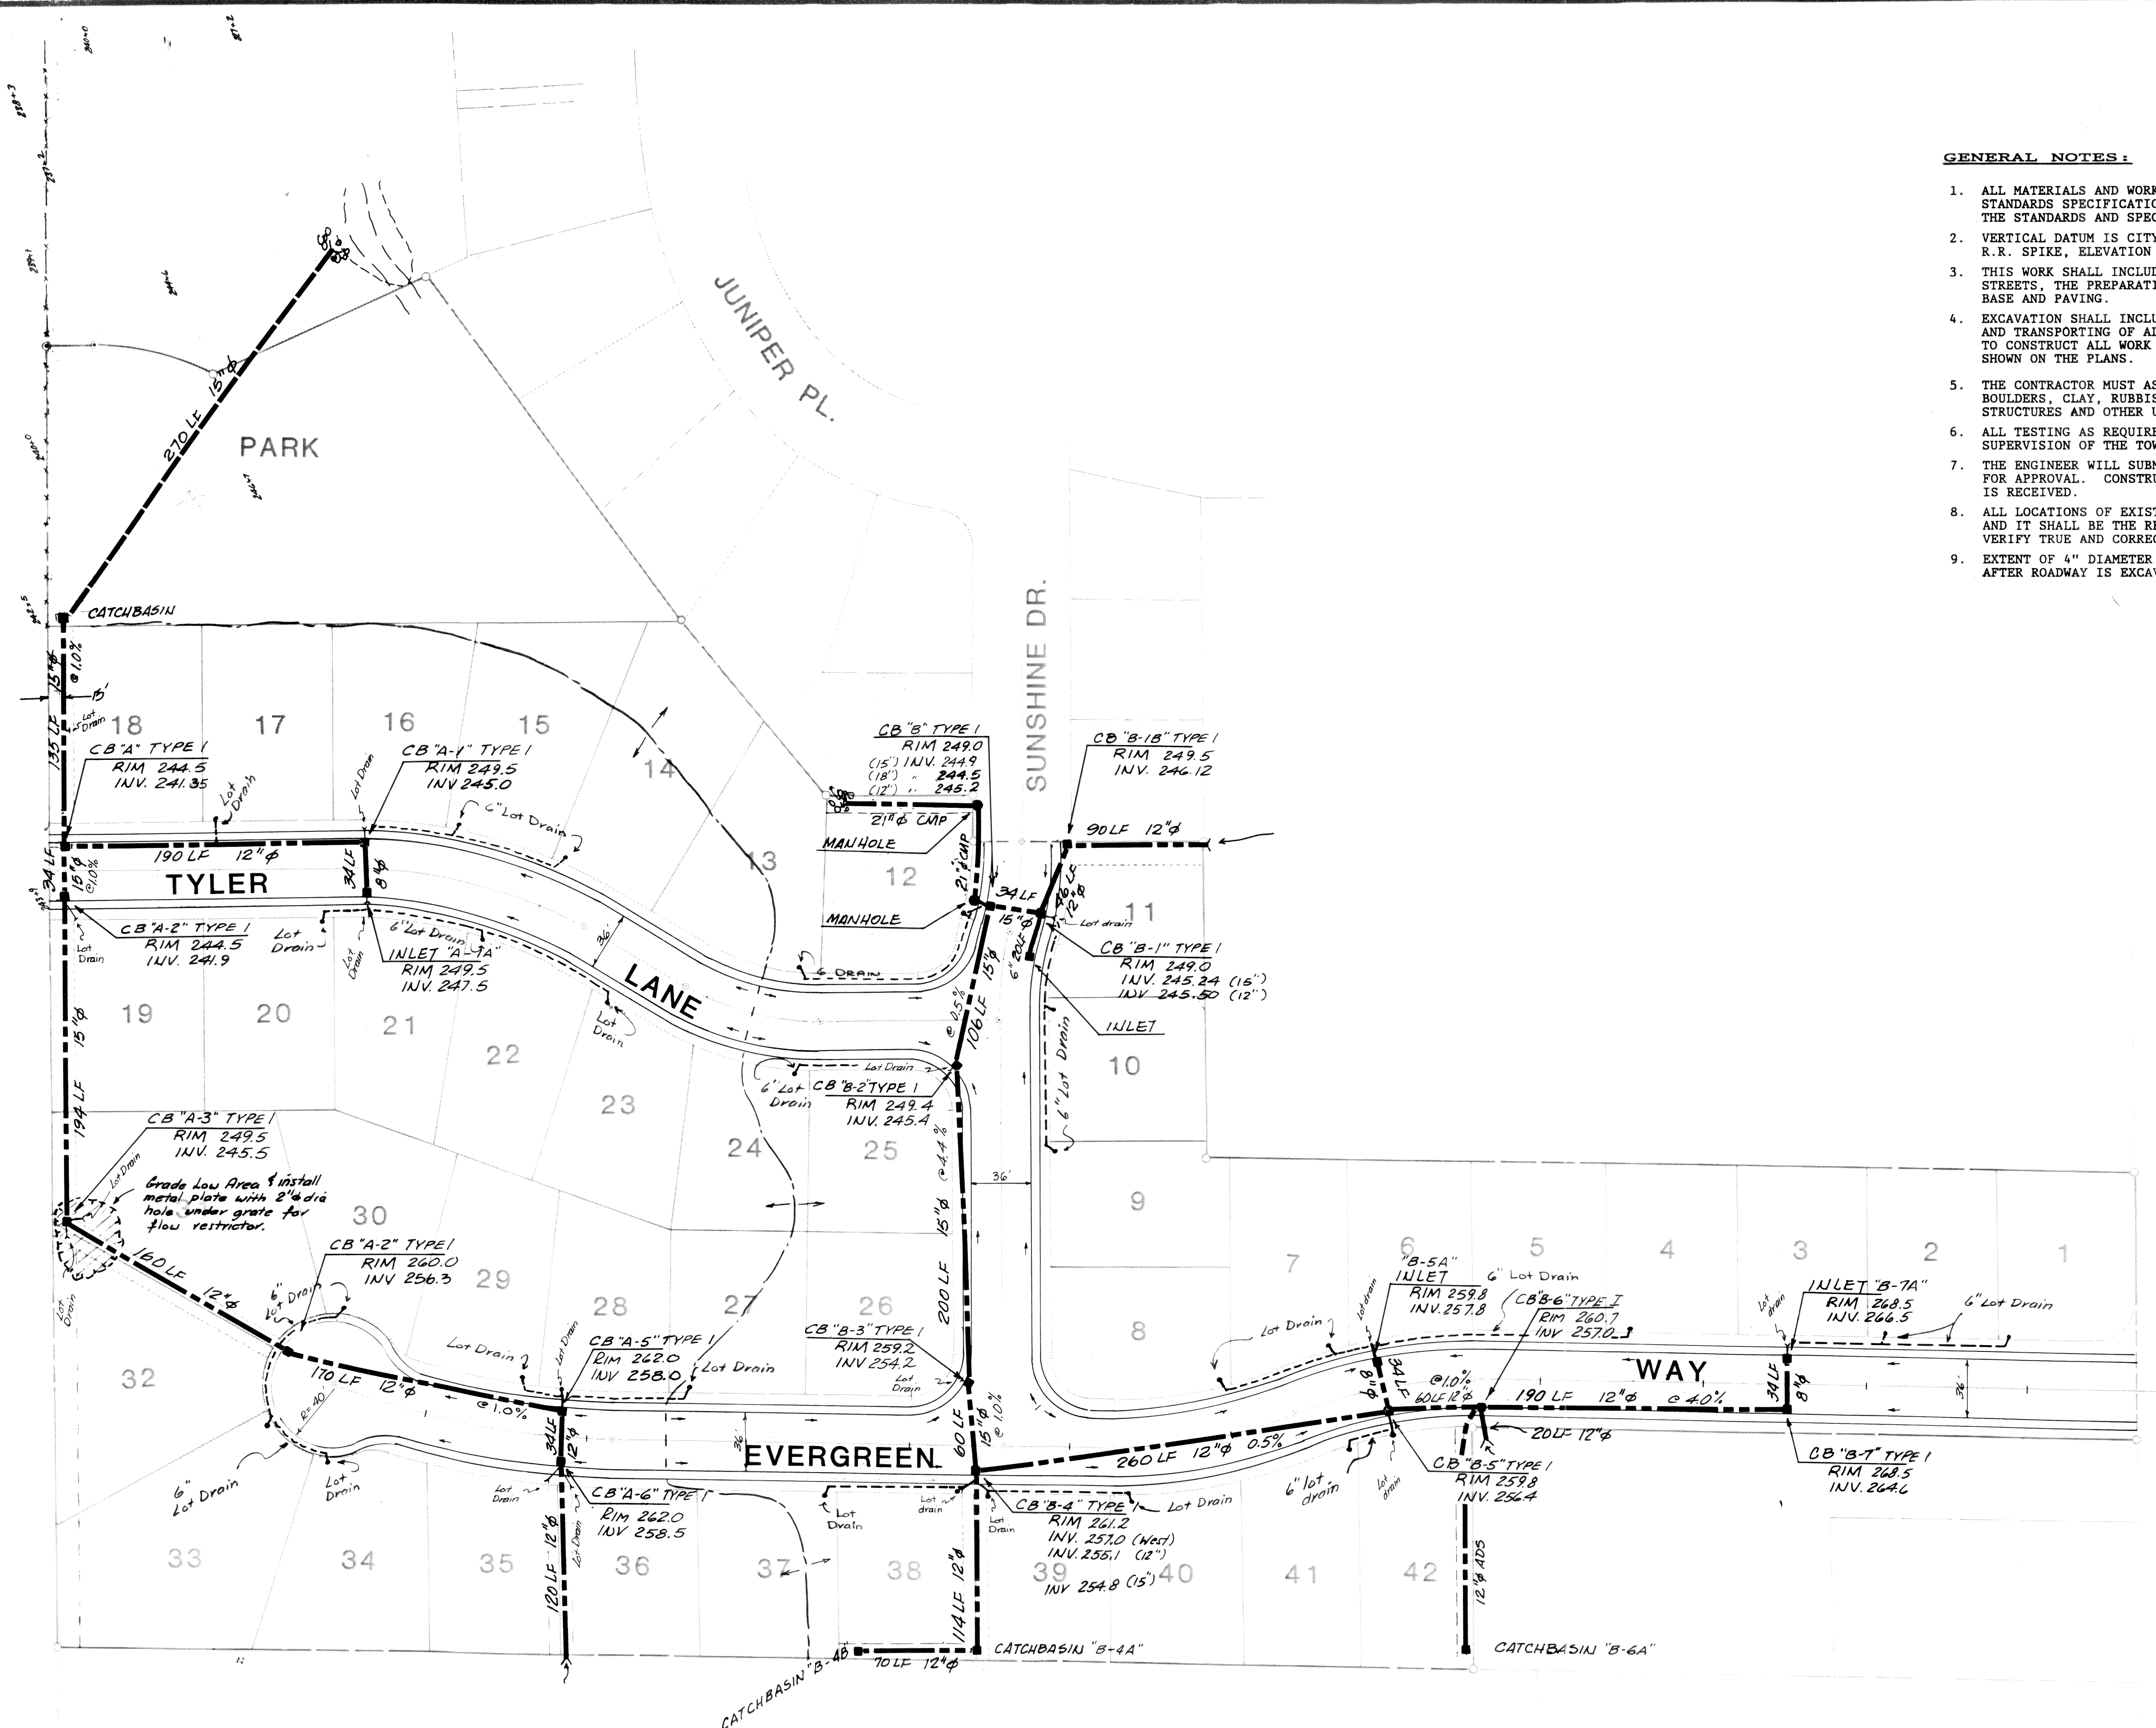


- GENERAL NOTES:**
1. ALL MATERIALS AND WORKMANSHIP SHALL CONFORM TO THE A.P.W.A. STANDARDS SPECIFICATIONS, 1977 EDITION, AND ACCORDANCE WITH THE STANDARDS AND SPECIFICATIONS OF THE CITY OF FERNDALE.
 2. VERTICAL DATUM IS CITY OF FERNDALE POWER POLE NO. 38973 R.R. SPIKE, ELEVATION 234.42.
 3. THIS WORK SHALL INCLUDE ALL EXCAVATION AND EMBANKMENT FOR STREETS, THE PREPARATION OF SUBGRADE, AND INSTALLATION OF BASE AND PAVING.
 4. EXCAVATION SHALL INCLUDE THE CLEARING OF THE SITE, LOADING AND TRANSPORTING OF ALL MATERIALS, WET OR DRY, NECESSARY TO CONSTRUCT ALL WORK TO THE LINES, GRADES, AND LOCATIONS SHOWN ON THE PLANS.
 5. THE CONTRACTOR MUST ASSUME THE RISK OF MEETING QUICKSAND, BOULDERS, CLAY, RUBBISH, EXISTING UTILITY LINES, MASONRY STRUCTURES AND OTHER UNFORSEEN OBSTACLES.
 6. ALL TESTING AS REQUIRED SHALL BE CONDUCTED UNDER THE SUPERVISION OF THE TOWN ENGINEER'S OFFICE.
 7. THE ENGINEER WILL SUBMIT THE PLANS TO THE CITY OF FERNDALE FOR APPROVAL. CONSTRUCTION IS PROHIBITED UNTIL SUCH APPROVAL IS RECEIVED.
 8. ALL LOCATIONS OF EXISTING UTILITIES SHOWN ARE APPROXIMATE AND IT SHALL BE THE RESPONSIBILITY OF THE CONTRACTOR TO VERIFY TRUE AND CORRECT LOCATIONS.
 9. EXTENT OF 4" DIAMETER SIDEWALK TO BE DETERMINED BY ENGINEER AFTER ROADWAY IS EXCAVATED TO SUBGRADE.

**AS BUILT
ROAD & DRAINAGE PLANS**

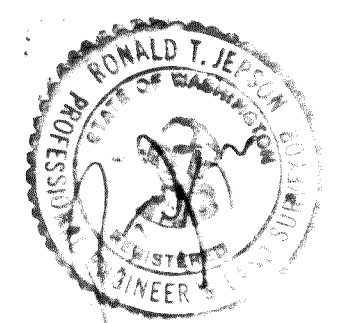

00042.002 2-10-06 K4

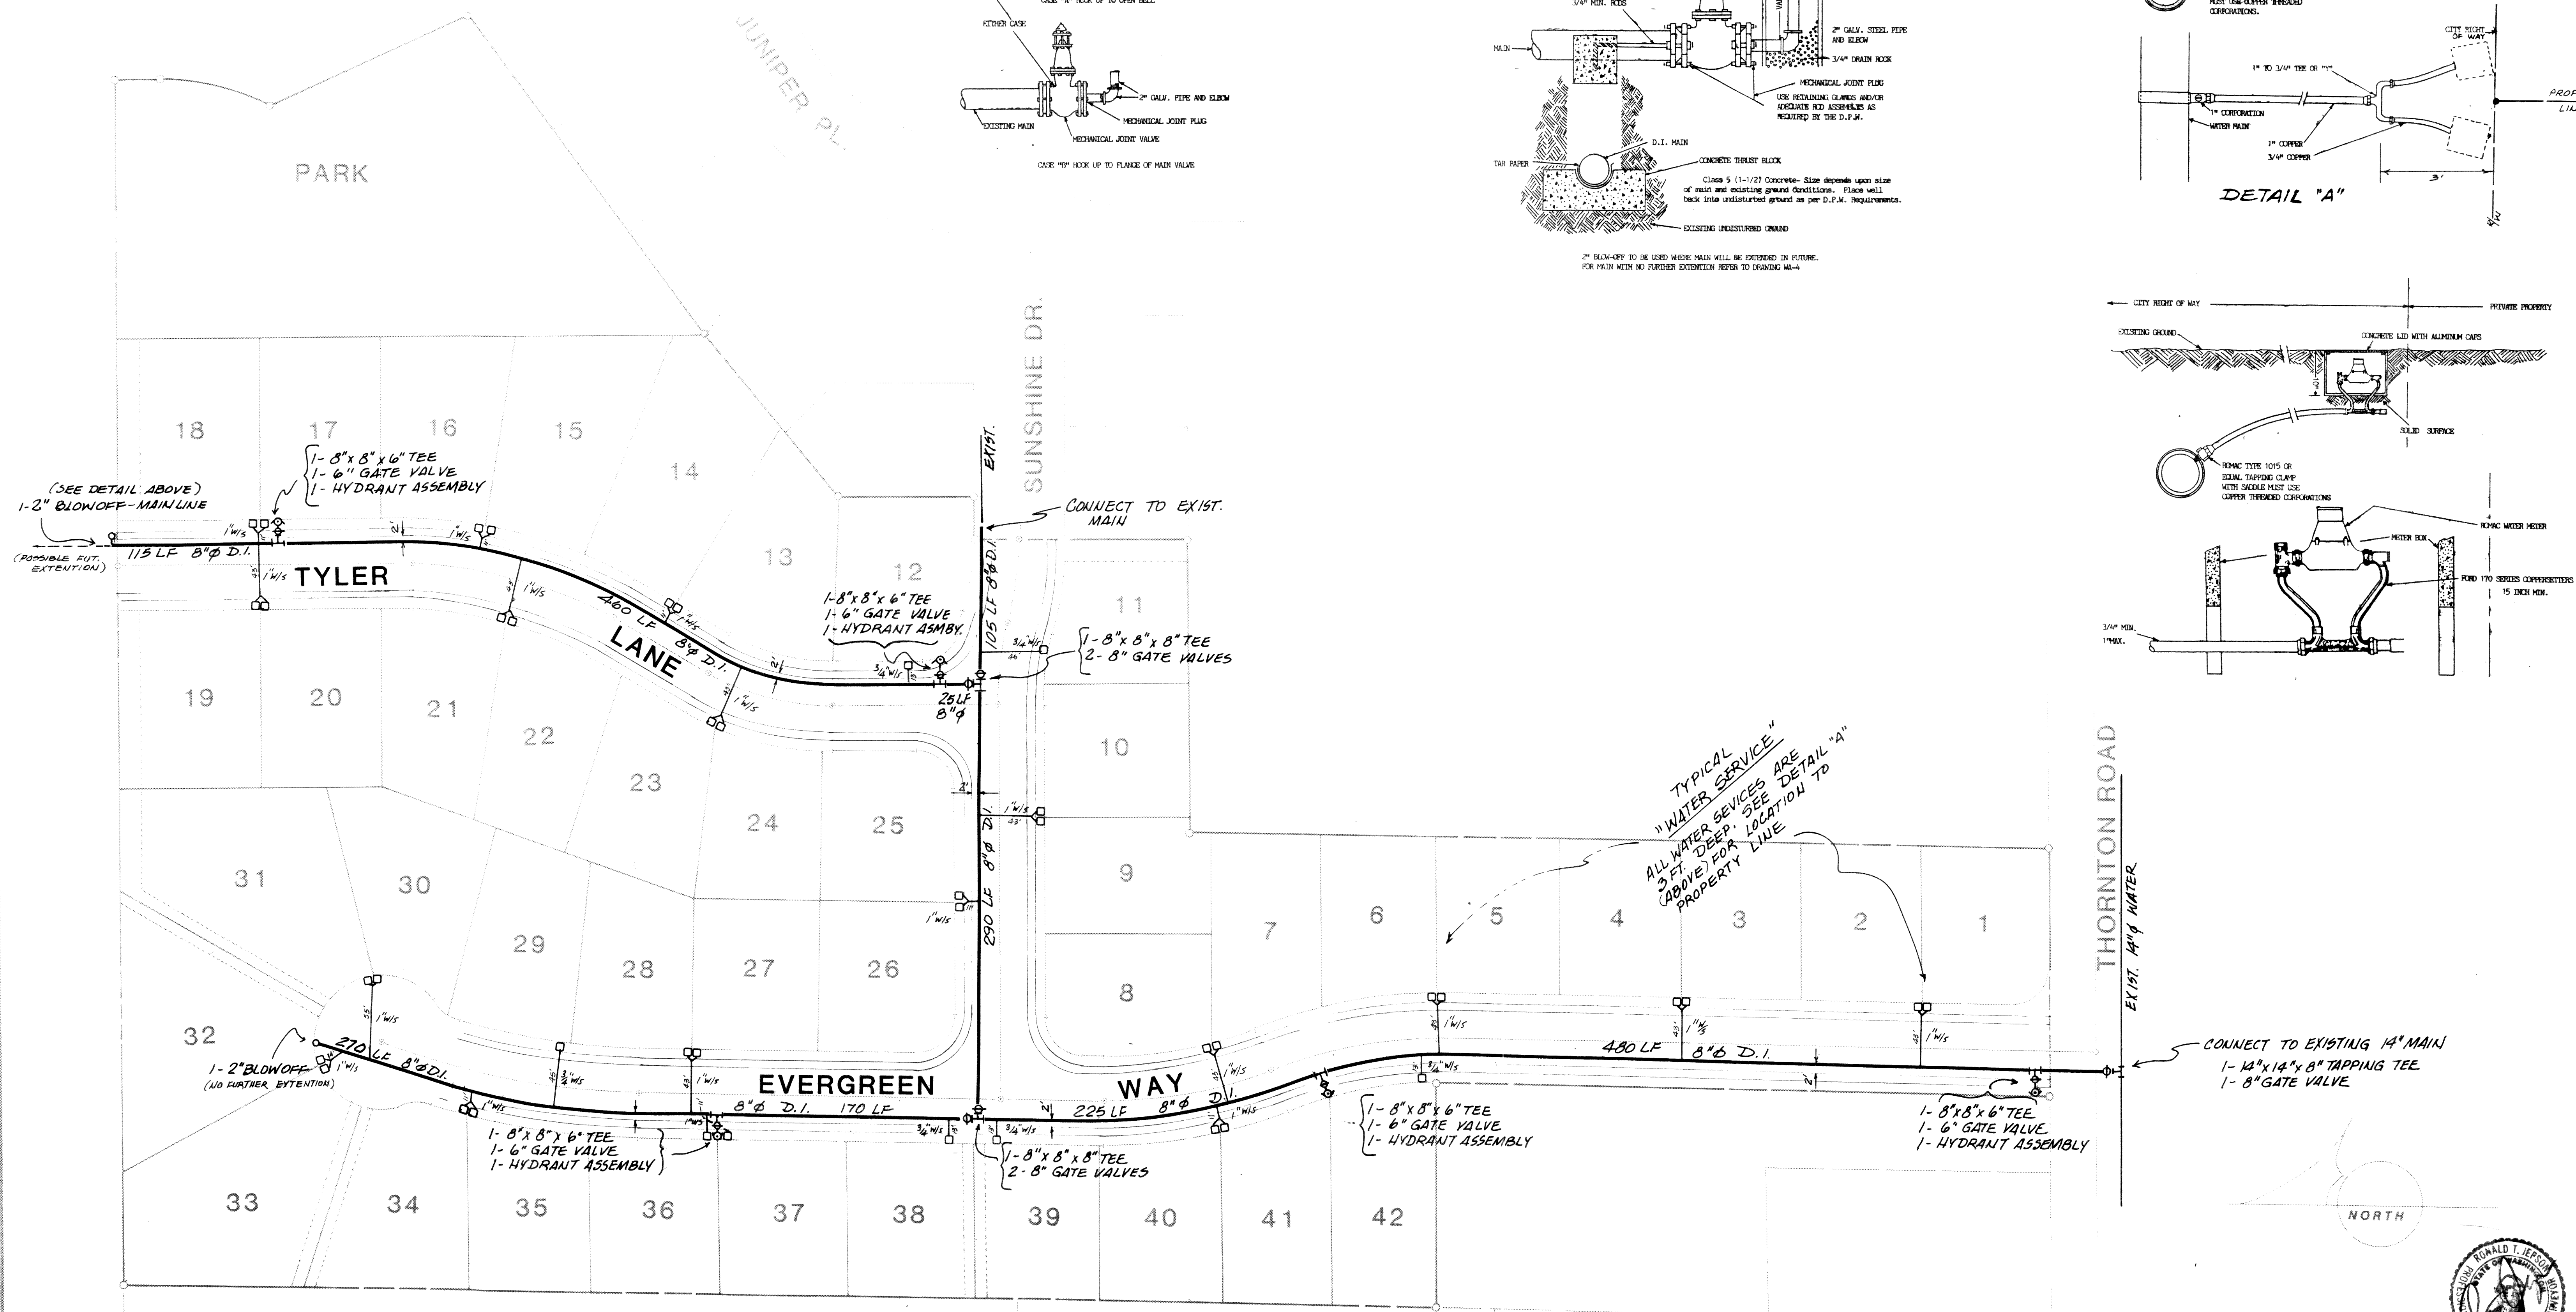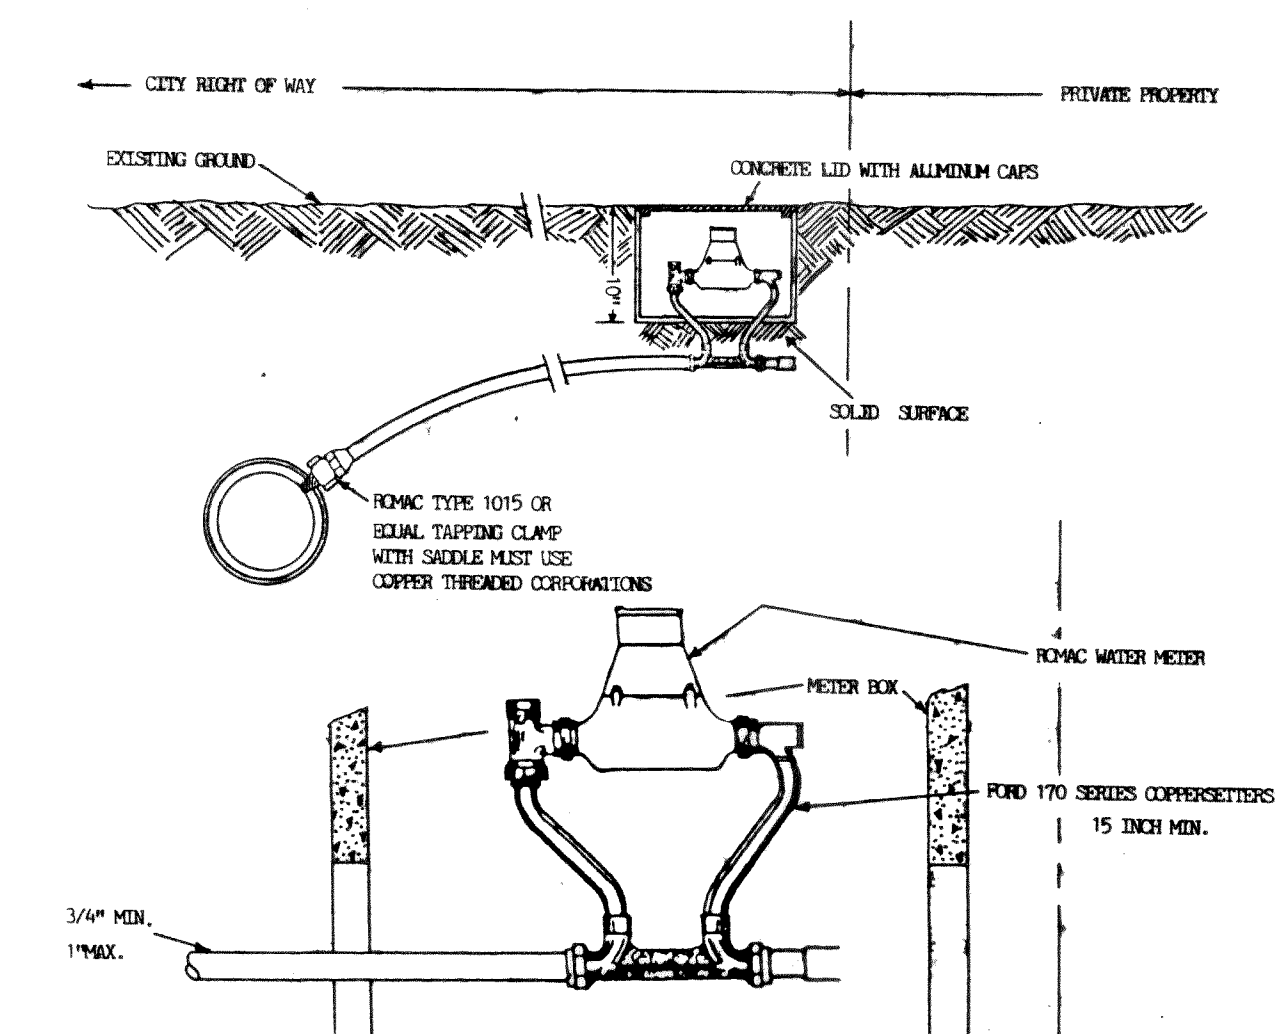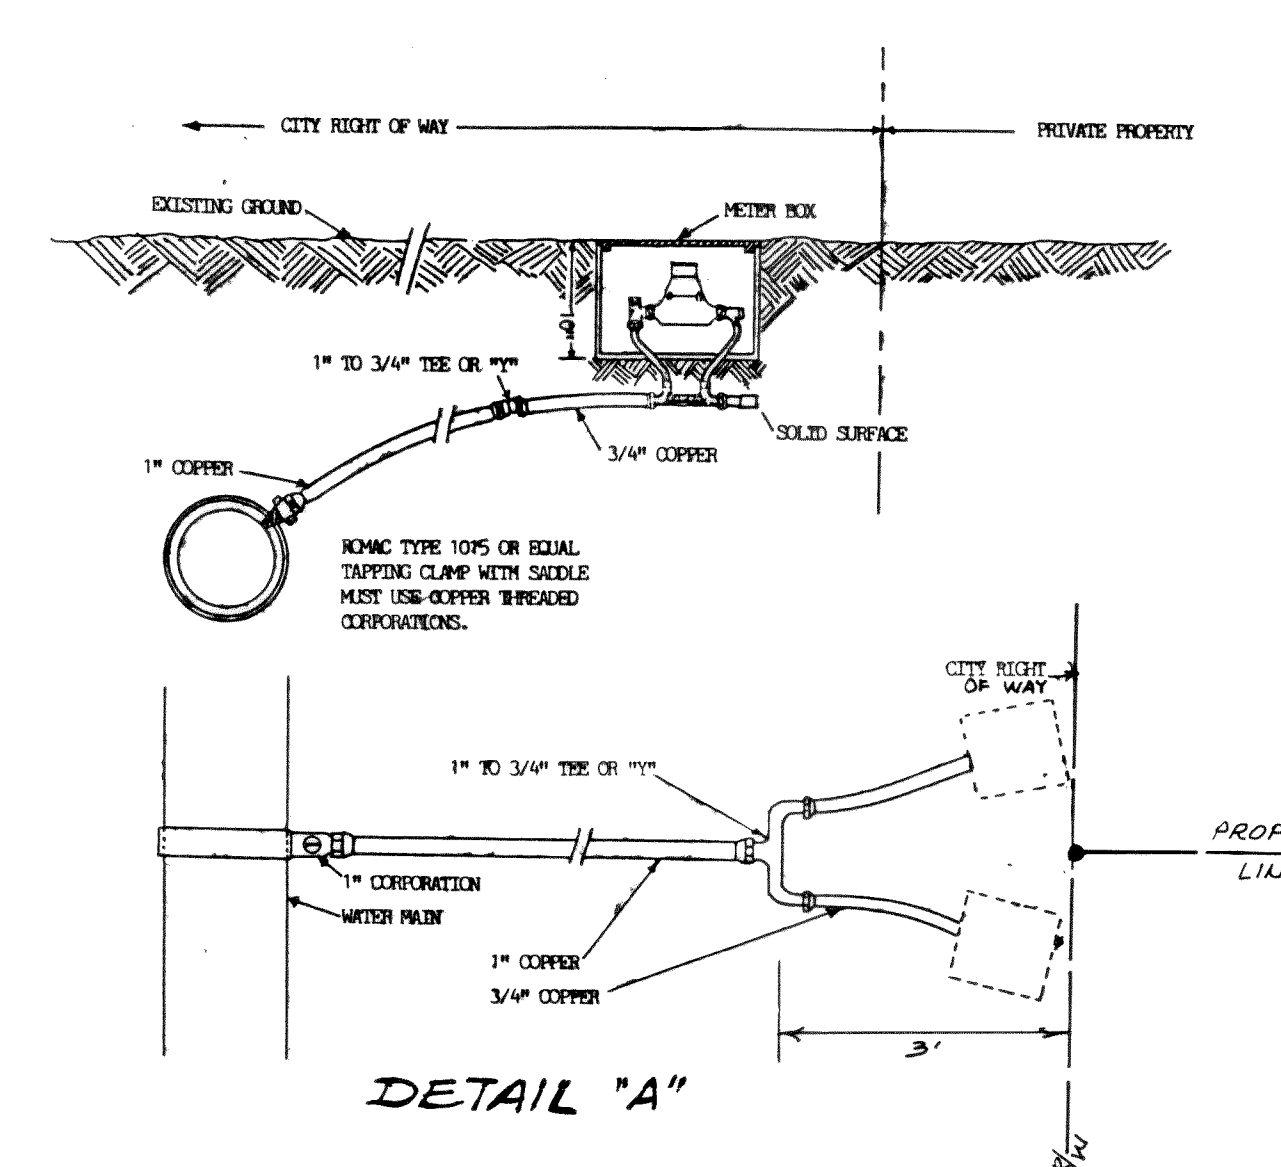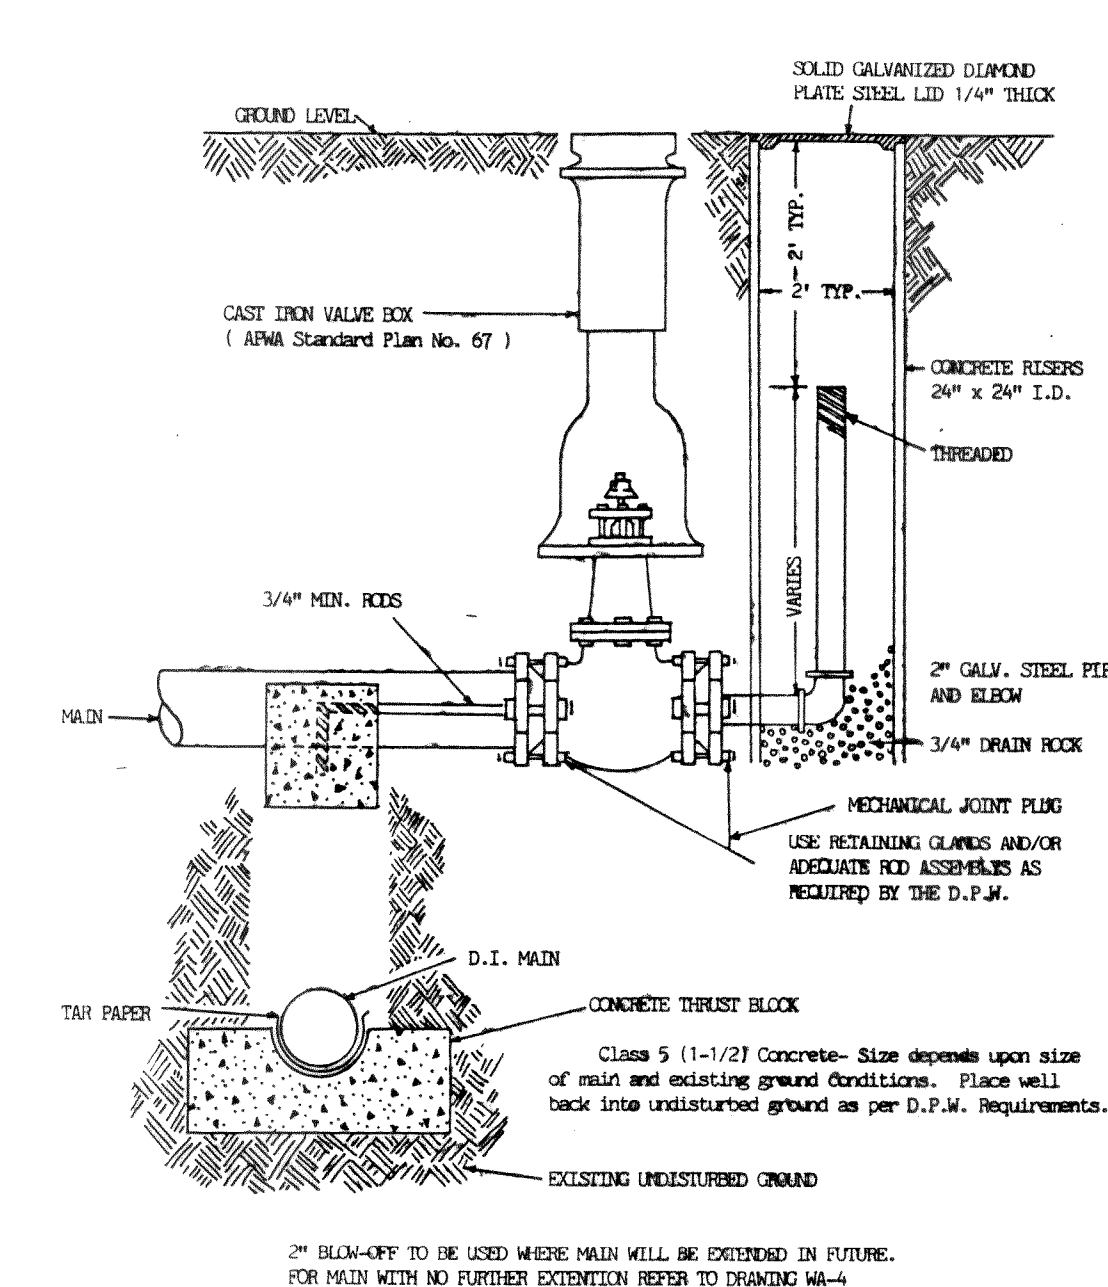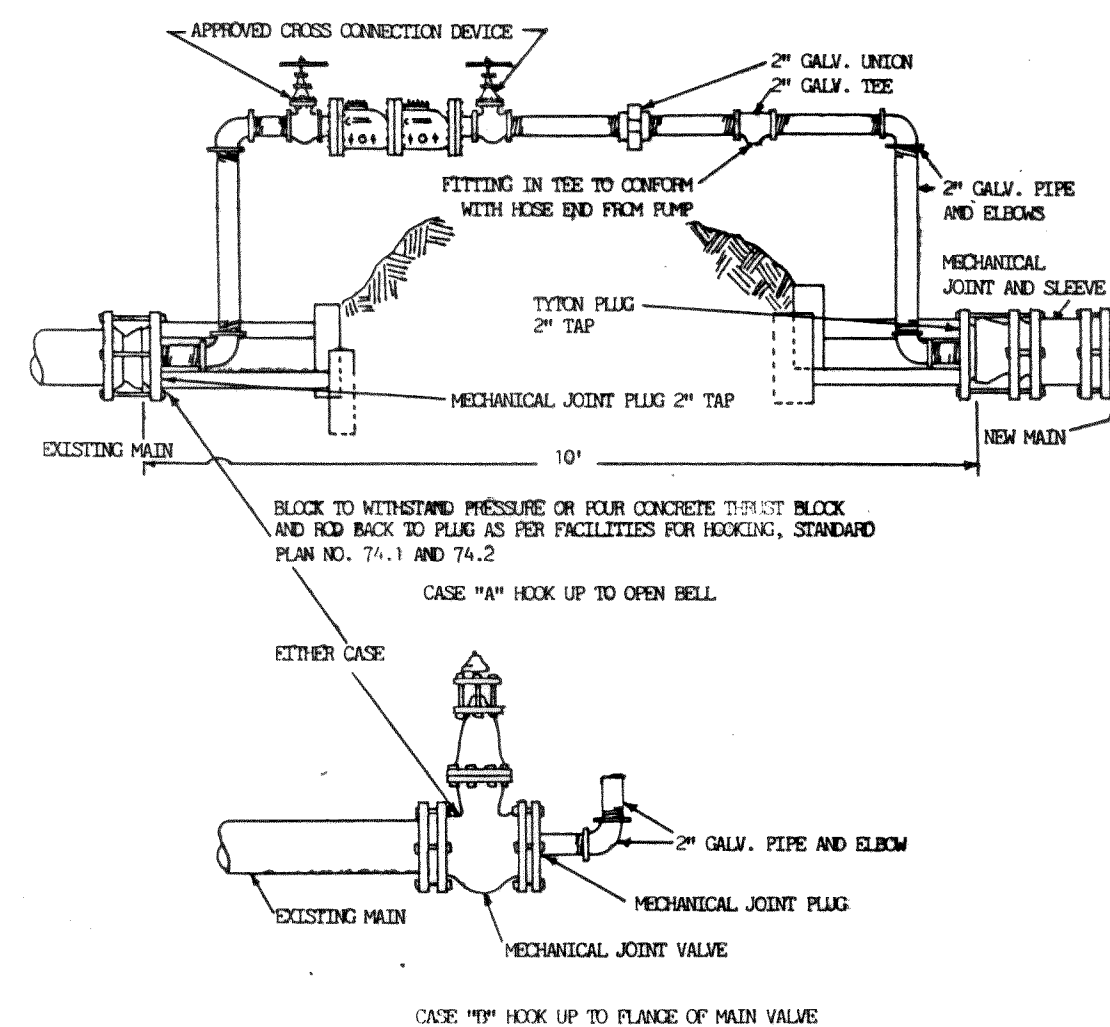

AS BUILT WATER DISTRIBUTION SYSTEM

RONALD T. JEPSON
REGISTERED PROFESSIONAL ENGINEERS AND LAND SURVEYORS



ASSOC.
BELLINGHAM, WASHINGTON 98225

DATE 1-50 DATE JUL '89
DRAWN BY AL
CHECKED BY _____
APPROVED _____


CLIENT:
KILMER / FENTON

EVERGREEN PLACE



SHEET
3
OF
7

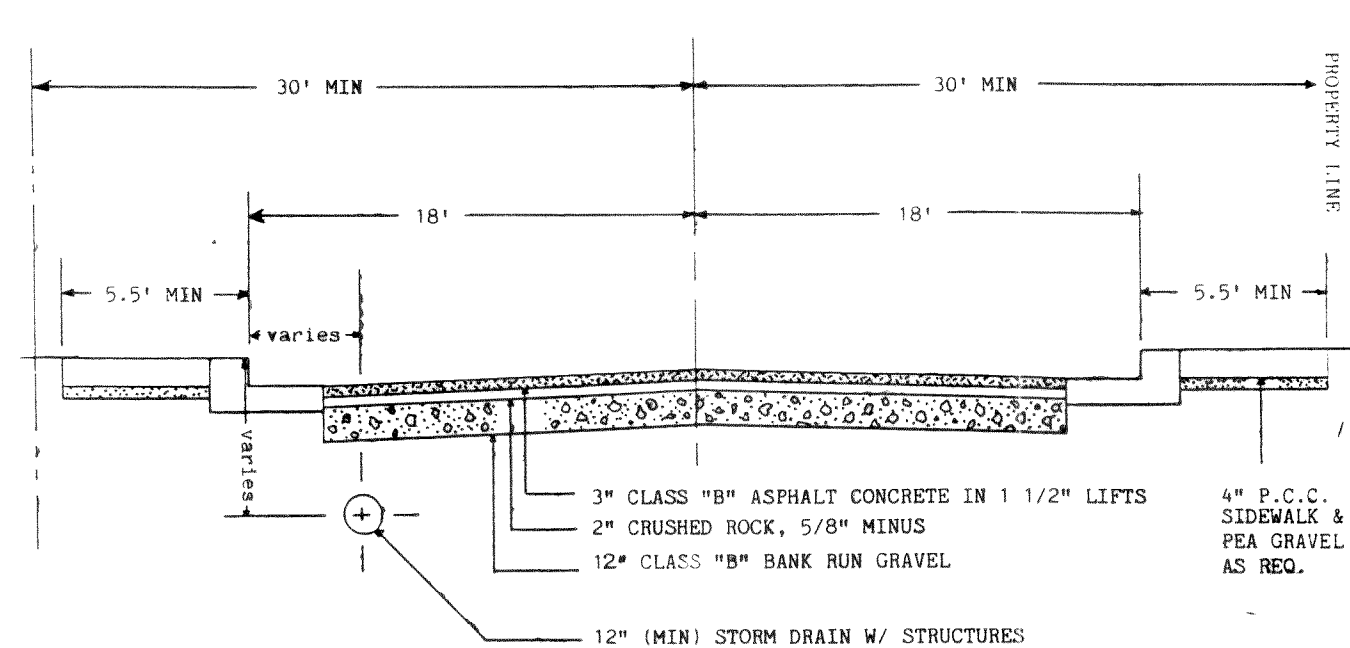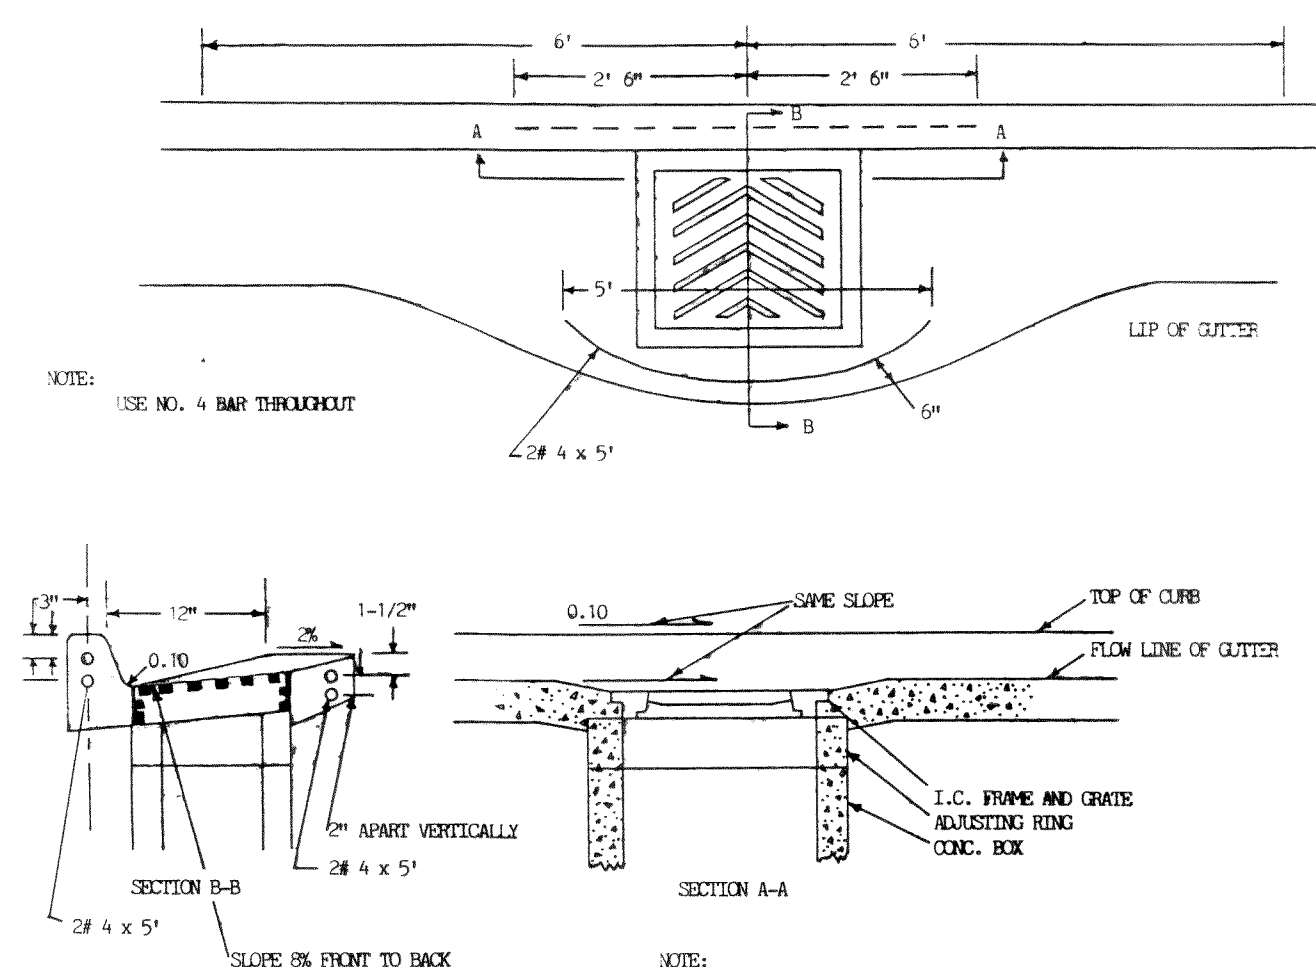




All material and workmanship shall conform to the provisions of applicable sections of A.P.W.A. "Standard Specifications" and shall conform to the requirements of the City Engineer.



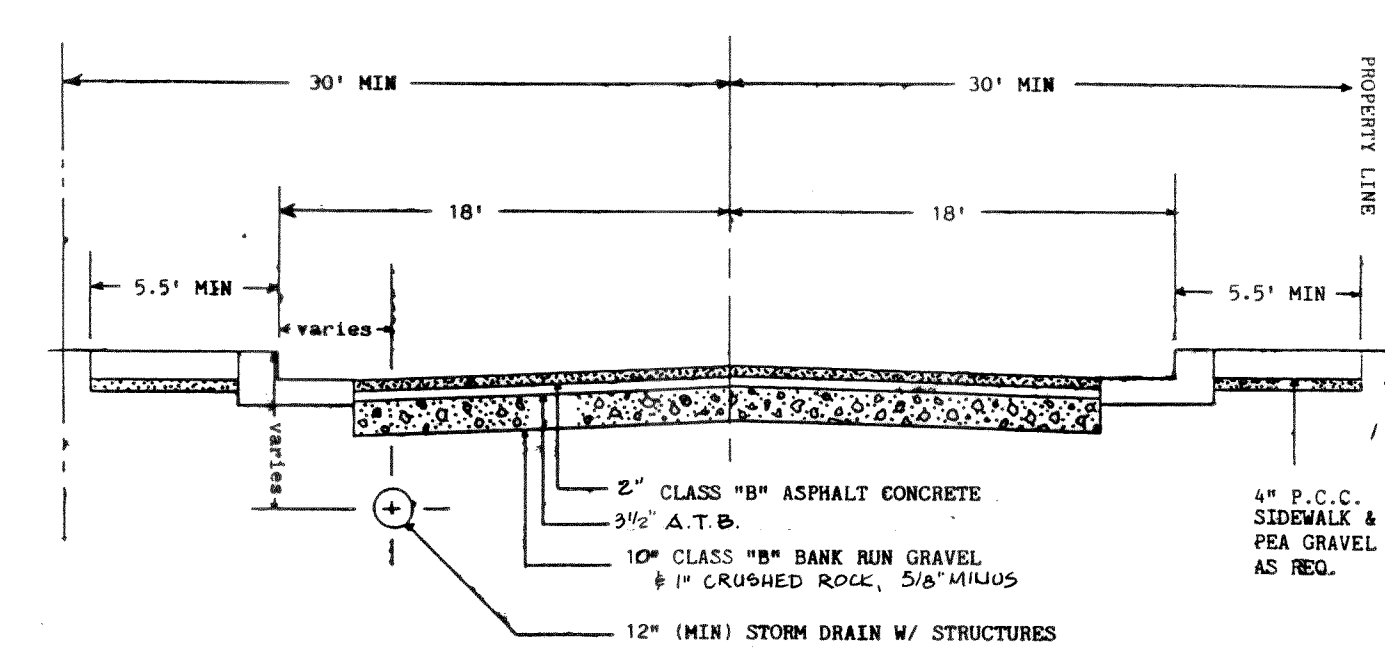


All material and workmanship shall conform to the provisions of applicable sections of A.P.W.A. "Standard Specifications" and shall conform to the requirements of the City Engineer.

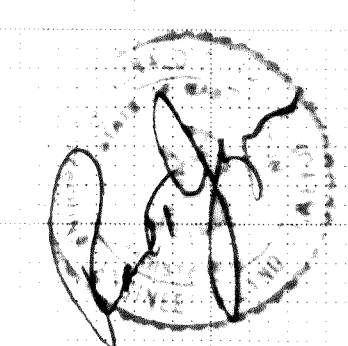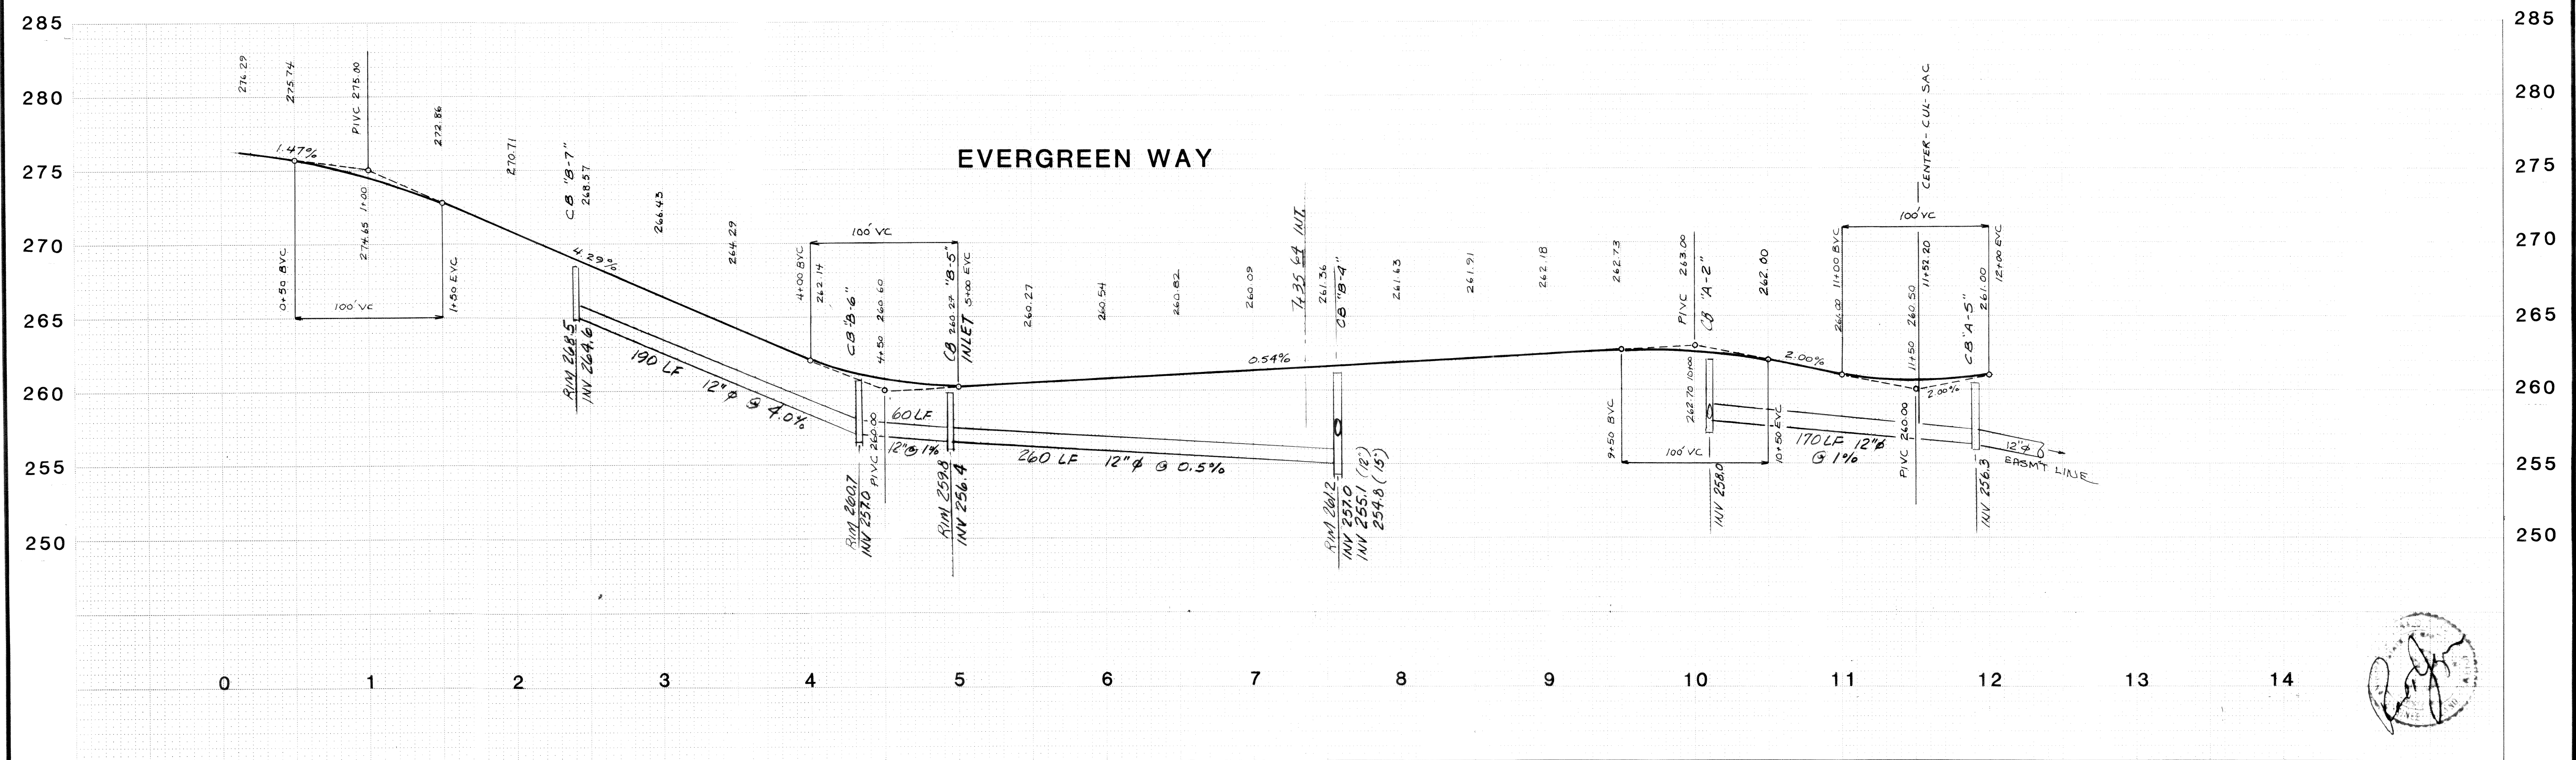

00042.005 2-10-06 R2

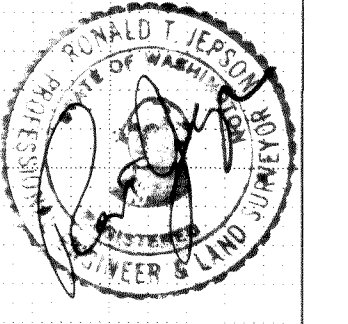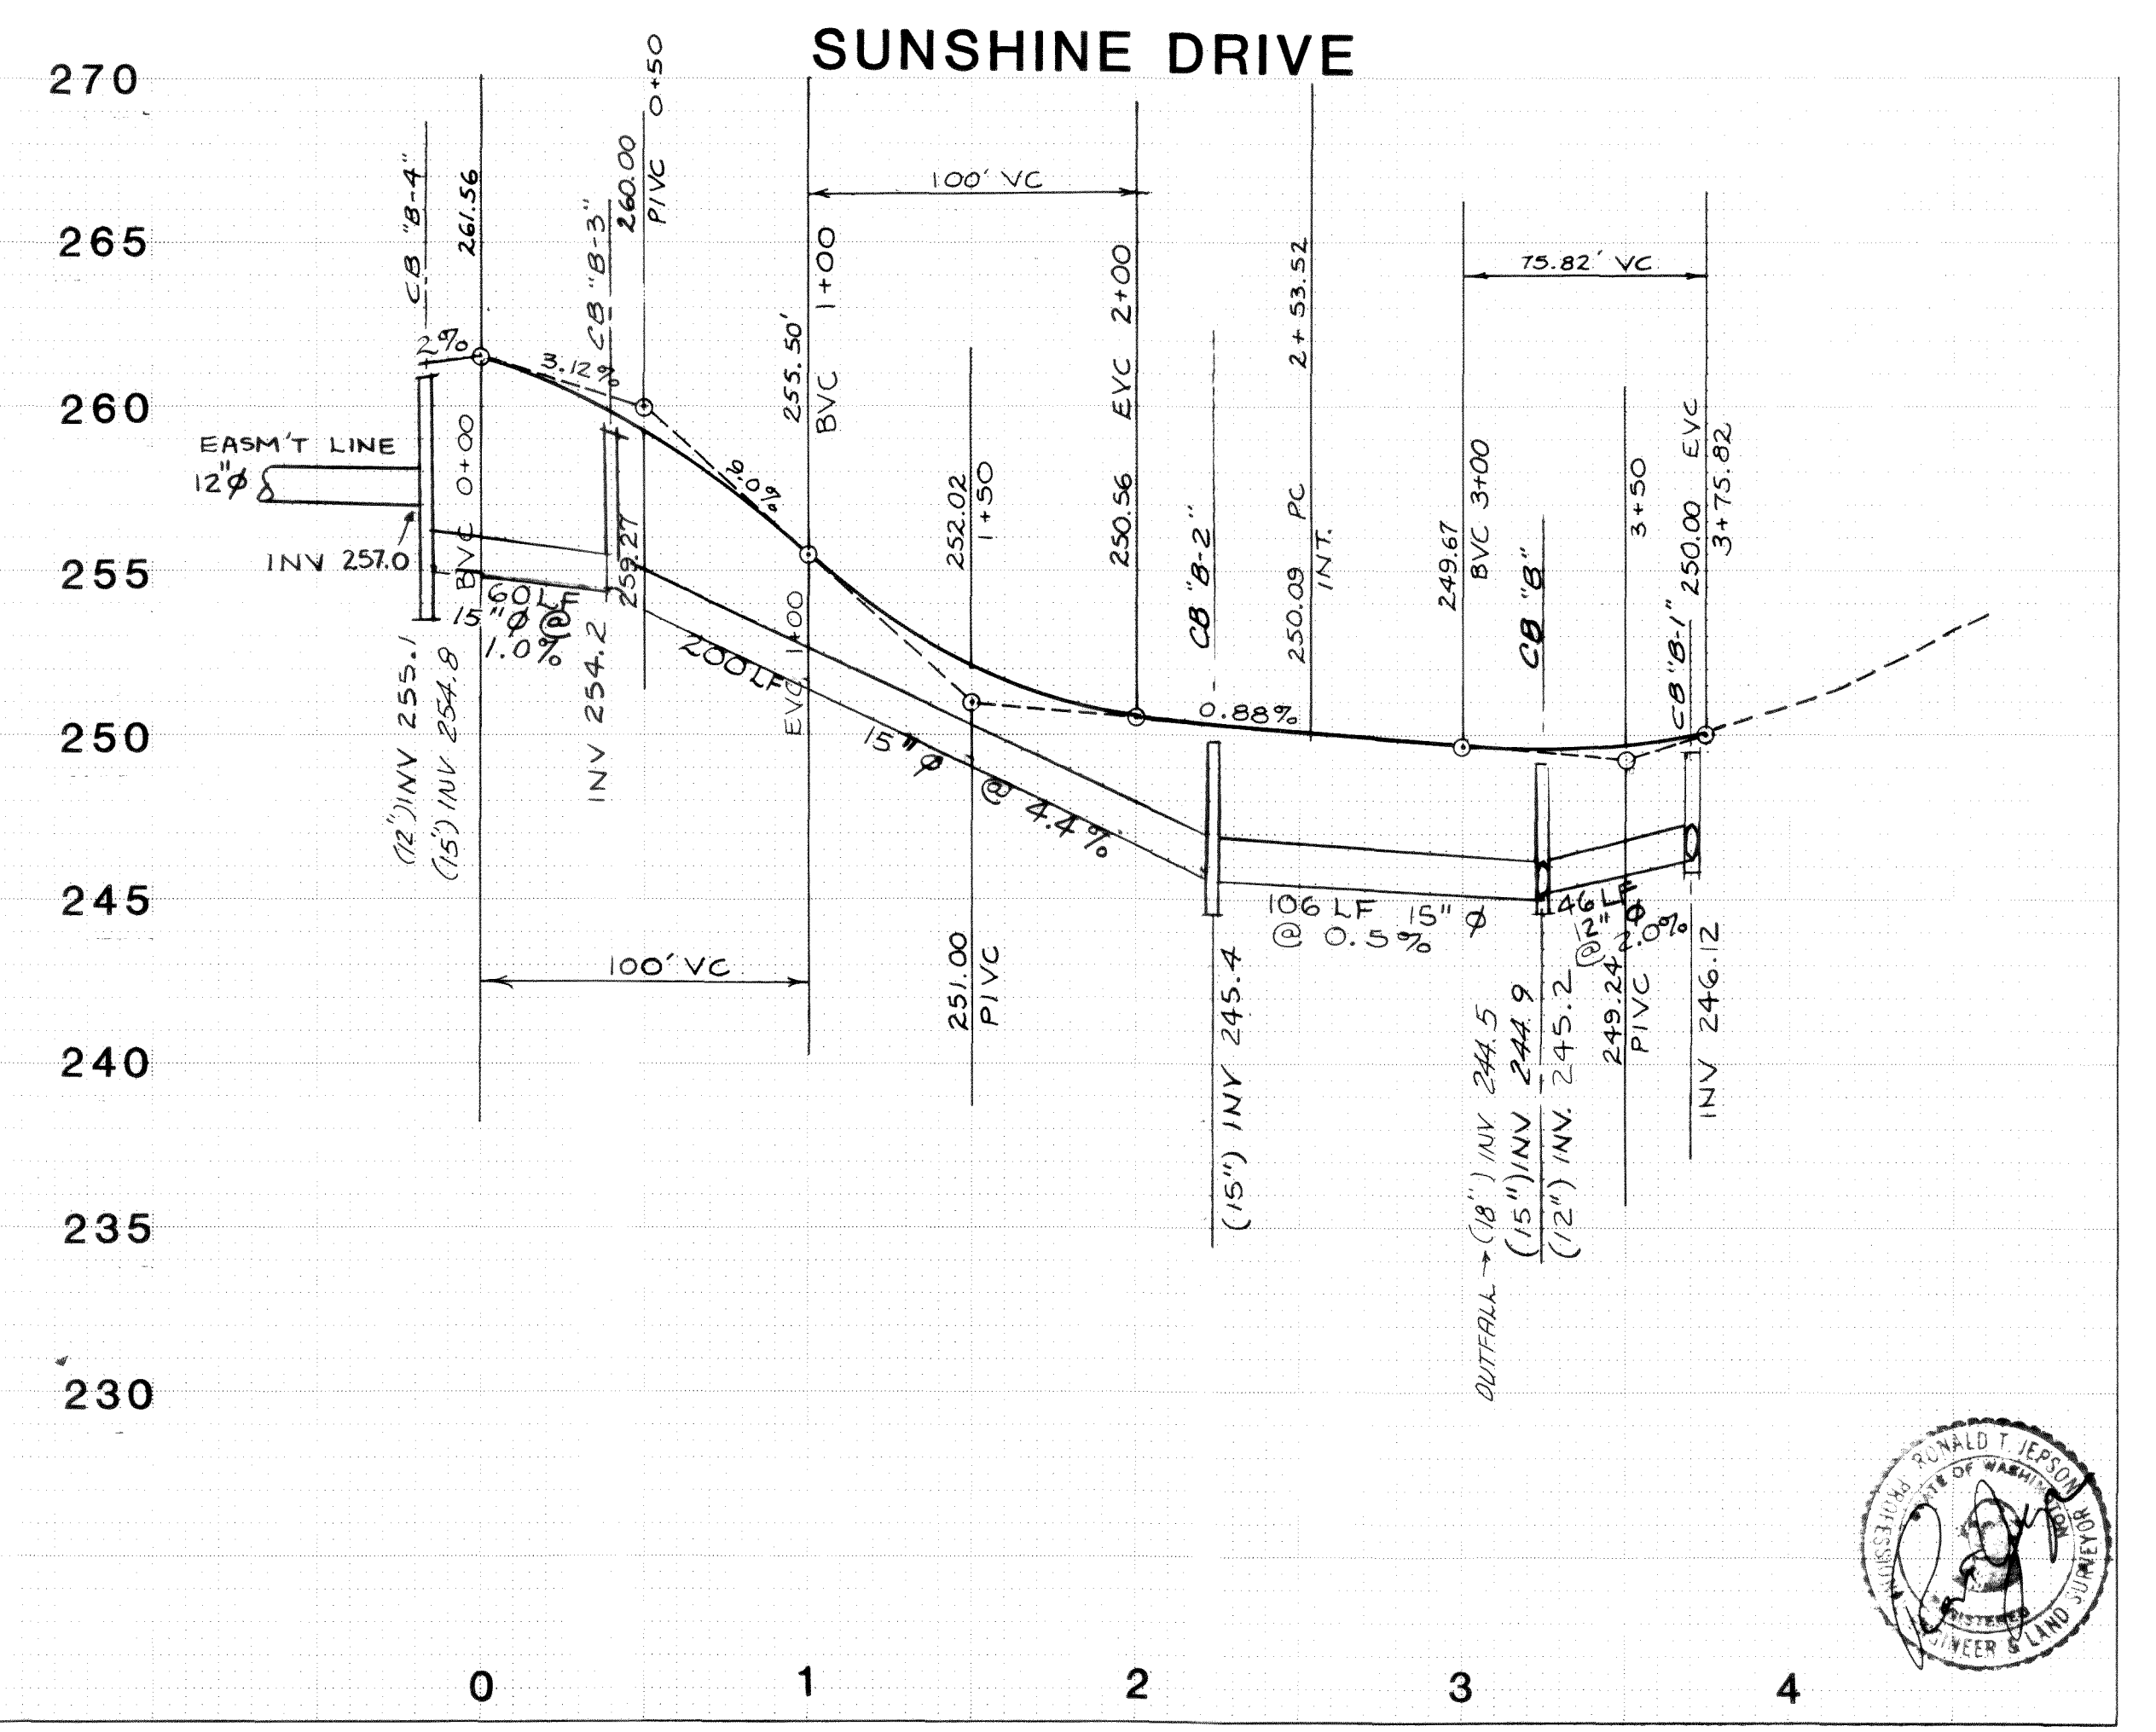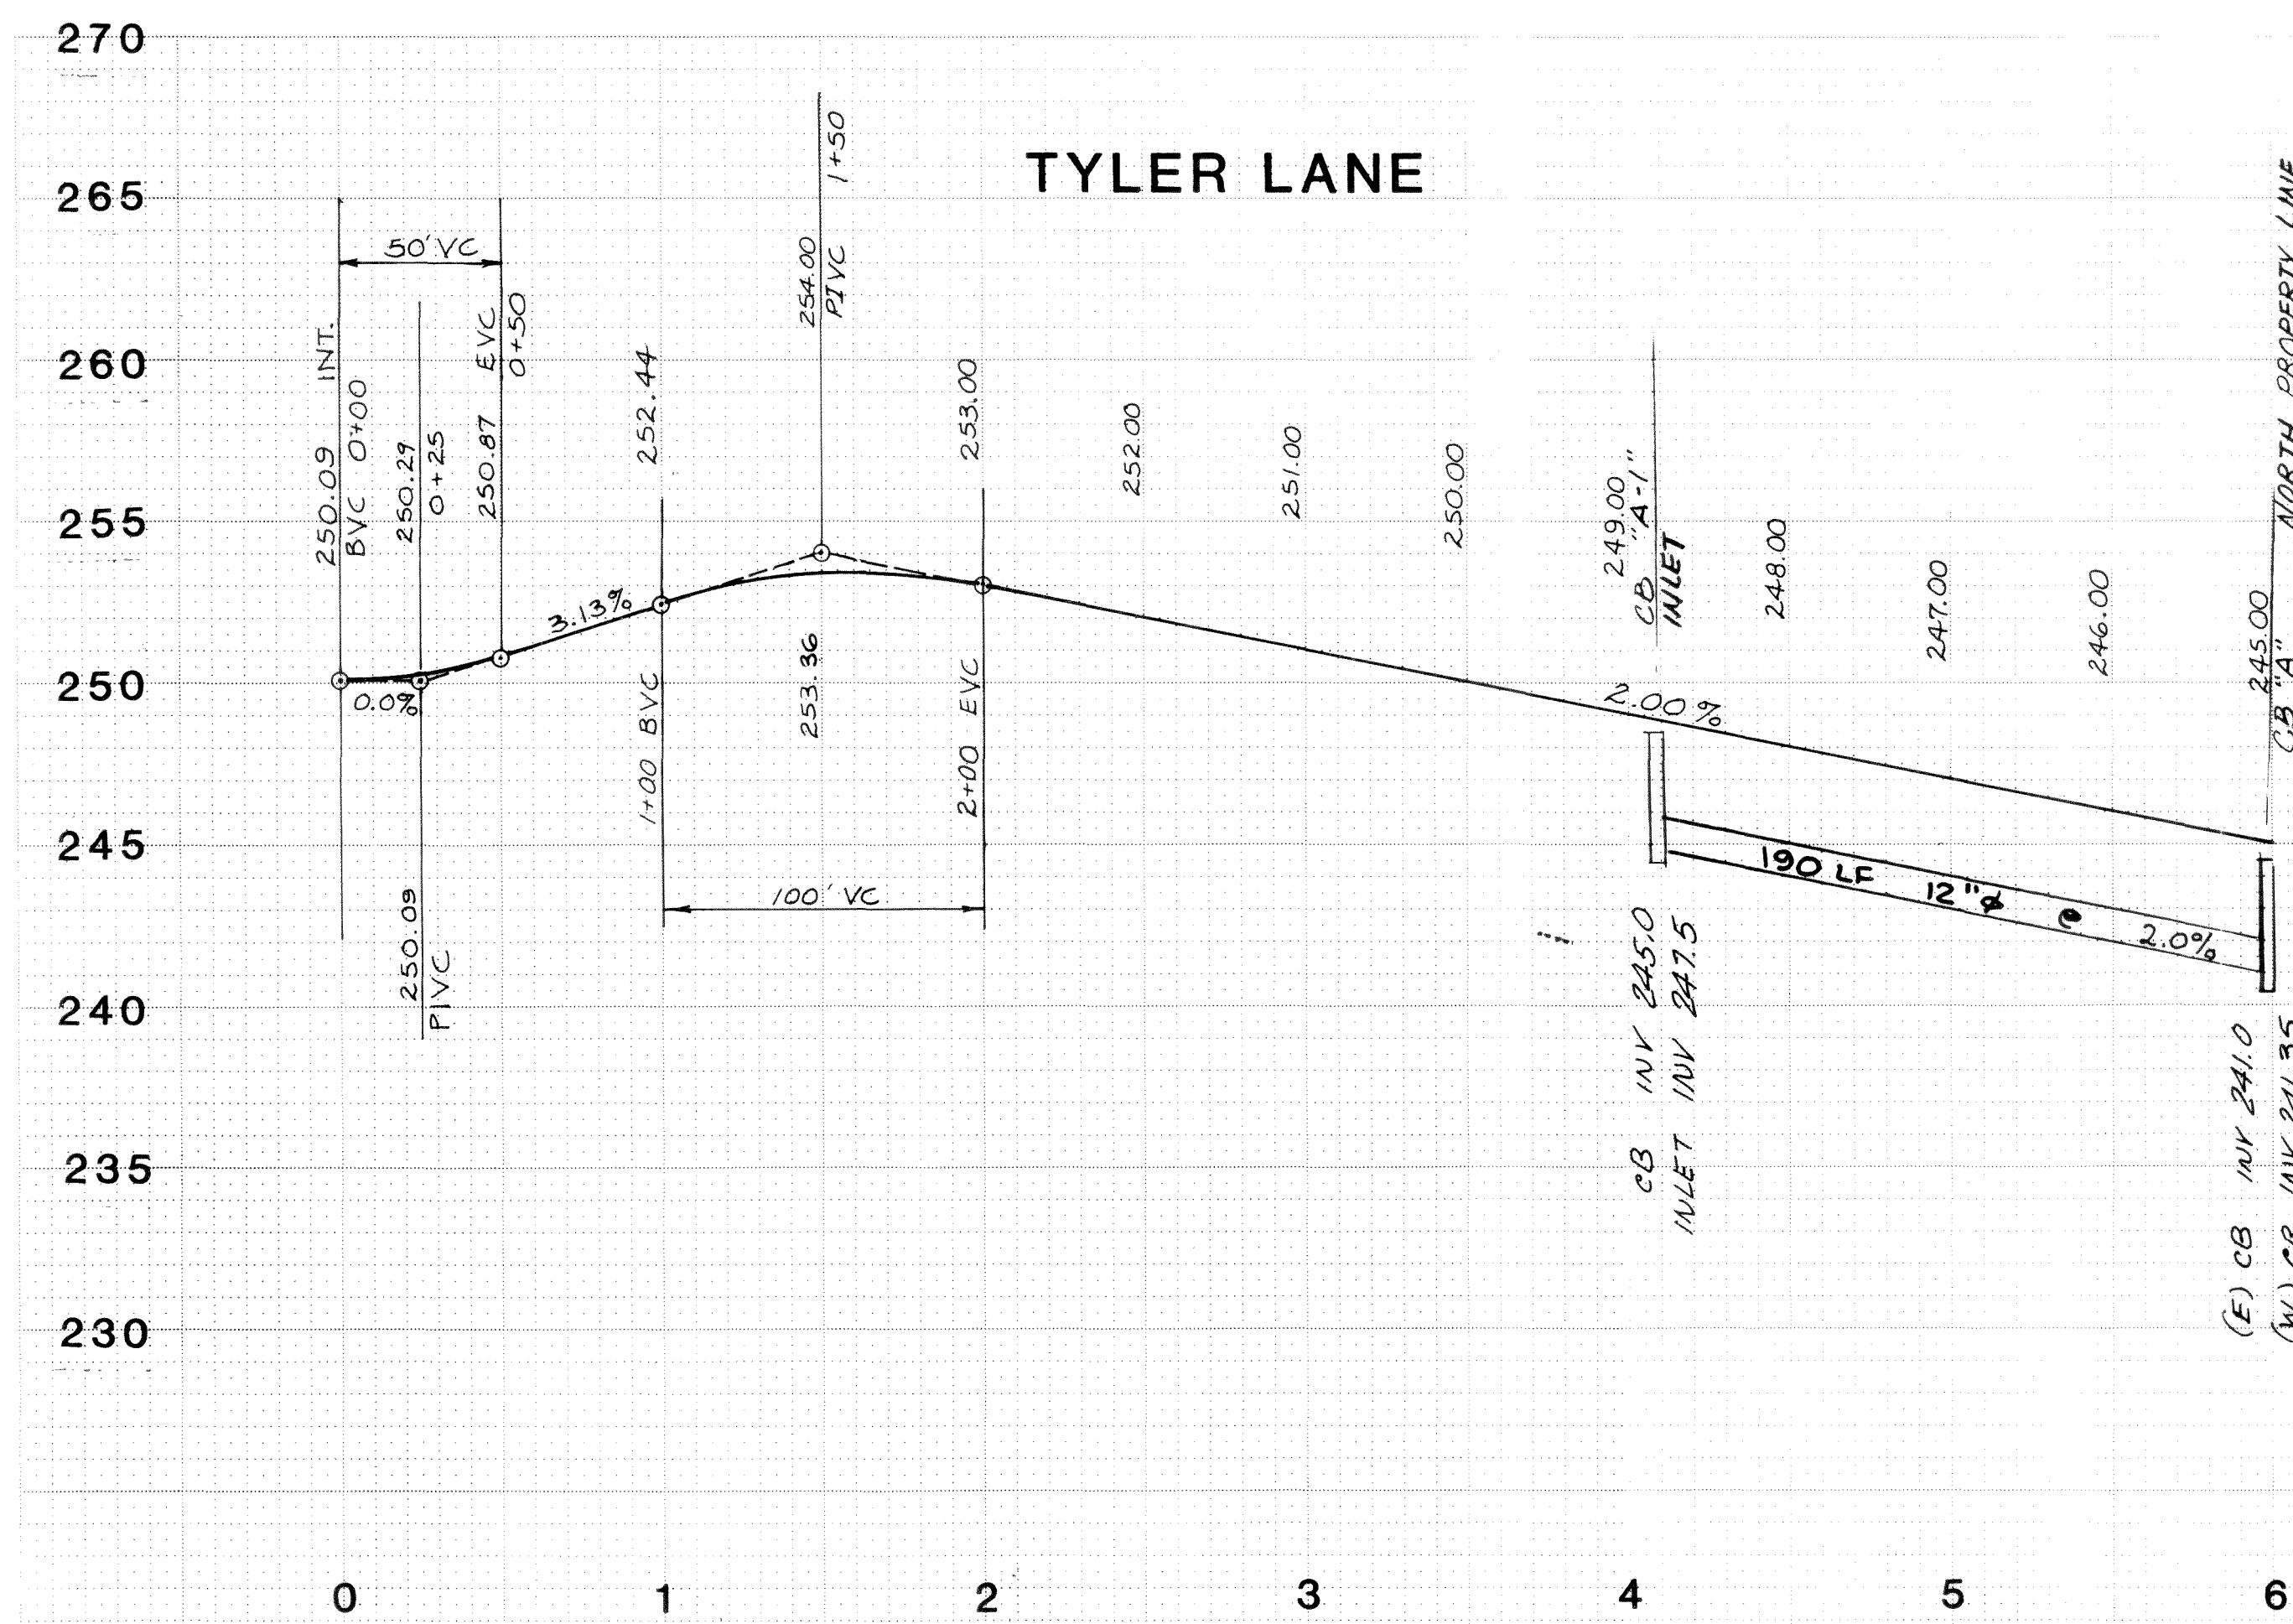

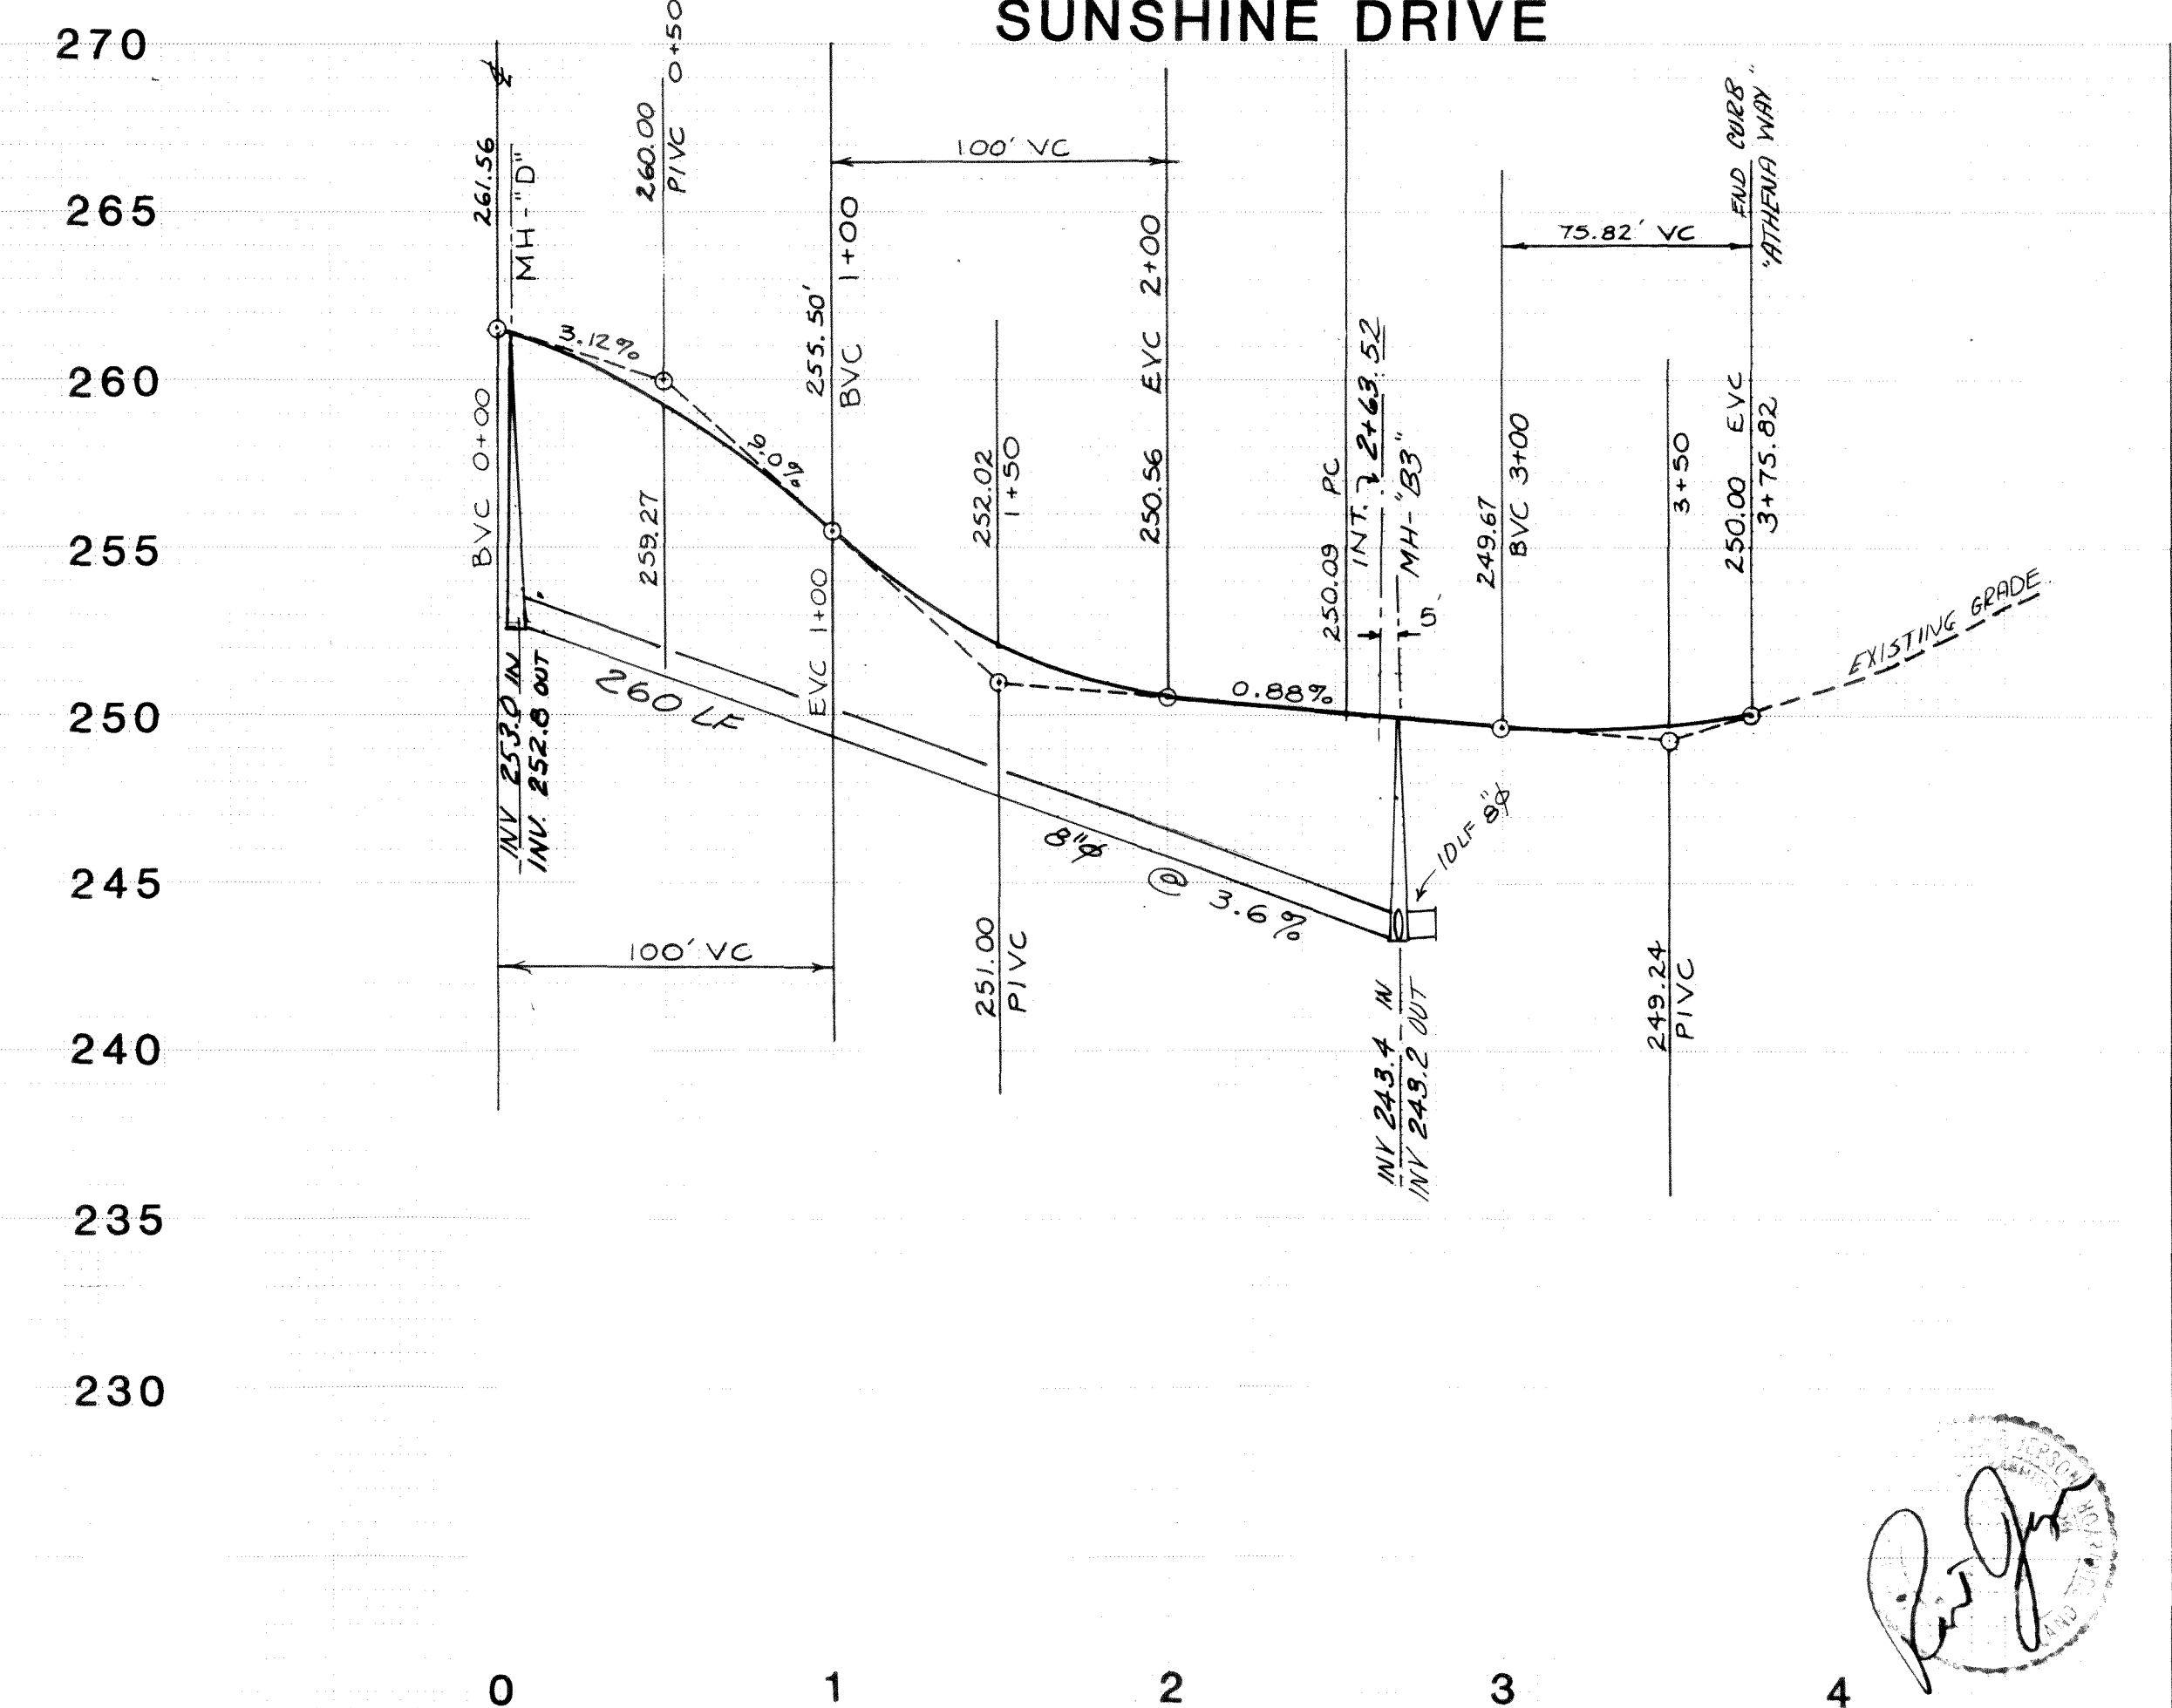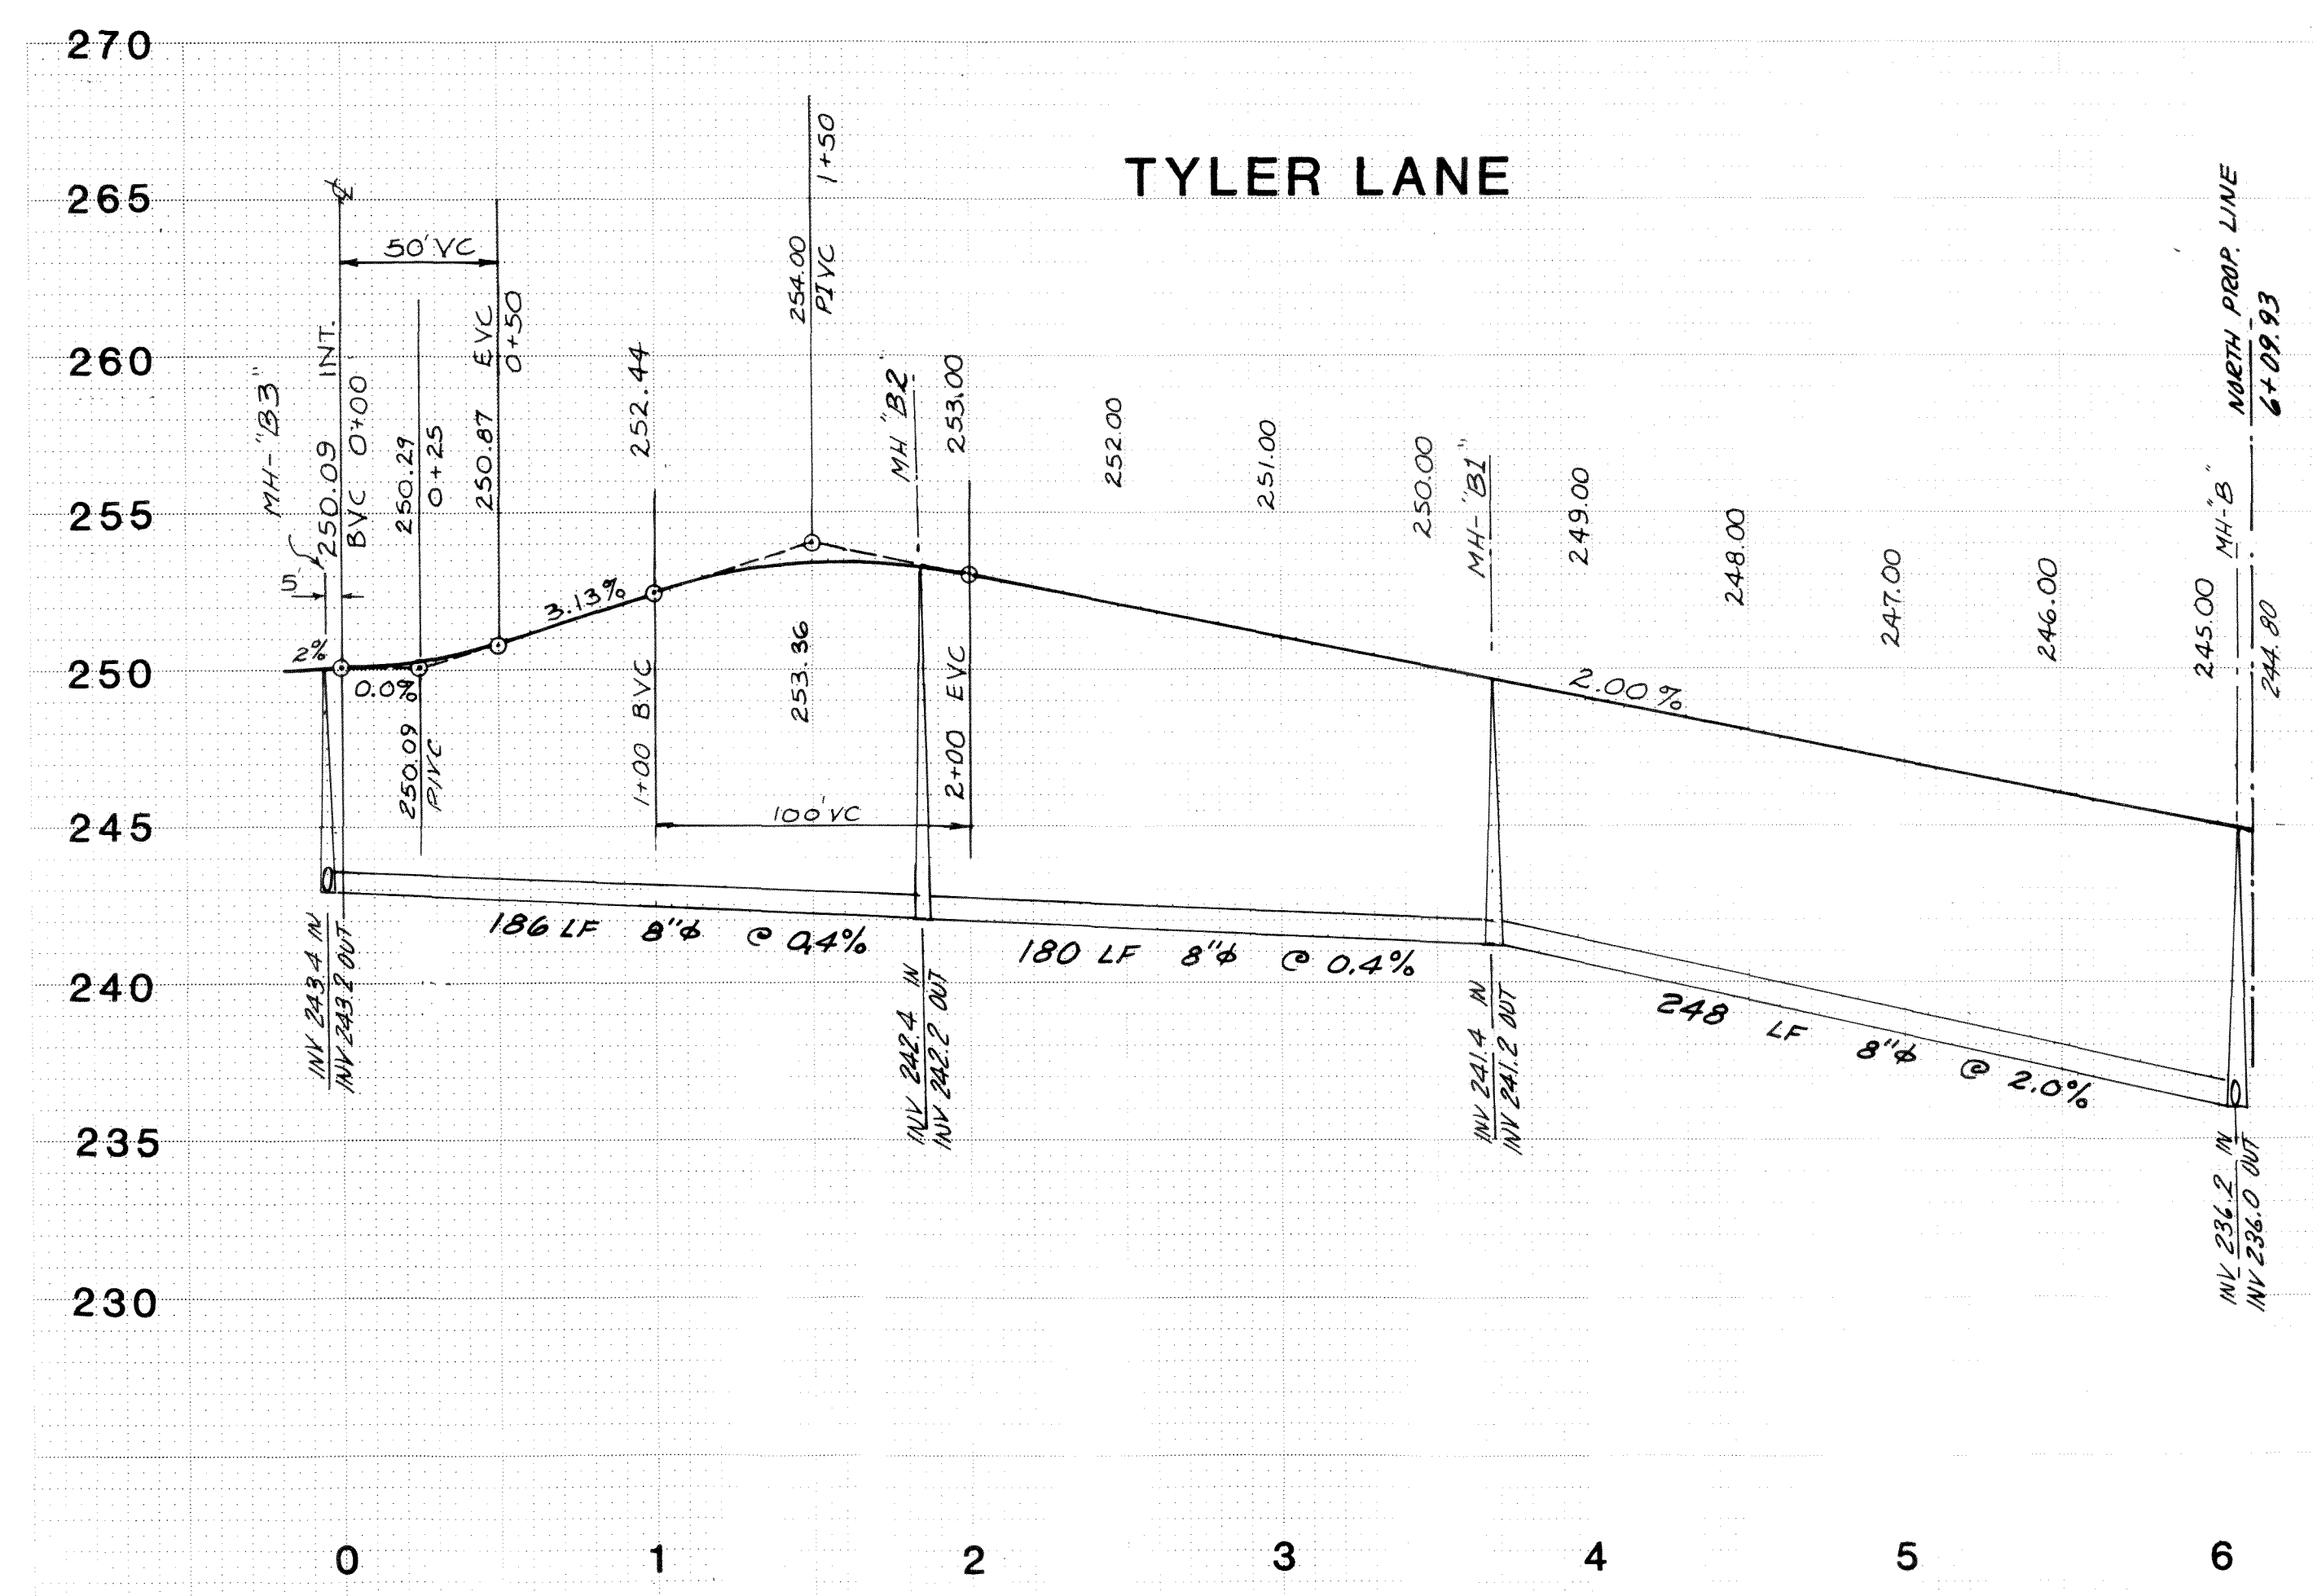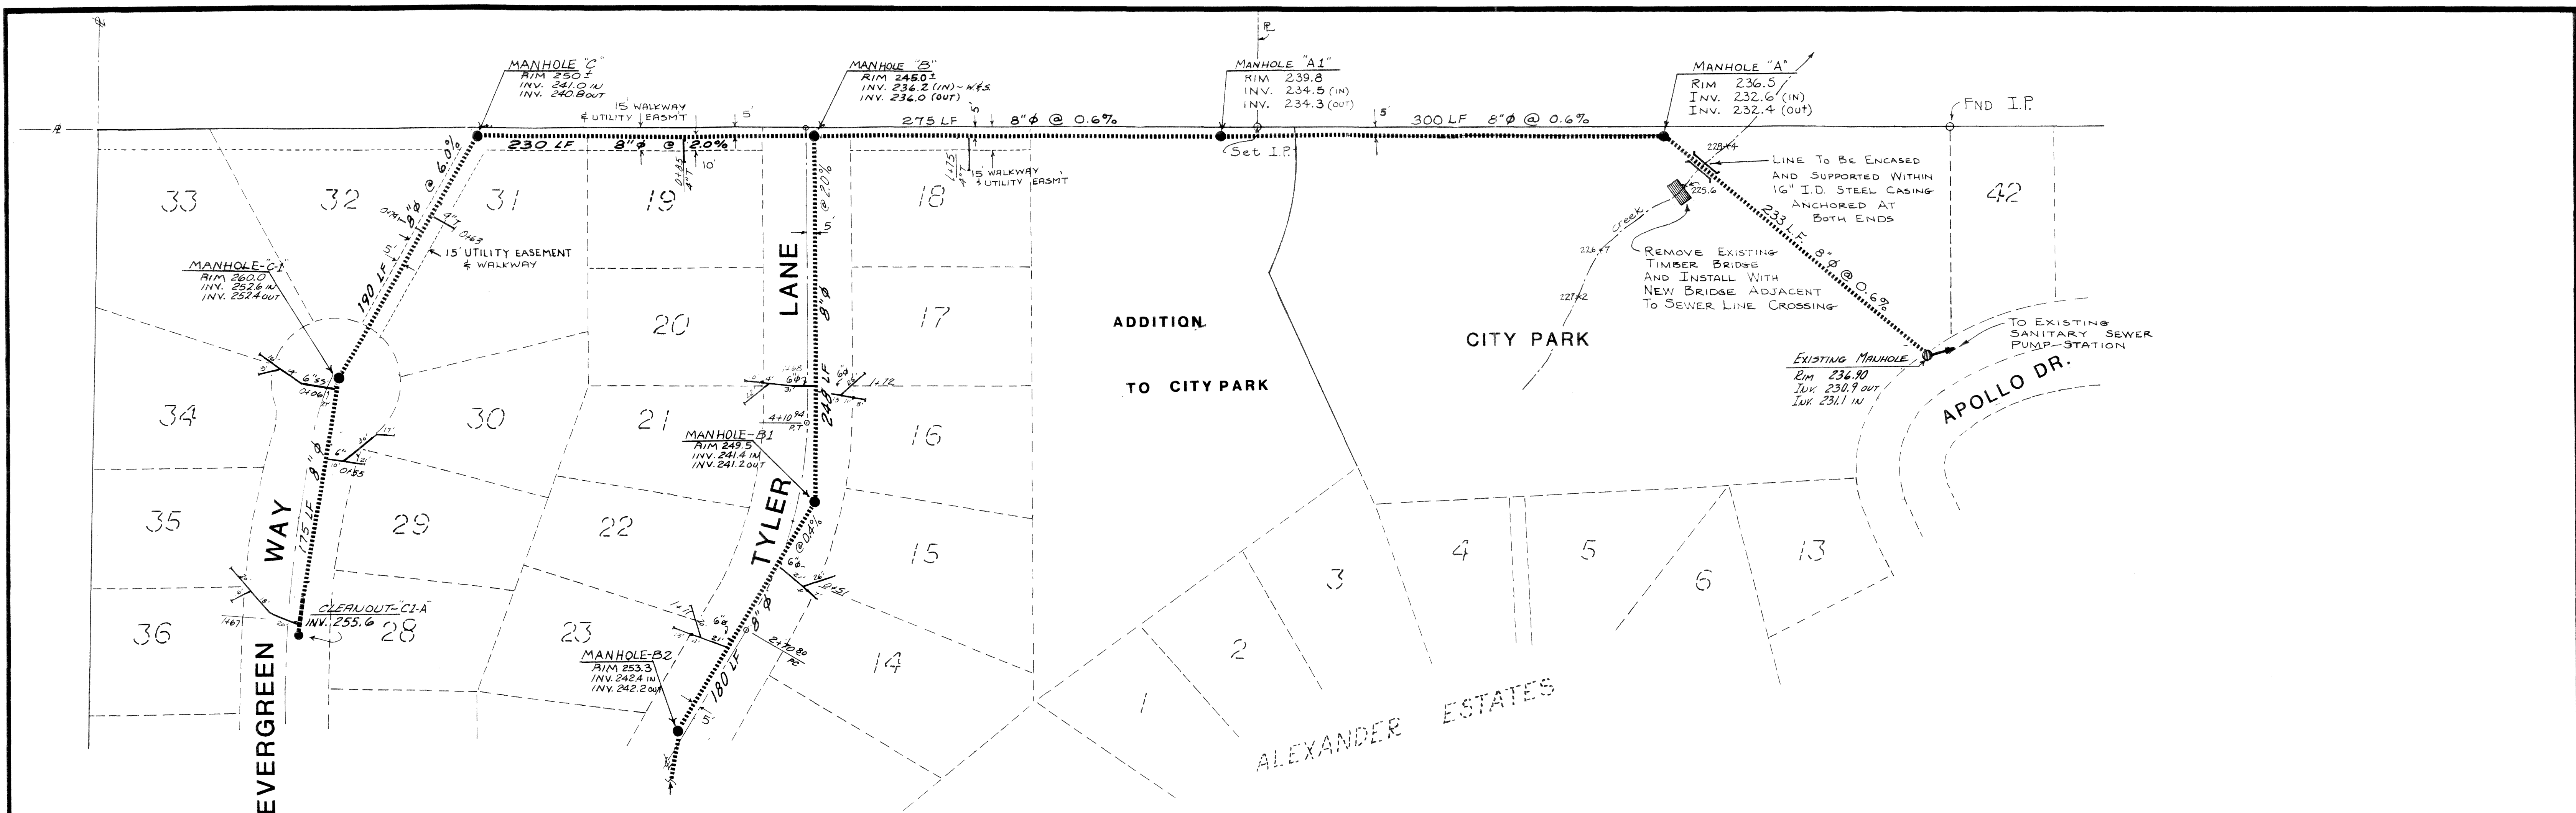

RONALD T. JEPSON &
REGISTERED PROFESSIONAL ENGINEERS AND LAND SURVEYORS

ASSOC.
BELLINGHAM, WASHINGTON 98225

SCALE 1"=50' DATE AUG 89
DRAWN BY SJS
CHECKED BY RTJ
APPROVED RTJ

REVISIONS
1. 10/2/89

AS BUILT
EVERGREEN PLACE

SANITARY SEWER PLAN
ROAD PROFILE, SANITARY & STORM SEWER PROFILE

SHEET 7 OF 7