

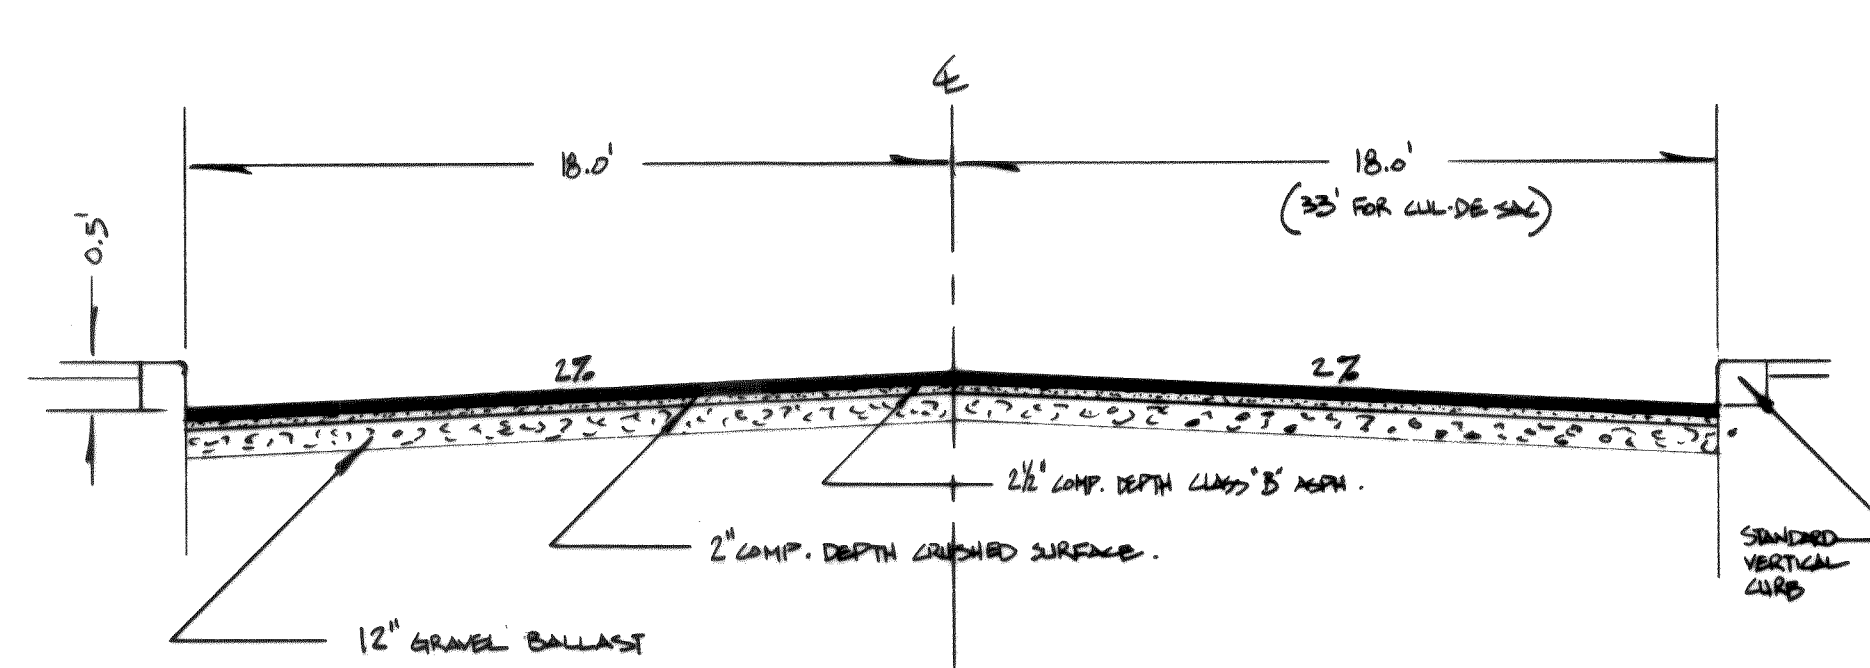


PLAN	SURVEYED	DATE
	PLOTTED	BY
	NOTE BOOK	GRADES CHECKED
	NO.	RT. OF WAY CHECKED

PROFILE	SURVEYED	DATE
	PLOTTED	BY
	NOTE BOOK	GRADES CHECKED
	NO.	STRUCTURE NOTATIONS CHECKED

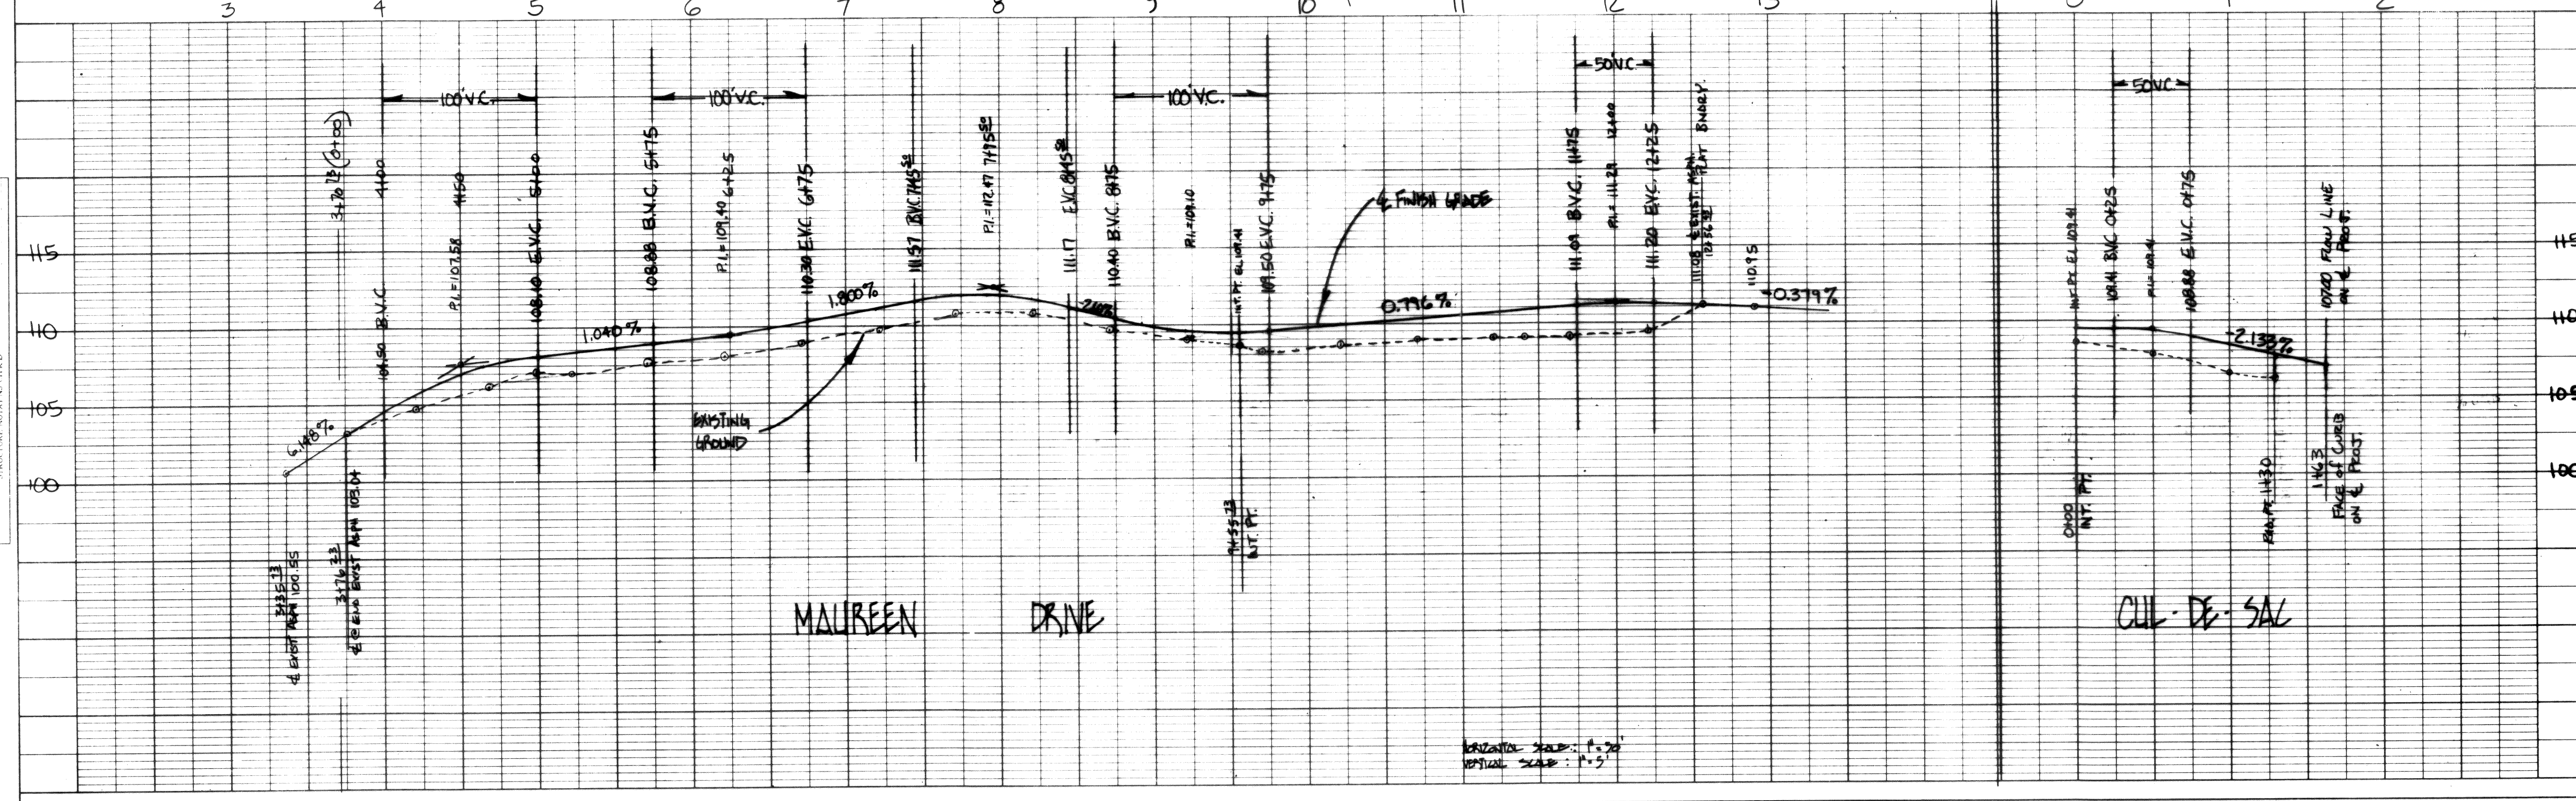

VISTA DIV. 2 "AS-BUILT" 1-13-82
ROAD PLAN & PROFILES

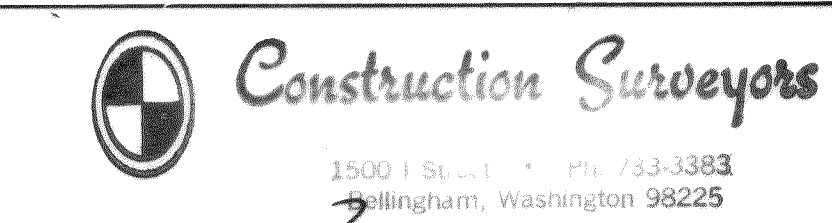

00246.001 2-16-06 982



PLAN	
DATE	BY
SURVEYED	
PLOTTED	
NOTES CHECKED	
BY	
DATE	

PROFILE	
DATE	BY
SURVEYED	
PLOTTED	
NOTES CHECKED	
BY	
DATE	


MAUREEN DR.

ROBYN

DRIVE

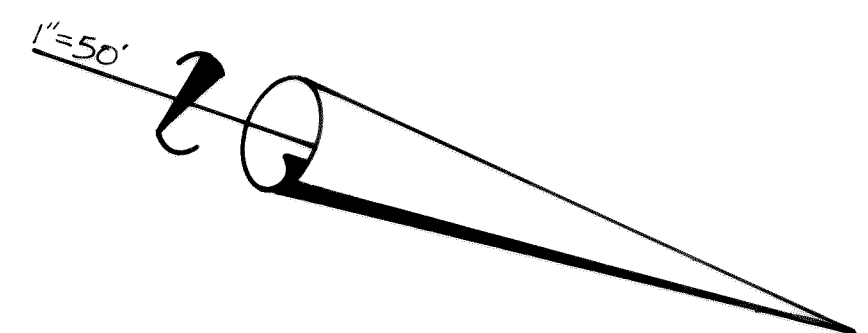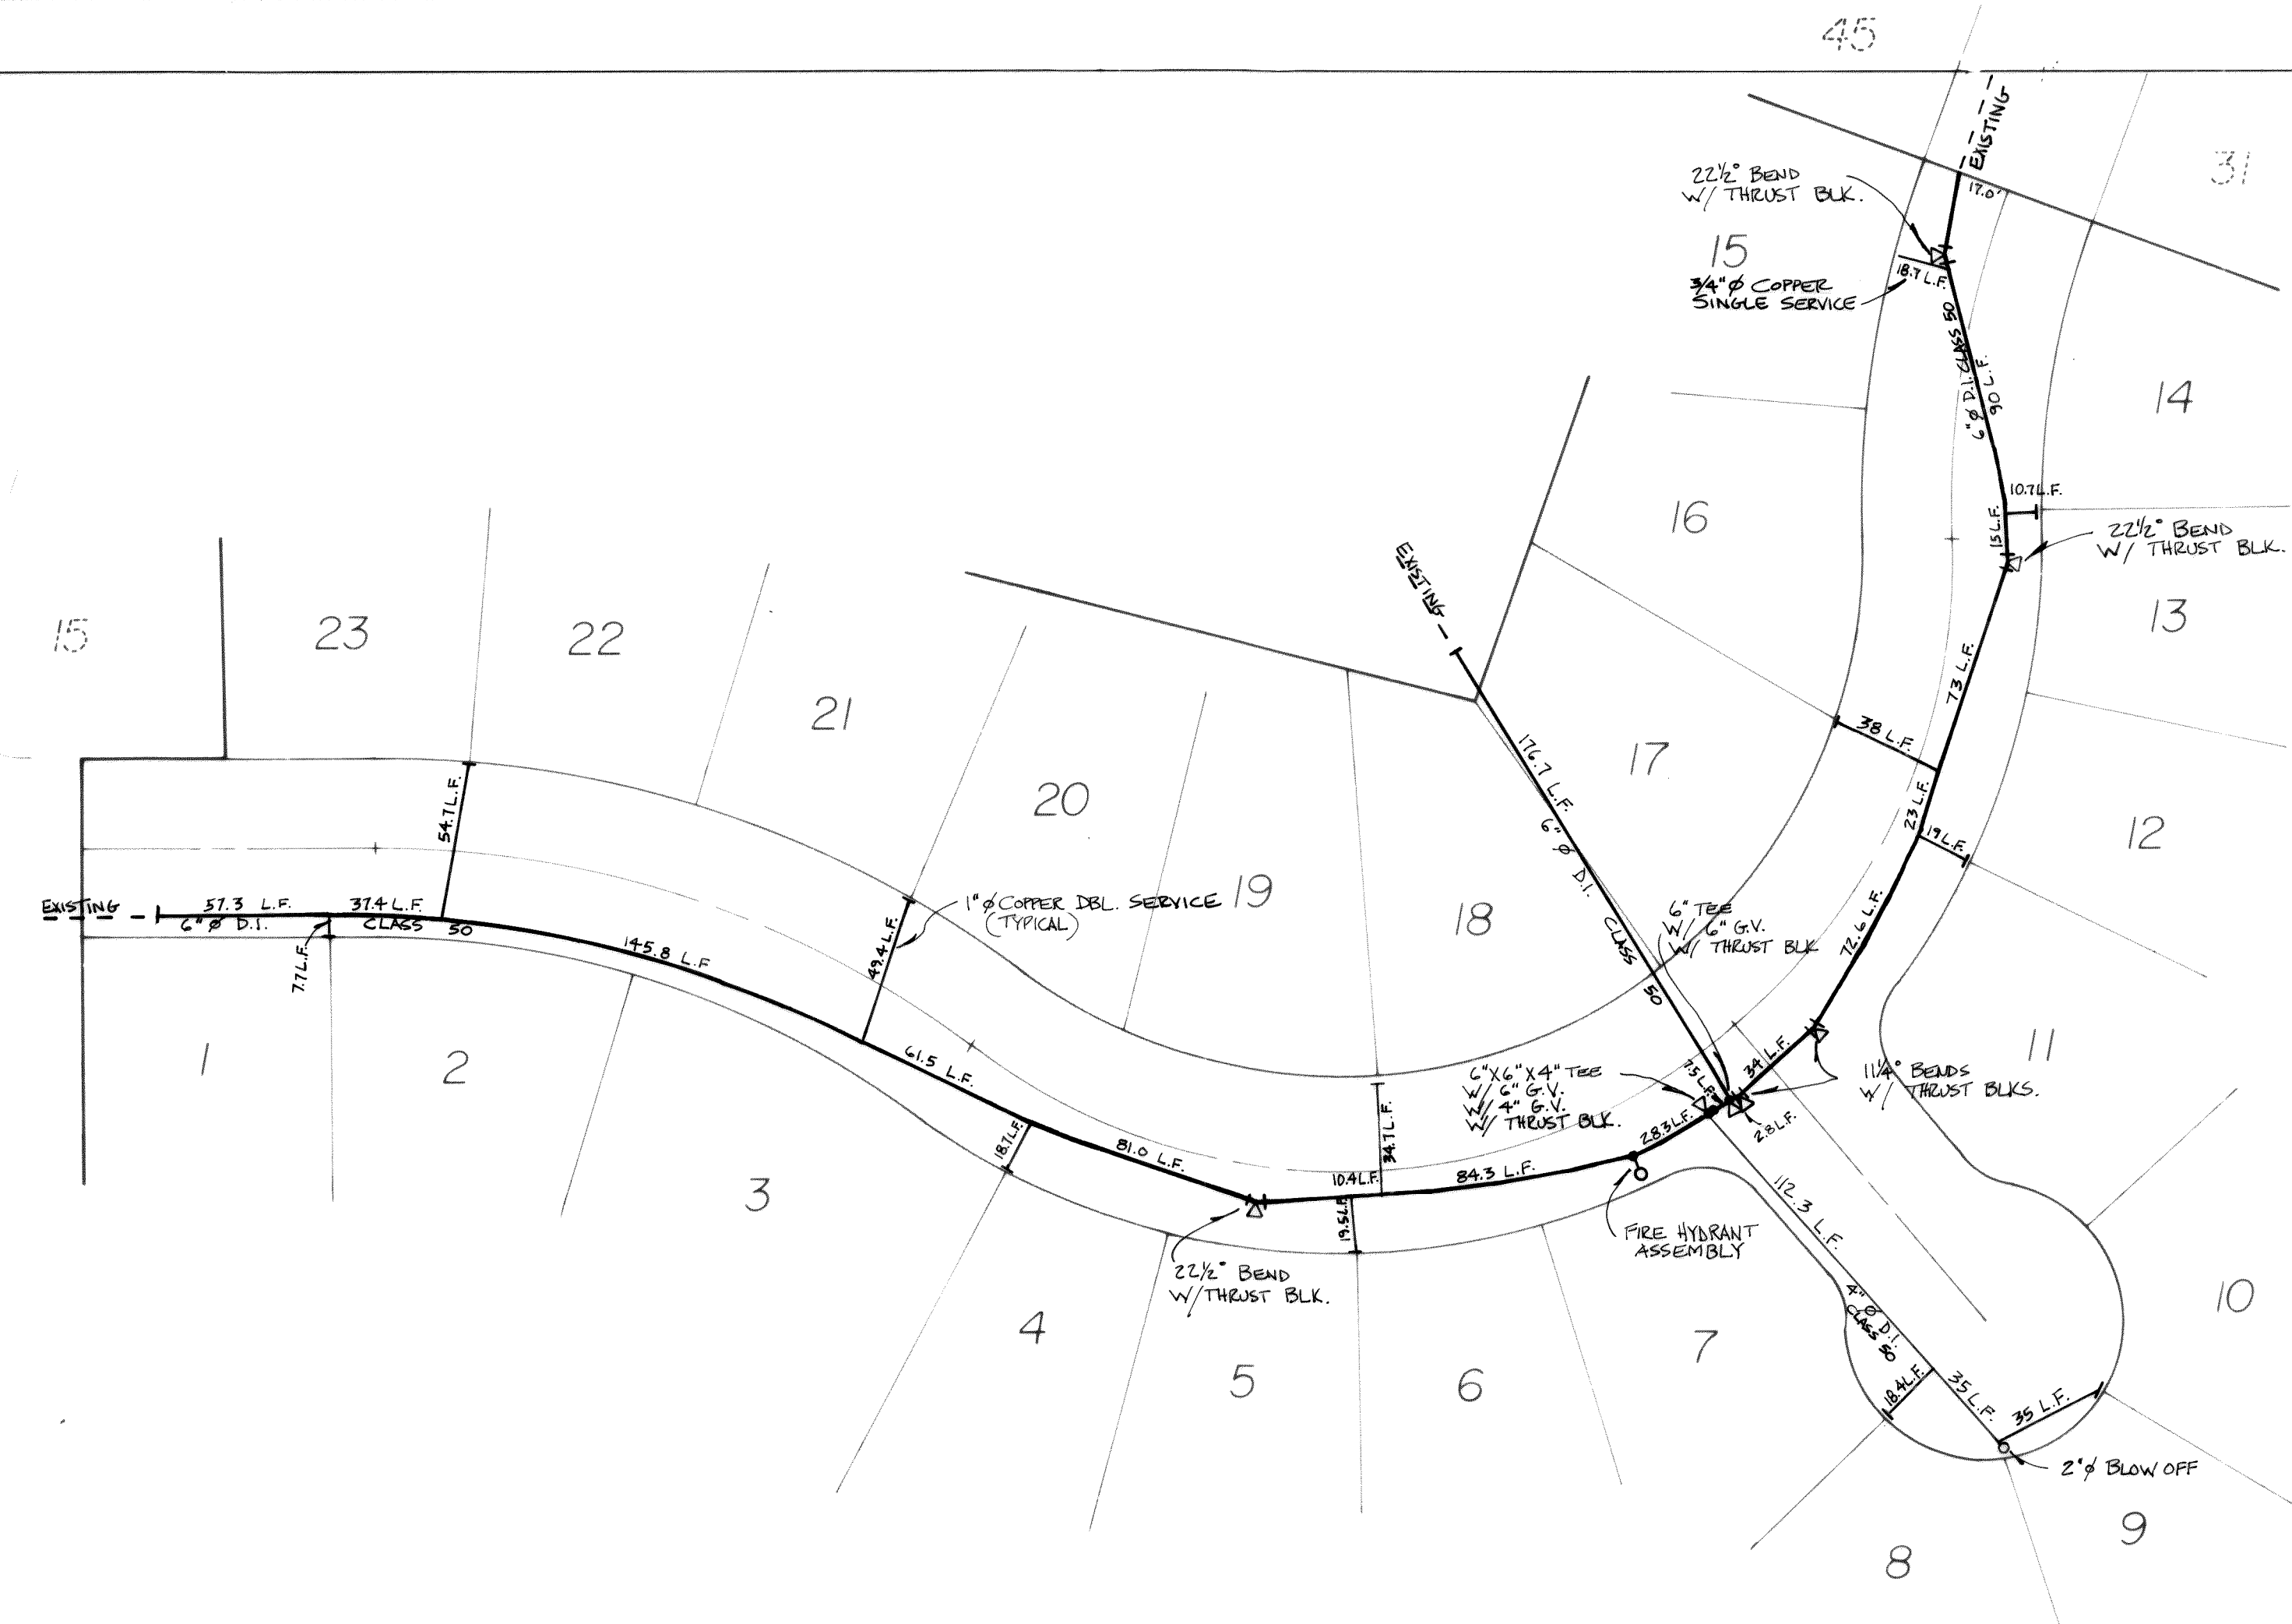


VISTA DIV. 2 "ASBUILT"
WATER DISTRIBUTION

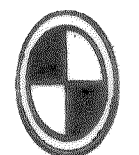 **Construction Surveyors**
1500 1 Street • Ph: 733-3383
Bellingham, Washington 98225


00246.002 2.16.06 KR

PROFILE SURVEIVED _____ PLOTTED _____ NOTE BOOK _____ GRADES CHECKED _____ B. M. 5 NOTED _____ NO. _____ STRUCTURE NOTATNS CHK'D _____	BY _____	DATE _____
--	----------	------------

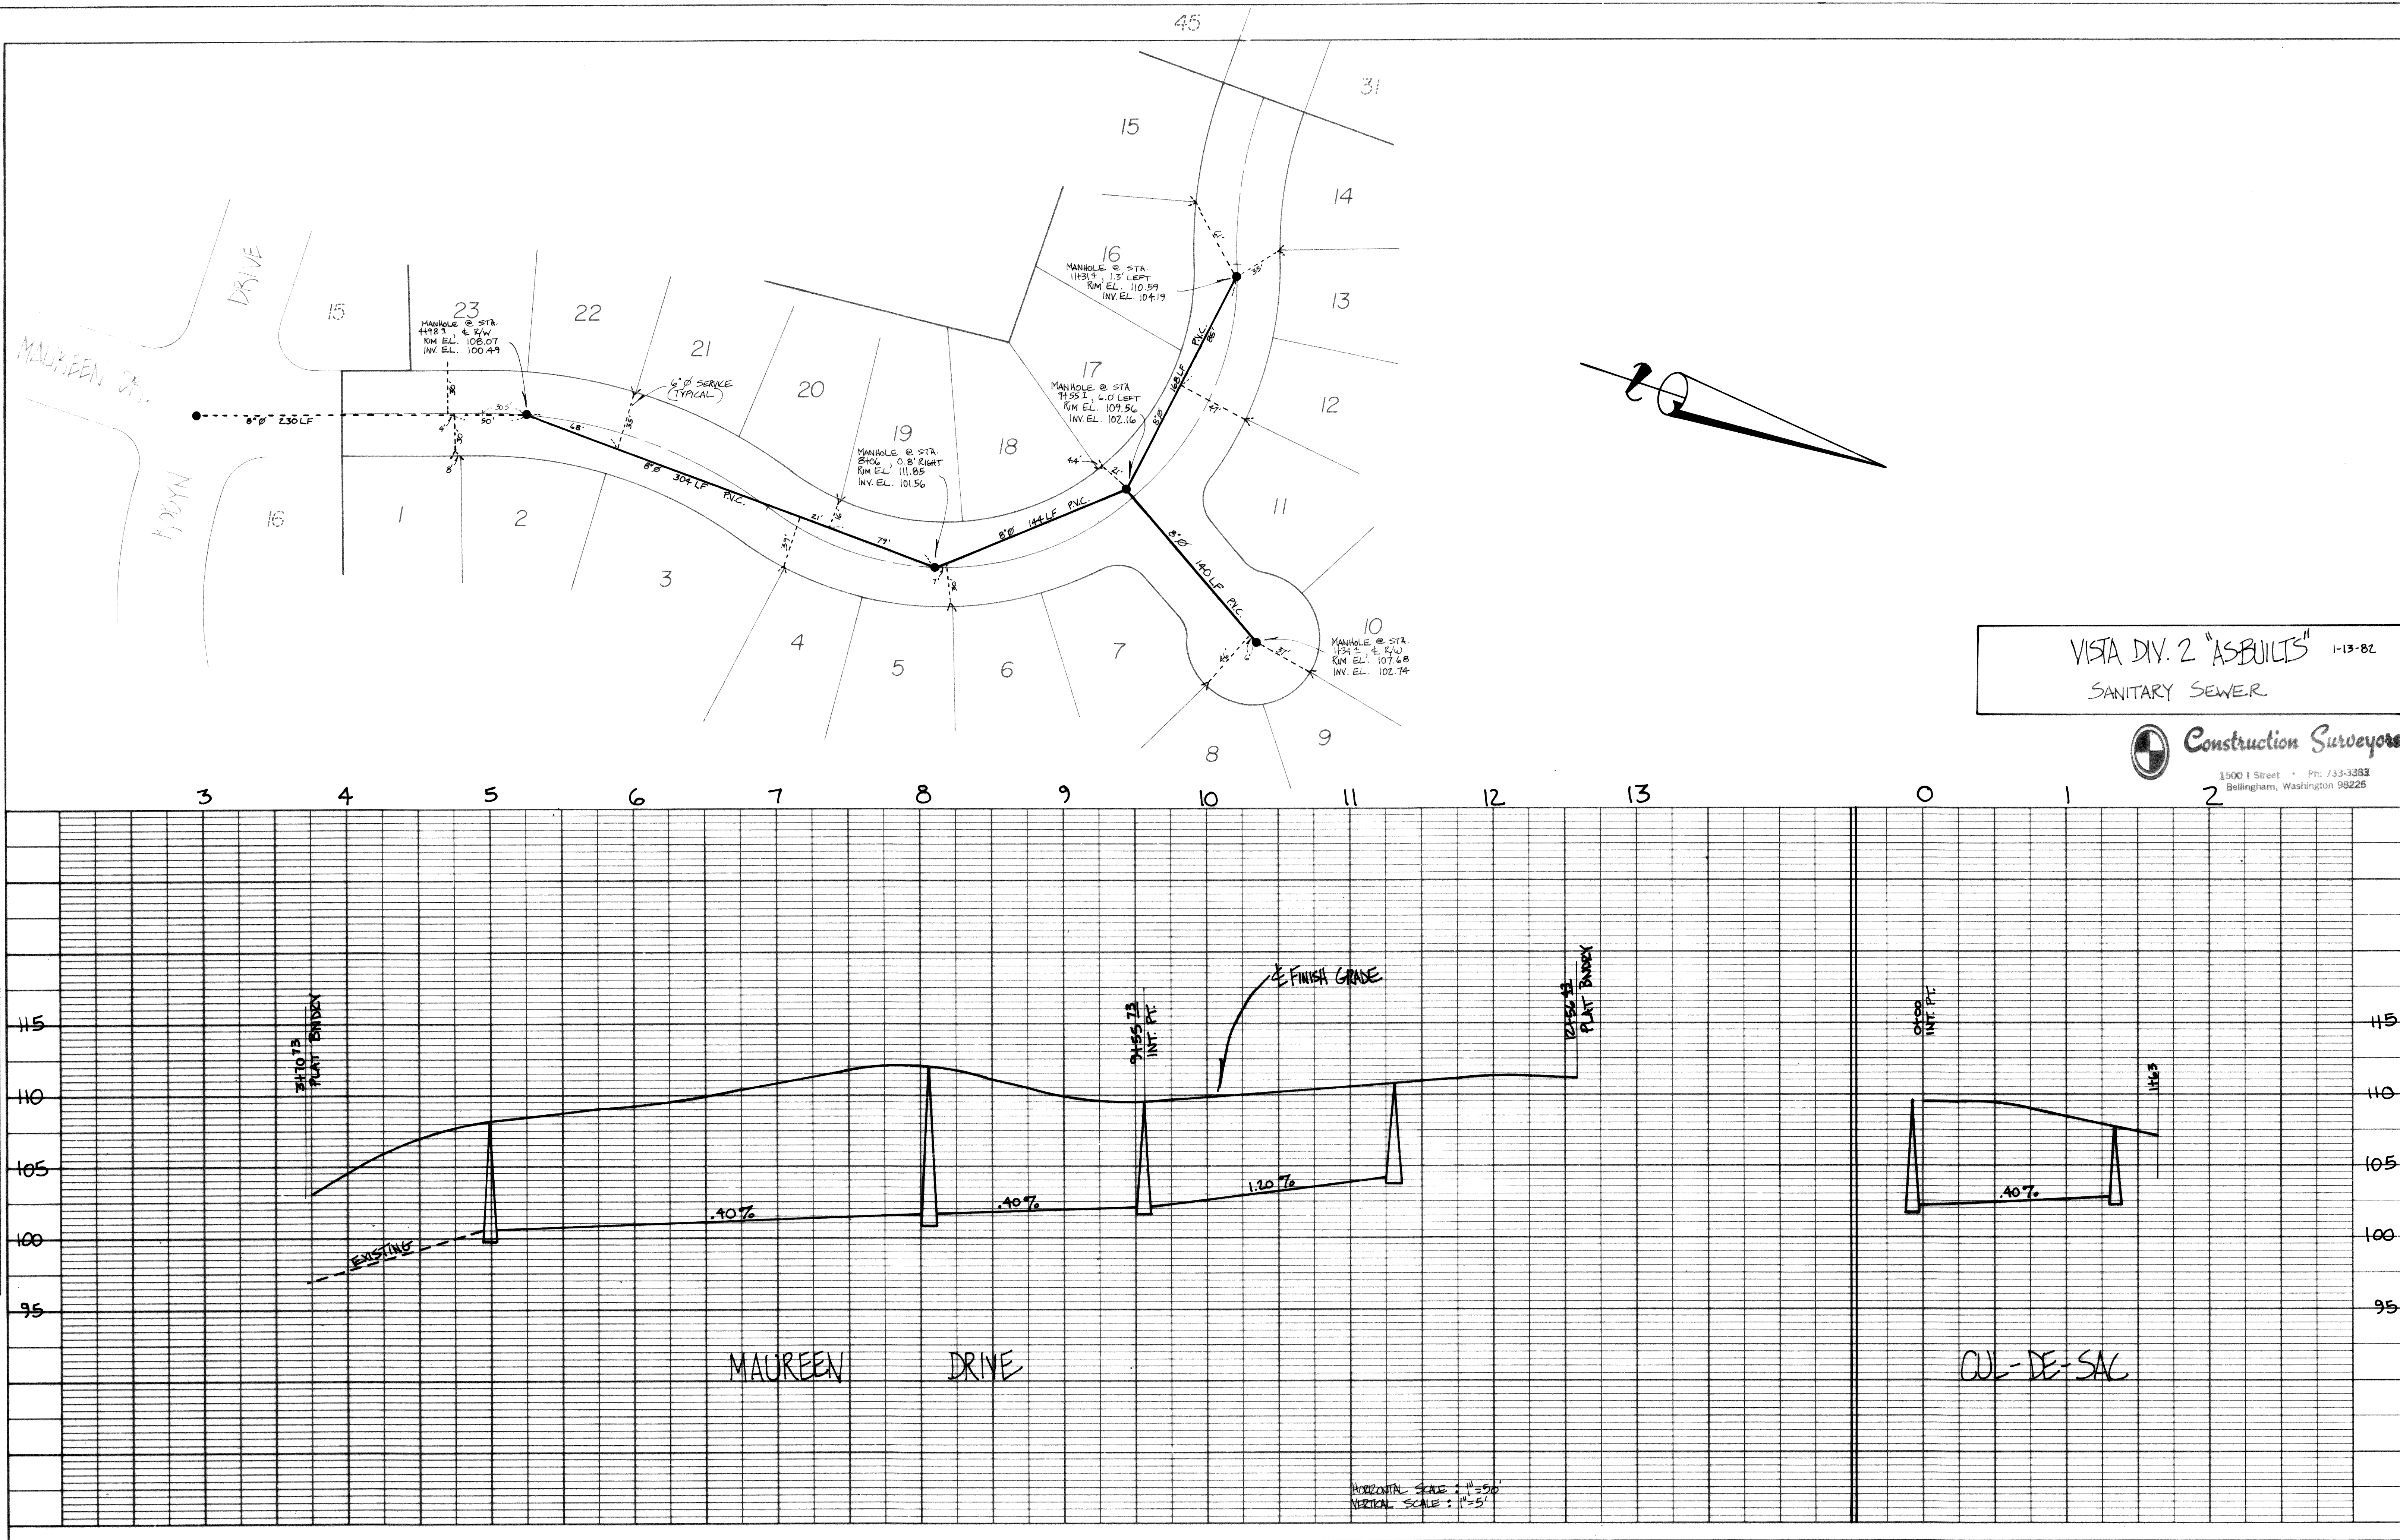

PLAN	DATE
REVIEWED	BY
PLANNED	
NOTE BOOK	
NO.	

PROFILE	DATE
REVIEWED	BY
PLANNED	
NOTE BOOK	
NO.	

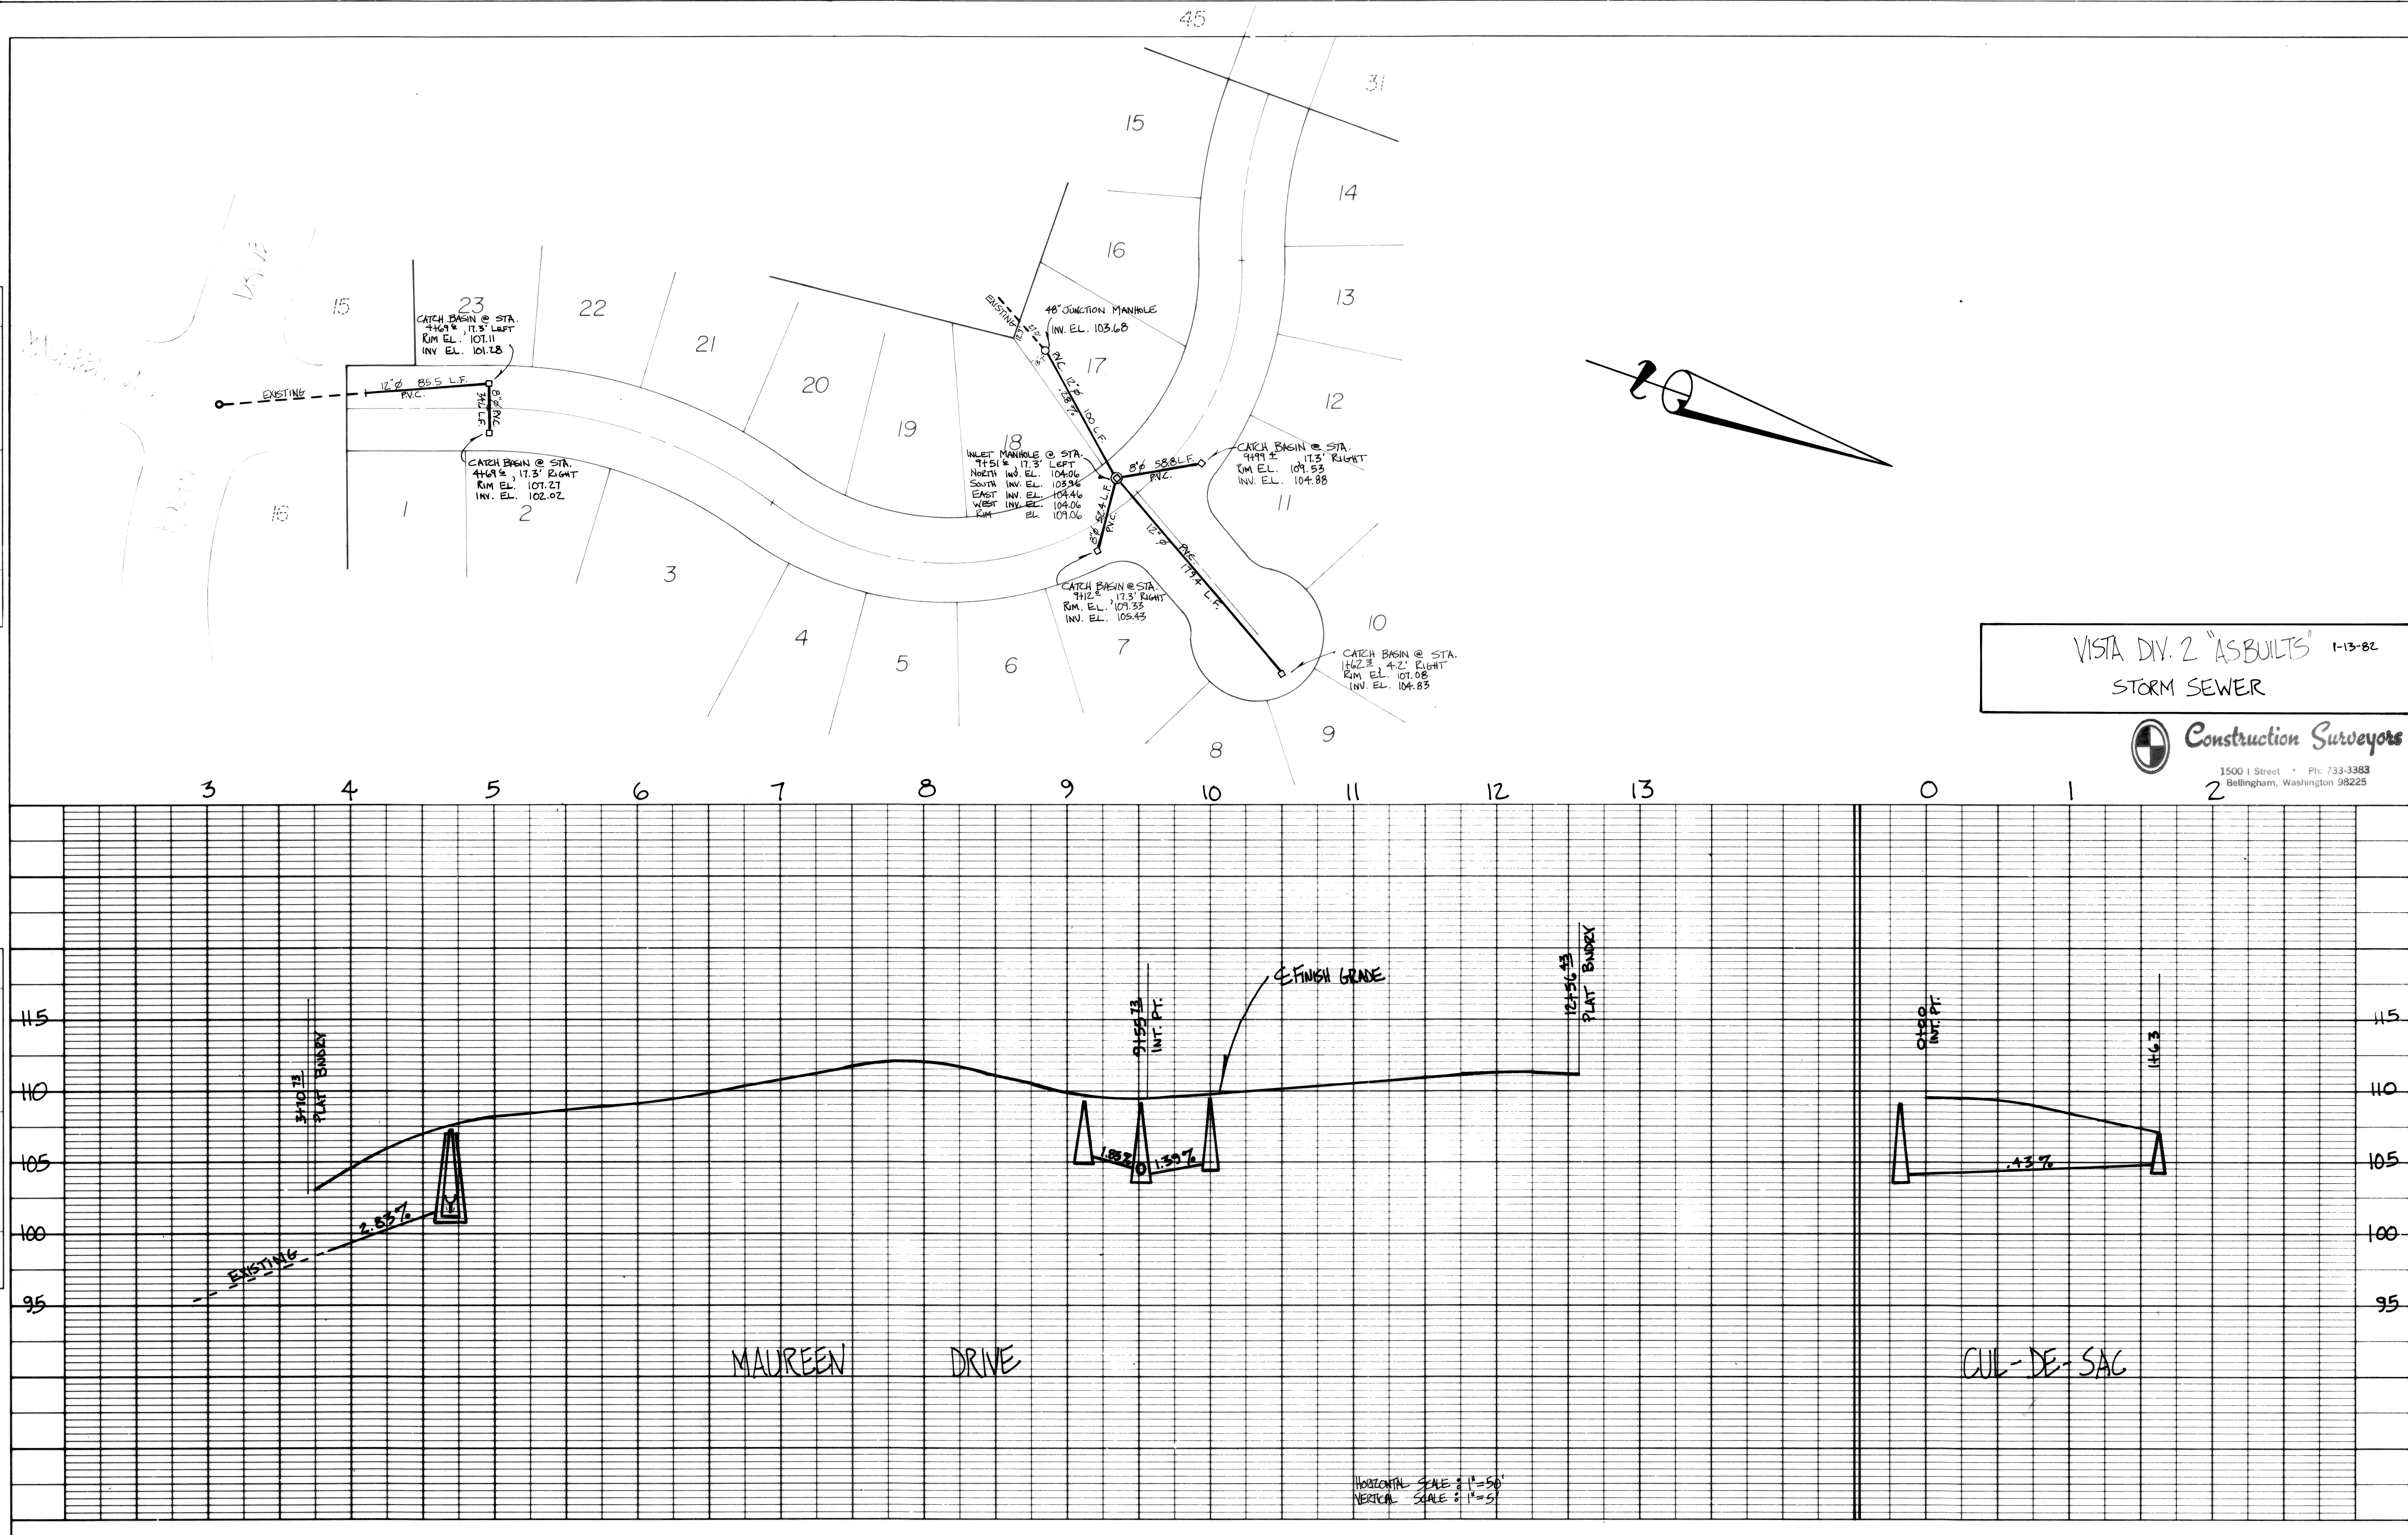

VISTA DIV. 2 "ASBUILT"
 STORM SEWER

Construction Surveyors
 1500 1 Street • Ph: 733-3383
 Bellingham, Washington 98225

00246.004 2-16-06 FR