


P:\HNM\017\RD008 Tue Aug 26 11:35:32 1997 DAVID EVANS AND ASSOCIATES - DWA

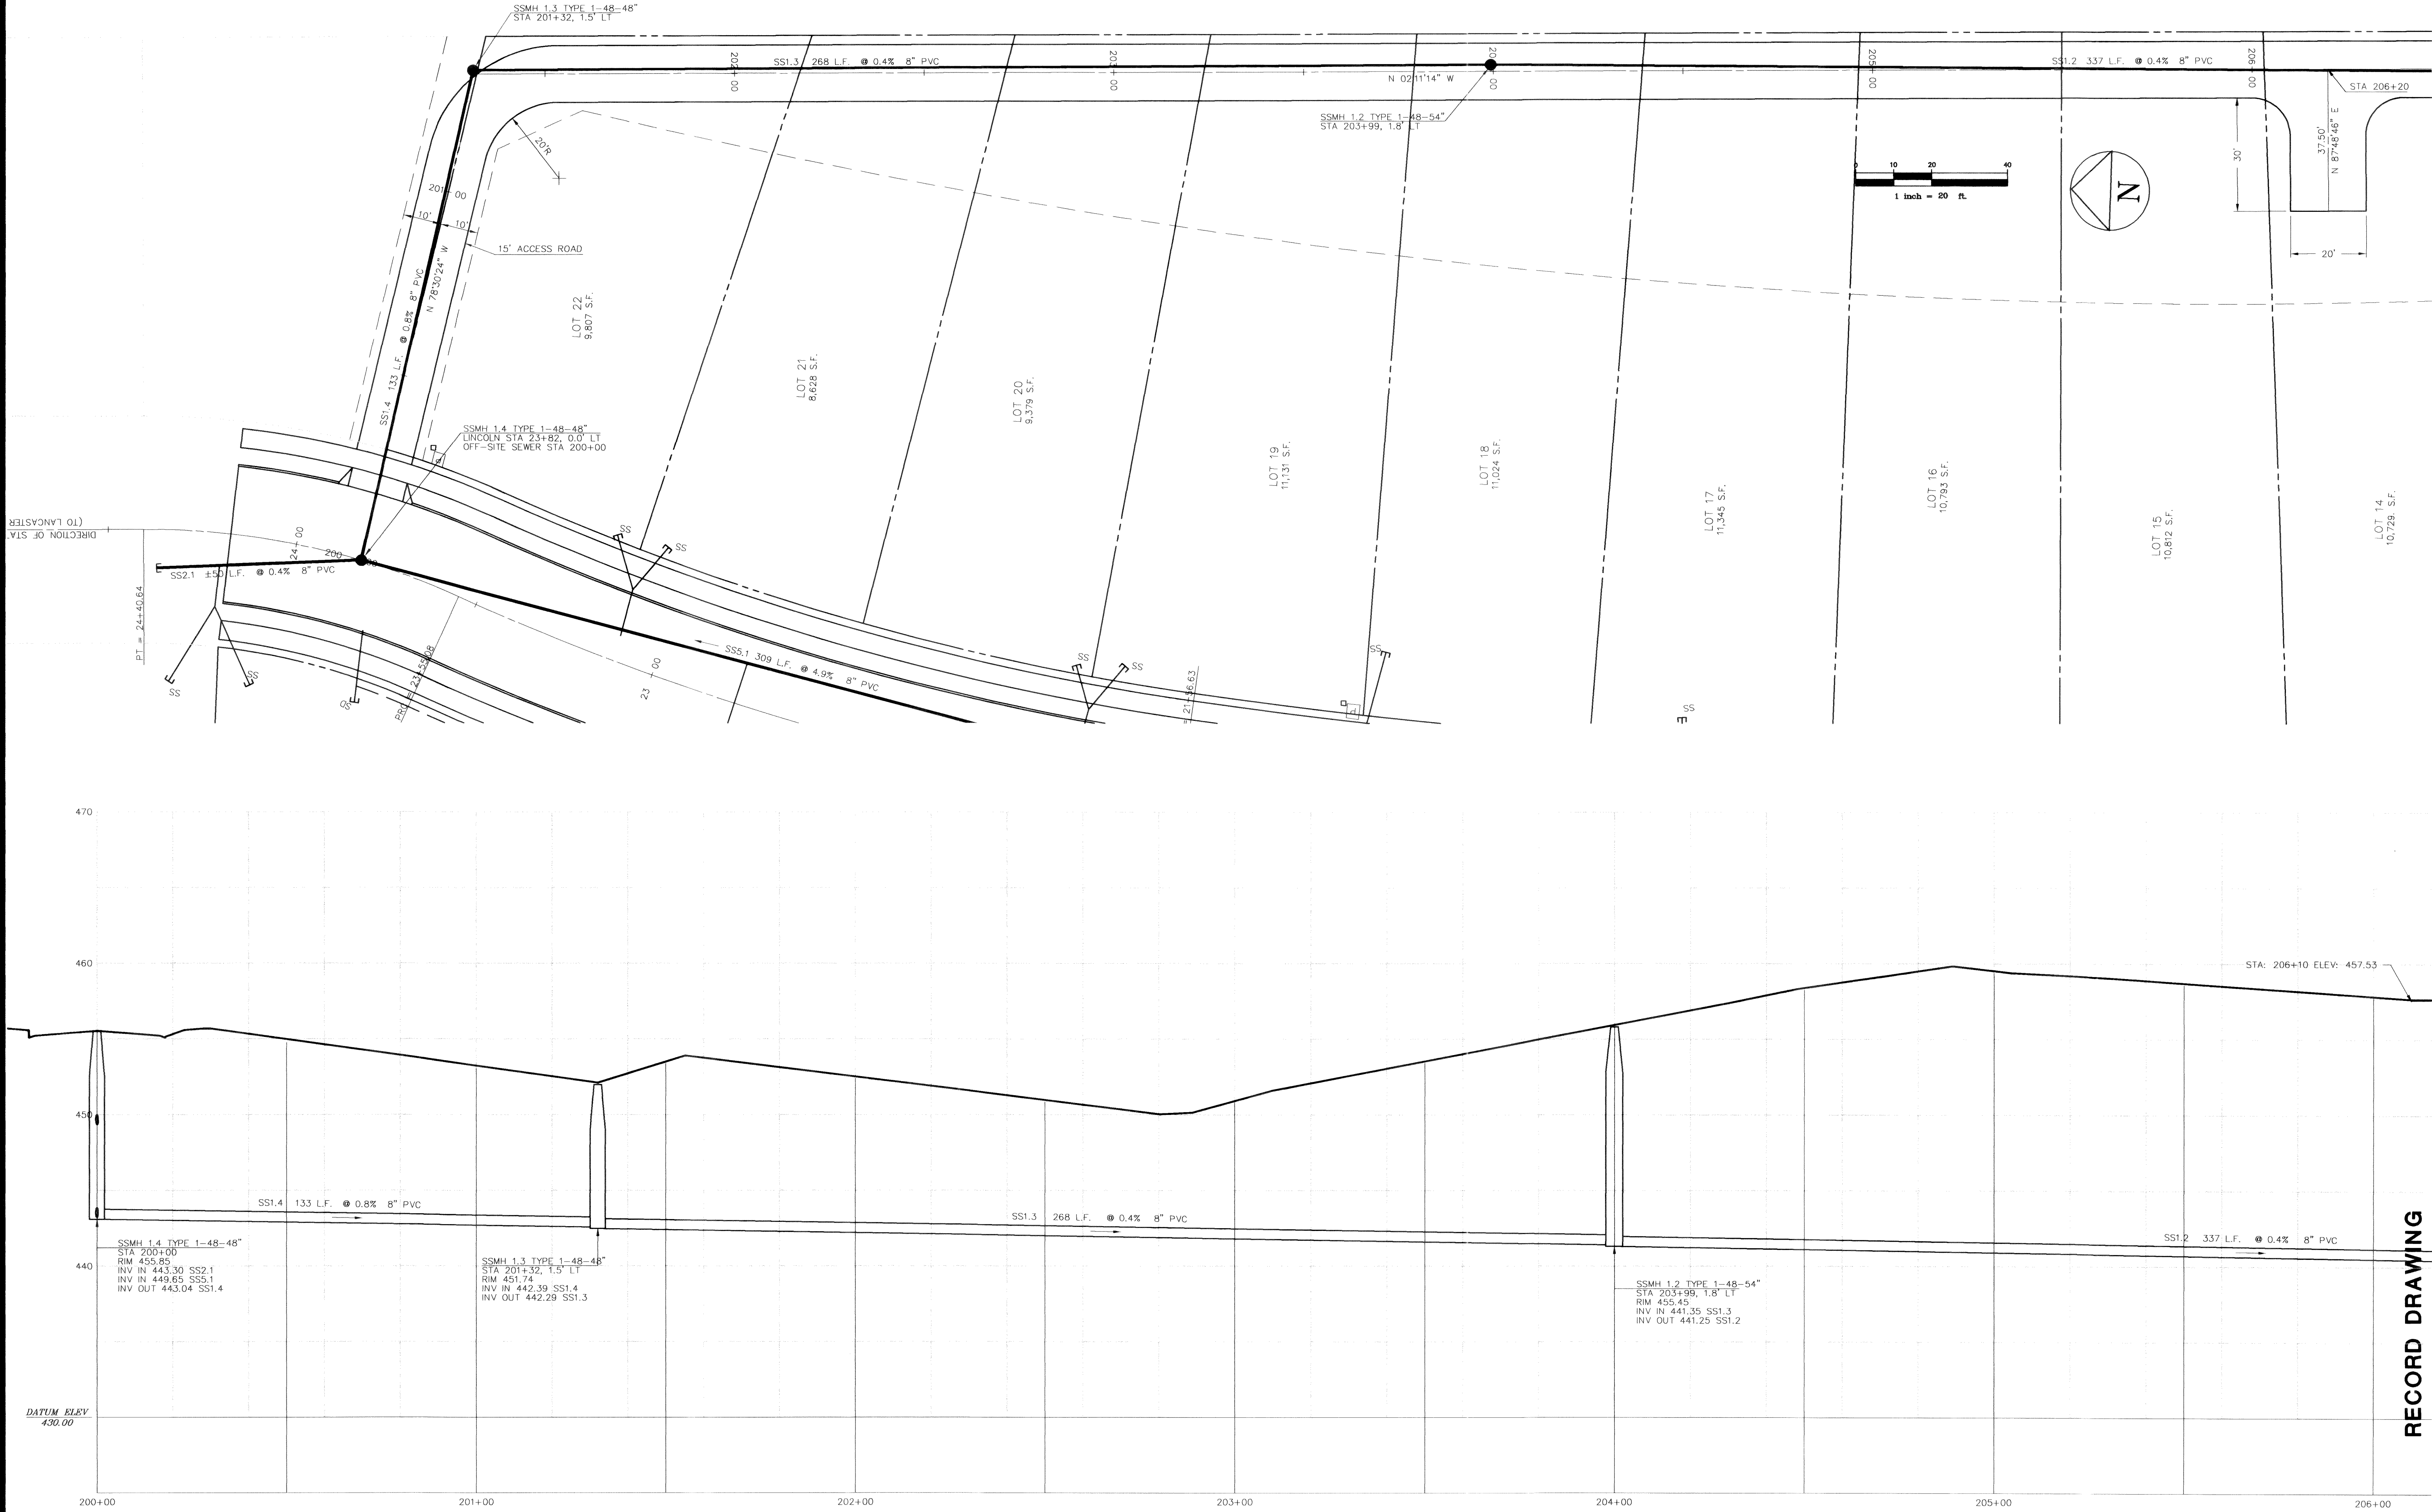

RECORD DRAWING

REVISIONS

2	OF	4	SHEETS
SCALE: H: 1"=20' V: 1"=5'	DESIGN: CRP		
DATE: 8-26-97	DRAWN: DWA		
FILE: HNM\0017\RD008.DWG	CHECKED:		




DAVID EVANS
AND ASSOCIATES,
INC.
119 GRAND AVENUE, SUITE D
BELLINGHAM, WA 98225-4400 (860) 647-7151

VISTA RIDGE
OFF-SITE SEWER PLAN / PROFILE
STA: 200+00 - 206+00

00220.001 2.16.06 JH

P:\VH\N0017\0008 Tue Aug 26 11:39:56 1997 DAVID EVANS AND ASSOCIATES - DWG

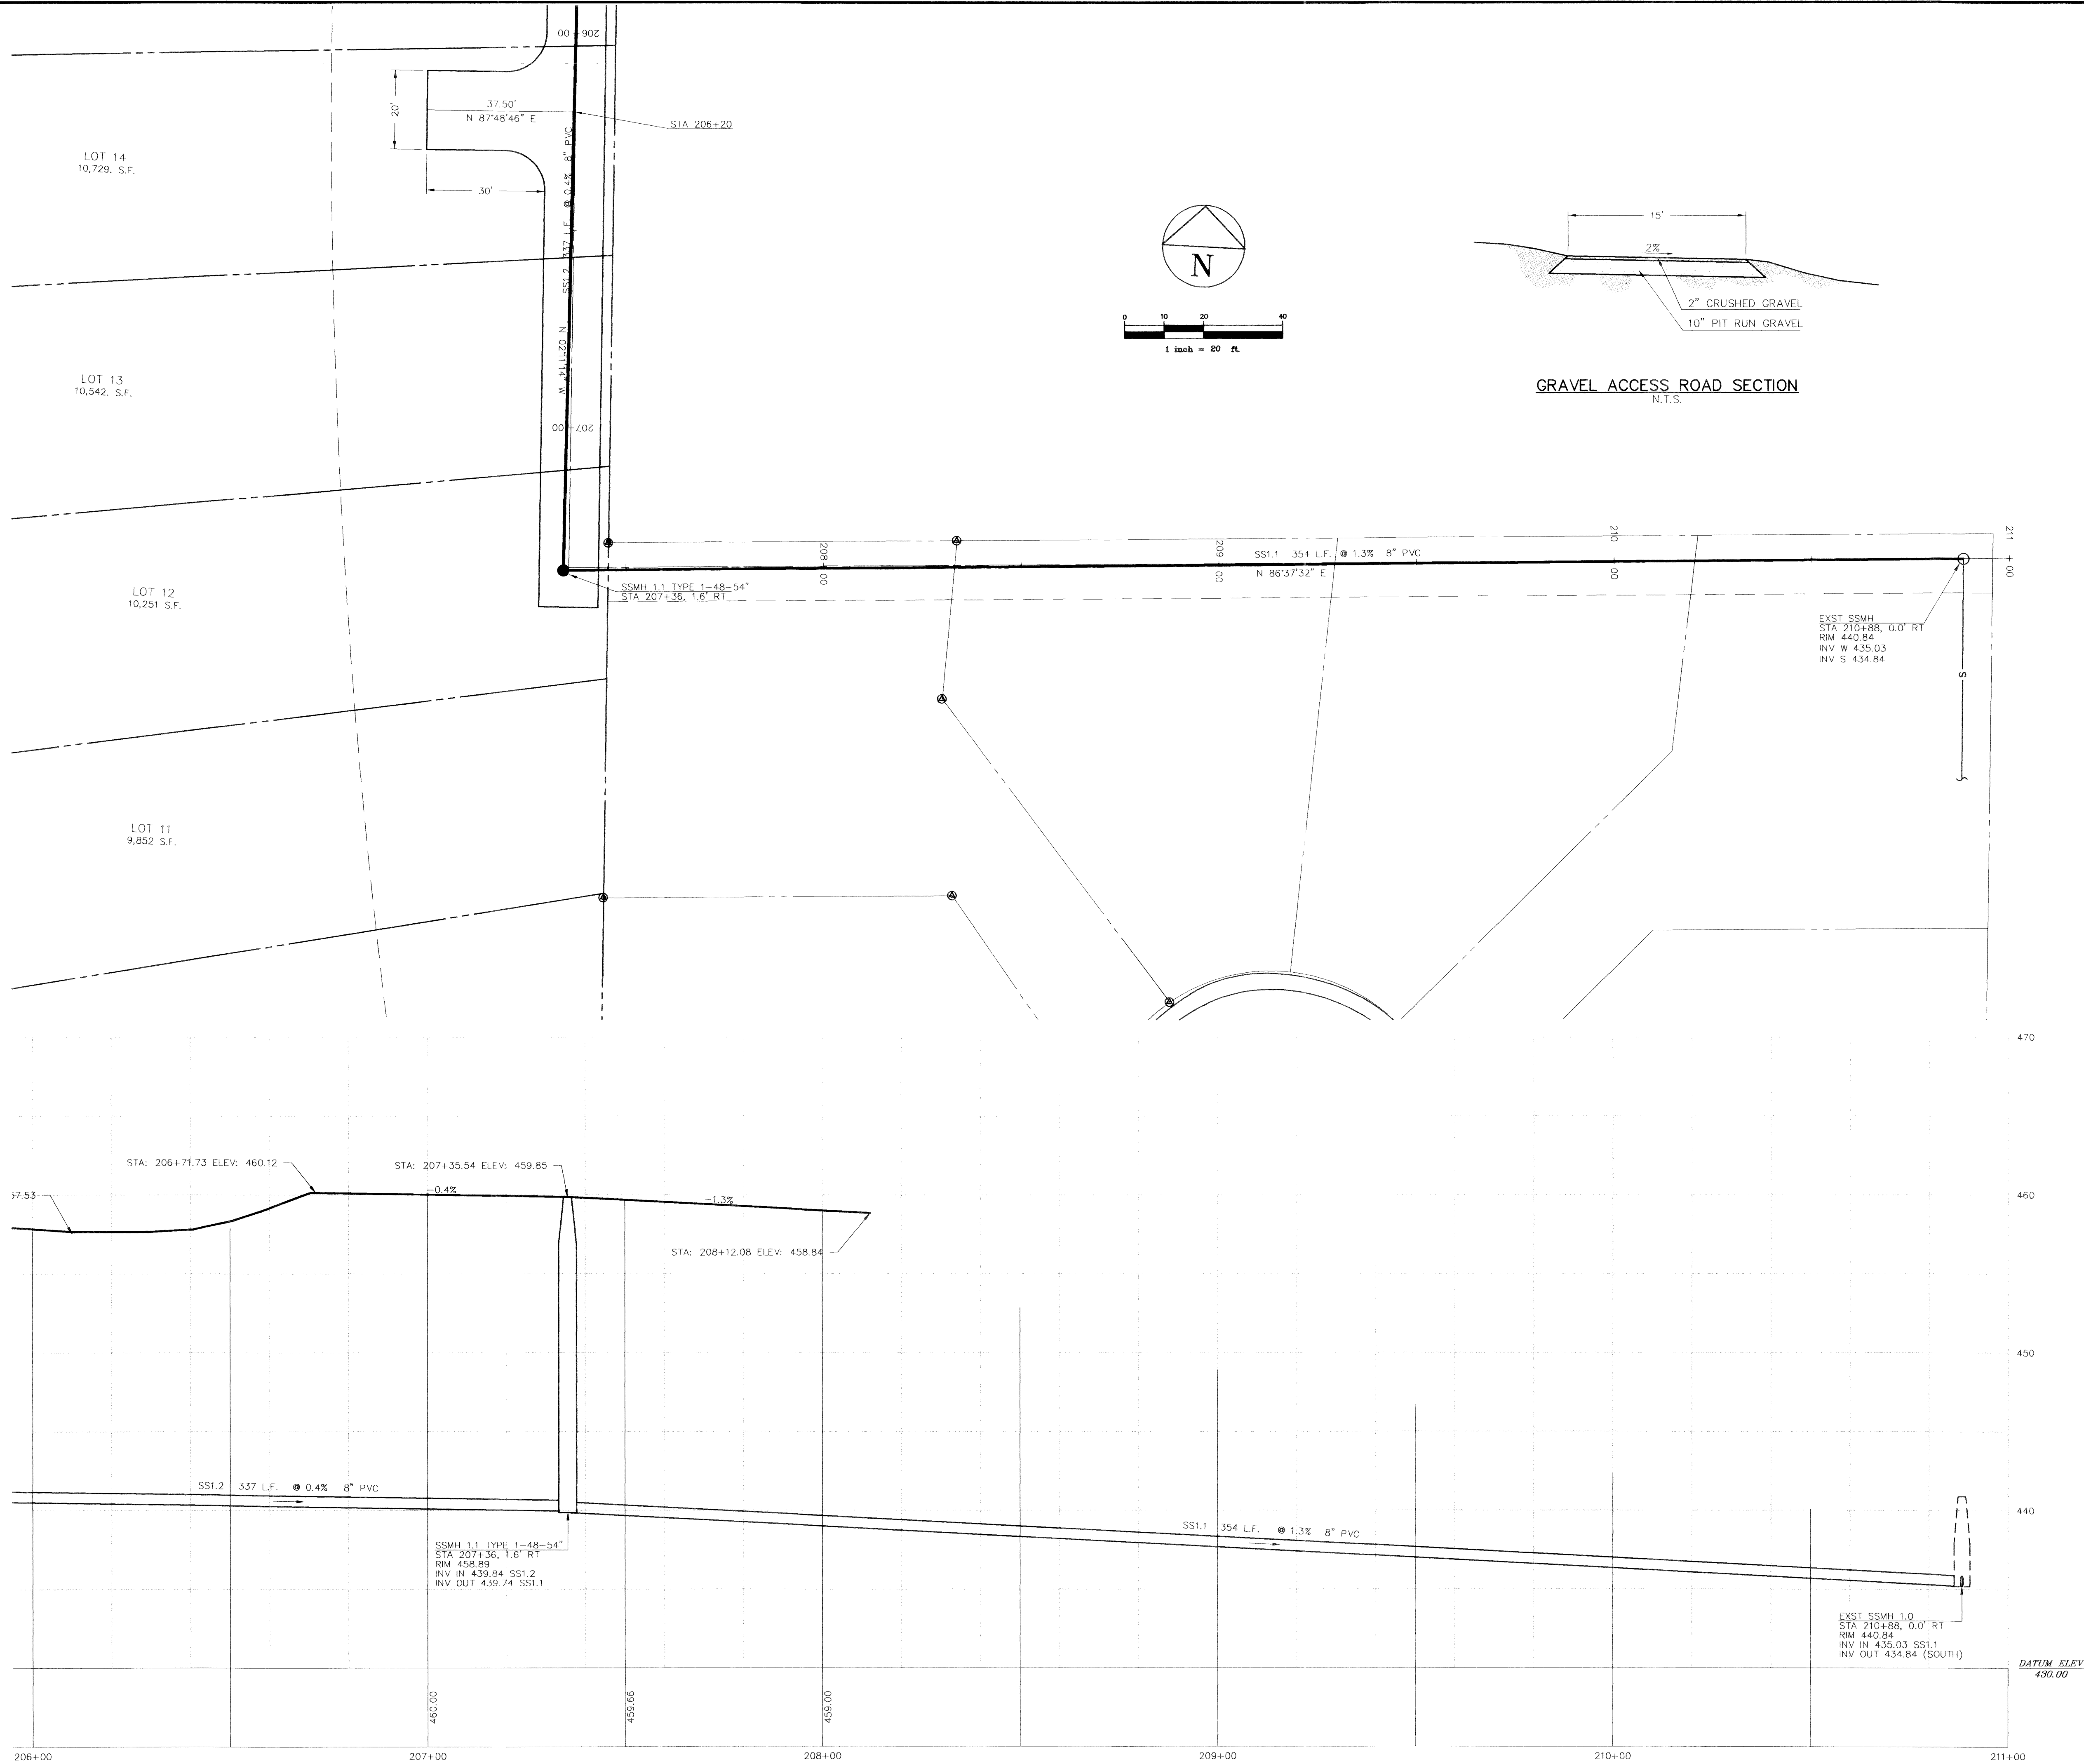

RECORD DRAWING

REVISIONS

NO.	DESCRIPTION	DATE	BY	CHECKED
3	OF	4	SHEETS	
SCALE:	H: 1"=20'	V: 1"=5'	DESIGN: CRP	
DATE:	8-26-97		DRAWN: DWA	
FILE:	H\N\N0017\RD008.DWG		CHECKED:	

den
INC.
DAVID EVANS
AND ASSOCIATES,
119 GRAND AVENUE, SUITE D
BELLINGHAM, WA 98225-4400 (800) 647-7151

VISTA RIDGE
OFF-SITE SEWER PLAN / PROFILE
STA: 206+00 - 211+00

00000.001 8-16-04 KLL