


NOT INCLUDED WITH THIS SUBMITTAL

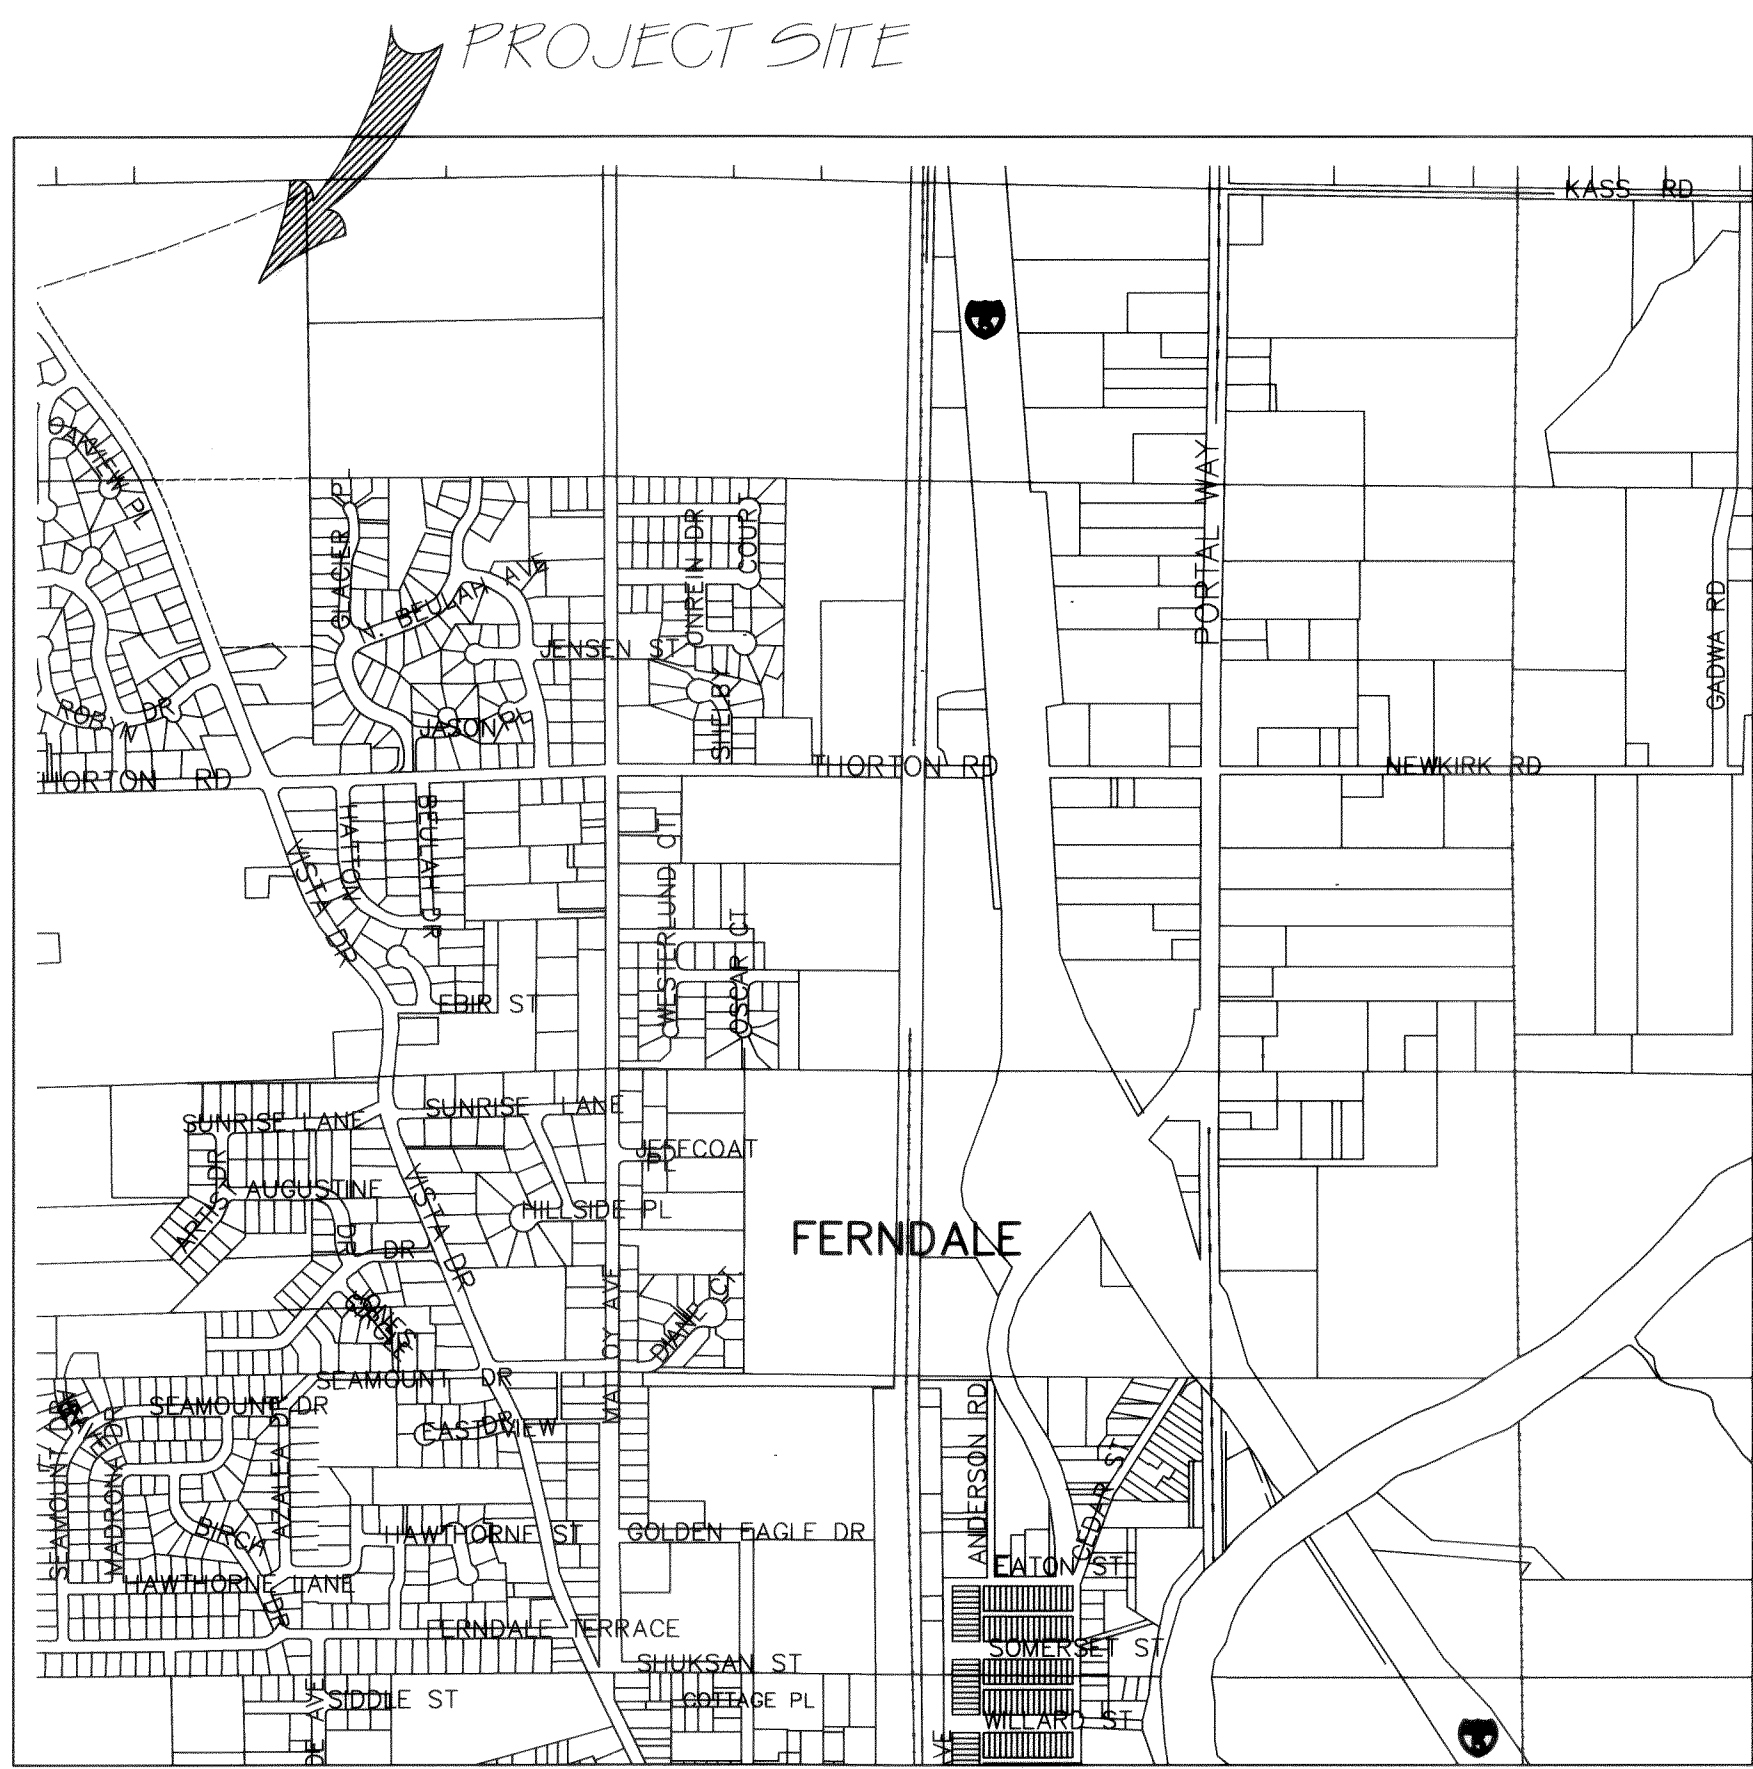

VICINITY MAP
N.T.S.

DRAWING INDEX

SHEET NO.	DRAWING TITLE	SHEET NO.	DRAWING TITLE
1	COVER SHEET	13	ALLEY PLAN / PROFILE STA: 75+00-76+97.55
2	SURVEY CONTROL PLAN		LANCASTER STREET PLAN / PROFILE STA: 80+00-81+30
3	LINCOLN STREET PLAN / PROFILE STA: 10+00-15+00	14	VISTA DRIVE PLAN / PROFILE STA: 100+00-105+00 NOT CONSTRUCTED
4	LINCOLN STREET PLAN / PROFILE STA: 15+00-20+00	15	VISTA DRIVE PLAN / PROFILE STA: 105+00-110+00 NOT CONSTRUCTED
5	LINCOLN STREET PLAN / PROFILE STA: 20+00-25+45.90	16	VISTA DRIVE PLAN / PROFILE STA: 110+00-115+00 NOT CONSTRUCTED
6	FULTON STREET PLAN / PROFILE STA: 30+00-35+79.19	17	VISTA DRIVE PLAN / PROFILE STA: 115+00-120+00 NOT CONSTRUCTED
7	HAMILTON STREET PLAN / PROFILE STA: 40+00-45+00	18	VISTA DRIVE PLAN / PROFILE STA: 120+00-125+00 NOT CONSTRUCTED
8	HAMILTON STREET PLAN / PROFILE STA: 45+00-50+00	19	EAST PROPERTY LINE STORM DRAIN PLAN
9	HAMILTON STREET PLAN / PROFILE STA: 50+00-54+35.14	20	DETENTION POND PLAN
10	LINCOLN STREET PLAN / PROFILE STA: 60+00-64+50	21	EROSION CONTROL PLAN
11	LINCOLN STREET PLAN / PROFILE STA: 64+50-69+20.29		
12	ALLEY PLAN / PROFILE STA: 70+00-75+00		

As-Built Drawing Certification

I hereby certify that the publicly maintained improvements in Vista Ridge Planned Unit Development have been located by David Evans and Associates, Inc. and constructed in conformance with the plans approved by the Public Works Director for said development and the general specifications adopted by the City of Ferndale Department of Public Works.

HOMESTEAD

PLANNED RESIDENTIAL DEVELOPMENT

VISTA RIDGE PLANNED UNIT DEVELOPMENT

CONTRACT DRAWINGS FOR:
HOMESTEAD NORTHWEST, INC.
LYNDEN, WASHINGTON

CONSULTING ENGINEER:
DAVID EVANS AND ASSOCIATES, INC.

LEGEND

EXISTING	PROPOSED	DESCRIPTION
— P —	— P —	POWER
— T —	— T —	TELEPHONE
— G —	— G —	GAS
— D —	— D —	STORM DRAINAGE
— S —	— S —	SEWER
— W —	— W —	WATER
—	—	INDEX CONTOURS
—	—	NORMAL CONTOURS
—	—	EDGE OF PAVEMENT
—	—	DITCH
—	—	PROPERTY LINE
—	—	EASEMENT/ROW LINE
—	—	SURVEY SECTION LINE
—	—	CENTER LINE
—	—	CULVERT
—	—	FIRE HYDRANT
—	—	STORM DRAIN CATCH BASIN
—	—	SANITARY SEWER MANHOLE
—	—	GATE VALVE
—	—	POWER POLE
—	—	POWER VAULT
—	—	TELEPHONE VAULT
—	—	SIGN
—	—	STREET LIGHT
—	—	JUNCTION BOX

SEWER NOTES

- PIPE FOR GRAVITY SEWERS SHALL BE PVC PIPE CONFORMING TO ASTM D3034 SDR-35. HANCOR SURE-LOK F477 CAN BE SUBSTITUTED FOR STORM SEWER PVC PIPE AT ALL STORM LOCATIONS EXCEPT ON VISTA DRIVE. PIPE BEDDING SHALL BE PER DETAIL ON SHEET 19.
- ALL JOINTS FOR GRAVITY AND PRESSURE SEWERS SHALL BE OF THE RUBBER GASKET TYPE.
- MANHOLES SHALL BE IN ACCORDANCE WITH STANDARD DETAILS. JOINTS ON MANHOLE SECTIONS SHALL BE GROUTED RUBBER GASKET TYPE. MANHOLES SHALL BE PRECHANNELED. A FLEXIBLE PIPE-TO-MANHOLE CONNECTOR SHALL BE EMPLOYED IN THE CONNECTION OF THE SANITARY SEWER PIPES TO PRECAST MANHOLES.
- MANHOLE COVERS SHALL BE BOLT-DOWN TYPE.

GENERAL NOTES

- ALL WORK AND MATERIALS SHALL CONFORM TO THE STANDARD PLANS AND SPECIFICATIONS OF THE WASHINGTON STATE DEPARTMENT OF TRANSPORTATION (STANDARD SPECIFICATIONS), AND AMENDMENTS TO THESE SPECIFICATIONS AS CONTAINED HEREIN, PARTICULARLY SECTIONS 5-04 THROUGH 5-08. SECTIONS 7-17.3(3), 9-01 THROUGH 9-03 WILL GENERALLY APPLY UNLESS OTHERWISE STATED BELOW, OR BY THE CONTRACT DOCUMENTS. IN CASE OF A CONFLICT BETWEEN THE REGULATORY STANDARDS OR SPECIFICATIONS, THE MORE STRINGENT REQUIREMENT WILL PREVAIL.
- UNDERGROUND UTILITIES ARE KNOWN TO EXIST IN THE AREA OF CONSTRUCTION. THE LOCATION OF EXISTING UTILITIES SHOWN IS APPROXIMATE. IT IS THE RESPONSIBILITY OF THE CONTRACTOR TO CONTACT ALL UTILITY OWNERS FOR LOCATIONS AND TO FIELD VERIFY ALL UTILITY LOCATIONS PRIOR TO CONSTRUCTION. THE ONE-CALL NUMBER FOR UNDERGROUND UTILITIES IS: 1-800-424-5555. THE CONTRACTOR SHALL BE RESPONSIBLE FOR MAINTAINING THE INTEGRITY OF ALL EXISTING UTILITIES AND TO NOTIFY THE ENGINEER PROMPTLY OF ANY CONFLICT WITH EXISTING UTILITIES.
- THE CONTRACTOR SHALL BE RESPONSIBLE FOR MAINTAINING EROSION CONTROL MEASURES (SILT FENCE, STRAW BALE DAMS, SILT PONDS, ETC.), THROUGHOUT THE DURATION OF THE PROJECT. EROSION CONTROL MEASURES SHALL BE INSTALLED PRIOR TO ANY CLEARING OR GRADING.
- THE CONTRACTOR SHALL BE RESPONSIBLE FOR KEEPING AS-BUILT INFORMATION, AND FOR PREPARING AS-BUILT DRAWINGS SUITABLE FOR THE ENGINEER TO CERTIFY AS AS-BUILT, AND MEETING THE CITY AS-BUILT ACCEPTANCE CRITERIA. THESE AS-BUILT DRAWINGS SHALL INCLUDE THE EXACT LOCATION OF ALL UNDERGROUND AND ABOVE-GROUND UTILITIES.
- WORK WILL ALSO CONFORM TO THE CITY OF FERNDALE DEVELOPMENT STANDARDS. THE FOLLOWING STANDARD DETAILS SHALL APPLY:

DETAIL TITLE	DRAWING
MAILBOX STANDARD	M-1
ROAD ASPHALT CONCRETE SECTION	R-4 (SEE SHEETS 4,13,14,&16)
DRIVEWAY SECTIONS	R-6
CURBS AND GUTTERS	R-9
TYPICAL SIDEWALK PLAN AND CROSS SECTION	R-12
CURB RAMPS	R-14
PIPE BEDDING FOR SANITARY AND PVC SEWER	SEE DETAIL ON SHEET 19
TYPE 1 48" MANHOLE	SS-2
8" CLEAN OUT	SS-5
15" AND SMALLER SEWER MAINS	SS-6
INSIDE DROP STRUCTURE	SS-10
DOUBLE SANITARY SERVICE	SS-13
CATCH BASIN, TYPE 1	ST-1
TYPE 2 CATCH BASIN, 48" & 54"	ST-2
INLET DETAIL	ST-7
THRU-CURB INLET FRAME & GRATE	ST-8
SILT FENCE DETAIL	ST-10
STRAW BALE DAM DETAIL	ST-11
SIDEWALK DRAINS	ST-15
FIRE HYDRANT ASSEMBLY	W-1
THRUST BLOCKING ELBOWS	W-2
THRUST BLOCKING TEES	W-3
THRUST BLOCKING 4-WAY INTERSECTION	W-4
TYPICAL WATER SERVICE	W-5
2" BLOW-OFF WATER MAIN EXTENSION	W-9
2" BLOW-OFF, NON-EXTENDABLE MAIN	W-10
TRENCHING DETAIL	W-11

APPROVED

OCT 14 2002
BY *[Signature]*
CITY OF FERNDALE

- STREET LIGHTING SHALL BE IN ACCORDANCE WITH SECTION 707 OF THE CITY OF FERNDALE DEVELOPMENT STANDARDS.
- SEE SHEET 20 FOR ROCK WALL AND RIP-RAP NOTES.
- INSPECTIONS FOR ROAD, DRAINAGE, AND UTILITY CONSTRUCTION SHALL BE AS OUTLINED AND IN ACCORDANCE WITH THE CITY OF FERNDALE DEVELOPMENT STANDARDS, SECTION 302
- CONTRACTOR TO PROVIDE A 2 YEAR WARRANTY FOR MAINTAINING ALL GRADES ON DETENTION POND AND STRUCTURES FREE FROM DEBRIS.

AS-BUILT DRAWING - 9/26/02


VISTA RIDGE
PLANNED UNIT DEVELOPMENT
CONSTRUCTION PLANS

00249.001 2.16.06 KLB



DAVID EVANS
AND ASSOCIATES, INC.

119 GRAND AVENUE, SUITE D
BRI LINGHAM, WA 98956-4400 (509) 847-7151

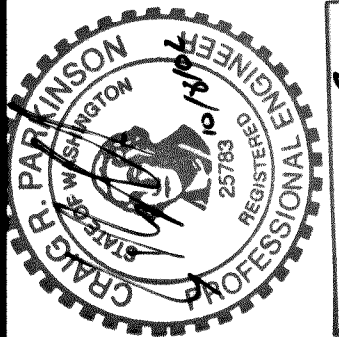

REVISIONS

Revisions per city 9-25-02

SHEETS

DESIGN: CRP

21

OF

SCALE: N.T.S.


DATE: 9/26/02

FILE: HMTW0017/HMT7RDTA.DWG

DRAWN: DWMA

CHECKED: CH

P:\P\HNNW0017\DWG\AS-BUILT\15\HML7-d2a.dwg Ver: Apr 11 10:11:35 2001 DAVID EVANS AND ASSOCIATES, INC. -TSR

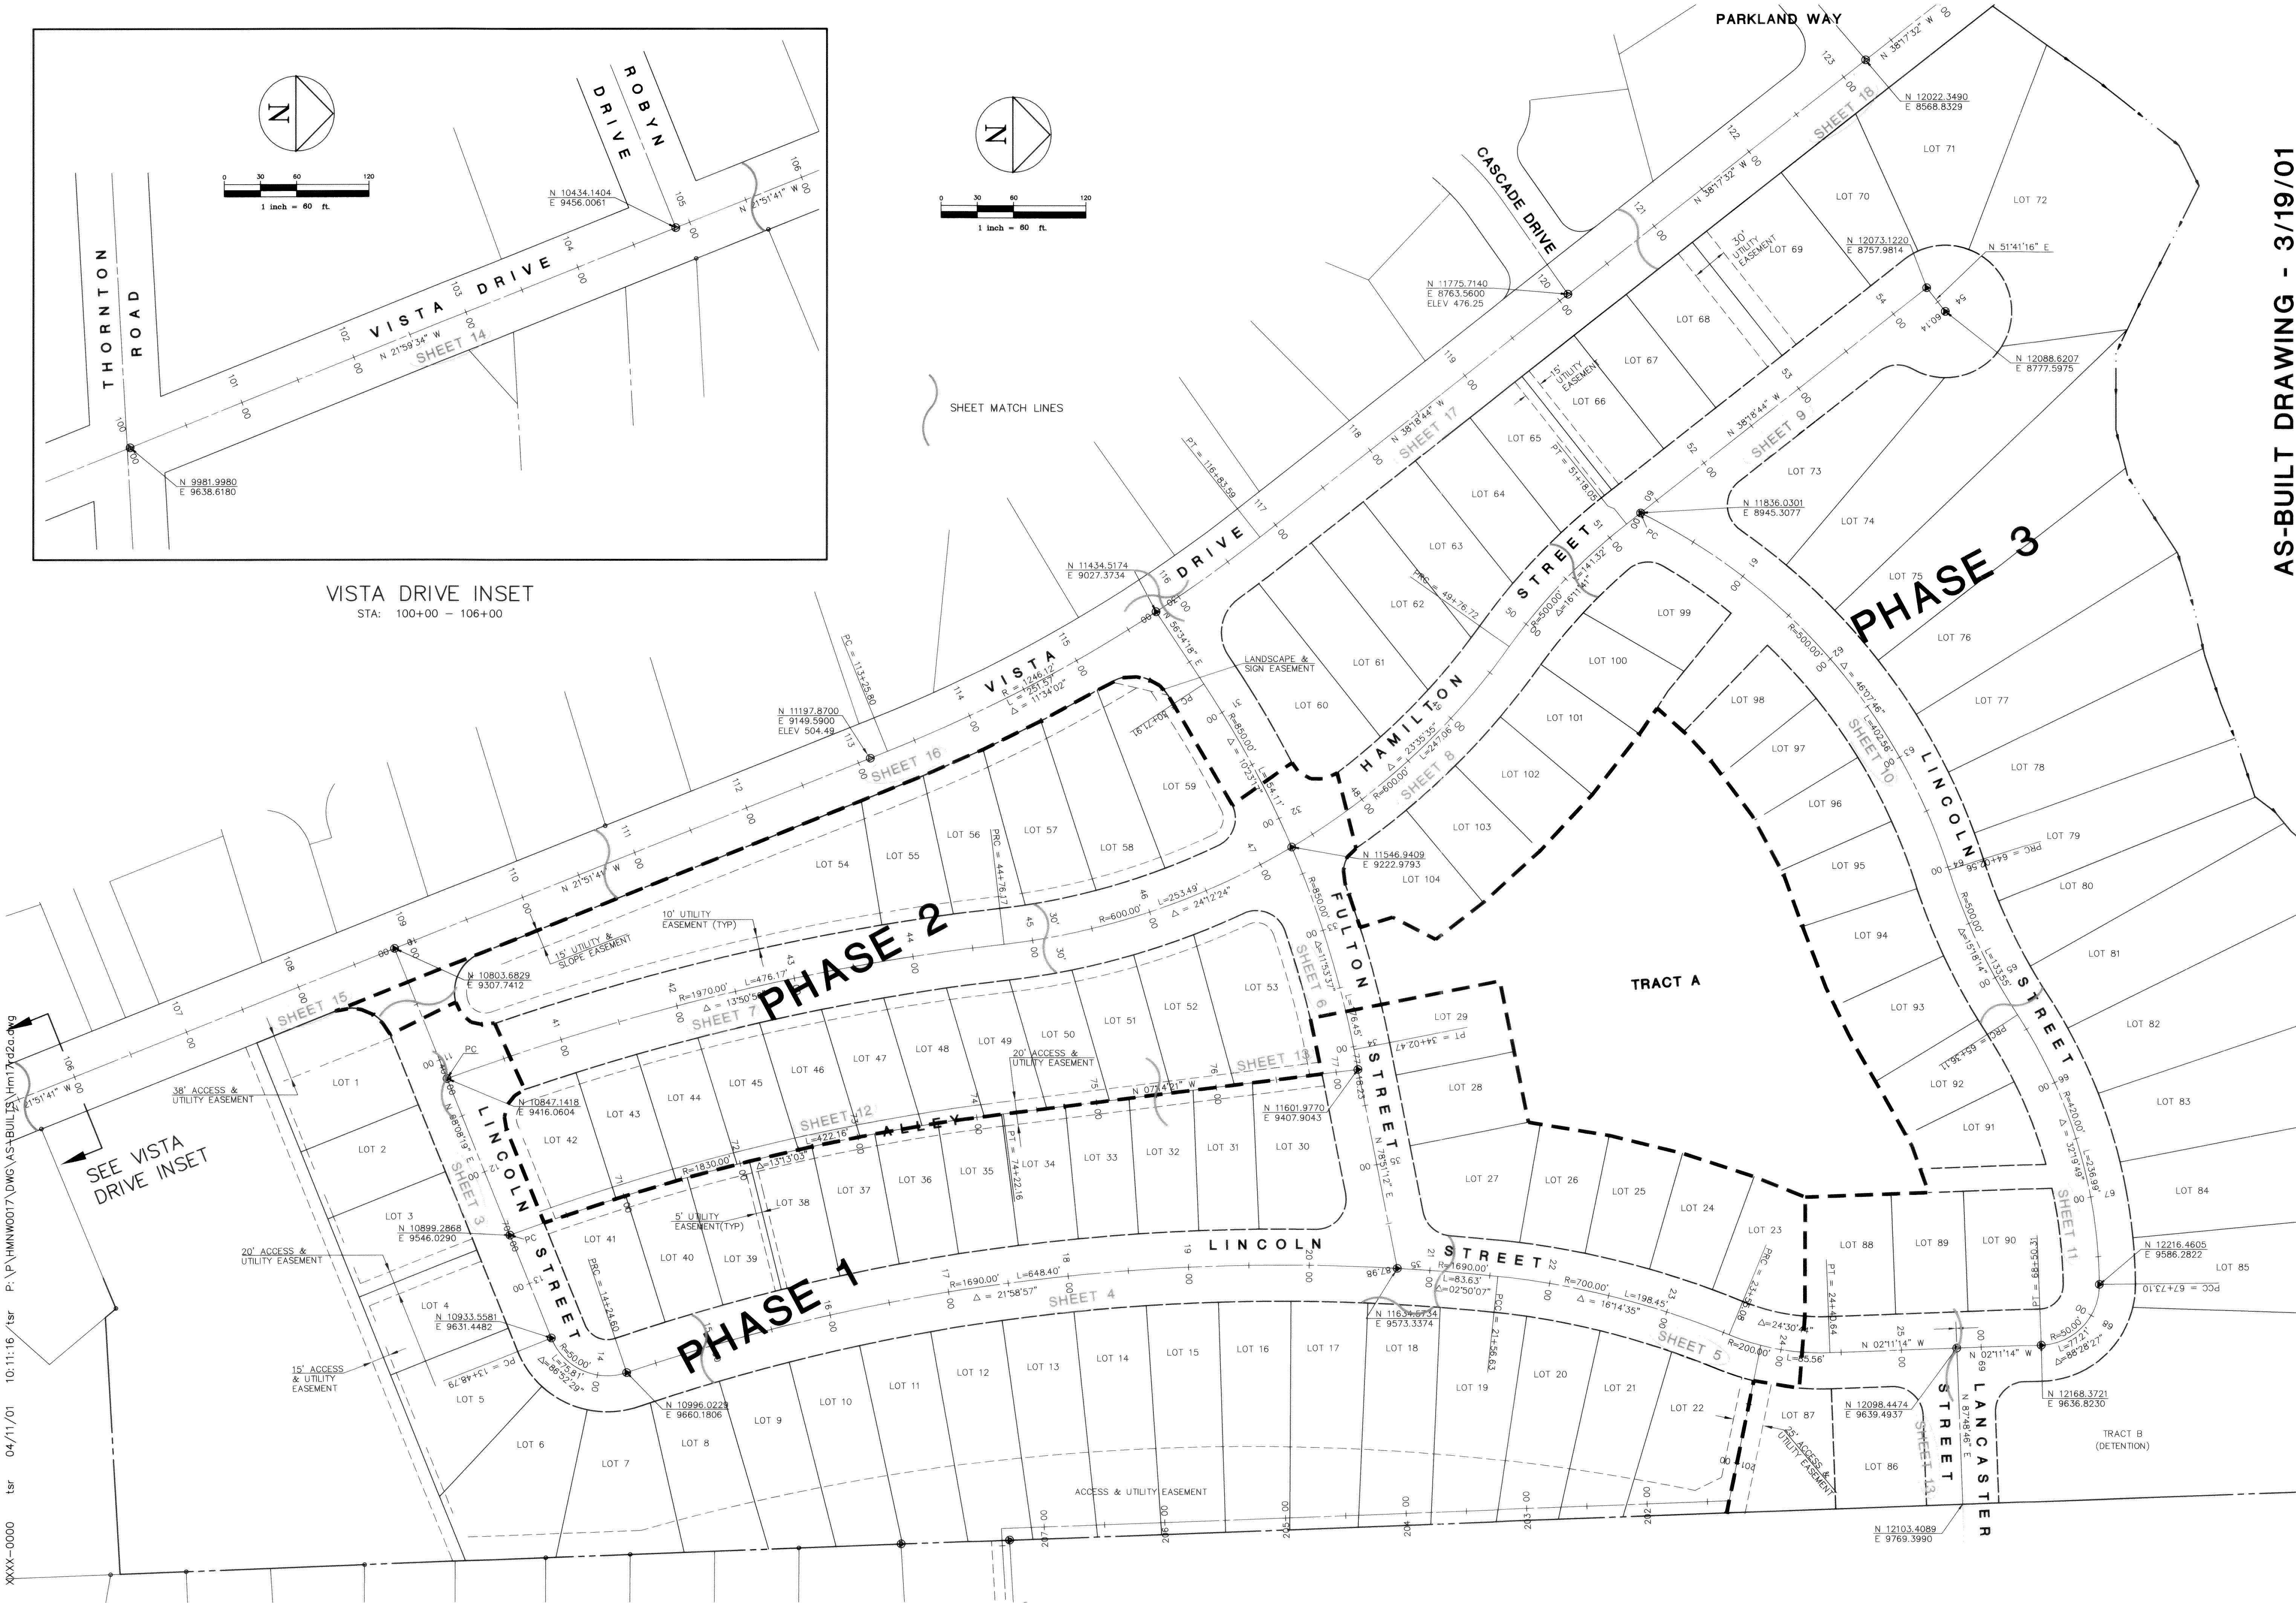


VISTA DRIVE INSET
STA: 100+00 - 106+00

AS-BUILT DRAWING - 3/19/01

VISTA RIDGE
SURVEY CONTROL PLAN

00249.002 2-16-06 K42

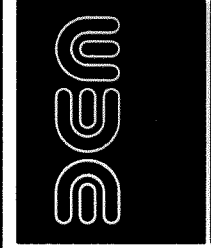

DAVID EVANS
AND ASSOCIATES, INC.
119 GRAND AVENUE, SUITE D
BELLINGHAM, WA 98225-4400 (800) 647-7151





EXPIRES 4-28-03

REVISIONS

NO.	DESCRIPTION	DATE
1	AS-BUILT	3/19/01

2	OF	21
SHEETS		
SCALE: 1"=60'	DESIGN: CRP	
DATE: 3/19/01	DRAWN: DWMA	
FILE: HNNW0017/HML7R02A.DWG	CHECKED: C42	

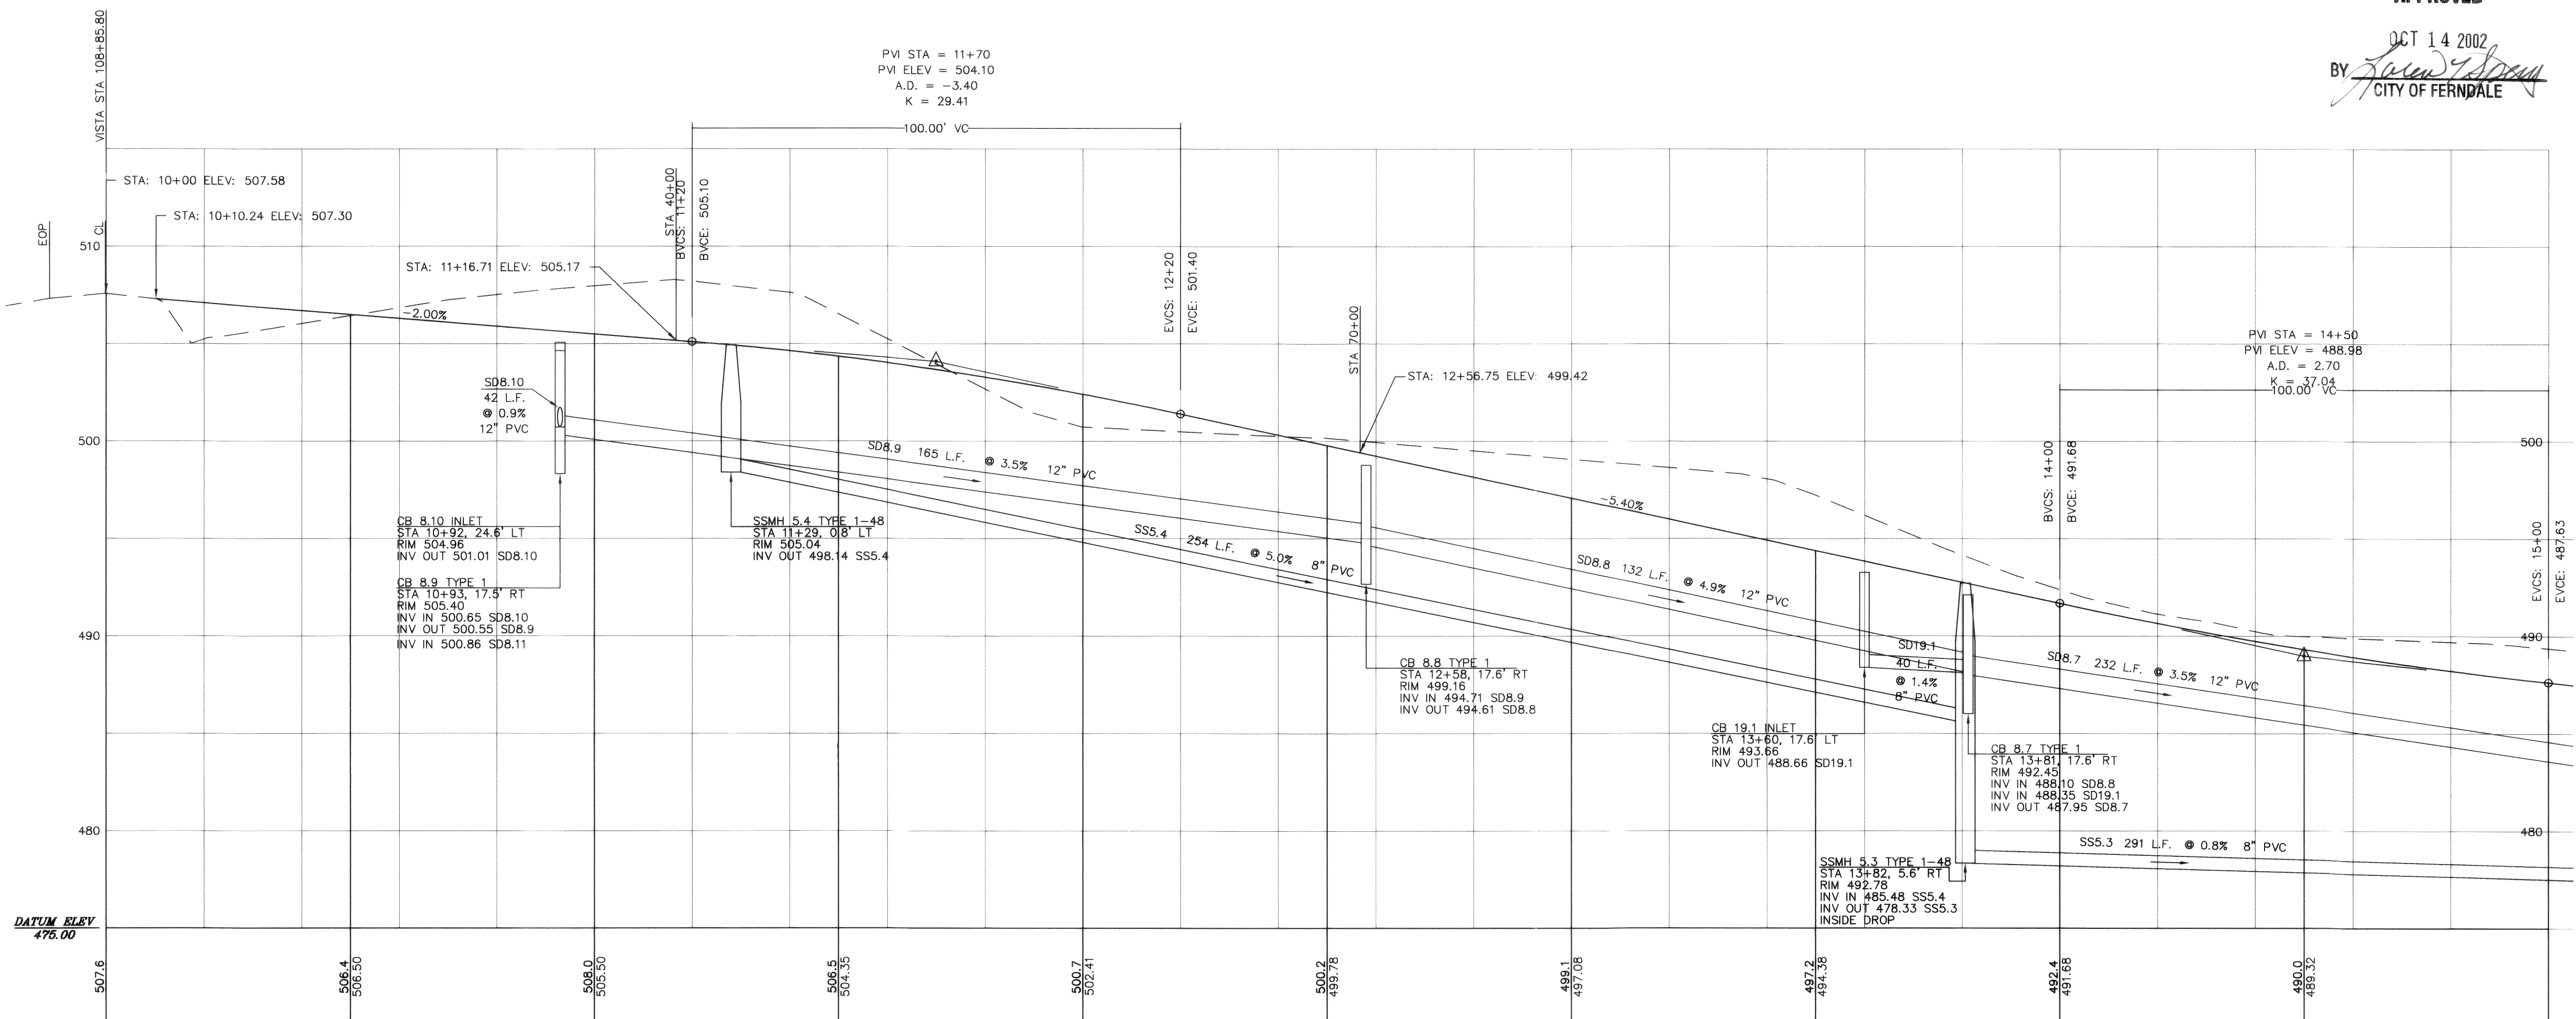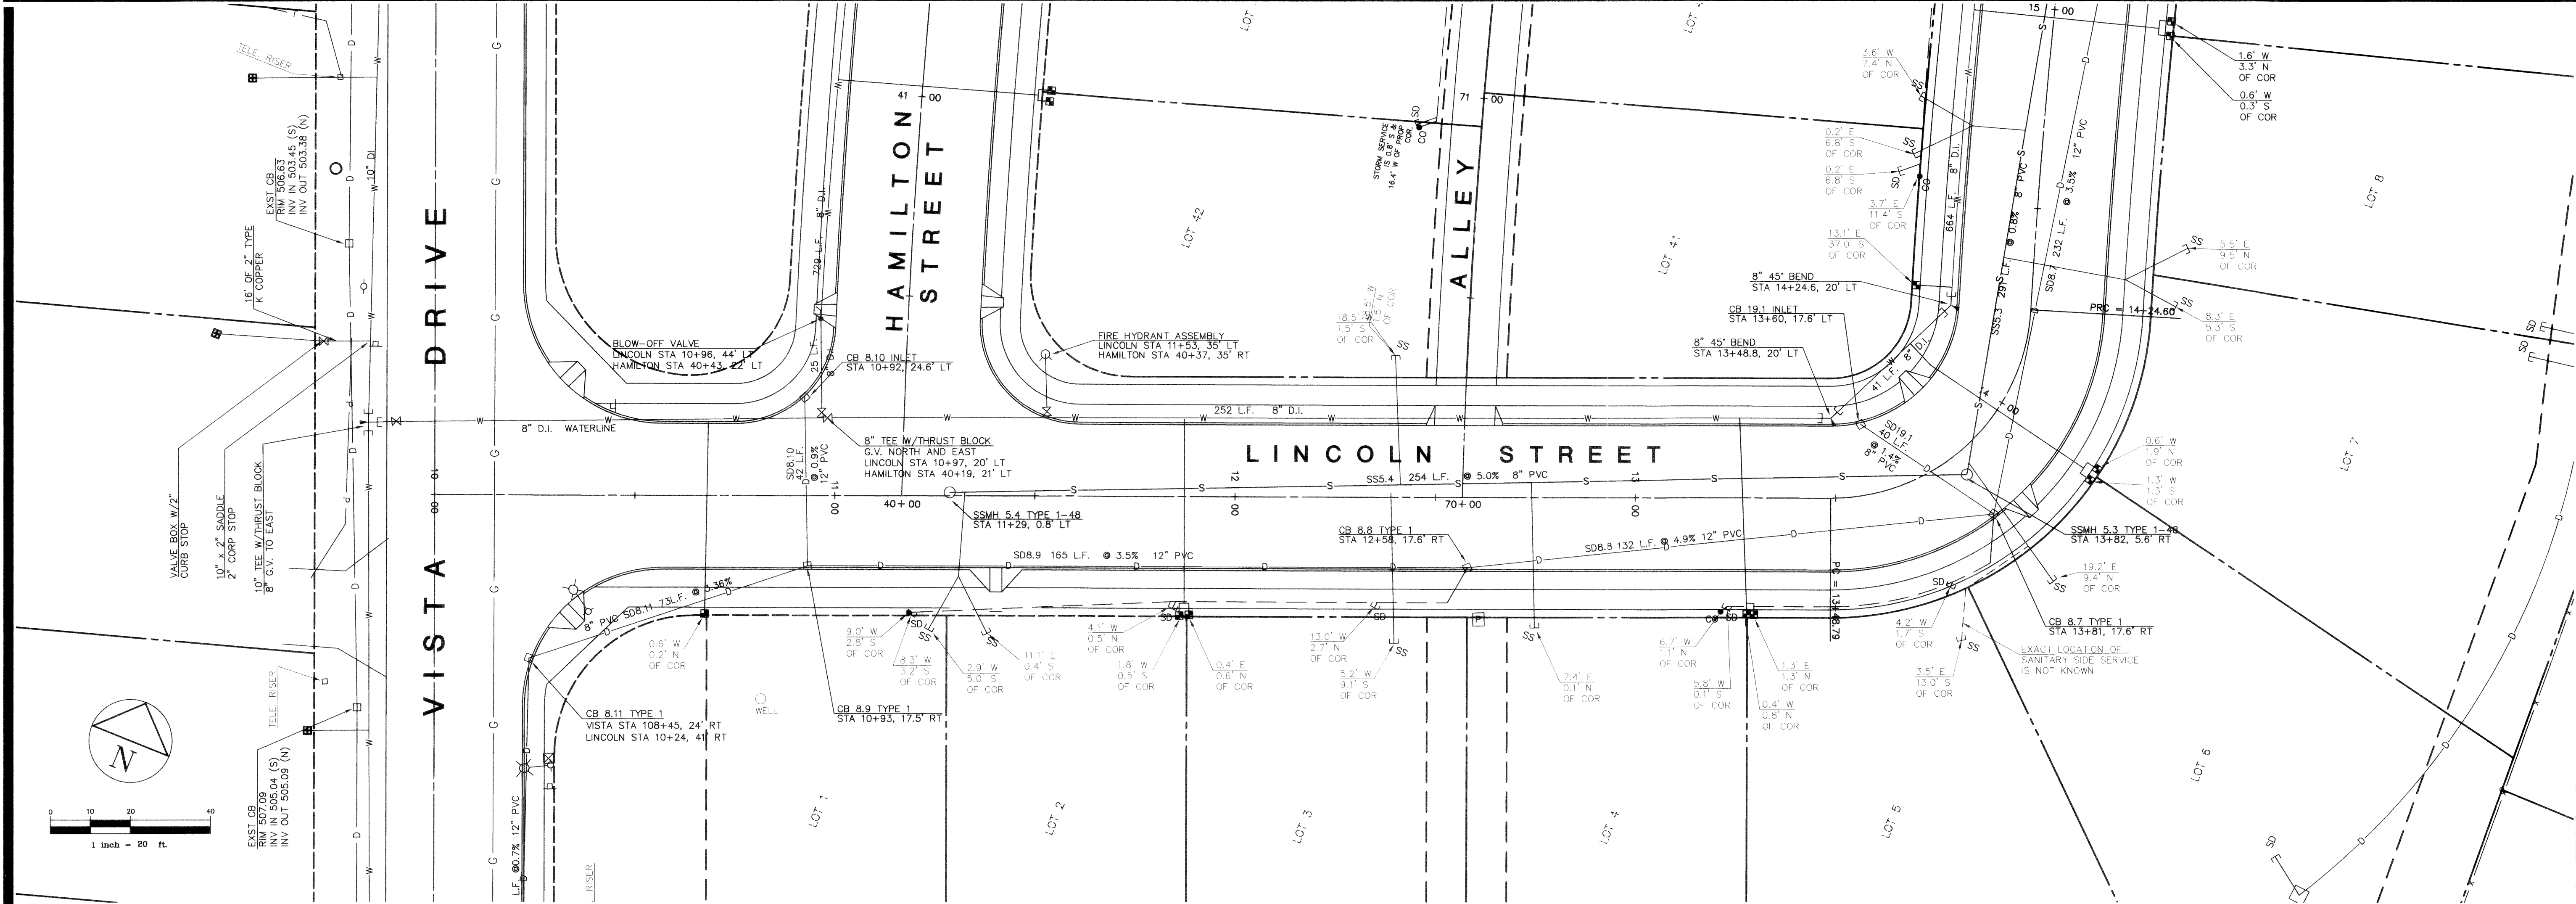

DAVID EVANS
AND ASSOCIATES, INC.
119 GRAND AVENUE, SUITE D
BELLINGHAM, WA 98225-4400 (800) 647-7151


DAVID EVANS
PROFESSIONAL ENGINEER
LICENSE NO. 25753
STATE OF WASHINGTON
EXPIRES 4-28-03

VISTA RIDGE
LINCOLN STREET PLAN / PROFILE
STA: 10+00 - 15+00
00249.003 2-16-00 KE

AS-BUILT DRAWING - 09/26/02

REVISIONS				
3	OF	21	SHEETS	PER CITY ON 6/19/02
Revisions per city 9-25-02				
SCALE	H: 1"=20' V: 1"=5'	DESIGN	CRP	
DATE	9-26-02	DRAWN	DWMA	
FILE	H:\HW0017\HW17RD3A.DWG	CHECKED	CP	

P:\P\HNM0017\DWG\AS-BUILT\15\HMI7\03a.dwg Wed Apr 11 07:09:22 2001 DAVID EVANS AND ASSOCIATES, INC. -159

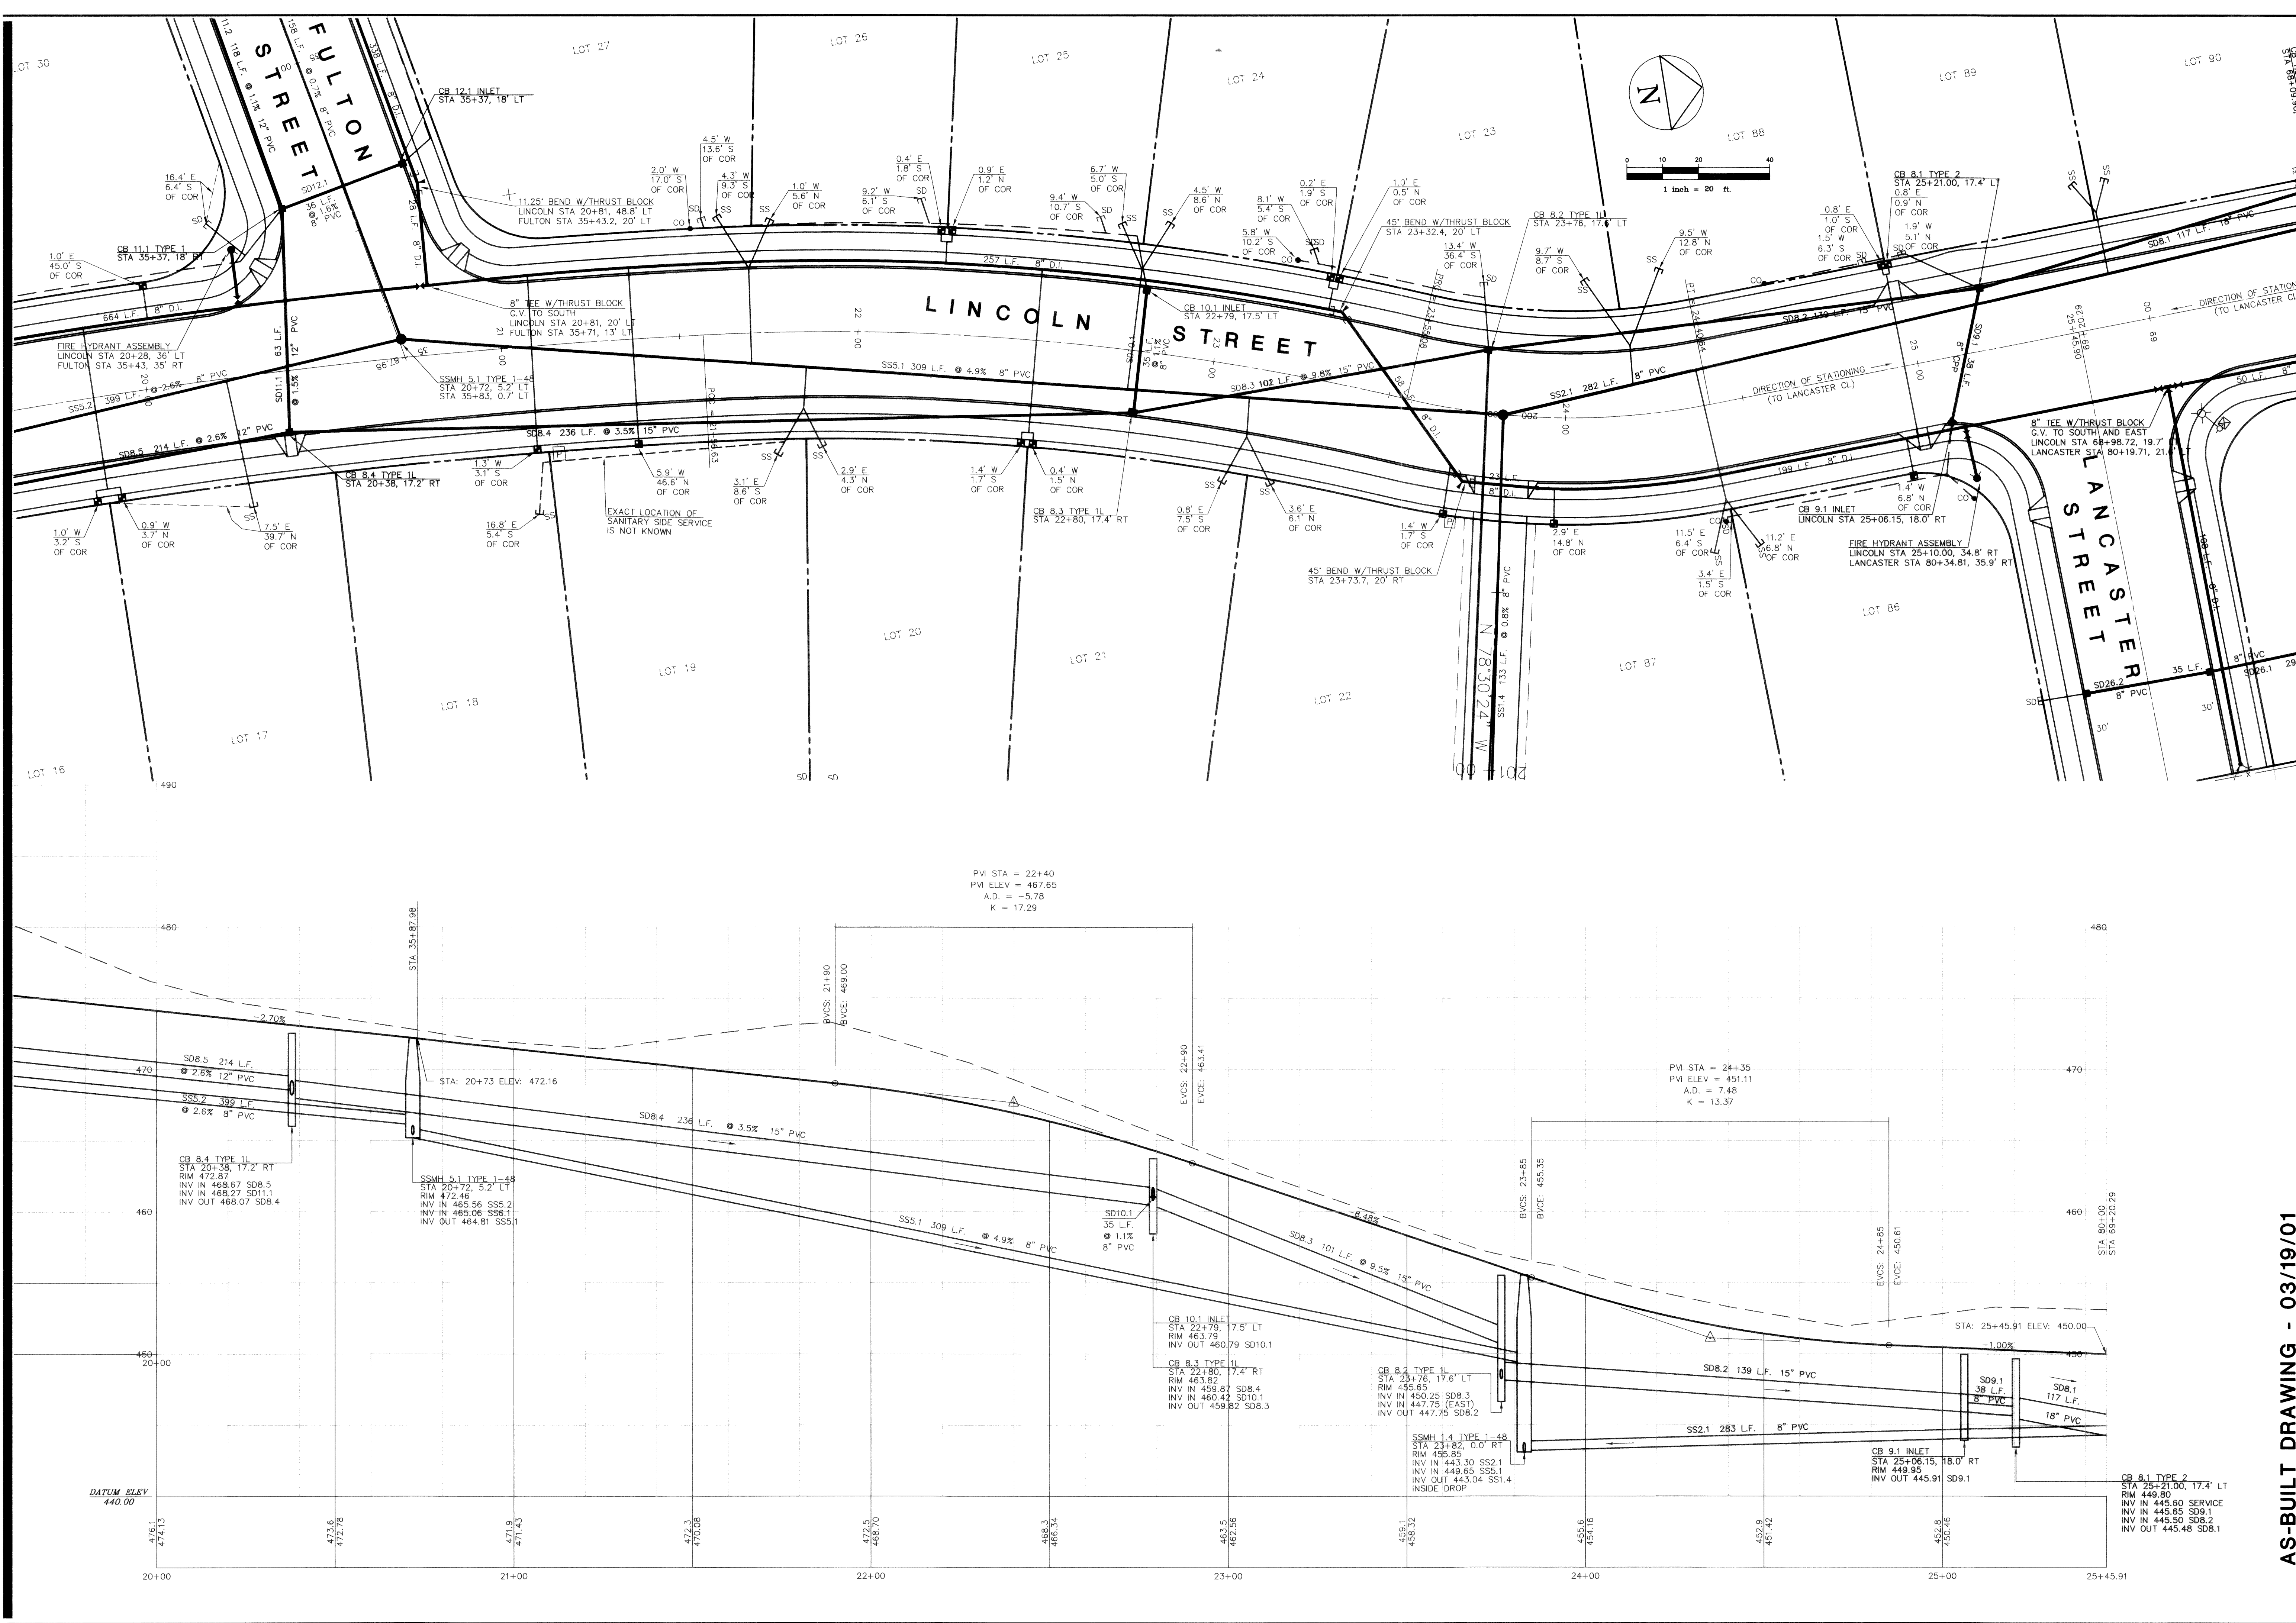

AS-BUILT DRAWING - 03/19/01

521

OF

REVISIONS

DATE: 3/19/01

RE: HNM0017/HMI7R03A.DWG

DESIGN: CRP

DRAWN: DVM/A

CHECKED: CH

DATE: 3/19/01

RE: HNM0017/HMI7R03A.DWG

DESIGN: CRP

DRAWN: DVM/A

CHECKED: CH

DAVID EVANS AND ASSOCIATES, INC.

119 GRAND AVENUE, SUITE D

BELLINGHAM, WA 98225-4400 (860) 647-7151

EXP. 4-28-01

1 inch = 20 feet

0 10 20 40

LOT 15

LOT 16

LOT 17

LOT 18

LOT 19

LOT 20

LOT 21

LOT 22

LOT 23

LOT 24

LOT 25

LOT 26

LOT 27

LOT 86

LOT 87

LOT 88

LOT 89

LOT 90

FULTON STREET

LINCOLN STREET

LANCASTER STREET

CB 11.1 TYPE 1

STA 35+37, 18' LT

CB 12.1 INLET

STA 35+37, 18' LT

CB 8.4 TYPE 1L

STA 20+38, 17.2' RT

SSMH 5.1 TYPE 1-48

STA 20+72, 5.2' LT

CB 8.3 TYPE 1L

STA 22+80, 17.4' RT

CB 10.1 INLET

STA 22+79, 17.5' LT

CB 8.2 TYPE 1L

STA 23+76, 17.6' LT

SSMH 1.4 TYPE 1-48

STA 23+82, 0.0' RT

CB 9.1 INLET

STA 25+06.15, 18.0' RT

CB 8.1 TYPE 2

STA 25+21.00, 17.4' LT

11.25' BEND W/THRUST BLOCK

LINCOLN STA 35+43.2, 20' LT

8" TEE W/THRUST BLOCK

G.V. TO SOUTH

LINCOLN STA 20+81, 20' LT

45' BEND W/THRUST BLOCK

STA 23+32.4, 20' LT

45' BEND W/THRUST BLOCK

STA 25+73.7, 20' RT

8" TEE W/THRUST BLOCK

G.V. TO SOUTH AND EAST

LINCOLN STA 68+98.72, 19.7'

LANCASTER STA 80+19.71, 21'

SD 8.5 214 L.F. @ 2.6% 12" PVC

SS 5.2 399 L.F. @ 2.6% 8" PVC

SD 8.4 236 L.F. @ 3.5% 15" PVC

SS 5.1 309 L.F. @ 4.9% 8" PVC

SD 10.1 35 L.F. @ 1.1% 8" PVC

SD 8.3 101 L.F. @ 9.5% 15" PVC

SS 2.1 283 L.F. 8" PVC

SD 8.2 139 L.F. 15" PVC

SD 9.1 38 L.F. 8" PVC

SD 8.1 117 L.F. 18" PVC

DATUM ELEV 440.00

476.1

474.13

472.76

471.9

471.43

470.3

470.08

469.5

468.70

468.3

467.34

466.5

465.56

458.1

458.32

456.6

454.16

452.9

451.42

450.8

450.46

449.80

449.95

449.65

449.50

448.60

448.50

448.48

448.1

PVI STA = 22+40

PVI ELEV = 467.65

A.D. = -5.78

K = 17.29


PVI STA = 24+35

PVI ELEV = 451.11

A.D. = 7.48

K = 13.37


0249.005 2:10:00 PL

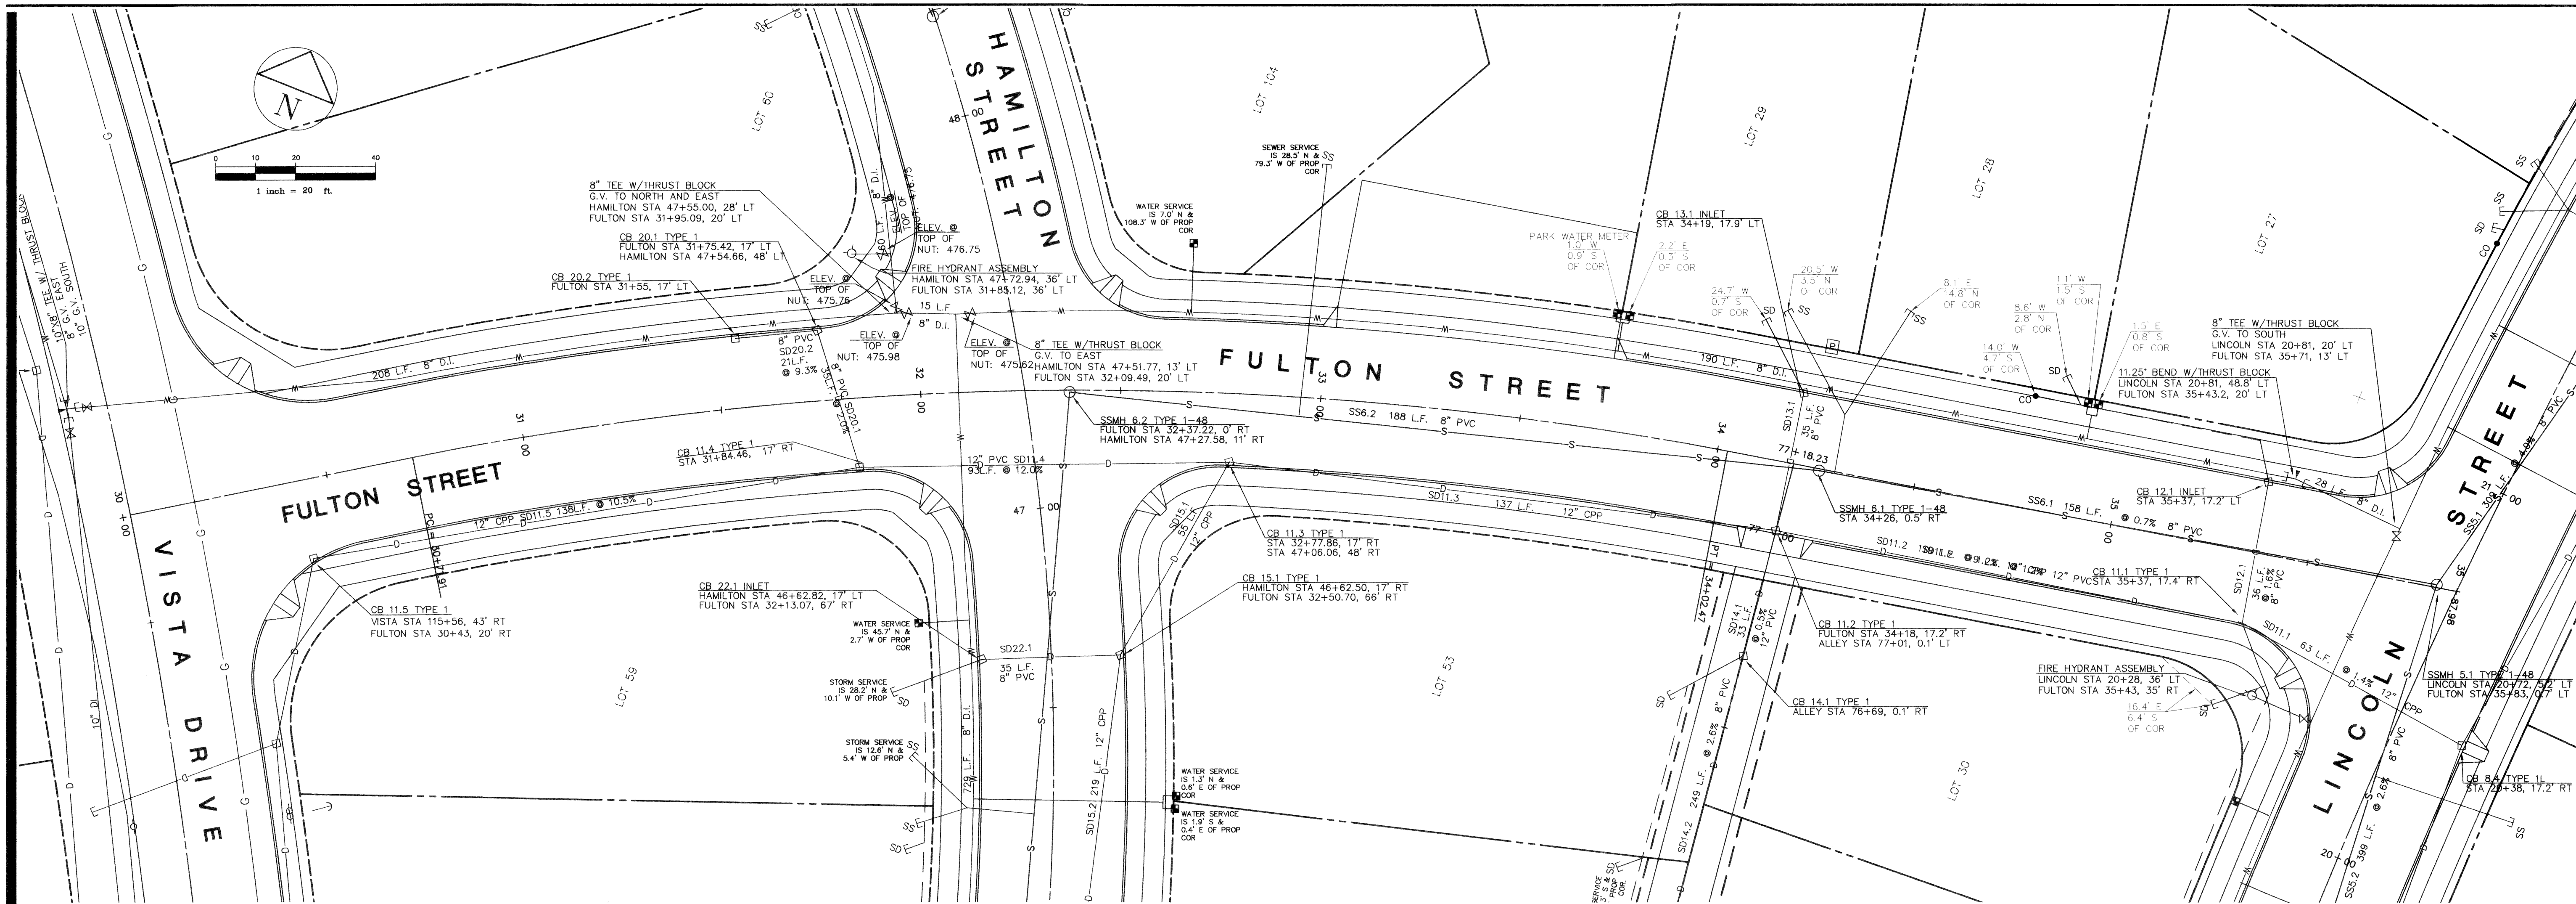

APPROVED

OCT 14 2002

BY *David Evans*
CITY OF FERDALE

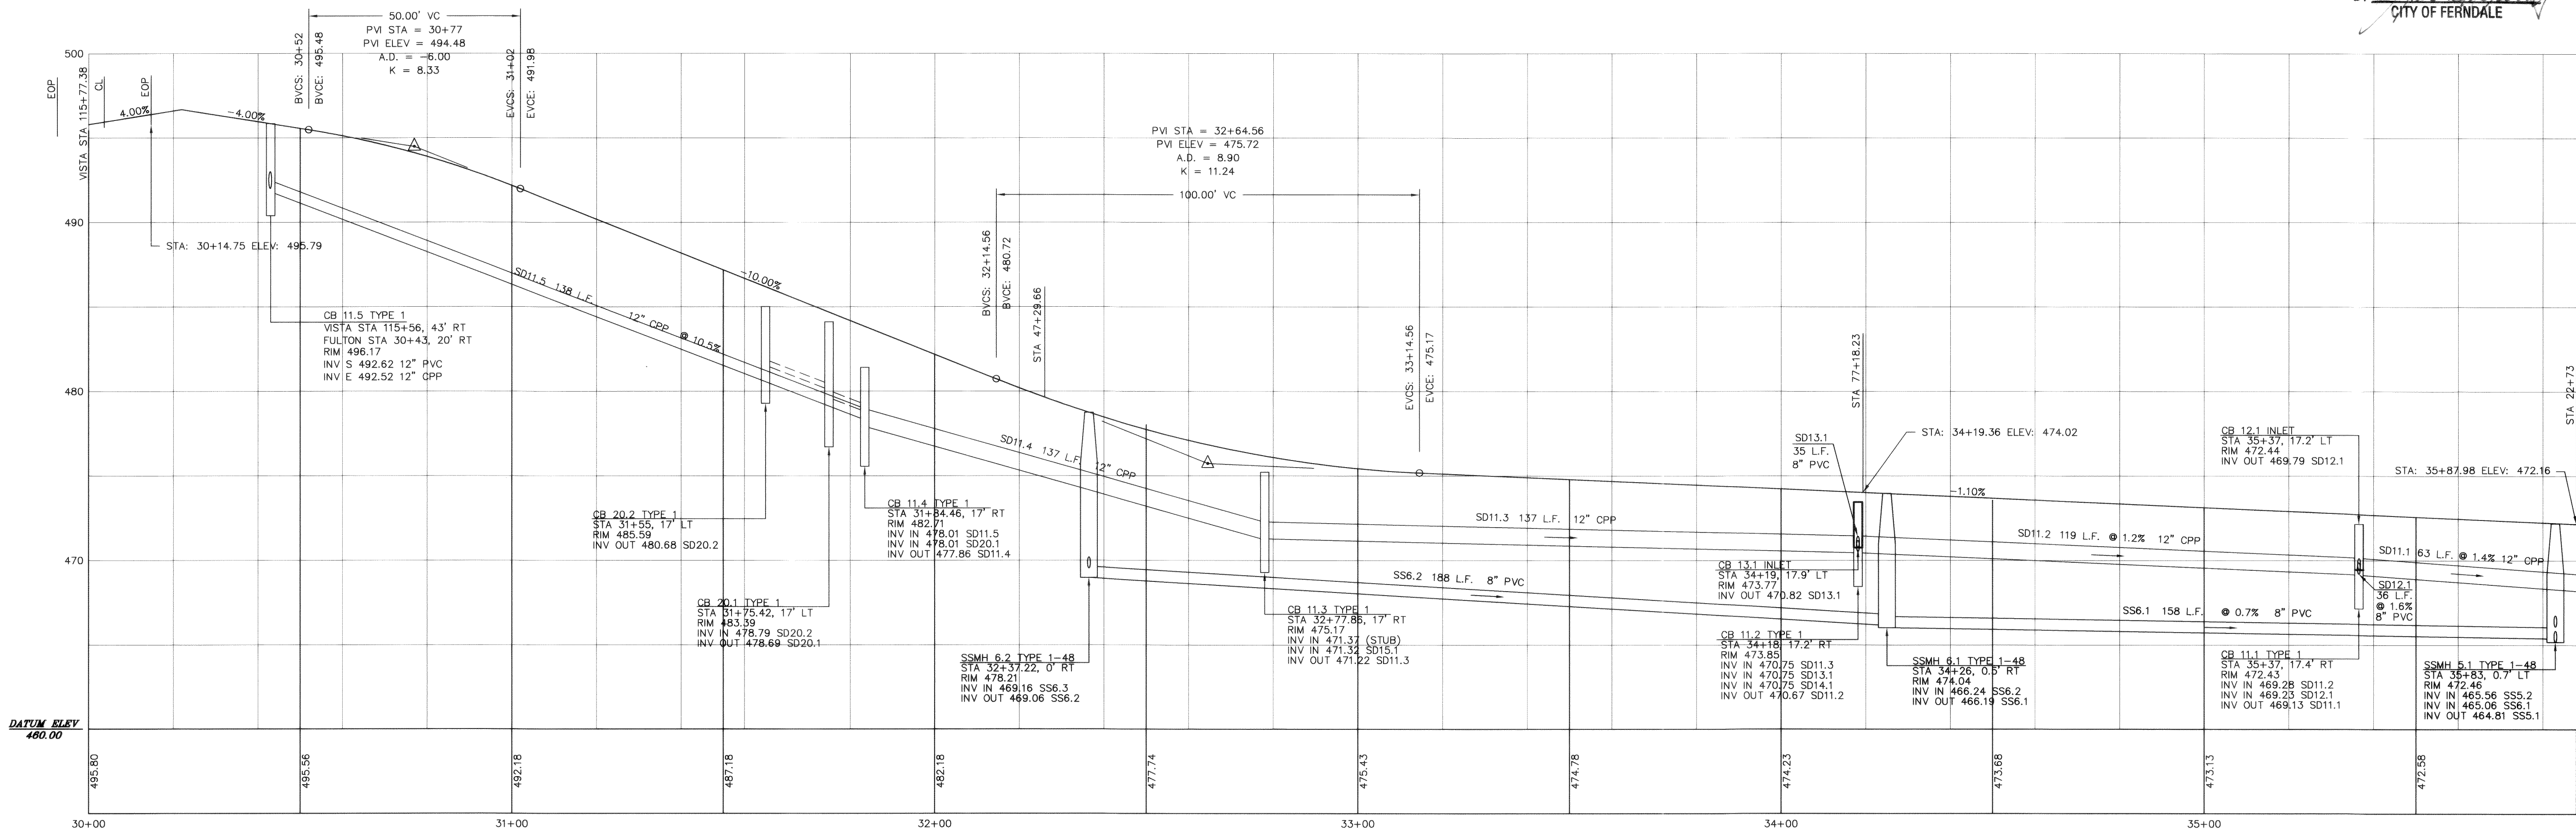

AS-BUILT DRAWING - 09/26/02

REVISIONS

PER CITY ON 6/19/02

SHEETS

DESIGN CRP

DRAWN: DWMA

DATE: 9/26/02

FILE: HMMW0017/HM17R03A.DWG

ORDER: CAP

6


21

OF

SALE: H: 1"=20' V: 1"=5'



REVISIONS

VISTA RIDGE
FULTON STREET PLAN / PROFILE
STA: 30+00 - 35+79
00249.000 2-16-00 RL

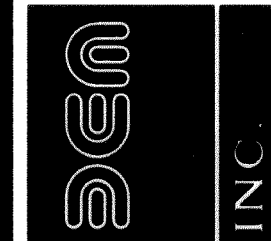

DAVID EVANS
AND ASSOCIATES, INC.
119 GRAND AVENUE, SUITE D
BELLINGHAM, WA 98225-4400 (360) 647-7151



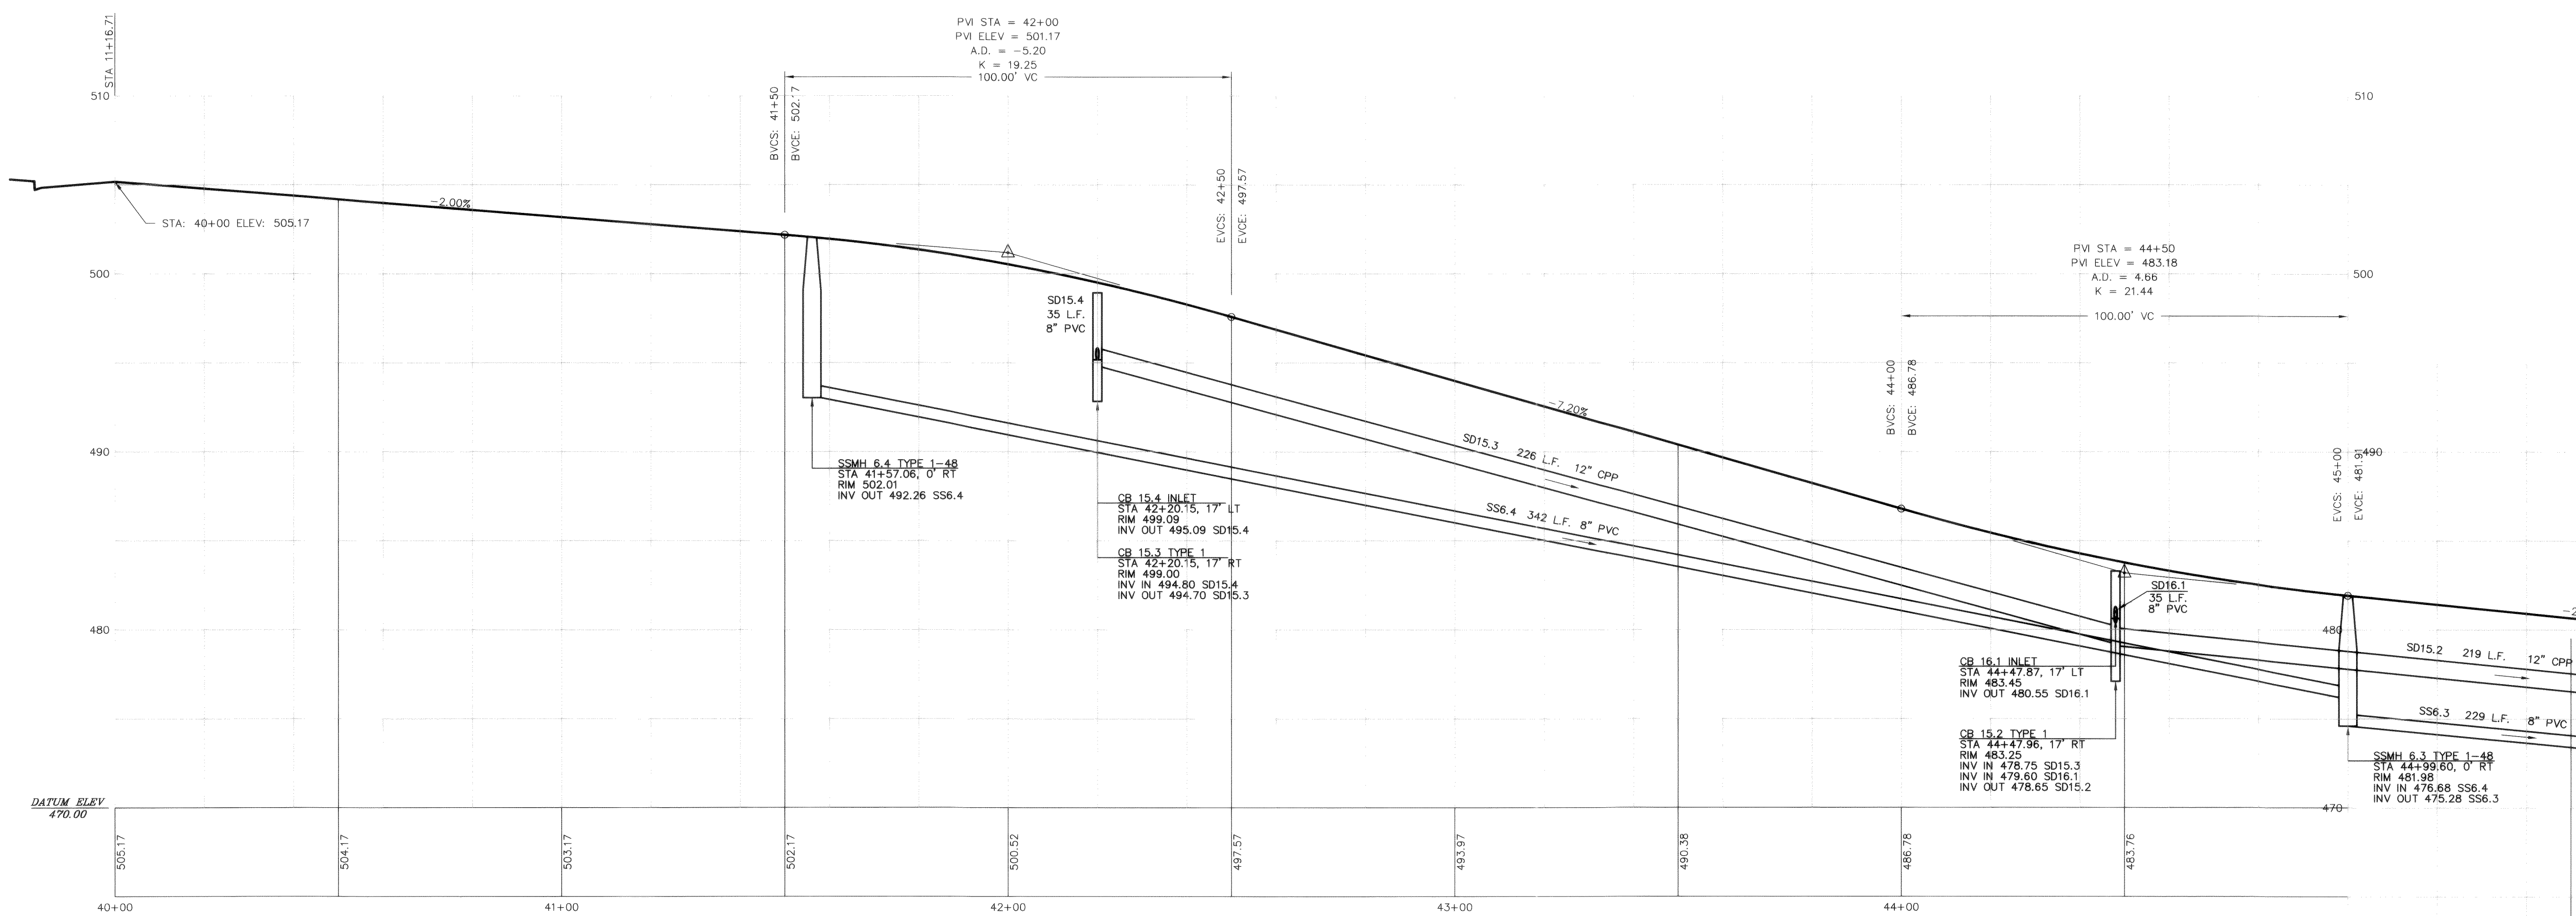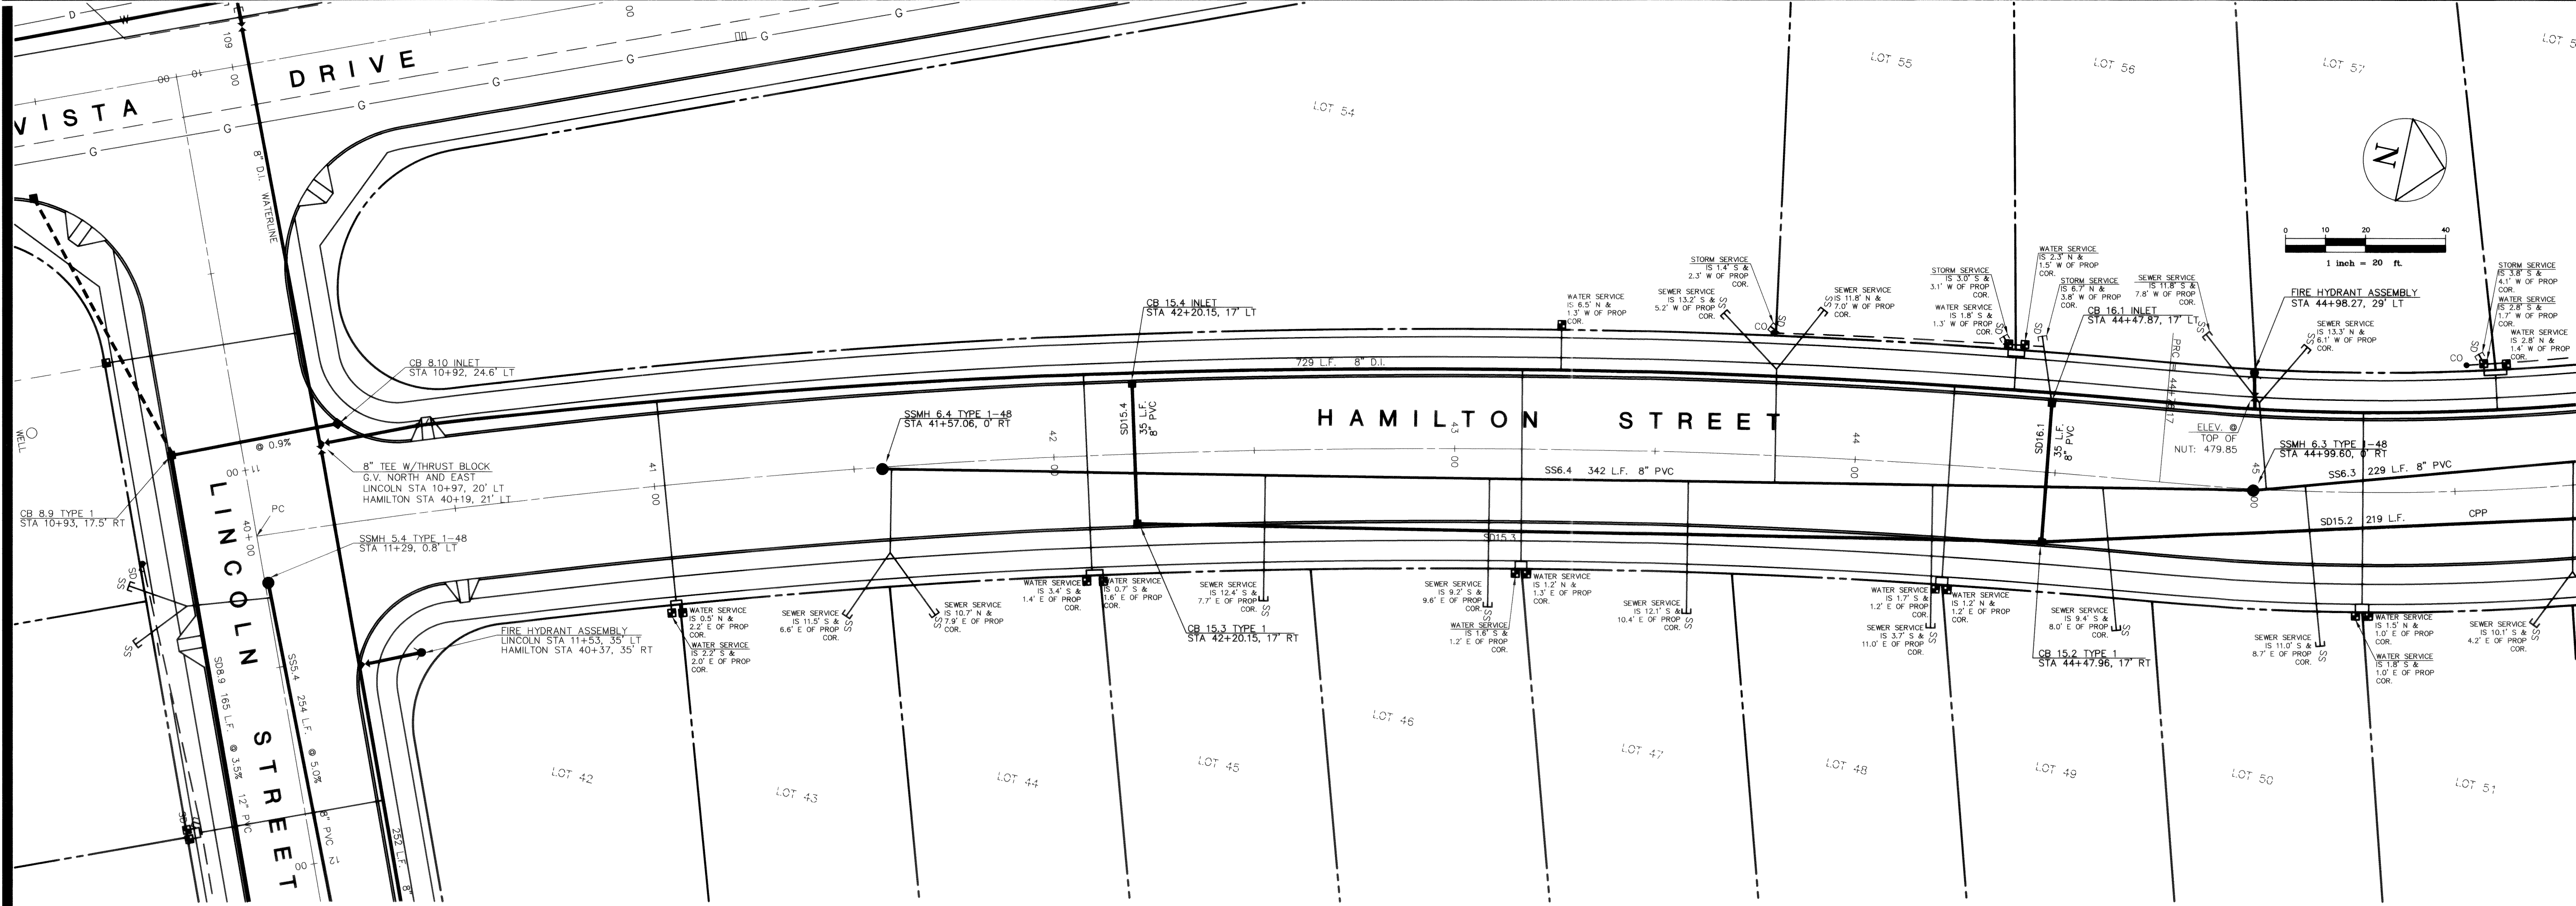

VISTA RIDGE
HAMILTON STREET PLAN / PROFILE
STA: 40+00 - 45+00
00249.007 2-16-00 KLE



dec
DAVID EVANS
AND ASSOCIATES,
INC.
119 GRAND AVENUE, SUITE D
BELLINGHAM, WA 98225-4400 (860) 647-7151


SEAL: CHAS. B. DAVENPORT
REGISTERED PROFESSIONAL ENGINEER
STATE OF WASHINGTON
EXPIRES 4-28-03

AS-BUILT DRAWING - 03/19/01

REVISIONS			


7	OF	21	SHEETS
SCALE:	H: 1"=20'	V: 1"=5'	DESIGN: CRP
DATE:	3/19/01		DRAWN: DWMA
FILE:	HNM0017/HM17R03A.DWG	CHECKED:	CRP

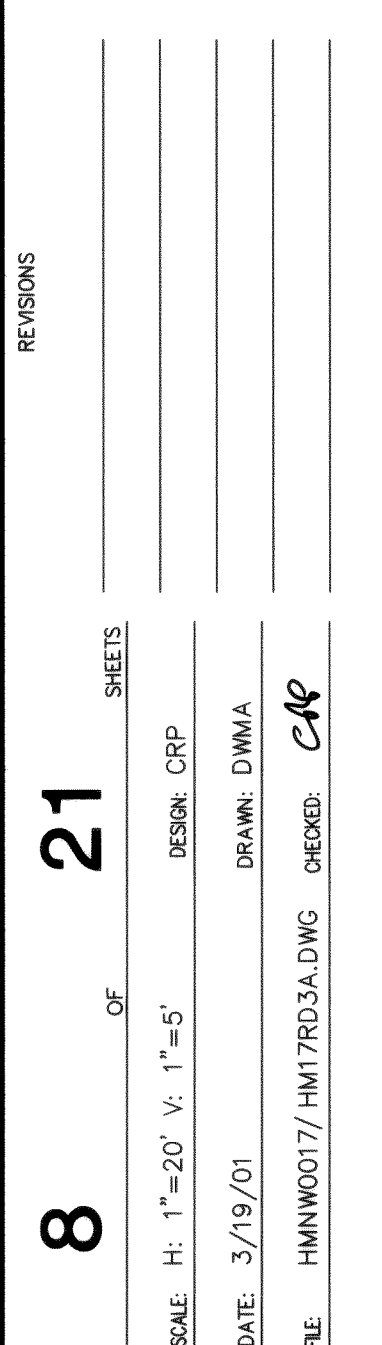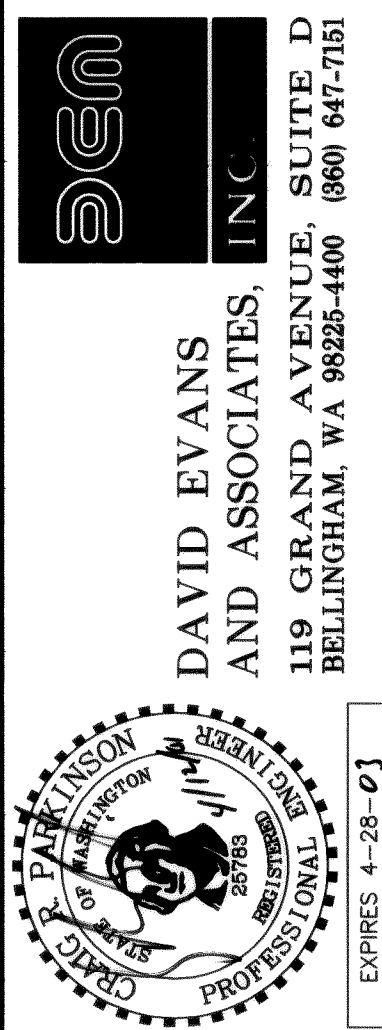

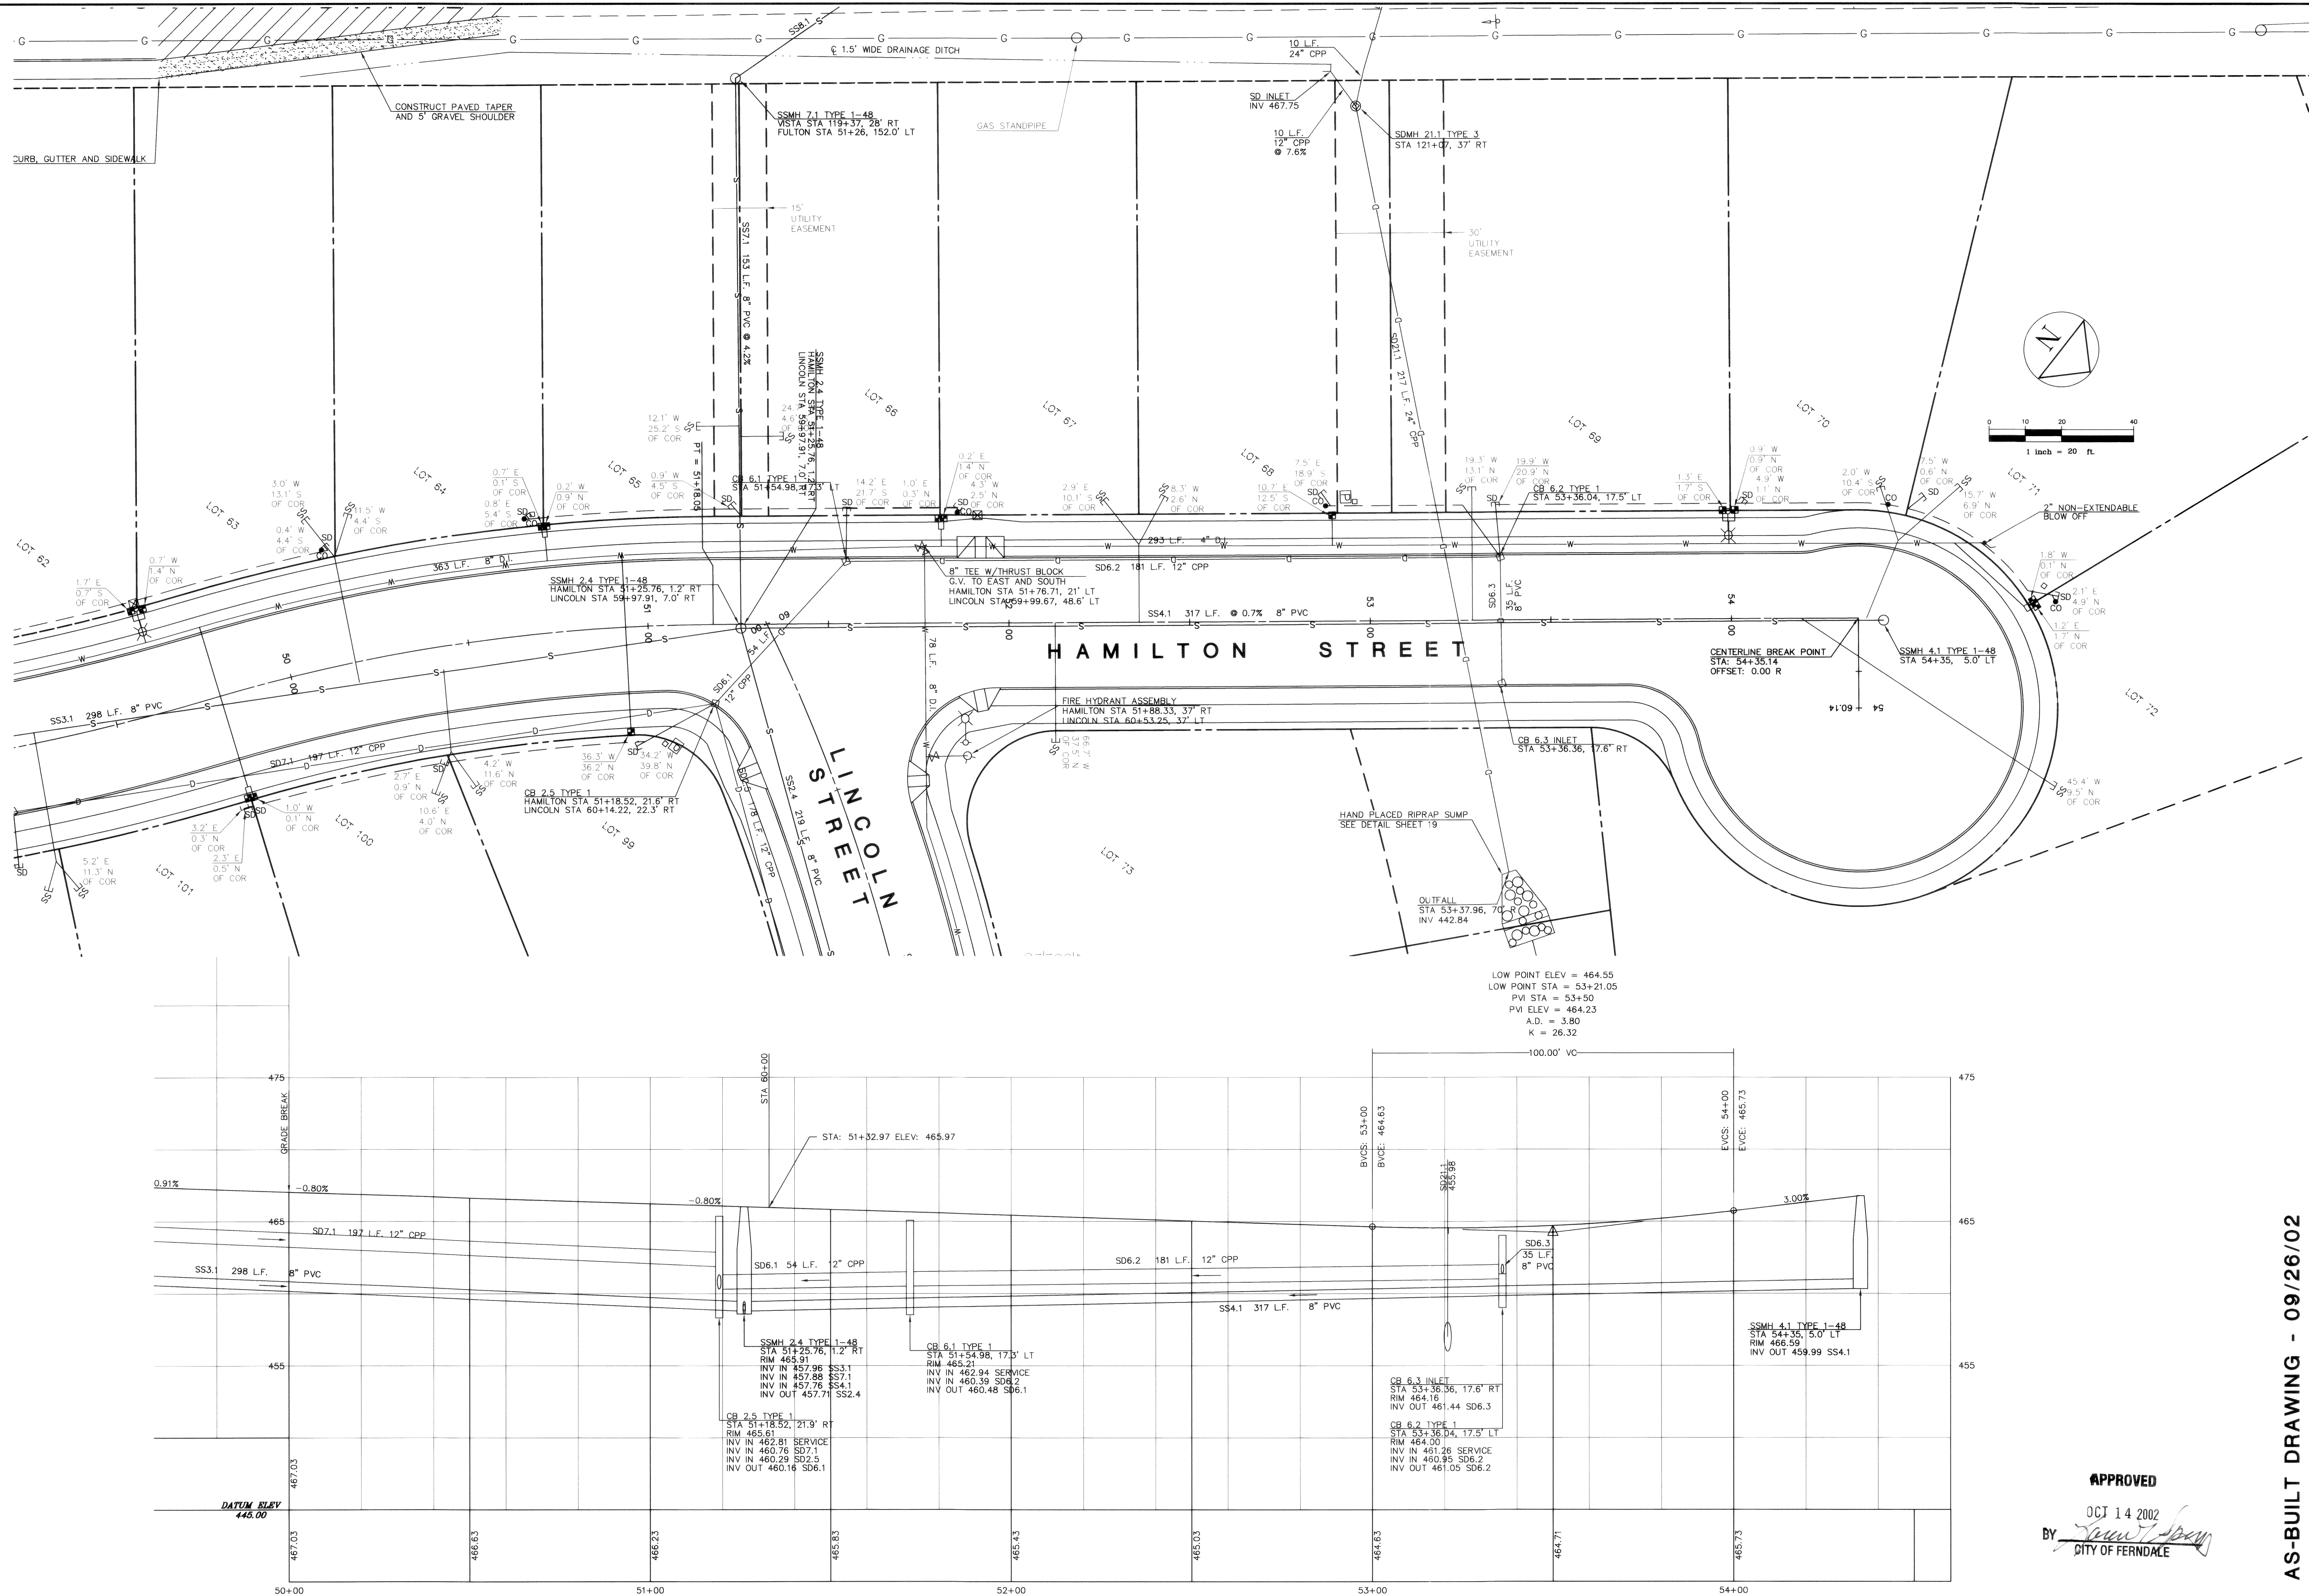

VISTA RIDGE
HAMILTON STREET PLAN / PROFILE
STA: 50+00 - 54+35

00249.009 2.16.06 KL

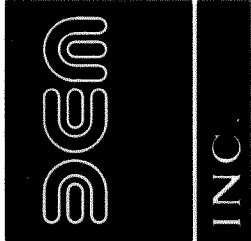

DAVID EVANS
AND ASSOCIATES, INC.
119 GRAND AVENUE, SUITE D
BELLINGHAM, WA 98225-4400 (360) 647-1101





REVISIONS			
PER CITY ON 6/19/02	SHEETS	OF	21
Revisions per city 9-25-02	DESIGN CRP	DATE	9/26/02
DATE	DRAWN: DWMA	CHECKED: CA	
FILE	HMW0017/HM17R03A.DWG	DESIGNED: CA	

AS-BUILT DRAWING - 09/26/02

APPROVED
OCT 14 2002
BY [Signature]
CITY OF FERDALE

P:\P\HNMW017\DWG\AS-BUILT\5-HM17703a.dwg Wed Apr 11 07:42:06 2001 DAVID EVANS AND ASSOCIATES, INC. -TSR

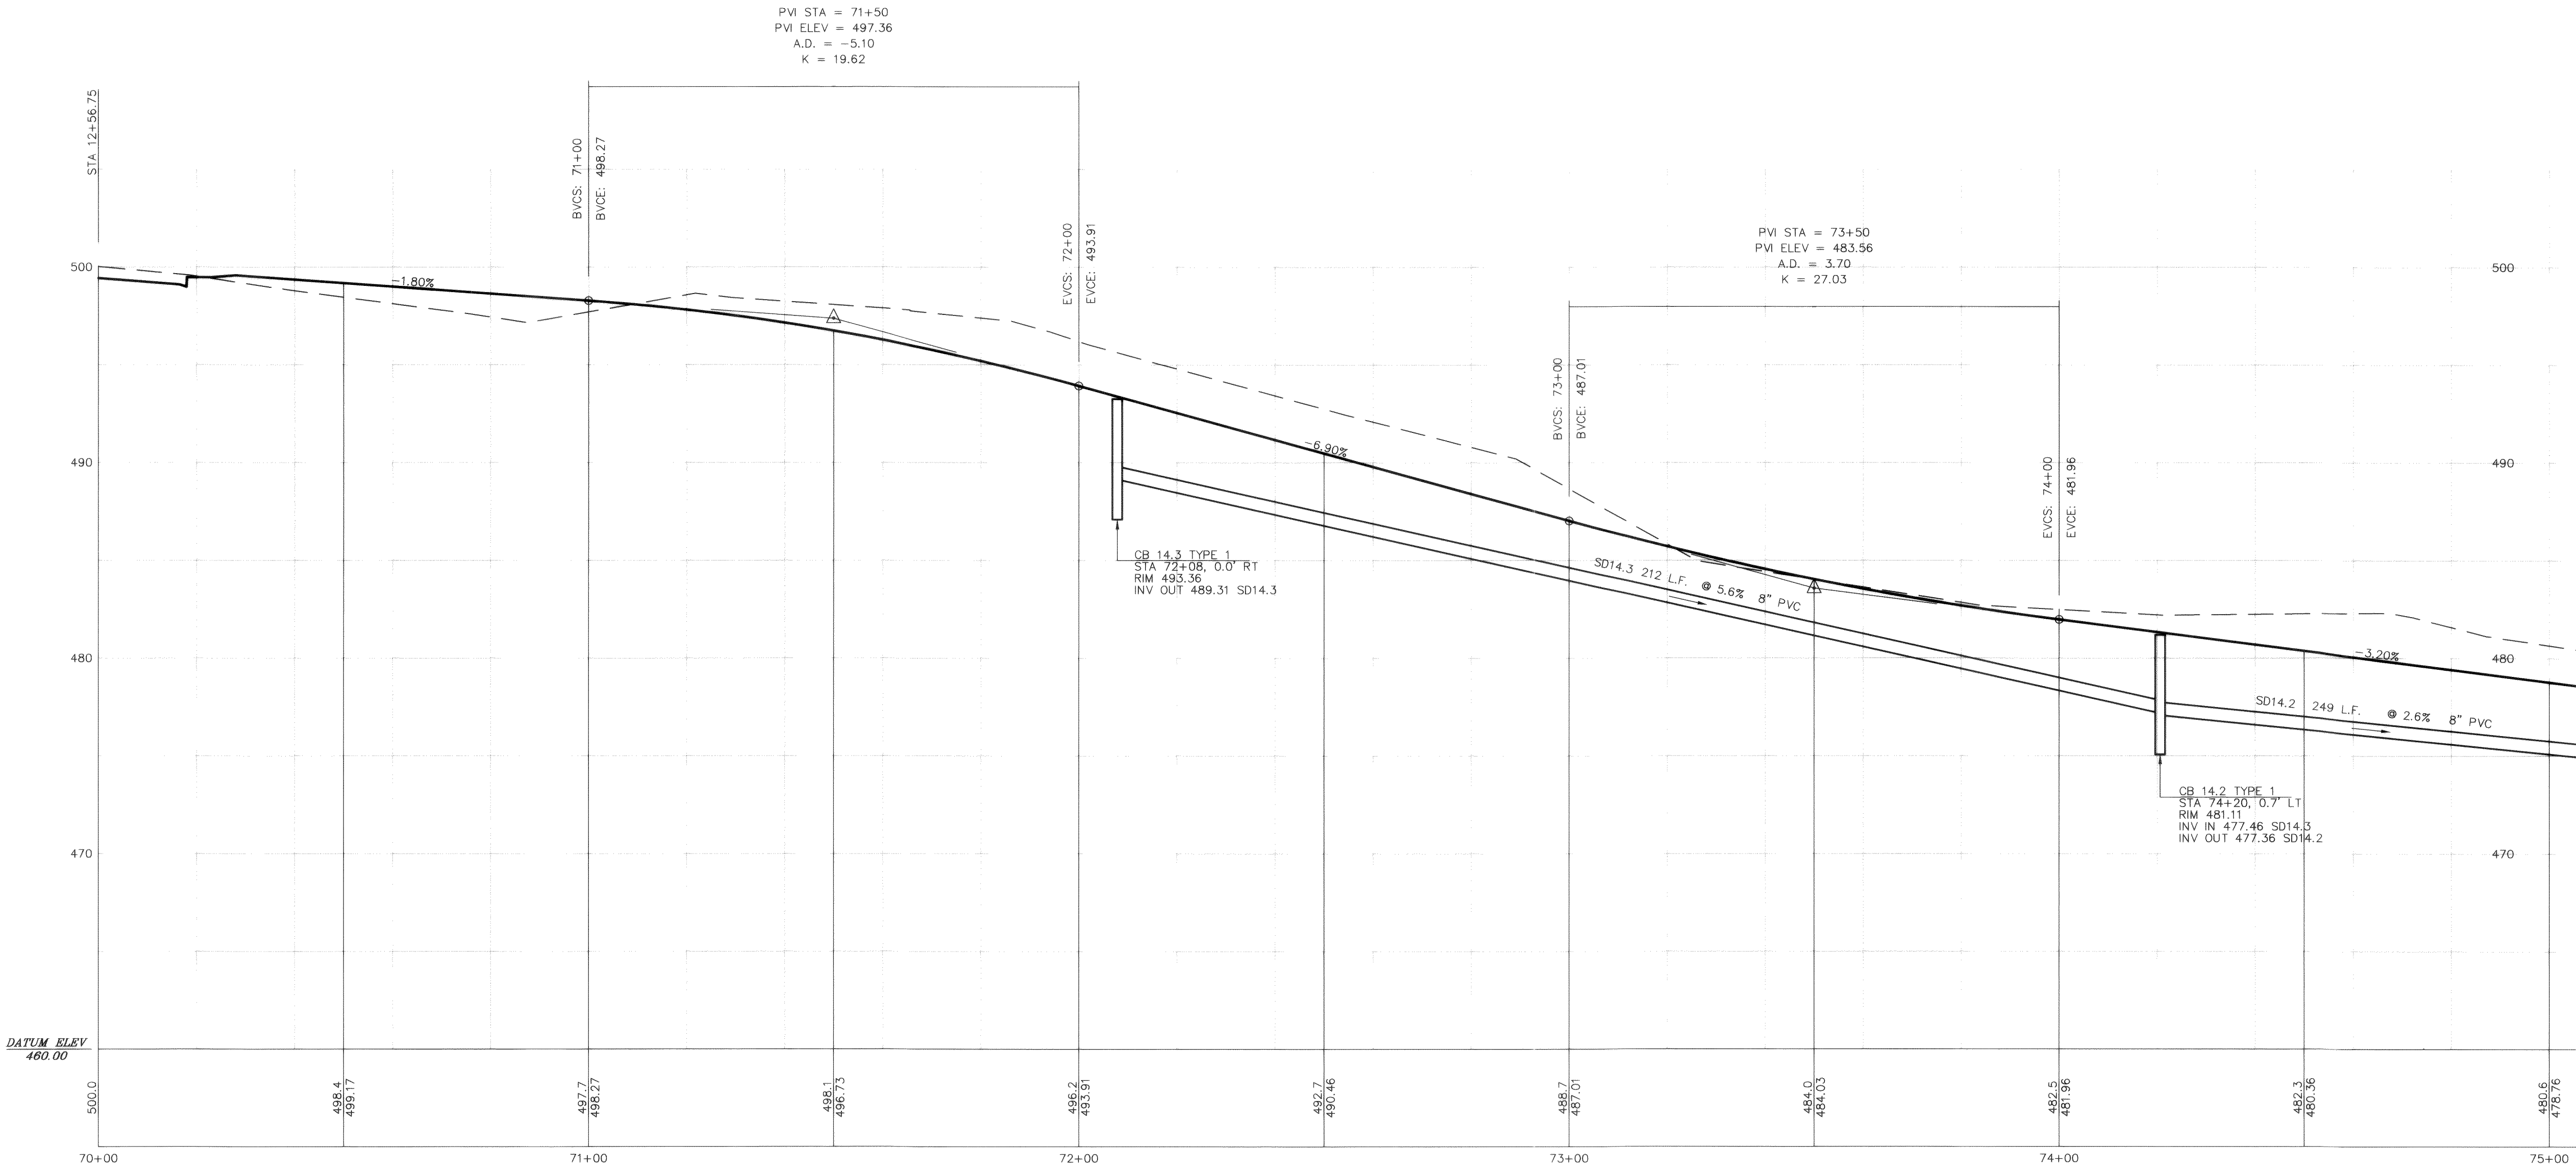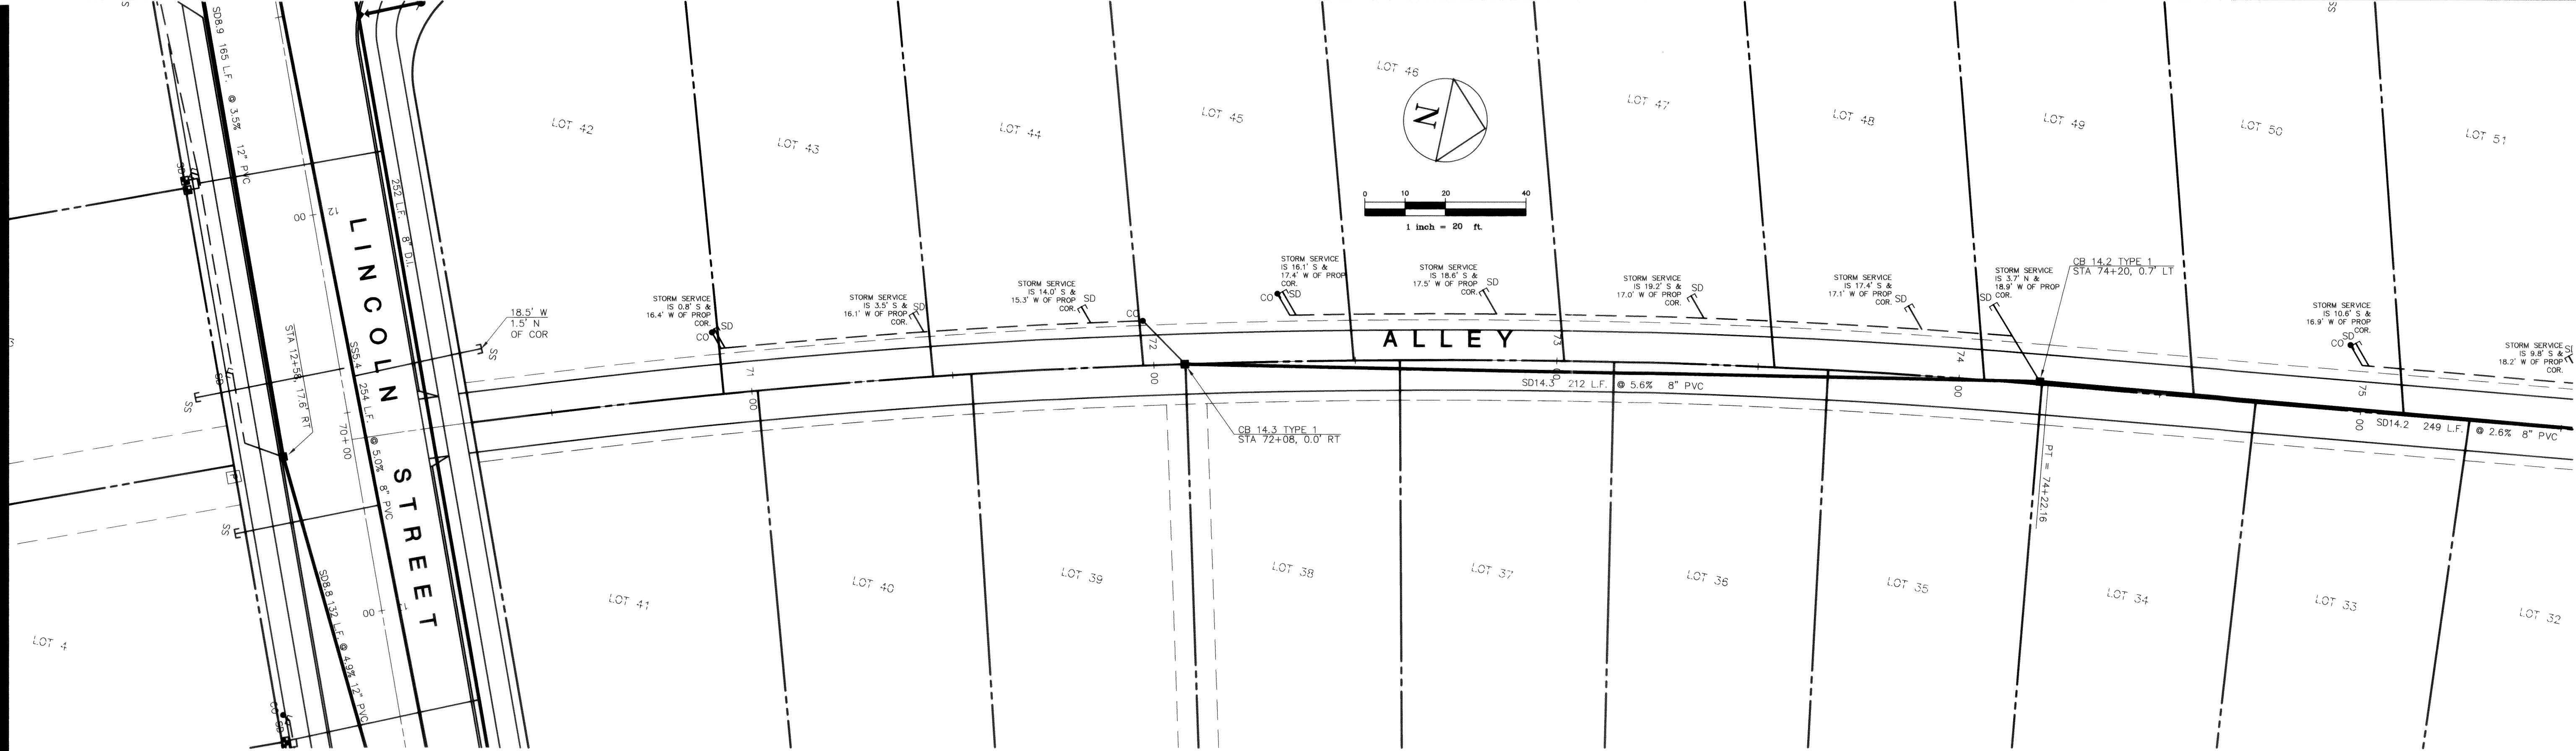


AS-BUILT DRAWING - 03/19/01

12 OF 21 SHEETS

SCALE: H: 1"=20' V: 1"=5'
DATE: 3/19/01
RE: HNMW017/HM17703A.DWG
DESIGN: CRP
DRAWN: DWMA
CHECKED: *cl*








DAVID EVANS
AND ASSOCIATES, INC.
119 GRAND AVENUE, SUITE D
BELLINGHAM, WA 98225-4400 (800) 647-7151

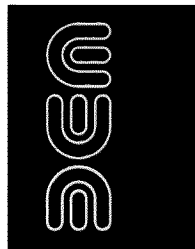

VISTA RIDGE
ALLEY PLAN / PROFILE
STA: 70+00 - 75+00


00249.012 2:10:00 *cl*

P:\PI\HMM0017\DWG\AS-BUILT\TS\H17n03a.dwg Wed Apr 11 07:42:39 2001 DAVID EVANS AND ASSOCIATES, INC. -TSR

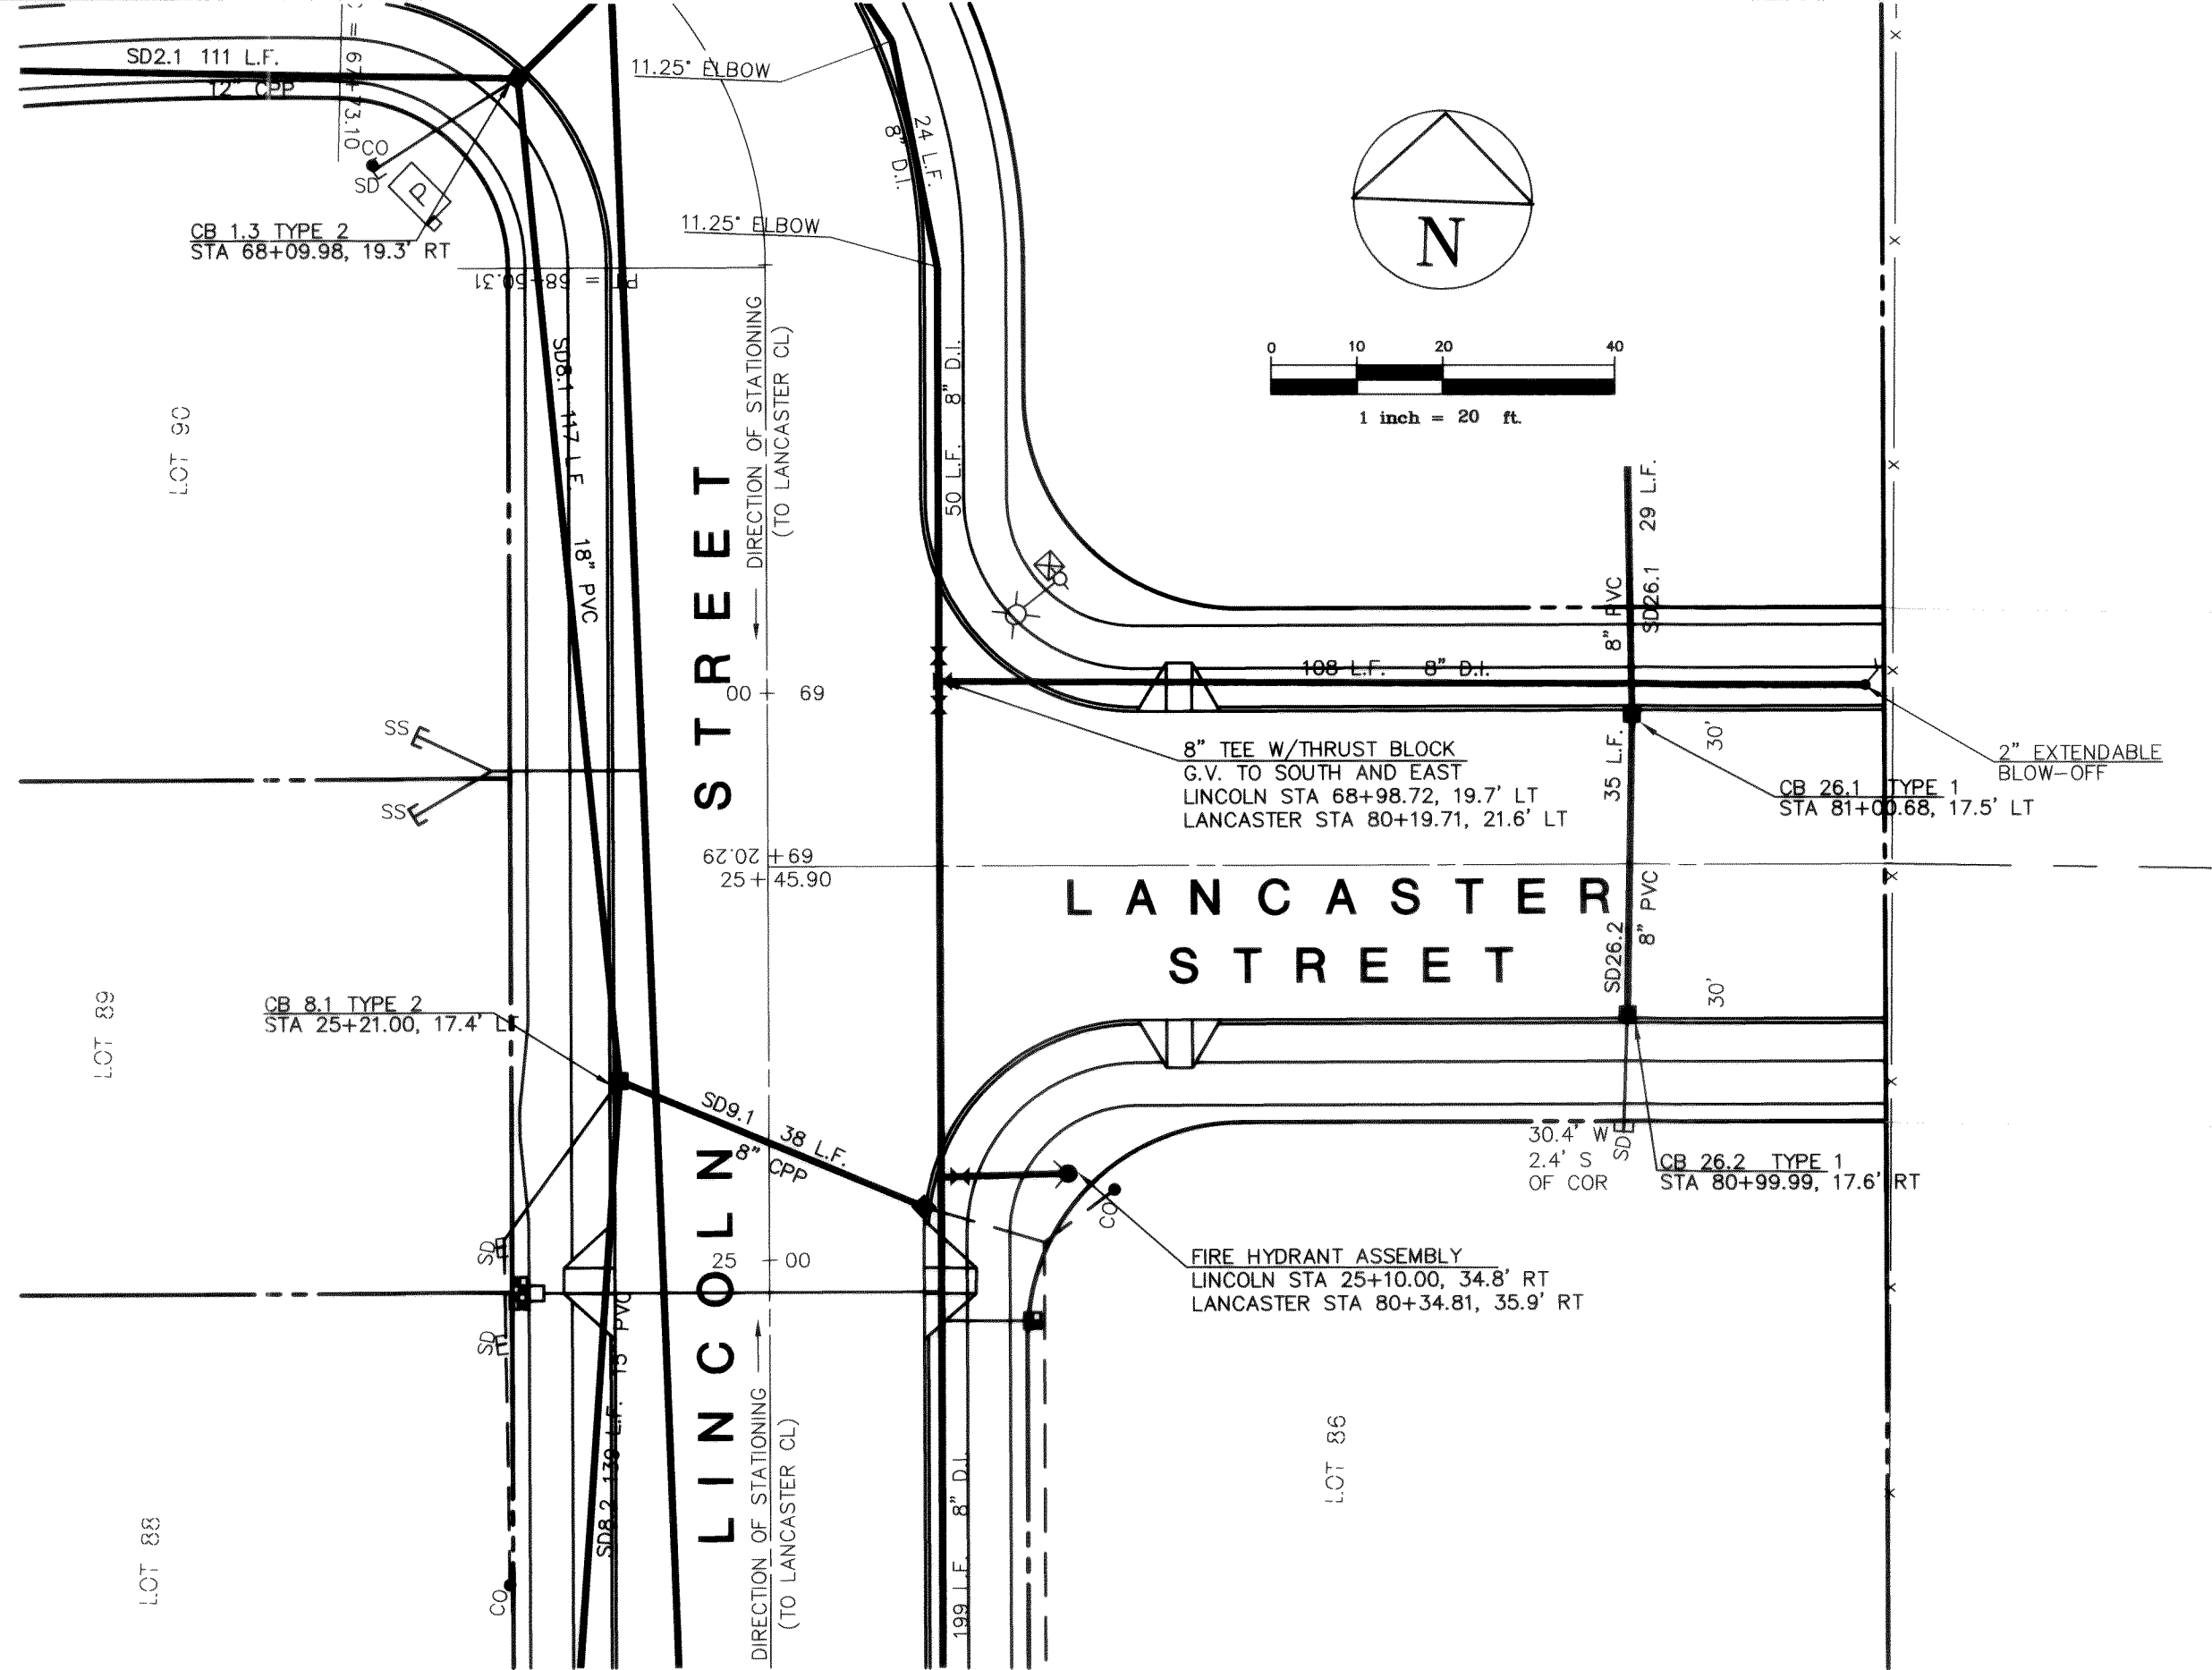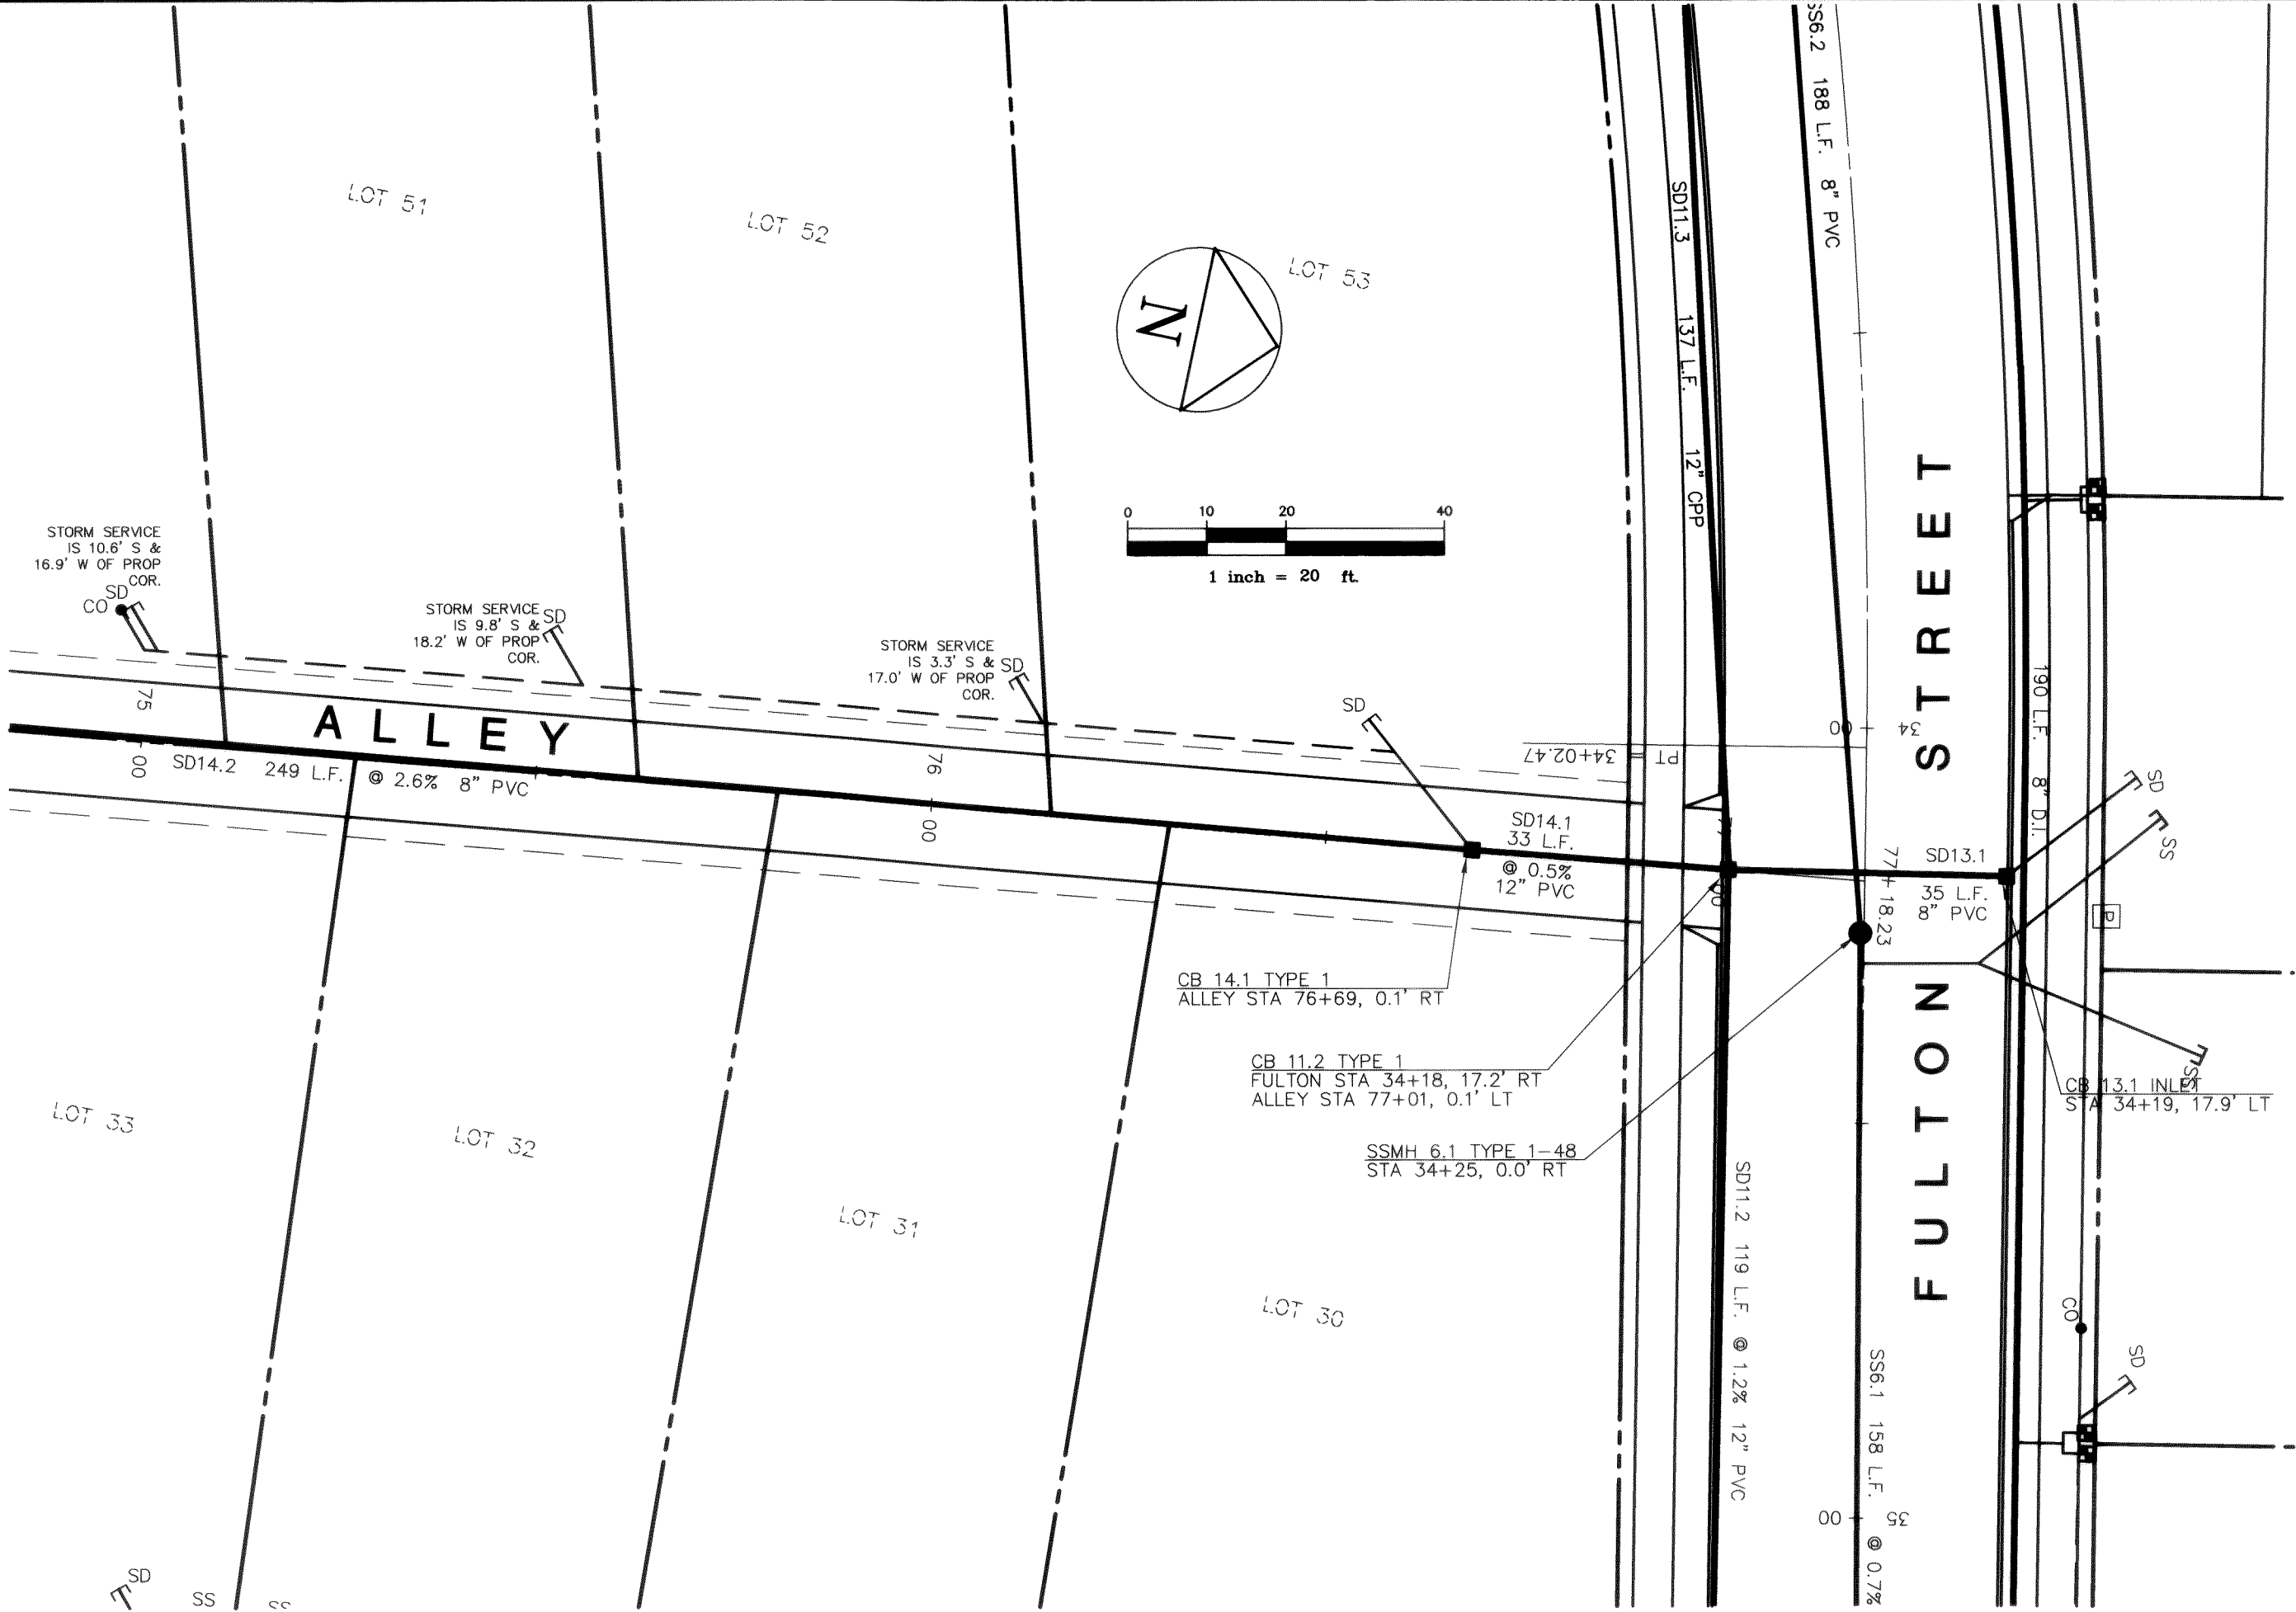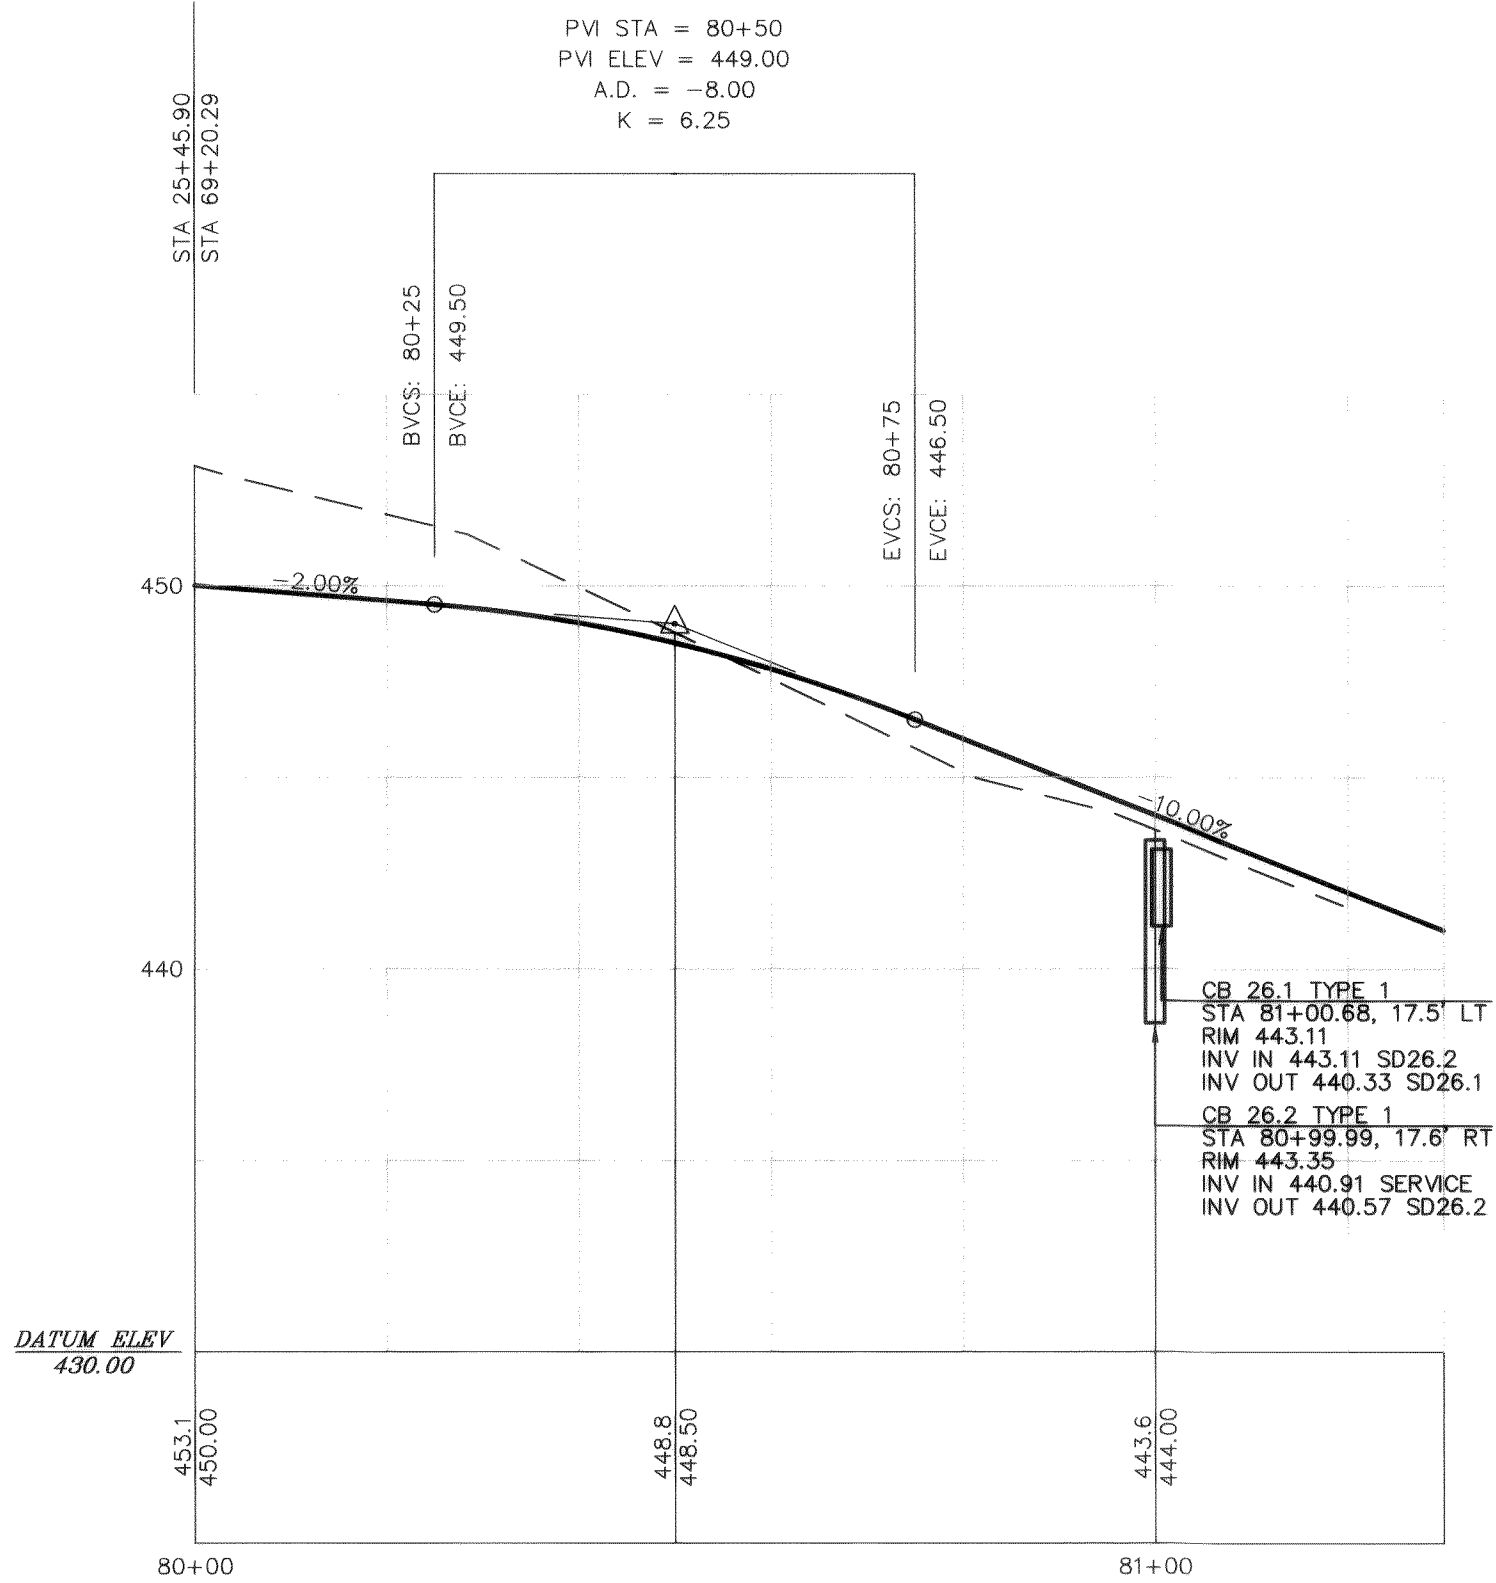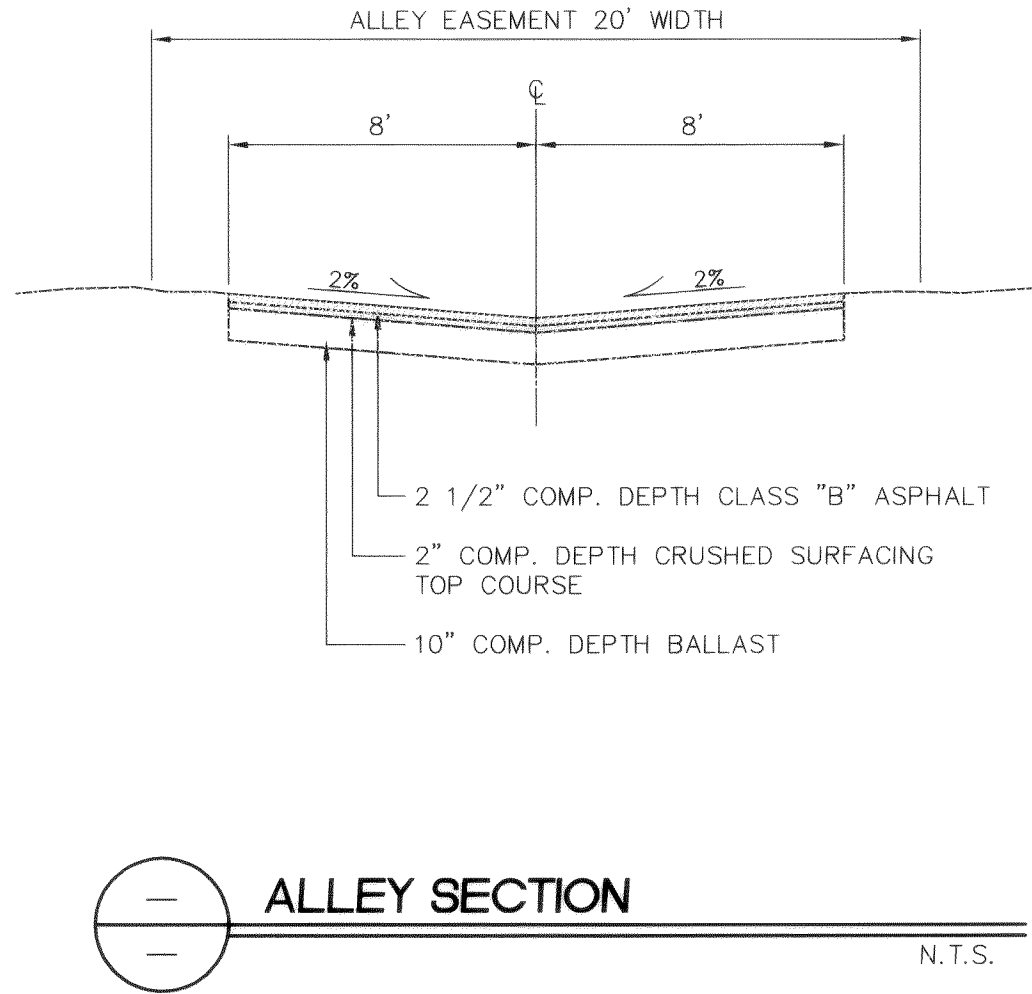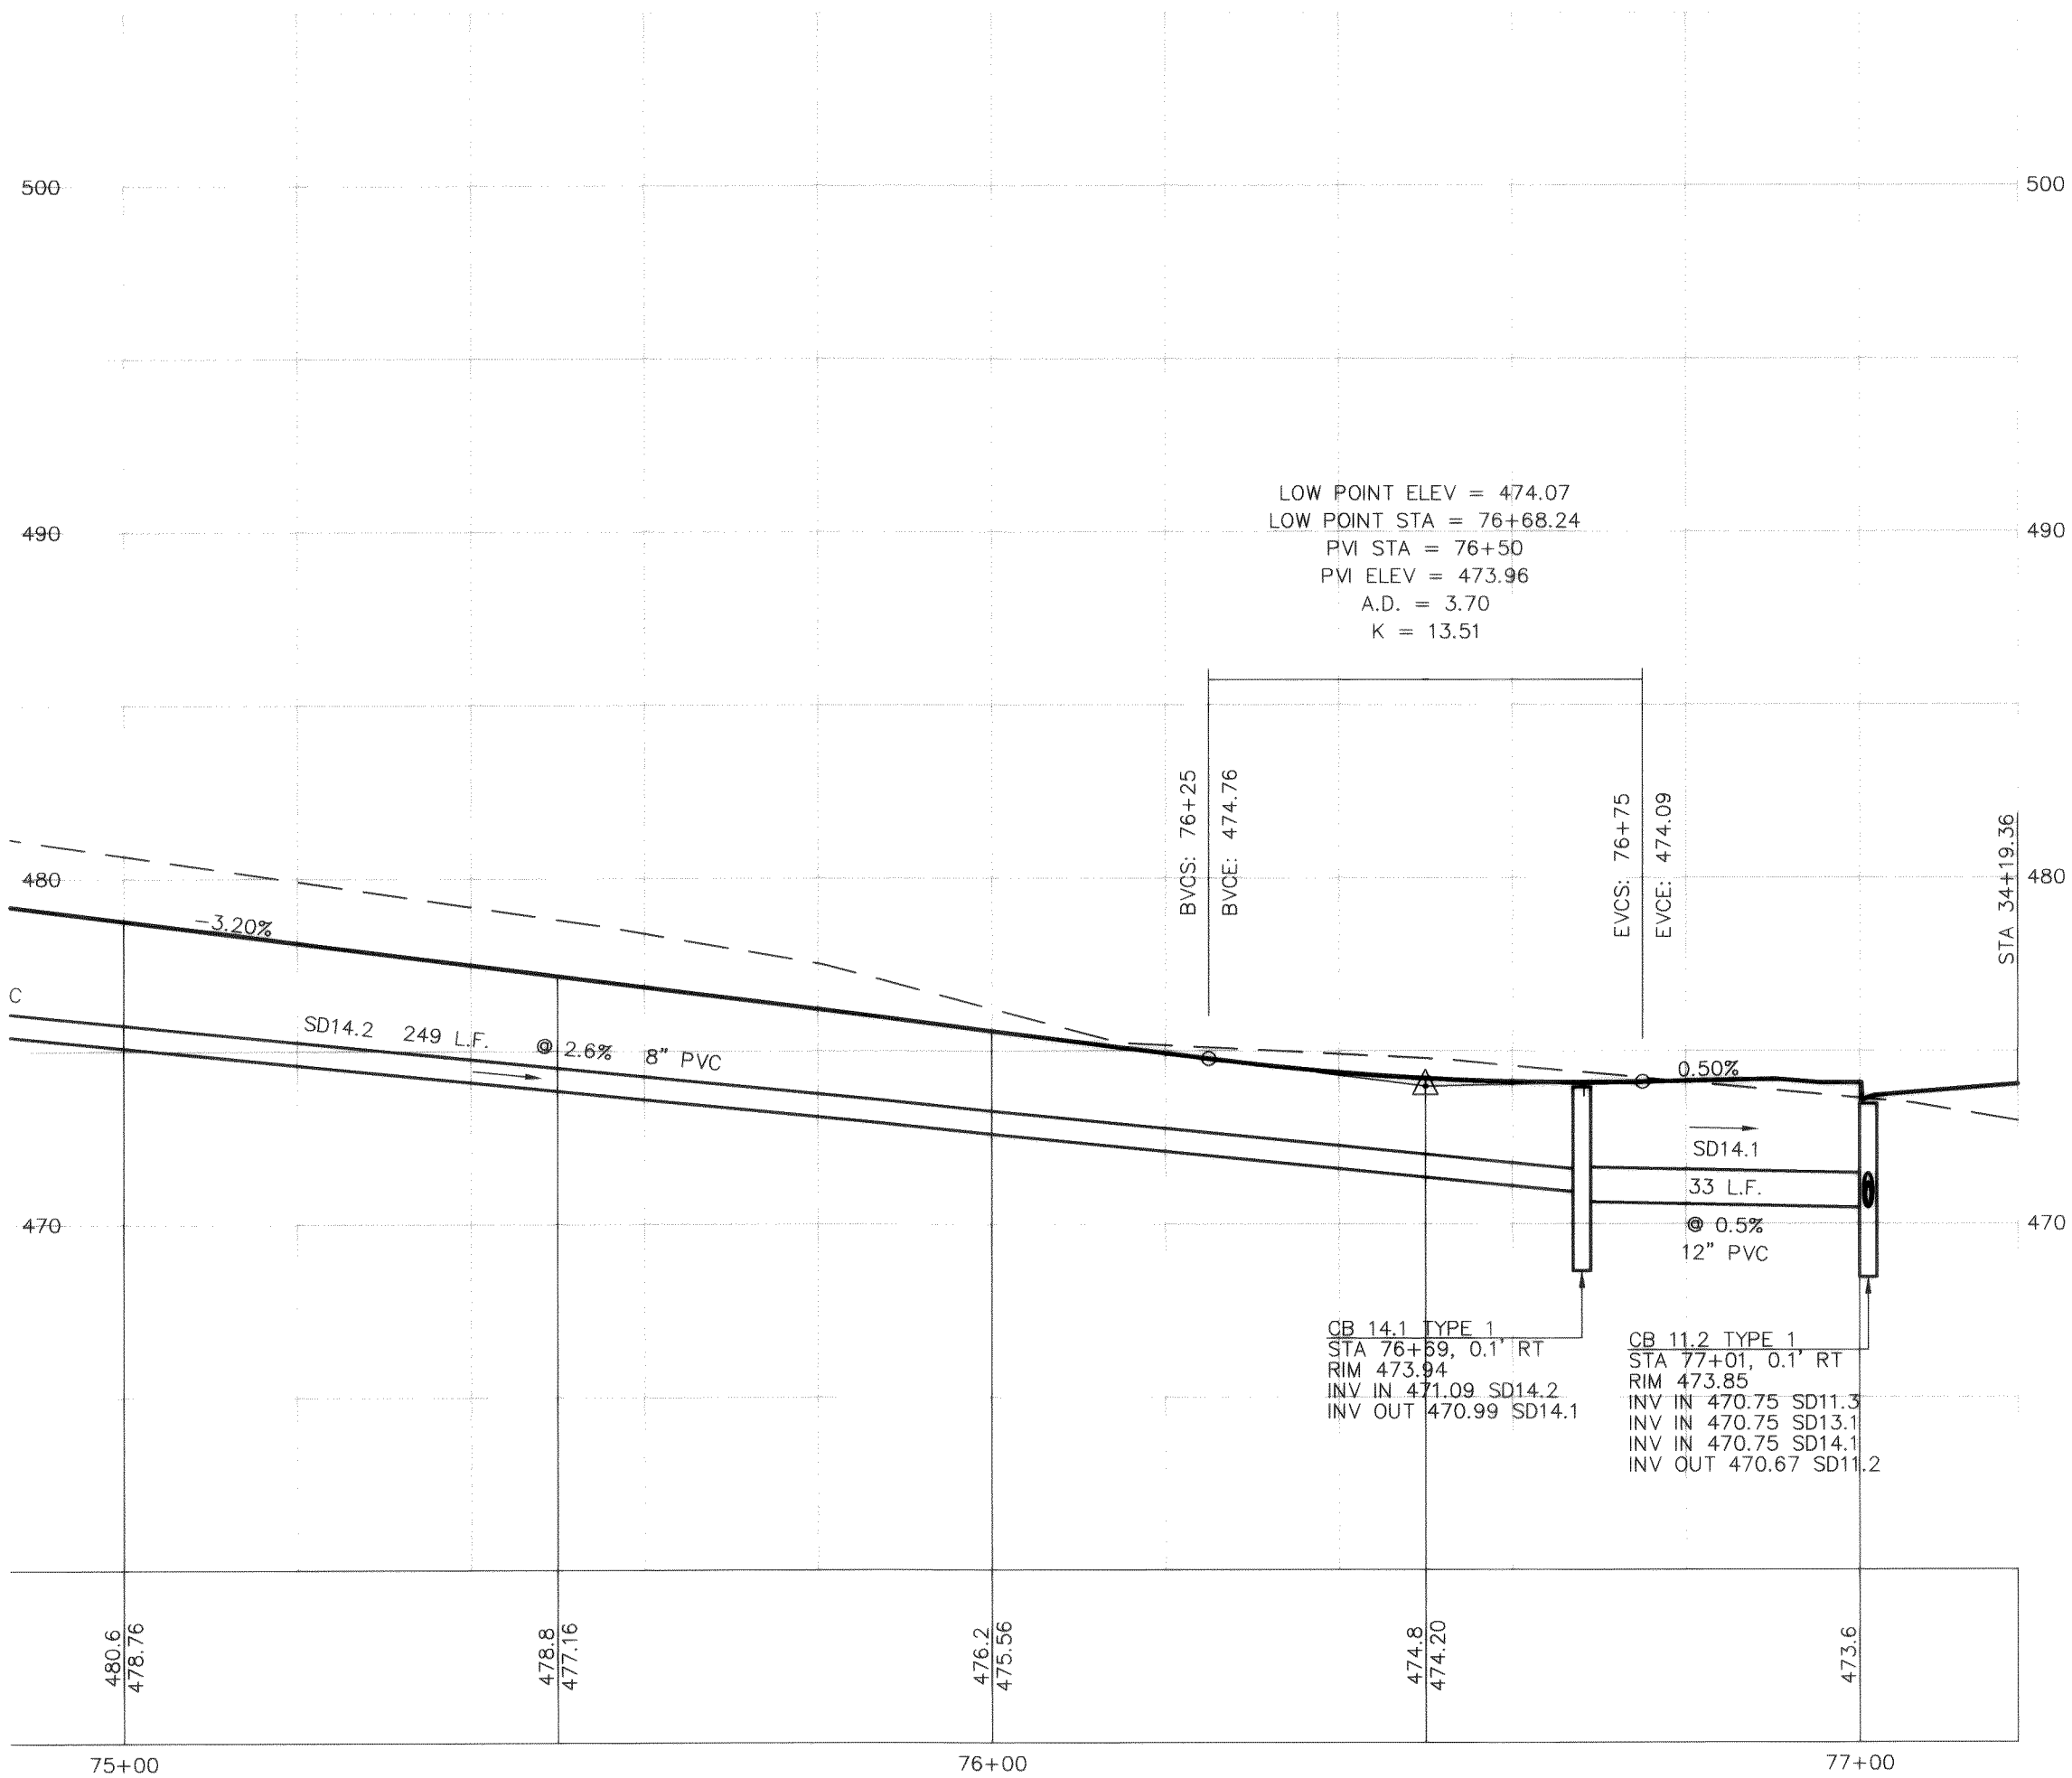


AS-BUILT DRAWING - 03/19/01

13	OF	21	SHEETS
SCALE: H: 1"=20' V: 1"=5'	DESIGN: CRP		
DATE: 3/19/01	DRAWN: DWA		
FILE: HMM0017/HM17RD3A.DWG	CHECKED: CA		


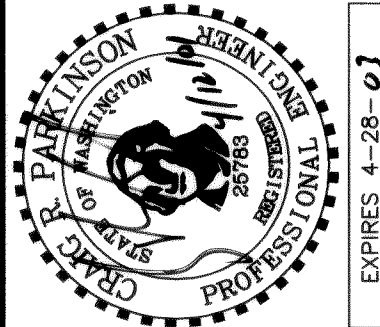


DAVID EVANS
AND ASSOCIATES, INC.
119 GRAND AVENUE, SUITE D
BELLINGHAM, WA 98225-4400 (800) 647-1151

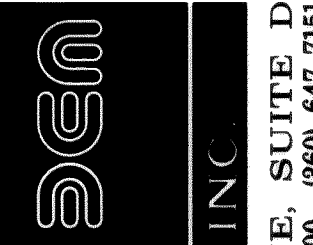


VISTA RIDGE
ALLEY & LANCASTER ST. PLAN / PROFILE
STA: 75+00-76+98 & 80+00-81+30

00249.013 2-16-00 KR

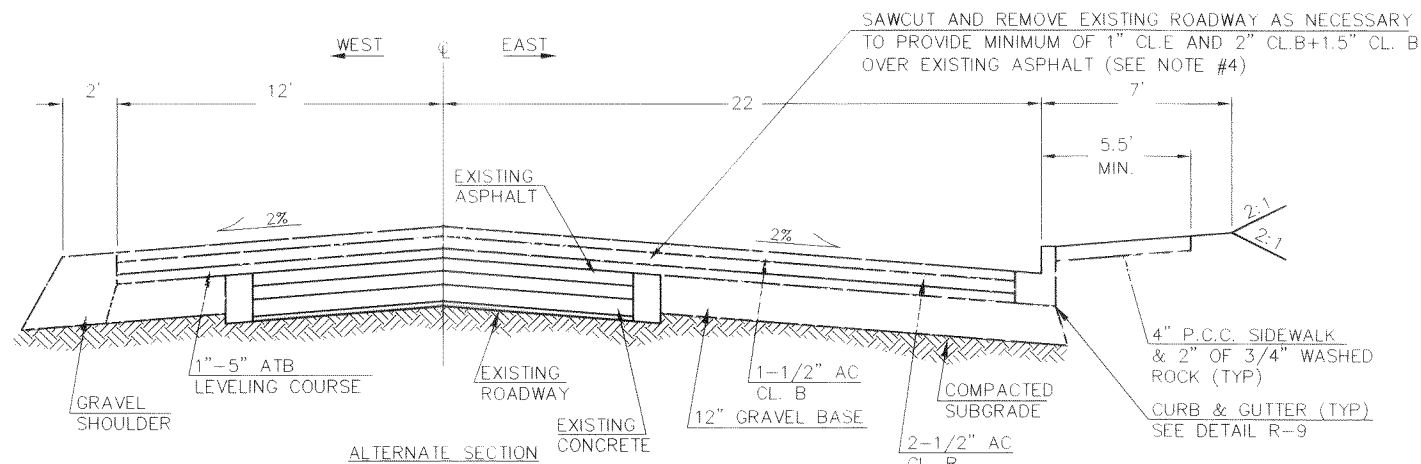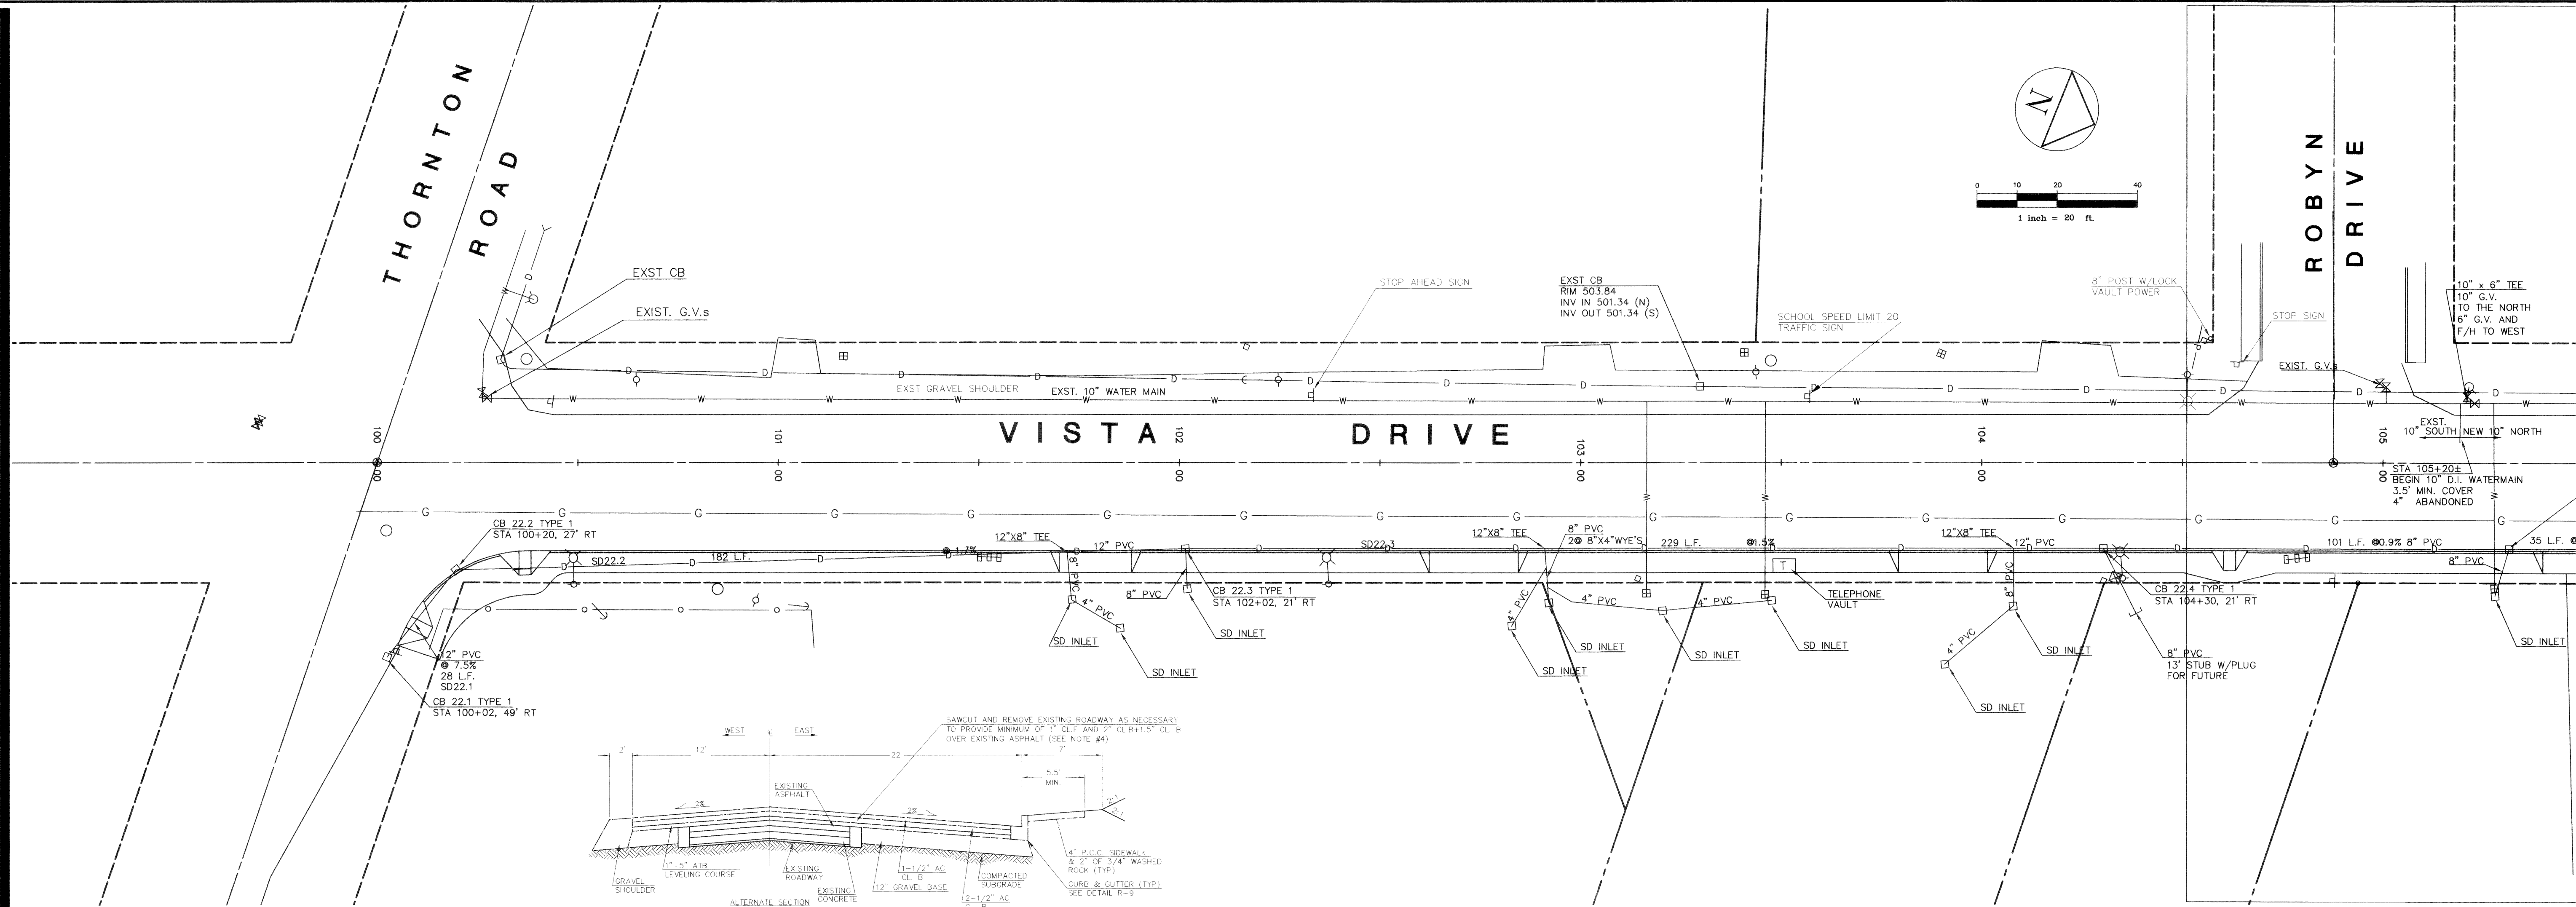

- NOTES:
1. AMORAVE 4599 AS MANUFACTURED BY AMOCO FABRICS & FIBER CO. (404-884-4444) OR ENGINEERING APPROVED EQUAL SHALL BE PLACED BETWEEN ASPHALT LIFTS IN ACCORDANCE WITH MANUFACTURER'S RECOMMENDATIONS.
 2. EXISTING CONCRETE ROADWAY TO BE LEFT IN PLACE WITH MINIMUM OF AC AND ATB LIFTS PLACED OVER EXISTING SURFACE.
 3. WIDENING TO BE PERFORMED OUTSIDE OF EXISTING ROADWAY SECTION.
 4. 3" OF EXISTING ASPHALT MAY BE USED IN LIEU OF 3" ATB.
 5. EXISTING CONCRETE PANEL ROADWAY AND SANDY GRAVEL MAYBE USED IN LIEU OF 10" GRAVEL BASE.
 6. 2" OF CLE OVER EXISTING ASPHALT IS NOT A LEVELING COURSE.
 7. 1" IS MINIMUM TO PROVIDE FULL SECTION WITH SUBSTITUTION AS NOTED WITH NOTE #5 AND #6.
 8. LESS THAN 1" OF CLASS E SECTION MUST BE REMOVED AND PROVIDE FULL ROAD SECTION.


APPROVED
OCT 14 2002
BY *[Signature]*
CITY OF FERDALE

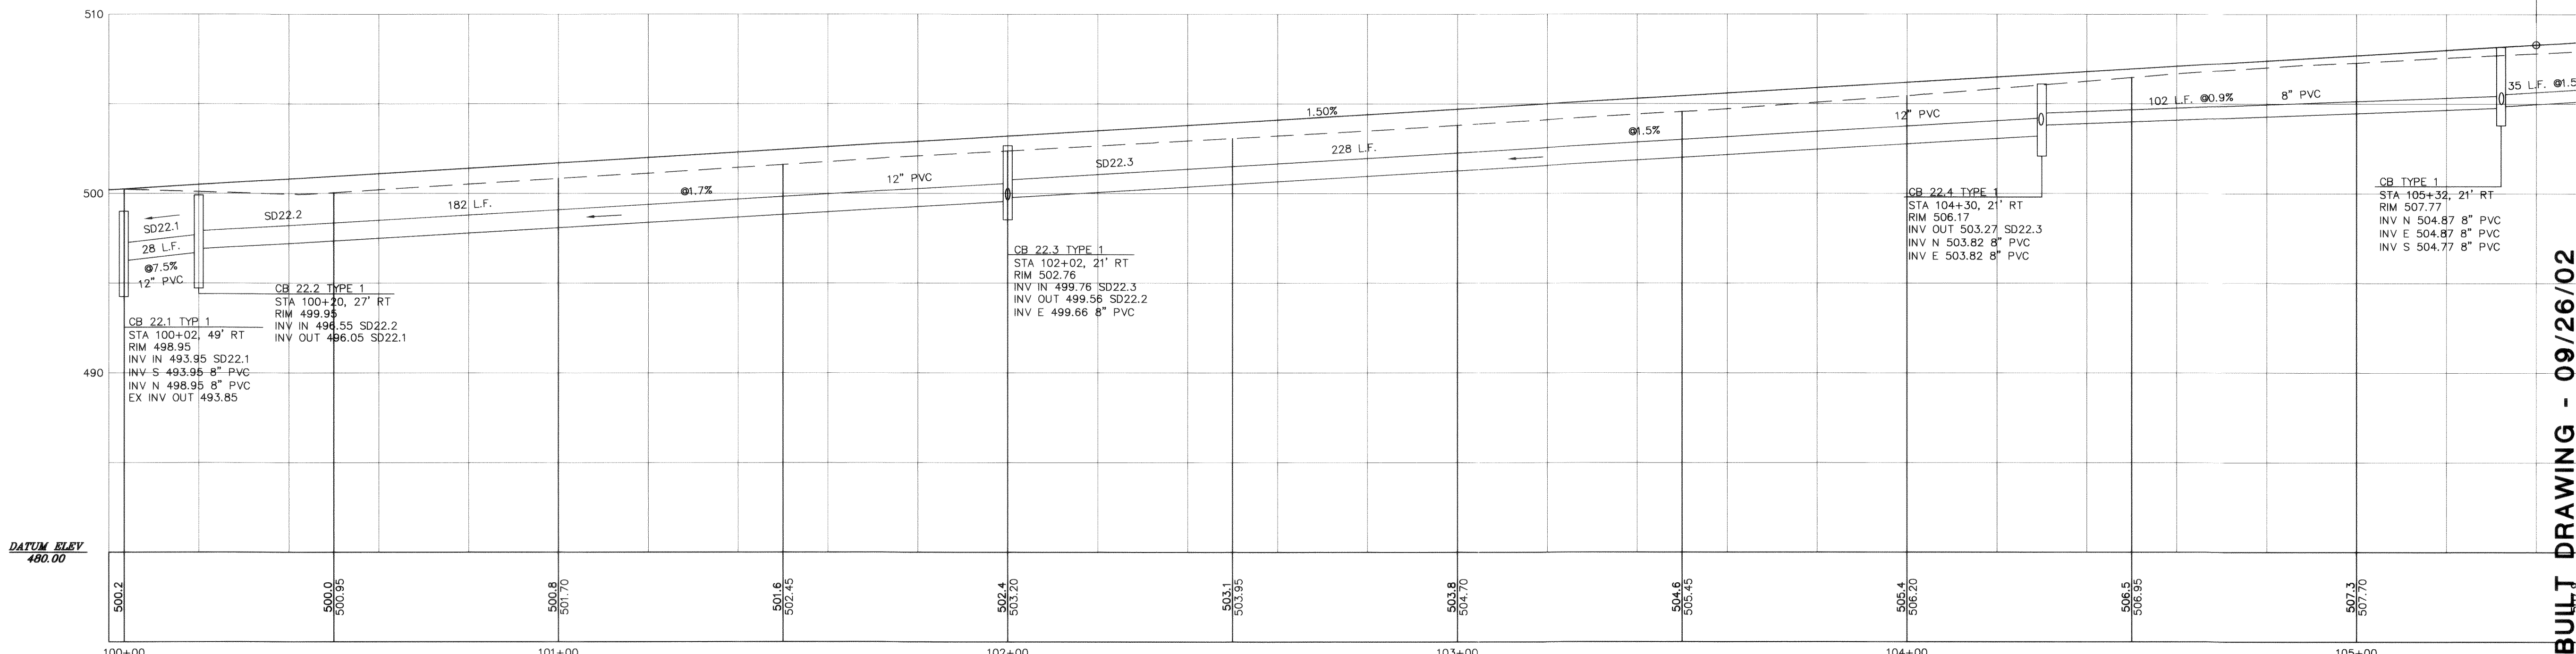




AS-BUILT DRAWING - 09/26/02

VISTA RIDGE
VISTA DRIVE PLAN / PROFILE
STA: 100+00-105+00

DAVID EVANS
AND ASSOCIATES, INC.
119 GRAND AVENUE, SUITE D
BELLINGHAM, WA 98225-4400 (800) 647-7151

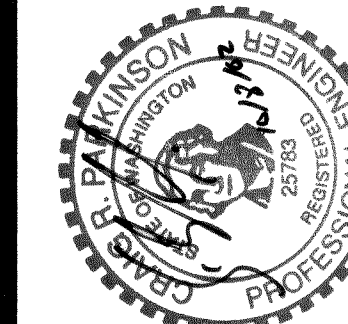


REVISIONS				
14	OF	21	PER CITY ON 6/19/02	
SCALE: H: 1"=20' V: 1"=5'	DESIGN: CRP		Revisions per city 9-25-02	
DATE: 9/26/02	DRAWN: DWA/A			
FILE: HMW0017/ HM17RD3A.DWG	CHECKED: CH			

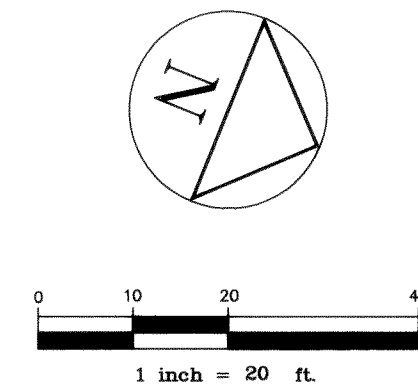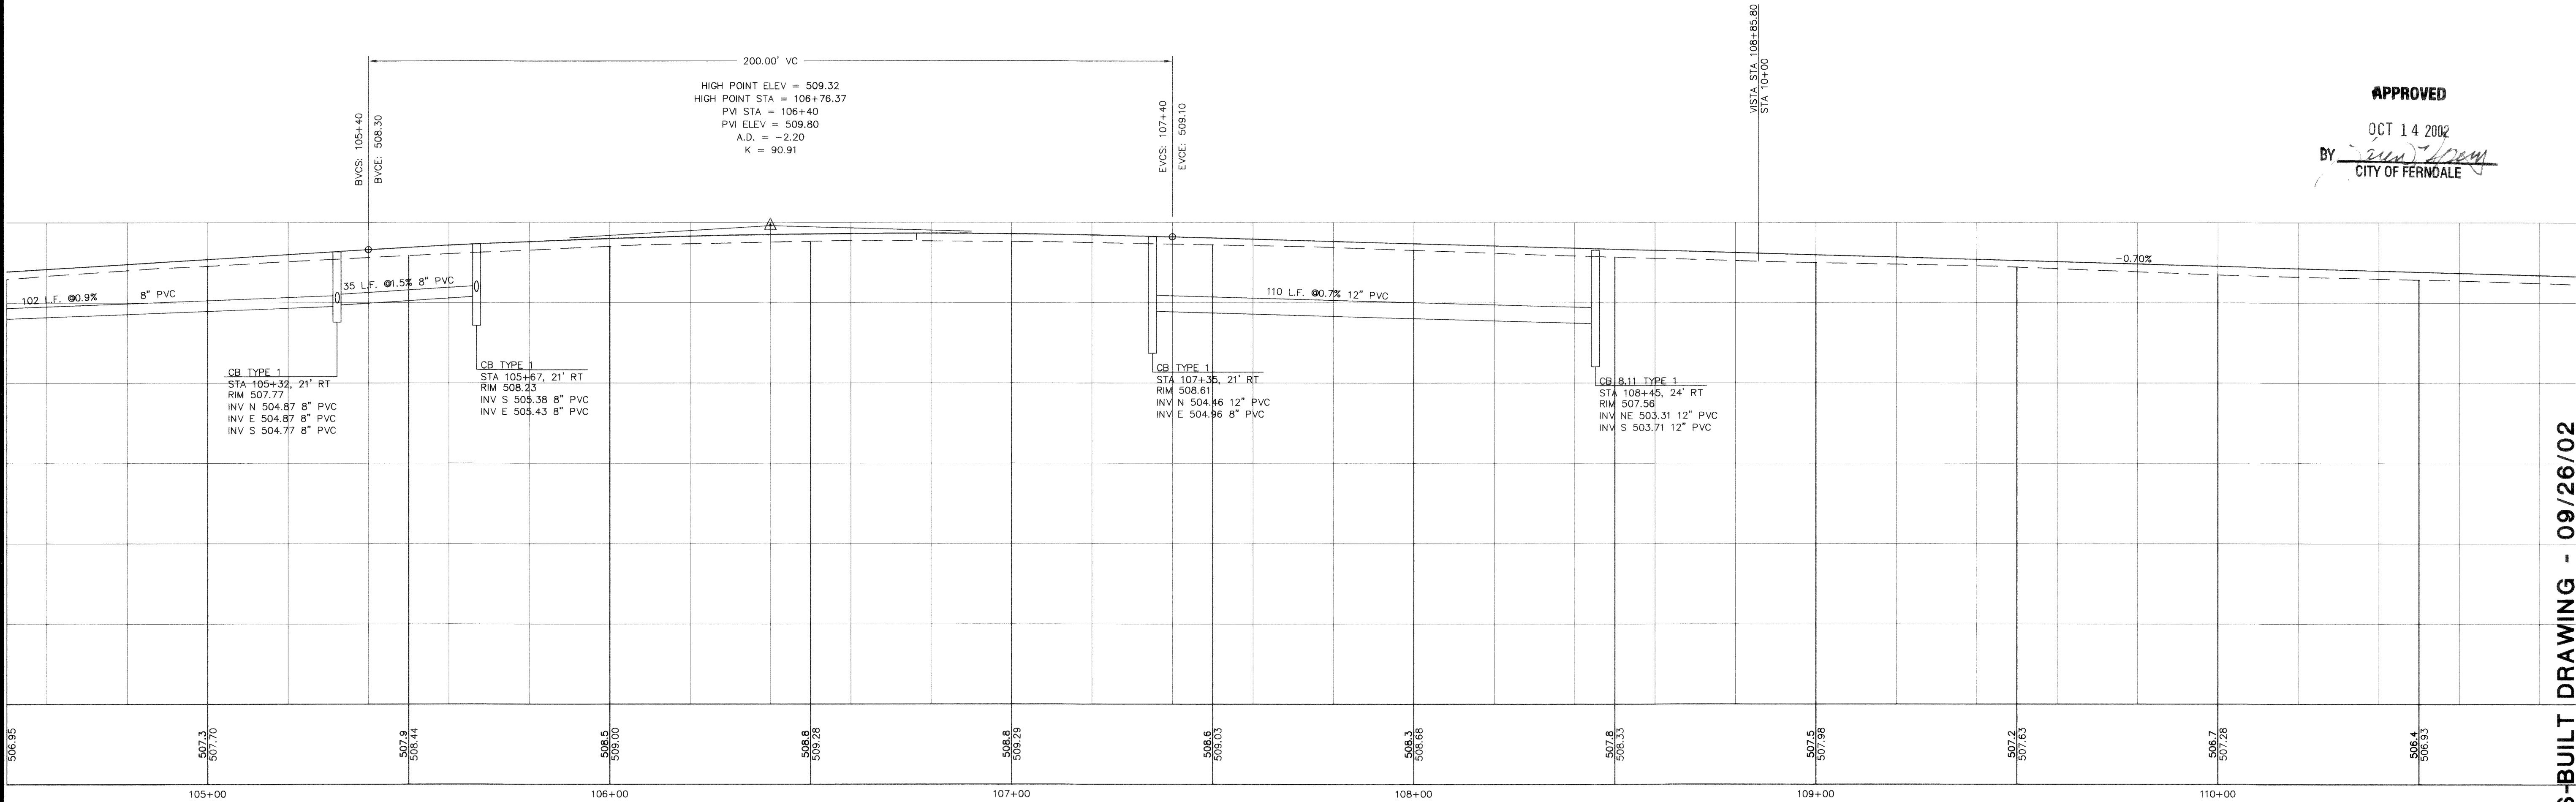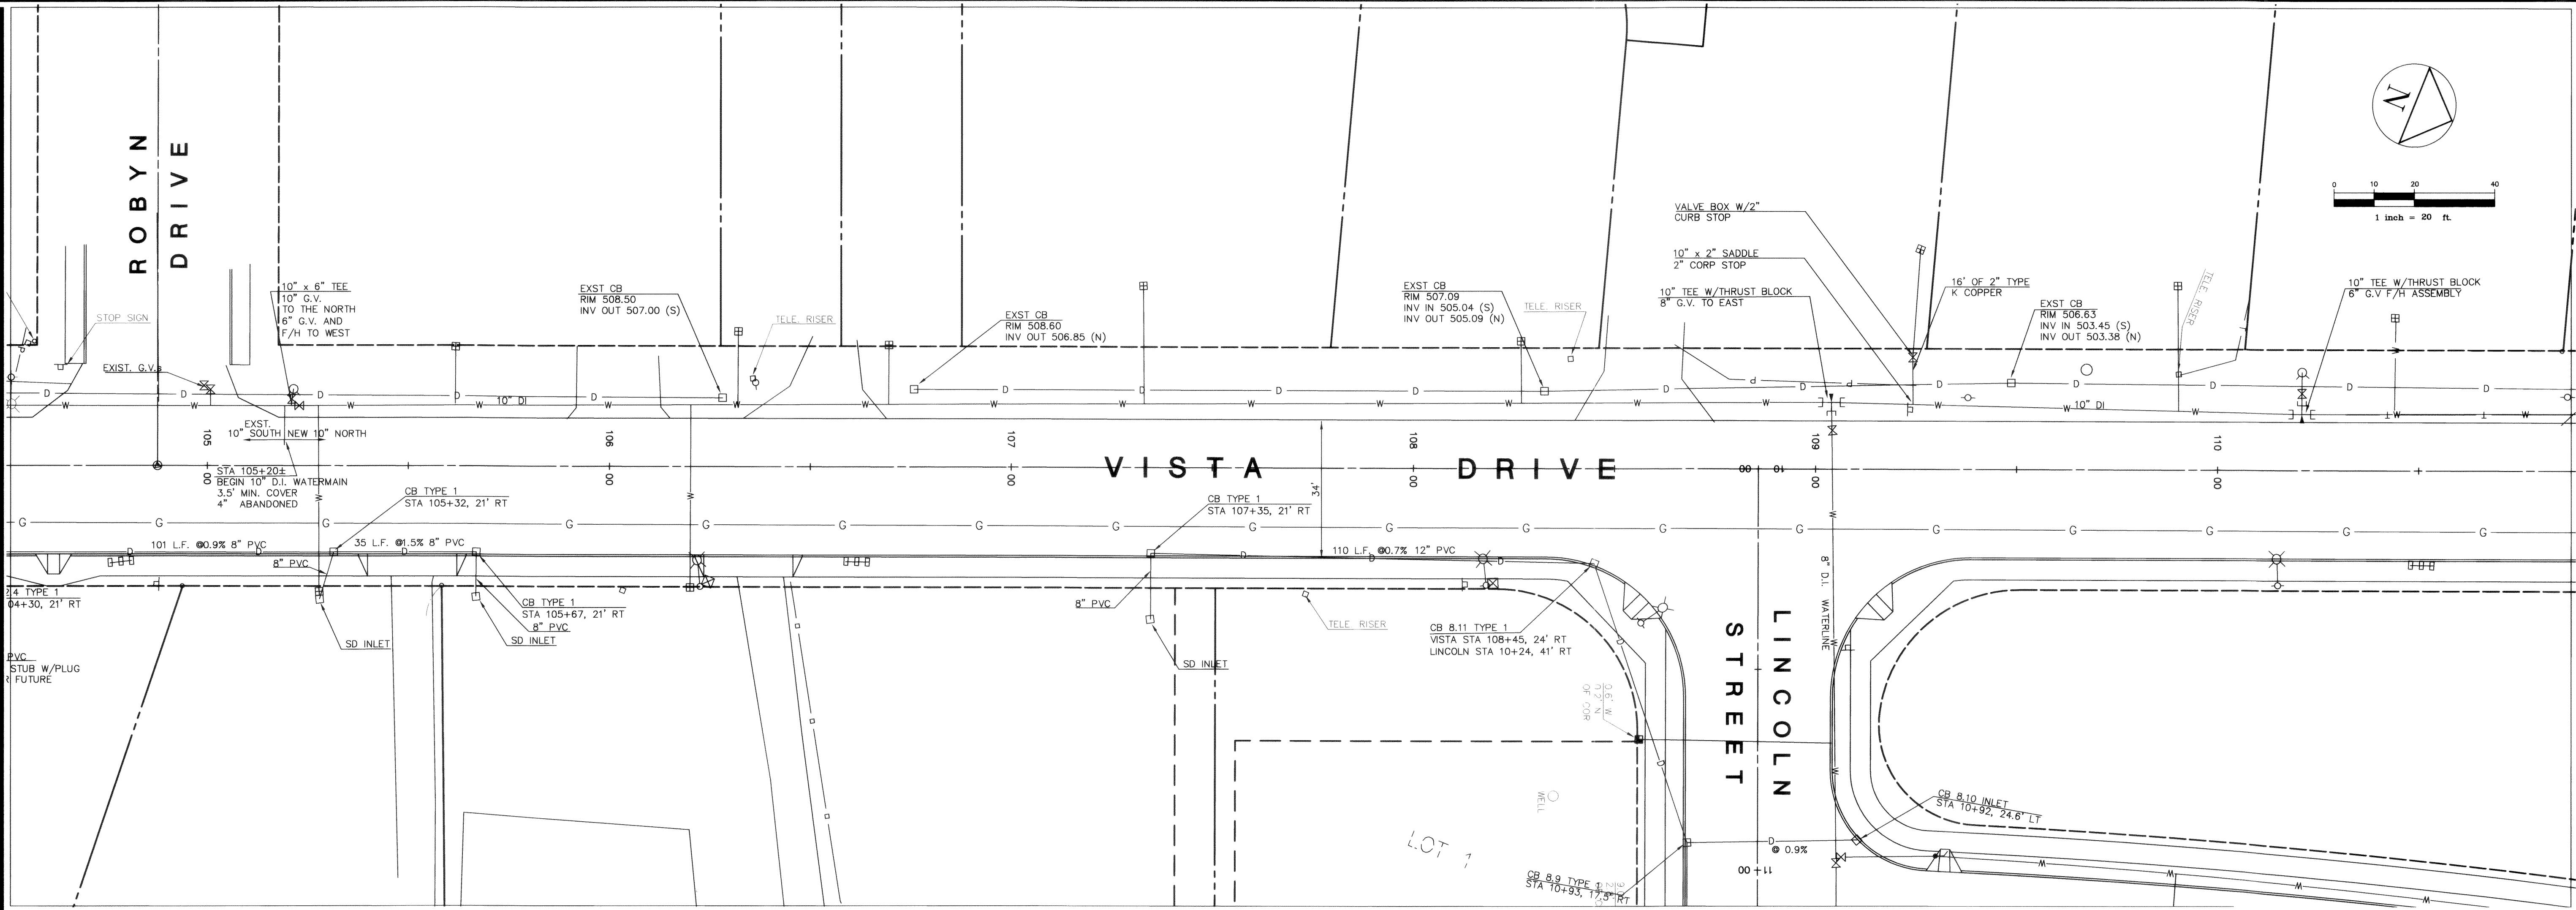

VISTA RIDGE
VISTA DRIVE PLAN / PROFILE
STA: 105+00-110+00

00249.015 2-16-06 RZ

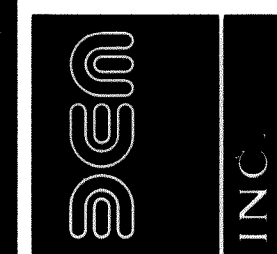

**DAVID EVANS
AND ASSOCIATES,
INC.**
119 GRAND AVENUE, SUITE D
BELLINGHAM, WA 98225-4400 (360) 647-7151





DAVID EVANS
AND ASSOCIATES,
INC.
119 GRAND AVENUE, SUITE D
BELLINGHAM, WA 98225-4400 (360) 647-7151


APPROVED
OCT 14 2002
BY *[Signature]*
CITY OF FERNO DALE

AS-BUILT DRAWING - 09/26/02

REVISIONS				
15	OF	21	SHEETS	PER CITY ON 6/19/02
SCALE: H: 1"=20' V: 1"=5'	PERSON: CRP	DATE: 9/26/02	DRAWN: DWMA	REVISIONS per city 9-25-02
FILE: HMW0017	HM17RD3A.DWG	CHECKED: <i>clp</i>		

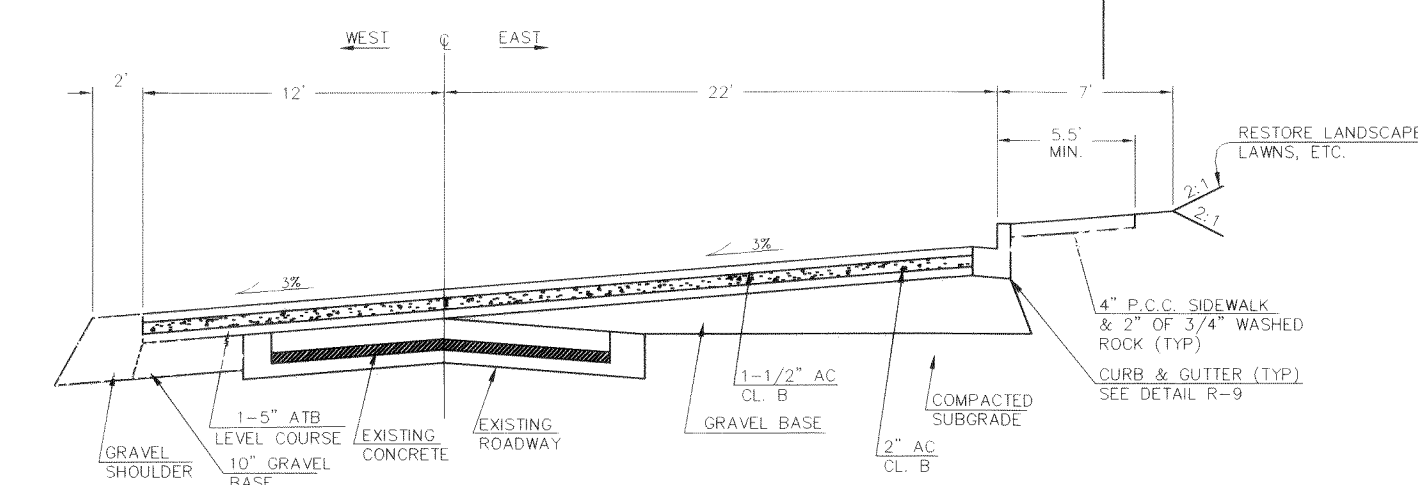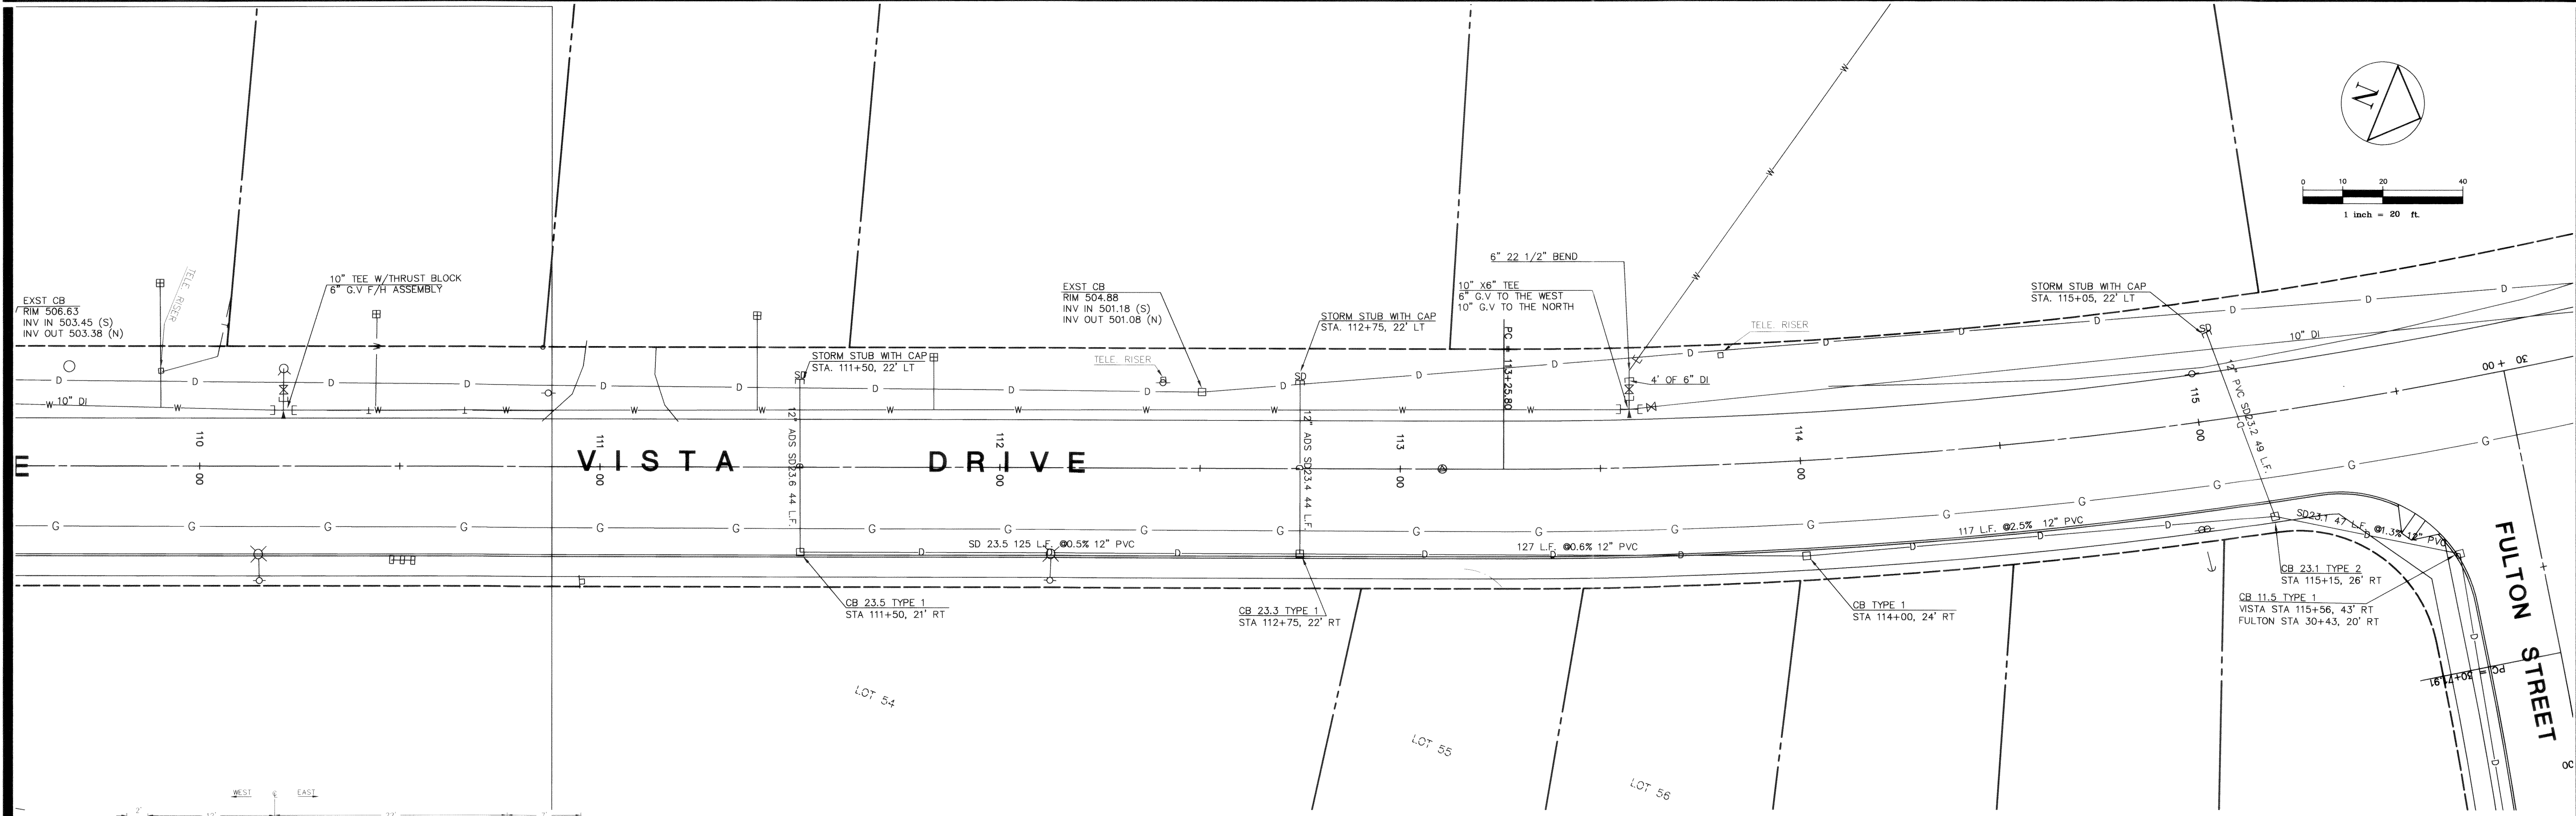

- NOTES:
1. ANFOPIE 4599 AS MANUFACTURED BY AMOCO FABRICS & FIBER CO. (404-384-4444) OR ENGINEERING APPROVED EQUAL SHALL BE PLACED BETWEEN ASPHALT LIFTS IN ACCORDANCE WITH MANUFACTURER'S RECOMMENDATIONS.
 2. EXISTING CONCRETE ROADWAY TO BE LEFT IN PLACE WITH MINIMUM OF AC LIFTS PLACED OVER EXISTING SURFACE.
 3. WHENING TO BE PERFORMED OUTSIDE OF EXISTING CONCRETE ROADWAY SECTION.
 4. 3\"/>
 5. EXISTING CONCRETE PANEL ROADWAY AND SANDY GRAVEL MAYBE USED IN LIEU OF 10\"/>
 6. 1\"/>
 7. LESS THAN 1\"/>


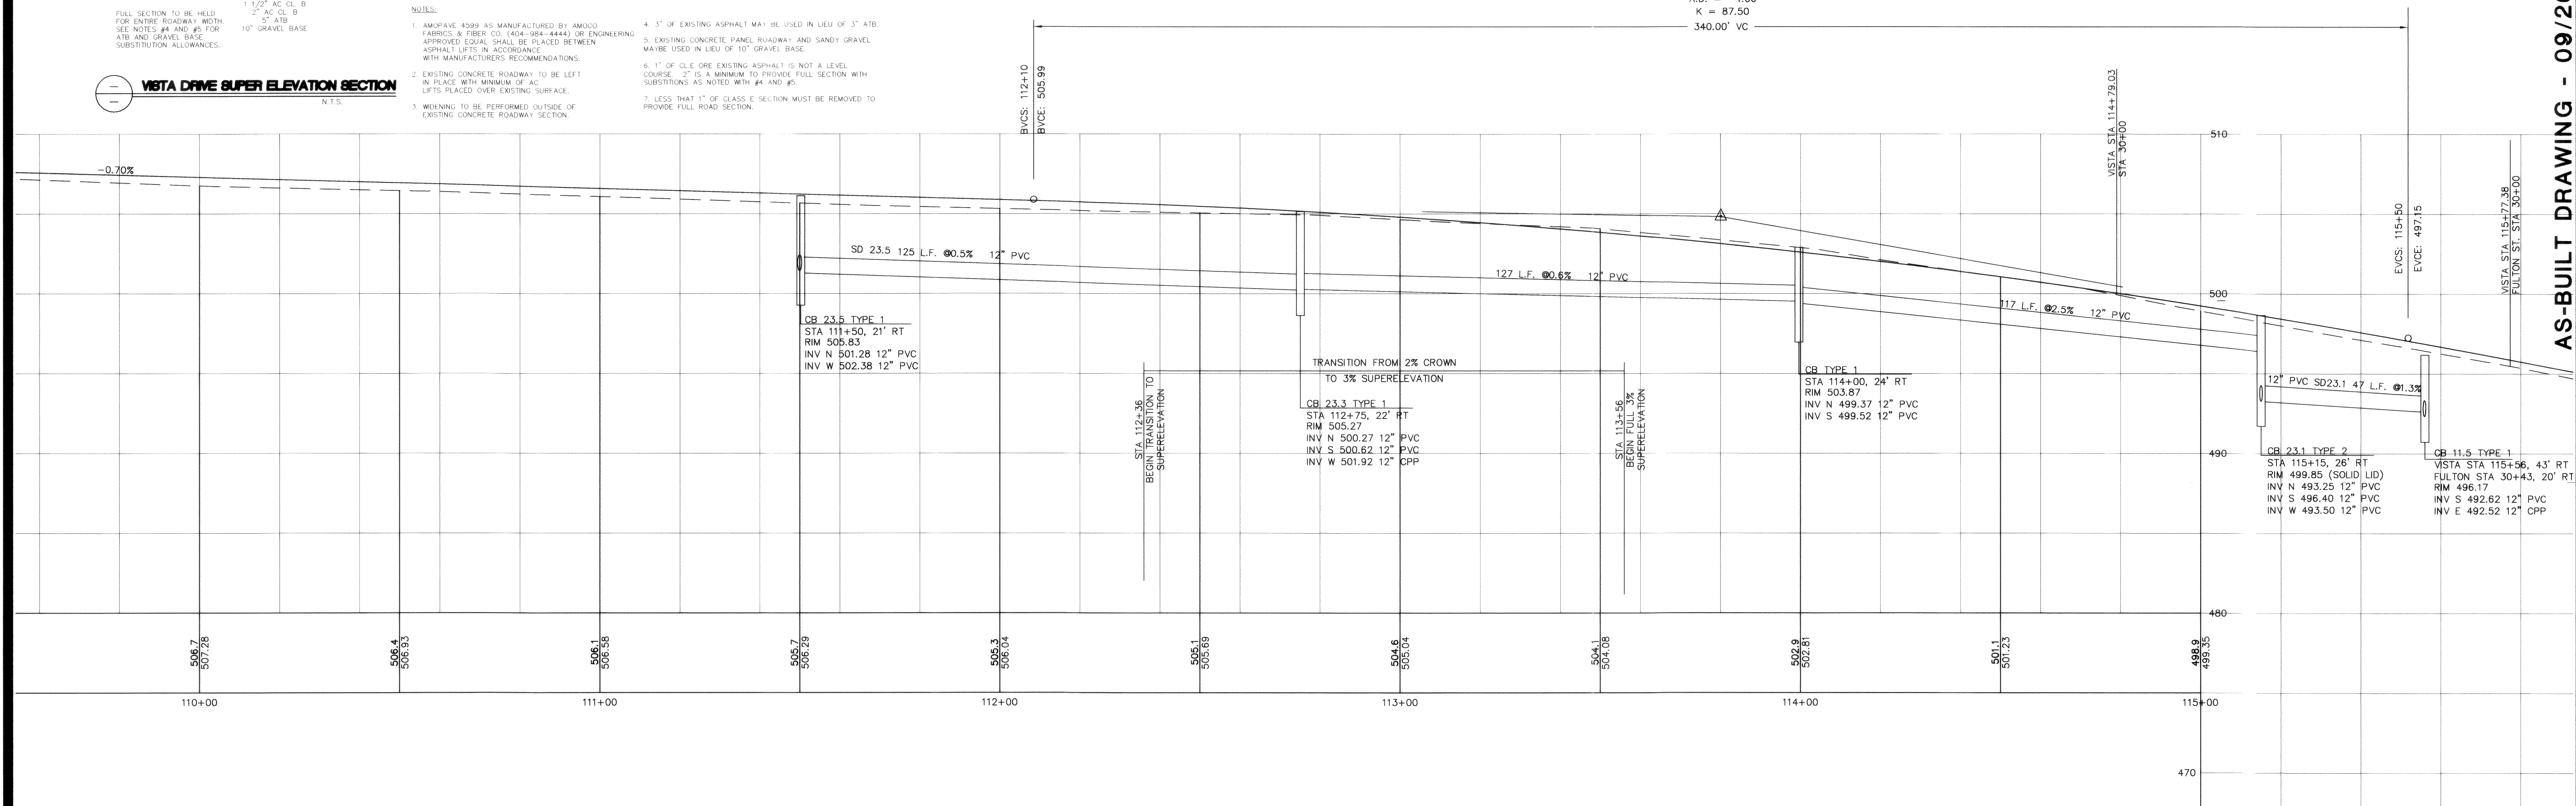


VISTA RIDGE
VISTA DRIVE PLAN / PROFILE
STA: 110+00-115+00
00249.016 2-16-00 RL

DAVID EVANS AND ASSOCIATES, INC.
119 GRAND AVENUE, SUITE D
BELLINGHAM, WA 98225-4400 (800) 647-7151

AS-BUILT DRAWING - 09/26/02

REVISIONS		DATE	BY	APP'D
1	PER CITY ON 6/19/02	6/19/02		
2	PER CITY ON 9/25/02	9/25/02		
3	PERSON: CRP			
4	DATE: 3/19/01			
5	FILE: HMW00171/HM17RO3A.DWG			
6	CHECKED: CLP			

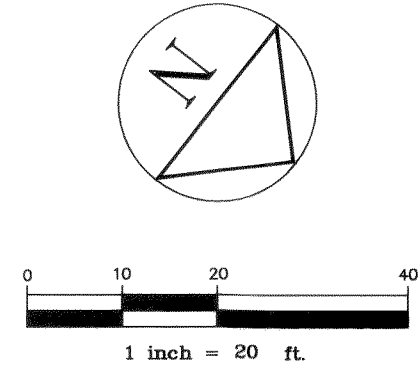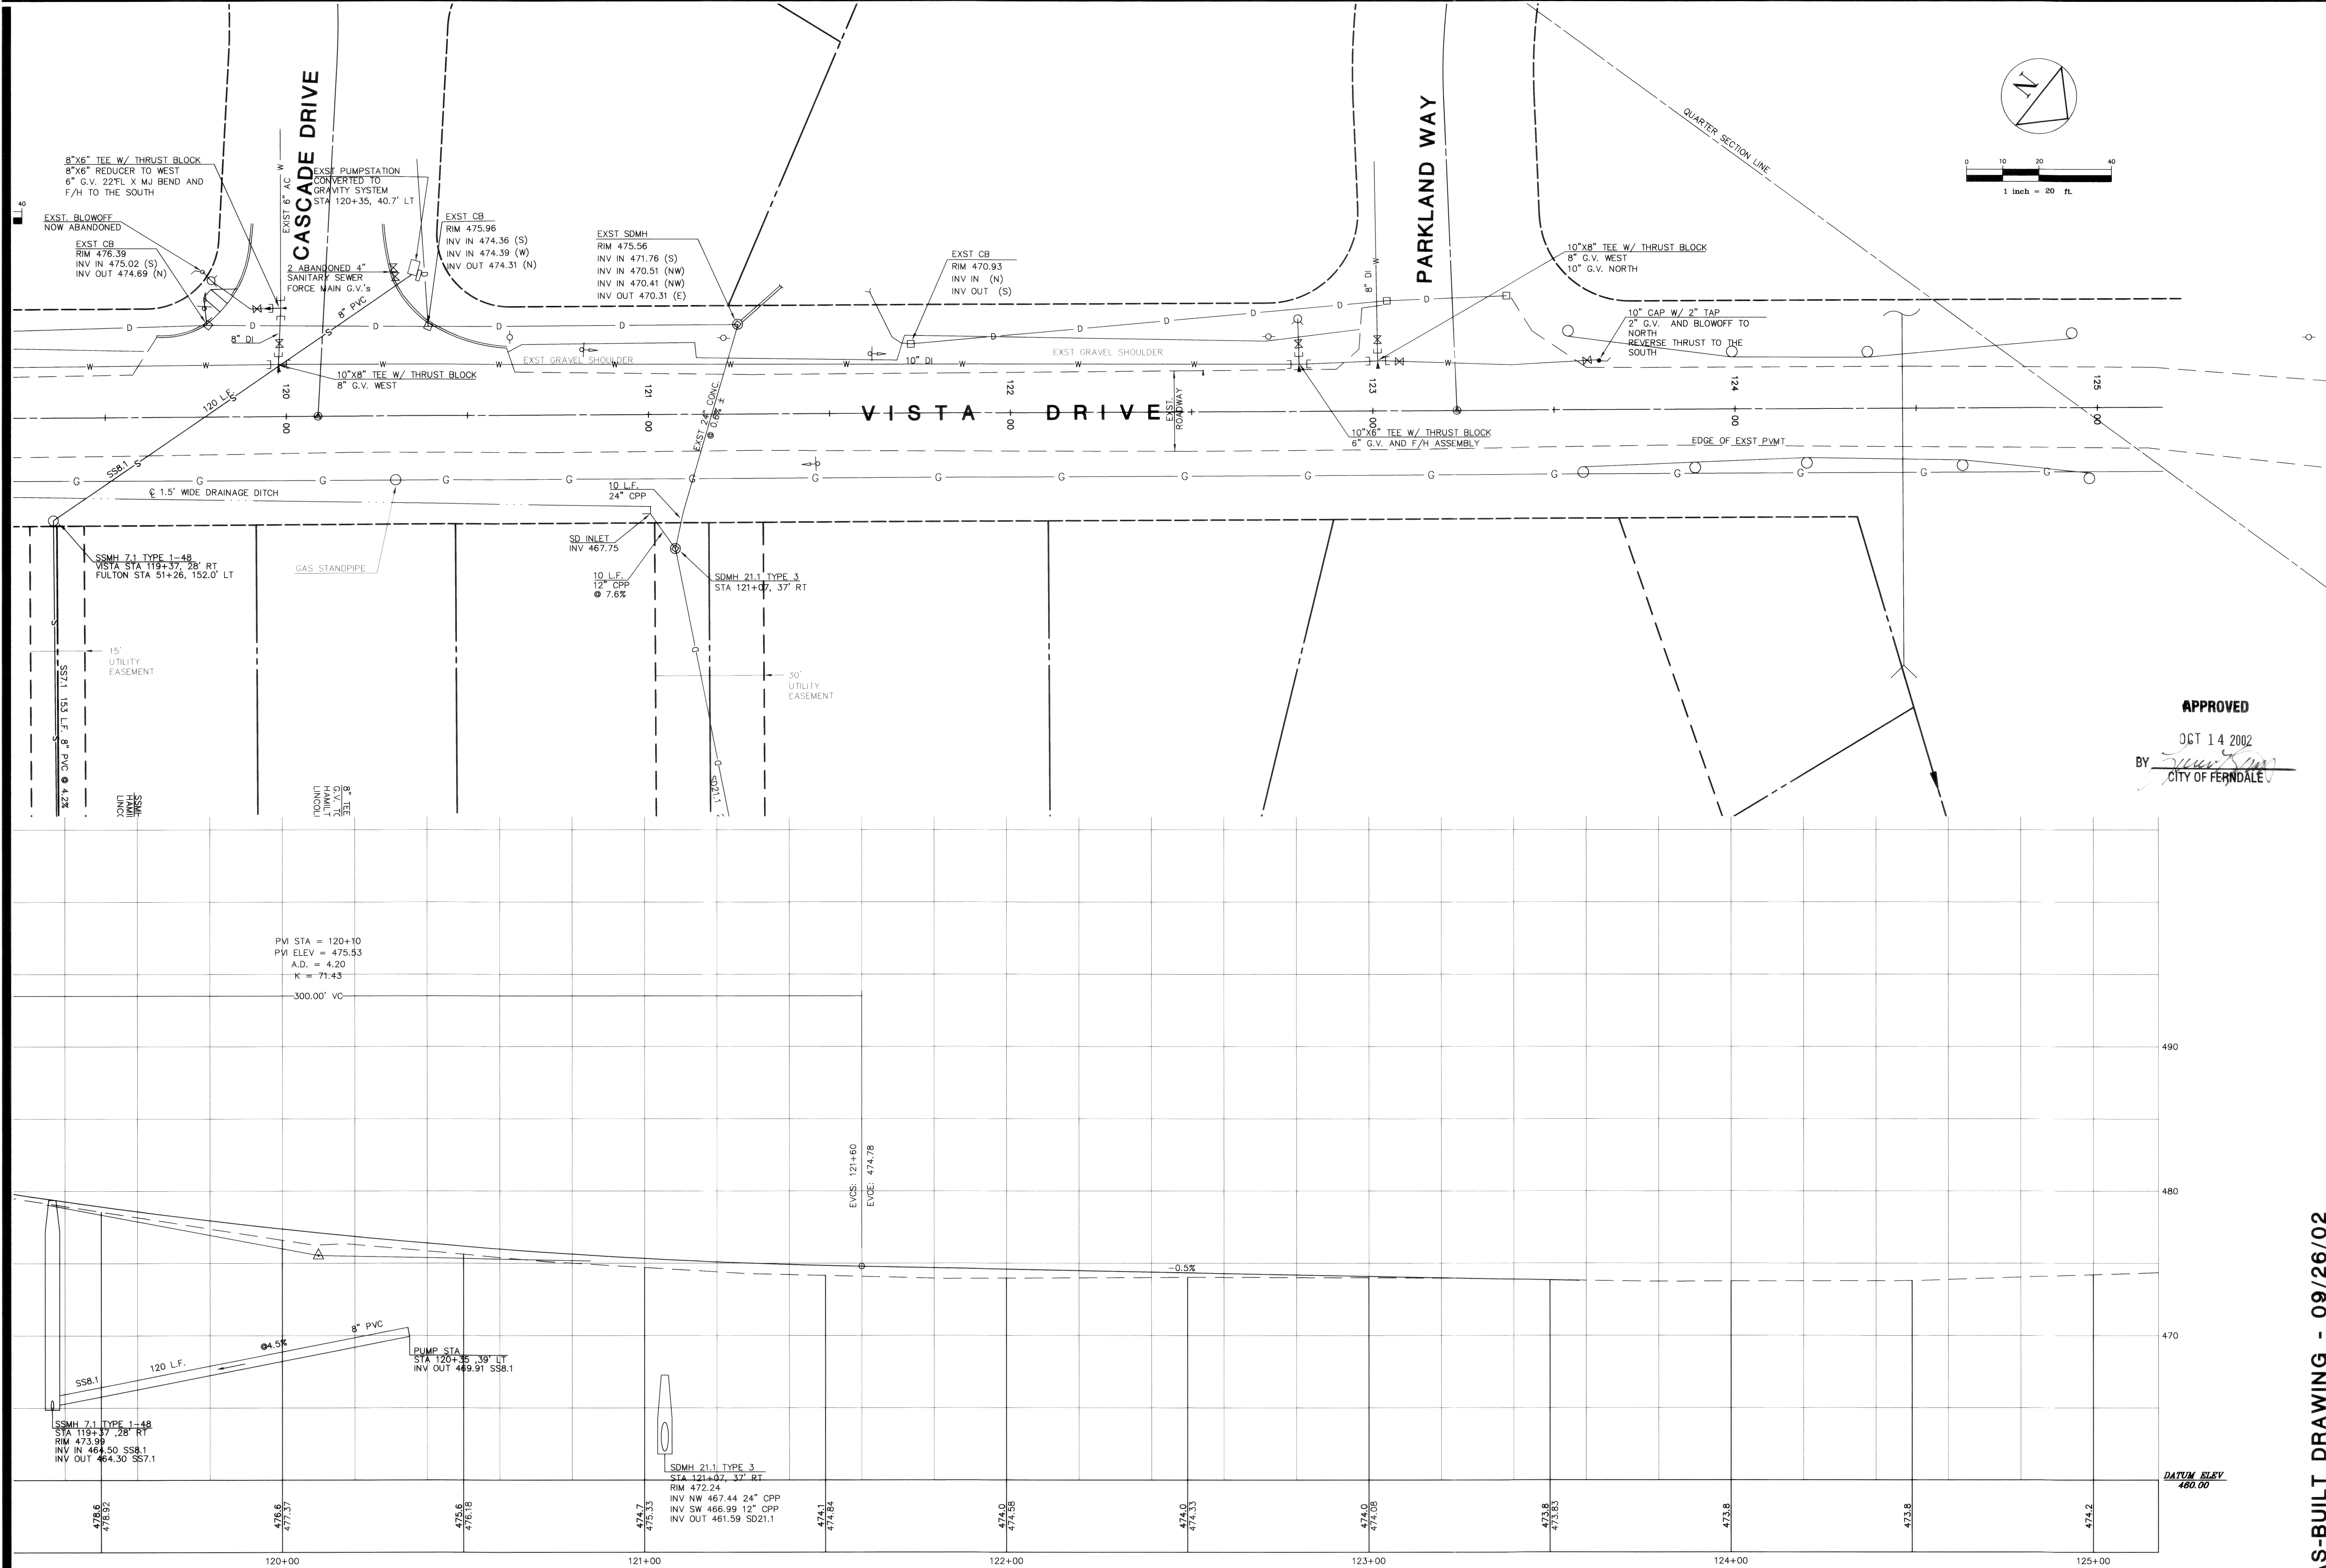

APPROVED
OCT 14 2002
BY *[Signature]*
CITY OF FERDALE

AS-BUILT DRAWING - 09/26/02

VISTA RIDGE
VISTA DRIVE PLAN / PROFILE
STA: 120+00-125+00





DAVID EVANS
AND ASSOCIATES, INC.
119 GRAND AVENUE, SUITE D
BELLINGHAM, WA 98225-4400 (800) 647-7151




REVISIONS			
18	OF	21	SHEETS
PER CITY ON 6/19/02	DESIGN: CRP	DATE: 3/19/01	FILE: HMAW0017/HM17R03A.DWG
PER CITY ON 9/25/02	DRAWN: DWMA	CHECKED: C42	

P:\P\HMM\017\DWG\AS-BUILT\15\HMT1703A.DWG Wed Apr 11 07:45:09 2001 DAVID EVANS AND ASSOCIATES, INC. -TSR

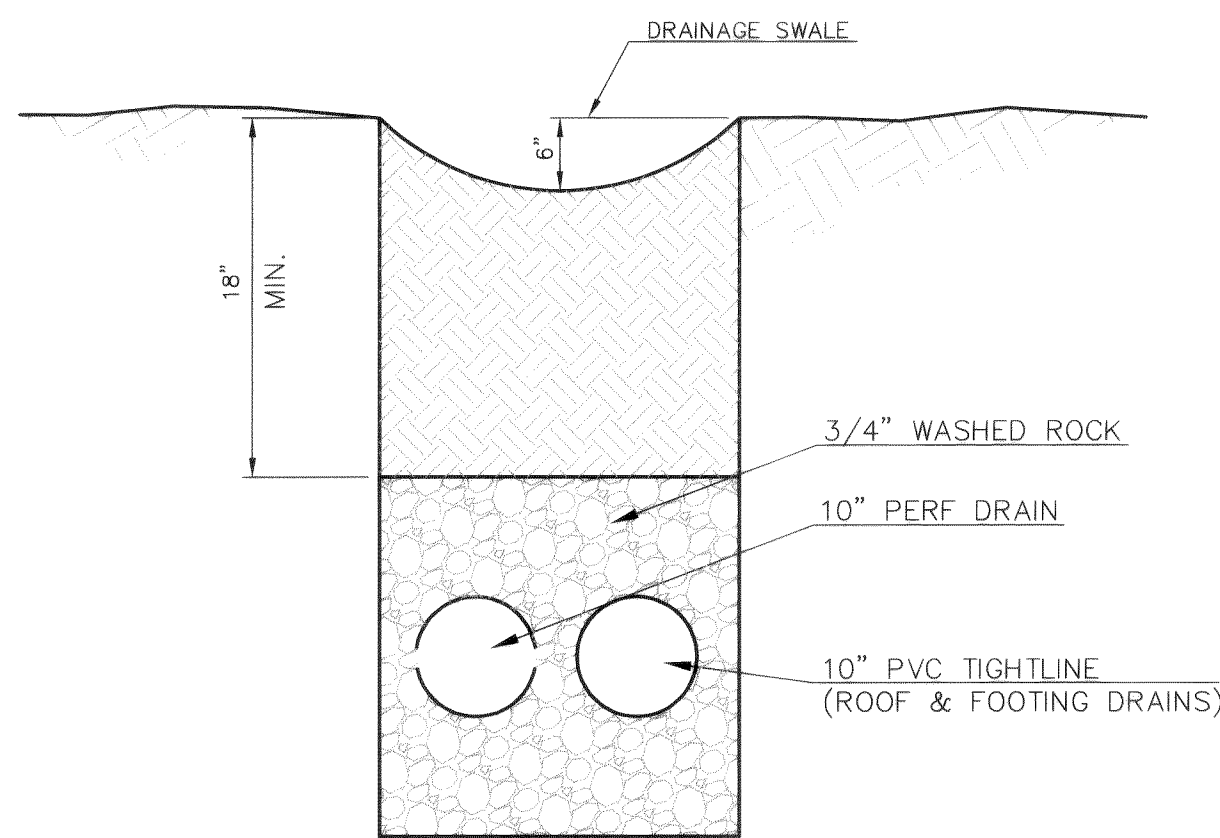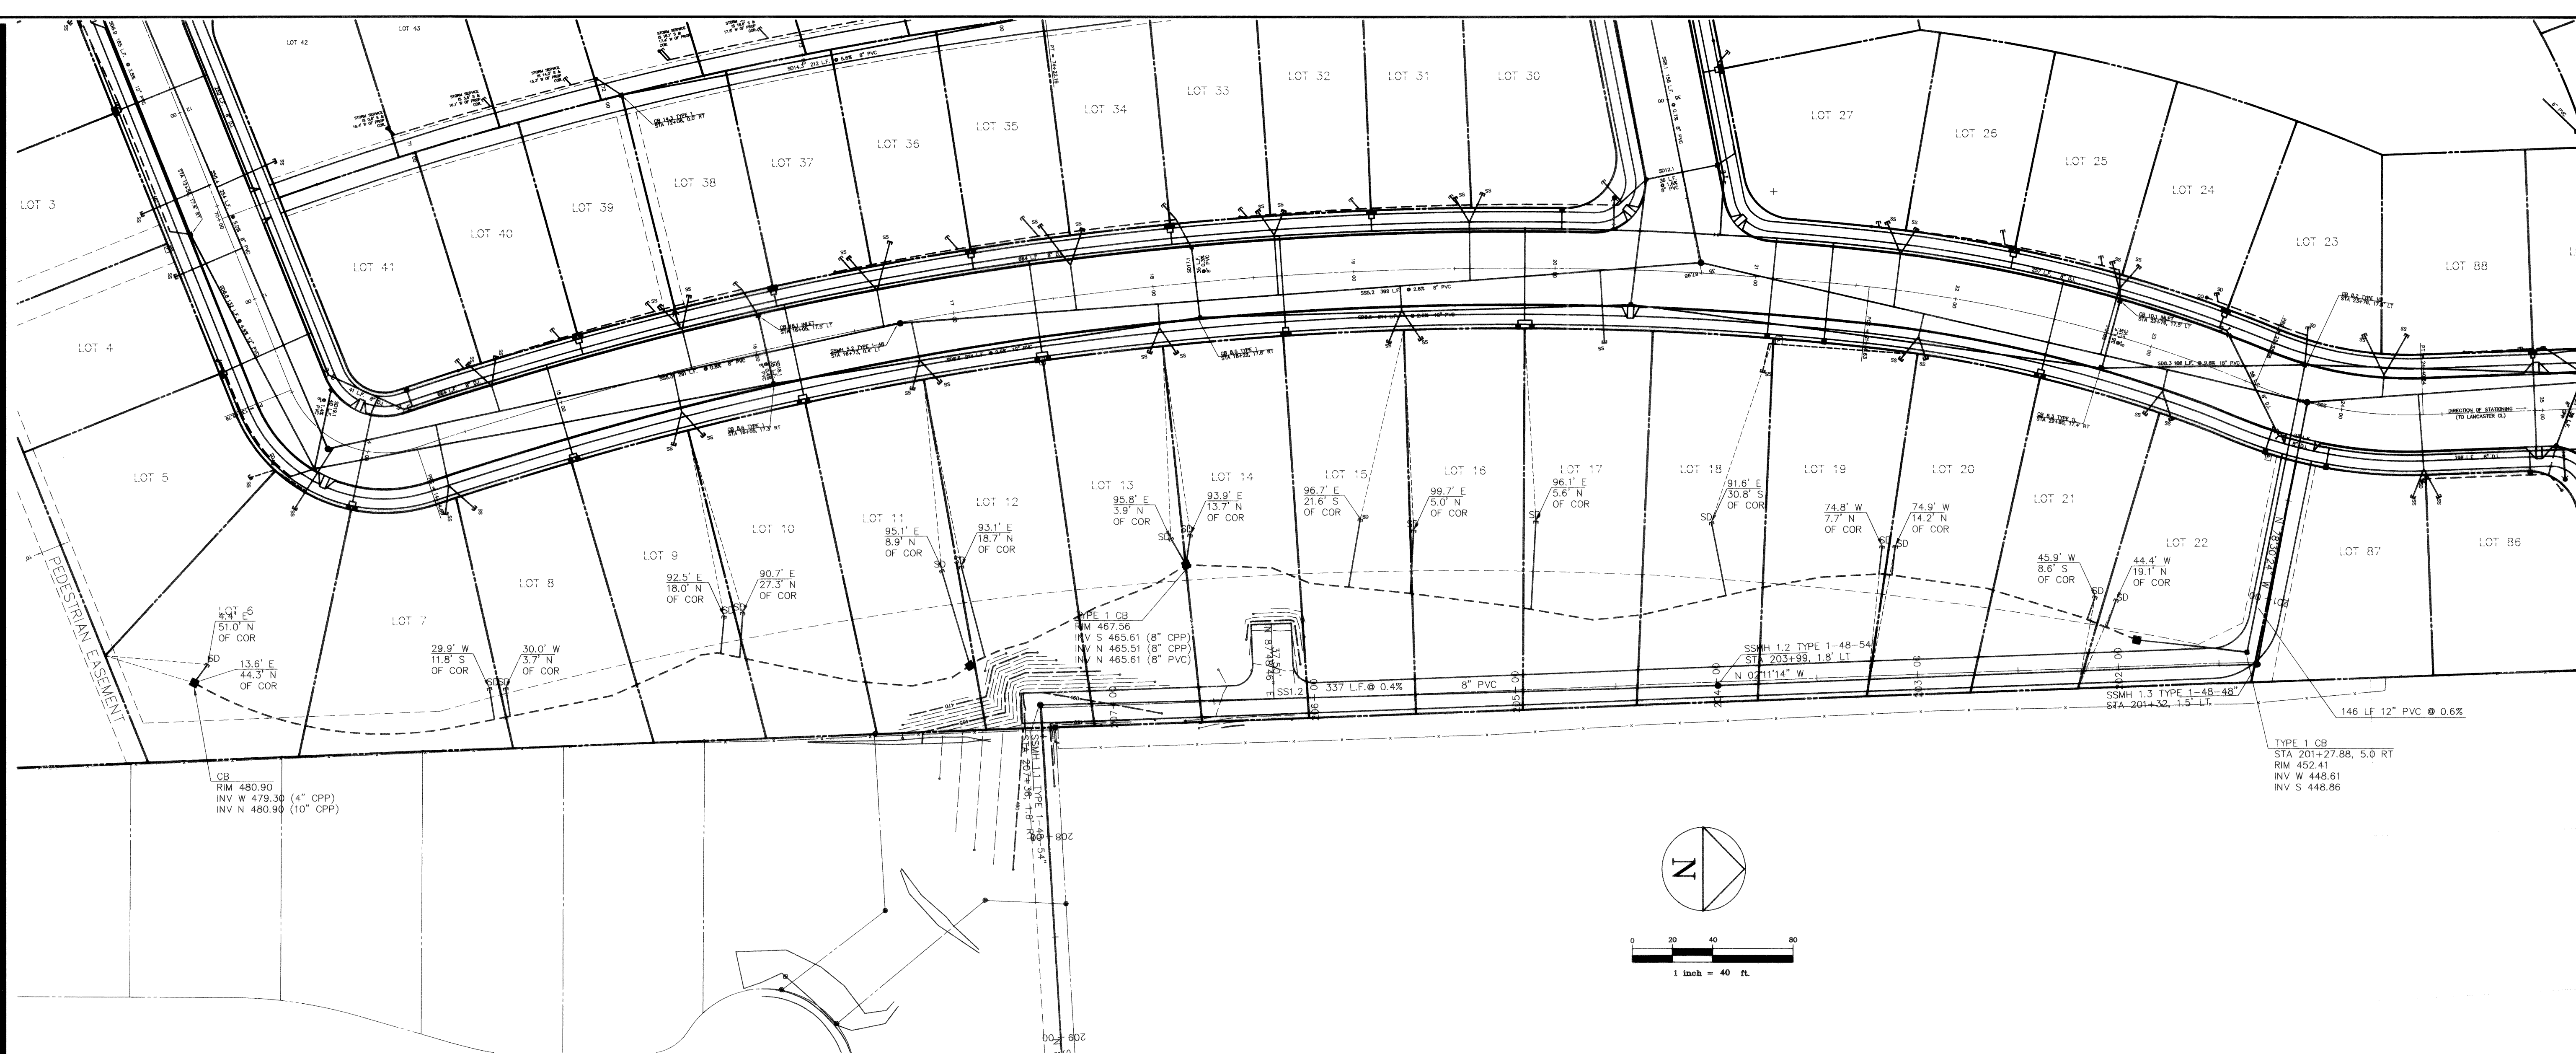

1
19 TYPICAL DRAIN LINE SECTION
NOT TO SCALE

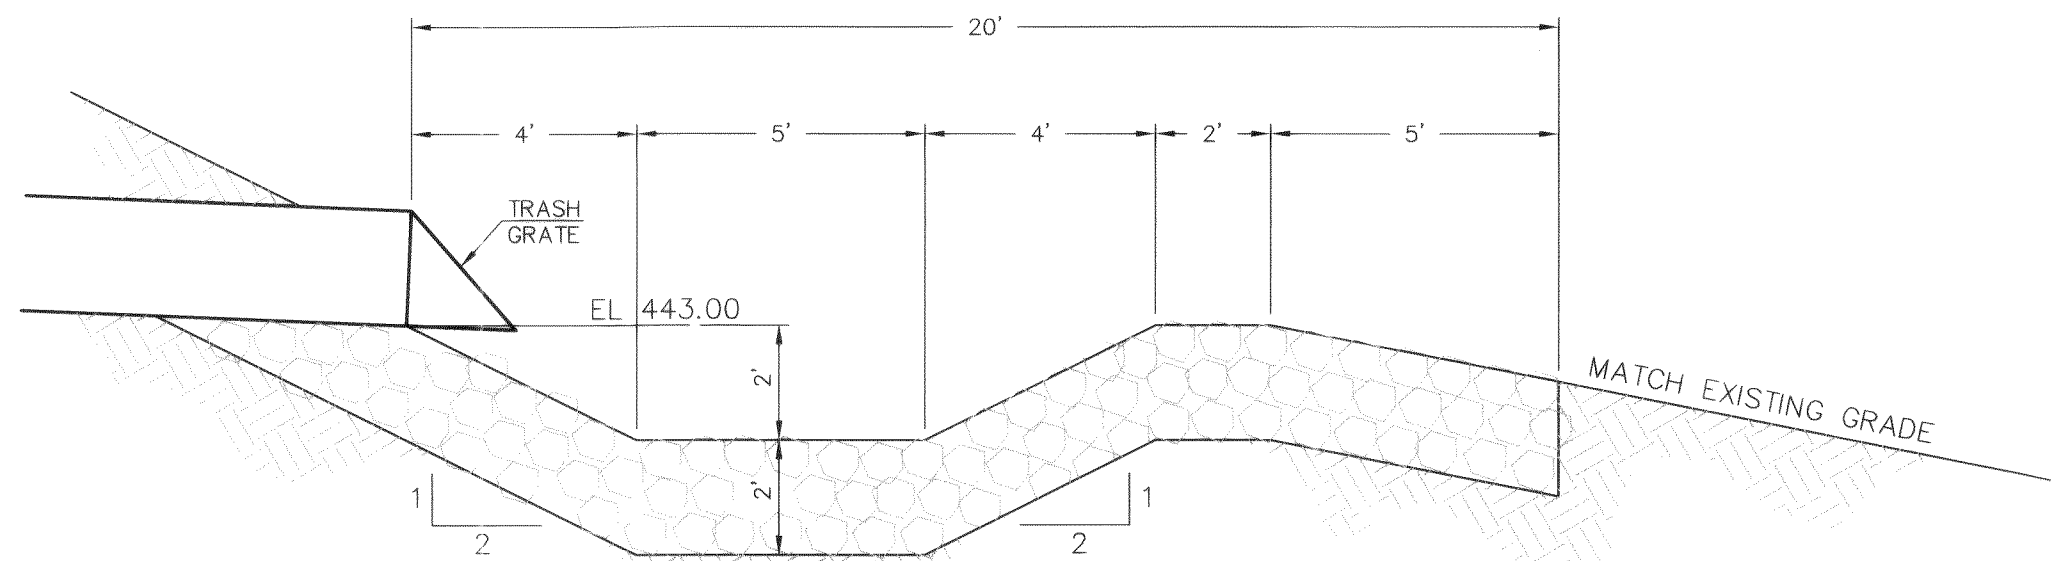

2
9 SD21.1 OUTFALL SUMP DETAIL
NOT TO SCALE

AS-BUILT DRAWING - 03/19/01

19
OF
21

SCALE: H: 1"=40'
DATE: 3/19/01
RE: HMM\0017\HMT1703A.DWG
DESIGN: CRP
DRAWN: DWMA
CHECKED: CLP










DAVID EVANS
AND ASSOCIATES, INC.
119 GRAND AVENUE, SUITE D
BELLINGHAM, WA 98225-4400 (800) 647-7151



VISTA RIDGE
EAST PROPERTY LINE
STORM DRAIN PLAN

00249.019 2.16.04 H

P:\P\HMM\0017\DWG\AS-BUILT\15\HMT17v03a.dwg Wed Apr 11 07:45:56 2001 DAVID EVANS AND ASSOCIATES, INC -15R

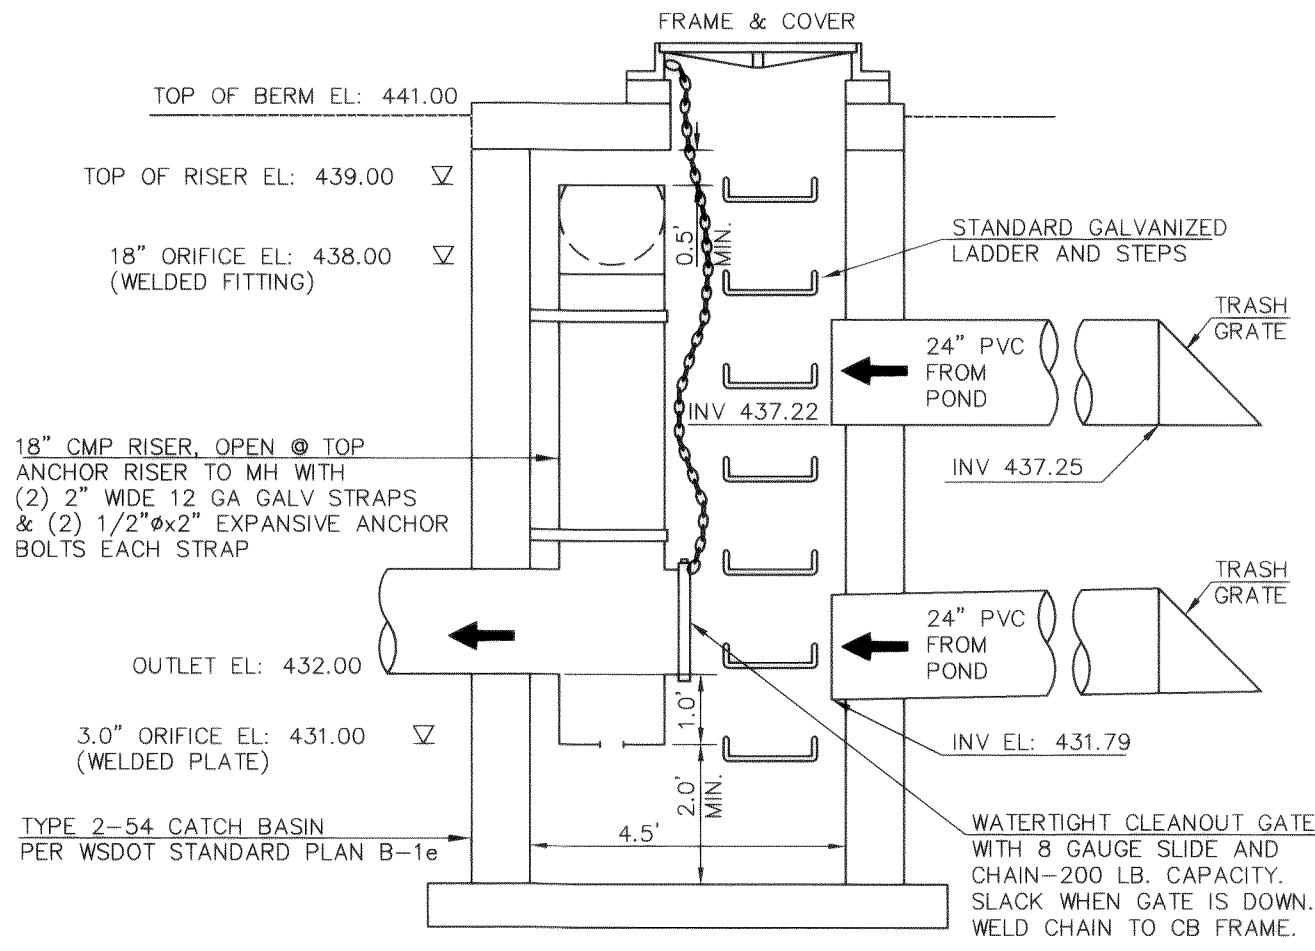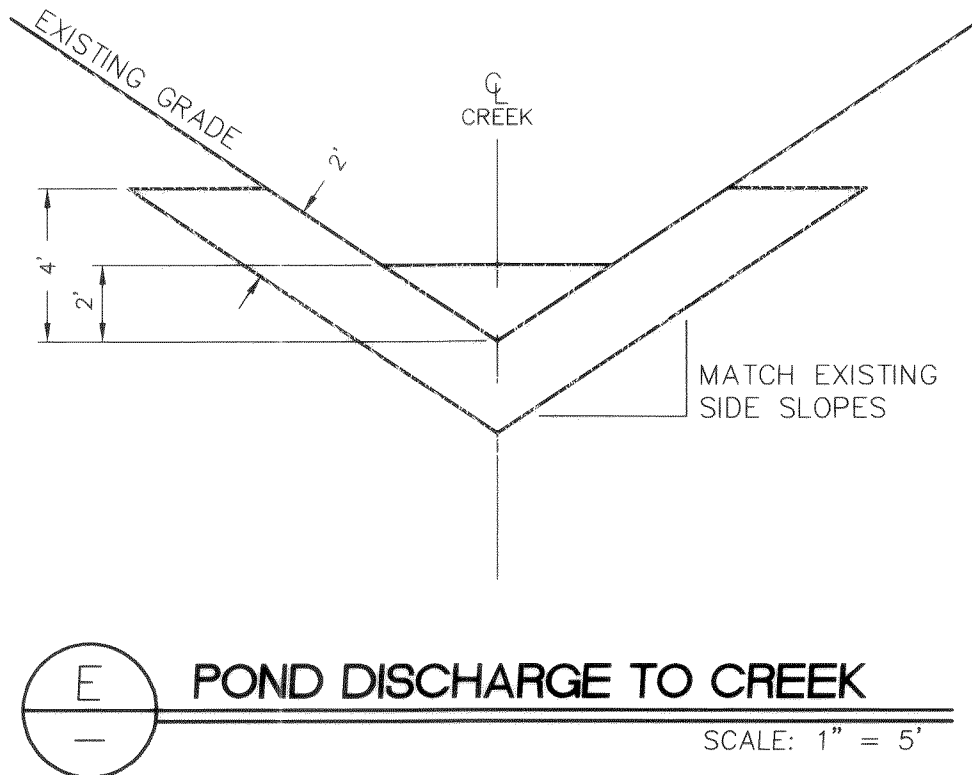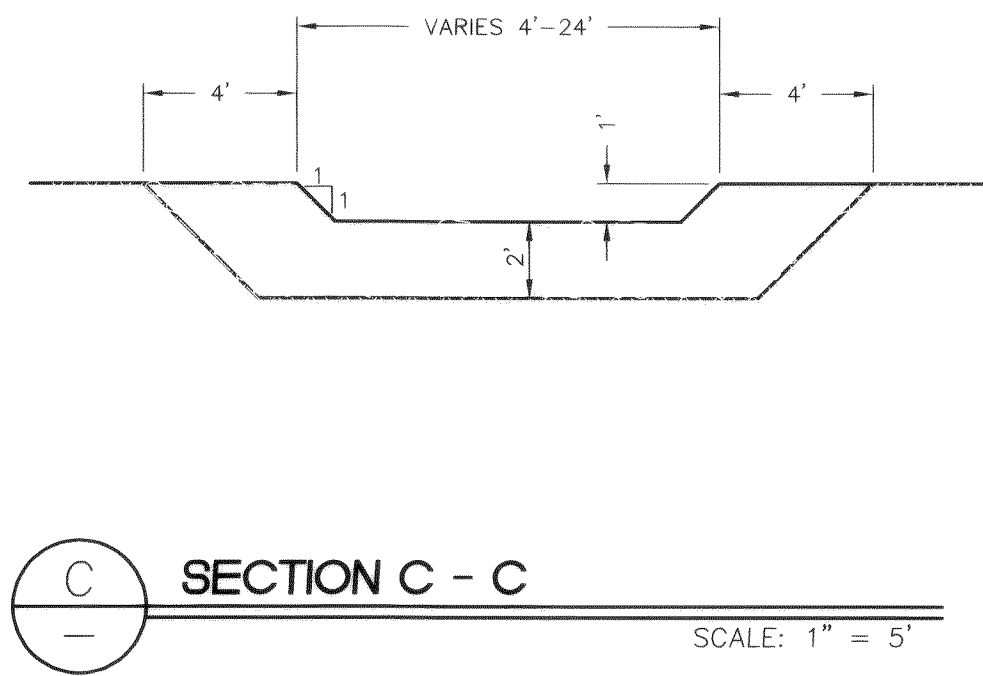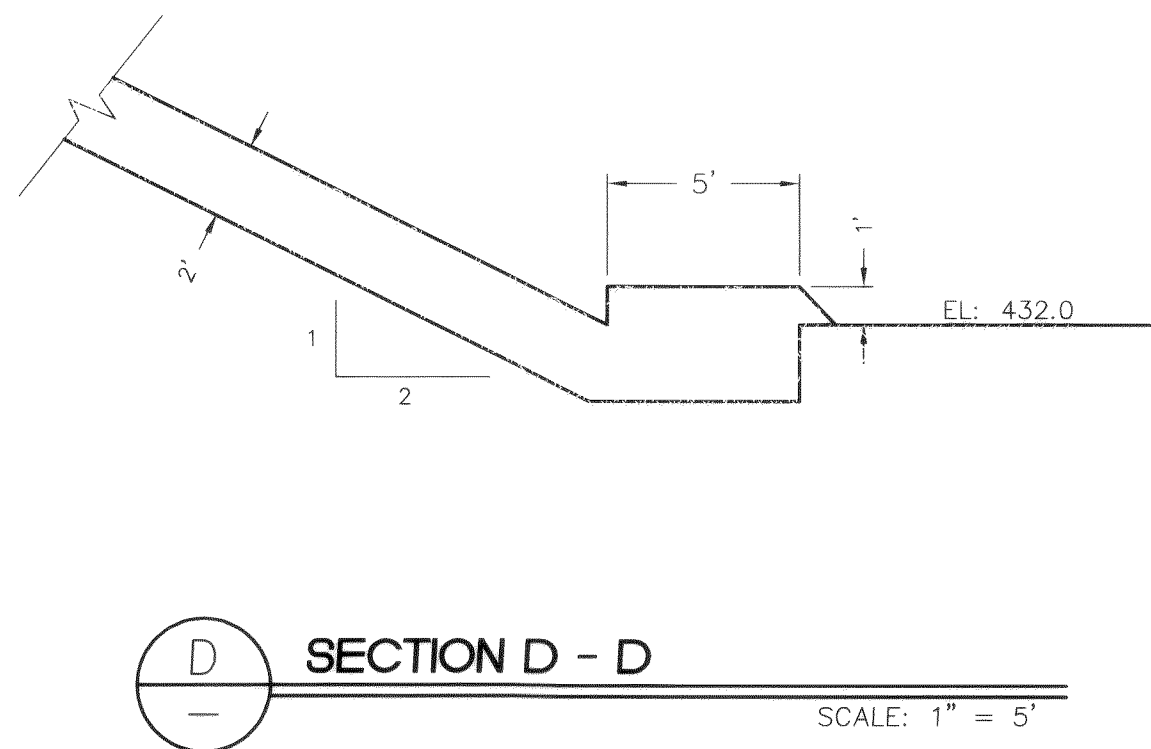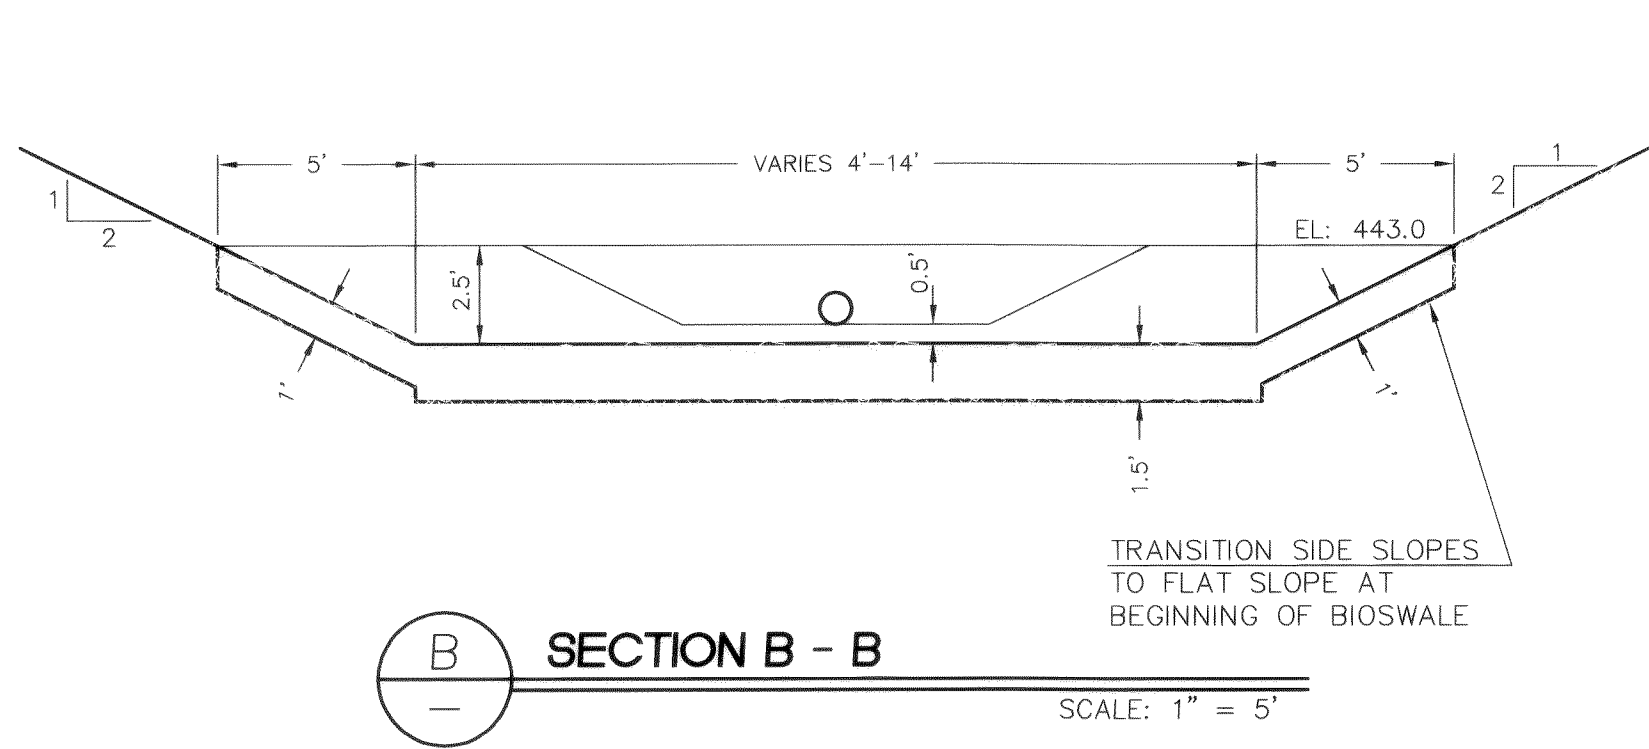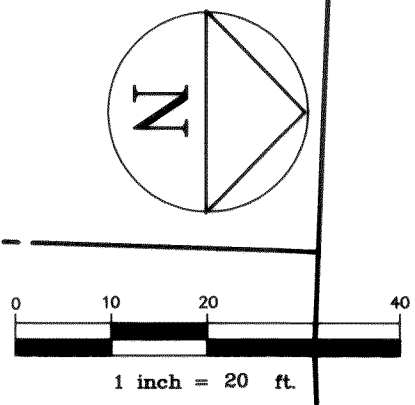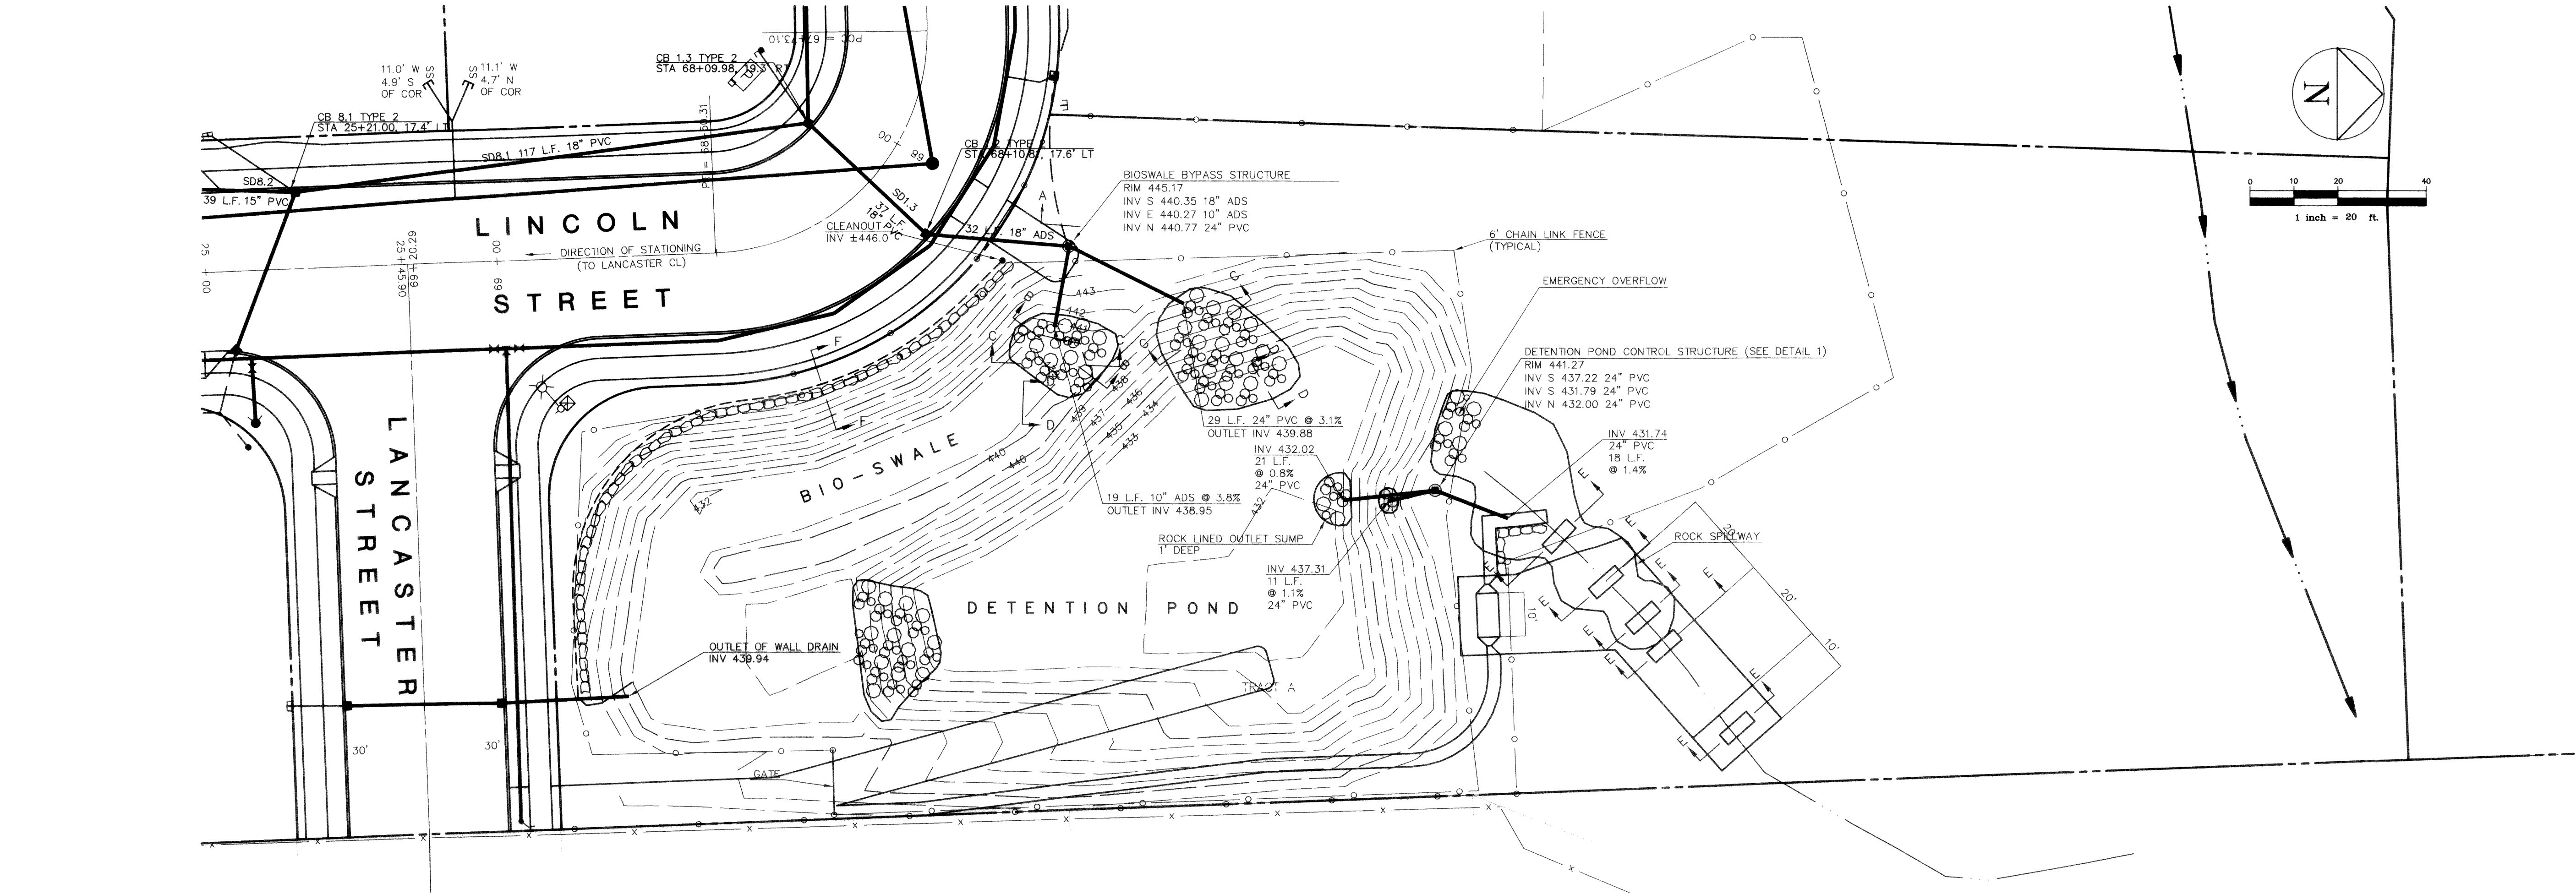

1
—
DETAIL 1
N.T.S.

NOTES:


- RIP-RAP SHALL BE IN ACCORDANCE WITH WSDOT 1996 STANDARD SPECIFICATIONS SECTION 9-13. RIP-RAP FOR BIOSWALE ENTRANCE AND SUMP FROM HAMILTON STREET CULVERT SHALL BE HAND PLACED RIP-RAP (9.13.2). ALL OTHER LOCATIONS SHALL BE LIGHT LOOSE RIP-RAP (9.13.1(2)).
- BIOSWALE AND DETENTION POND SIDE SLOPES TO BE COVERED WITH EROSION CONTROL SEED MATTING.
- DETENTION POND BERM BACKFILL SHOULD BE ON-SITE MATERIAL AND SHALL BE FREE OF ORGANICS AND DELETERIOUS MATERIALS. ALL MATERIAL SHALL BE PLACED IN MAXIMUM 12 INCH LOOSE LIFTS AND COMPACTED TO 90% MAXIMUM DRY DENSITY ACCORDING TO ASTM D-1557 MODIFIED PROCTOR METHOD. SLOPES SHALL NOT BE STEEPER THAN 2 HORIZONTAL TO 1 VERTICAL, OR AS RECOMMENDED BY A SOILS ENGINEER.

AS-BUILT DRAWING - 03/19/01

20 OF 21

REVISIONS			
NO.	DATE	DESCRIPTION	BY

SCALE: AS NOTED	DESIGN: CRP	SHEETS
DATE: 9-5-97	DRAWN: DWMA	
FILE: HMM\0017\HMT17\03A.DWG	CHECKED: <i>CE</i>	

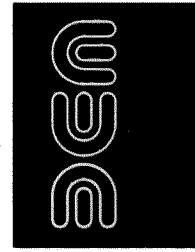




DAVID EVANS
AND ASSOCIATES, INC.
119 GRAND AVENUE, SUITE D
BELLINGHAM, WA 98225-4400
(800) 847-7151



DAVID EVANS
PROFESSIONAL ENGINEER
LICENSE NO. 207165
STATE OF WASHINGTON
EXPIRES 4-28-03

VISTA RIDGE
DETENTION POND PLAN

03/19/01 2.10.06 *KE*

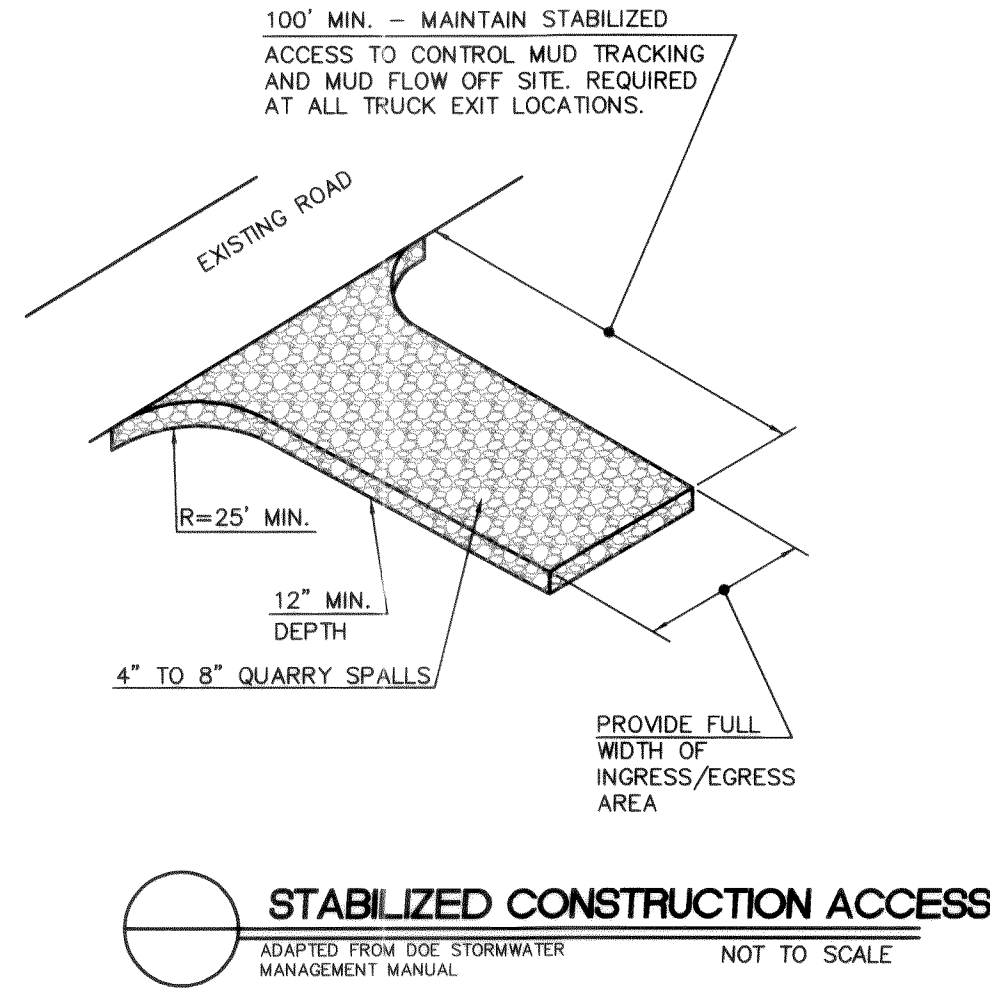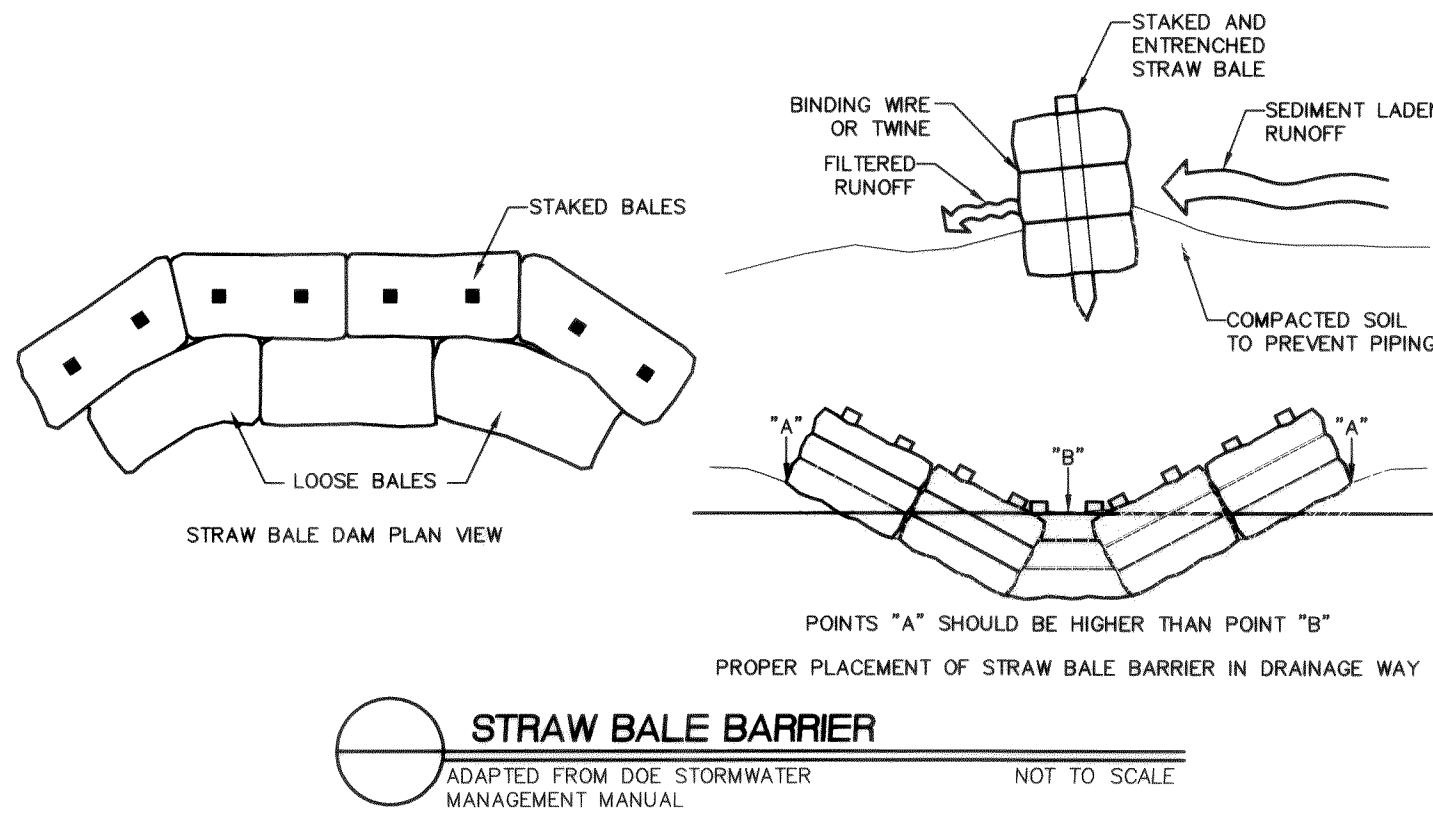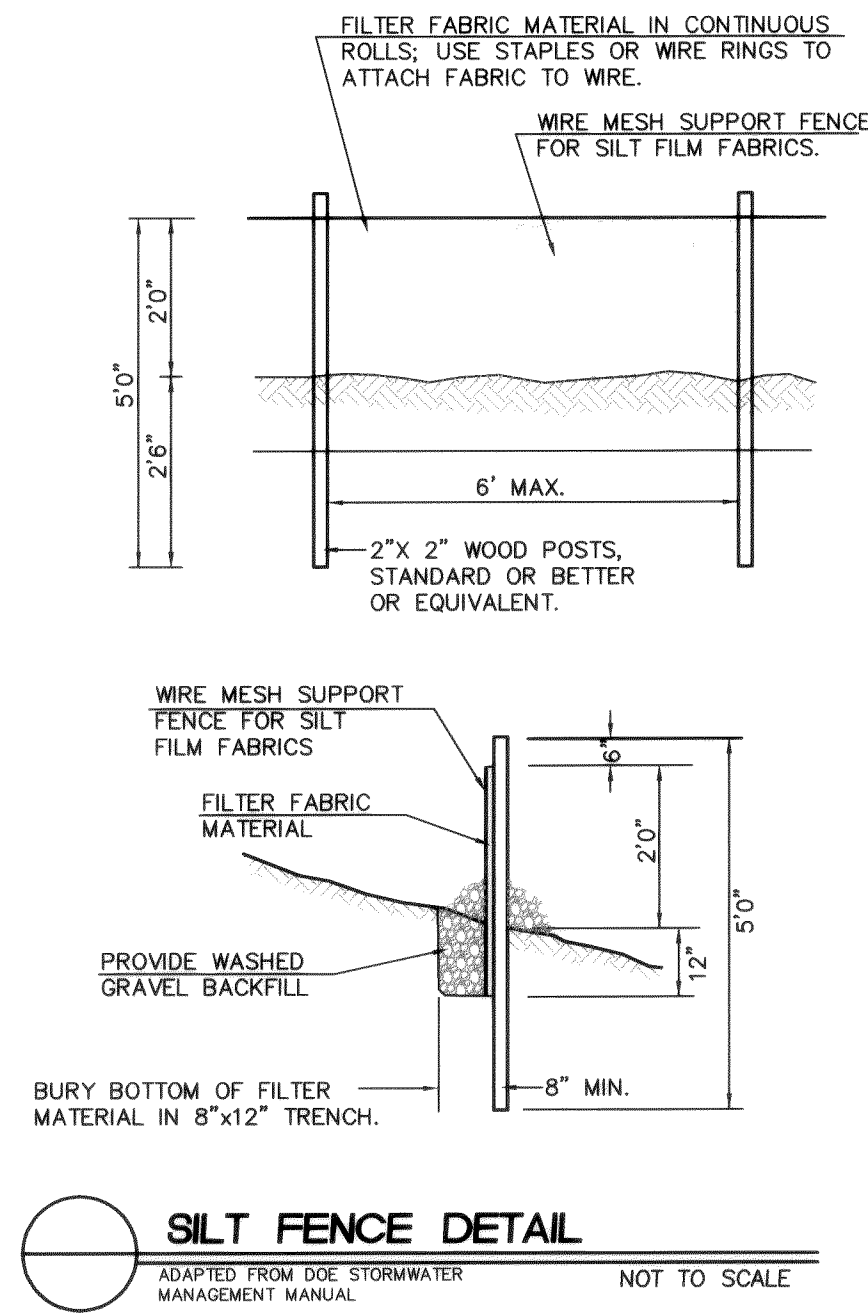

- NOTES:
1. EXCAVATE & SEED TEMPORARY DITCHES AND BASINS AS SOON AS POSSIBLE TO ENCOURAGE GRASS GROWTH PRIOR TO RELEASE OF STORM WATER TO BASINS. IF SEED NOT WELL ESTABLISHED, INSTALL STRAW BALE CHECK DAMS 50 FT ON CENTER IN ALL SWALES.
 2. VISTA DRIVE SHALL BE SWEEPED DAILY OR AS DEEMED NECESSARY BY THE CITY OF FERNDALE.
 3. PLACE FILTER FABRIC IN CATCH BASIN GRATES AT TIME OF INSTALLATION.
 4. EXPOSED AREAS TO BE SEEDED/HYDROSEEDED.

