


2-14-09 KR  
00150.00

SCALE: 1" = 50.0'

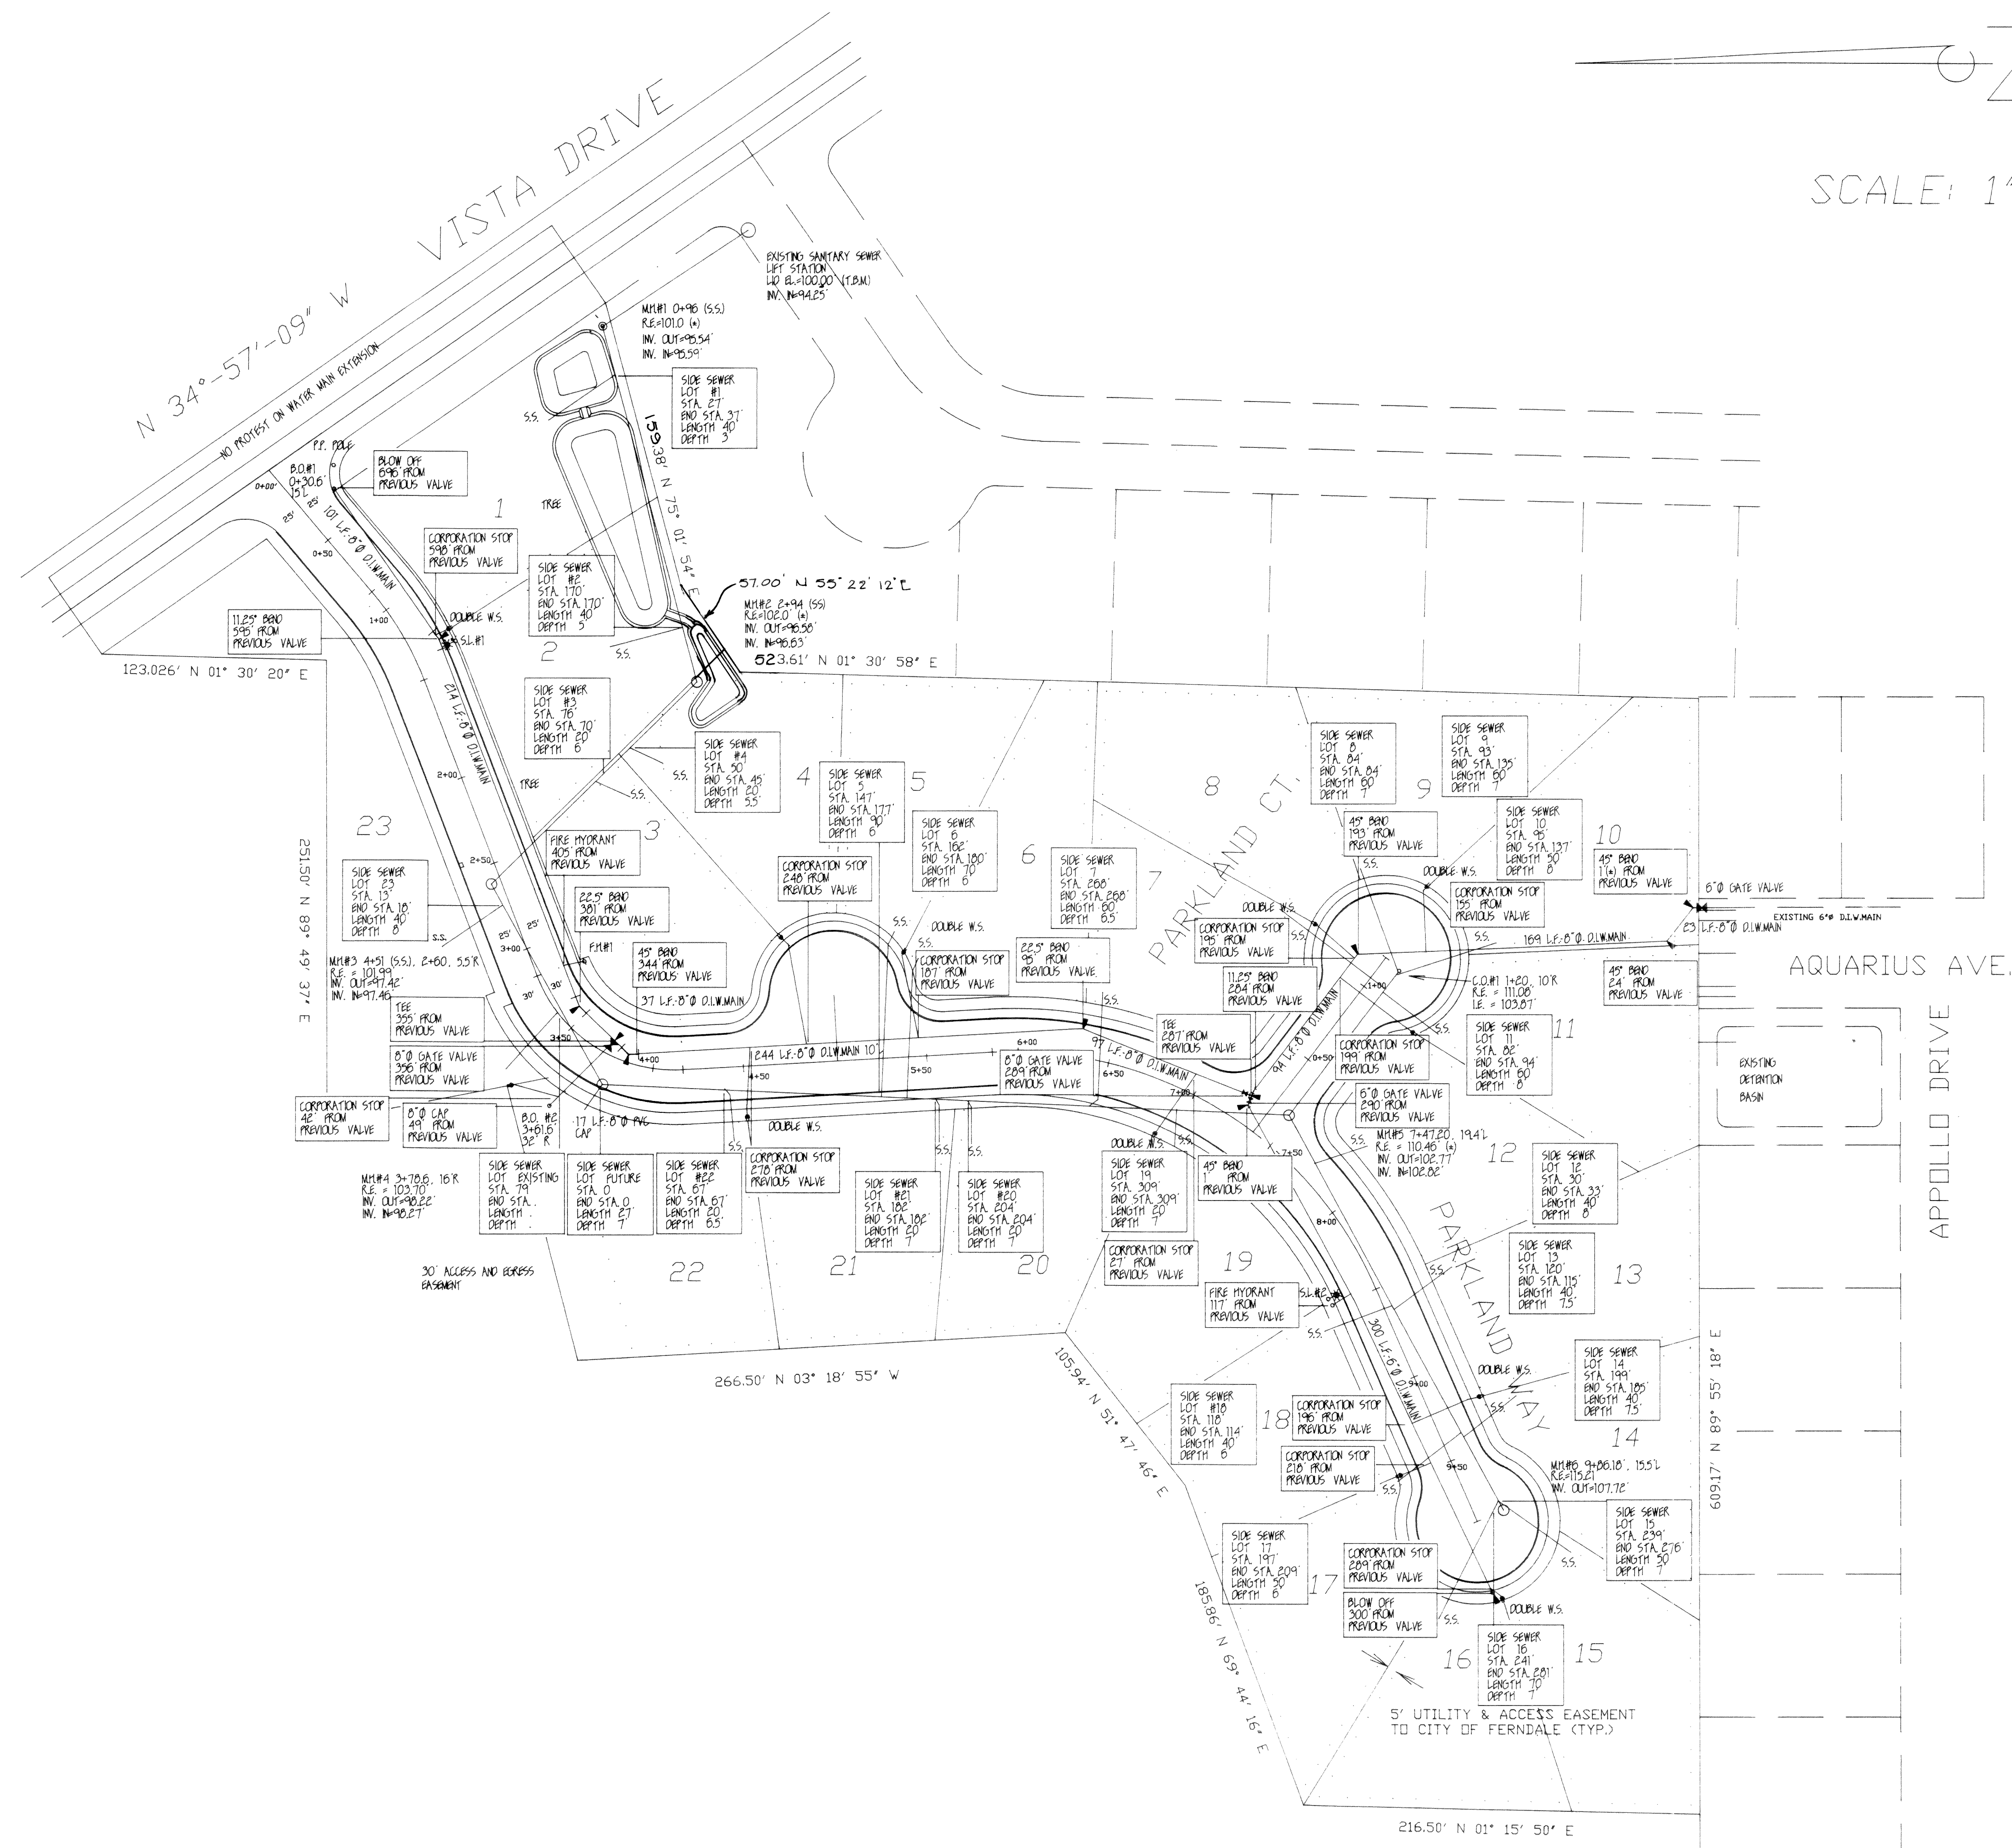

KEY TO AS-BUILT DATA:

SANITARY SEWER:

SIDE SEWER  
LOT 9  
STA. 93'  
END STA. 135'  
LENGTH 60'  
DEPTH 7'

LOT SERVED  
STATION OF SERVICE TEE AT MAIN \*  
STATION OF END OF SIDE SEWER \*  
LENGTH OF SIDE SEWER  
DEPTH AT END OF SIDE SEWER

\* MEASURED IN LINE WITH WATER MAIN FROM PREVIOUS DOWNHILL M.M.

WATER:

CORPORATION STOP  
199' FROM  
PREVIOUS VALVE

ITEM DESCRIPTION  
STATION OF ITEM MEASURED IN LINE WITH WATER MAIN \*  
POSITION OF 0+00

\* MEASURED IN DIRECTION OF FLOW

AS - BUILT DRAWING


BY: Greg Dibble  
DATE: 9/7/90



| JOHN FRIBERG     |              |              |
|------------------|--------------|--------------|
| SCALE: 1"=50'    | APPROVED BY: | DRAWN BY: KG |
| DATE: 4-22-90    |              |              |
| PARK MEADOW PLAT |              |              |
| PLAT PLAN        |              |              |
| DRAWING NUMBER:  |              | 26389 1/6    |




SCALE: 1" = 50.0'

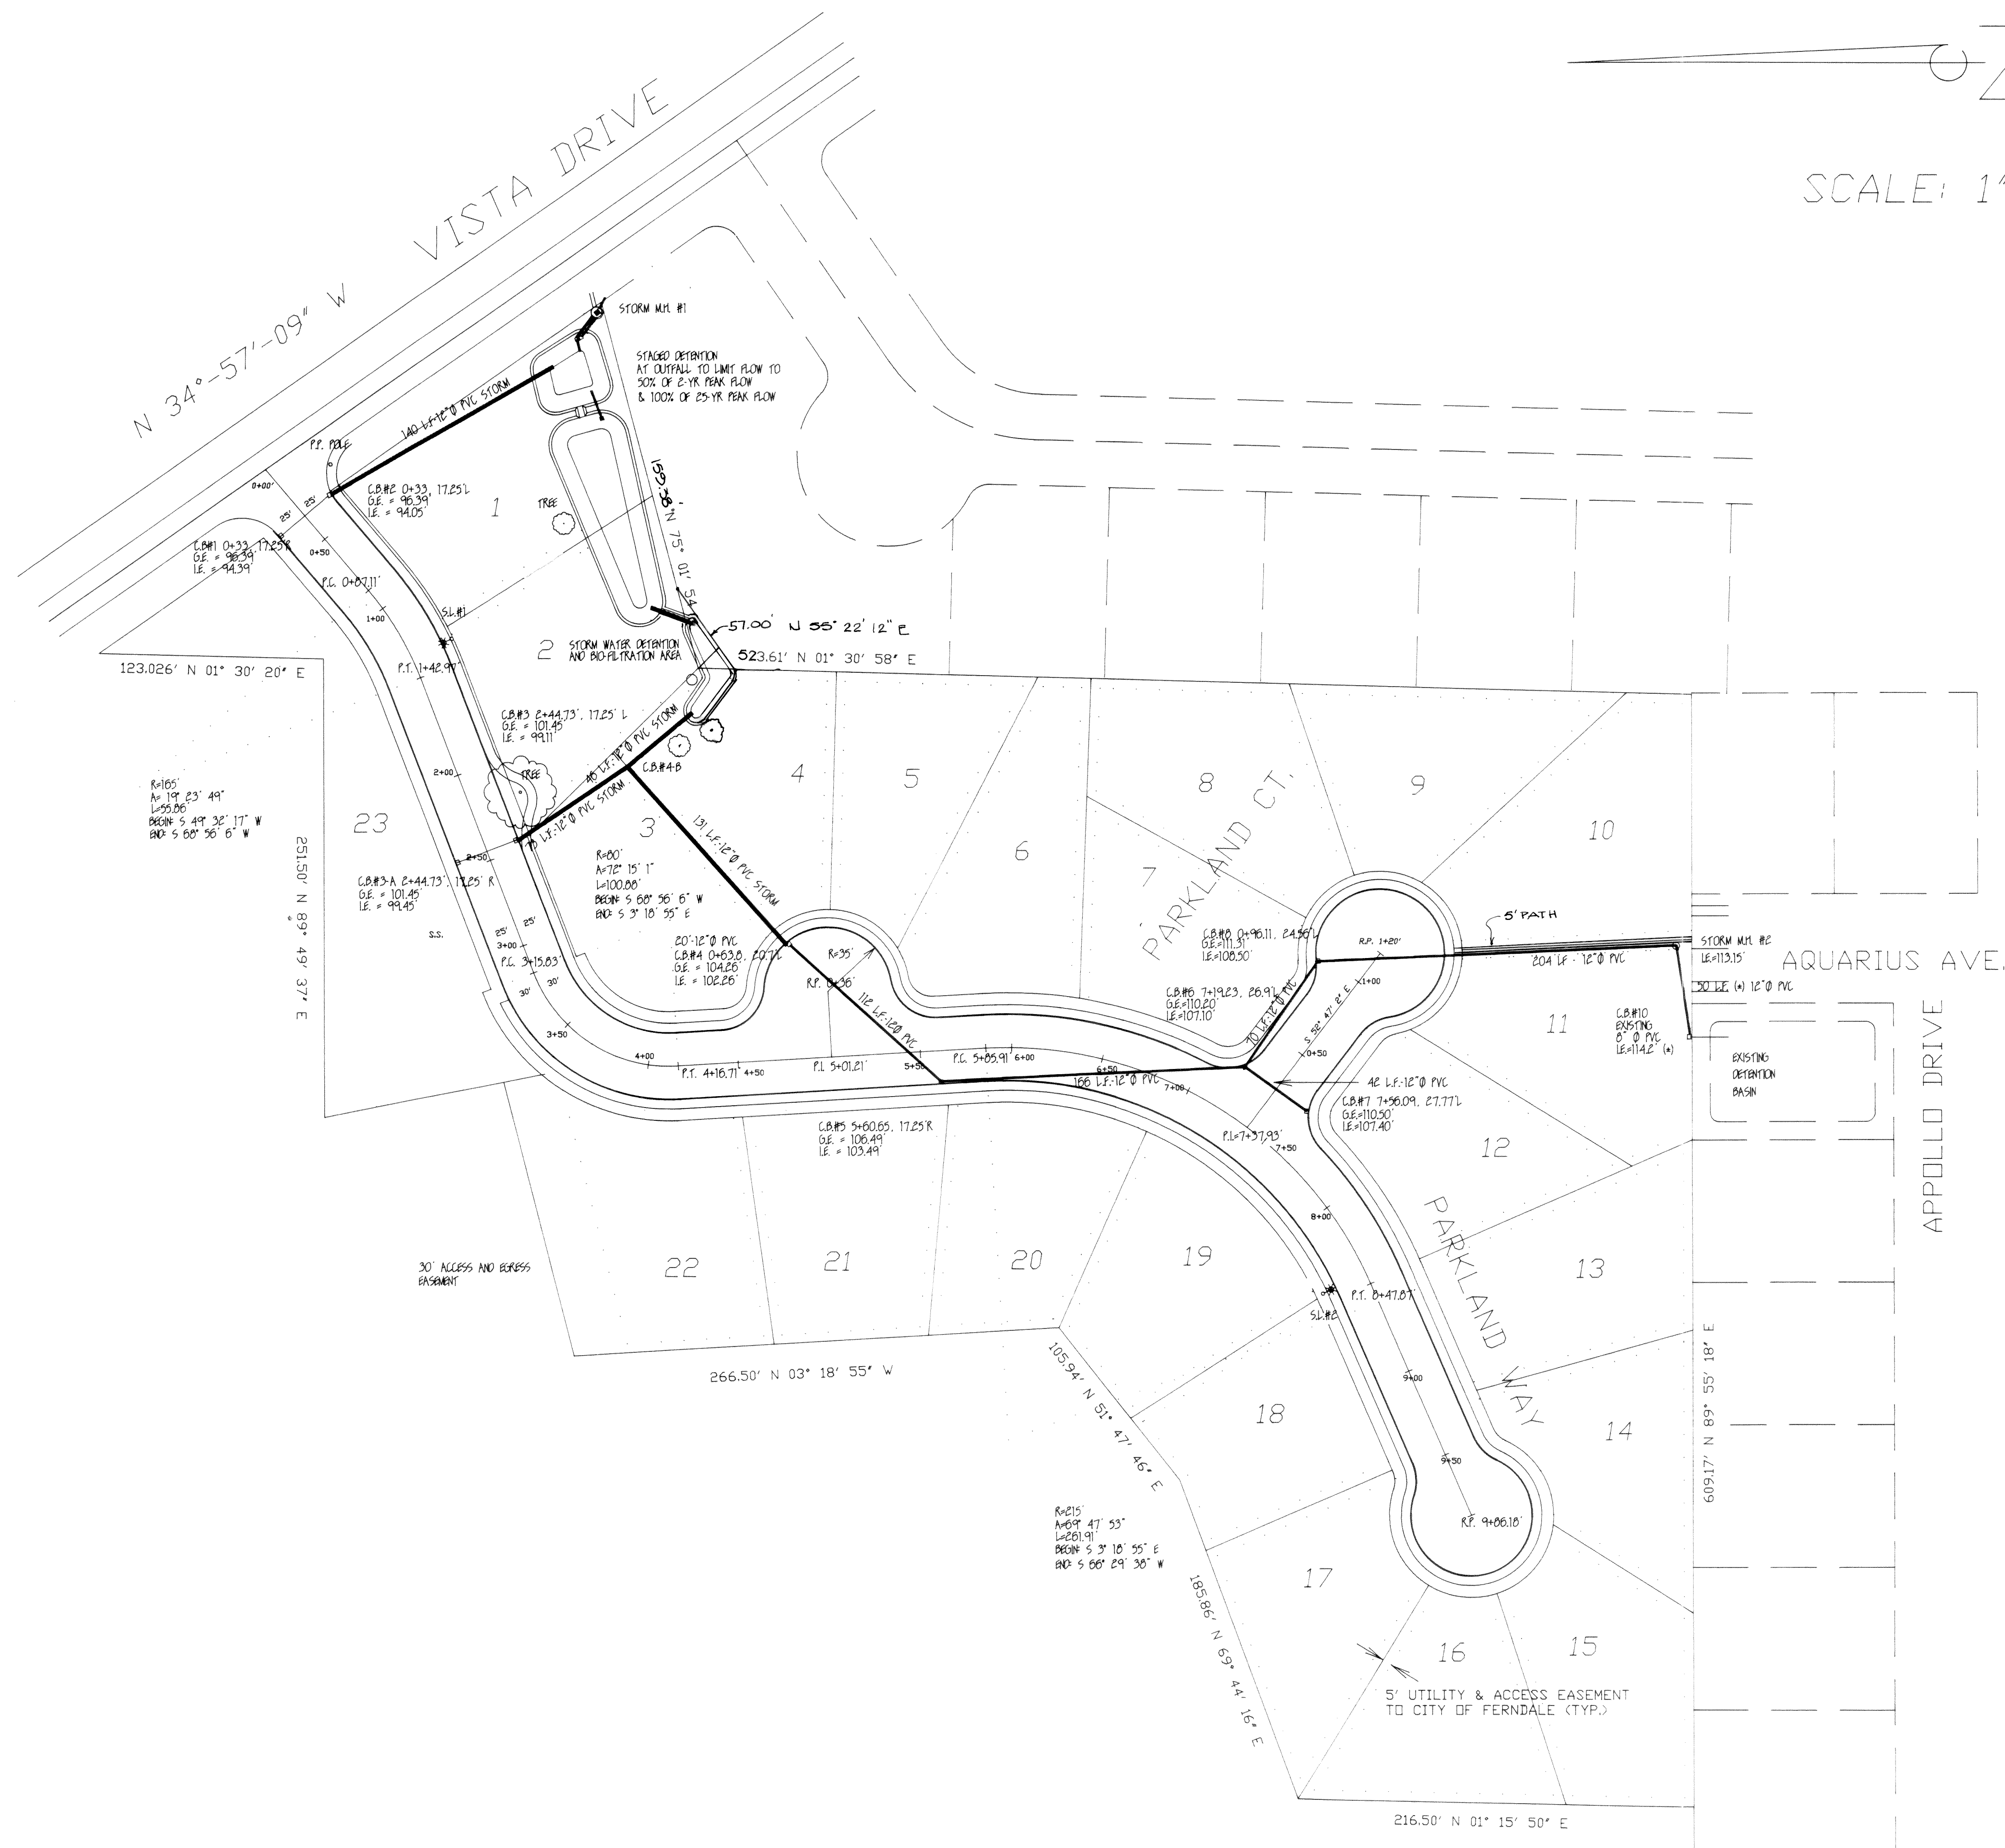

AS - BUILT DRAWING

BY: *Greg Wible*  
DATE: 9/7/90

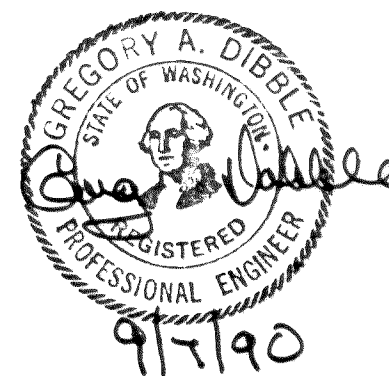

JOHN FRIBERG

|                          |              |              |
|--------------------------|--------------|--------------|
| SCALE: 1"=50'            | APPROVED BY: | DRAWN BY: JG |
| DATE: 4-22-90            |              | REVISED:     |
| PARK MEADOW PLAT         |              |              |
| PLAT PLAN                |              |              |
| DRAWING NUMBER 26389 1/6 |              |              |