


PLAN	DATE	BY
SURVEYED		
NOTED		
ALIGNED		
CHECKED		
NO.		



PROFILE	DATE	BY
SURVEYED		
NOTED		
ALIGNED		
CHECKED		
NO.		

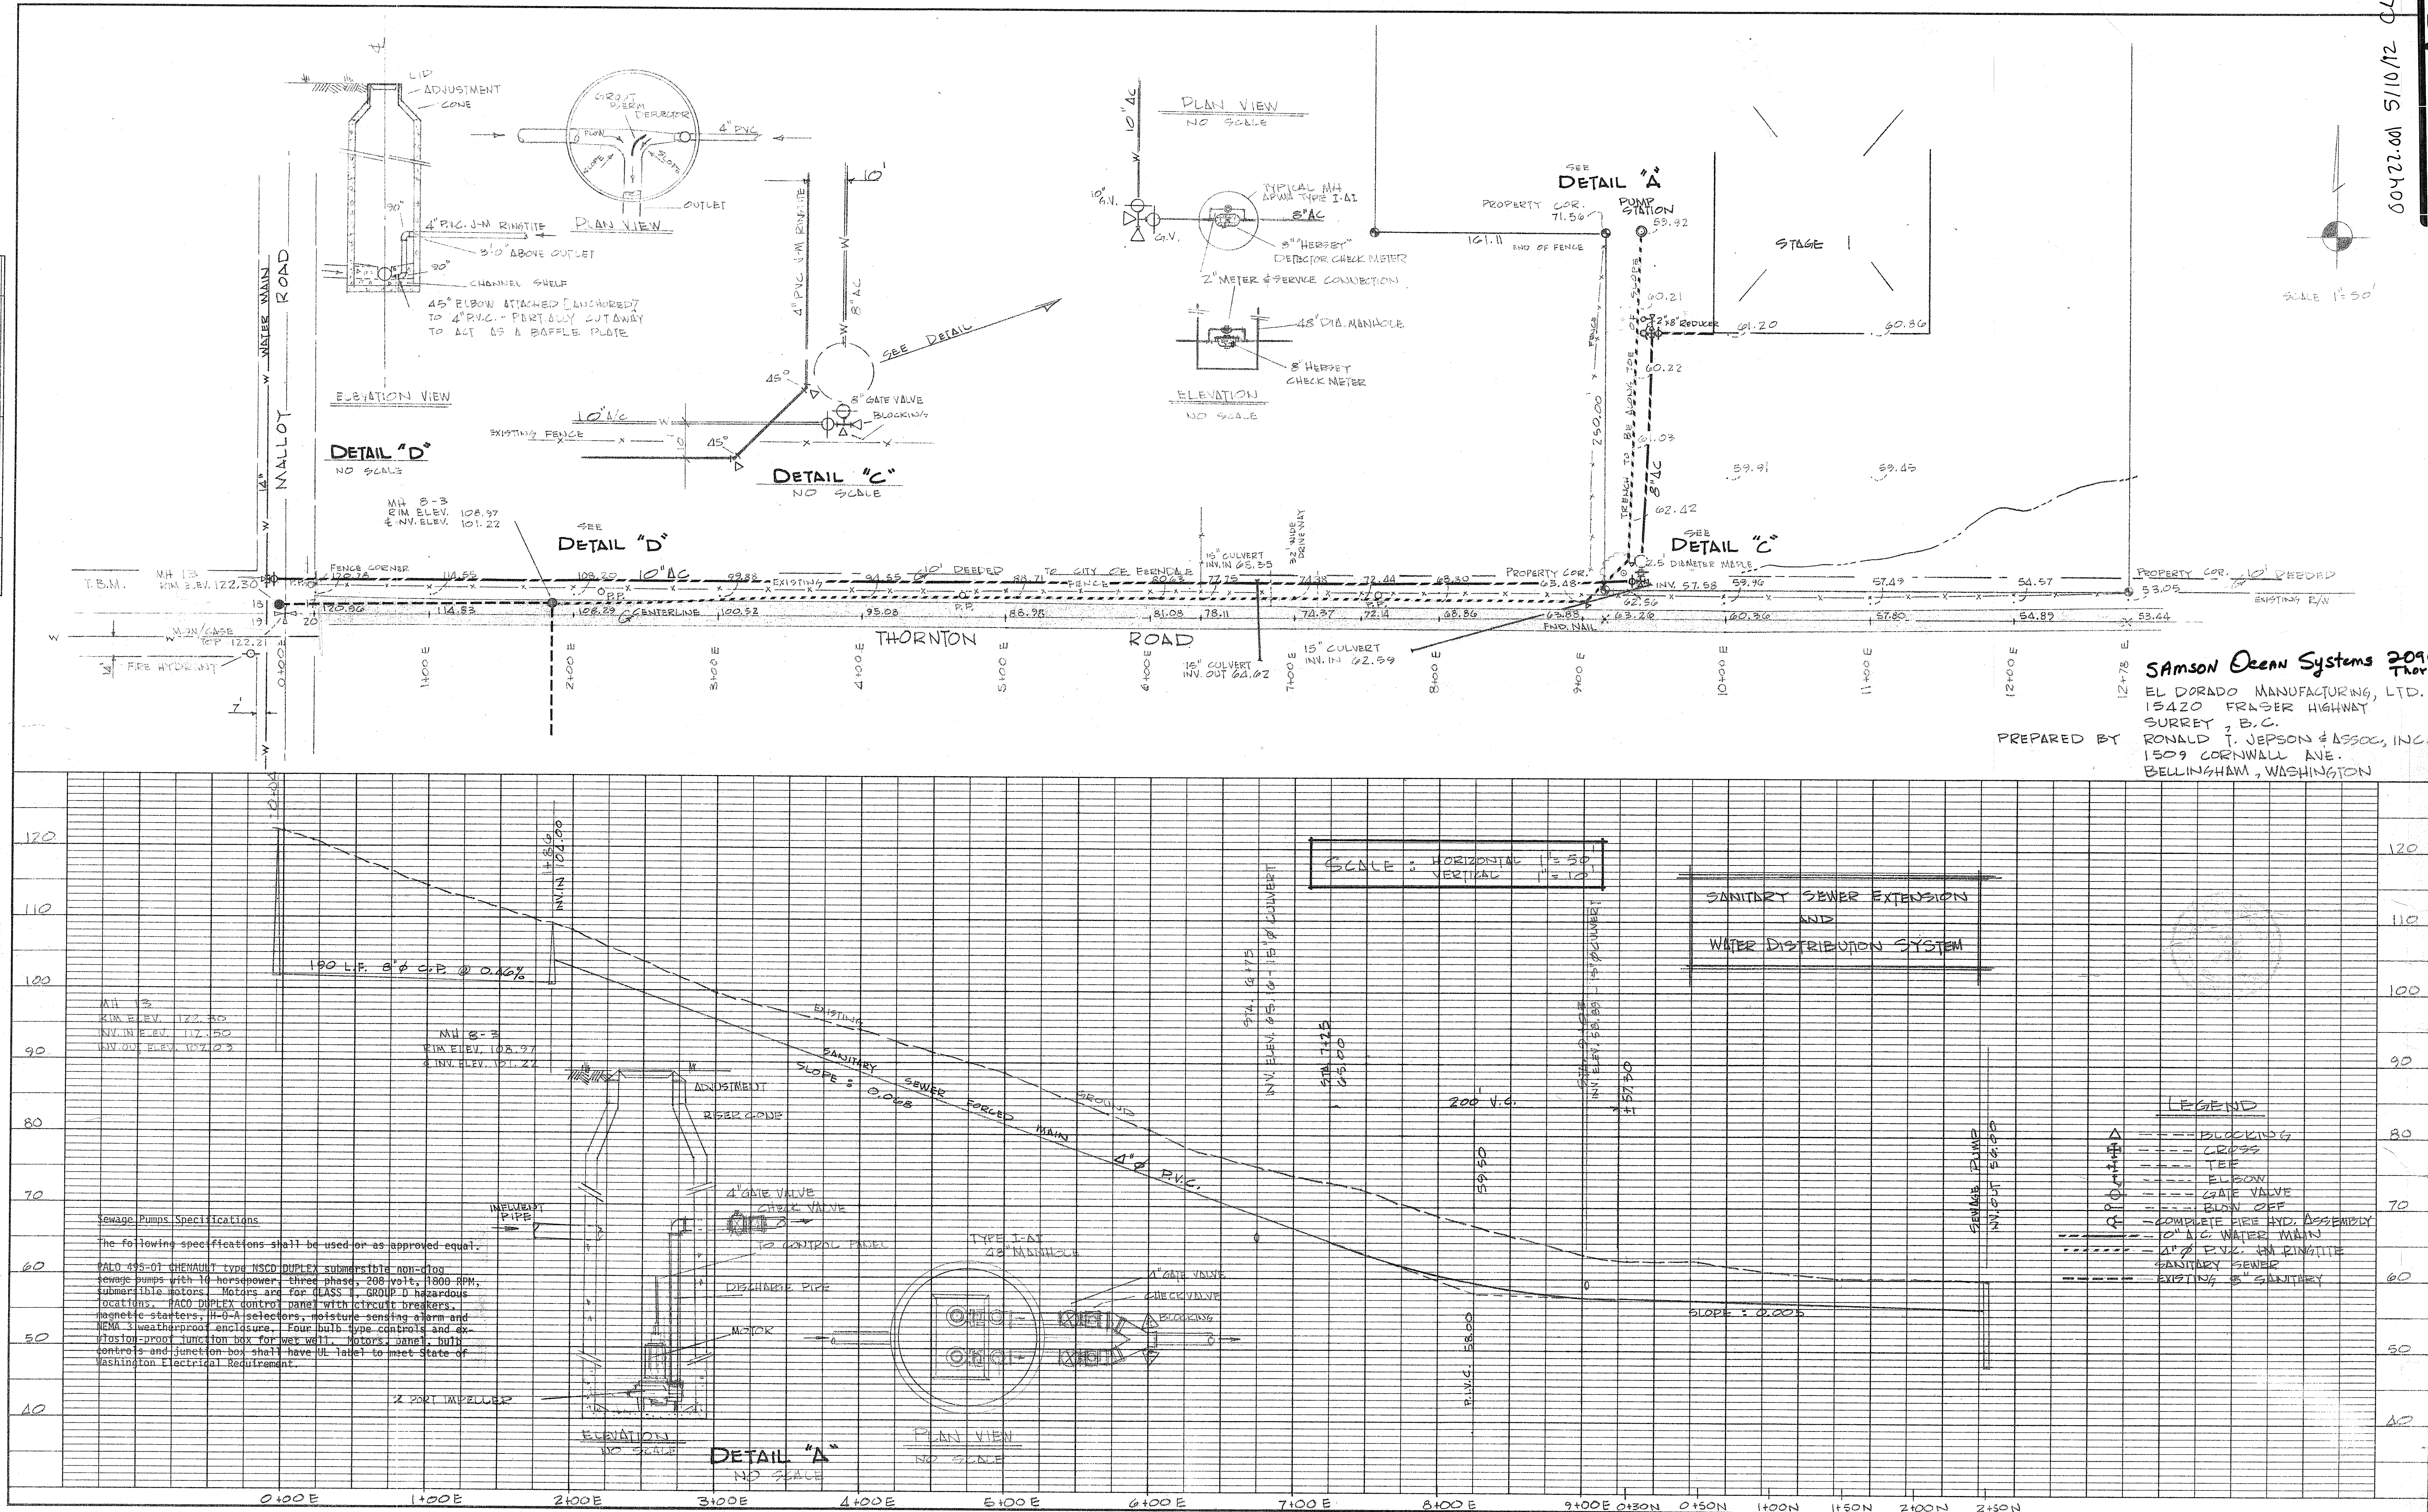

SAMSON Ocean Systems 2090 Thornton Rd.
EL DORADO MANUFACTURING, LTD.
15420 FRASER HIGHWAY
SURREY, B.C.
PREPARED BY: RONALD J. JEPSON & ASSOC., INC.
1509 CORNWALL AVE.
BELLINGHAM, WASHINGTON

PROFILE			DATE
SURVEYED	BY		
DESIGNED			
CHECKED			
NOTED			
NO.			
STRUCTURE NO. 1000000000			

PLAN			DATE
SURVEYED	BY		
DESIGNED			
CHECKED			
NOTED			
NO.			
STRUCTURE NO. 1000000000			

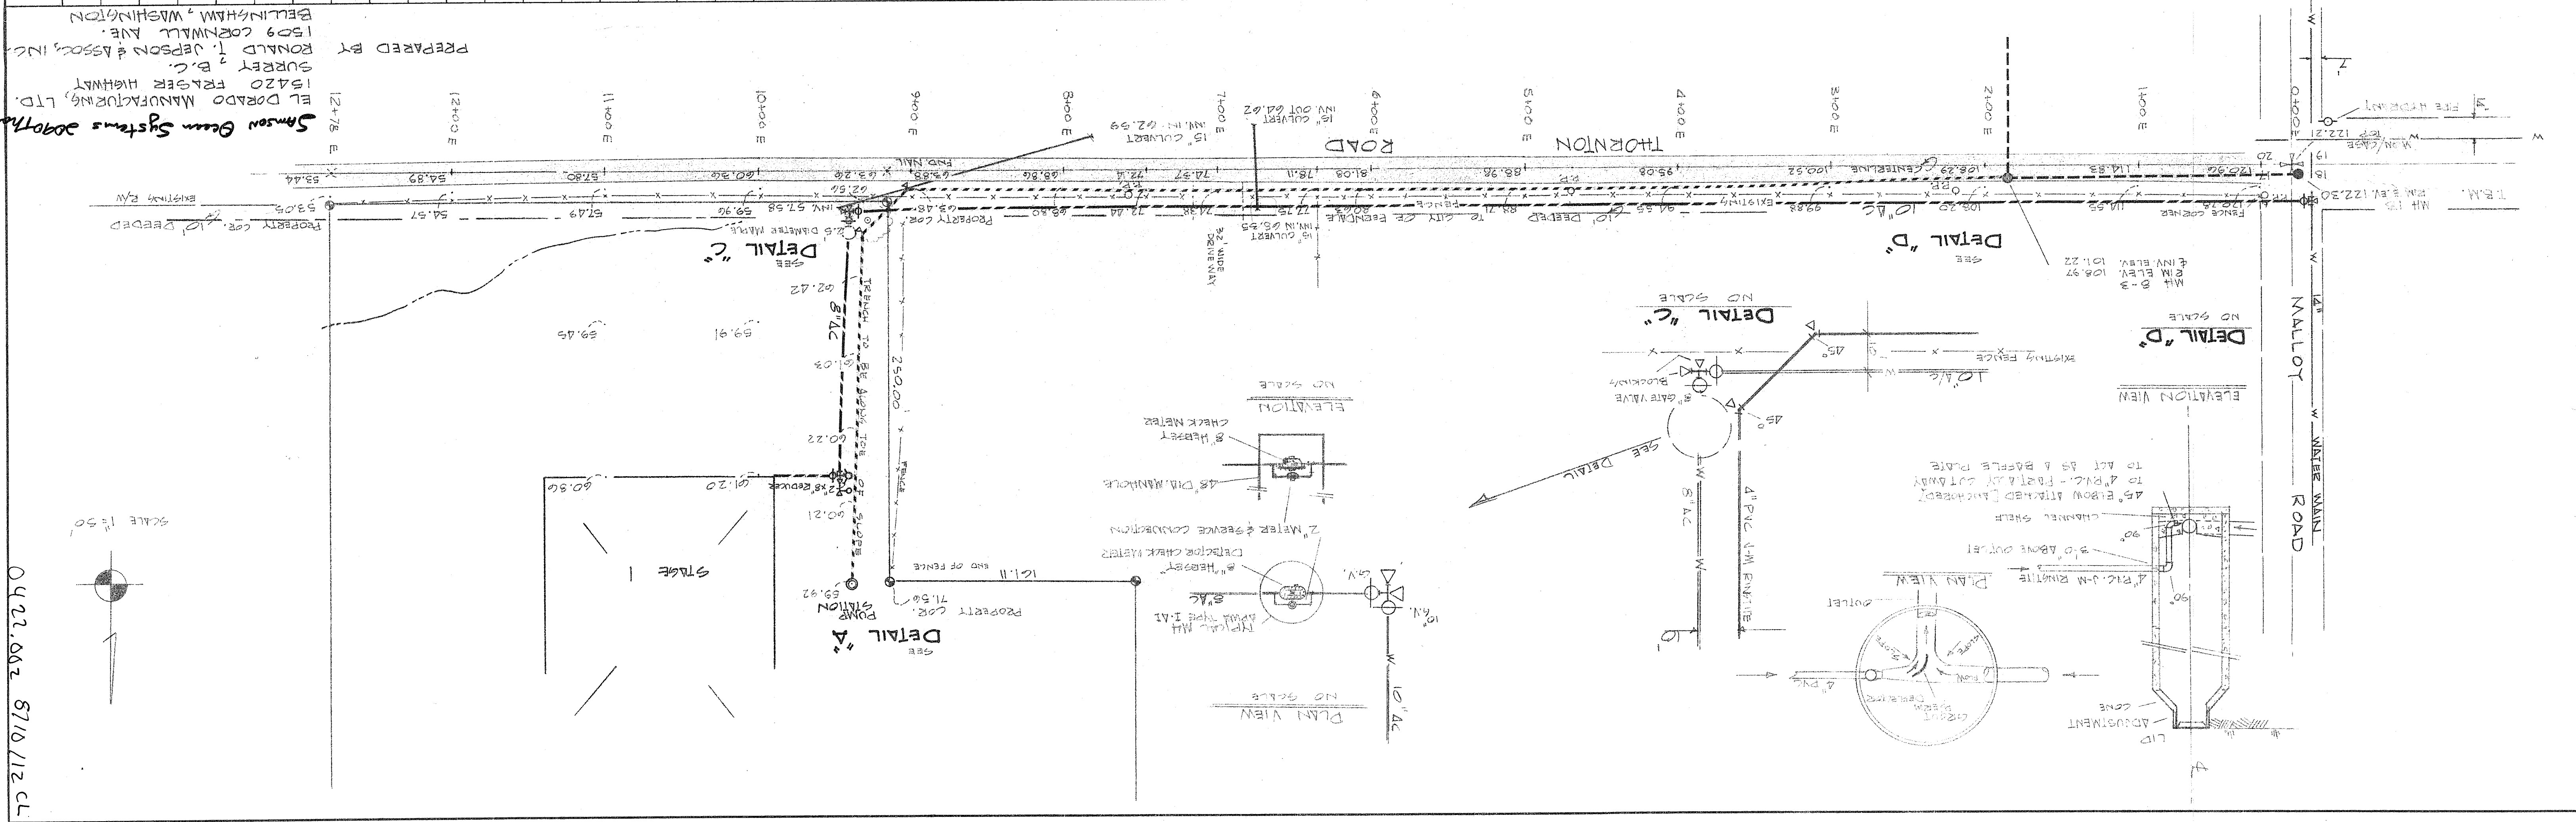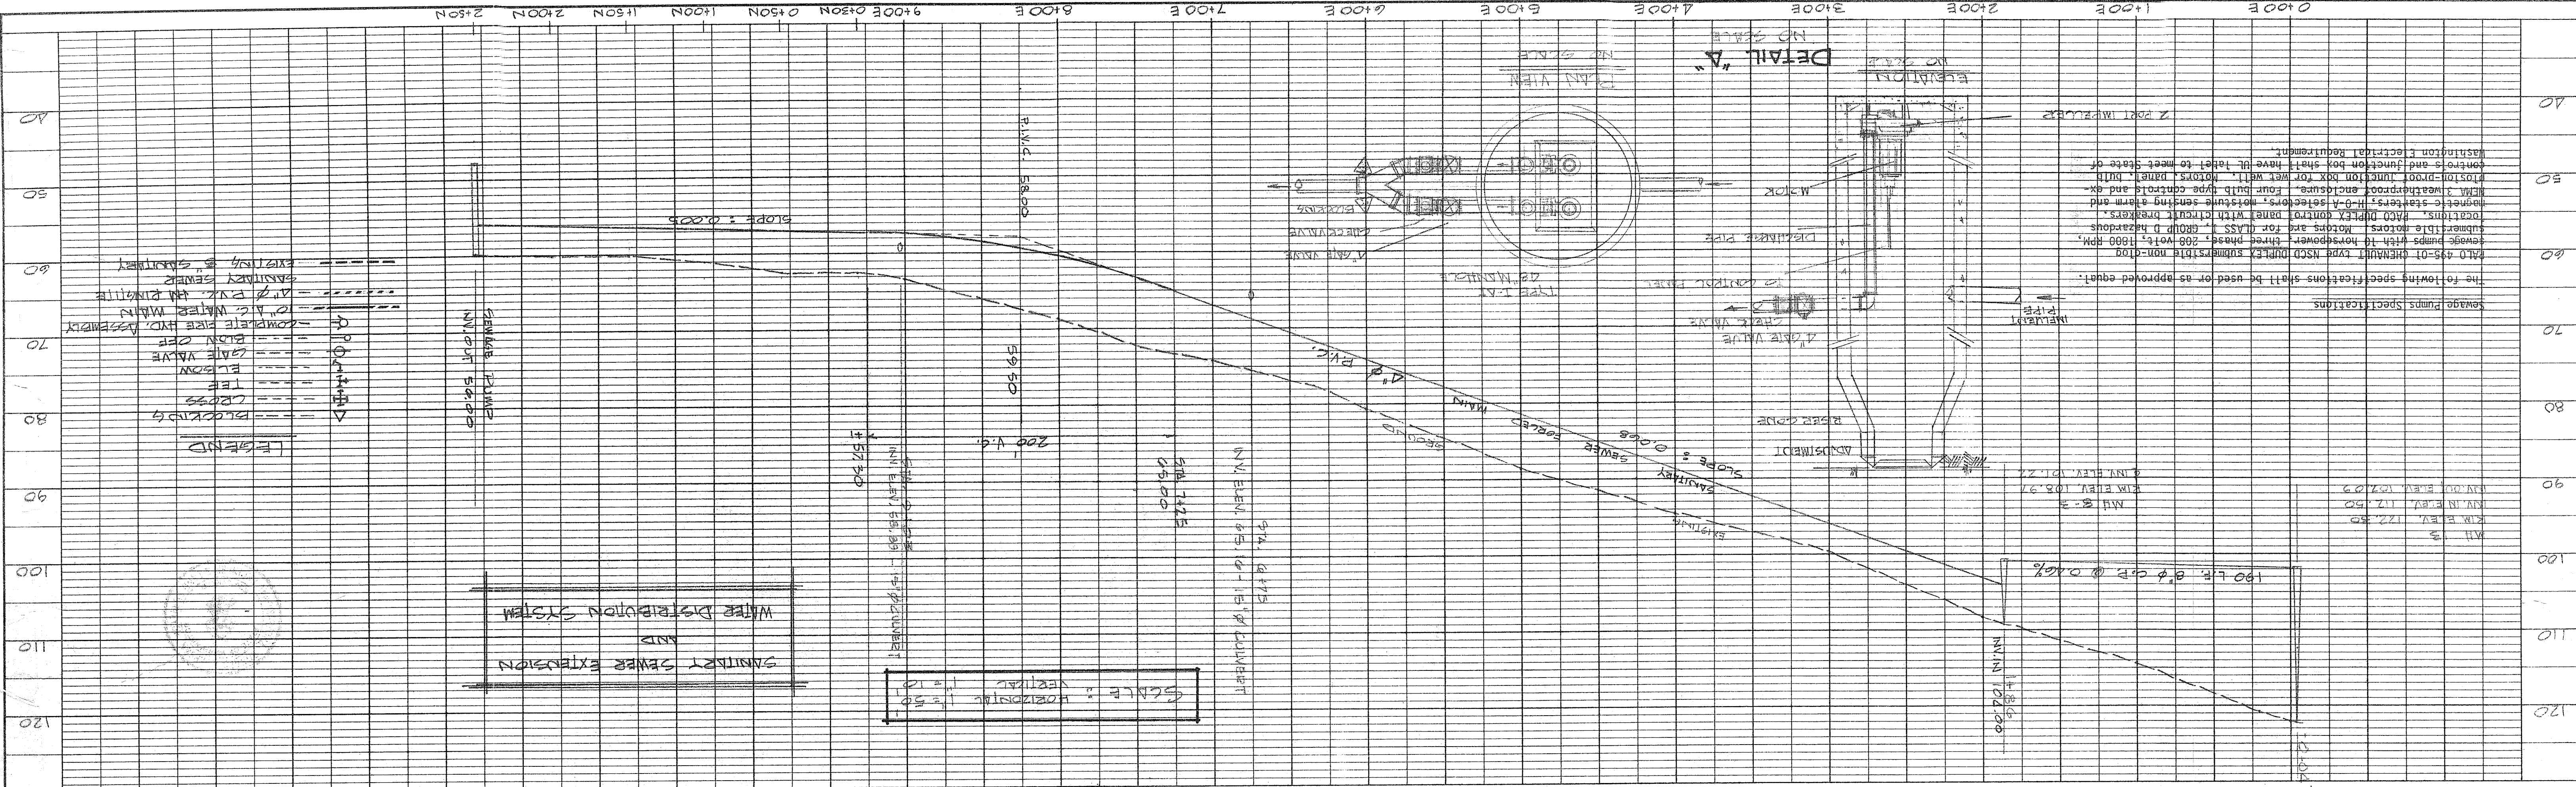

Job No. 76003

K&E
K&E ENGINEERING
K&E ENGINEERING
K&E ENGINEERING

Sanborn Ocean Systems 3000000000

EL DORADO MANUFACTURING, LTD.

15420 FRASER HIGHWAY

SURREY, B.C.

PREPARED BY RONALD T. JEPSON & ASSOC., INC.

1509 CORNWALL AVE.

BELLINGHAM, WASHINGTON

SCALE 1"=50'

0422.002 6110/12 CL