


VISTA MIDDLE SCHOOL

VISTA DRIVE

I HEREBY CERTIFY THAT THE IMPROVEMENTS IN THE FERDALE SCHOOL DISTRICT ADMINISTRATION BUILDING PROJECT HAVE BEEN INSPECTED BY DAVID EVANS AND ASSOCIATES, INC. AND CONSTRUCTED IN CONFORMANCE WITH THE PLANS APPROVED BY THE PUBLIC WORKS DIRECTOR FOR SAID DEVELOPMENT AND THE GENERAL SPECIFICATIONS ADOPTED BY THE CITY OF FERDALE DEPARTMENT OF PUBLIC WORKS.

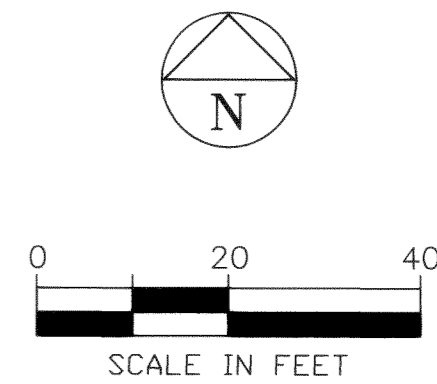

FERDALE SCHOOL DIST. NO. 502
ADMINISTRATION BUILDING ADDITION
AS-BUILT DRAWINGS

PROJECT NUMBER:
FPSX0009

DATE: 5/04/02
DESIGN: KADE
DRAWN: KADE
CHECKED:

SCALE: 1"=20'

SHEET NO.

1

OF 1



DAVID EVANS
AND ASSOCIATES, INC.
119 Grand Avenue, Suite D
Bellingham, Washington 98225
Phone: 360.647.7151
Fax: 360.647.7160



APPROVED

MAY 13 2002
BY *[Signature]*
CITY OF FERDALE

NO. REVISIONS:

EXPRES 6-30-03

APPD.

000.8.001 2.7.00 *[Signature]*