




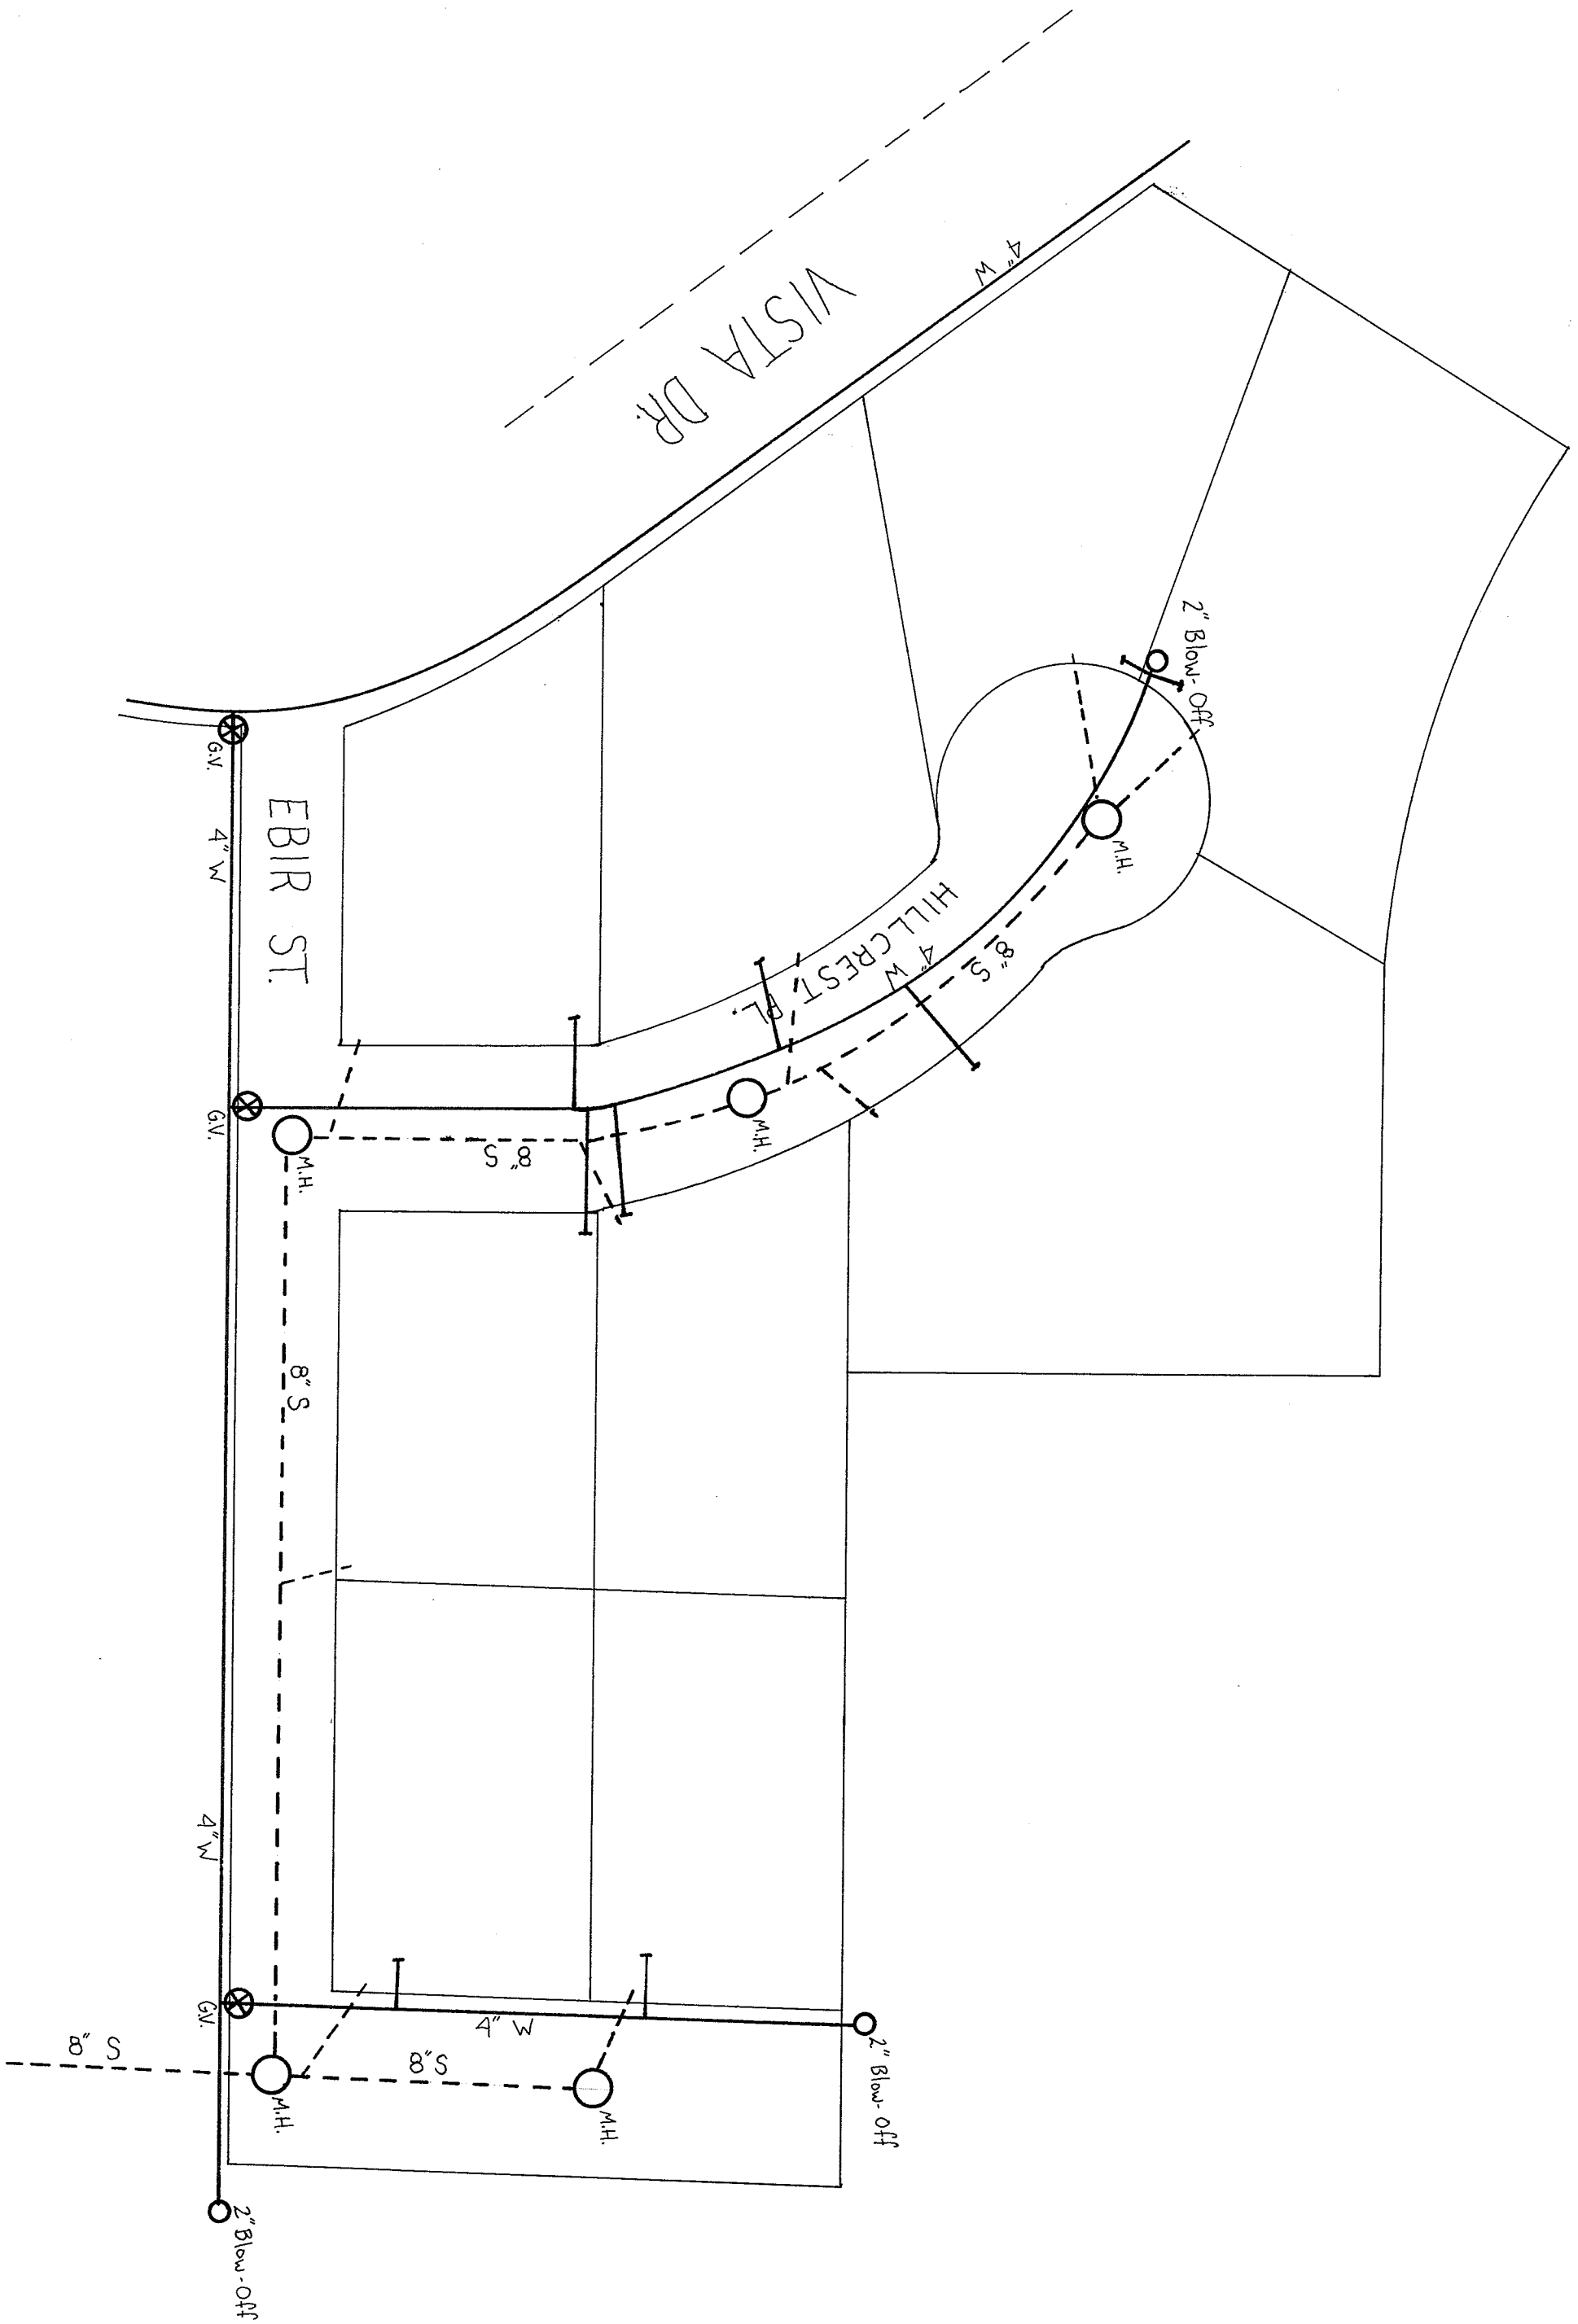

HILLCREST PLAT

1" = 50'

N

EBIR STREET

B2 B2

Ebir Street