


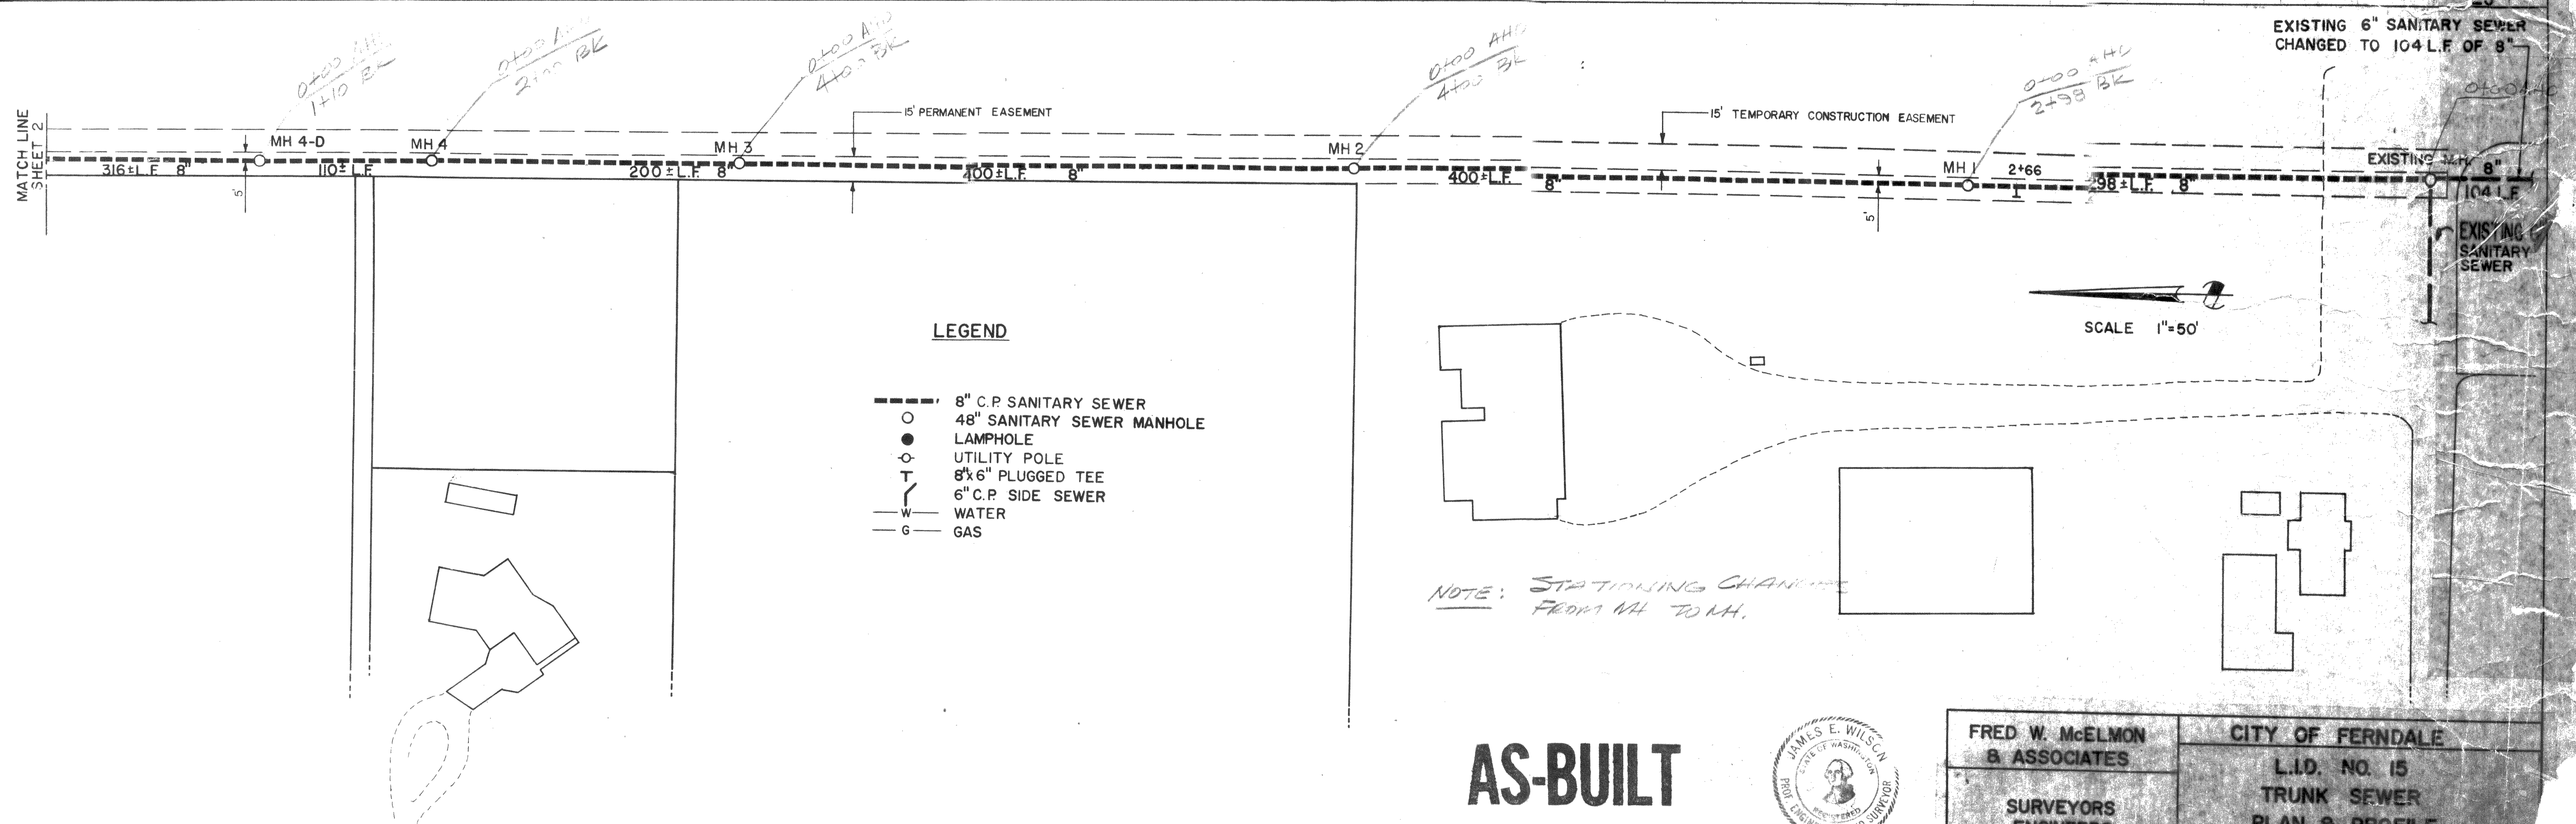
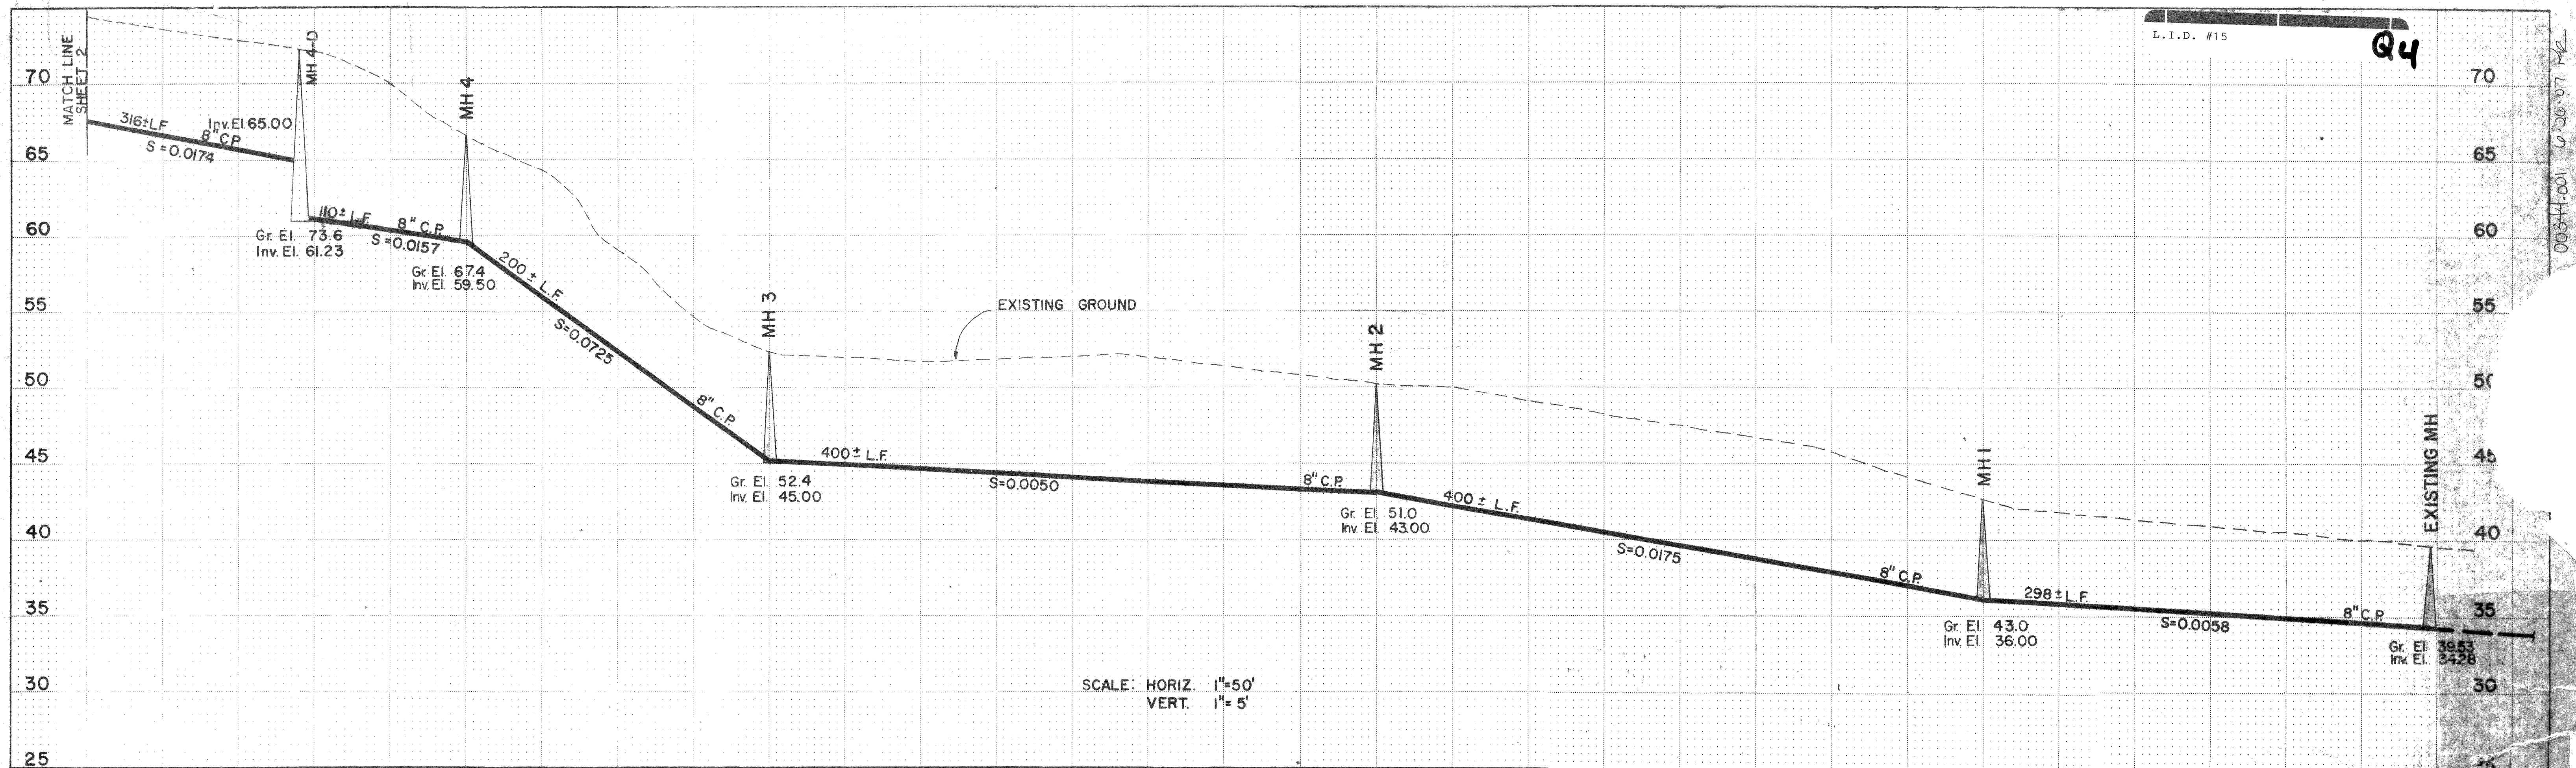


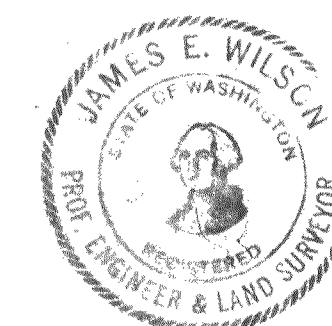

**AS-BUILT**

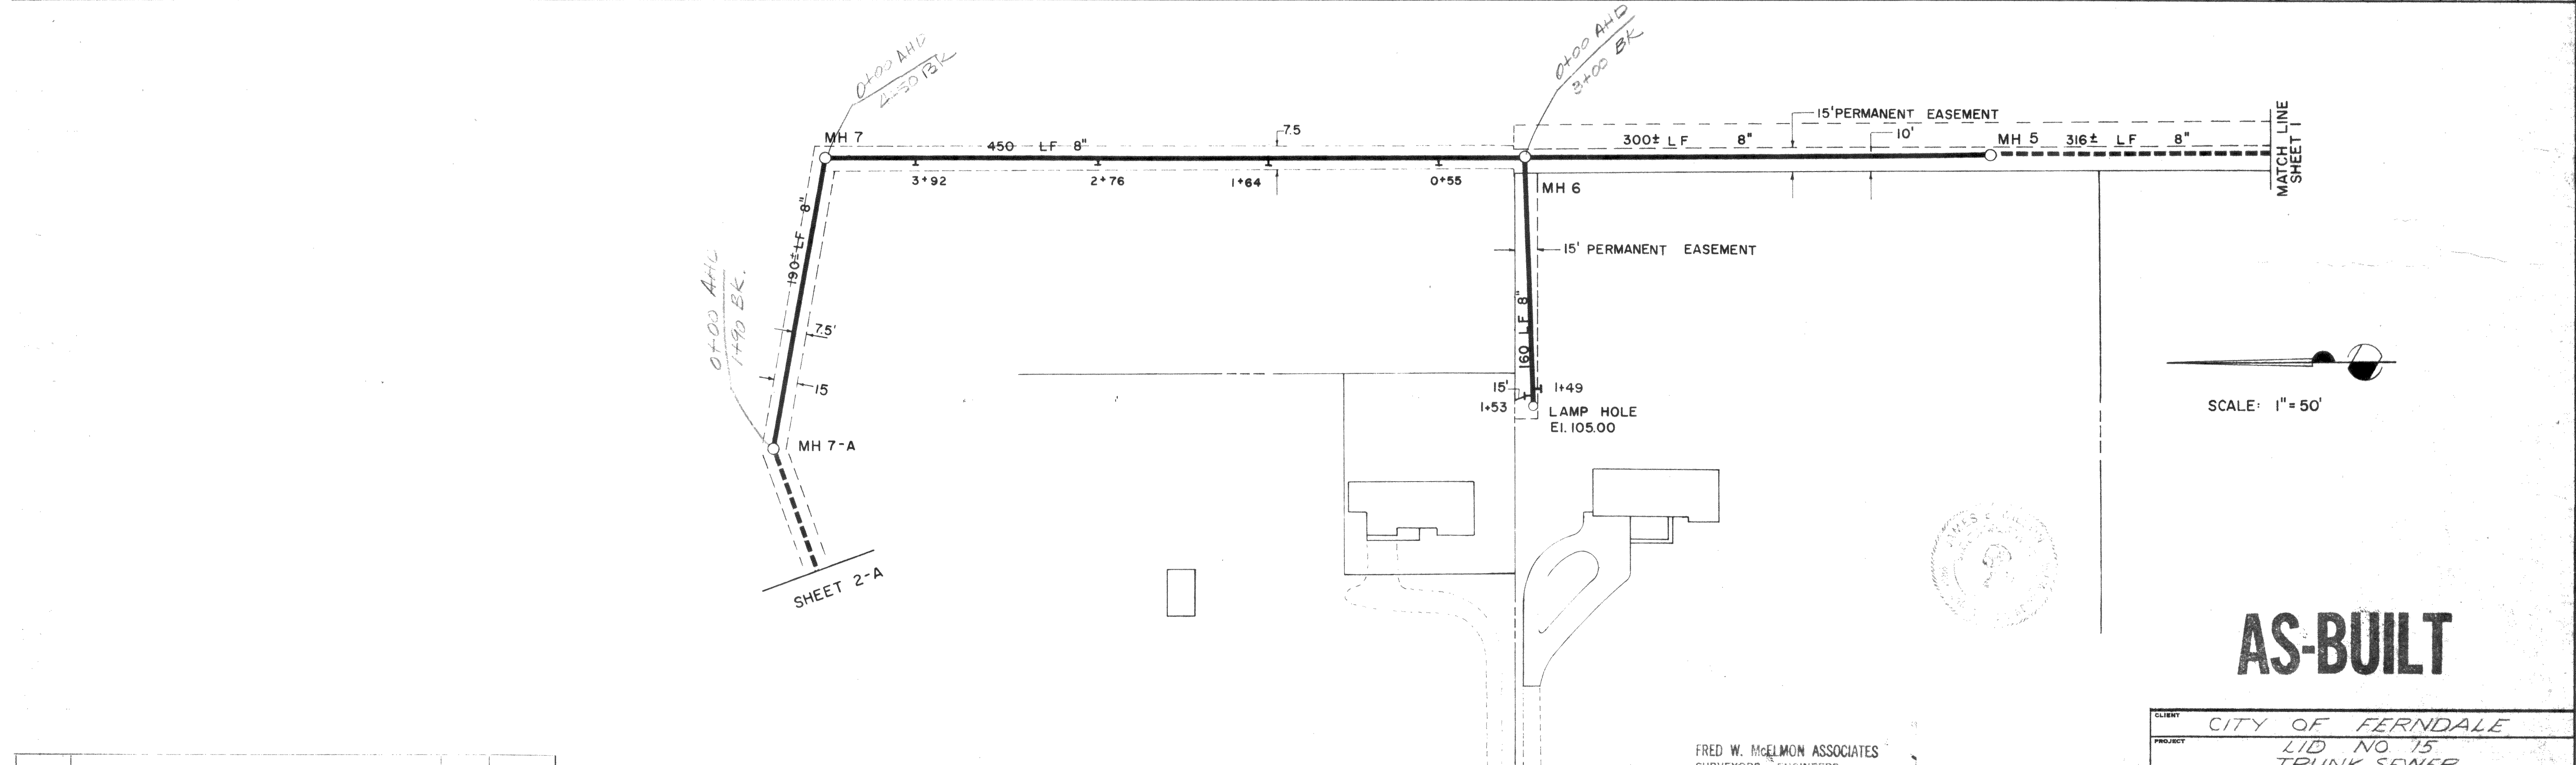

|                                 |                 |              |              |    |
|---------------------------------|-----------------|--------------|--------------|----|
| FRED W. McELMON<br>& ASSOCIATES | CITY OF FERDALE |              |              |    |
|                                 | L.I.D. NO. 15   |              |              |    |
| SURVEYORS<br>ENGINEERS          | TRUNK SEWER     |              |              |    |
|                                 | PLAN & PROFILE  |              |              |    |
| Drawn by G.R.N.                 | Checked by C.A. | Scale 1"=50' | Sheet 1 of 1 |    |
| Project                         | NOTED           | 20           | 300          | 20 |

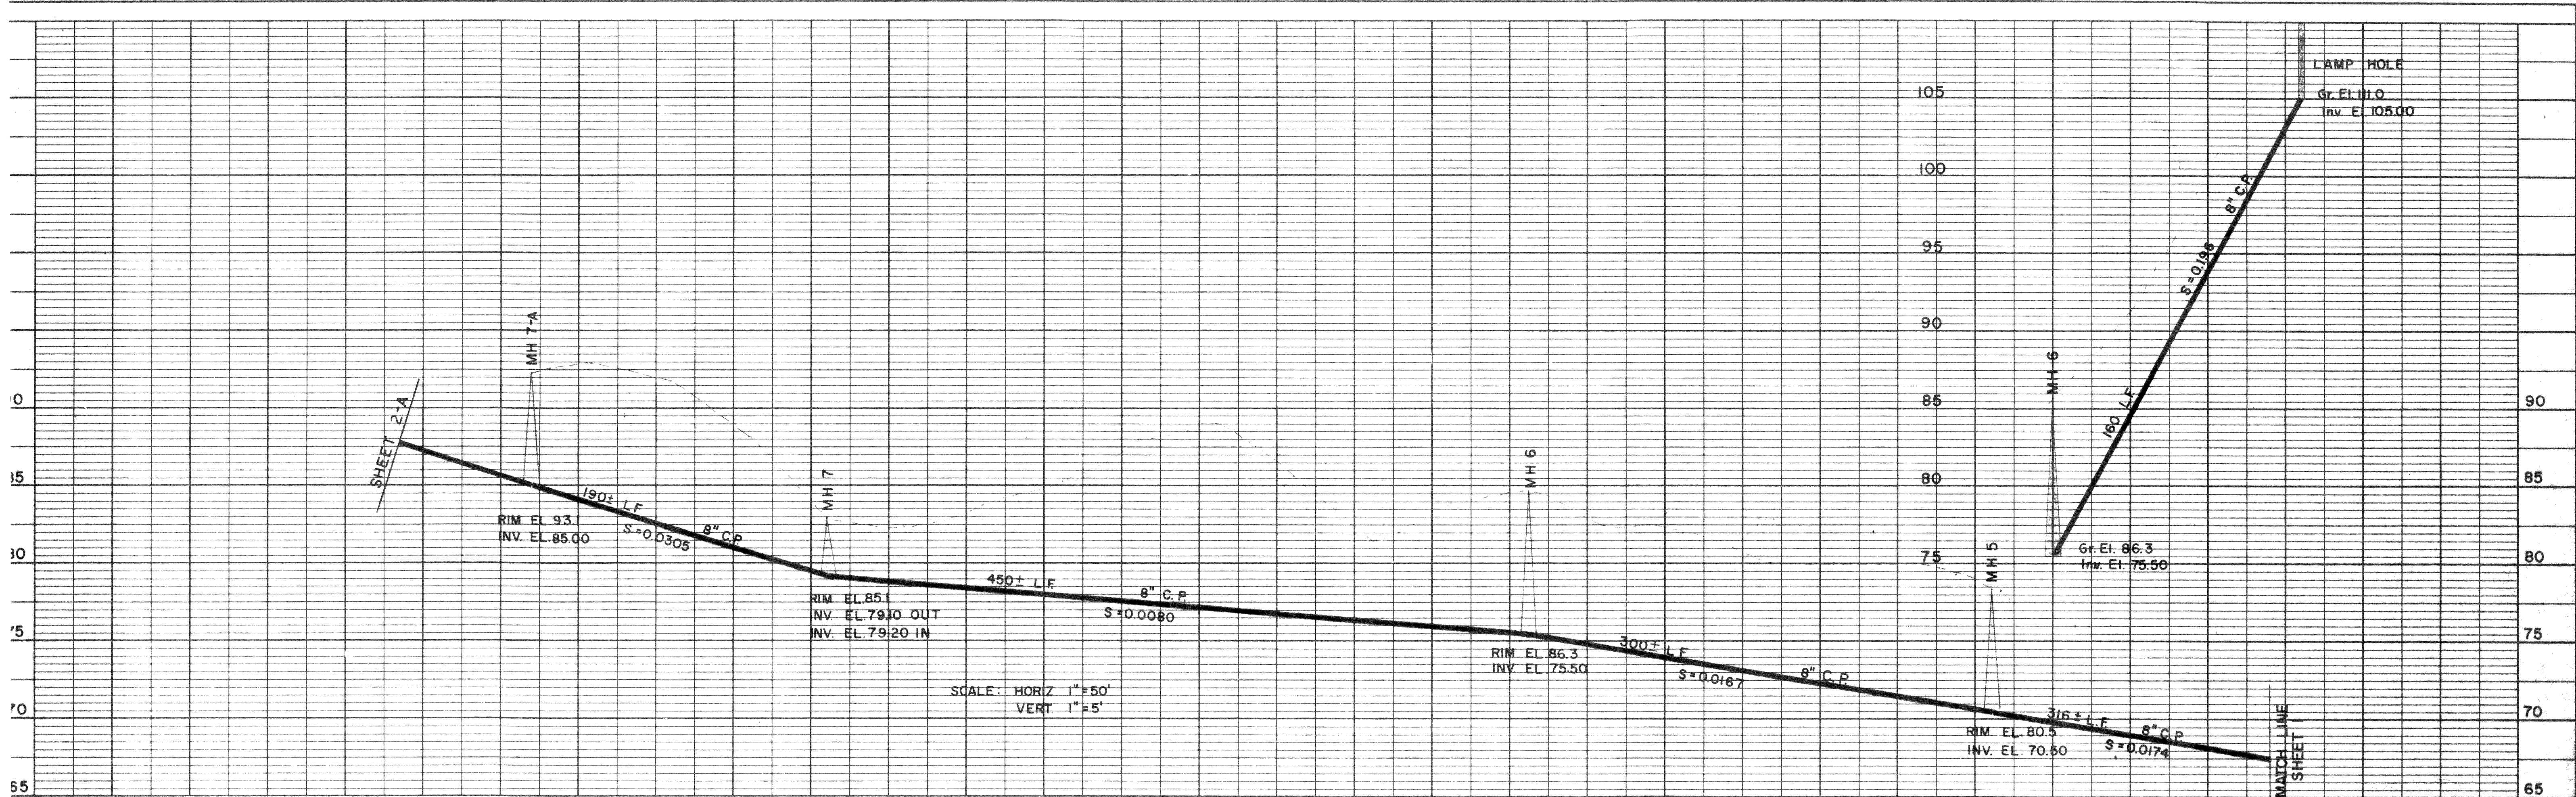

| REVISIONS | DATE | APPROVAL |
|-----------|------|----------|
|           |      |          |
|           |      |          |
|           |      |          |

FRED W. McELMOM ASSOCIATES  
SURVEYORS - ENGINEERS  
610 HERALD BUILDING  
BELLINGHAM, WASHINGTON 98225


|          |                                             |         |          |
|----------|---------------------------------------------|---------|----------|
| CLIENT   | CITY OF FERNDALE                            |         |          |
| PROJECT  | LID NO. 15<br>TRUNK SEWER<br>PLAN & PROFILE |         |          |
| DRAWN BY | DD                                          | SCALE   | NOTED    |
| APPROVED | DATE 12-15-09                               | P. BOOK | FOR 8867 |

AS-BUILT

|           |      |
|-----------|------|
| PROFILE   | DATE |
| NO. 1     |      |
| DATE      |      |
| BY        |      |
| REVISIONS |      |
|           |      |
|           |      |
|           |      |


|           |      |
|-----------|------|
| PLAN      | DATE |
| NO. 1     |      |
| DATE      |      |
| BY        |      |
| REVISIONS |      |
|           |      |
|           |      |
|           |      |

00344.002 6-26-07 42

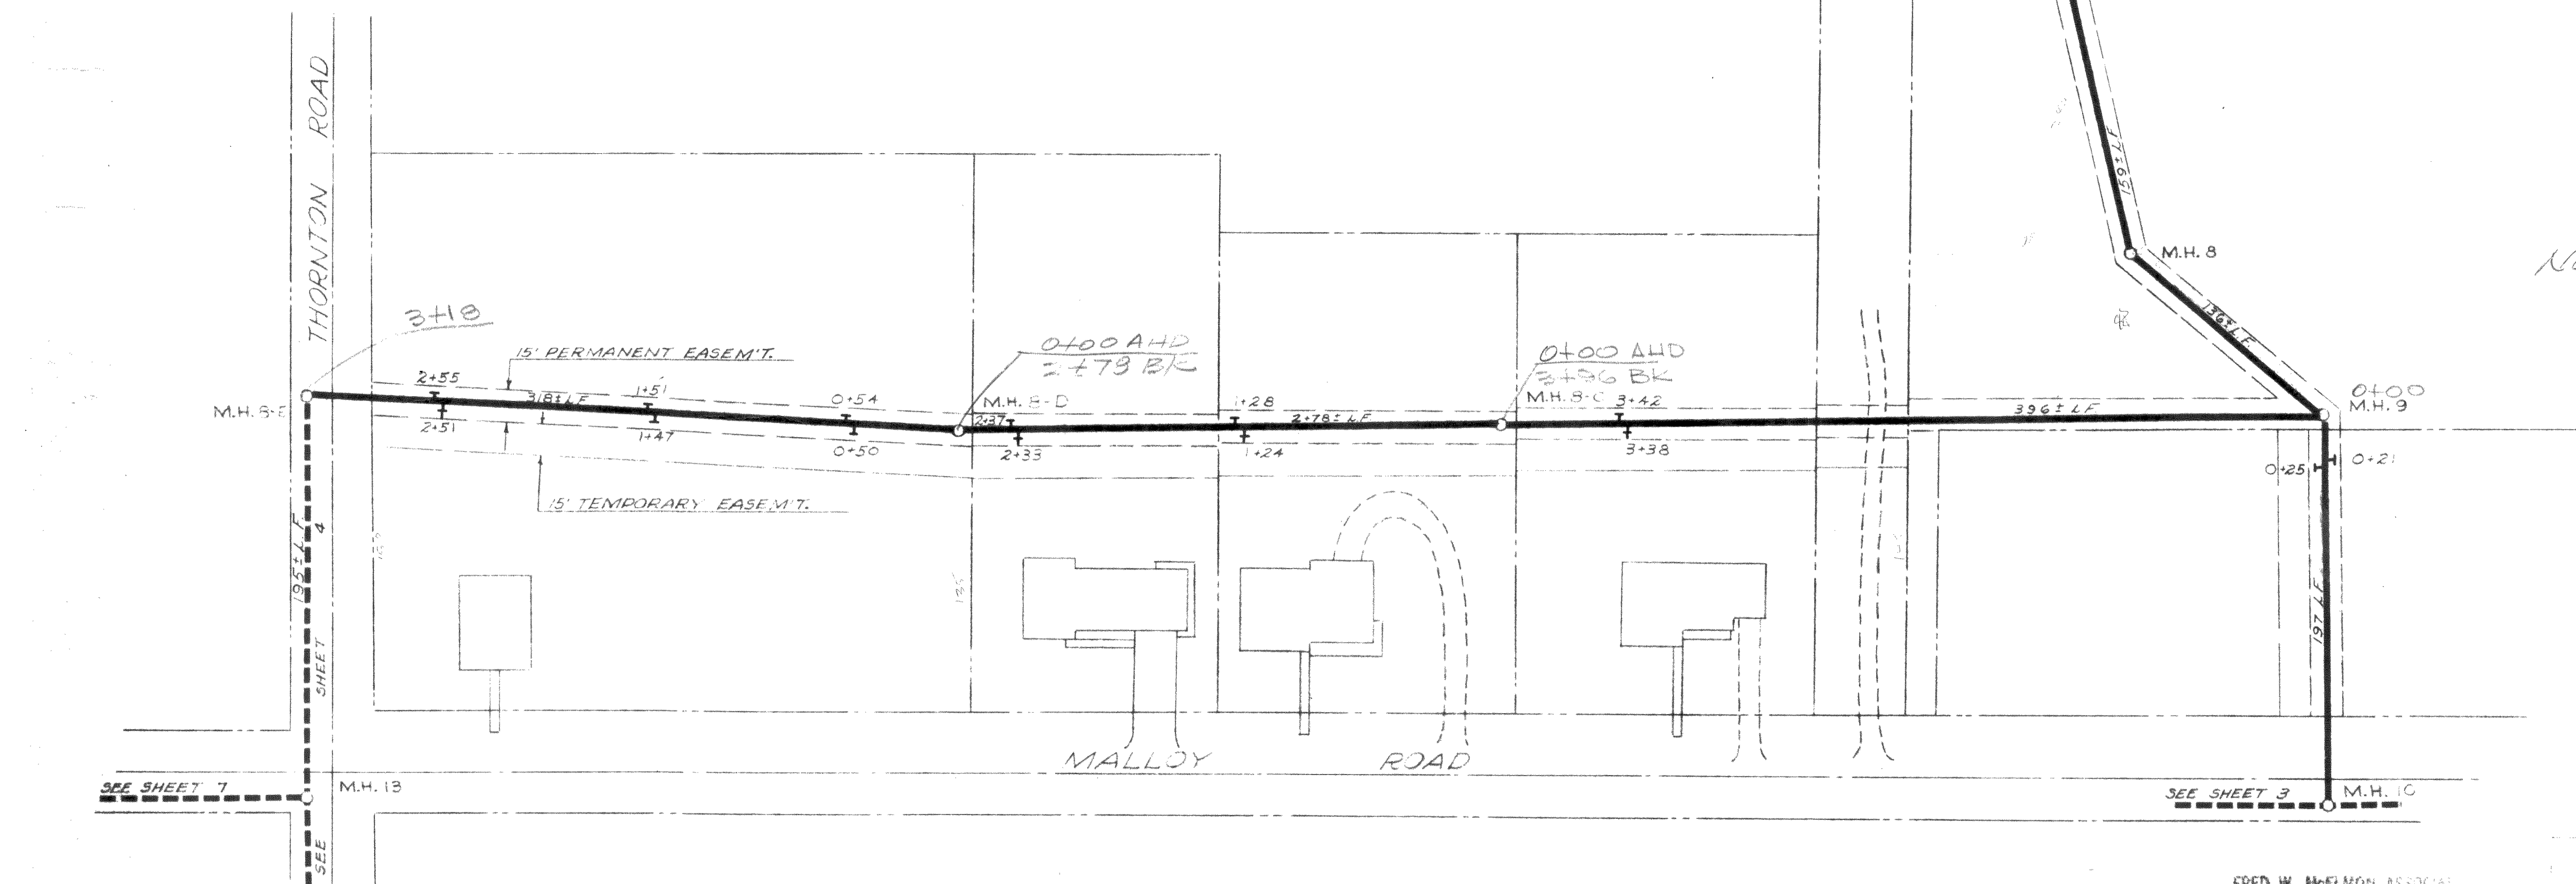

NOTE: TATIONING CHANGES  
FROM MH TO MH

NOTE: Trees at sta. 3+38, 1+24, 2+39, and 2+51 have risers to within 6' of surface.

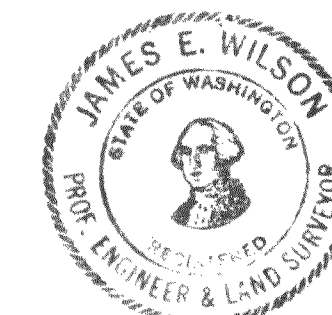


# AS-BUILT


FRED W. McELMON ASSOCIATES  
SURVEYORS-ENGINEERS  
810 HERALD BUILDING  
BELLINGHAM, WASHINGTON 98220

|          |                                                |        |           |              |
|----------|------------------------------------------------|--------|-----------|--------------|
| CLIENT   | CITY OF FERNDALE                               |        |           |              |
| PROJECT  | L.I.D. NO. 15<br>TRUNK SEWER<br>PLAN & PROFILE |        |           |              |
| DRAWN BY | D.E.M.                                         | SCALE  | AS NOTED  |              |
| APPROVED | DATE 10-21-69                                  | F.SOOK | JGR 00067 | SHEET 4 OF 4 |

[illegible]


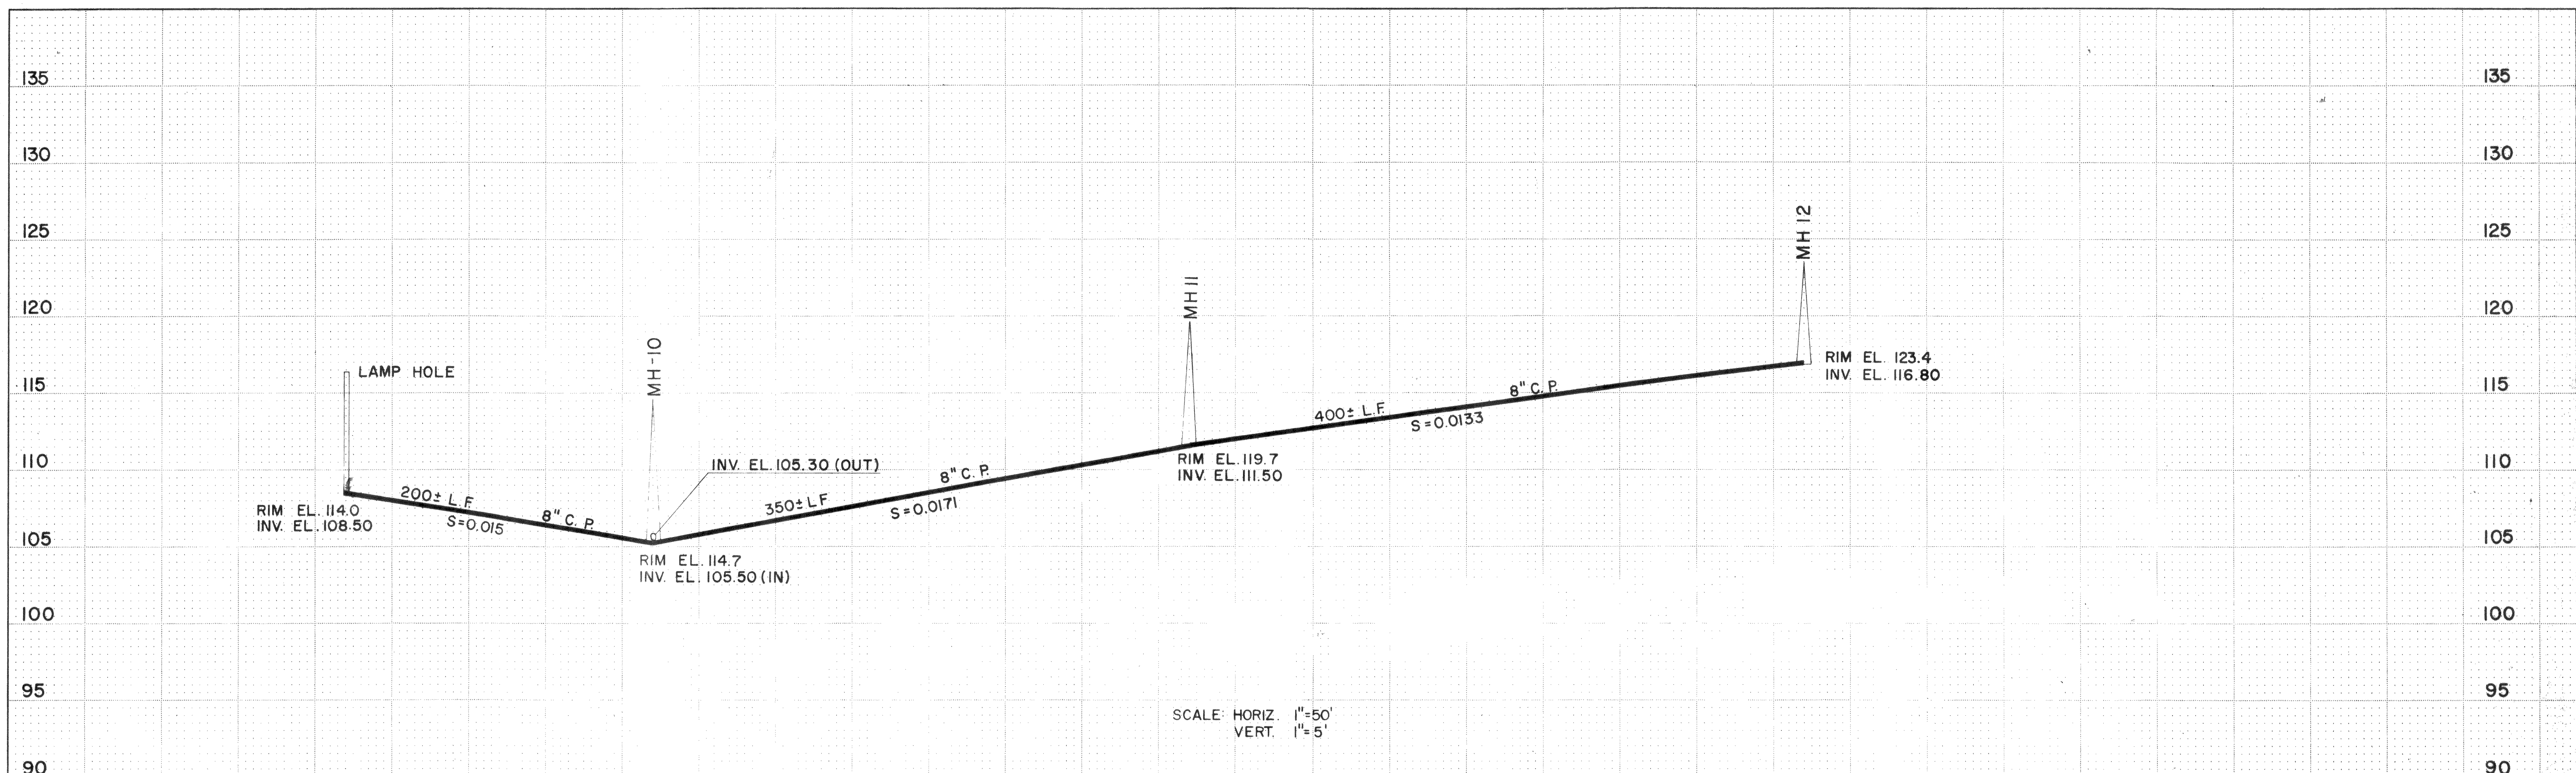


00344.000 19-26-07 K2

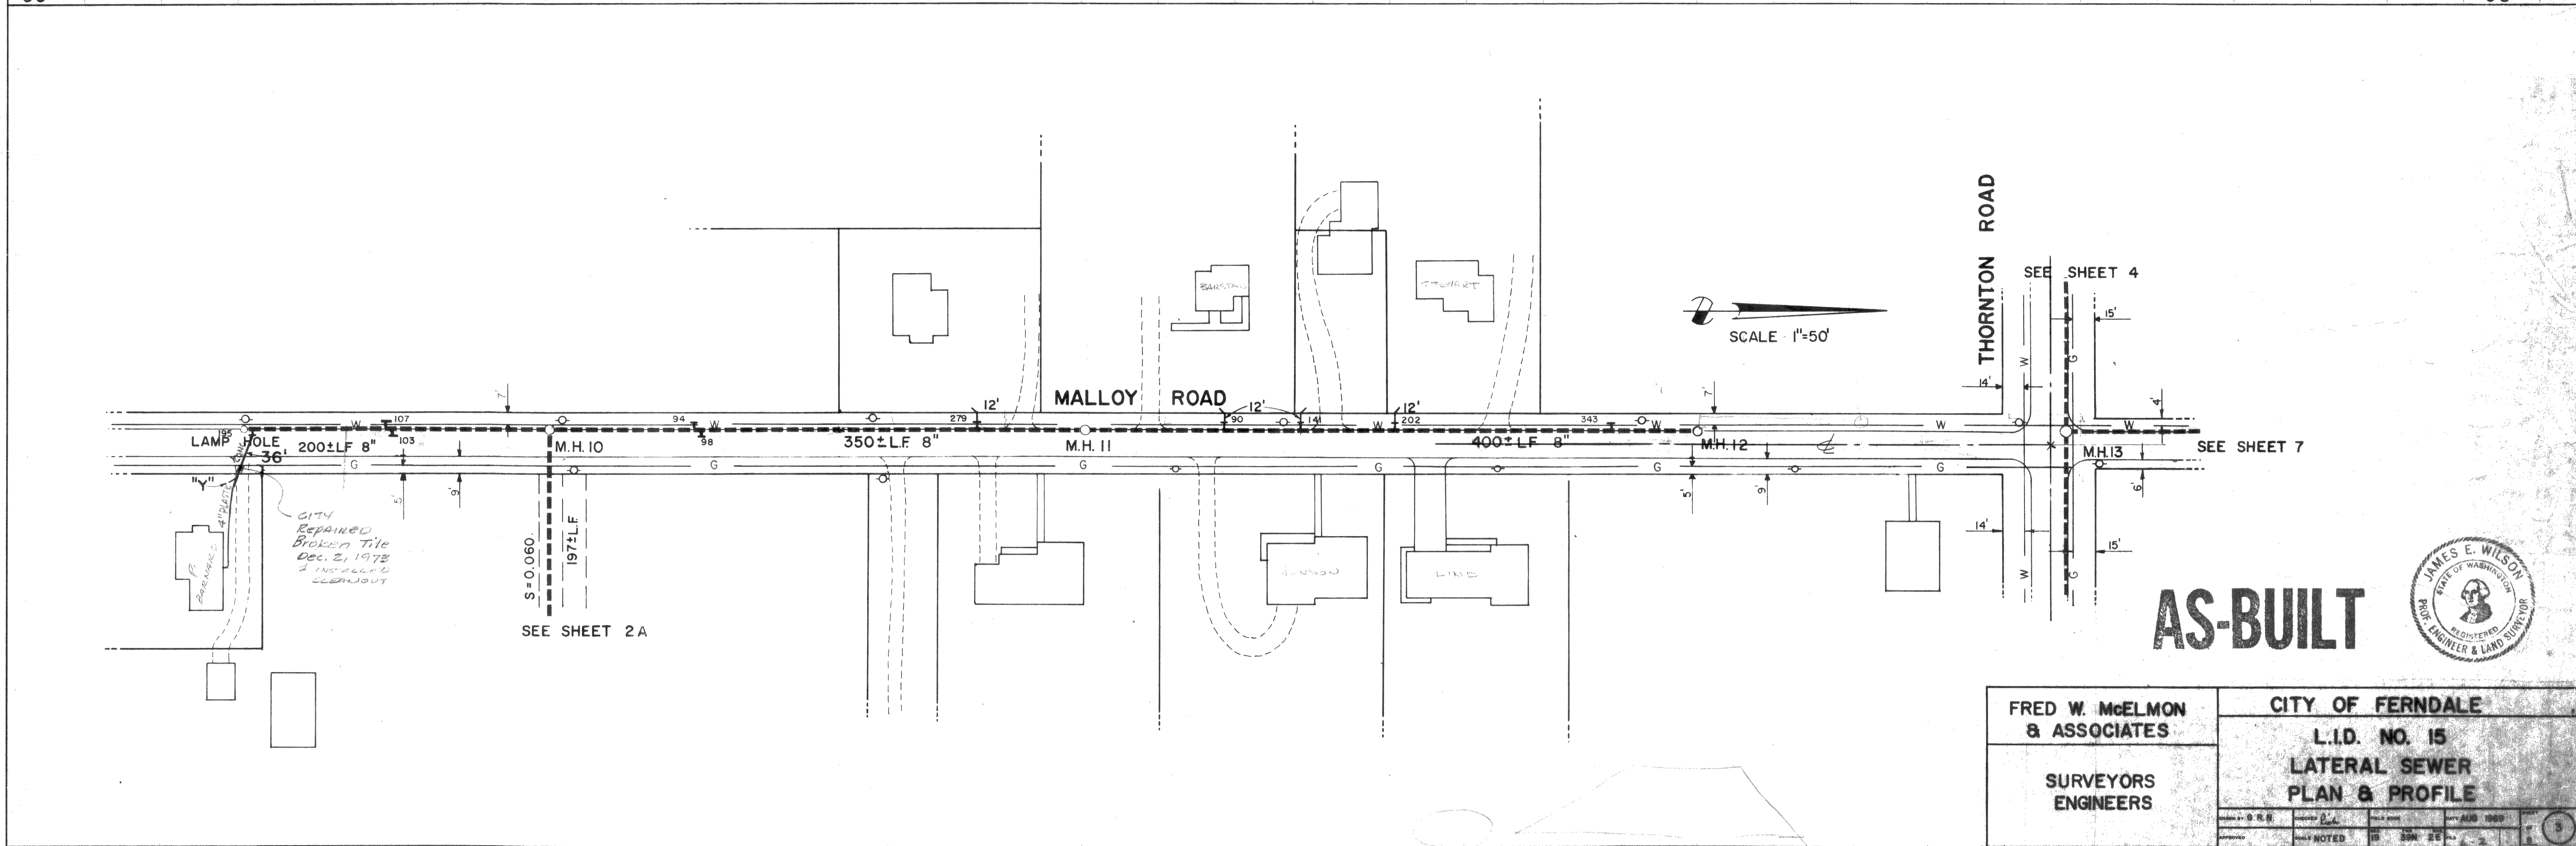


AS-BUILT

|                                 |                 |          |          |    |
|---------------------------------|-----------------|----------|----------|----|
| FRED W. McELMON<br>& ASSOCIATES | CITY OF FERNDAL |          |          |    |
|                                 | L.I.D. NO. 15   |          |          |    |
| SURVEYORS<br>ENGINEERS          | LATERAL SEWER   |          |          |    |
|                                 | PLAN & PROFILE  |          |          |    |
| DATE: 10-10-88                  | BY: JEM         | CHK: JEM | APP: JEM | 3  |
| NOTED                           | 15              | 20       | 25       | 30 |

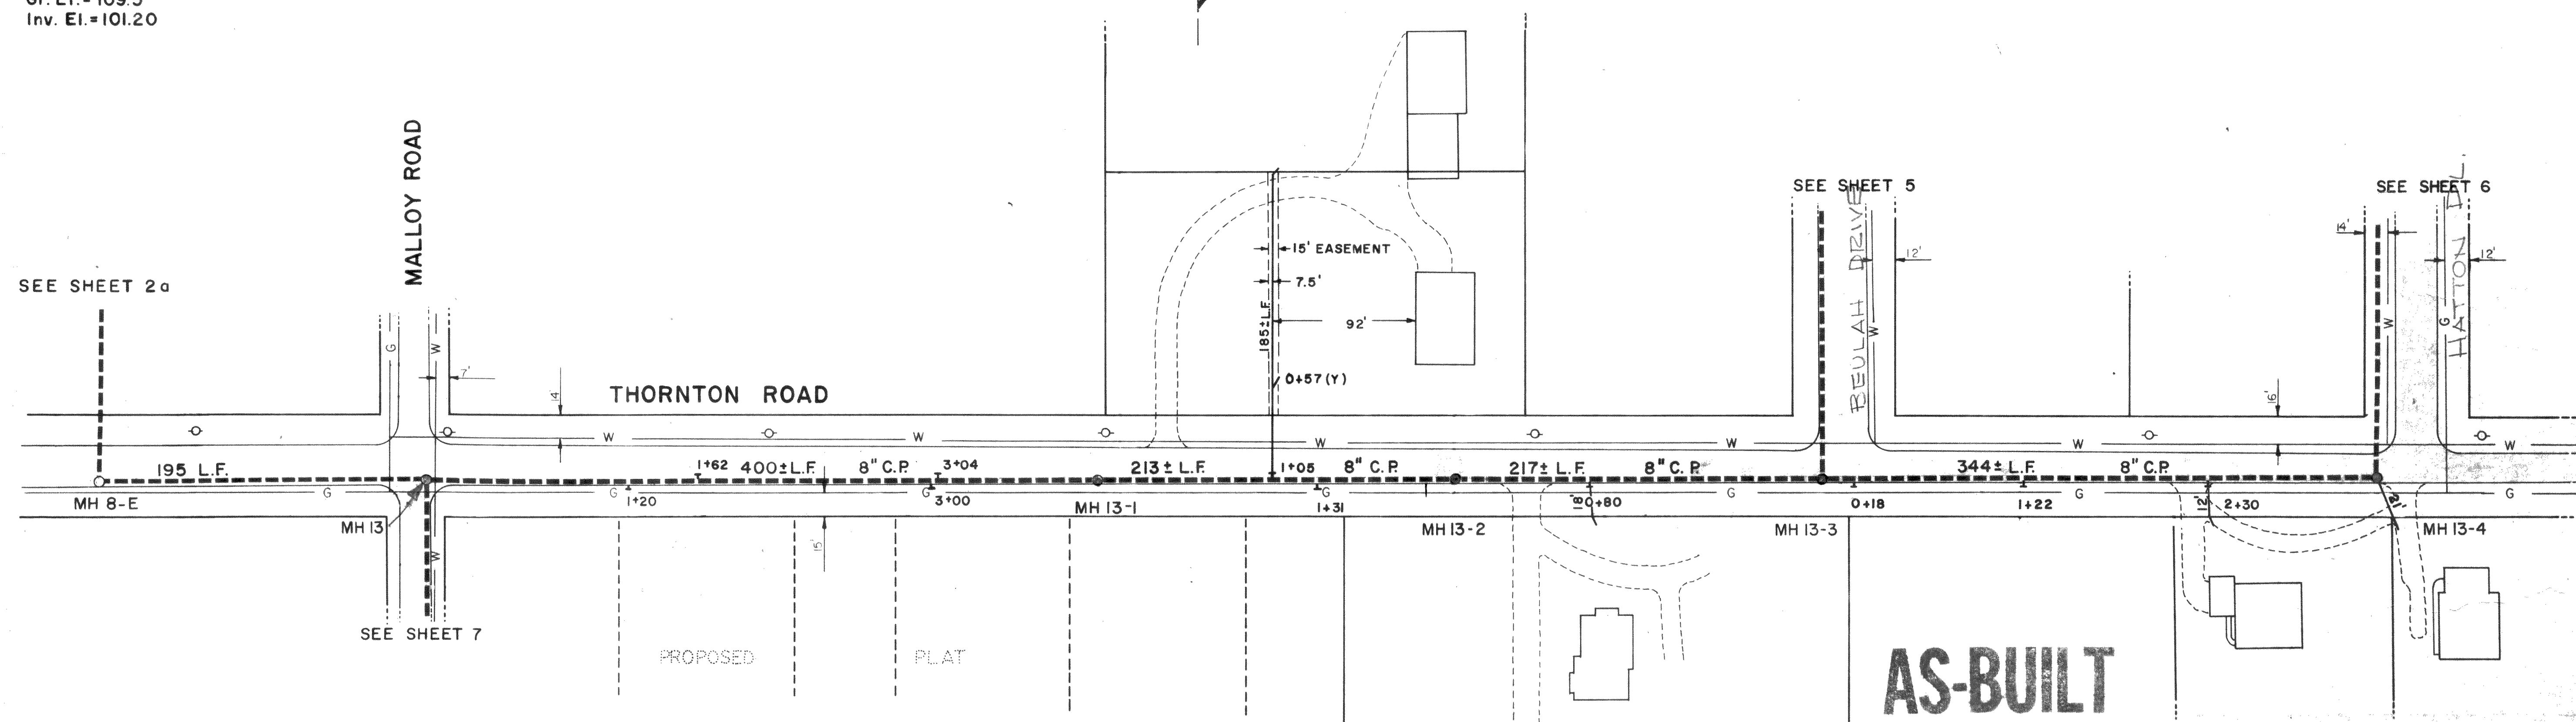
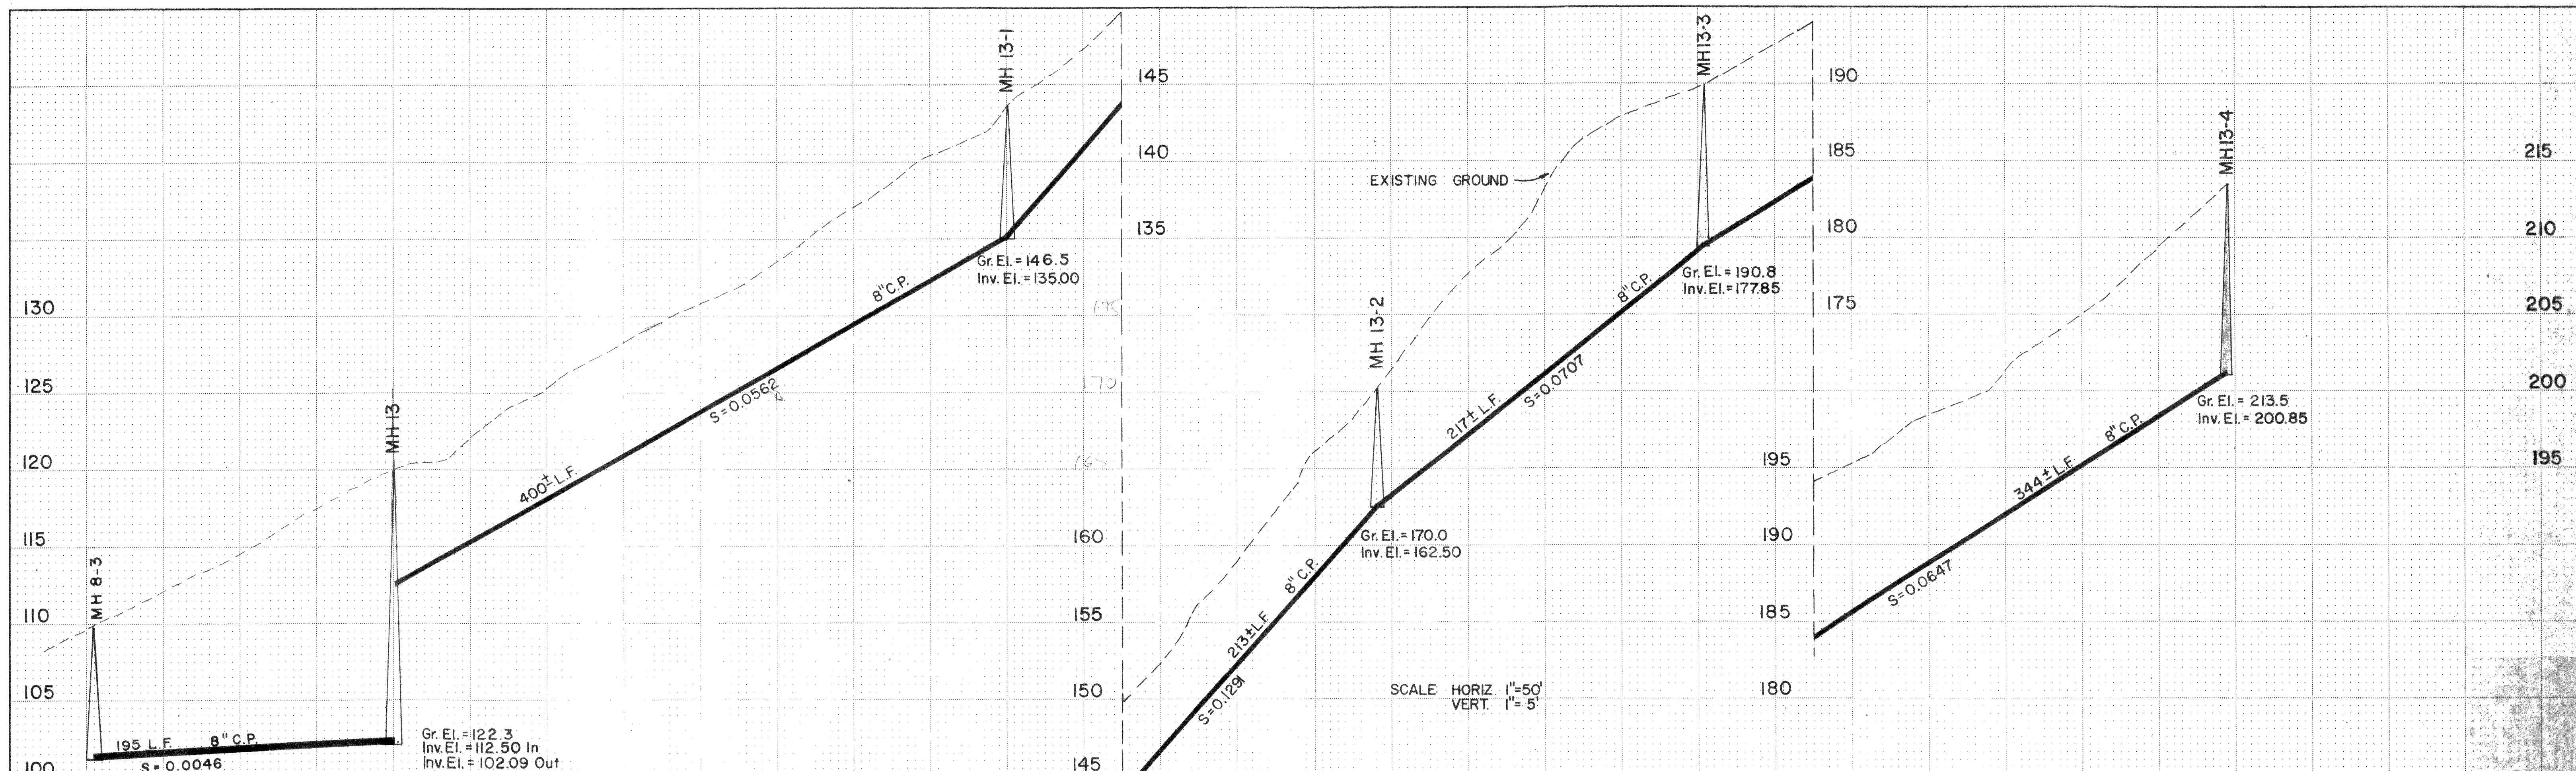


**AS-BUILT**

|                                                                |                                 |                                                                             |  |
|----------------------------------------------------------------|---------------------------------|-----------------------------------------------------------------------------|--|
| <b>FRED W. McELMON &amp; ASSOCIATES</b><br>SURVEYORS ENGINEERS |                                 | <b>CITY OF FERNDALE</b><br>L.I.D. NO. 15<br>LATERAL SEWER<br>PLAN & PROFILE |  |
| DRAWN BY: D.C.H.<br>CHECKED BY: J.W.L.<br>APPROVED BY: J.W.L.  | DATE: AUG 1989<br>SHEET: 2 OF 2 | PROJECT: 15<br>SCALE: 1"=50'                                                |  |

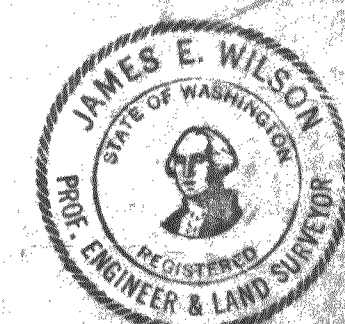


00344.005 6-26-07 K12

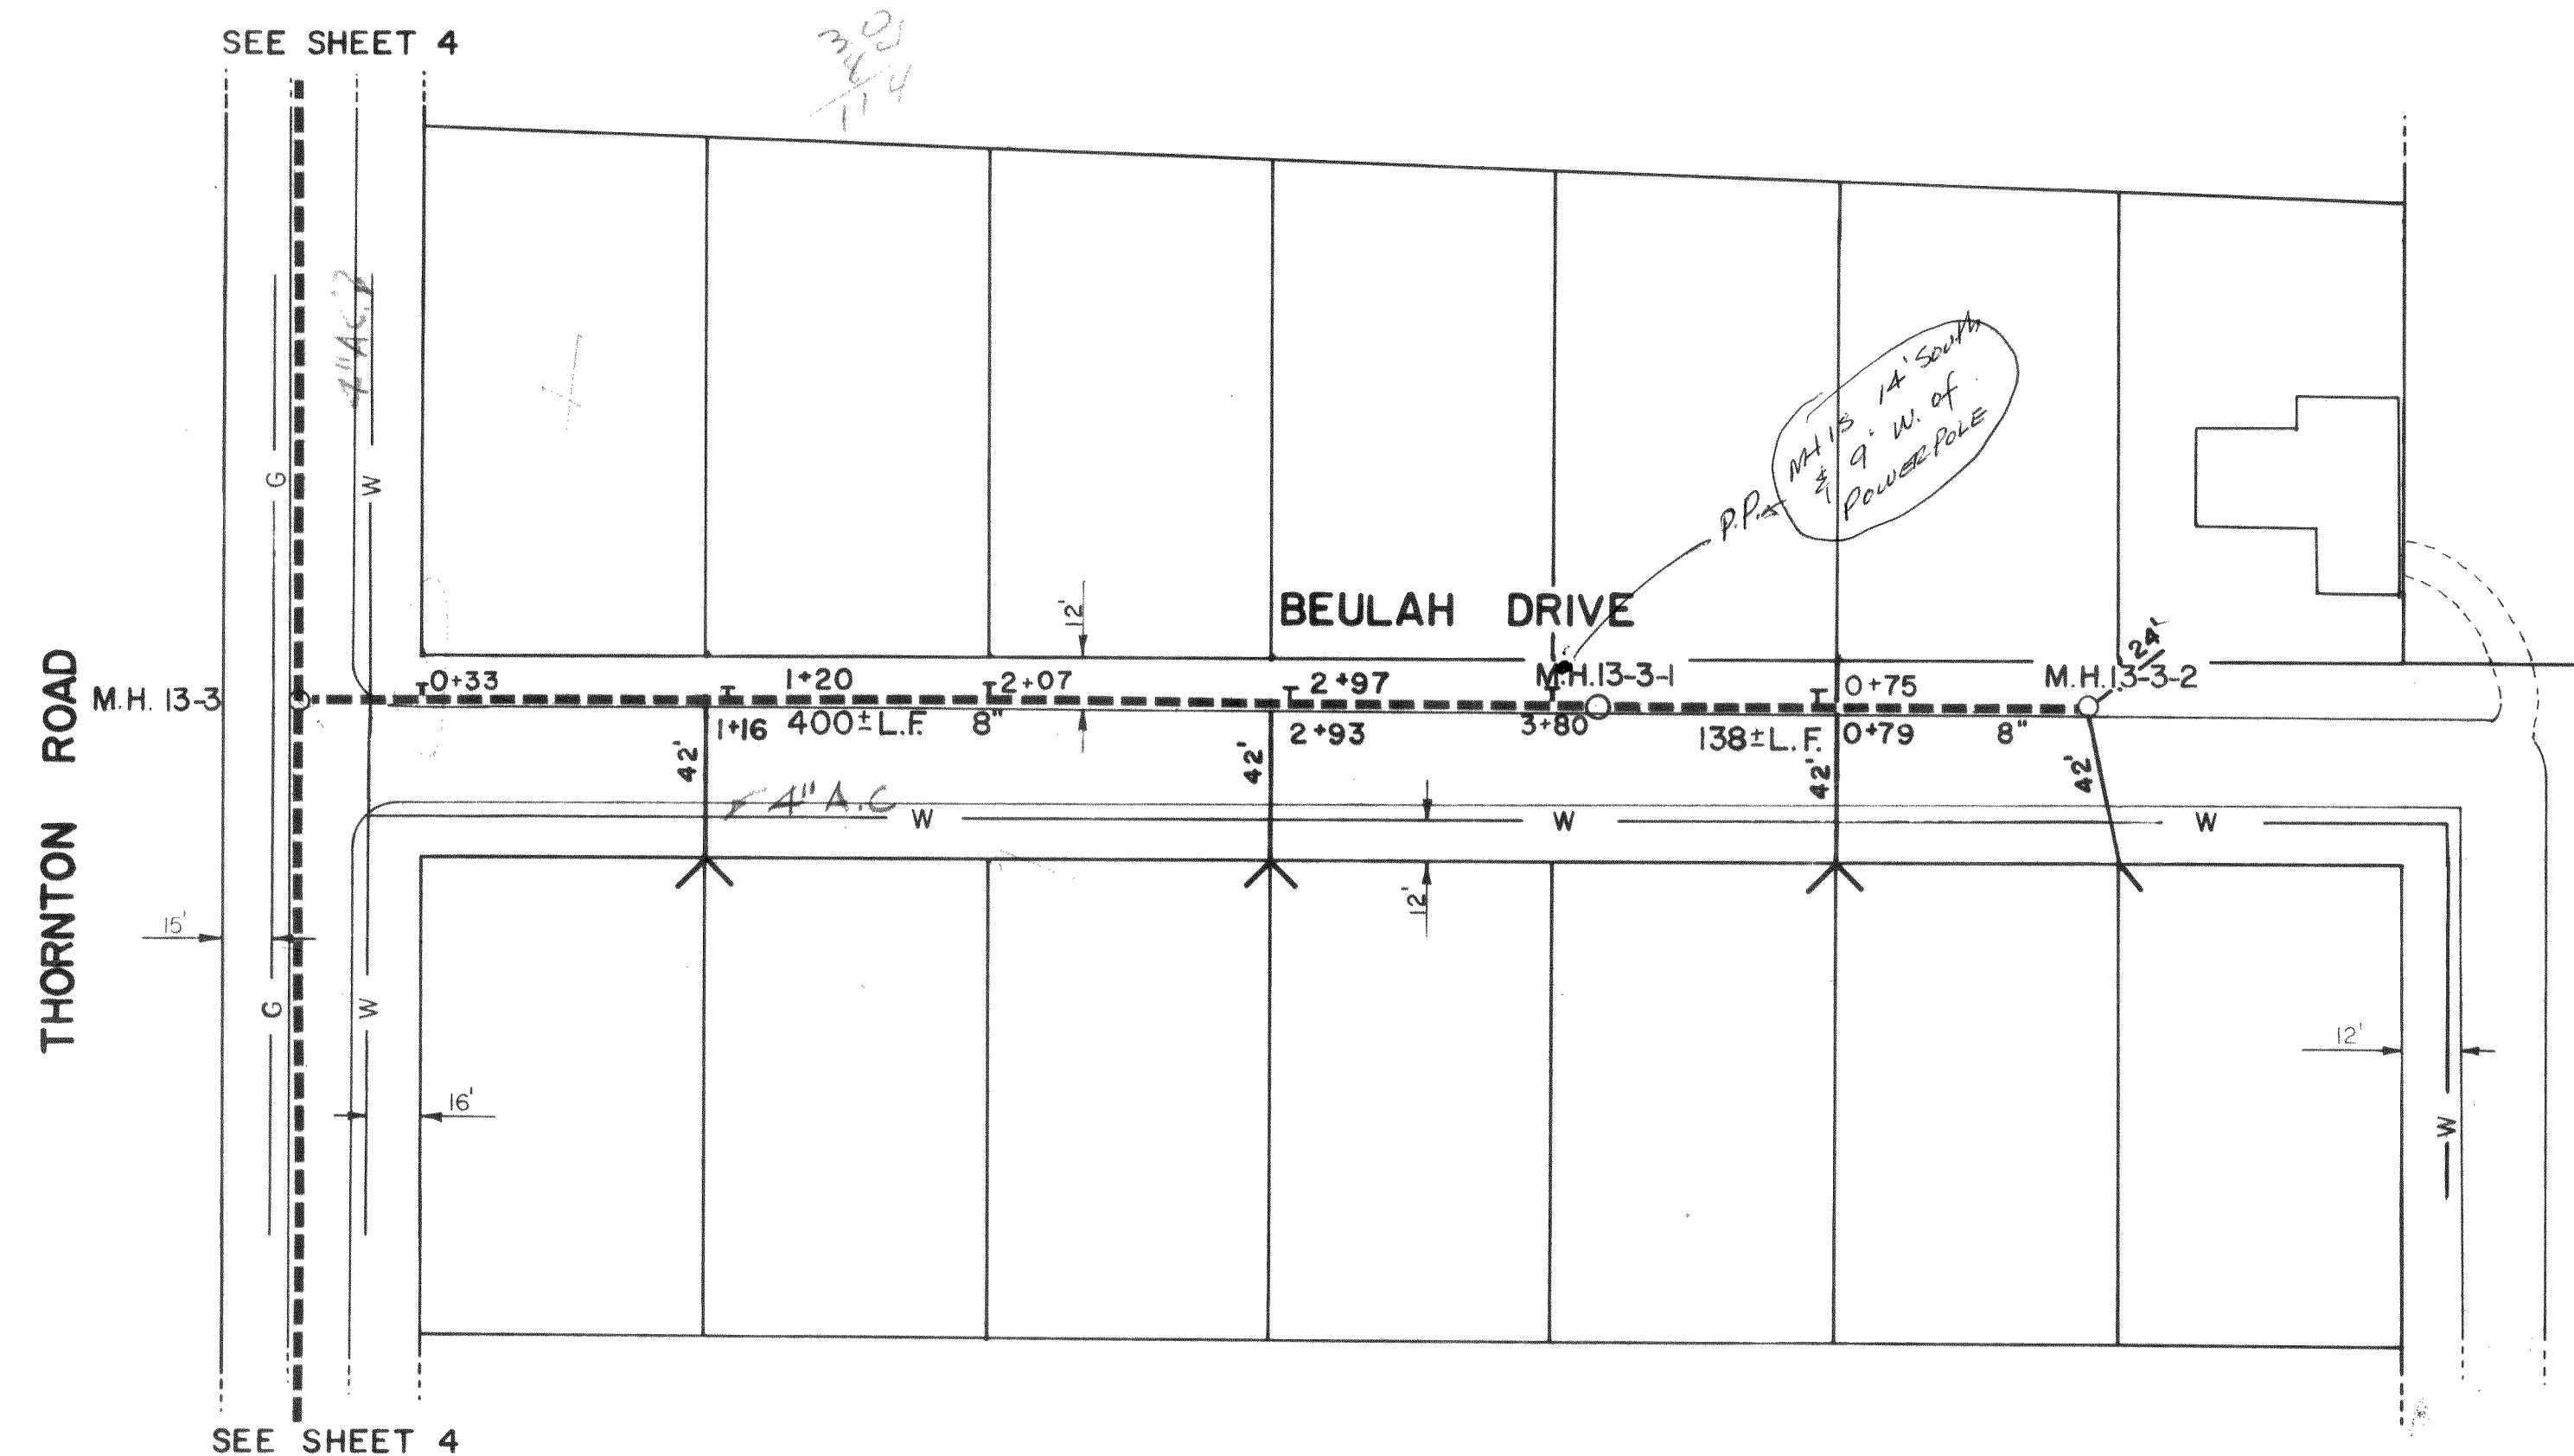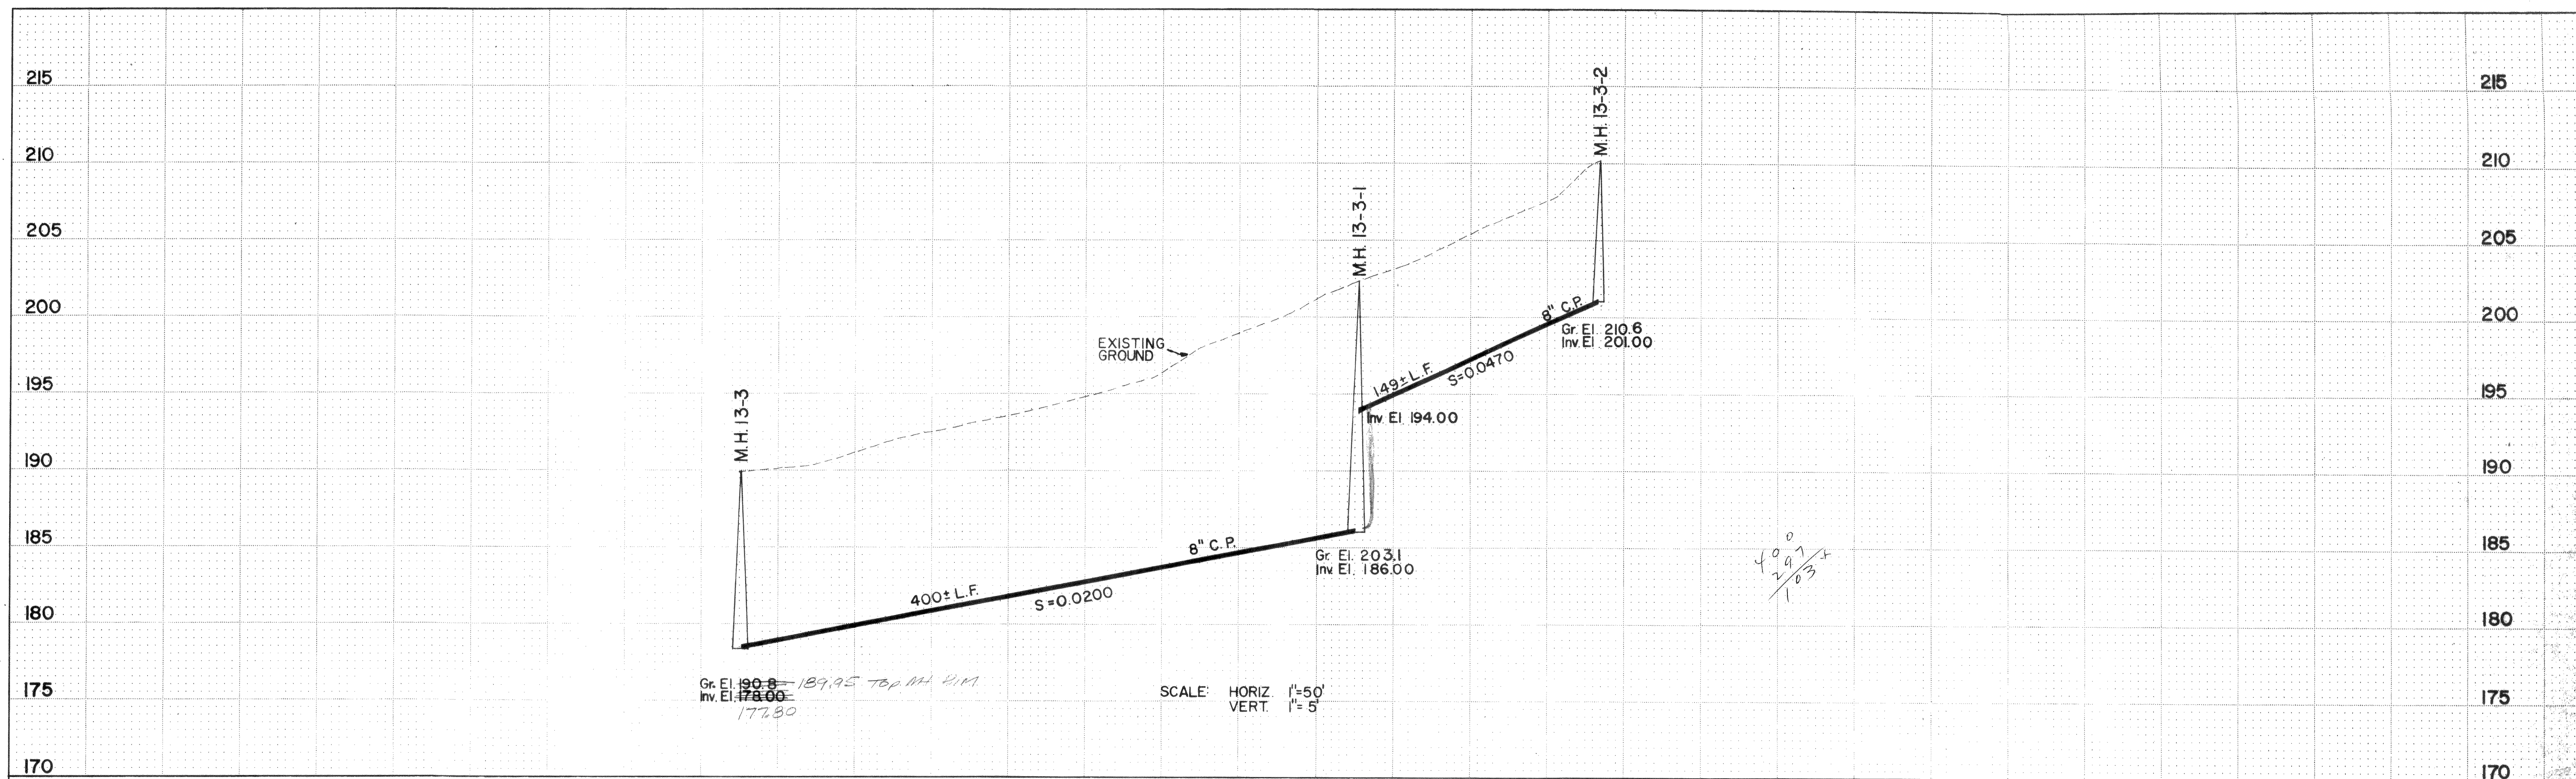


SCALE: 1"=50'

AS-BUILT

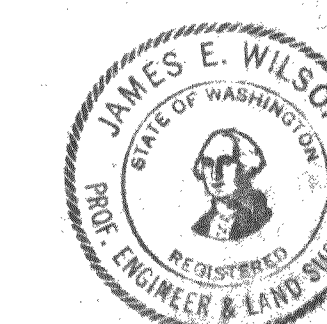


|                                 |                                  |
|---------------------------------|----------------------------------|
| FRED W. McELMON<br>& ASSOCIATES | CITY OF FERNDAL<br>L.I.D. NO. 15 |
| SURVEYORS<br>ENGINEERS          | LATERAL SEWER<br>PLAN & PROFILE  |

|          |       |             |   |
|----------|-------|-------------|---|
| APPROVED | NOTED | 19 JUN 1969 | 5 |
|----------|-------|-------------|---|

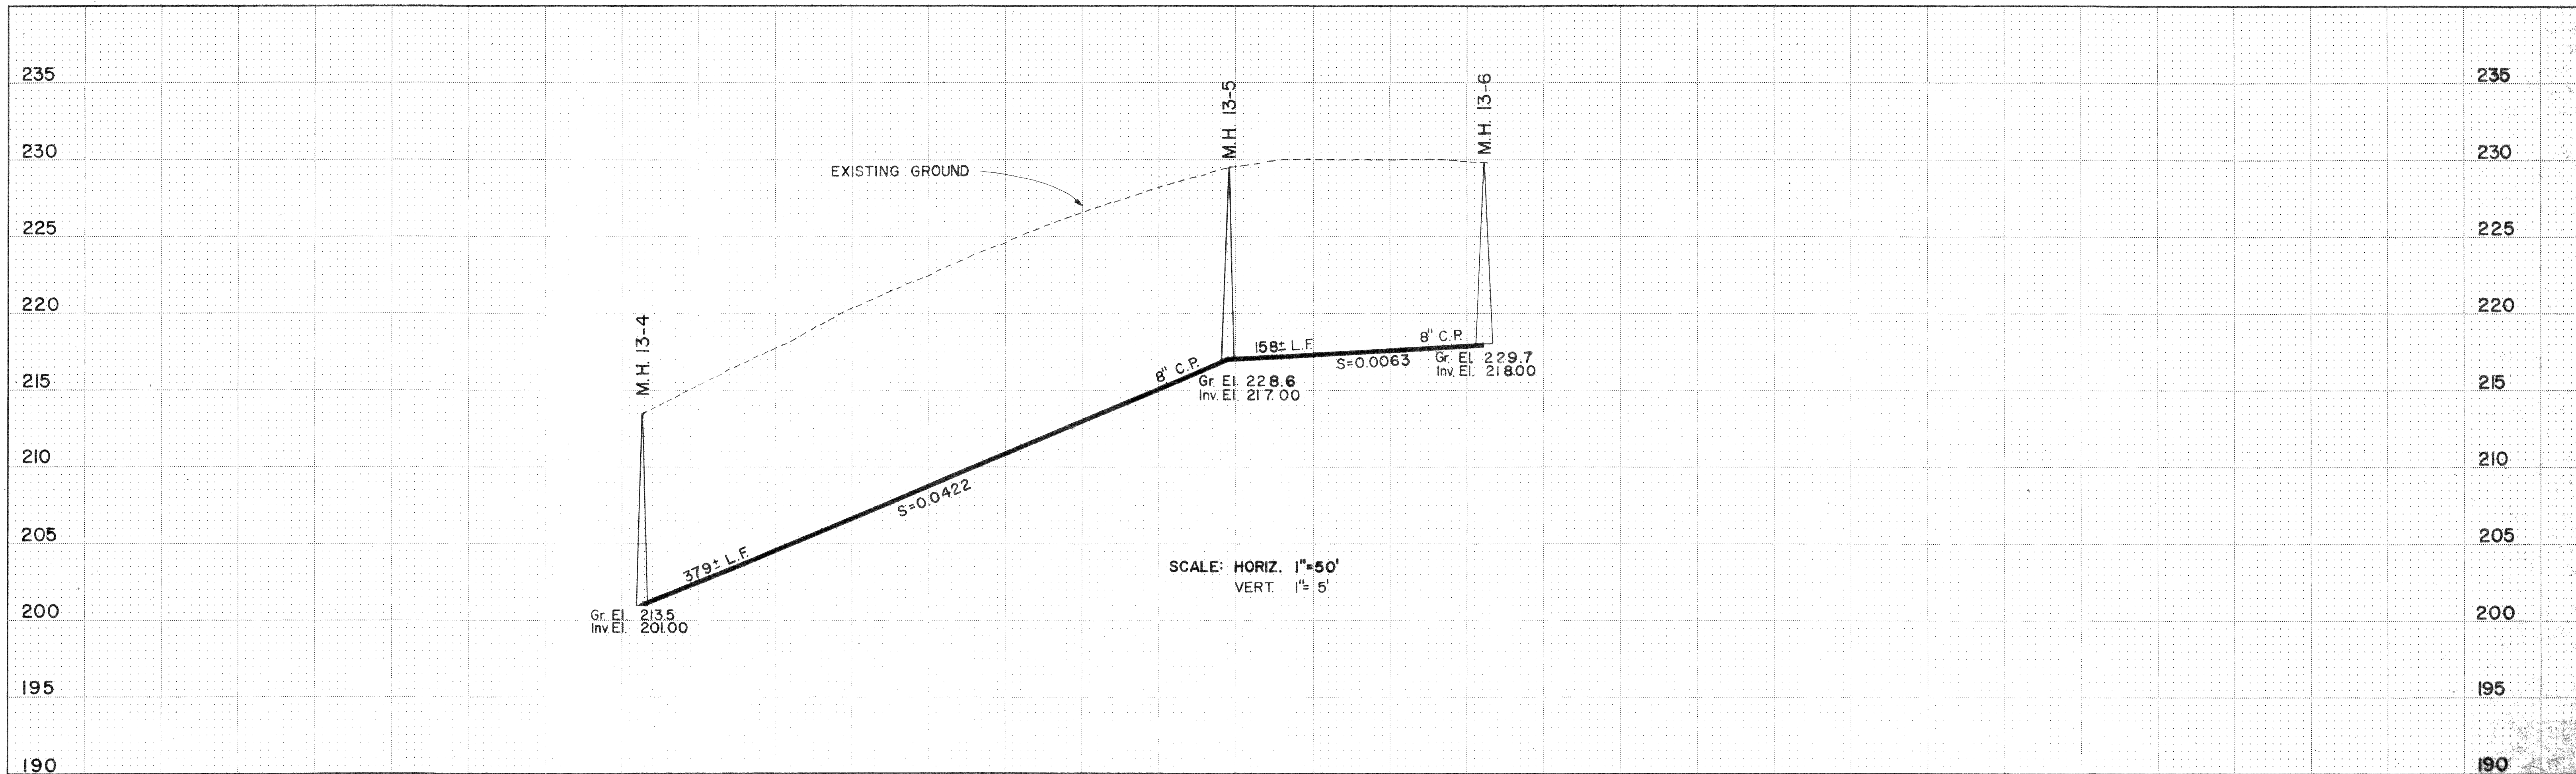


00344.007 6.26.07 K2


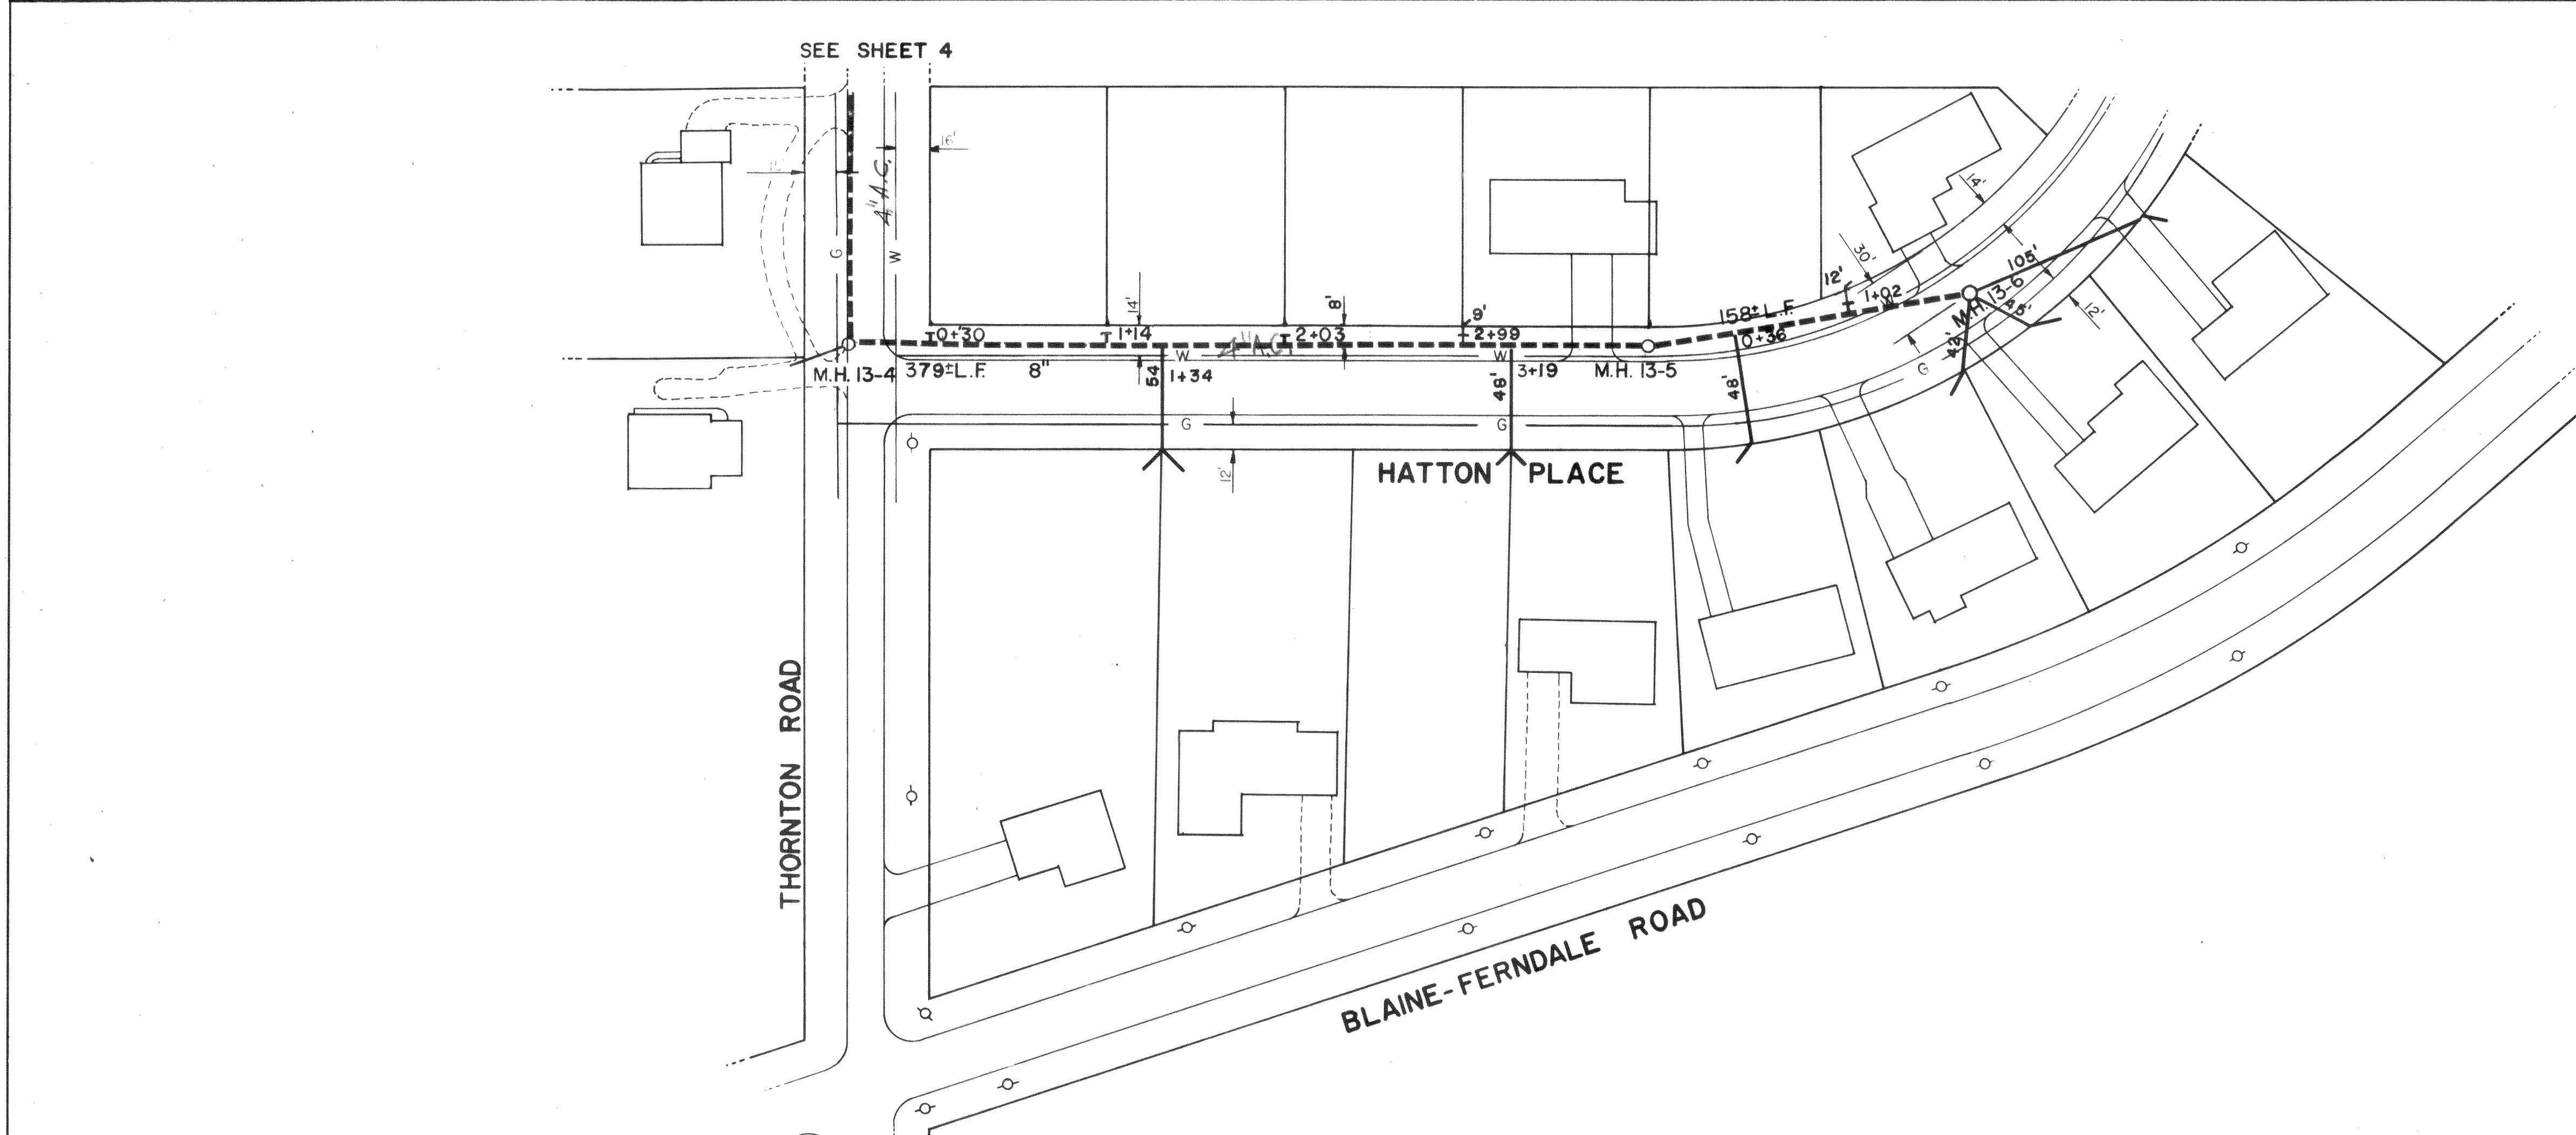


SCALE: 1"=50'



**AS-BUILT**

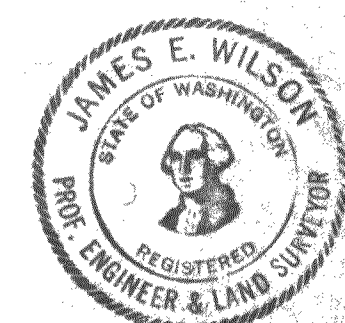

|                                 |                                  |
|---------------------------------|----------------------------------|
| FRED W. McELMON<br>& ASSOCIATES | CITY OF FERNDAL<br>L.I.D. NO. 15 |
| SURVEYORS<br>ENGINEERS          | LATERAL SEWER<br>PLAN & PROFILE  |
| DRAWN BY: D.C.H.                | CHECKED BY: J.W.                 |
| DATE: 8/8/88                    | DATE: 8/8/88                     |
| NOTED: 8/8/88                   | NOTED: 8/8/88                    |

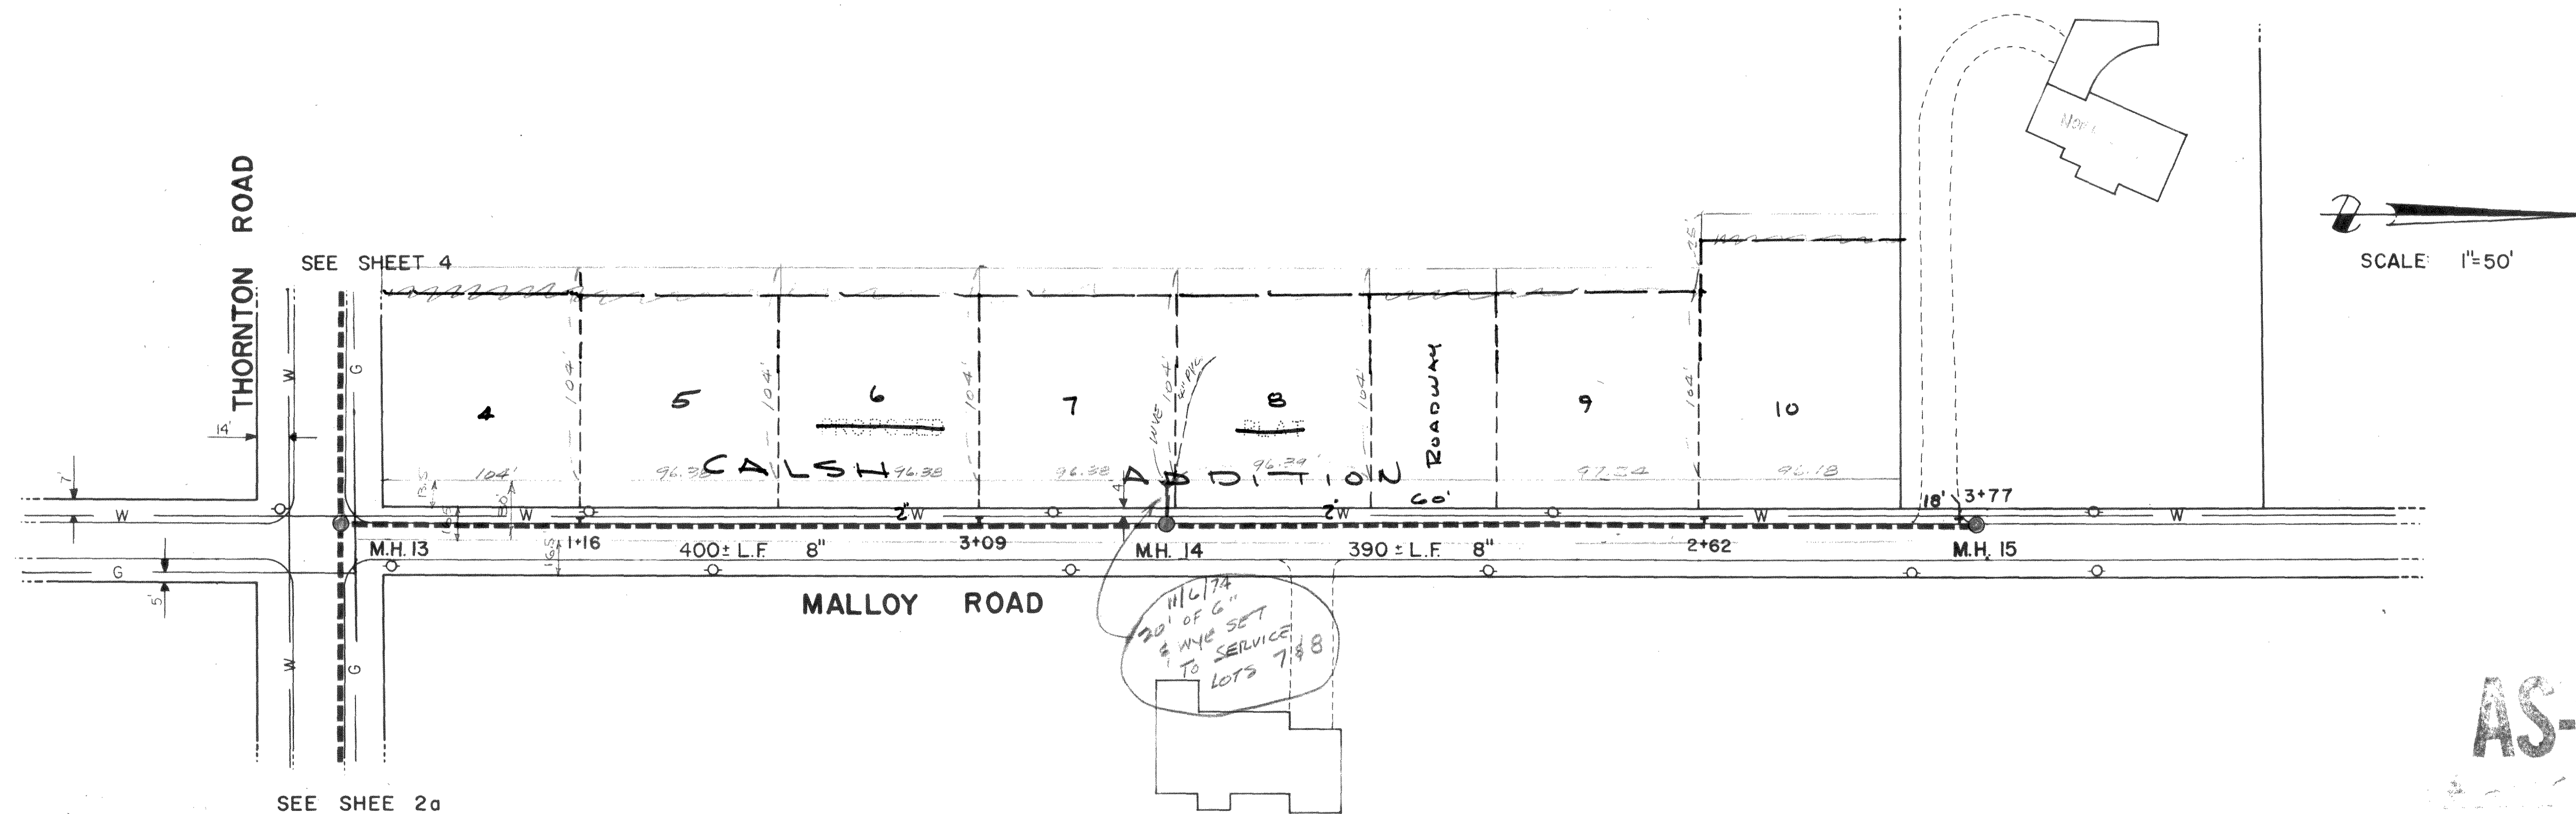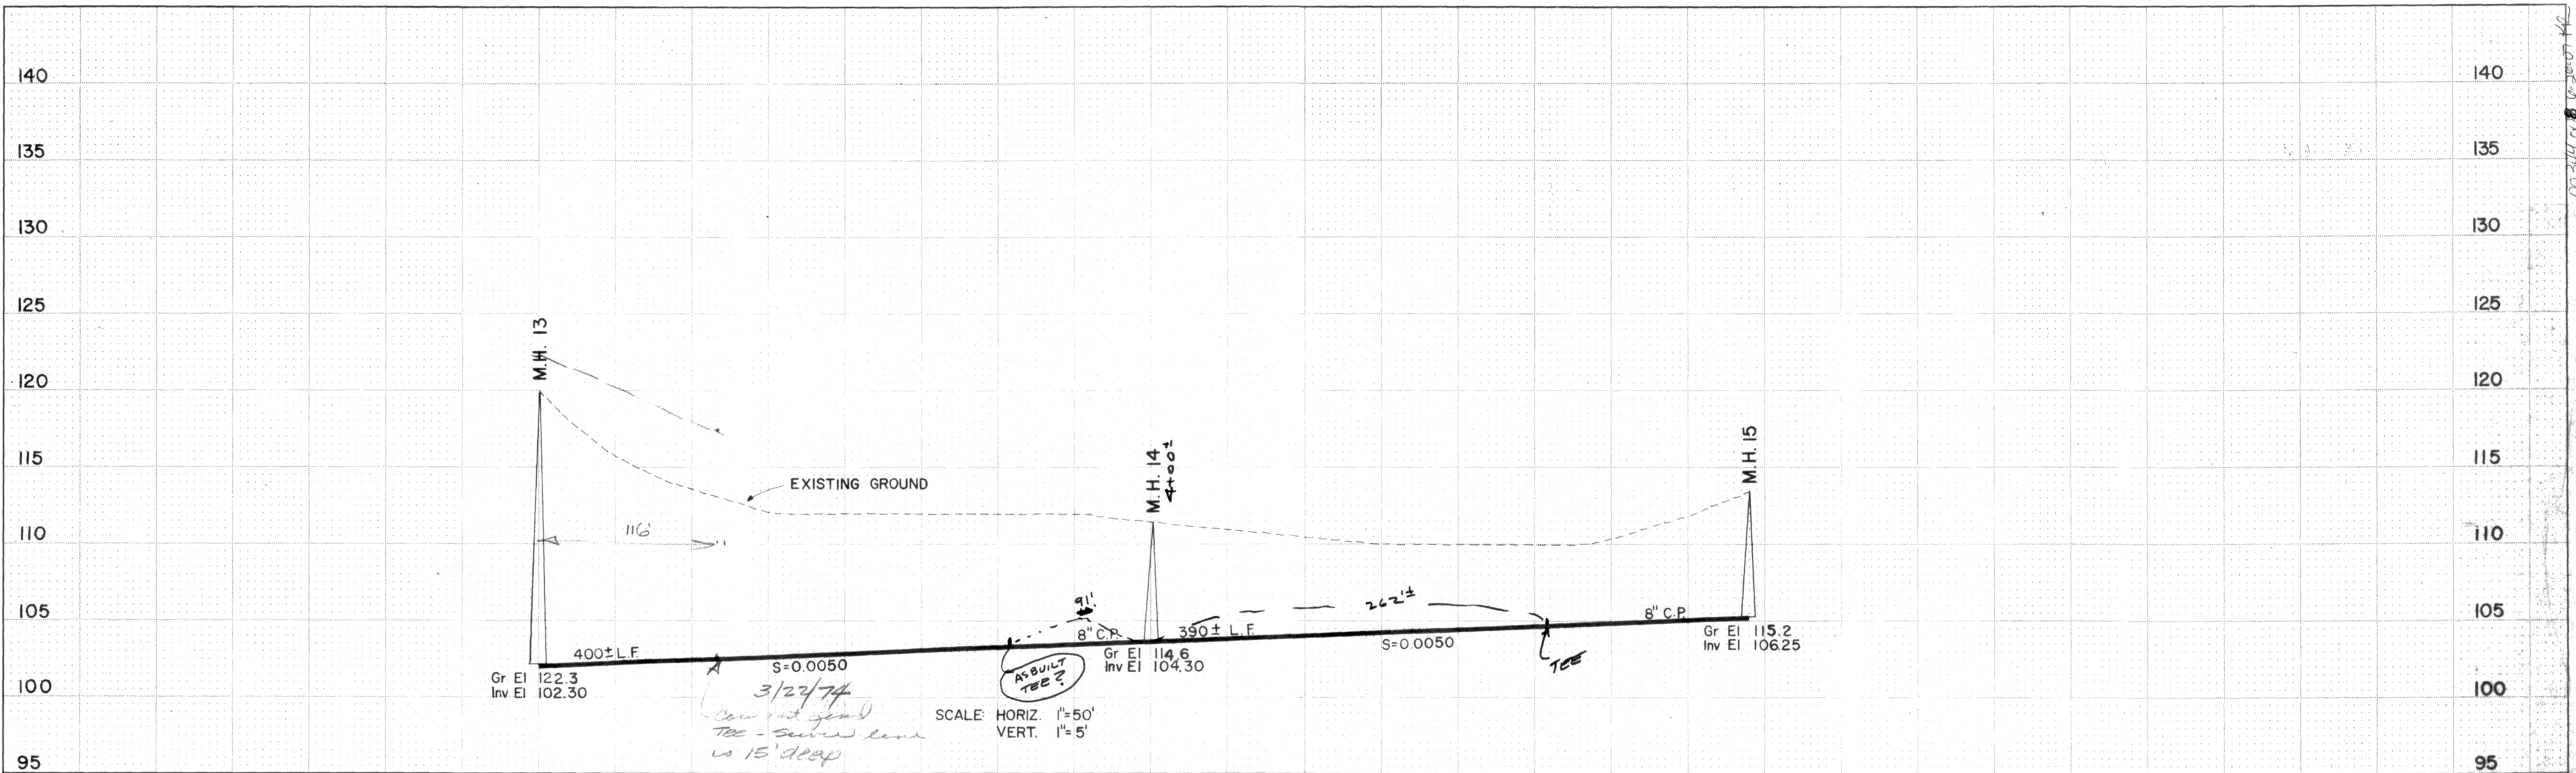


|                                 |                                                  |                |                    |                |
|---------------------------------|--------------------------------------------------|----------------|--------------------|----------------|
| FRED W. McELMON<br>& ASSOCIATES | CITY OF FERDALE                                  |                |                    |                |
|                                 | L.I.D. NO. 15<br>LATERAL SEWER<br>PLAN & PROFILE |                |                    |                |
| SURVEYORS<br>ENGINEERS          | DESIGNED BY: G.R.H.                              | DRAWN BY: R.H. | CHECKED BY: J.E.W. | DATE: AUG 1968 |
|                                 | APPROVED:                                        | NOTED:         | 18                 | 30N 2E         |

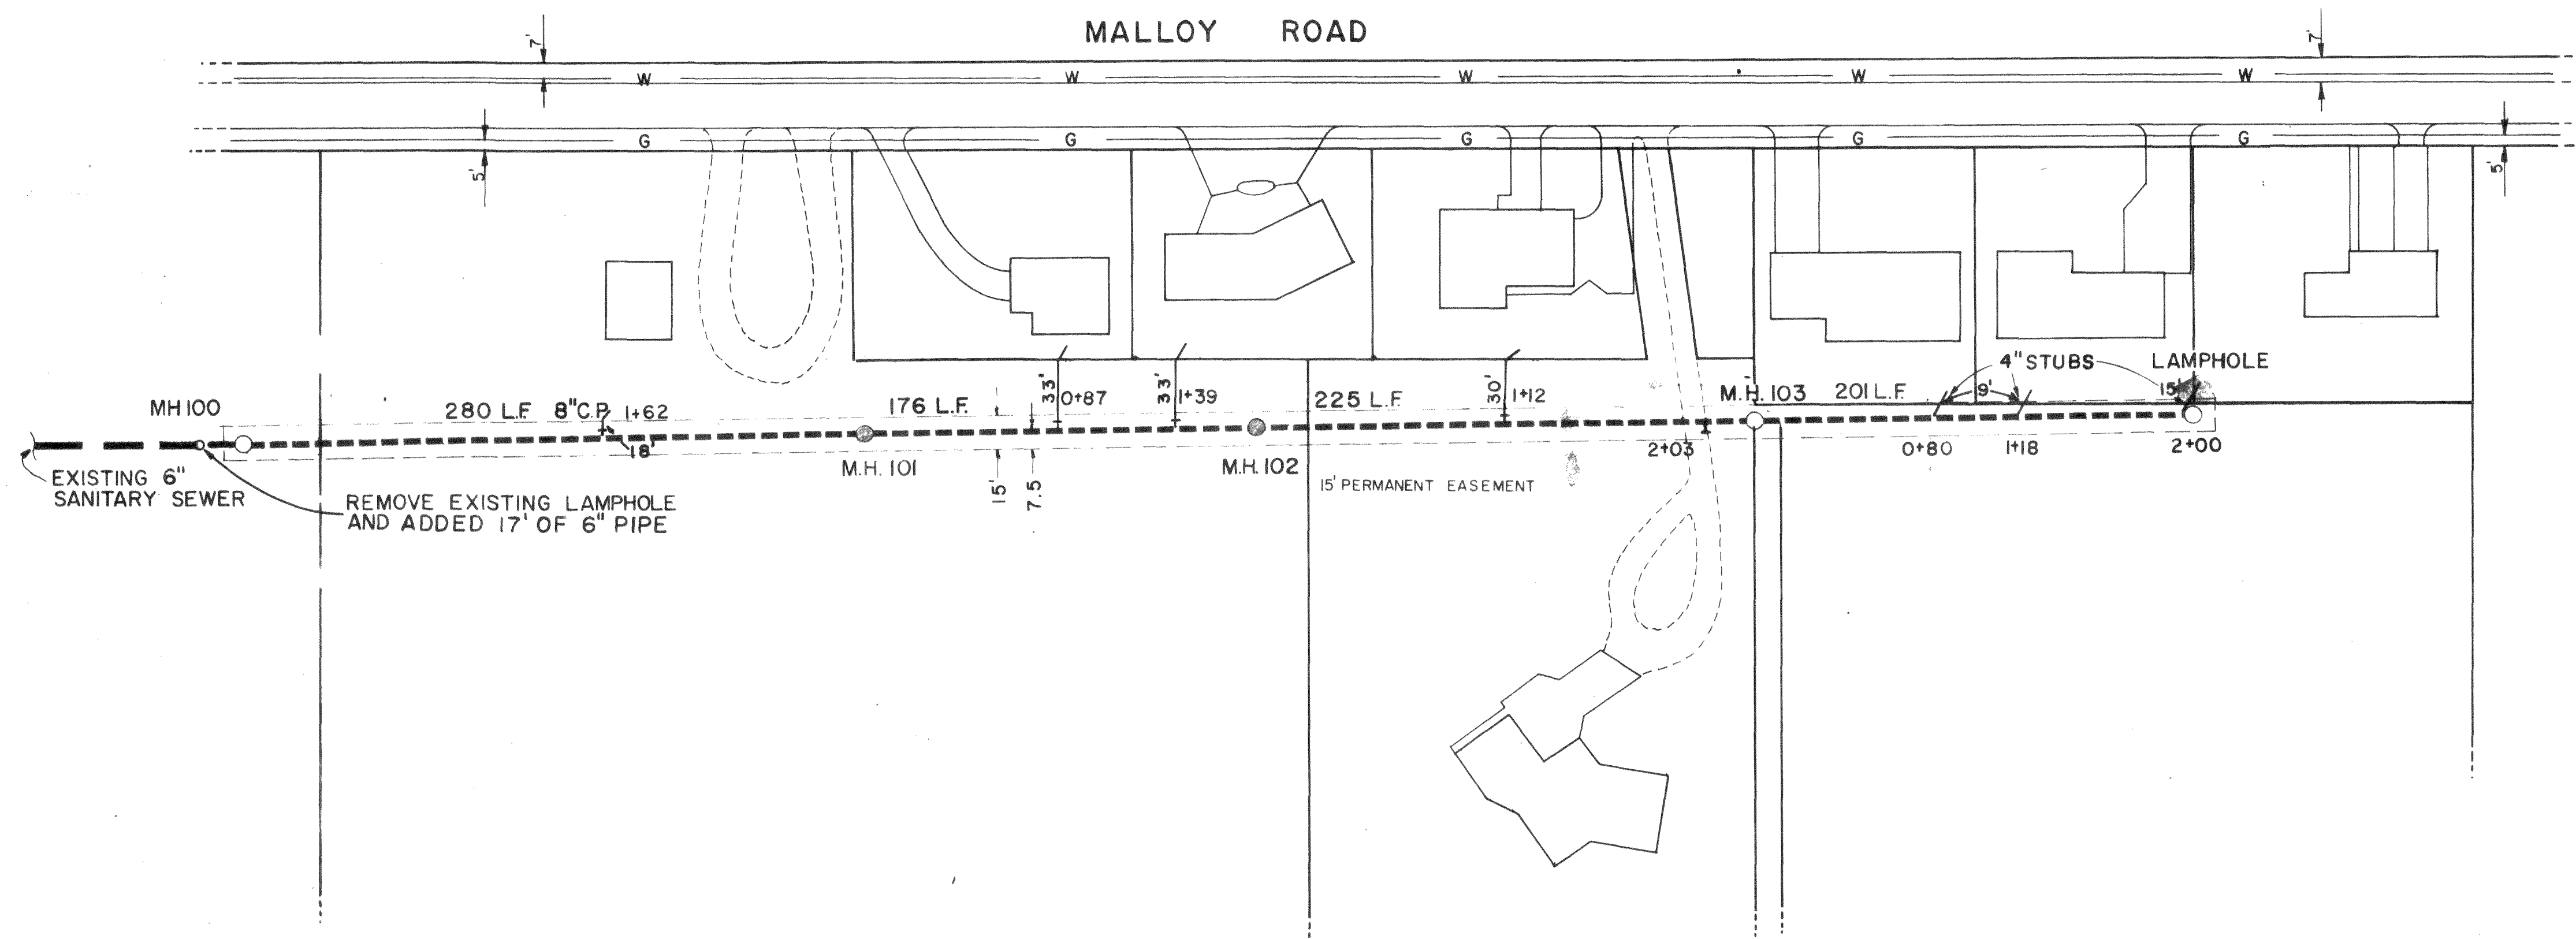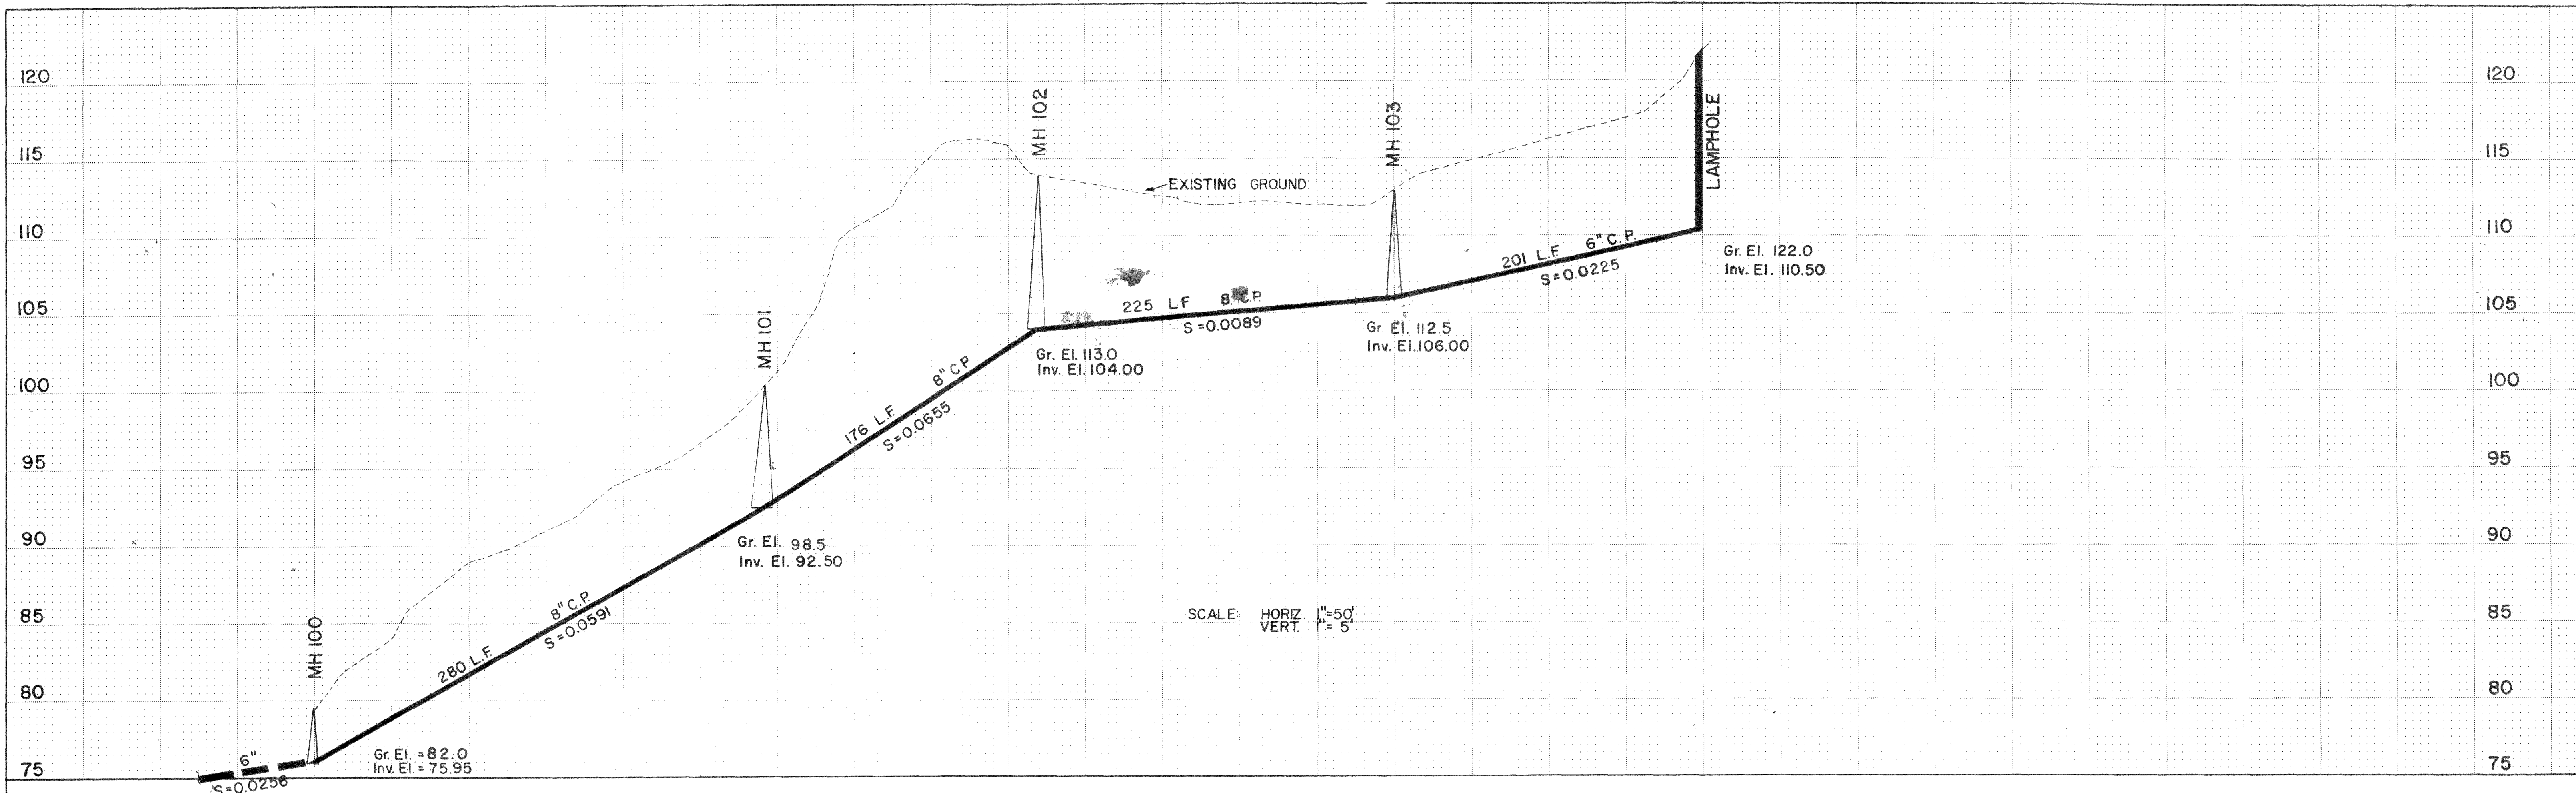

SCALE: 1"=50'

AS-BUILT

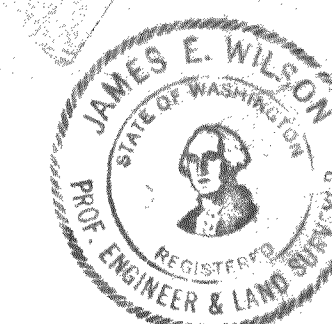

FRED W. McELMON  
& ASSOCIATES

SURVEYORS  
ENGINEERS

CITY OF FERDALE  
L.I.D. NO. 15  
LATERAL SEWER  
PLAN & PROFILE

|                |          |            |     |      |     |      |
|----------------|----------|------------|-----|------|-----|------|
| DATE OF D.C.R. | APPROVED | DATE NOTED | NO. | DATE | NO. | DATE |
|                |          |            | 20  | 30   | 20  |      |

0344 009 626-0742