

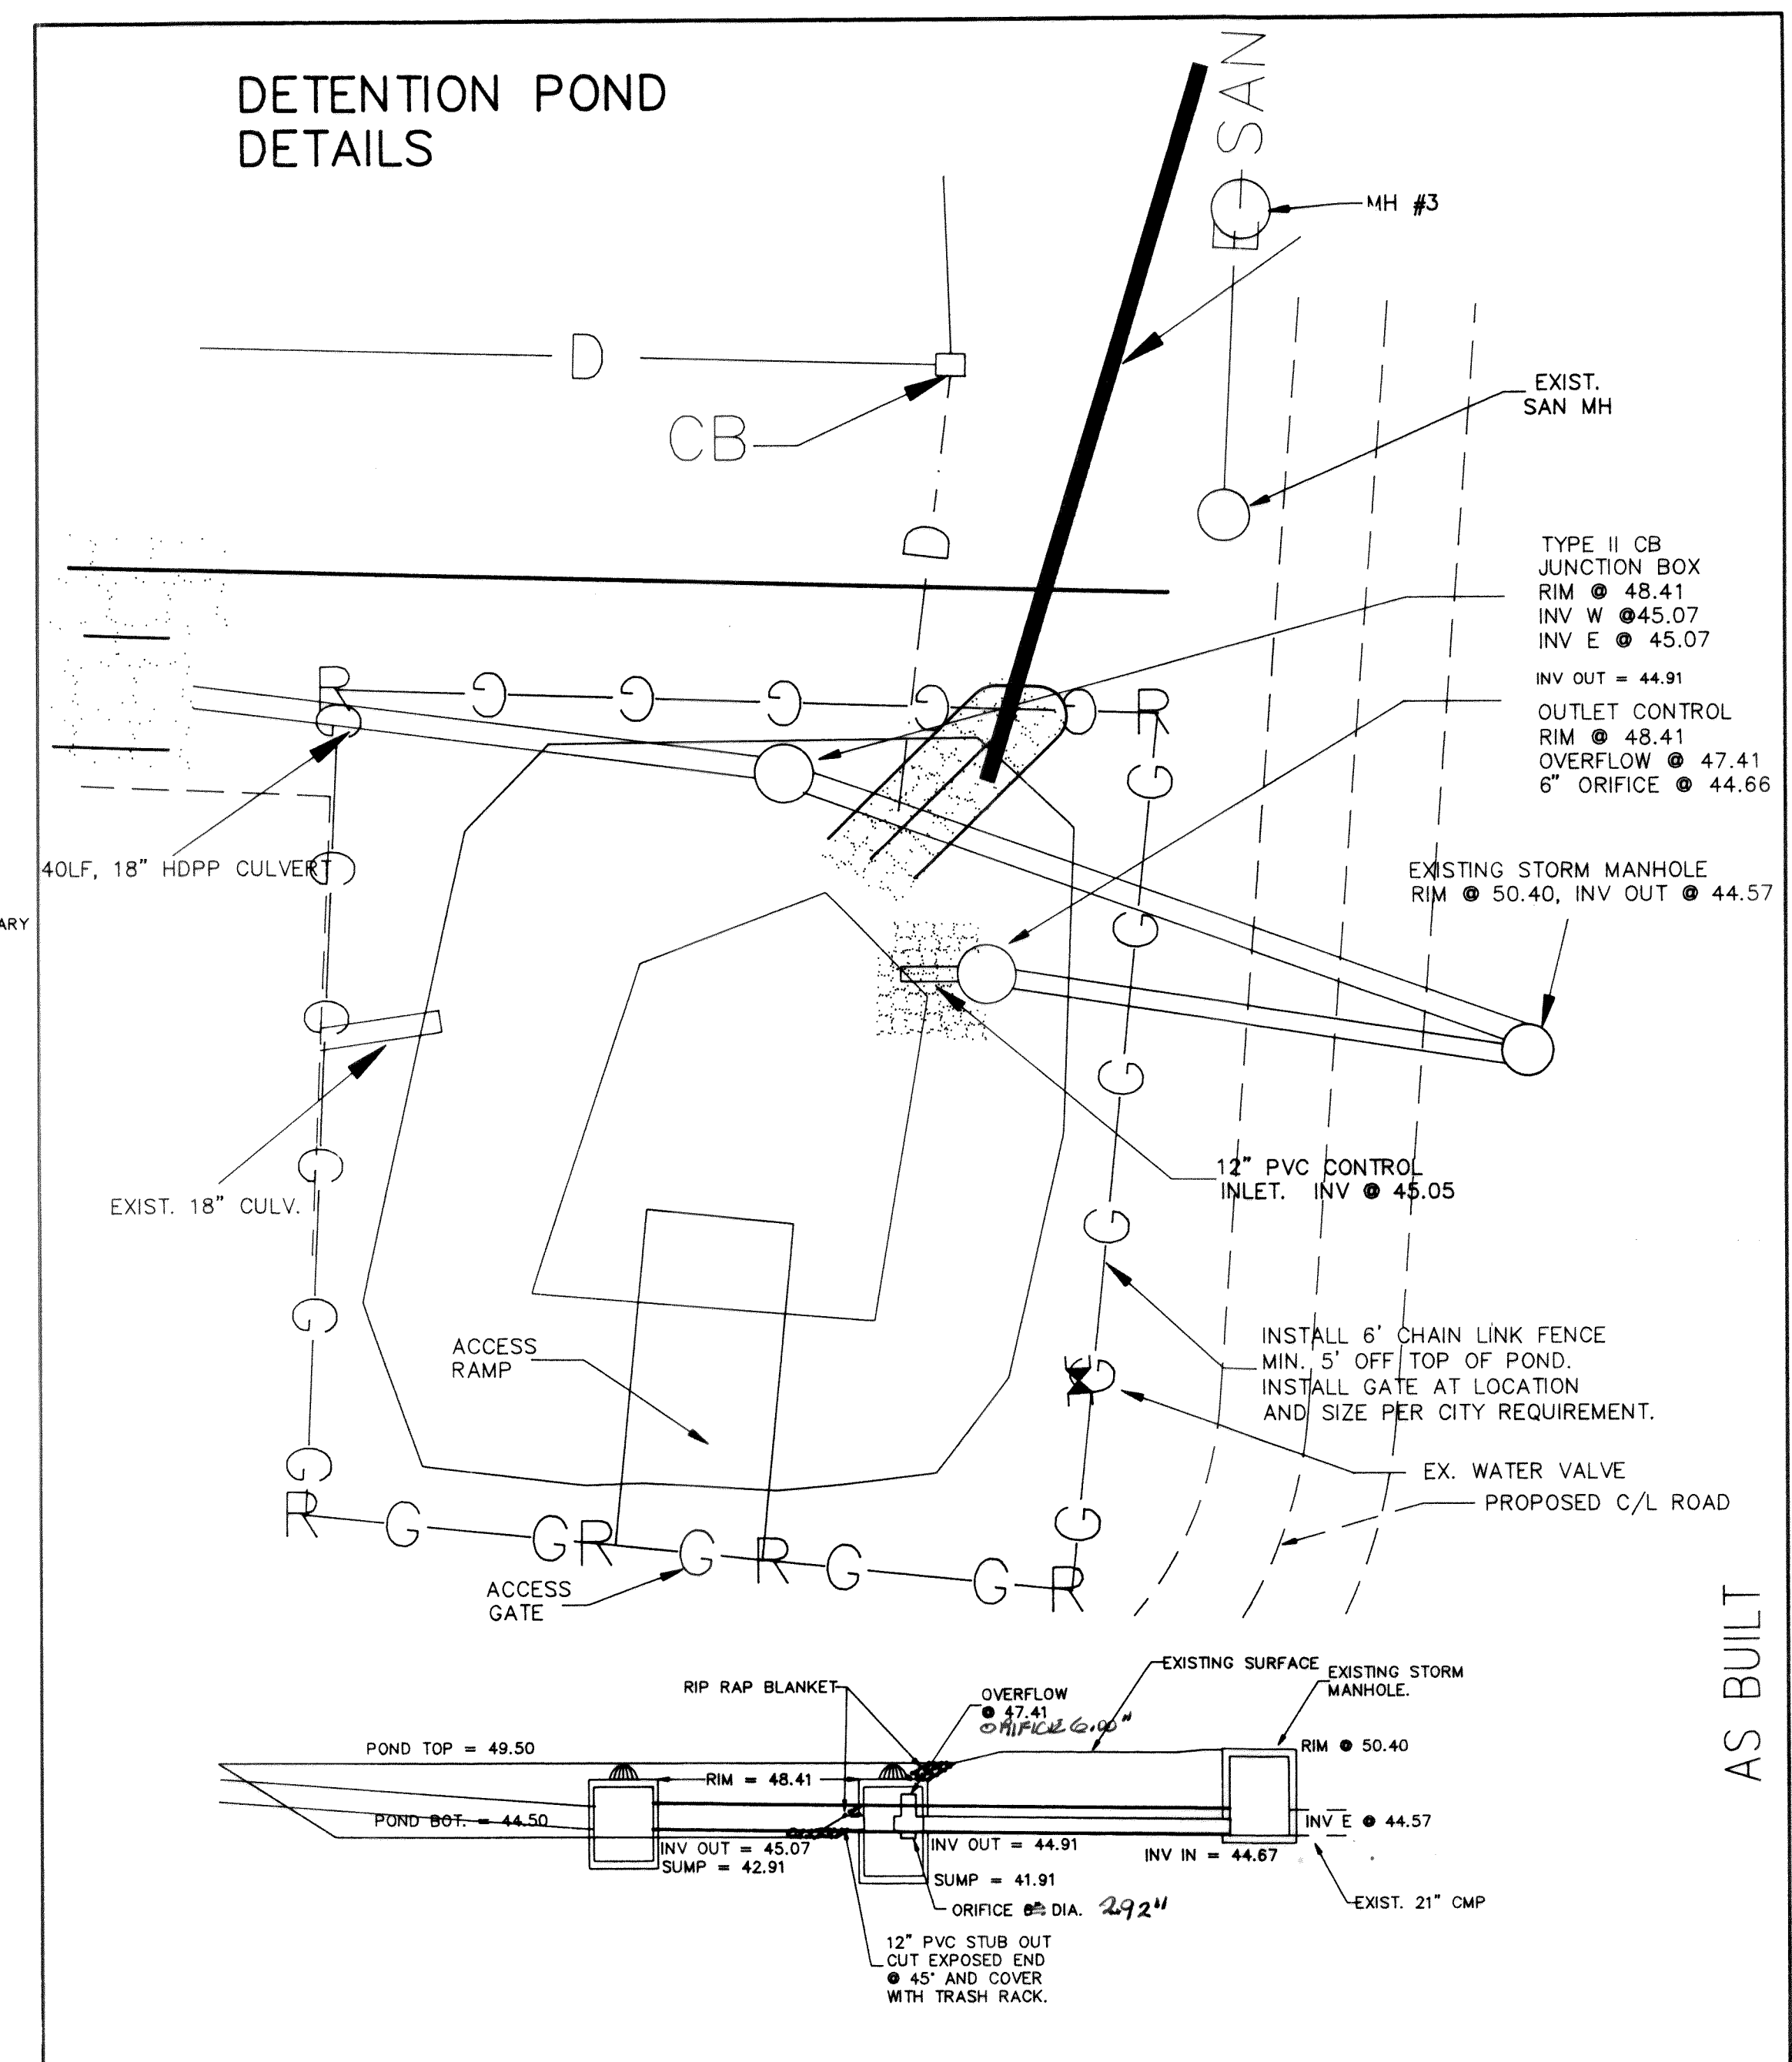


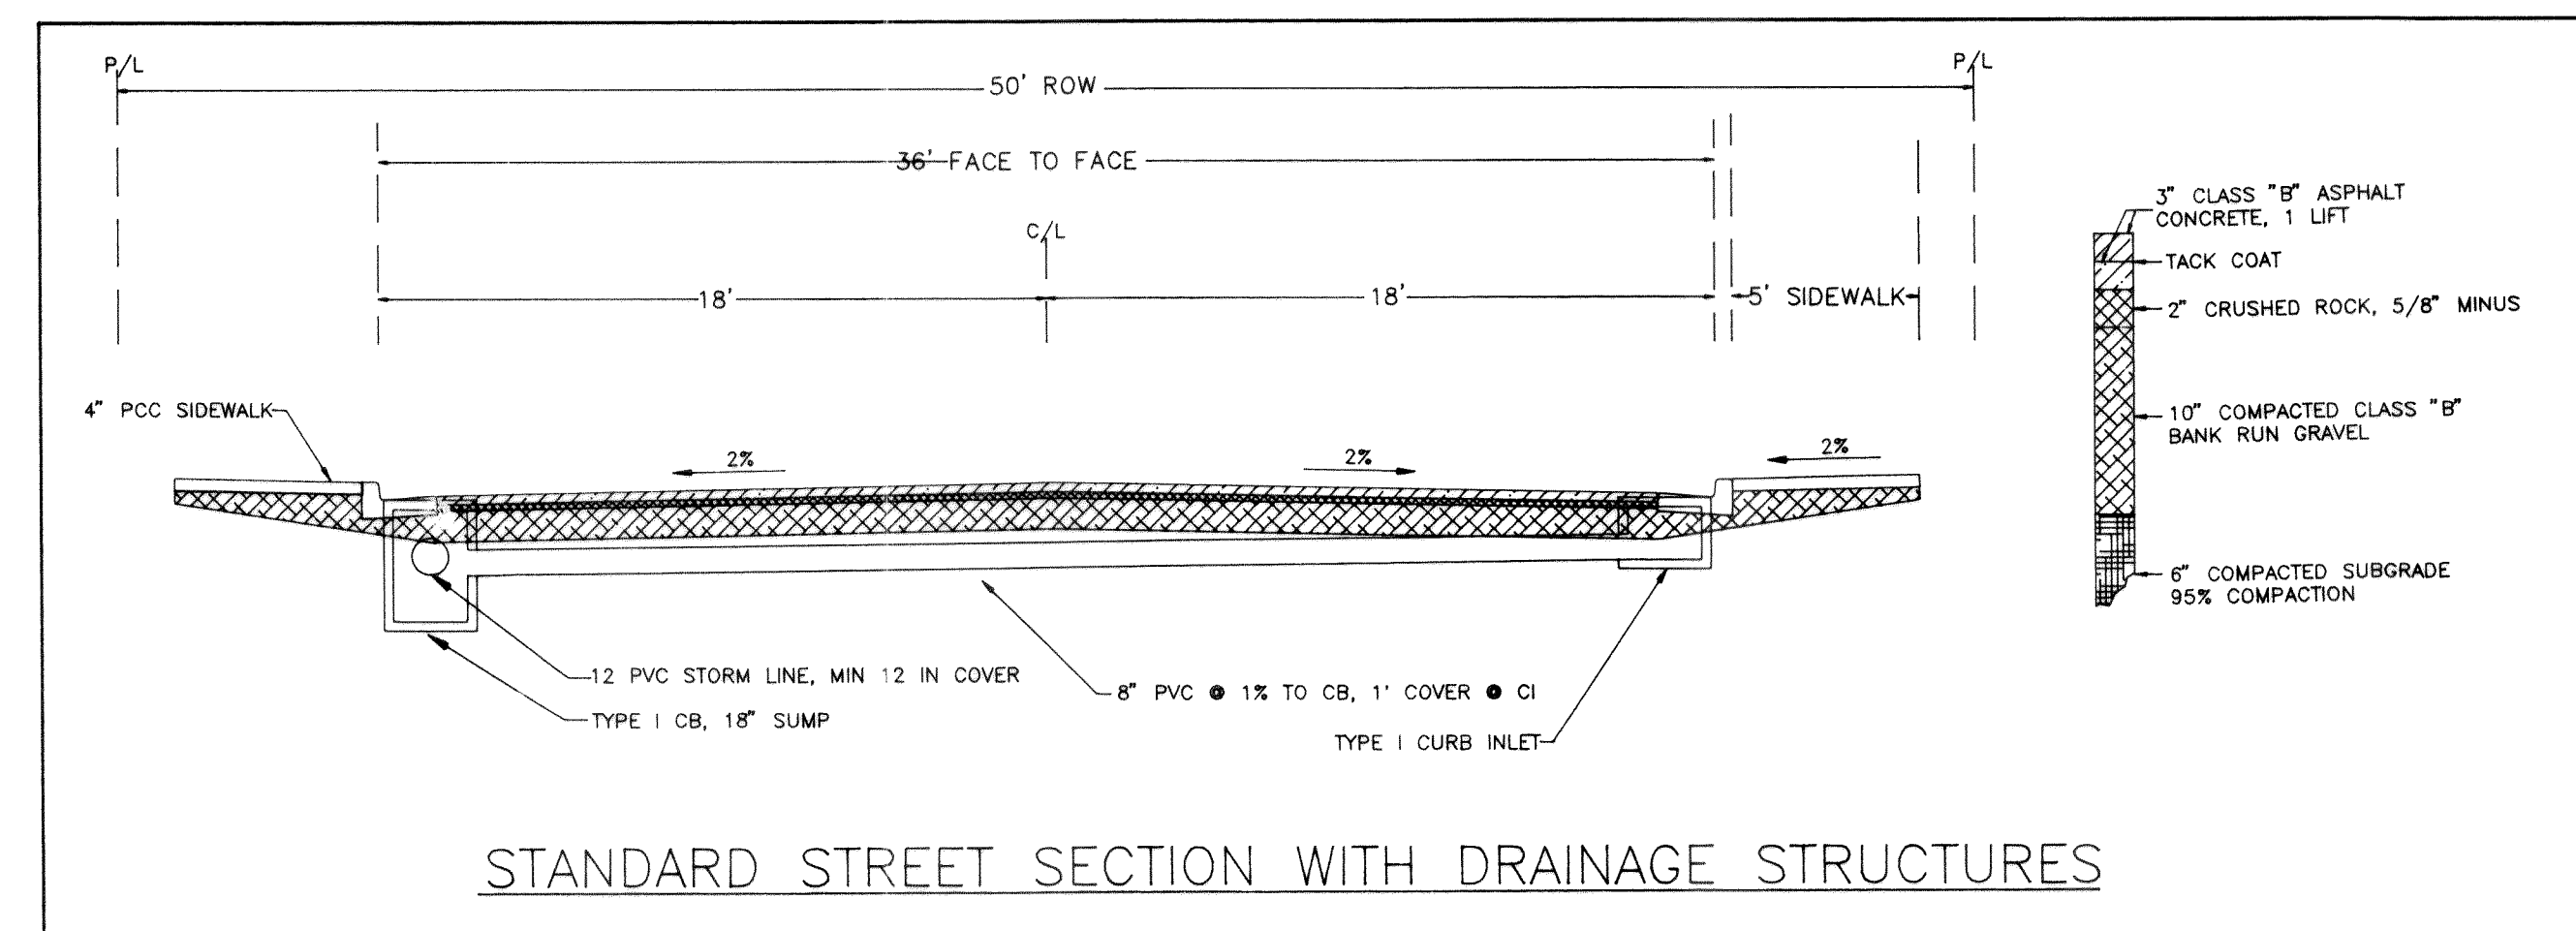

AS BUILT

THIS AS BUILT DRAWING WAS PREPARED BASED
ON SURVEY INFORMATION PROVIDED BY CONSTRUCTION
SURVEYORS, INC.

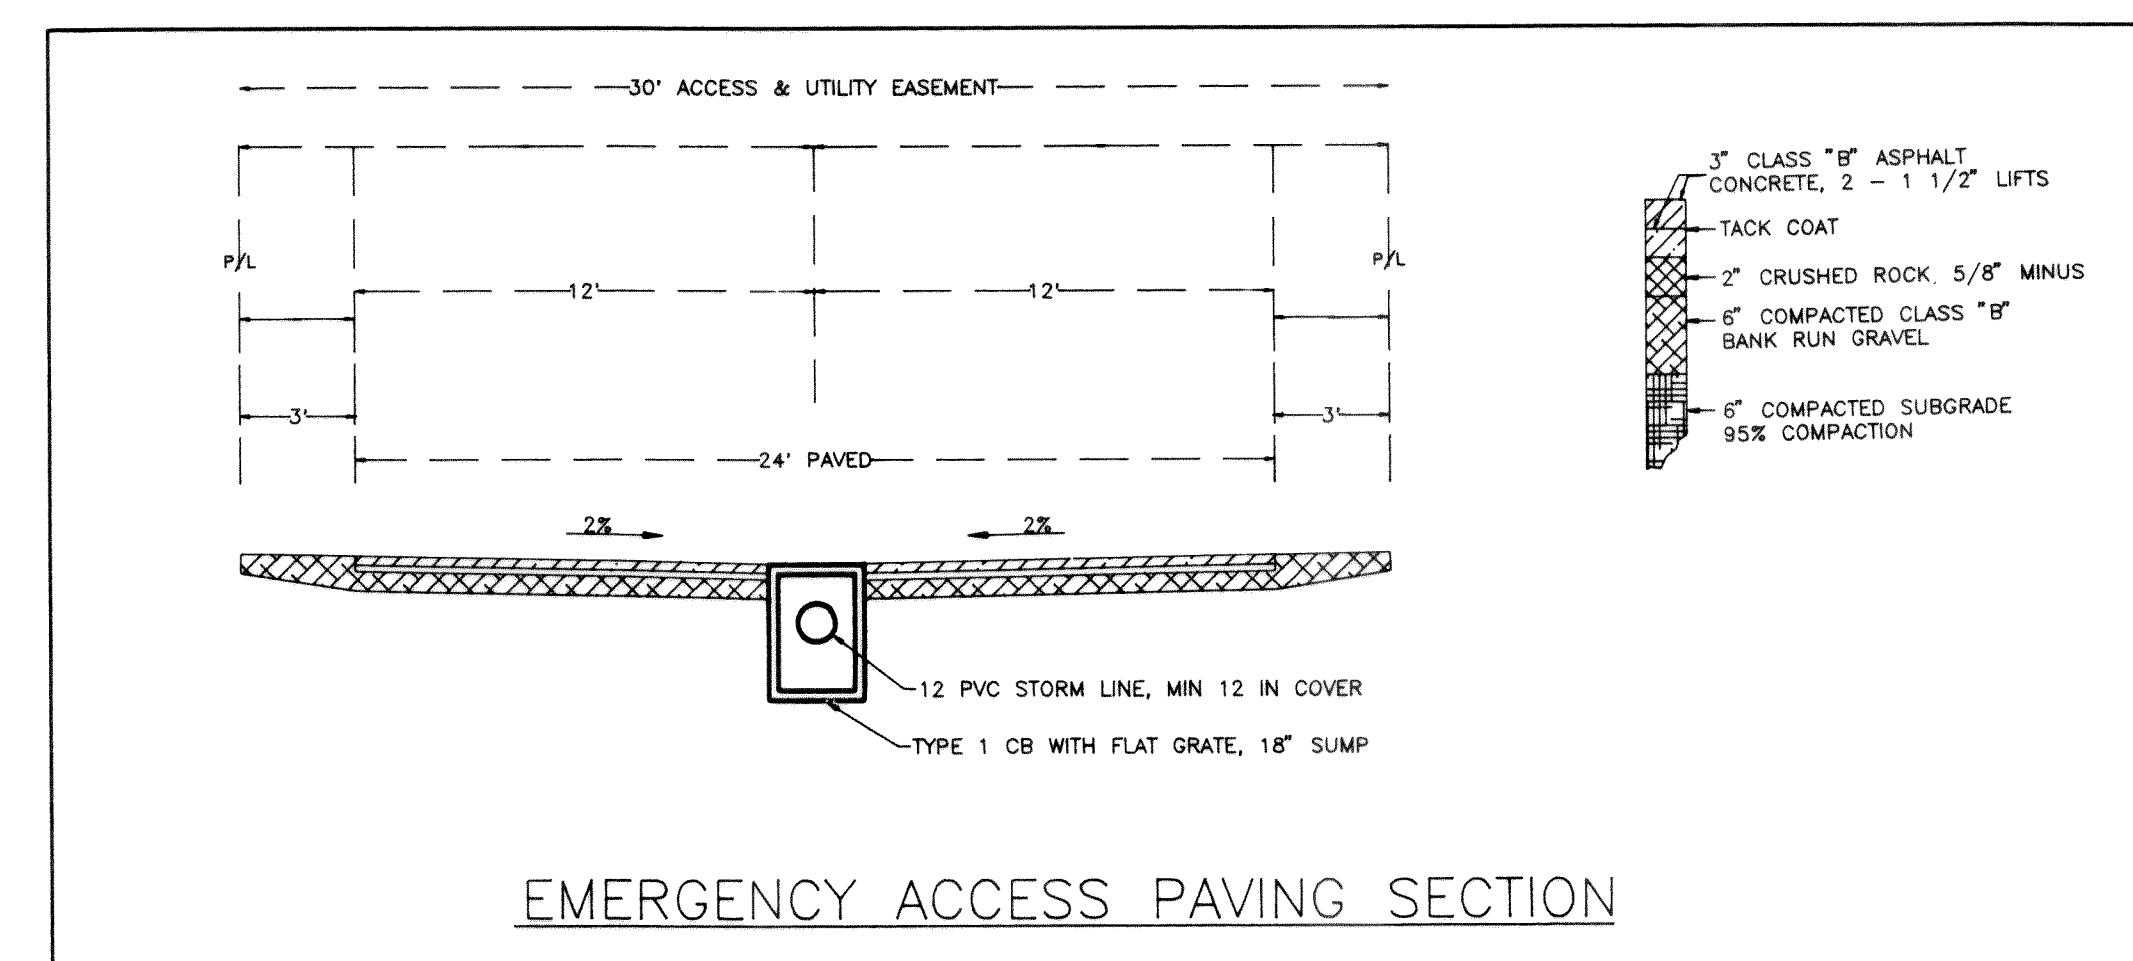


...METRON
CONSULTING GROUP, INC.

6951 Hannegan Rd. Suite 14
Lynden, Washington 98264 206-354-7617

DRAWN: B.C.S.

CHECKED: B.C.S.

FILE: 3G07B\AB-SH-1

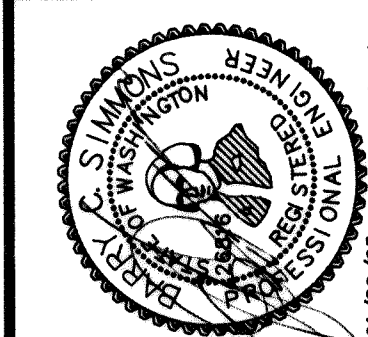

CONSTRUCTION OVERVIEW

ASHLEY MEADOW'S

REVISIONS

NO.	DATE	DESCRIPTION
1	10/1/19	...
2	10/2/19	...
3	10/3/19	...
31	10/31/19	...

1 07/06/94 ISSUE

2 08/19/94 CONST

3 11/05/94 DETEN.

4 01/20/95 ASBLD

1. **Introduction**

PROJECT NO. D.

3G07B 8/11

SHEET TITLE

SHEET TITLE
AS BUILT

CONSTRUCT


OVERVIEW

AS BUILTS

SHEET NO.

SHEET NO.

1 OF 4

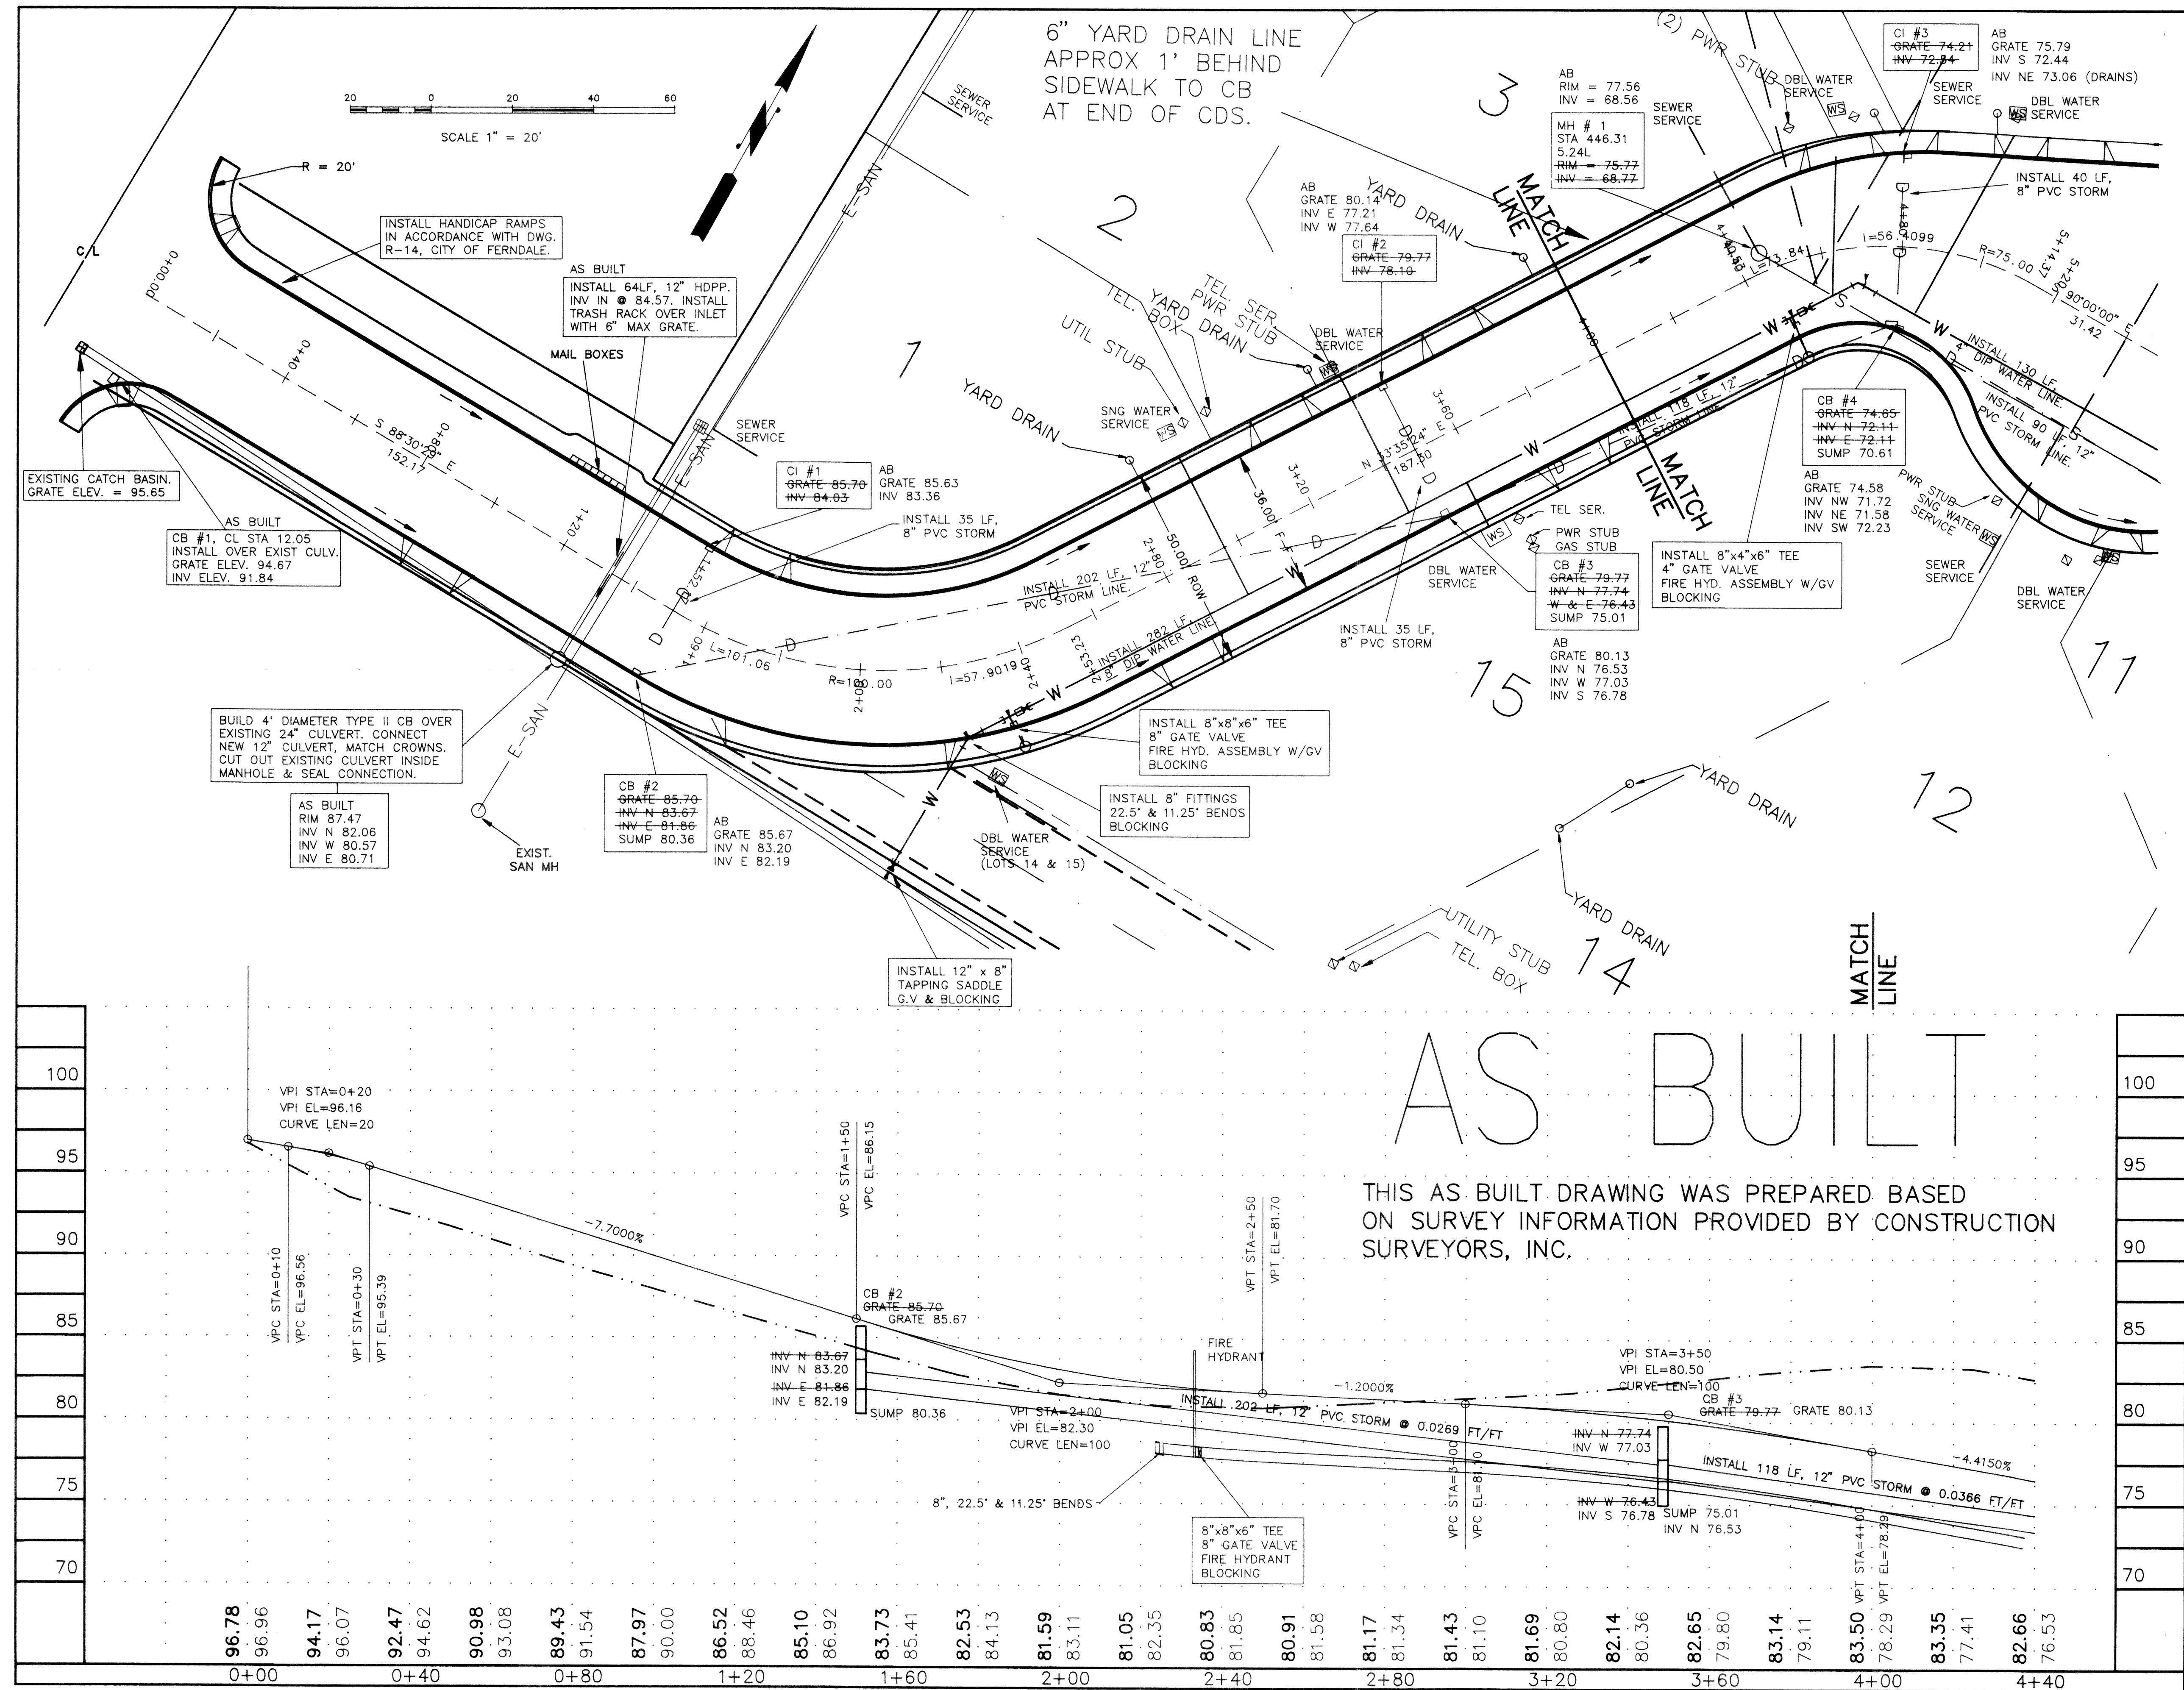


CONSULTING GROUP, INC.

6951 Hannegan Rd. Suite 14
Lynden, Washington 98264 206-354-7617

DRAWN: B.C.S.

CHECKED: B.C.S.

FILE: AB-SH-2.DWG

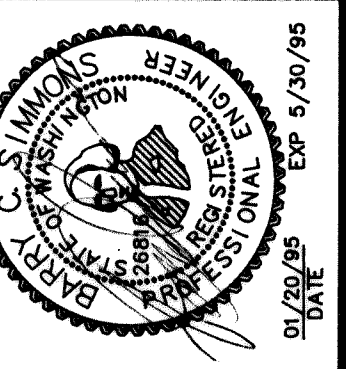

ASHLEY MEADOW'S

STREET & UTILITIES PLAN & PROFILE

STATION 0+00 - 4+00


NO.	DATE	DESCRIPTION
1	07/06/94	ISSUE
2	08/19/94	CONST.
3	12/13/94	ASBUILT

PROJECT NO. DATE
3607B 8/11/94


SHEET TITLE
AS BUILT
STREET P&P
BOP - 4+00

SHEET NO.
2 OF 4

00011.002 2.10.06

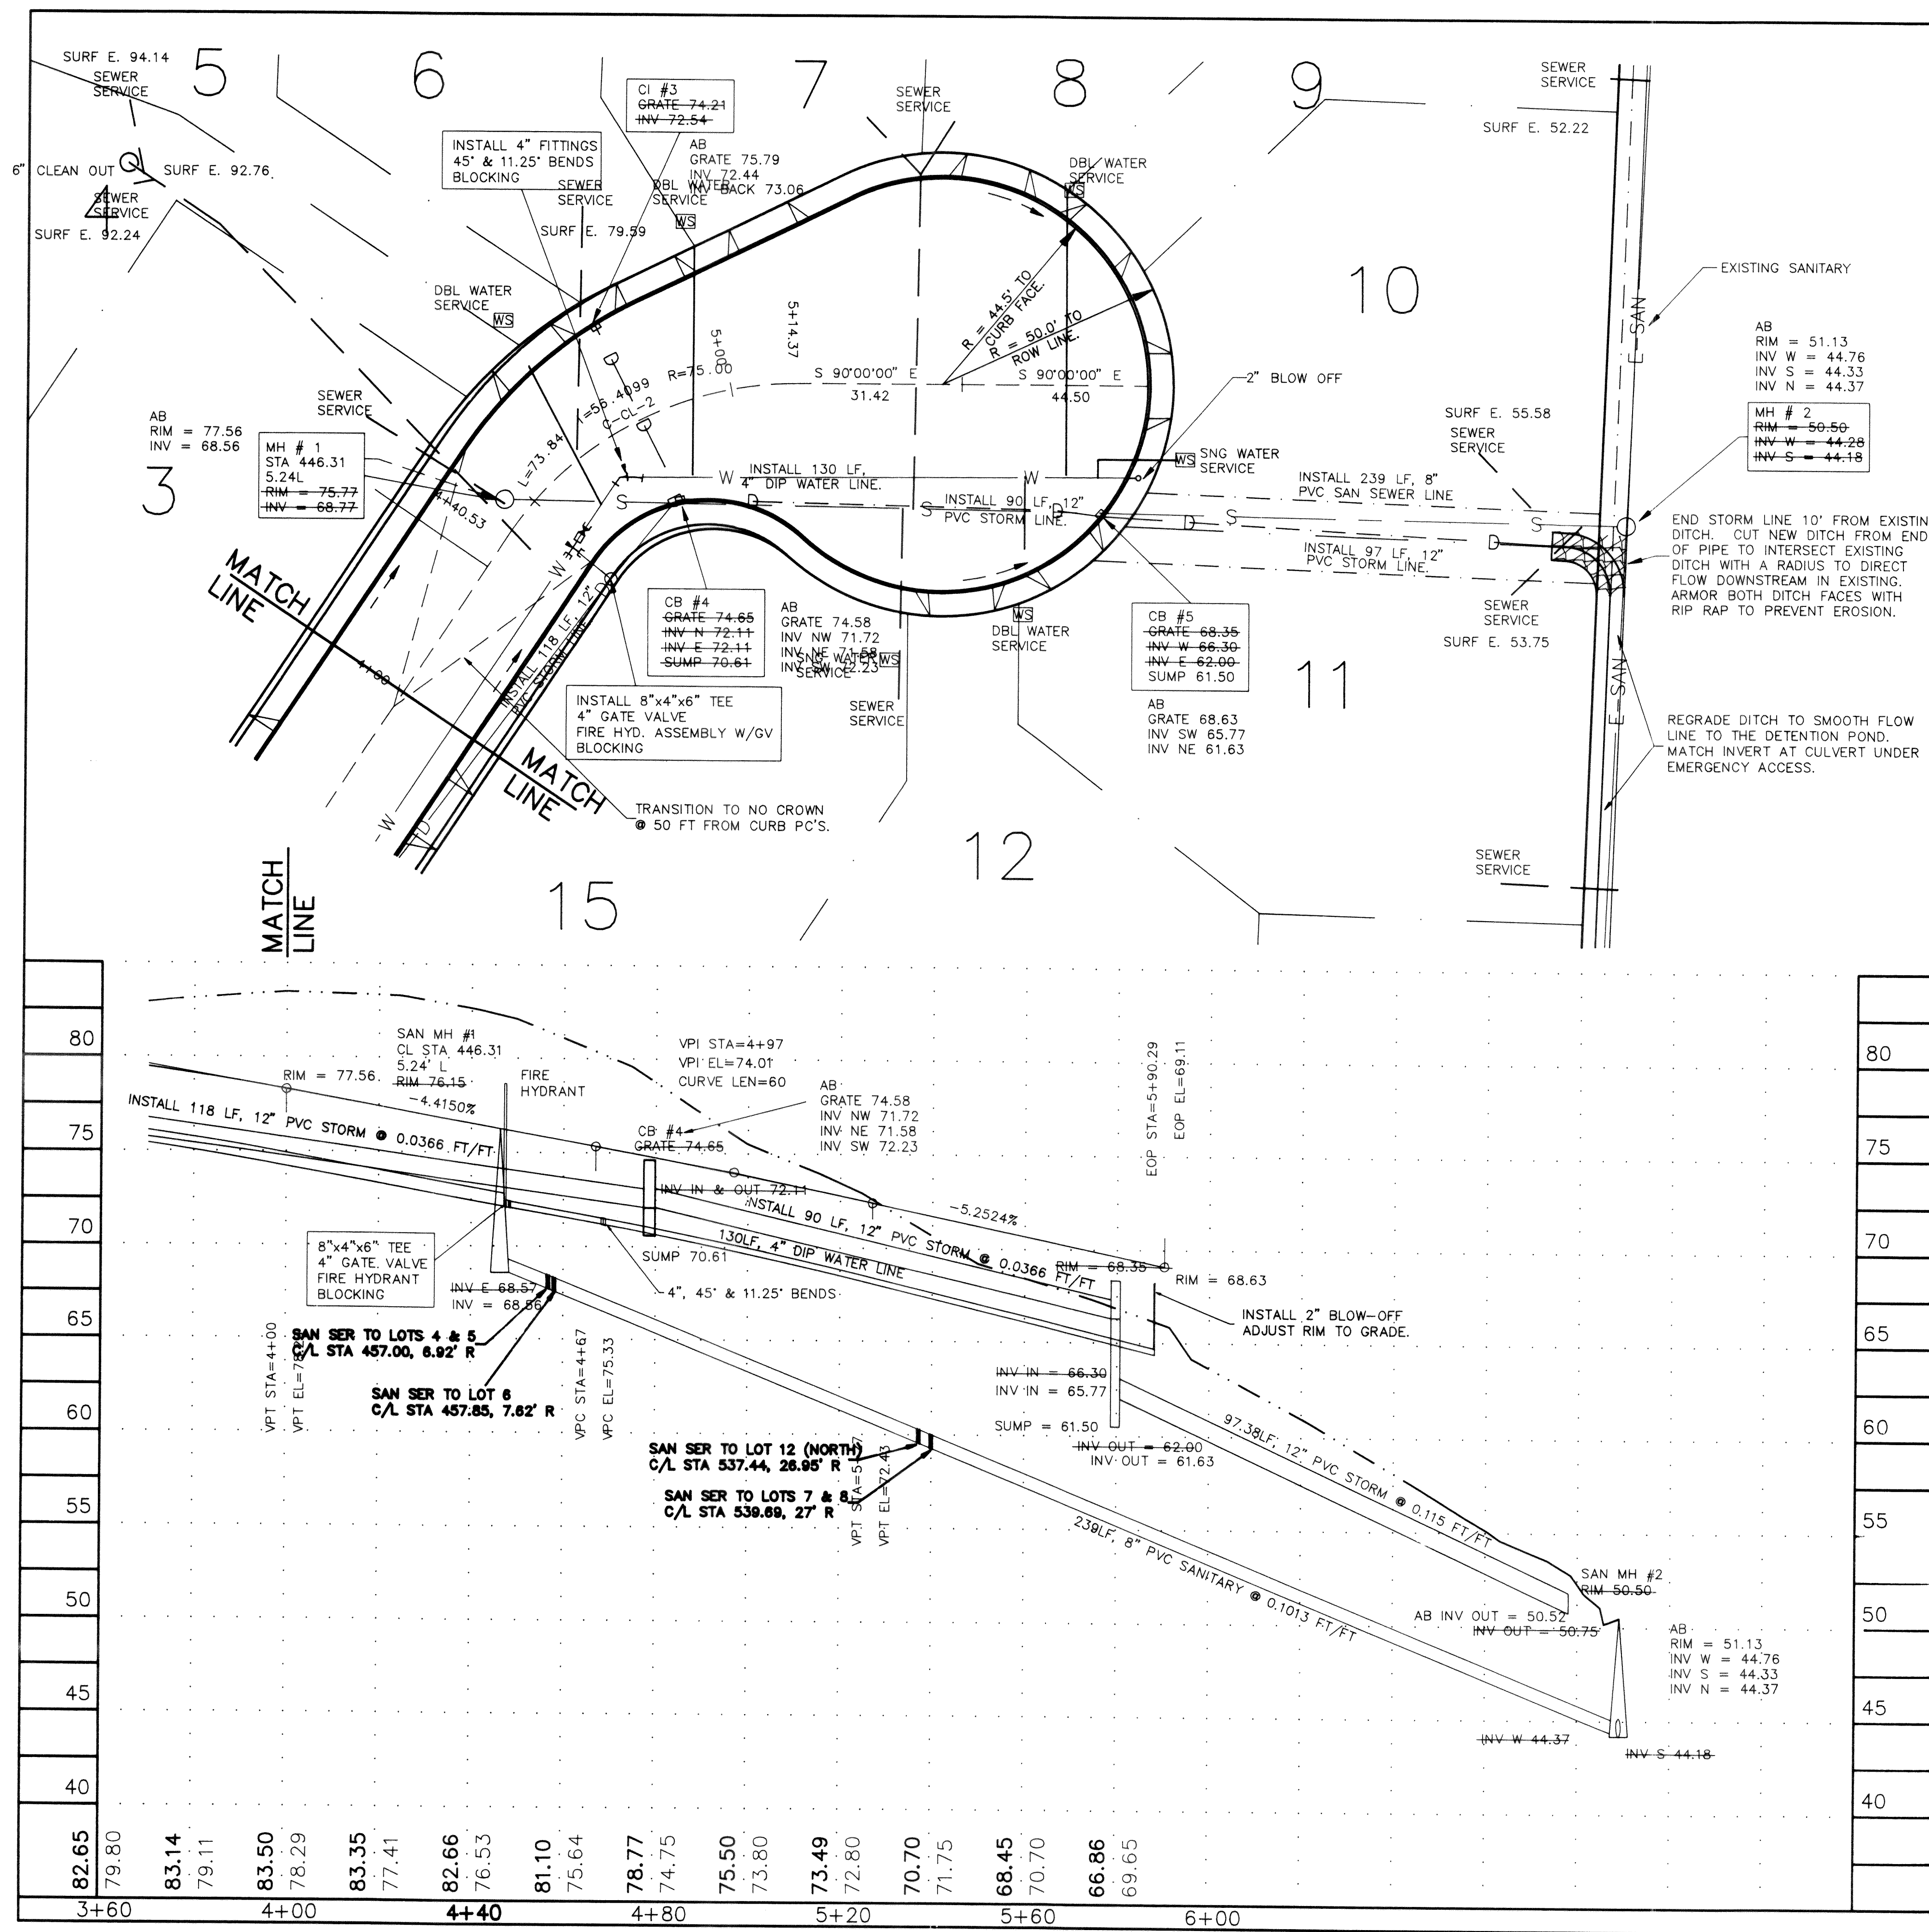



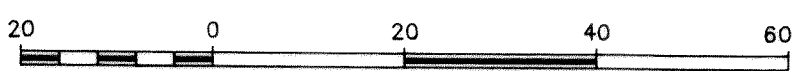

SCALE 1" = 20'


LEGEND

	STORM DRAIN
	WATER MAIN
	SANITARY MAIN
	15 PROPERTY LINE, LOT #
	STREET CENTER LINE
	E-SAN EXISTING SANITARY MAIN

- GENERAL NOTES
1. ALL WORK SHALL CONFORM TO CITY OF FERNDAL STANDARDS WHERE THEY EXIST, OTHERWISE TO WASHINGTON STATE DOT/APWA STANDARDS.
 2. ALL WATER METERS LOCATED IN TRAFFIC AREAS, INCLUDING DRIVE WAYS SHALL HAVE TRAFFIC COVERS. SEE CITY OF FERNDAL DRAWING W-7.
 3. ALL FILL/BACKFILL IN TRAFFIC AREAS SHALL BE OF A STRUCTURAL QUALITY AS PER WSDOT.
 4. ALL DITCHES/SWALES SHALL BE GRADED WITH A SMOOTH FLOWLINE, A MINIMUM OF 1.5' DEEP AND 5' WIDE. VEGETATION SHALL BE ESTABLISHED IMMEDIATELY AFTER GRADING.
 5. THE CUL DE SAC SHALL BE SURFACED WITH NO CROWN FROM THE TRANSITION AREA. THE SURFACE SHALL HAVE A UNIFORM CROSS SLOPE FROM GUTTER PAN TO GUTTER PAN PERPENDICULAR TO THE CENTERLINE.

AS BUILT

THIS AS BUILT DRAWING WAS PREPARED BASED ON SURVEY INFORMATION PROVIDED BY CONSTRUCTION SURVEYORS, INC.

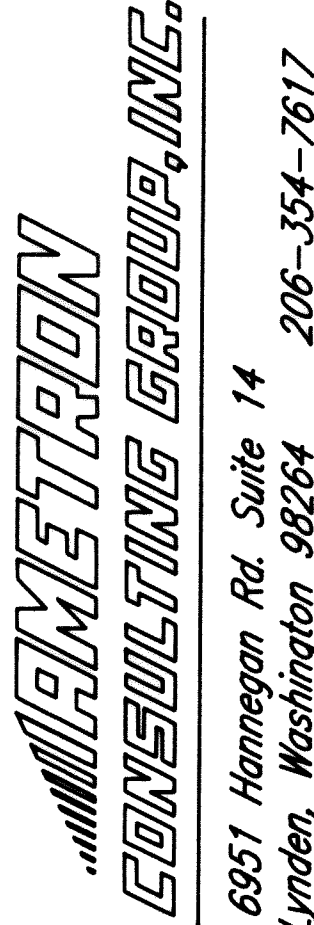

6951 Hannegan Rd. Suite 14
Lynden, Washington 98264 206-354-7617

DRAWN: B.C.S.
CHECKED: B.C.S.
FILE: AB-SH-3



STREET & UTILITIES
PLAN & PROFILE
STATION 4+00 - END

ASHLEY MEADOW'S


REVISIONS	
NO.	DATE DESCRIPTION
1	07/06/94 ISSUE
2	08/19/94 CONST.
3	12/14/94 ASBUILT

PROJECT NO.	DATE
3607B	8/11/94

SHEET TITLE

AS BUILT
STREET P&P
4+00 - END

SHEET NO.
3 OF 4

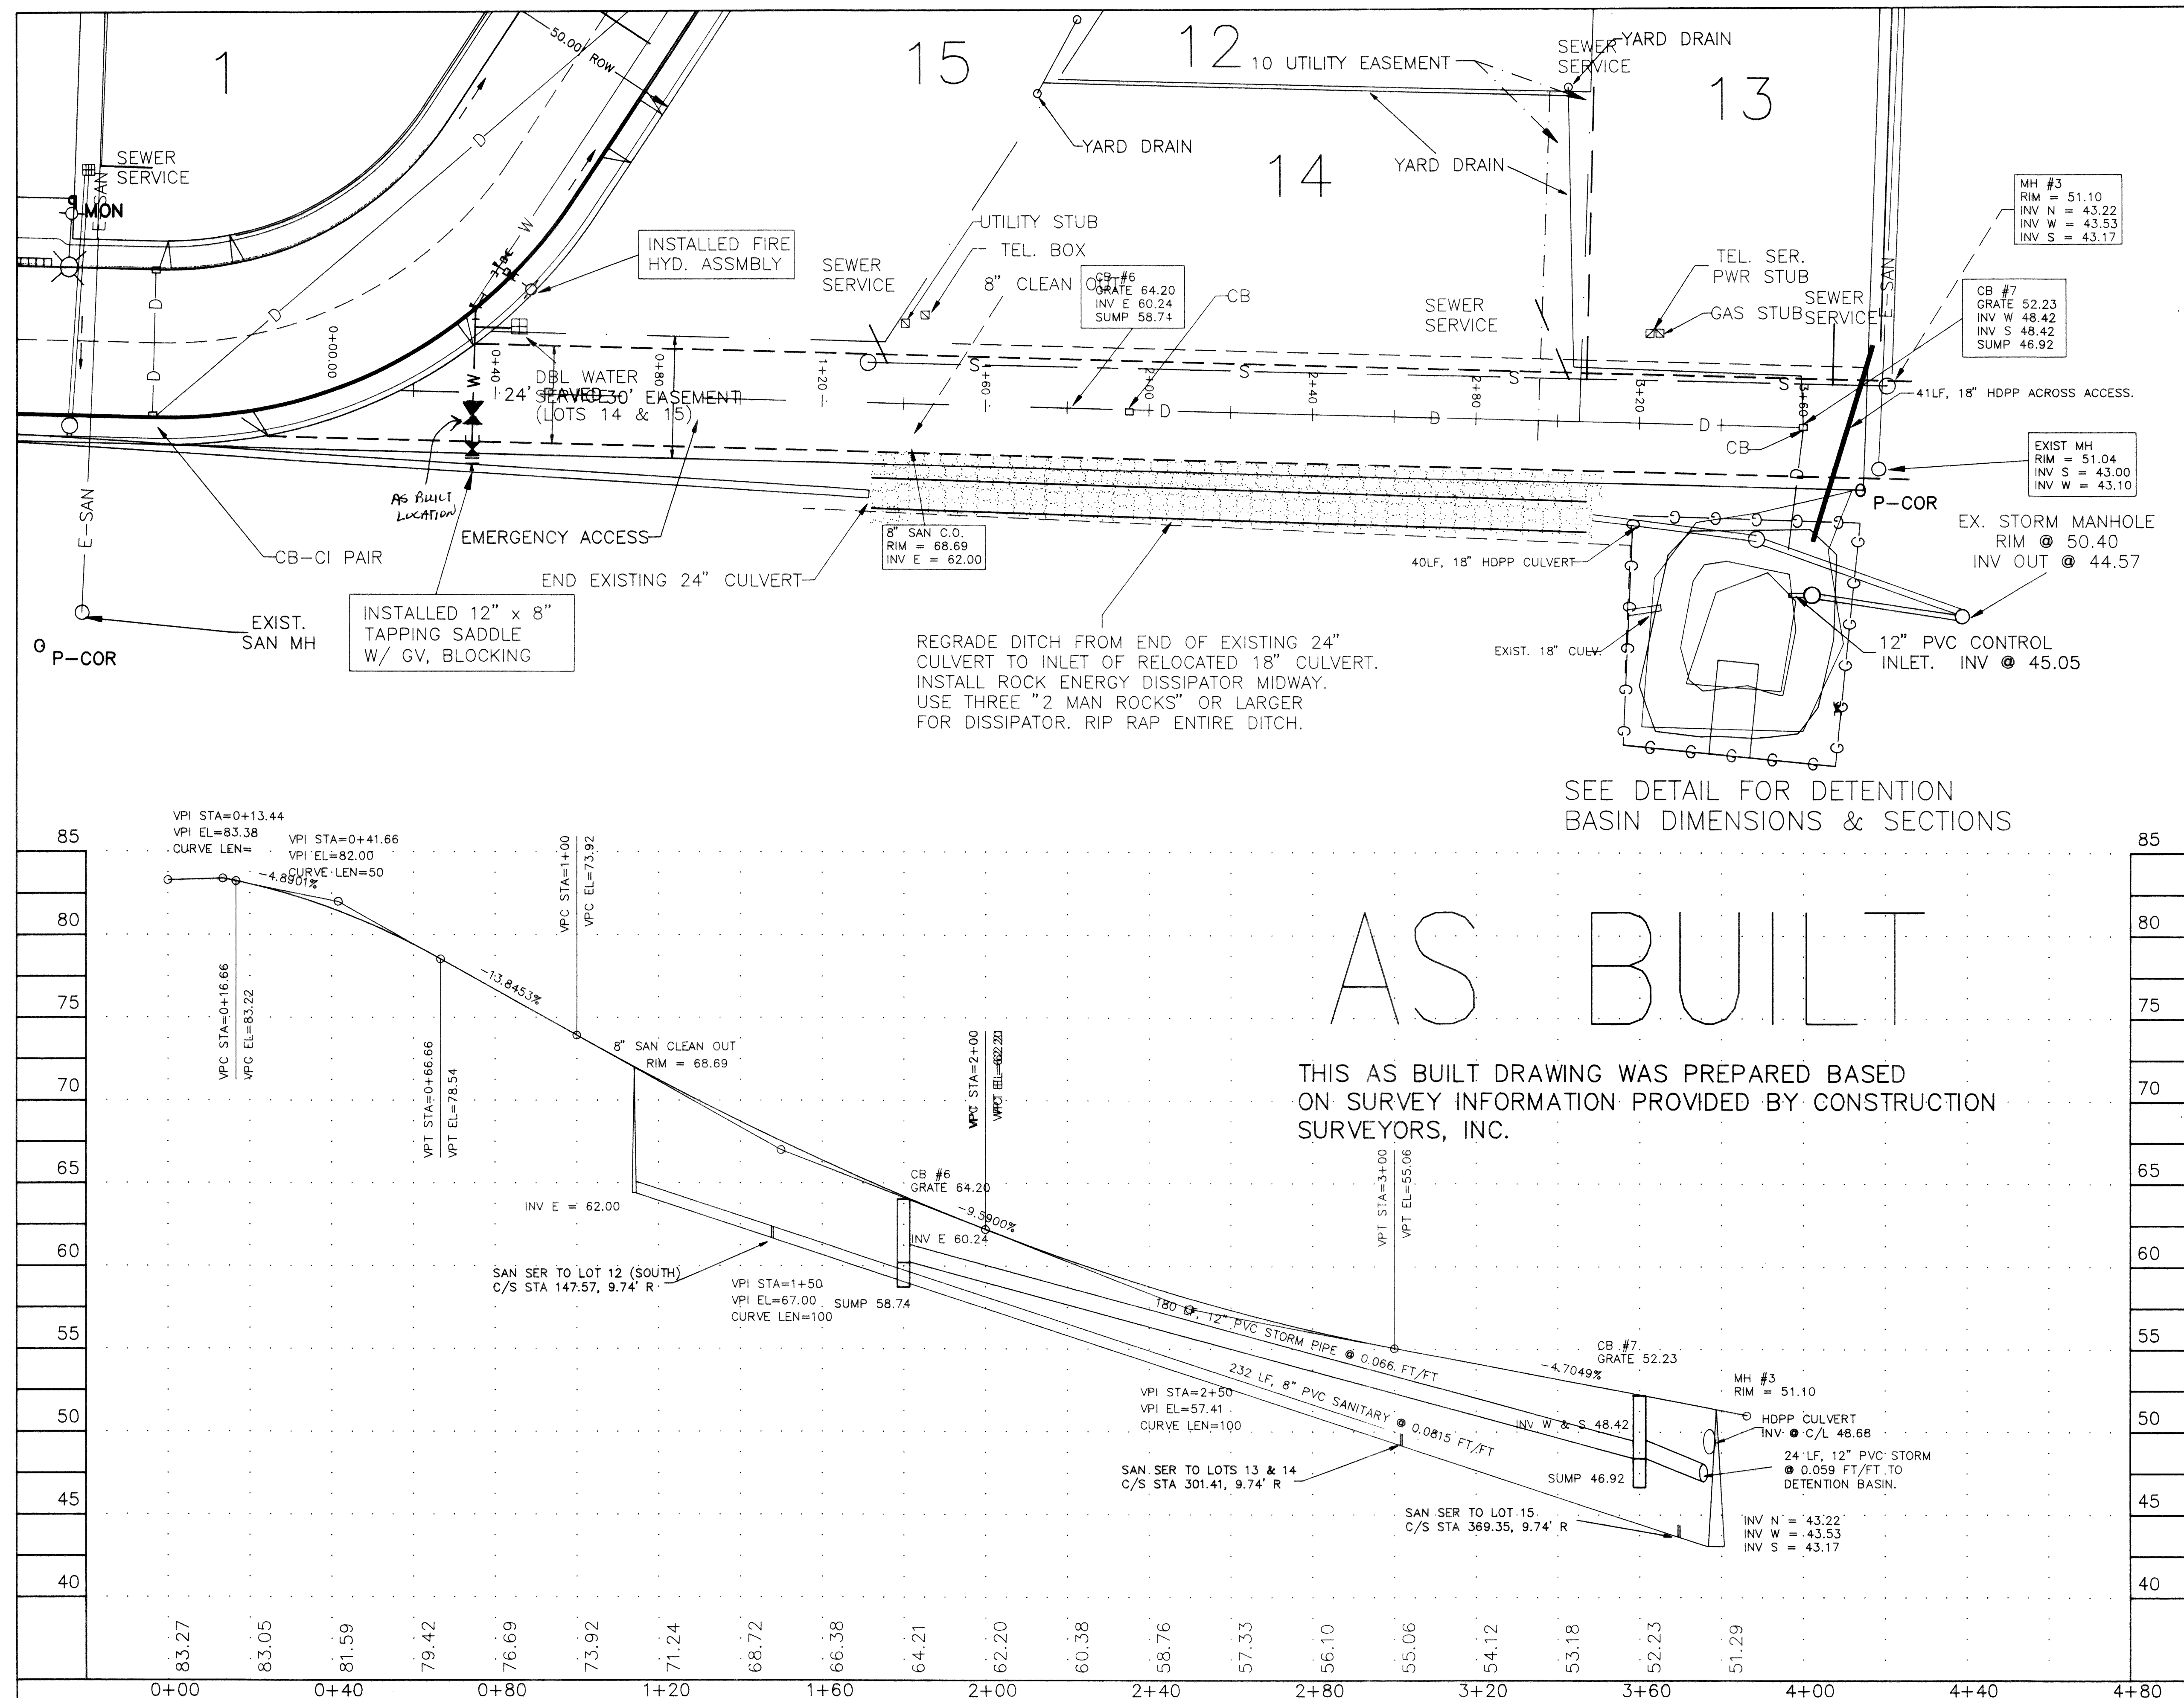

6951 Hannegan Rd. Suite 14
Lynden, Washington 98264 206-354-7617

00011.004 2.10.06 KE

DRAWN: B.C.S.

CHECKED: B.C.S.

FILE: 3G07B\AB-SH-4

EMERGENCY ACCESS W/UTILITIES
PLAN & PROFILE

ASHLEY MEADOW'S

REVISIONS

NO.	DATE	DESCRIPTION
1	07/06/94	ISSUE
2	08/19/94	CONST.
3	01/20/95	ASBLD

PROJECT NO. DATE

3G07B 8/11/94

SHEET TITLE

AS BUILT
EMER. ACCESS
W/UTILITIES

SHEET NO.

4 OF 4