



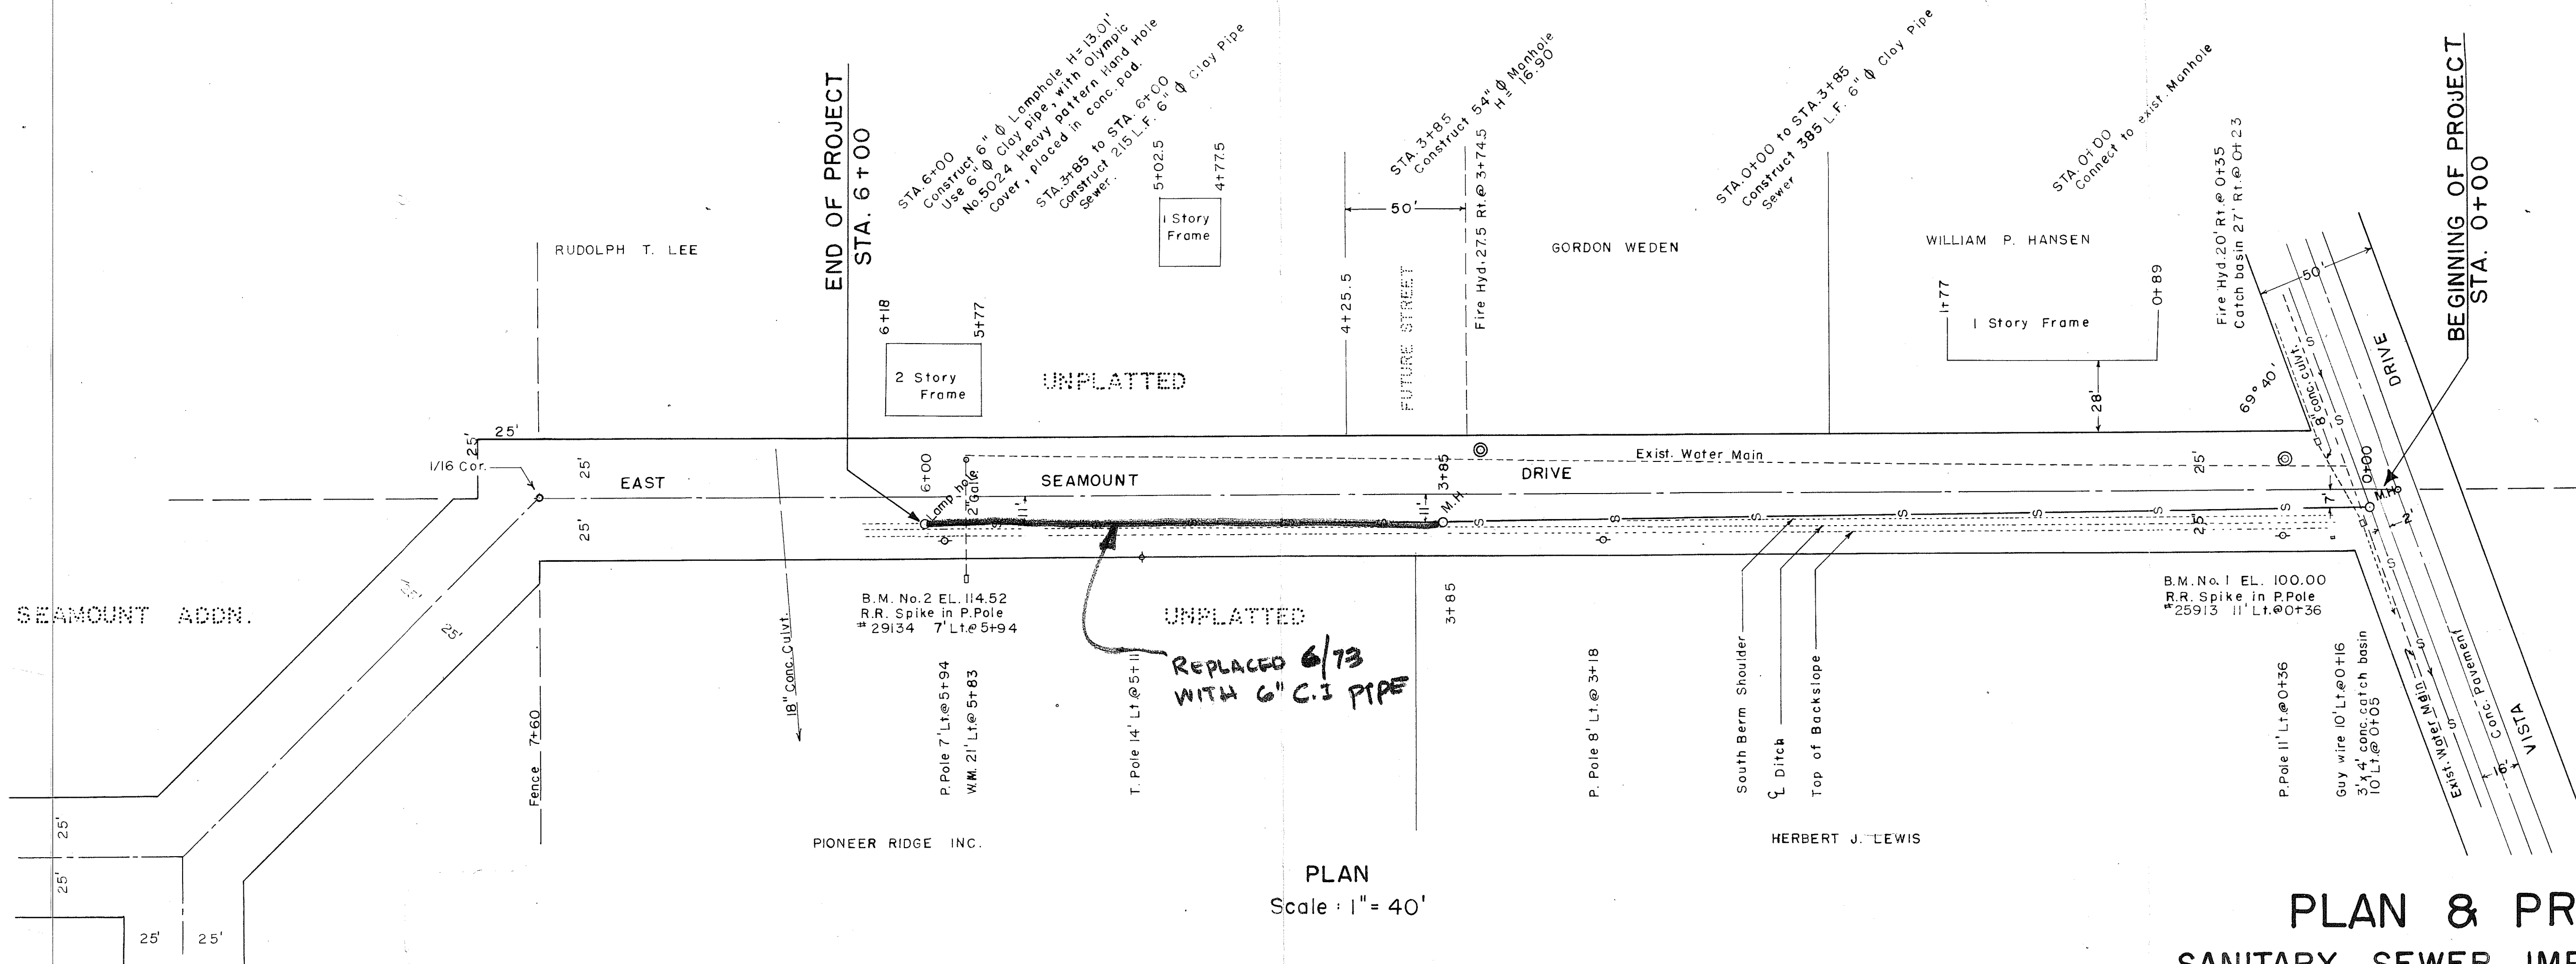


PLAN
Scale: 1" = 40'

PLAN & PROFILE SANITARY SEWER IMPROVEMENT EAST SEAMOUNT DRIVE VISTA DRIVE EAST 600 FT. FERNDAL, WASHINGTON

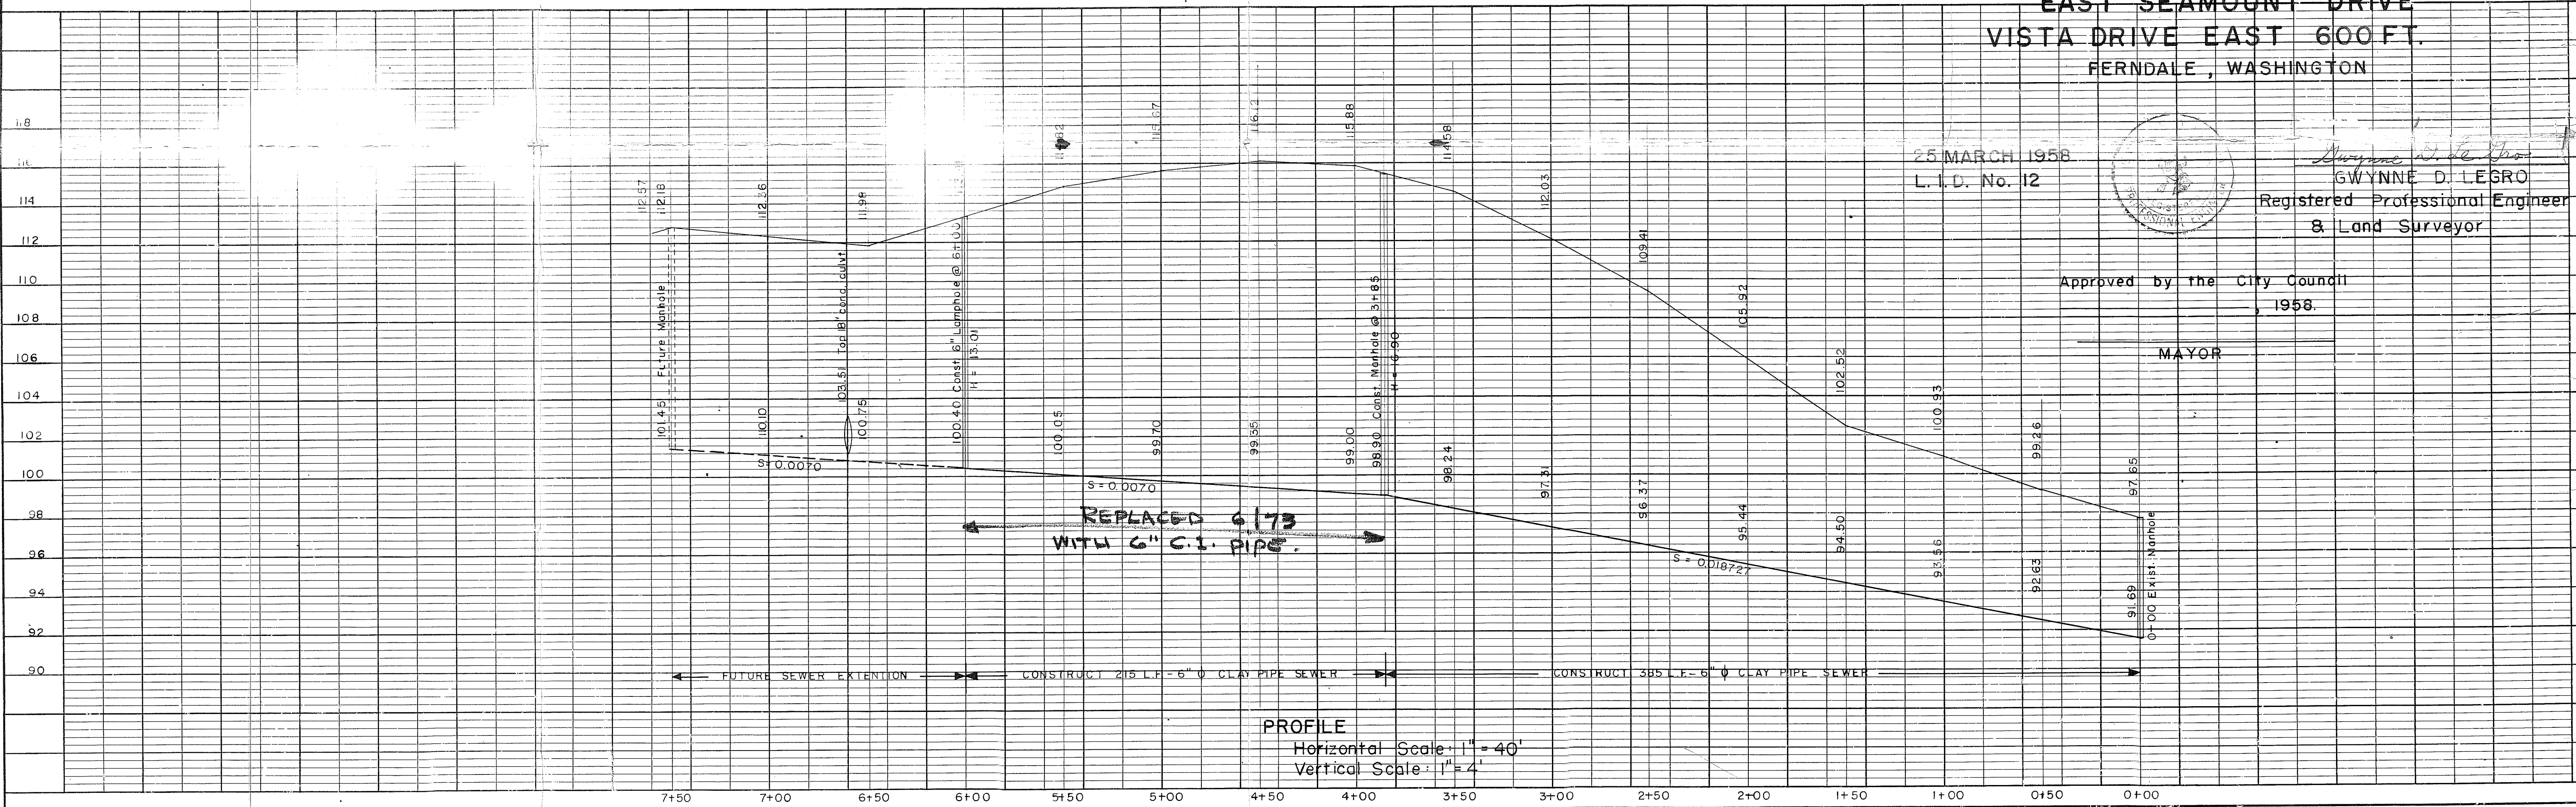

PROFILE
Horizontal Scale: 1" = 40'
Vertical Scale: 1" = 4'

25 MARCH 1958
L.I.D. No. 12

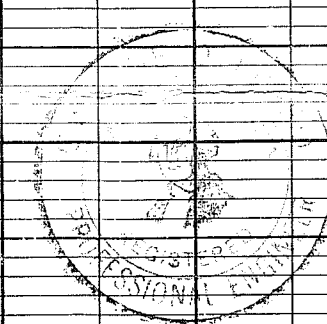

Gwynne D. Legro
Registered Professional Engineer
& Land Surveyor


Approved by the City Council
1958.

MAYOR

588.03 at 7/5/12

Q4

L.I.D. #12

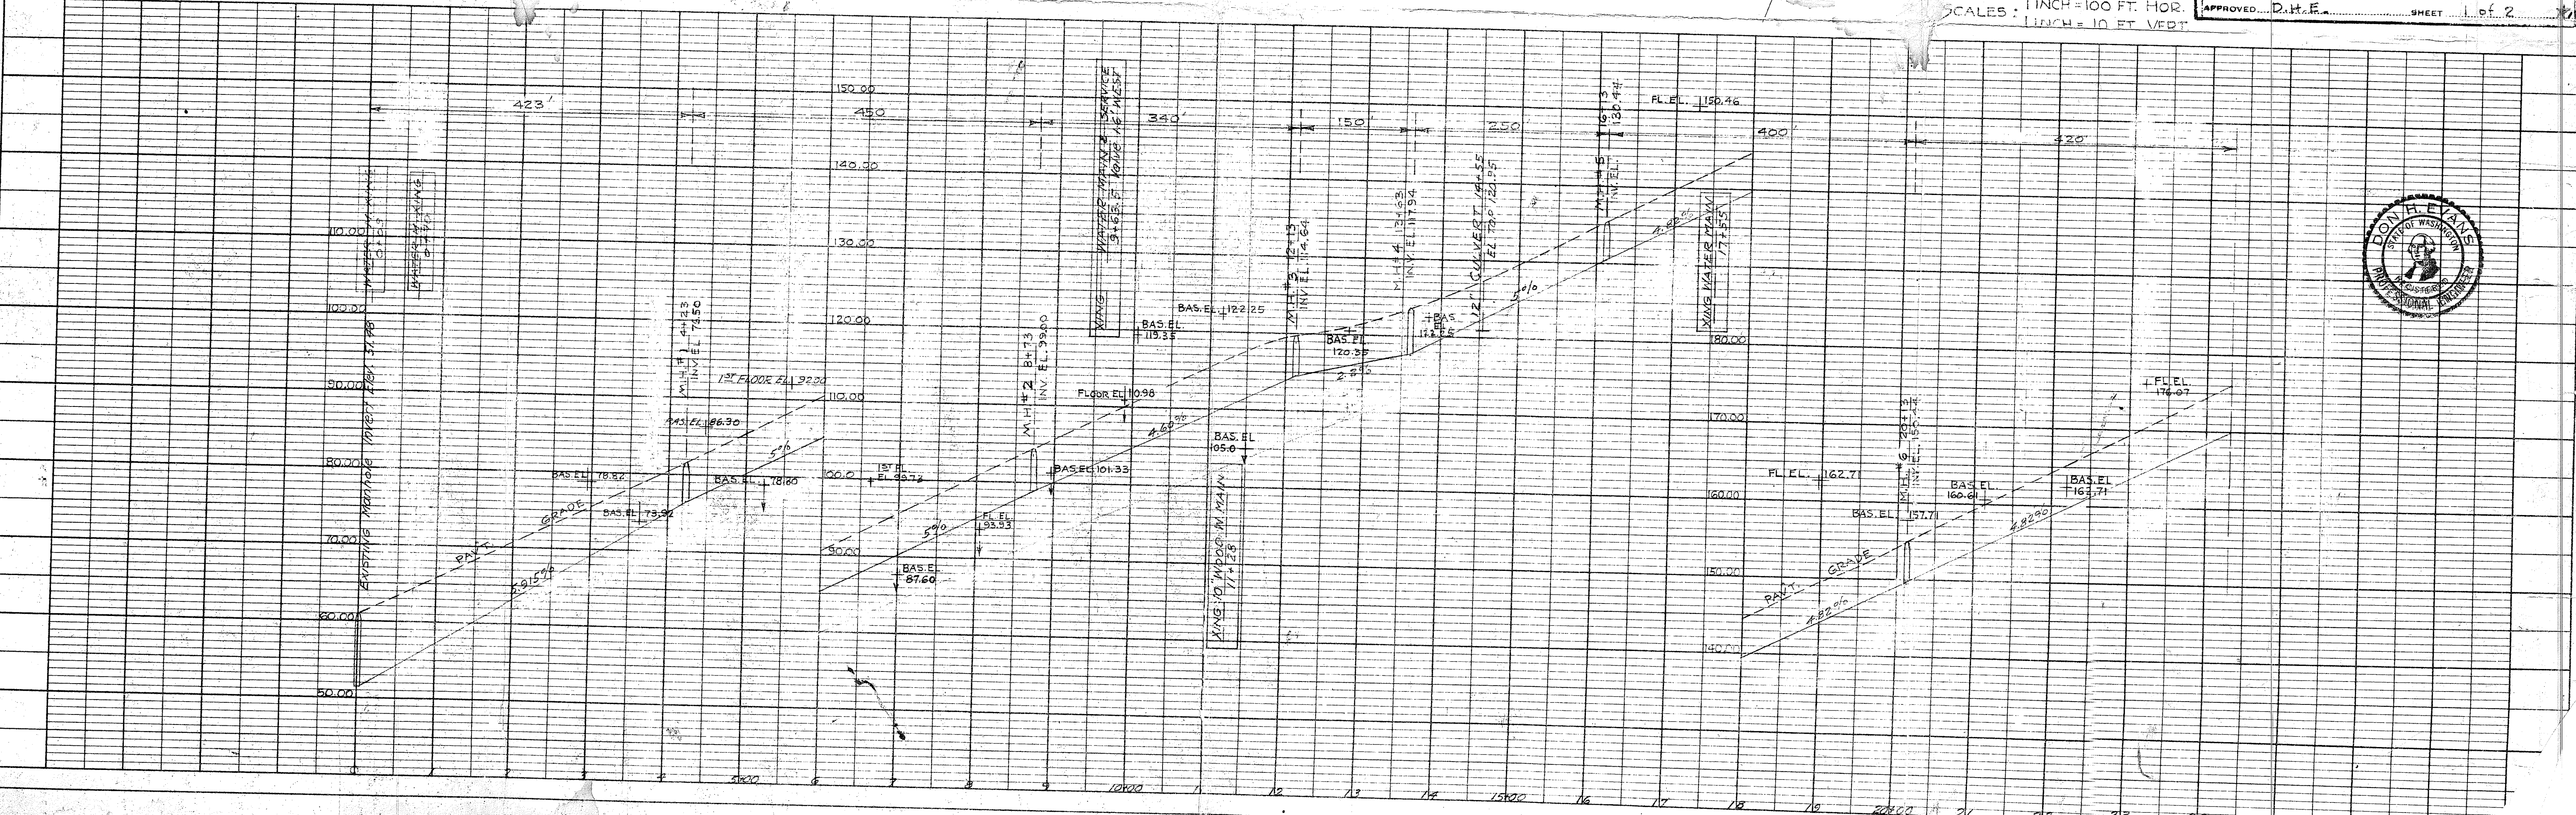

NOTES:

L.I.D. #11


Q4-

1. Approx. 243.3' of 8" Vit. Clay Sewer, this sheet.
2. 13-8"x8"x6" V.C. Wye house connections to be located by Engineer during construction, see typical sketch.
3. All Sewer pipe to be Vitrified Clay.
4. Specifications are to be "City of Seattle Standard Plans & Specifications, 6th Edition (Substitute Ferndale for Seattle)".
5. Contractor must protect water lines during work; if lines are broken, contractor must repair same as per ruling specs. at contractor's expense.
6. Pipe laid in wet trench or where line will be subject to submersion in storm water shall be coated with oakum, or equal and a suitable compo used in the joints. Oakum or equal shall be used in all cement mortar joints.
7. Backfill pavement cuts "carefully, topping with 12" crushed rock & 3" Asphaltic concrete.

7/5/7




2018.09.01 7/7

FERNDALE LOCAL IMP. DIST. NO. 11	
WHATCOM CO.-WASH.	
DON H. EVANS, INC.	
CIVIL & STRUCTURAL ENGRS.	
LAND SURVEYORS	
DRAWN BY	DATE
CHECKED BY	JOB NO.
APPROVED	SHEET

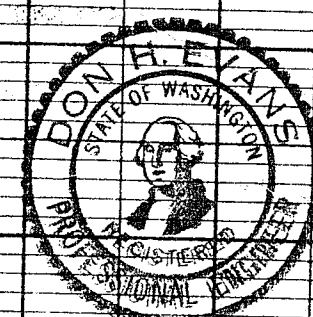

PLAN	DATE
	BY
	SURVEYED
	NOTED
NOTE BOOK	ALIGNMENT CHECKED
	RT. OF WAY CHECKED
	No.
	No.

PROFILE	DATE
	BY
	SURVEYED
	NOTED
NOTE BOOK	GRADES CHECKED
	B. M. NOTED
	STRUCTURE NOTATIONS CHECKED
	No.

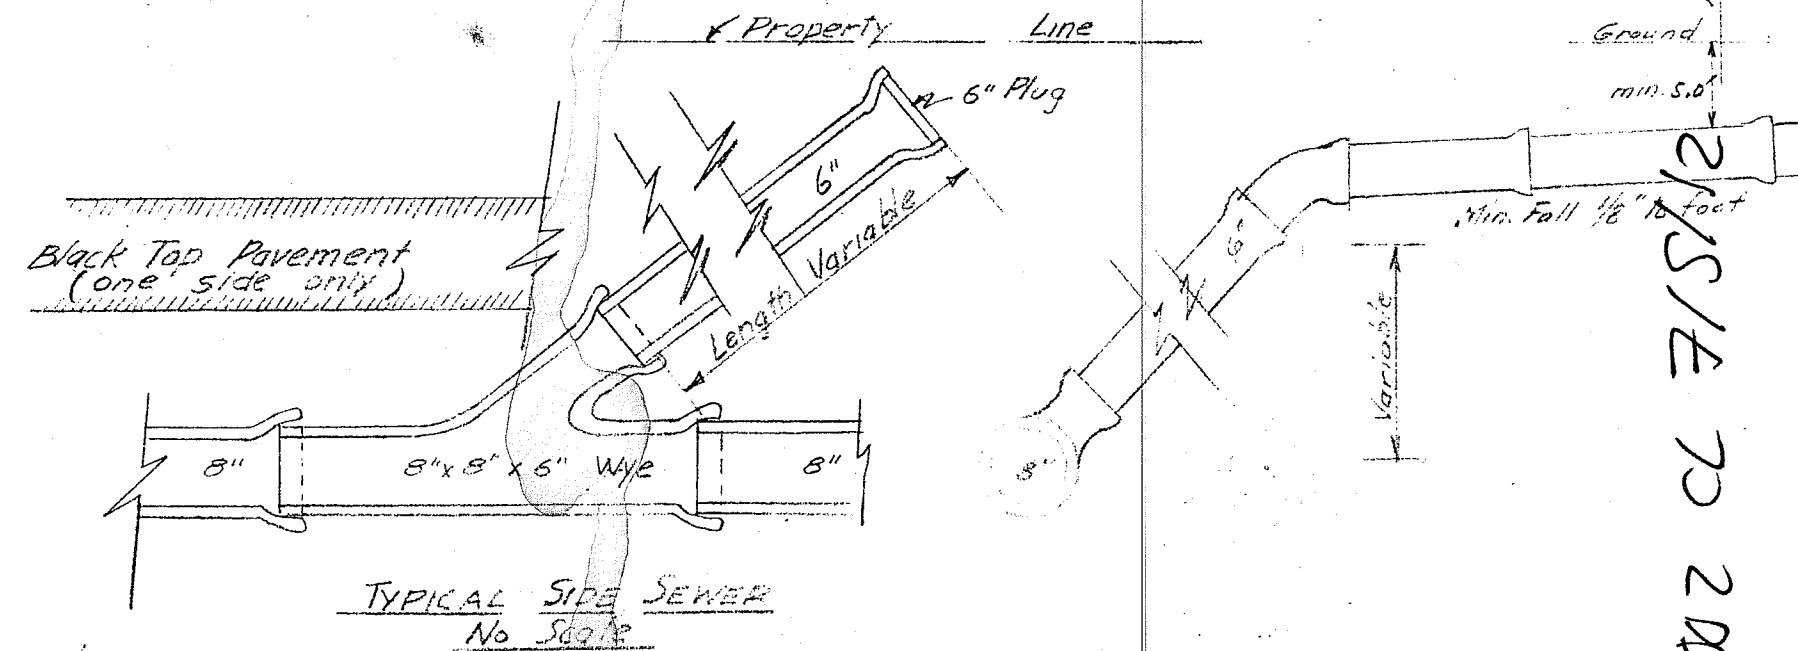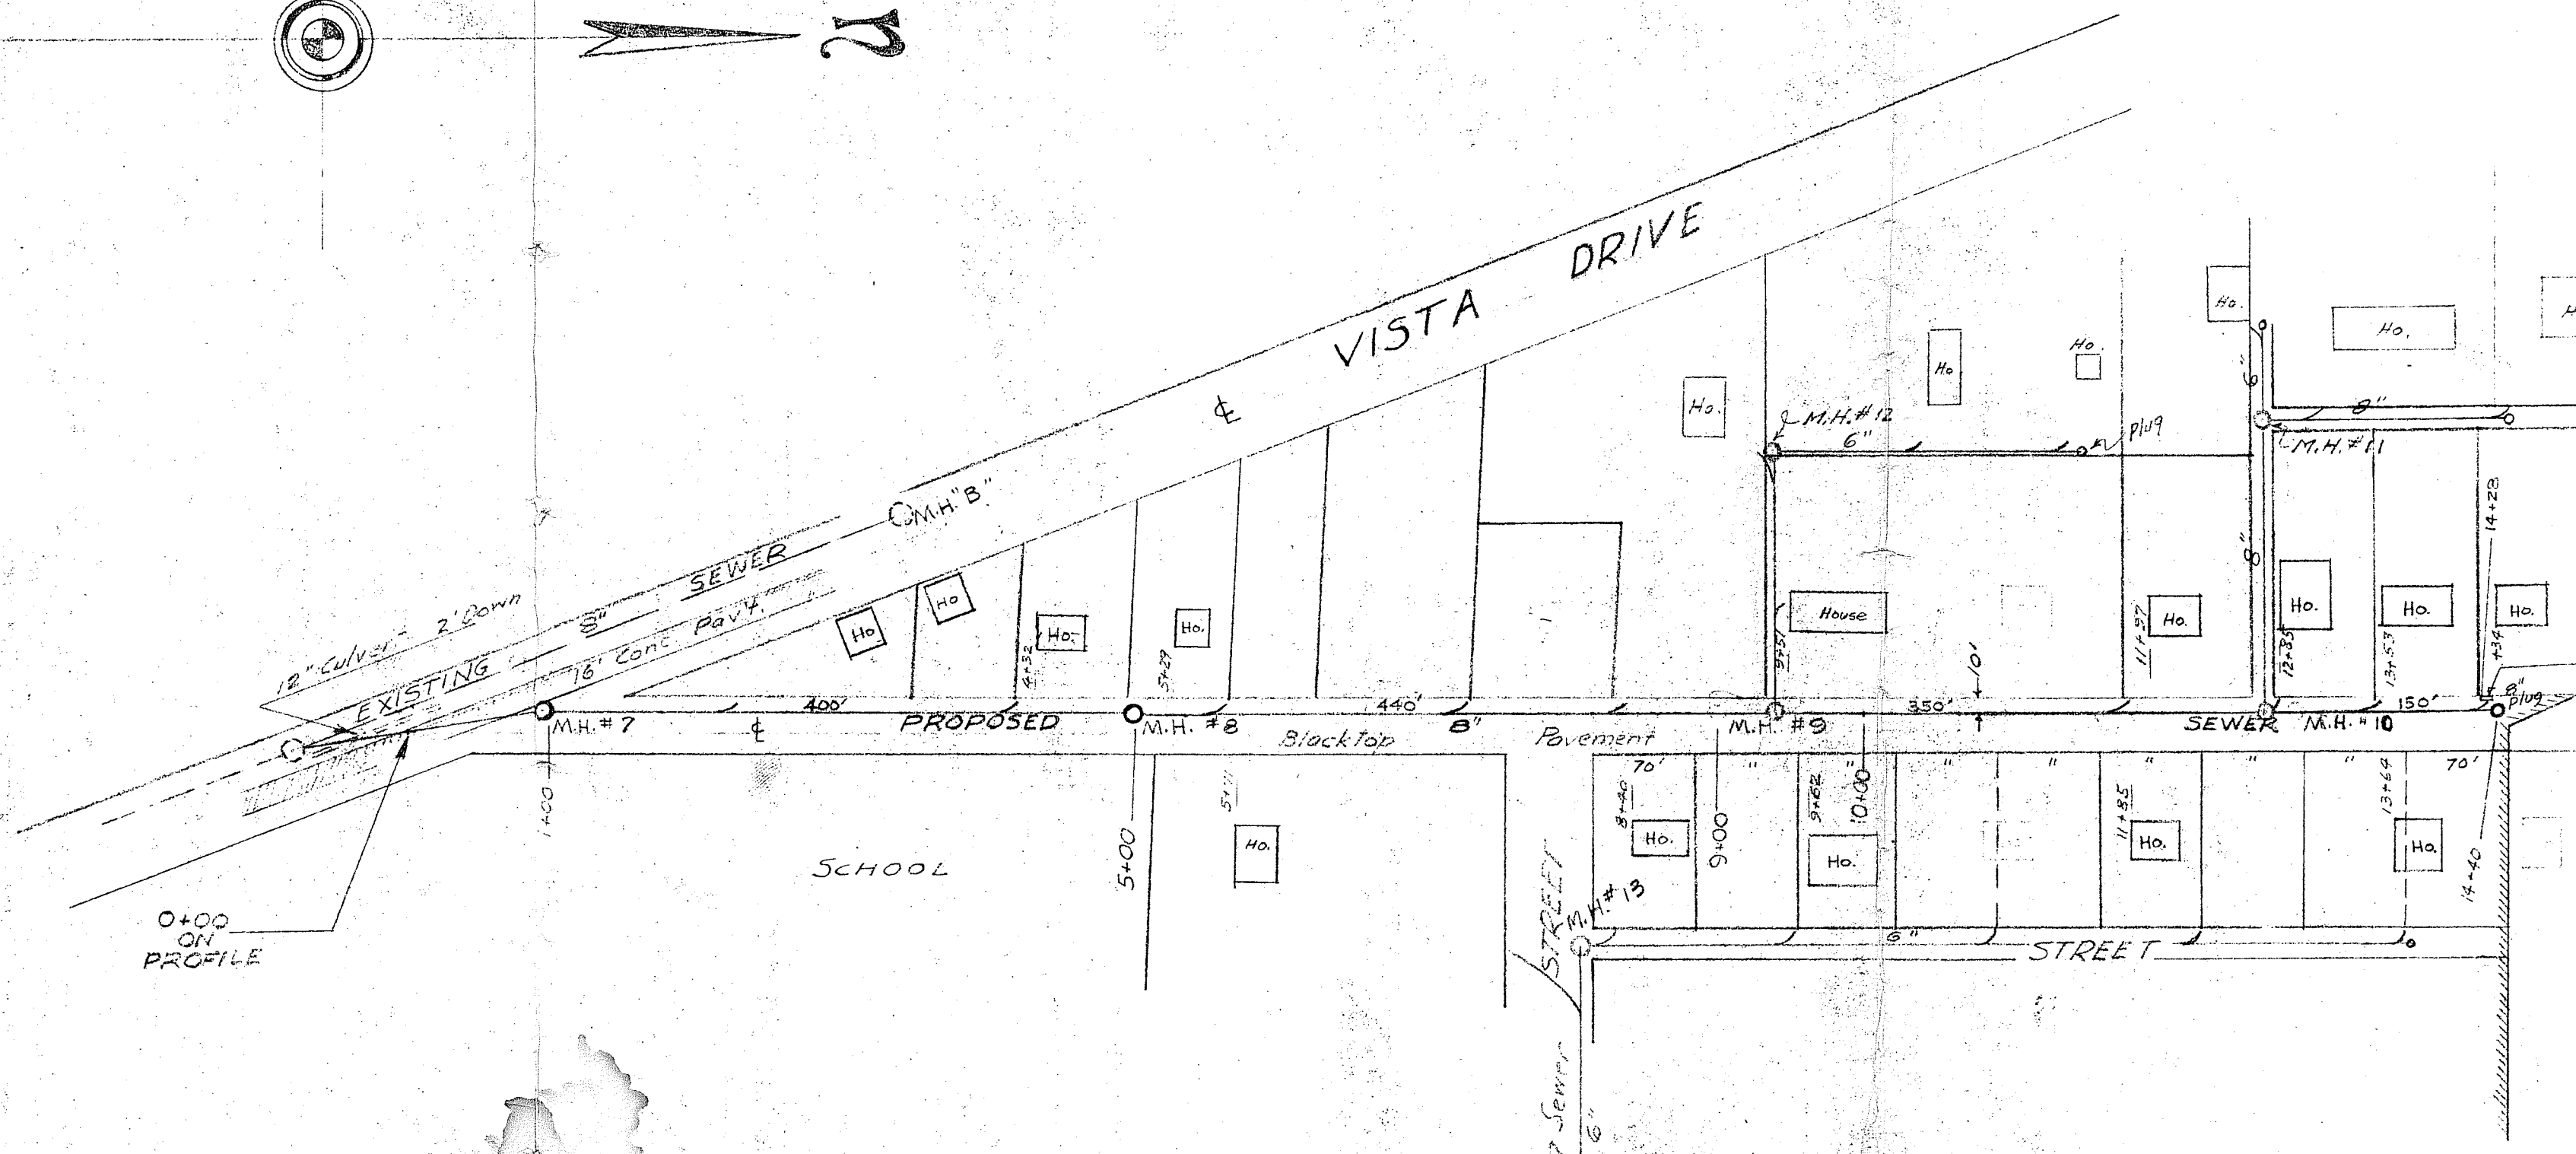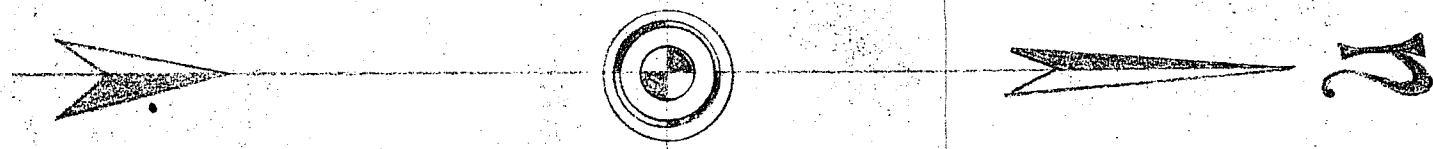

Note: Where necessary to cut pavement for installation of side sewers contractor must replace to satisfaction of Engineer. Contractor may turn up soil but must keep under water (lips, see elevation above). Ends of side sewers shall be marked by a #12 galv iron wire fastened to the end of the pipe and extending vertically to within 6" of the surface. A brass tag 1/2" x 3" stamped "SEWER" in letters 1/4" high shall be attached to the surface end of the wire.

- Notes:
- Approx. 1470' of 8" Vitrified Clay Sewer, this sheet.
 - 22 Side Sewer "Y"s for house connections to be located by Engineer during construction, See sketch above.
 - All sewer pipe to be V.C.
 - Specifications are to be City of Seattle Standard Plans & Specifications 6th Edition (Submittal) and 1st Edition (Construction).
 - Contractor shall be responsible for obtaining all necessary permits and for securing all necessary easements.
 - Pipe laid in wet trenches or water shall be subject to examination in ground water and shall be caulked with oakum or sawdust and a suitable compound used in the joints. Oakum or sawdust shall be used in all cement mortar joints.
 - Backfill pavement cuts carefully sloping with 12" of crushed rock & 3" of asphaltic concrete.

SCALES: 1 INCH = 100 FT. HOR. 1 INCH = 10 FT. VERT.

FERNDAL LOC. IMP. DIST. #11	
WHATCOM CO. WASH.	
DON H. EVANS, INC.	
CIVIL & STRUCTURAL ENGRS.	
LAND SURVEYORS	
DWG. BY: Marsh	DATE: July, 1955
CHECKED BY: J.A.M.	JOB NO. 55925
APPROVED: J.H.E.	SHEET 2 OF 2

