

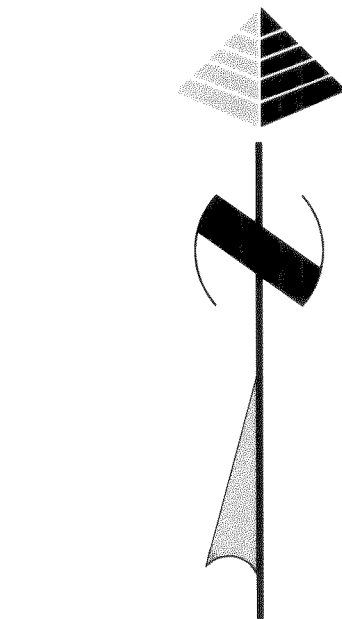


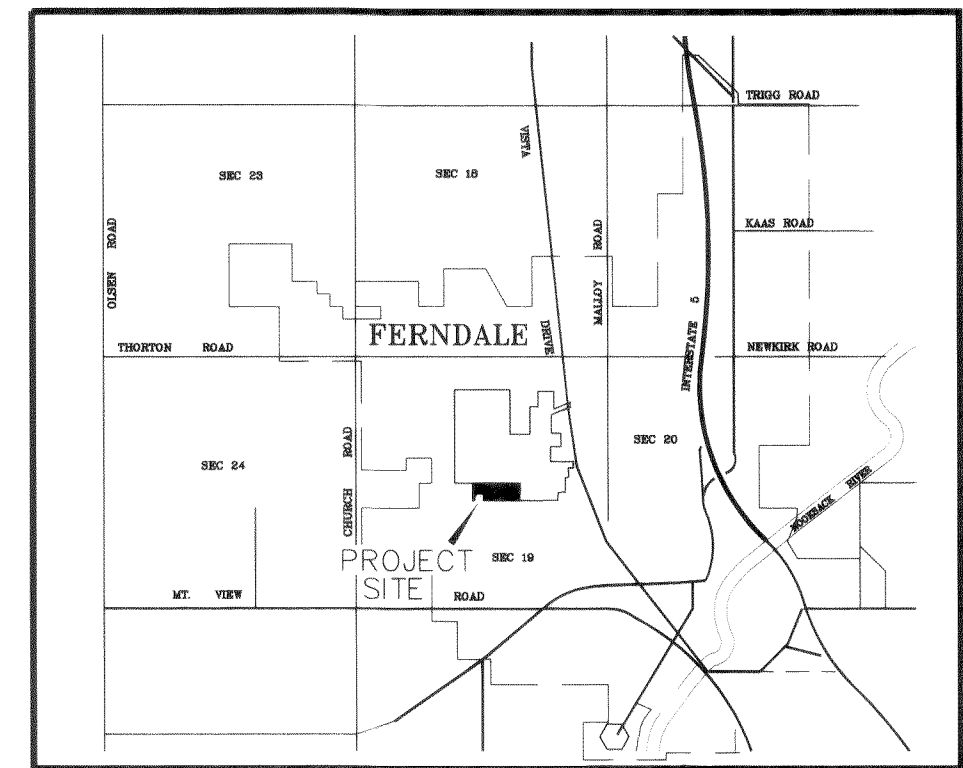

0 50 100 150
(SCALE IN FEET)
1" = 50 FEET

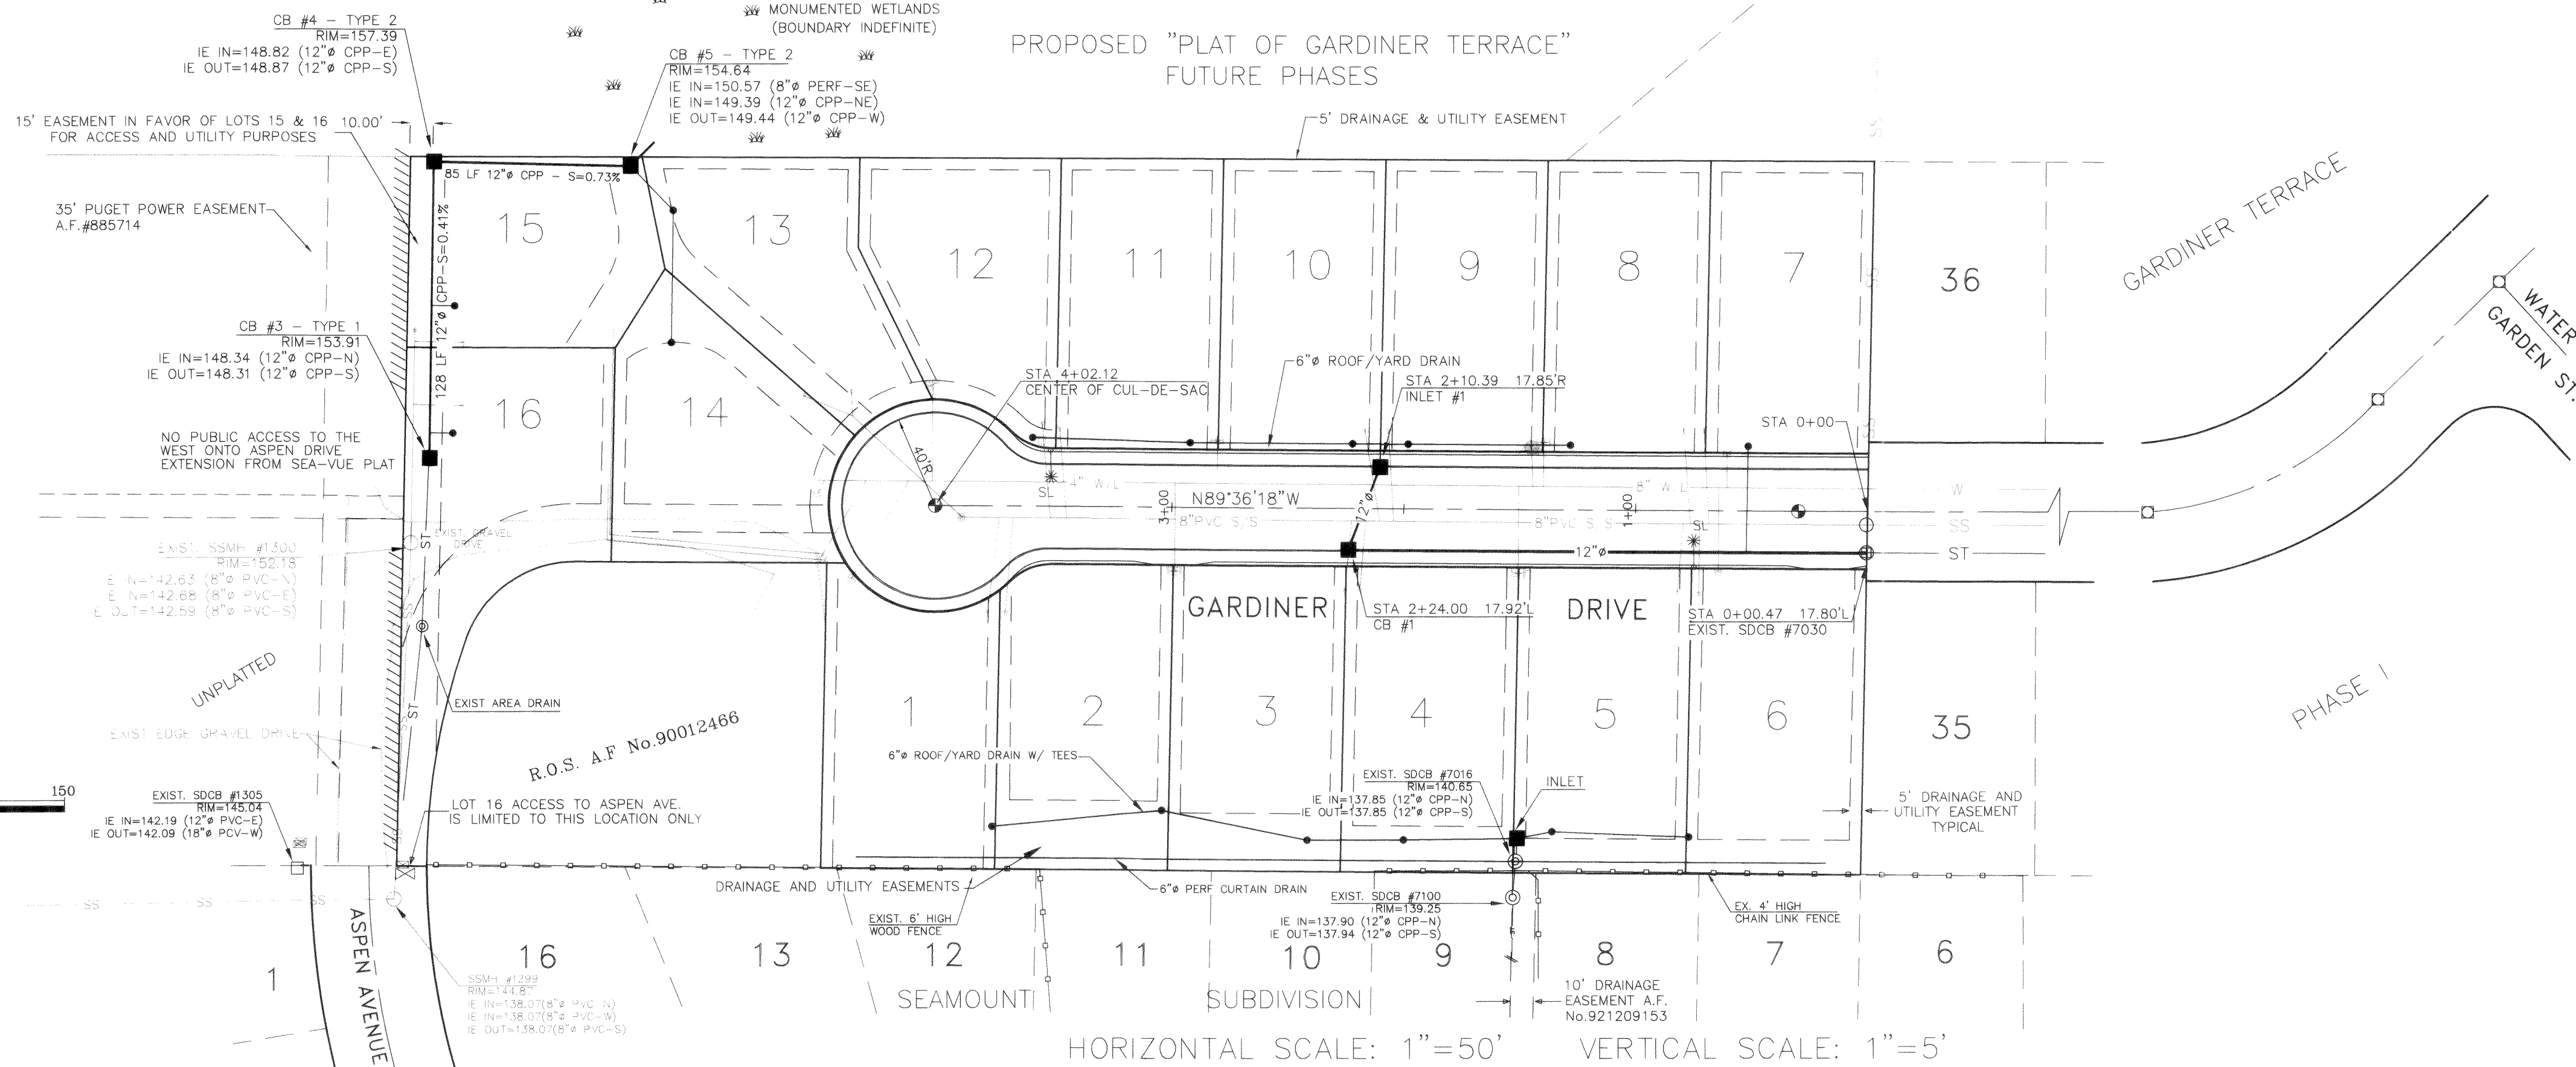


VICINITY MAP N.T.S.

LEGEND

- ROAD CENTERLINE
- SS EXIST. SANITARY SEWER MAIN
- W EXIST. WATER MAIN
- ST EXIST. STORM MAIN
- EXIST. SANITARY SEWER MANHOLE
- ⊙ EXIST. STORM SEWER STRUCTURE
- ⊙ AS-BUILT WATER METER
- ⊙ AS-BUILT FIRE HYDRANT
- ⊙ AS-BUILT SEWER MANHOLE
- ⊙ AS-BUILT SEWER SERVICE
- AS-BUILT STORM CATCH BASIN
- ⊙ AS-BUILT STREET LIGHT
- ⊙ STREET MON. (NOT INSTALLED AS OF NOVEMBER 15, 2001)

165
160
155
150
145
140
135
130


165
160
155
150
145
140
135
130

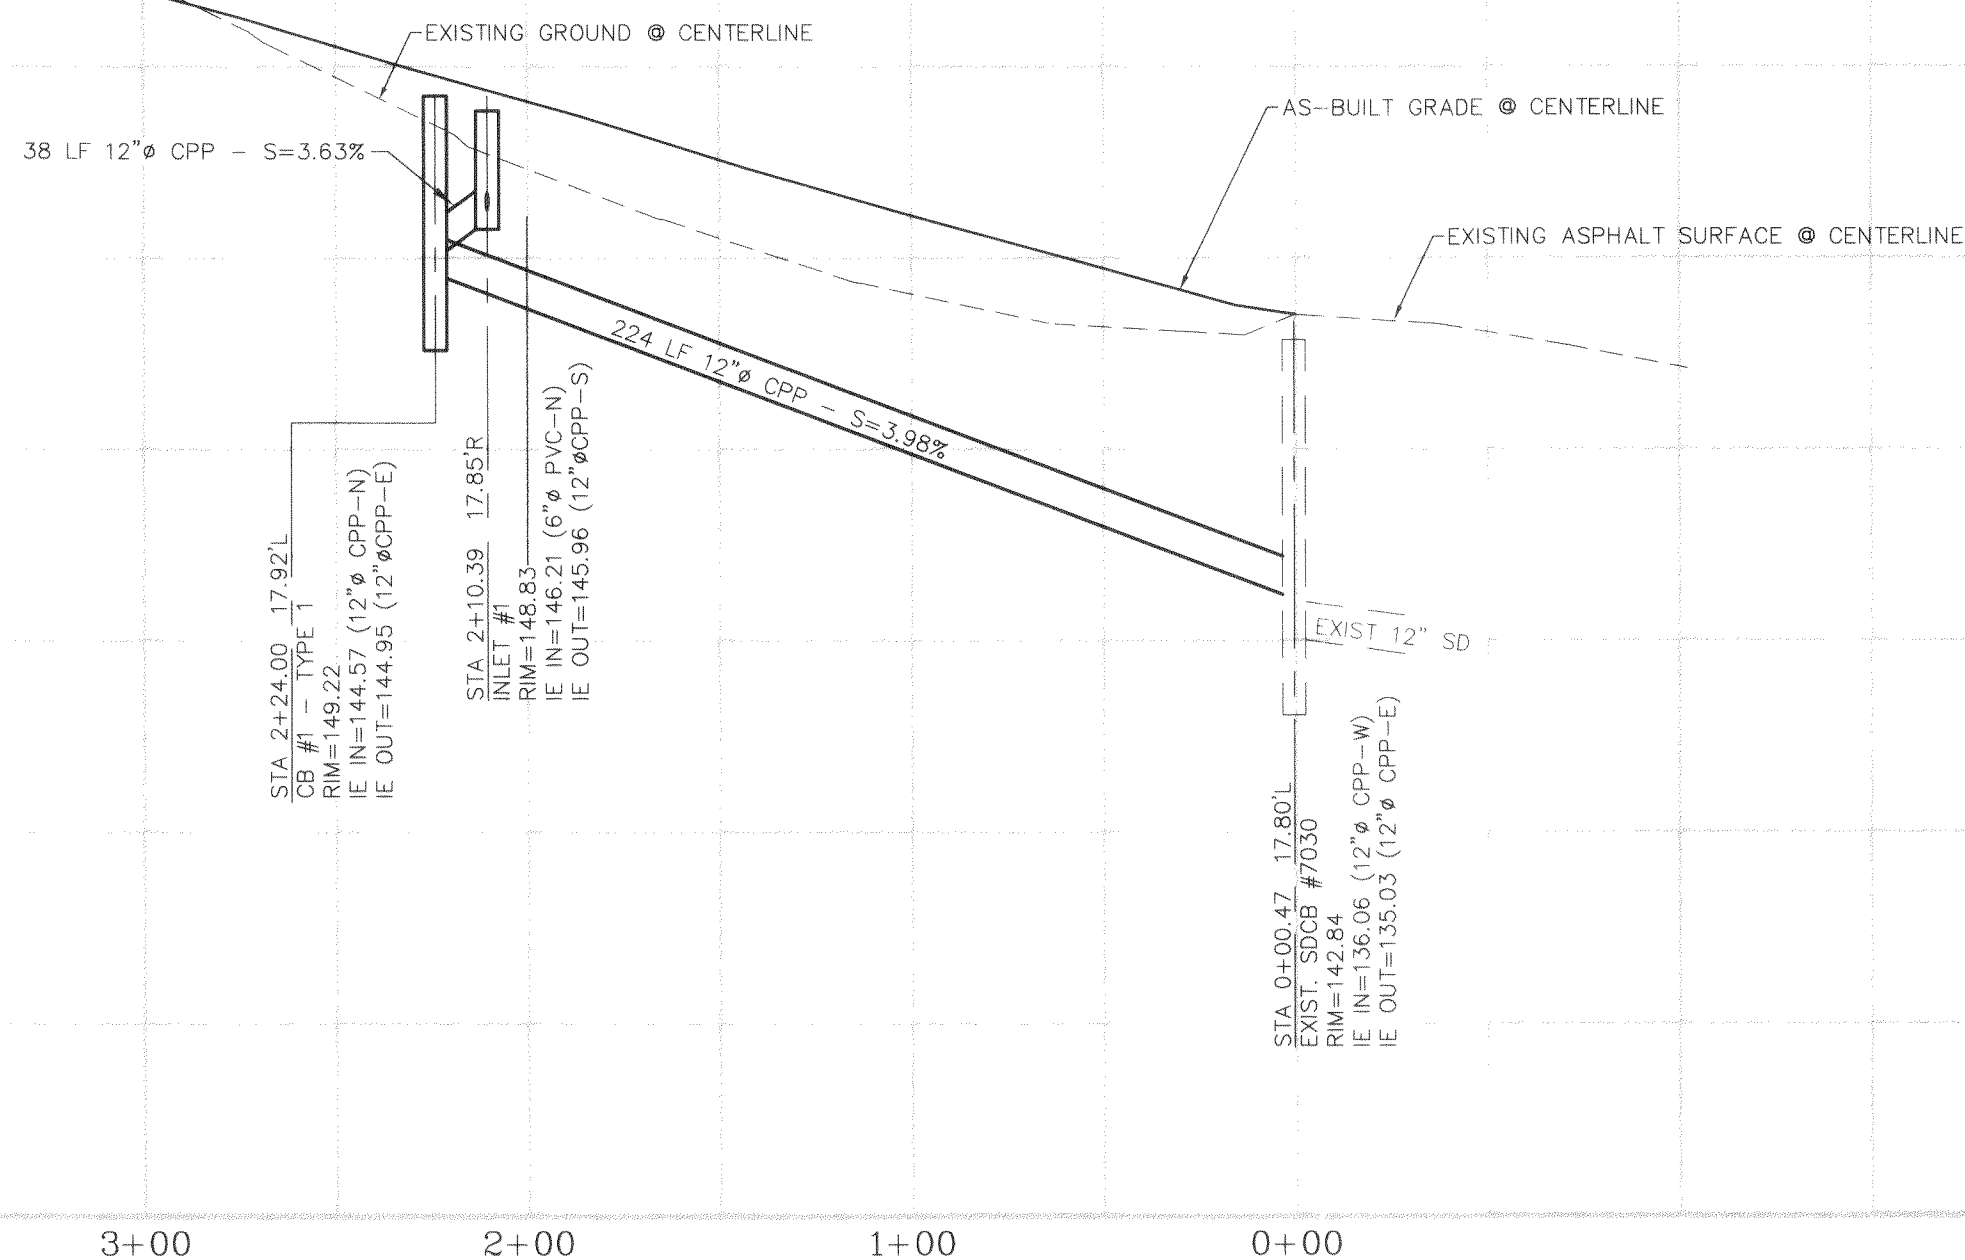

CALL BEFORE
YOU DIG
1-800-424-5555

NOTES

- AS-BUILT FIELD DATA PER NORTHWEST SURVEYING & GPS.
- I HEREBY CERTIFY THAT THE IMPROVEMENTS IN SEA-VUE ADDITION HAVE BEEN INSPECTED *IN SITU* BY MILLENNIUM ENGINEERING GROUP, INC. AND CONSTRUCTED IN CONFORMANCE WITH THE PLANS APPROVED BY THE PUBLIC WORKS DIRECTOR FOR SAID DEVELOPMENT AND THE GENERAL SPECIFICATIONS ADOPTED BY THE CITY OF FERNDALE DEPARTMENT OF PUBLIC WORKS.

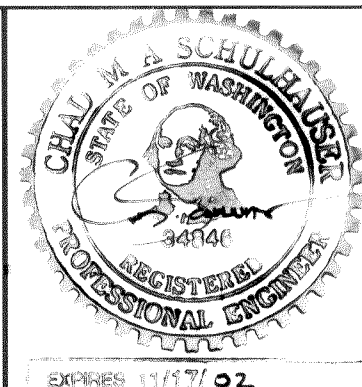

APPROVED

FEB 04 2002

BY *Wayne Larson*
CITY OF FERNDALE

APPROVAL STAMPS

DATUM

VERTICAL

NOV 29

HORIZONTAL

ASSUMED COORDINATES AT NE PROPERTY CORNER OF LOT #7, AS ESTABLISHED BY CONCRETE MONUMENT WITH ALUMINUM DISC SET AS PER GARDINER TERRACE PHASE 1, A.F. No. 930921266

N 10000.00 E 15000.00

BASIS OF BEARINGS

CENTERLINE GARDINER DRIVE AS PER GARDINER TERRACE PHASE 1 (A.F. No. 930921266)

MILLENNIUM
Engineering Group, Inc.

109-3rd ST., PO BOX 137, LYNDEN, WA 98264
PH: (360) 354-8141 FAX: (360) 354-3744
mail@2001egi.com www.2001egi.com

SEA-VUE ADDITION - GARDINER DRIVE

**AS-BUILT
ROAD & DRAINAGE
IMPROVEMENTS**

FOR
WAYNE LARSON

PTN, NE1/4, SEC.19, T39N, R2E, W.M.
CITY OF FERNDALE, WHATCOM COUNTY, WASHINGTON

SCALE: 1" = 50'

DATE: 11/26/01

DRAWN BY: CMAS

REVISED:





SHEET: 1 OF 2

JOB NUMBER:

01044

00224.001 2-10-06 KR


00224.002 2.16.06 KR

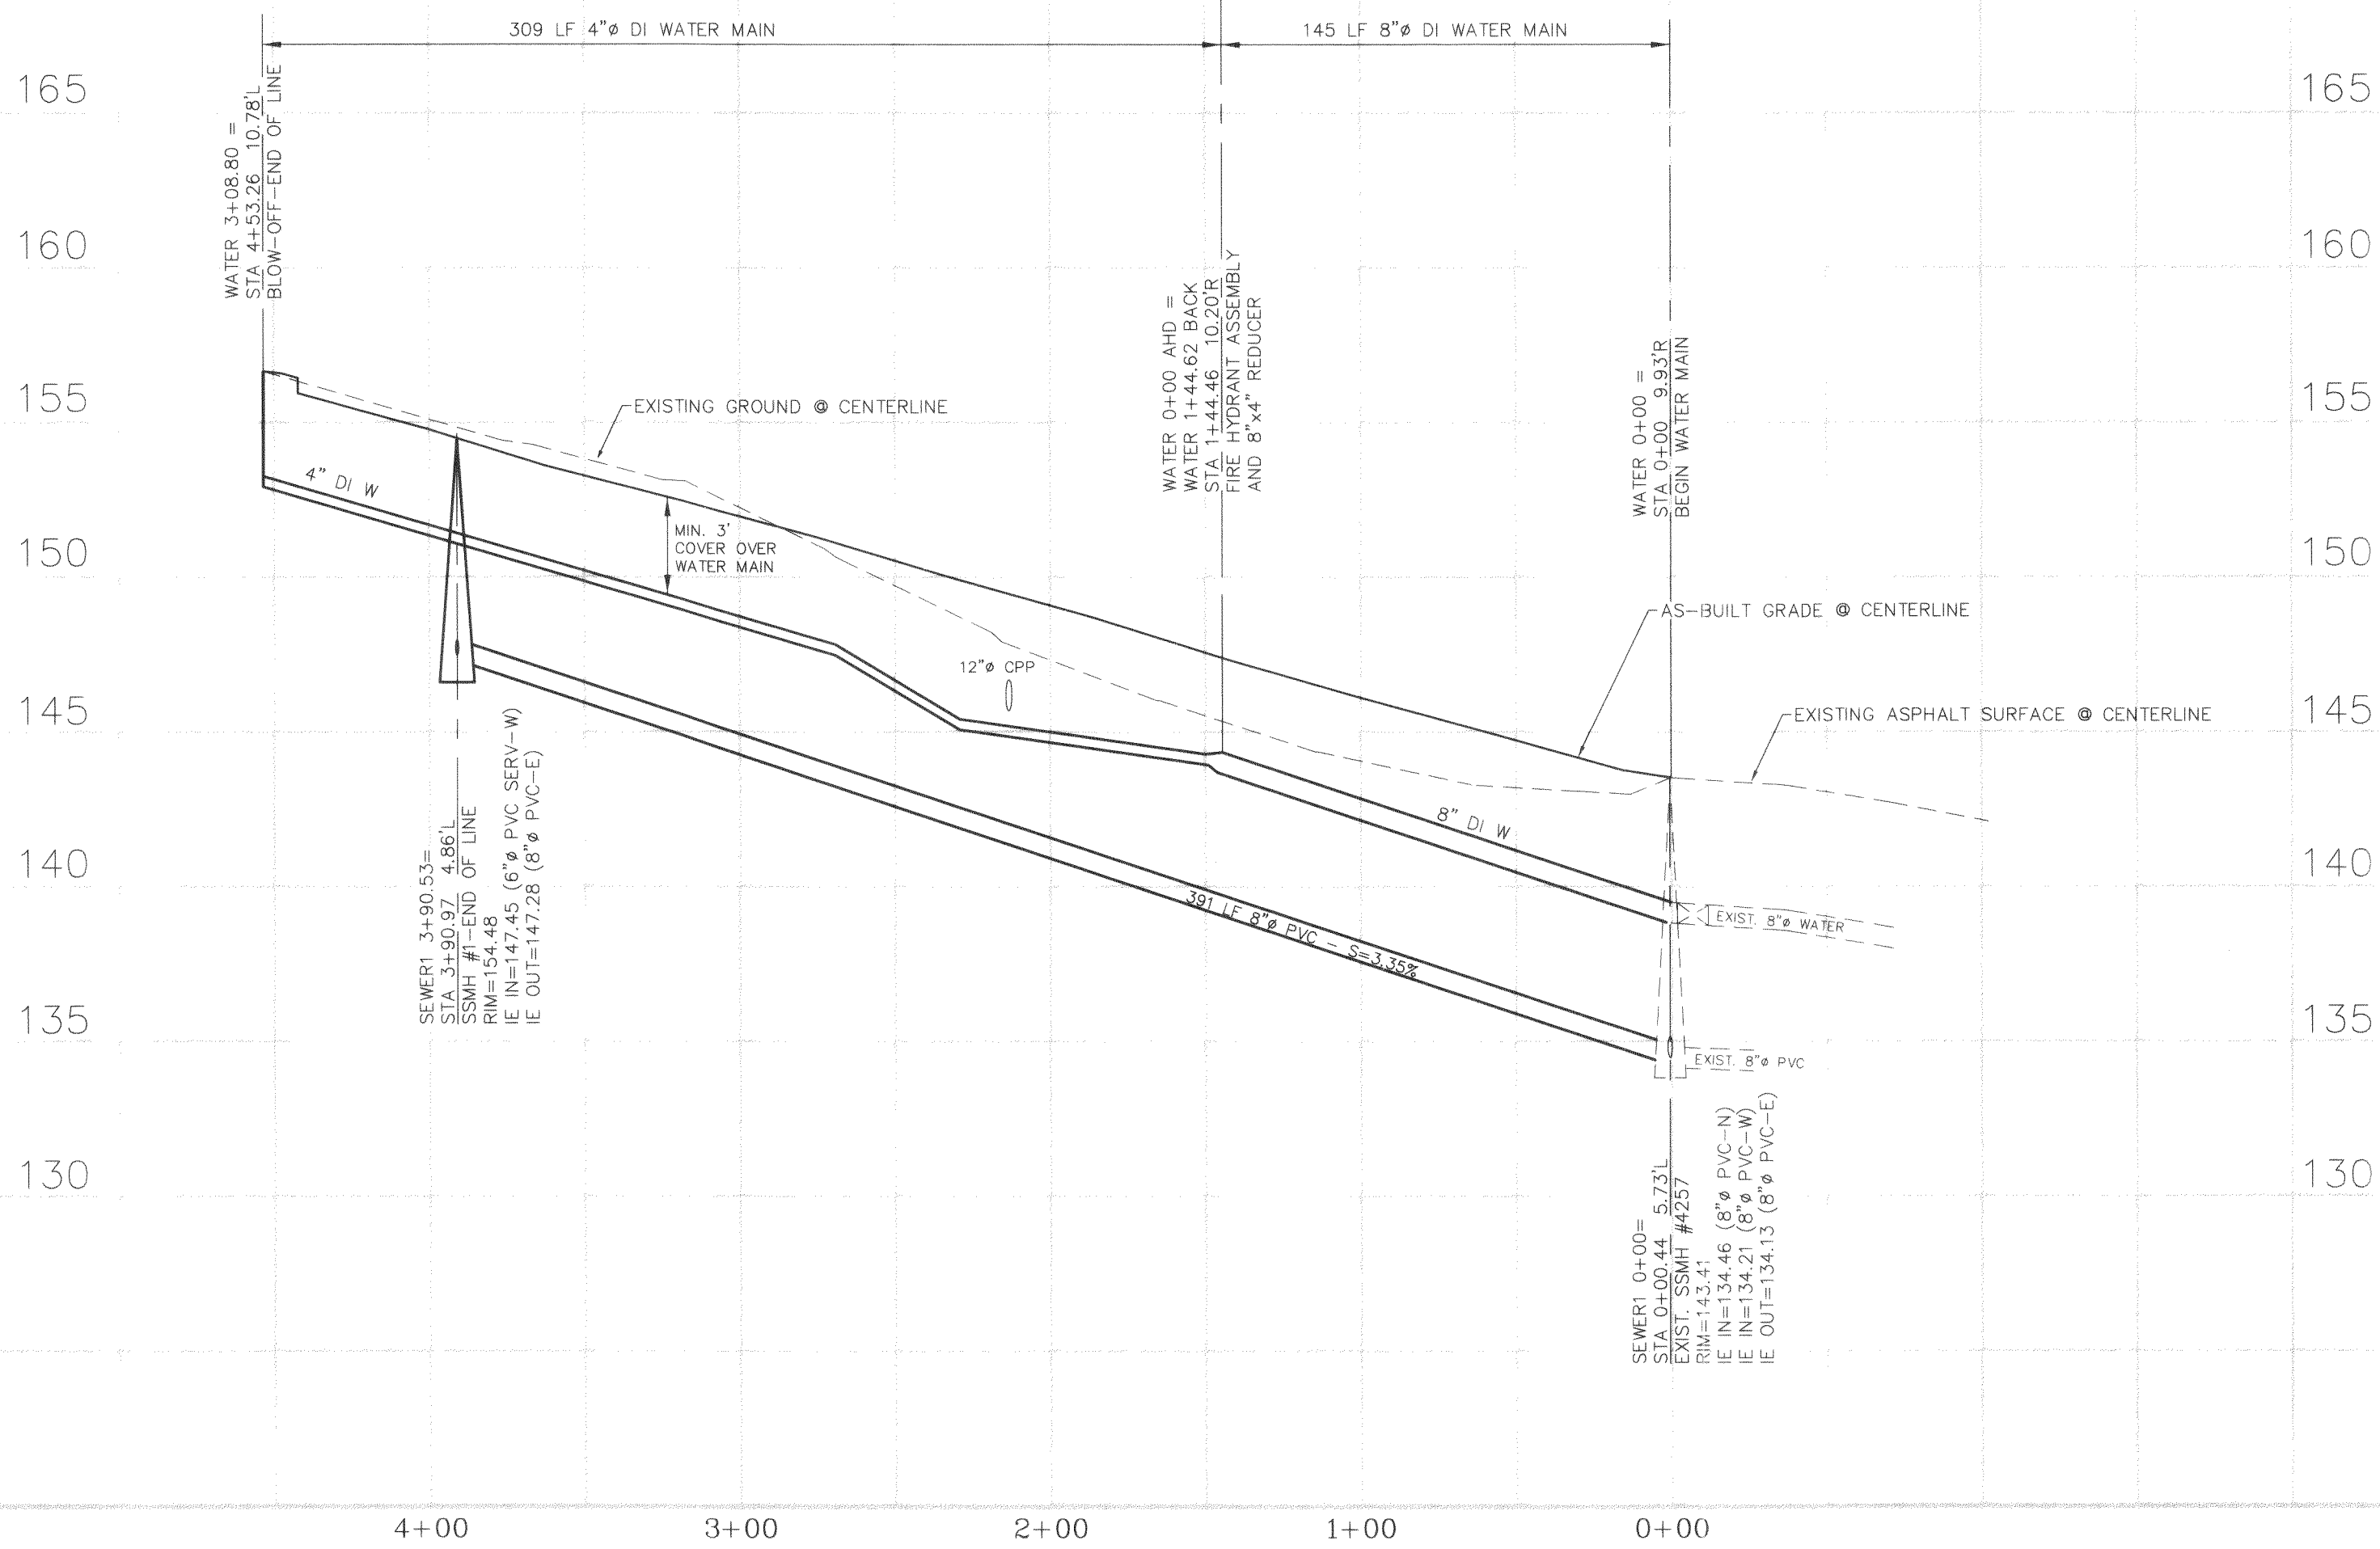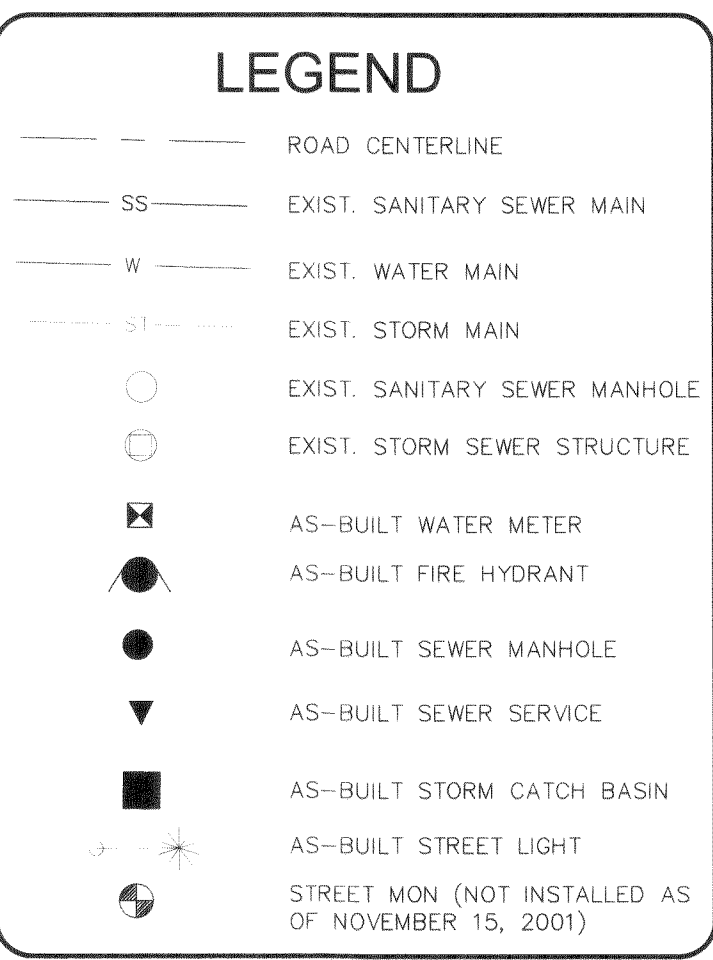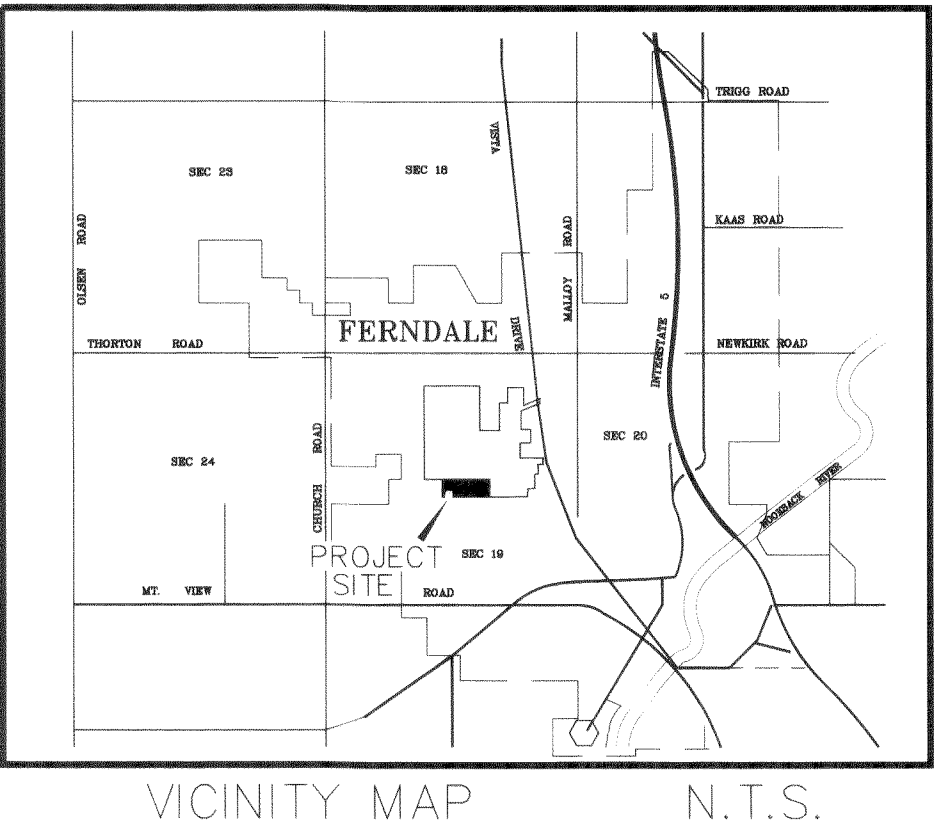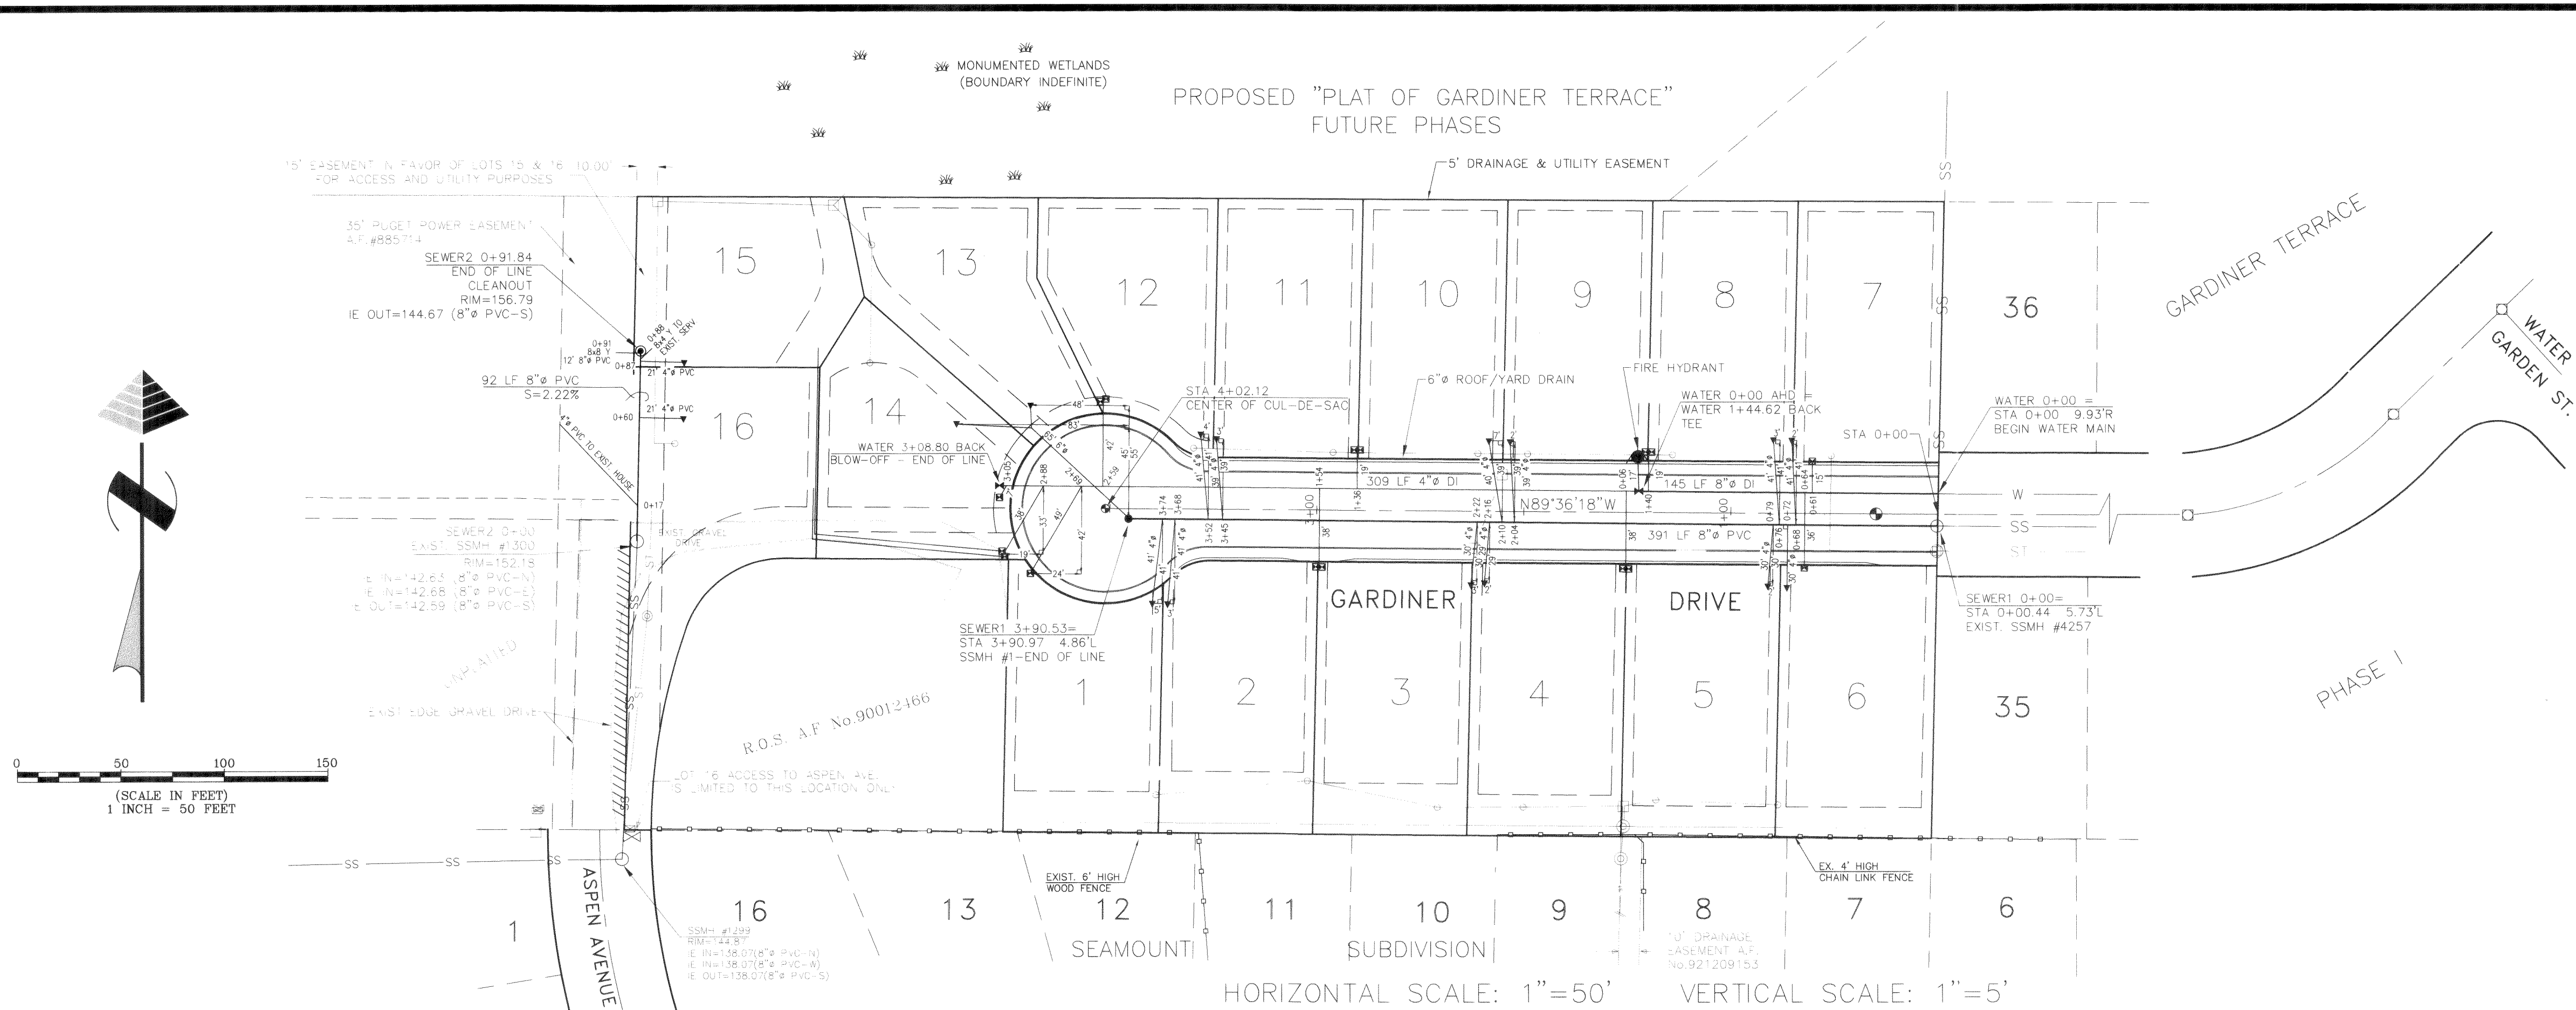

CALL BEFORE
YOU DIG
1-800-424-5555

NOTES

1. AS-BUILT FIELD DATA PER NORTHWEST SURVEYING & GPS.
I HEREBY CERTIFY THAT THE IMPROVEMENTS IN SEA-VUE ADDITION HAVE BEEN INSPECTED IN SITU BY MILLENNIUM ENGINEERING GROUP, INC. AND CONSTRUCTED IN CONFORMANCE WITH THE PLANS APPROVED BY THE PUBLIC WORKS DIRECTOR FOR SAID DEVELOPMENT AND THE GENERAL SPECIFICATIONS ADOPTED BY THE CITY OF FERNDALE DEPARTMENT OF PUBLIC WORKS.

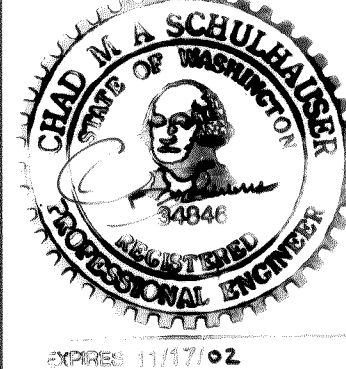

APPROVED
FEB 04 2002
BY *Chad A. Schuller*
CITY OF FERNDALE

APPROVAL STAMPS

DATUM
VERTICAL
NAD 83
HORIZONTAL
ASSUMED COORDINATES AT NE PROPERTY CORNER OF LOT #7, AS ESTABLISHED BY CONCRETE MONUMENT WITH ALLUMINUM DISC SET AS PER GARDINER TERRACE PHASE 1, A.F. No. 930921266
N 10000.00 E 15000.00
BASIS OF BEARINGS
CENTERLINE GARDINER DRIVE AS PER GARDINER TERRACE PHASE 1 (A.F. No. 930921266)

MILLENNIUM
Engineering Group, Inc.
109-3rd ST., PO BOX 137, LYNDEN, WA 98264
PH: (360) 354-8141 FAX: (360) 354-3744
mail@2001egi.com www.2001egi.com

SEA-VUE ADDITION - GARDINER DRIVE
AS-BUILT
WATER & SANITARY SEWER
IMPROVEMENTS
FOR
WAYNE LARSON
PTN. NE1/4, SEC.19, T39N, R2E, W.M.
CITY OF FERNDALE, WHATCOM COUNTY, WASHINGTON

SCALE: 1" = 50'
DATE: 11/26/01
DRAWN BY: CMAS
REVIEWED:
SHEET: 2 OF 2
JOB NUMBER: 01044