
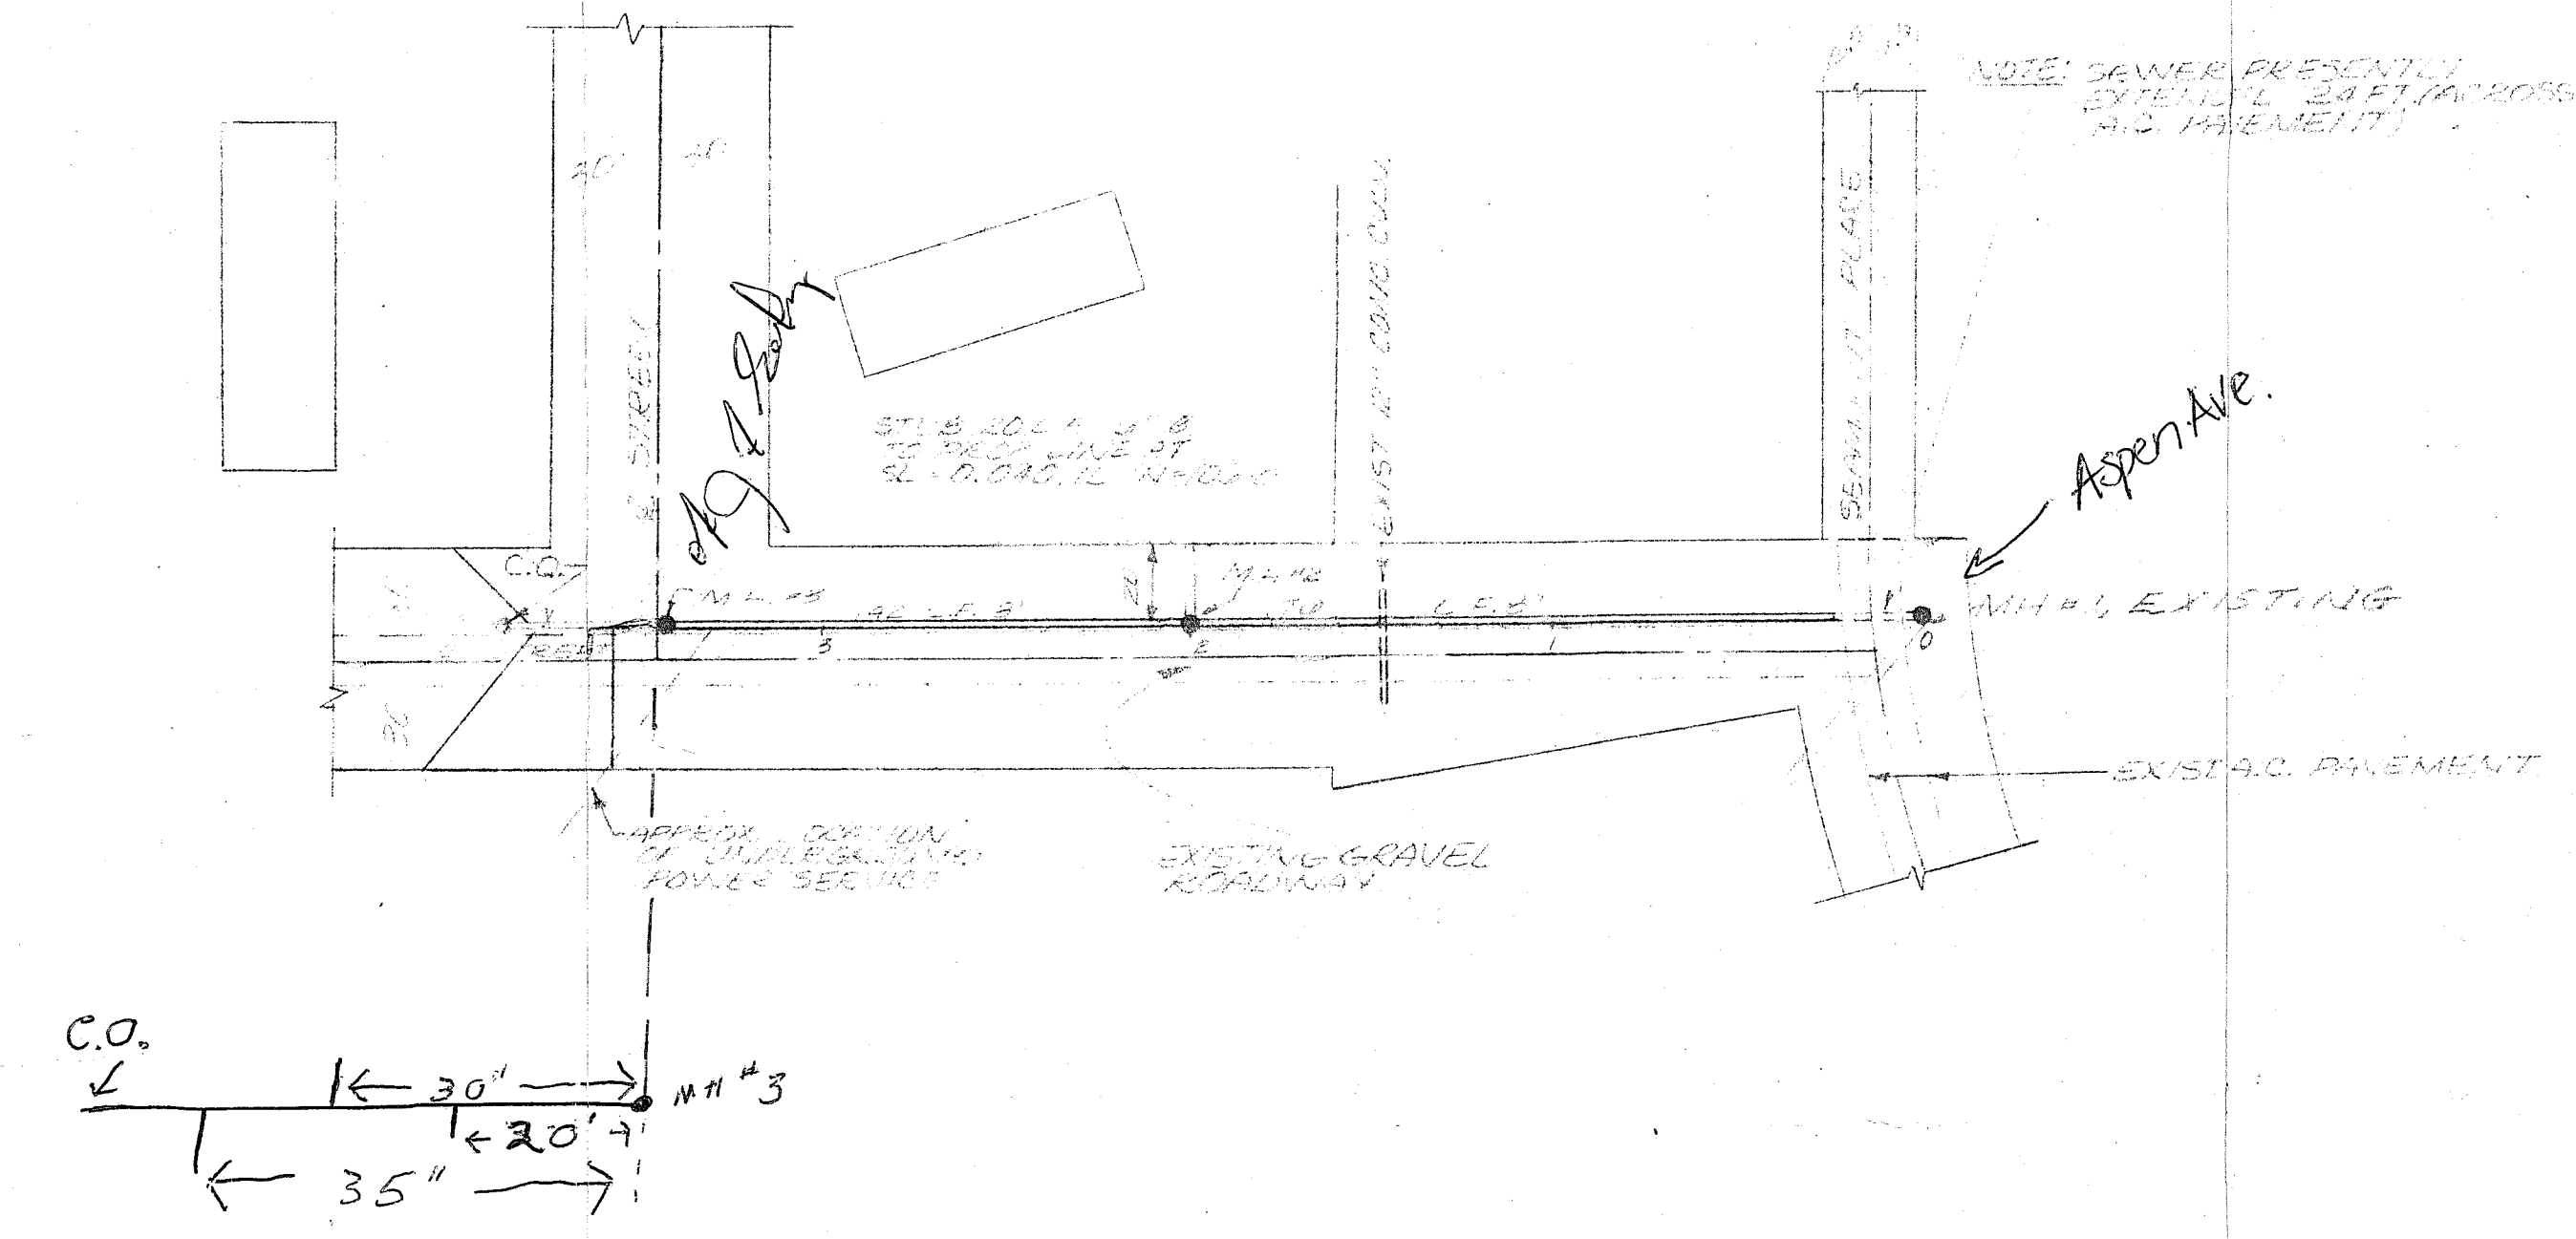



NO.	DATE	BY	DATE
1	10/1/78	J. A. ESTEP	
2	10/1/78	J. A. ESTEP	
3	10/1/78	J. A. ESTEP	
4	10/1/78	J. A. ESTEP	
5	10/1/78	J. A. ESTEP	
6	10/1/78	J. A. ESTEP	
7	10/1/78	J. A. ESTEP	
8	10/1/78	J. A. ESTEP	
9	10/1/78	J. A. ESTEP	
10	10/1/78	J. A. ESTEP	

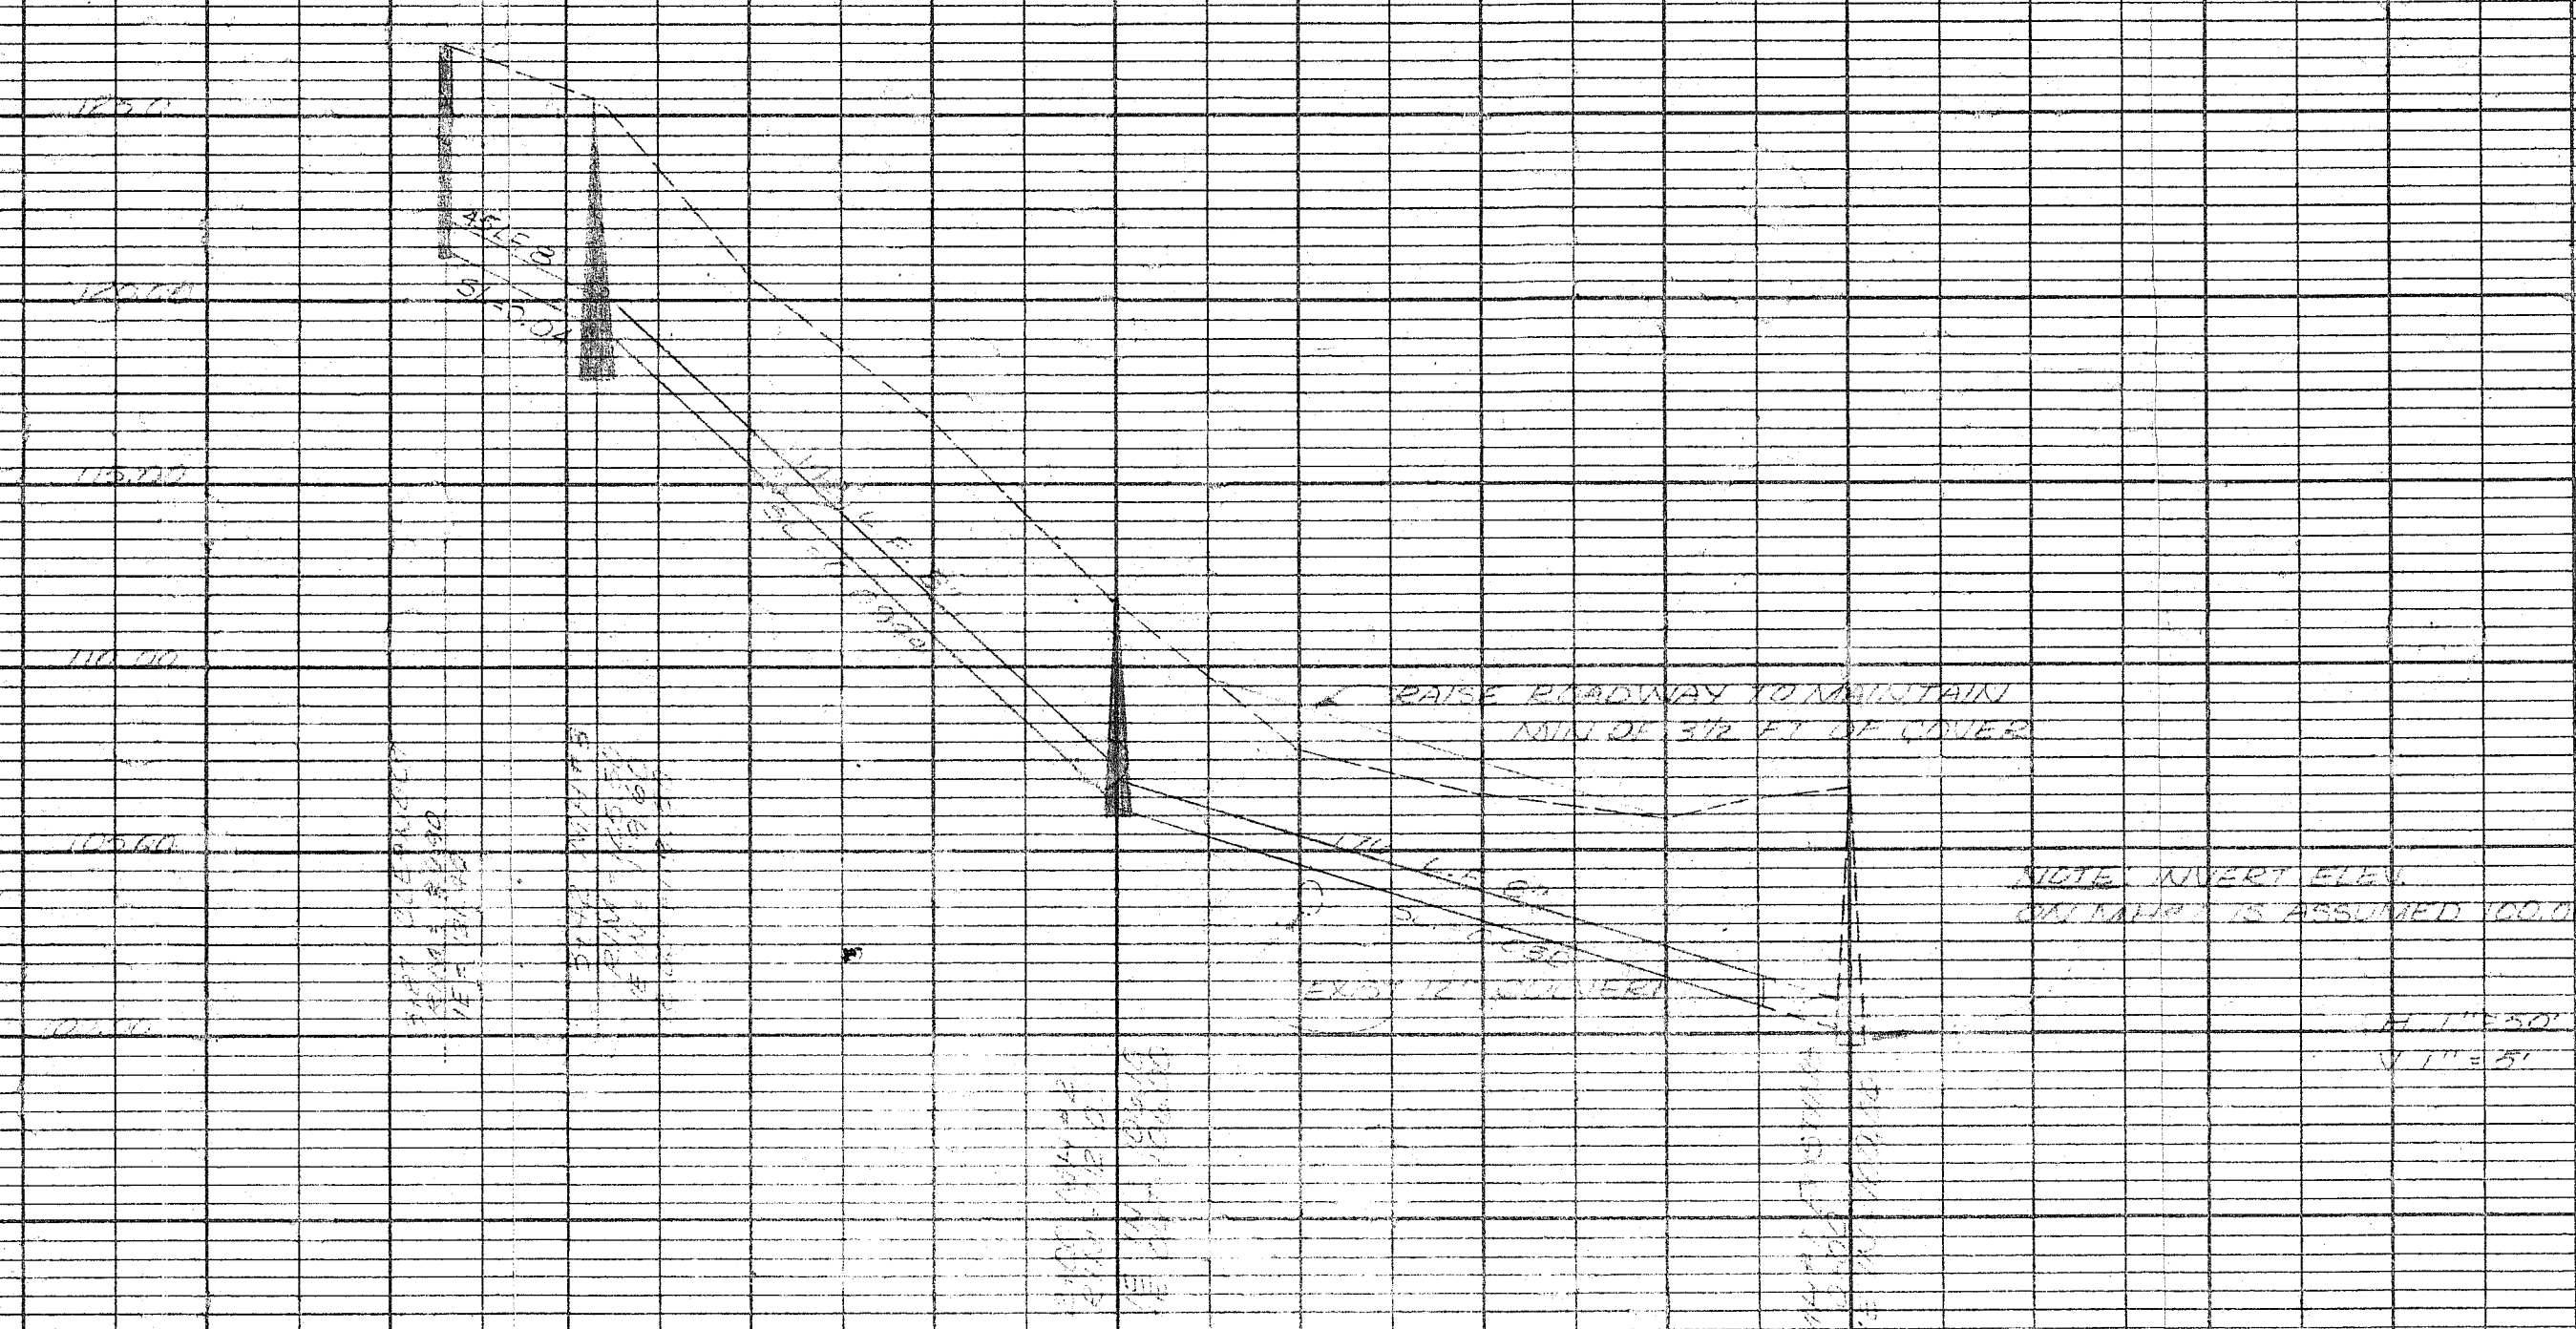



GENERAL NOTES

1. ALL WORK AND MATERIALS SHALL BE IN ACCORDANCE WITH A.P.W.A. STANDARD SPECIFICATIONS, 1977 EDITION AND SHALL BE SUBJECT TO APPROVAL BY THE CITY OF FERNDALE.
2. SEWER SHALL BE 12" P.V.C. PIPE INSTALLED WITH BEDDING PER CITY OF FERNDALE SPECIFICATIONS.
3. THE MANHOLE SHALL BE 48 INCH I.D. TYPE 1A1 WITH OFFSET CONE. CONCRETE MANHOLE RINGS SHALL BE OLMPIC NO. 5943 OR EQUAL, THE WORD "SEWER" SHALL BE CAST IN LID.
4. TESTING SHALL BE DONE IN THE PRESENCE OF AND UNDER THE SUPERVISION OF THE CITY OF FERNDALE.
5. THE CITY OF FERNDALE SHALL BE NOTIFIED NOT LESS THAN 24 HOURS PRIOR TO START OF SEWER CONSTRUCTION.
6. ALL 4" SIDE SEWER TO BE STUBBED TO PROPERTY LINE OF A MINIMUM OF 2 PIPE LENGTHS.

NO.	DATE	BY	DATE
1	10/1/78	J. A. ESTEP	
2	10/1/78	J. A. ESTEP	
3	10/1/78	J. A. ESTEP	
4	10/1/78	J. A. ESTEP	
5	10/1/78	J. A. ESTEP	
6	10/1/78	J. A. ESTEP	
7	10/1/78	J. A. ESTEP	
8	10/1/78	J. A. ESTEP	
9	10/1/78	J. A. ESTEP	
10	10/1/78	J. A. ESTEP	

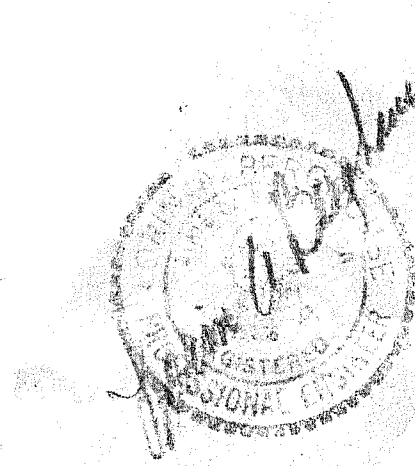


CLIENT	JOHN ESTEP		
PROJECT	ESTEP SHORT PLAT SANITARY SEWER EXTENSION		
DRAWN BY	SCALE	DATE	SHEET
APPROVED	DATE	DATE	OF

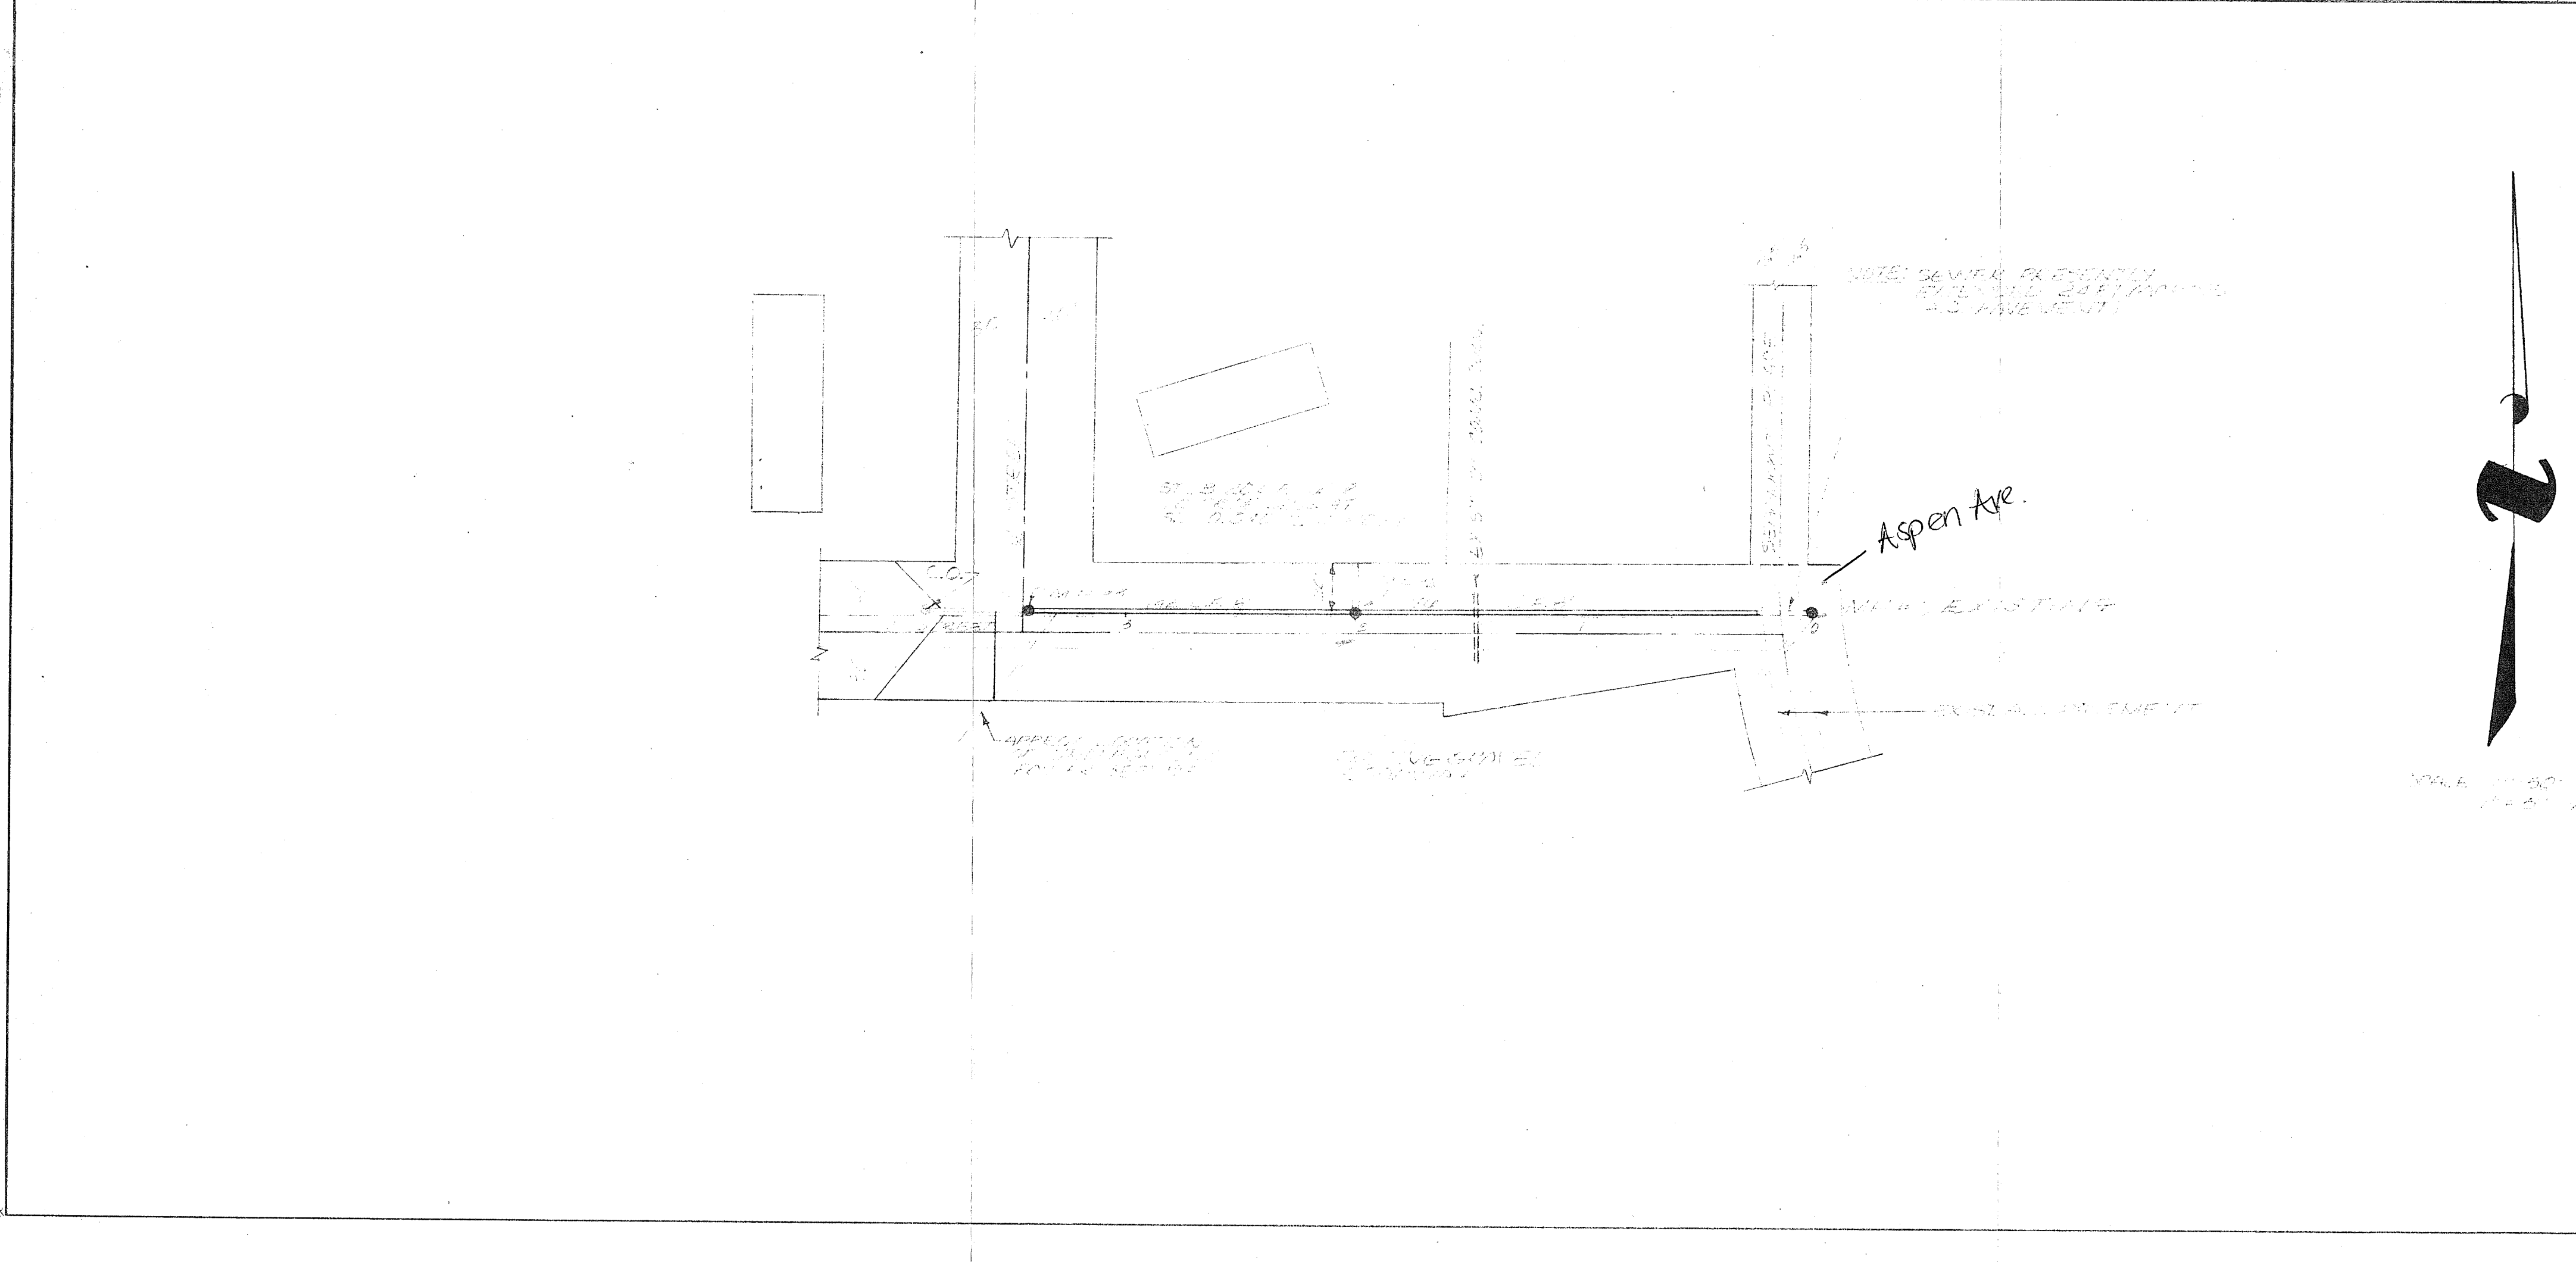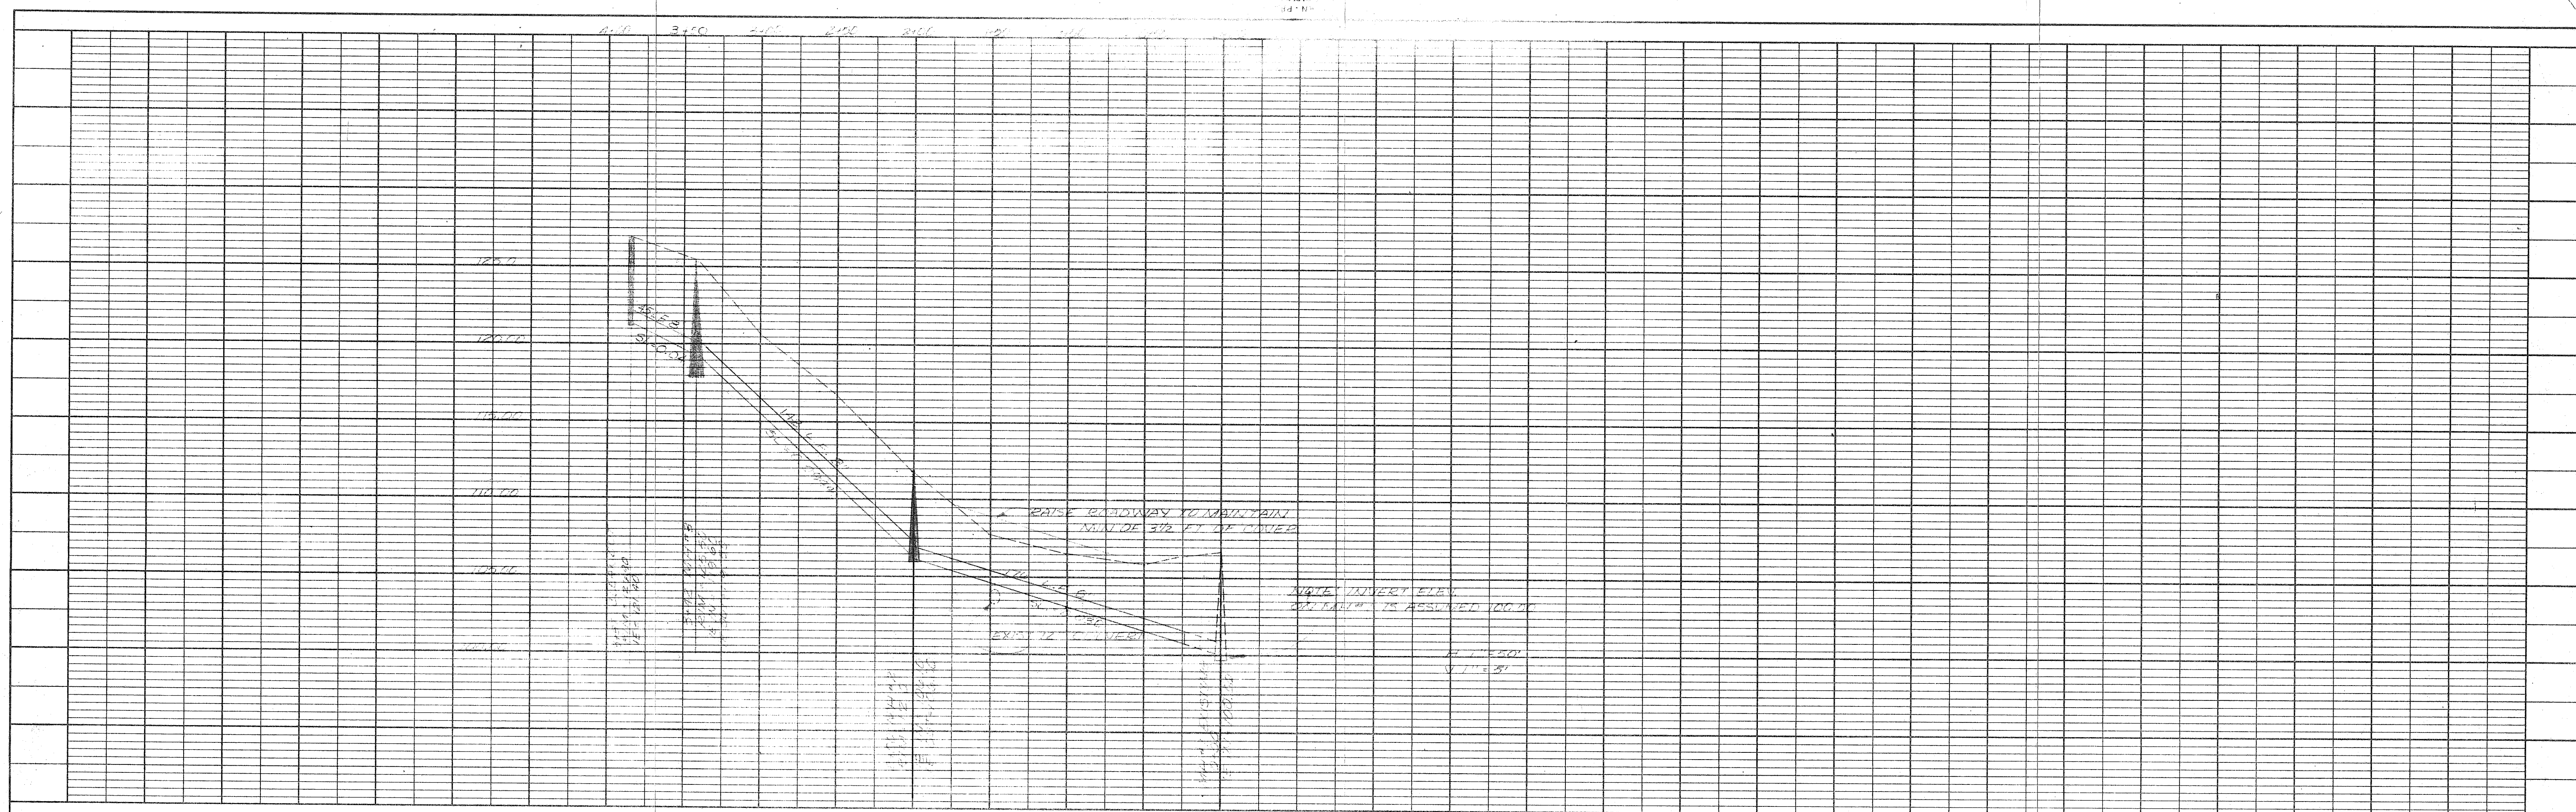

GENERAL NOTES

1. ALL WORK AND MATERIALS SHALL BE IN ACCORDANCE WITH A.P.W.A. STANDARD SPECIFICATIONS, 1977 EDITION AND SHALL BE SUBJECT TO APPROVAL BY THE CITY OF FERNDALE.
2. SEWER SHALL BE PSM-ASTM D 3034-73A P.V.C. PIPE INSTALLED WITH BEDDING PER CITY OF FERNDALE SPECIFICATIONS.
3. THE MANHOLE SHALL BE 48 INCH I.D. TYPE 1A1 WITH OFFSET CONE. CONCRETE MANHOLE RINGS SHALL BE OLYMPIC NO. 5943 OR EQUAL. THE WORD "SEWER" SHALL BE CAST IN LTD.
4. TESTING SHALL BE DONE IN THE PRESENCE OF AND UNDER THE SUPERVISION OF THE CITY OF FERNDALE.
5. THE CITY OF FERNDALE SHALL BE NOTIFIED NOT LESS THAN 24 HOURS PRIOR TO START OF SEWER CONSTRUCTION.
6. ALL 4" SIDE SEWERS TO BE STUBBED TO PROPERTY LINE OF A MINIMUM OF 2 PIPE LENGTHS.

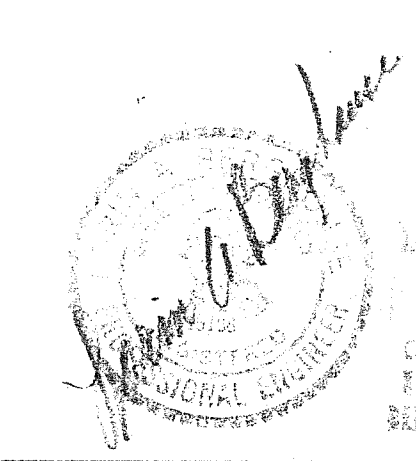

CLIENT		JOHN ESTEP	
PROJECT		ESTEP SHORT PLAT SANITARY SEWER EXTENSION	
DRAWN BY	SCALE	DATE	SHEET
DATE	DATE	F.SOOK	OF

21/11/19 12 208 98400

PROFILE		BY	DATE
NO.	NO.		
NO.	NO.		
NO.	NO.		

PLAN		BY	DATE
NO.	NO.		
NO.	NO.		
NO.	NO.		