


2121 Ferndale Terrace
By. K. Radder, City of Ferndale
May 24, 2021

N ↑
NTS

PLAN VIEW

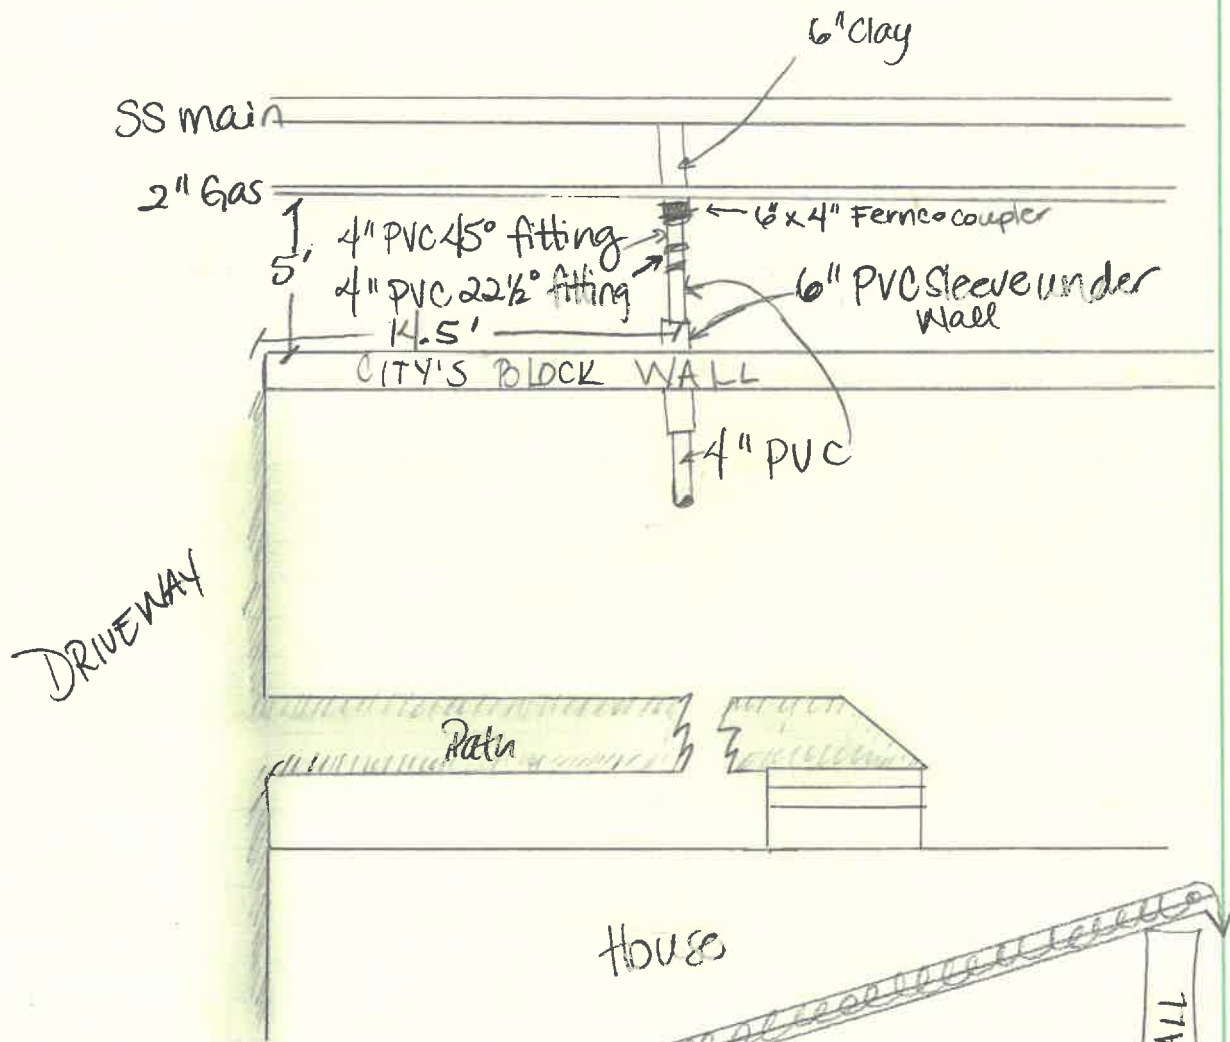

PROFILE VIEW

All bedded in pea gravel &
Street backfill was CSTC

