


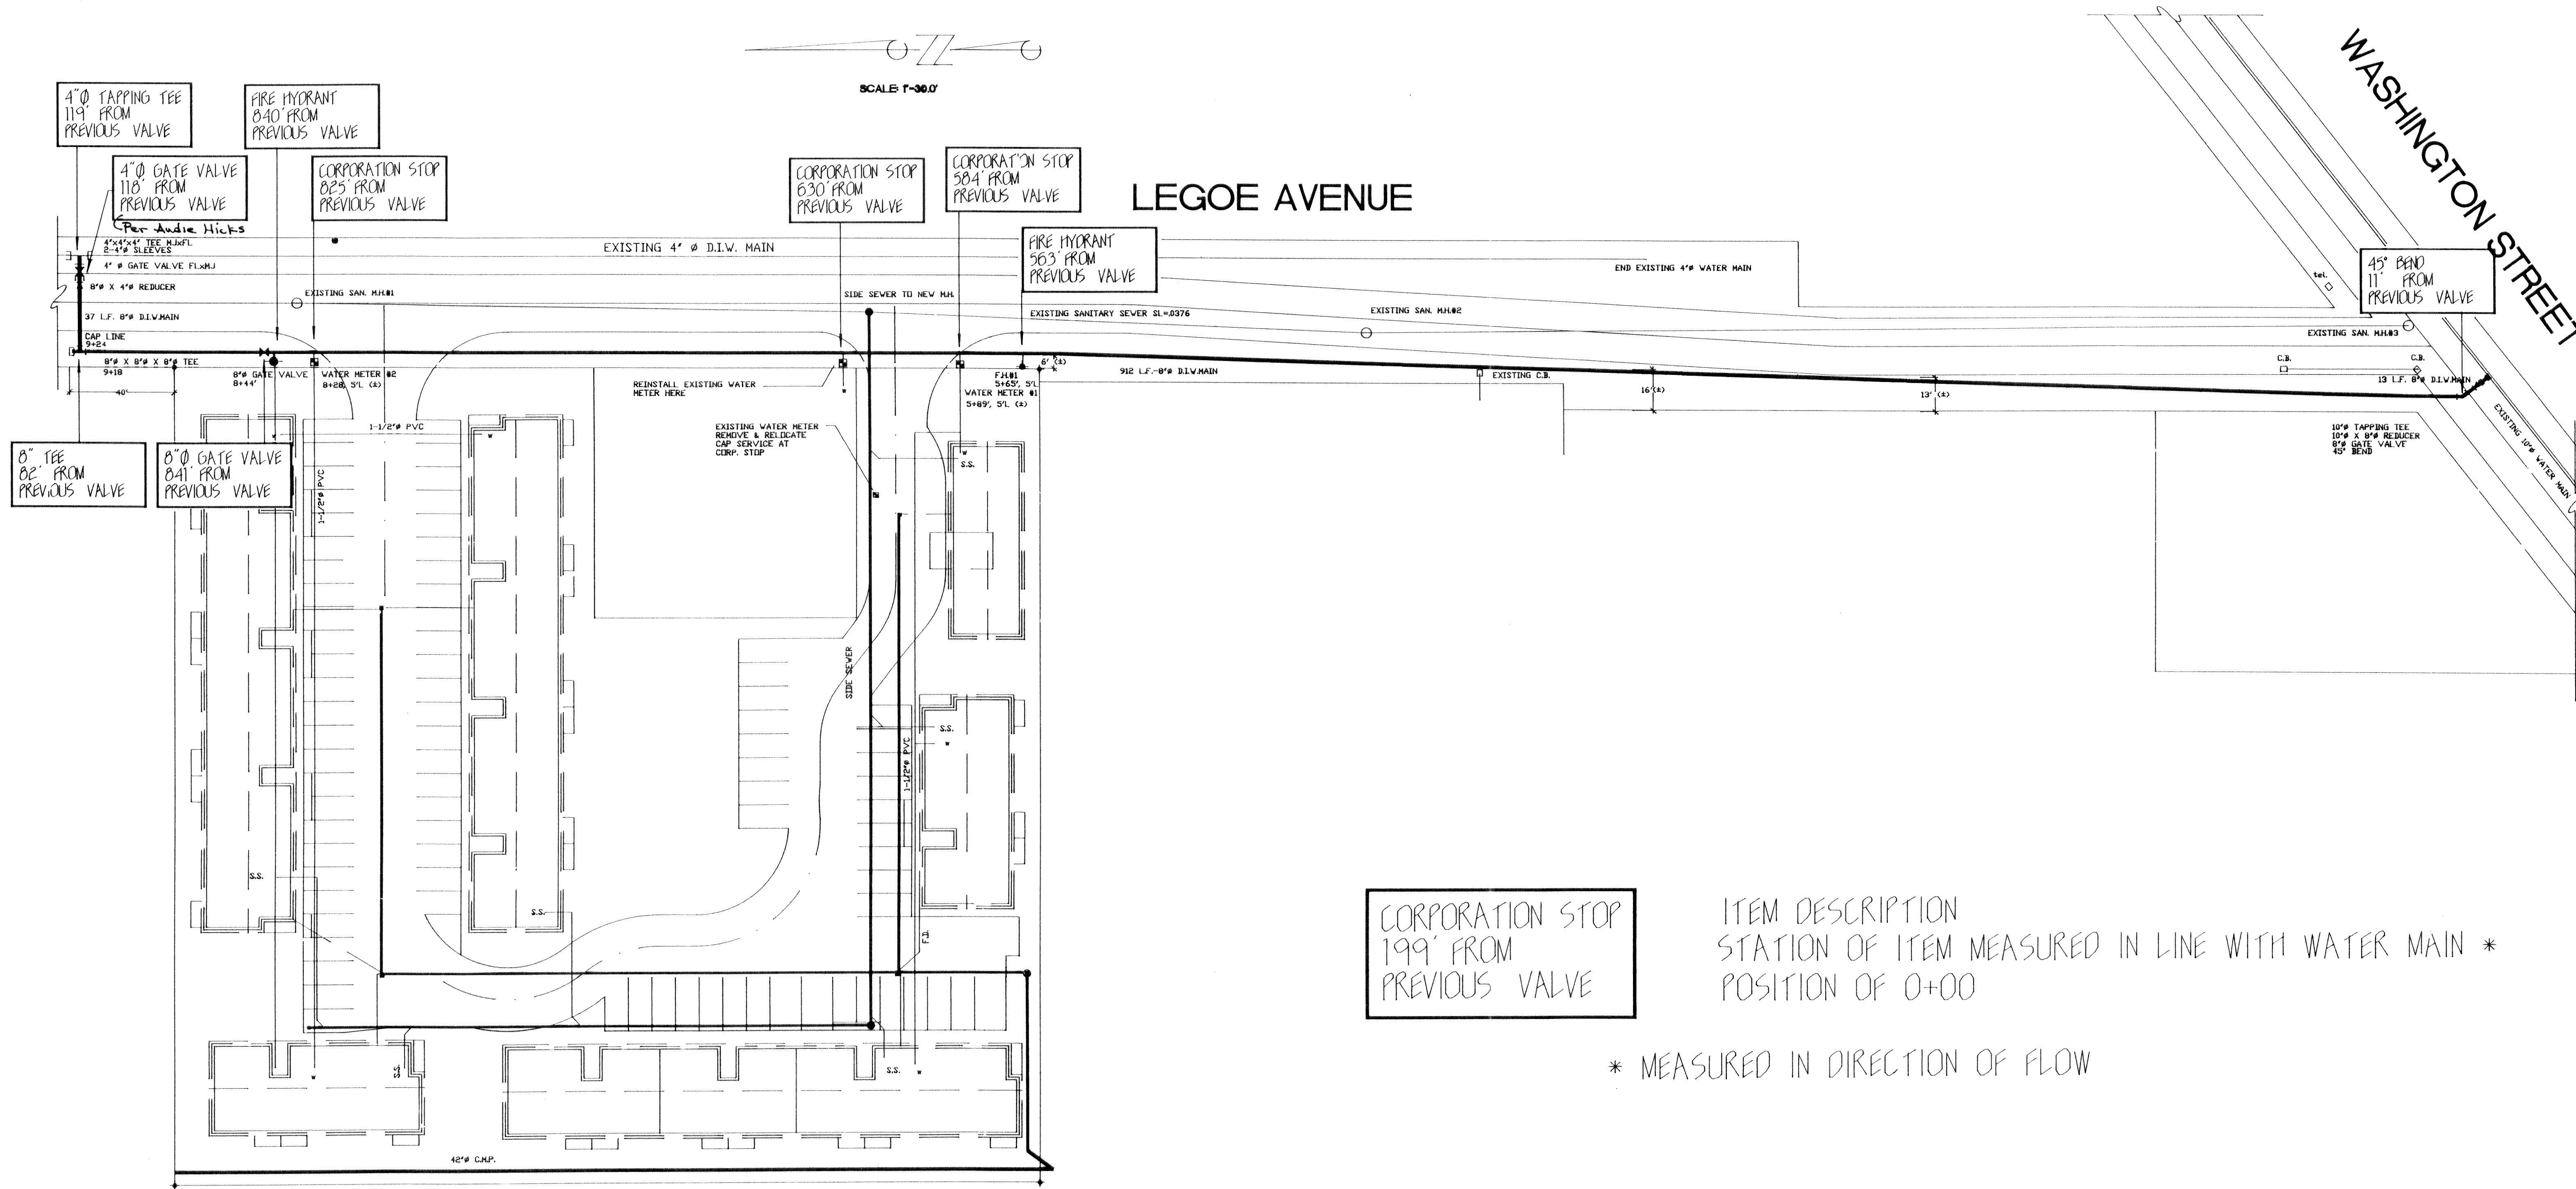


CORPORATION STOP
199' FROM
PREVIOUS VALVE

ITEM DESCRIPTION
STATION OF ITEM MEASURED IN LINE WITH WATER MAIN *
POSITION OF 0+00

* MEASURED IN DIRECTION OF FLOW

AS-BUILT DRAWING

BY: Greg Dibble
DATE: 8/7/91

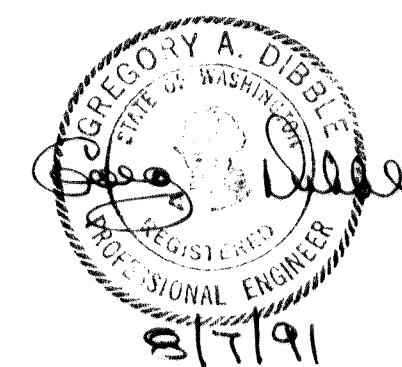

GREG DIBBLE, P.E.
CONSULTING ENGINEER
100 CENTRAL AVE. 734-1288
BELLINGHAM, WA 98225

MARVEL CONST.

SCALE: 1"=30'	APPROVED BY:	DRAWN BY: KG
DATE: 12/6/90		REVISED:

LEGOE ST.

WATER MAIN EXT.

DRAWING NUMBER
48390 2/2