

Seamount


SEAMOUNT

#4

FILE 53035

DON. H. EVANS, INC.
CIVIL ENGINEERS

SEWER MAP

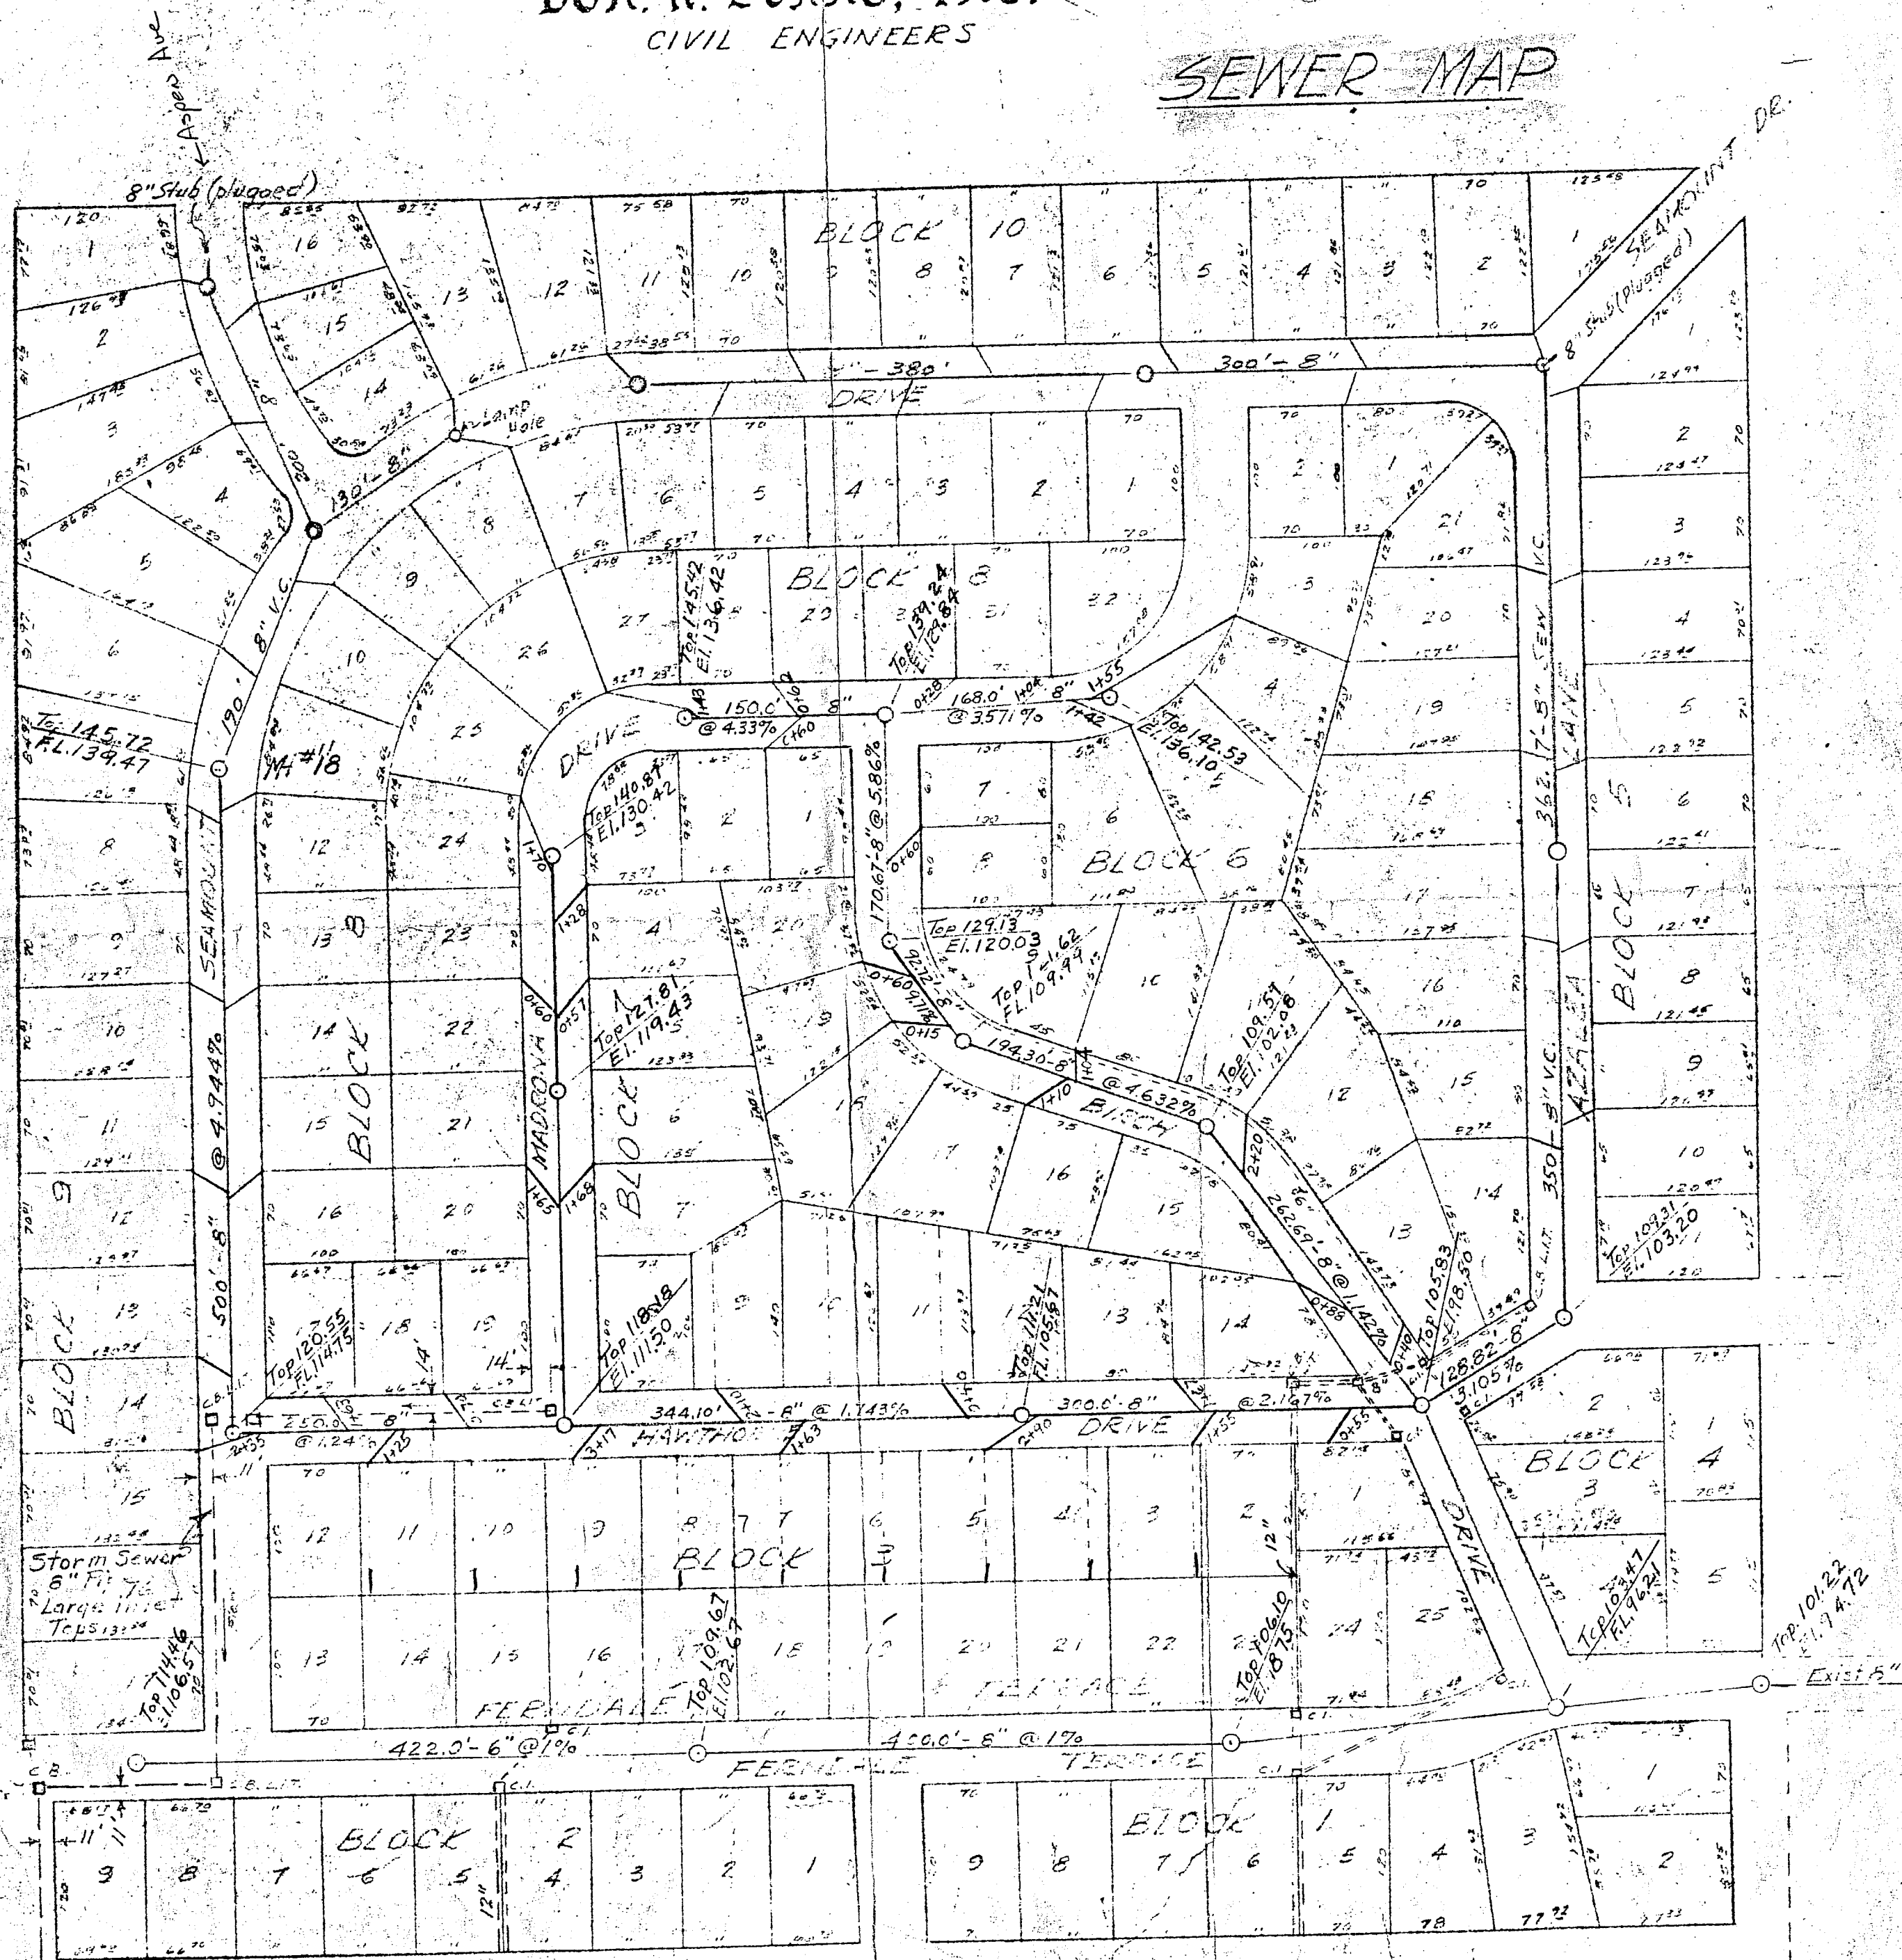

2/52/72 70 0071.003 CL 6128712

53035

Seamount

DON. H. EVANS, INC.
CIVIL ENGINEERS

SEAMOUNT DR.
WATER MAP

#4


Air VAC

FILE 530

WATER MAP

SEAMOUNT-WATER AND SEWER



21/5/21/9 100.74.00 72

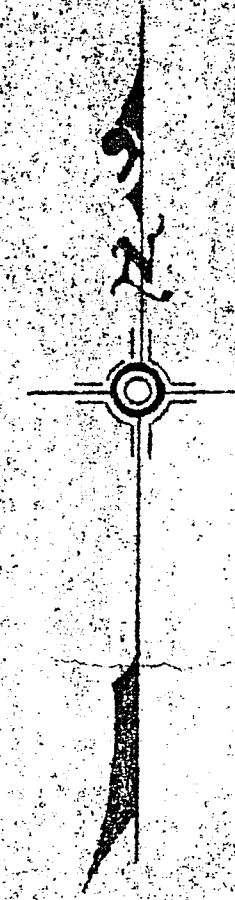

Seamont

DON. H. EVANS, INC.
CIVIL ENGINEERS


WATER MAP

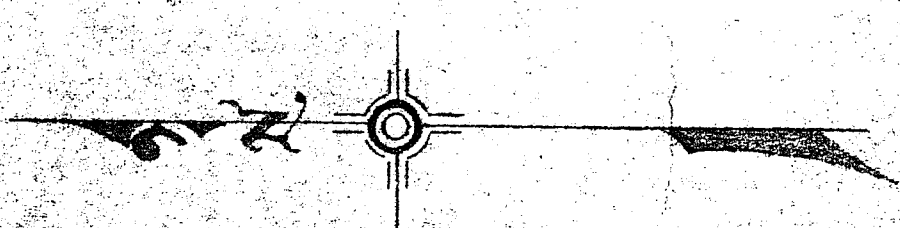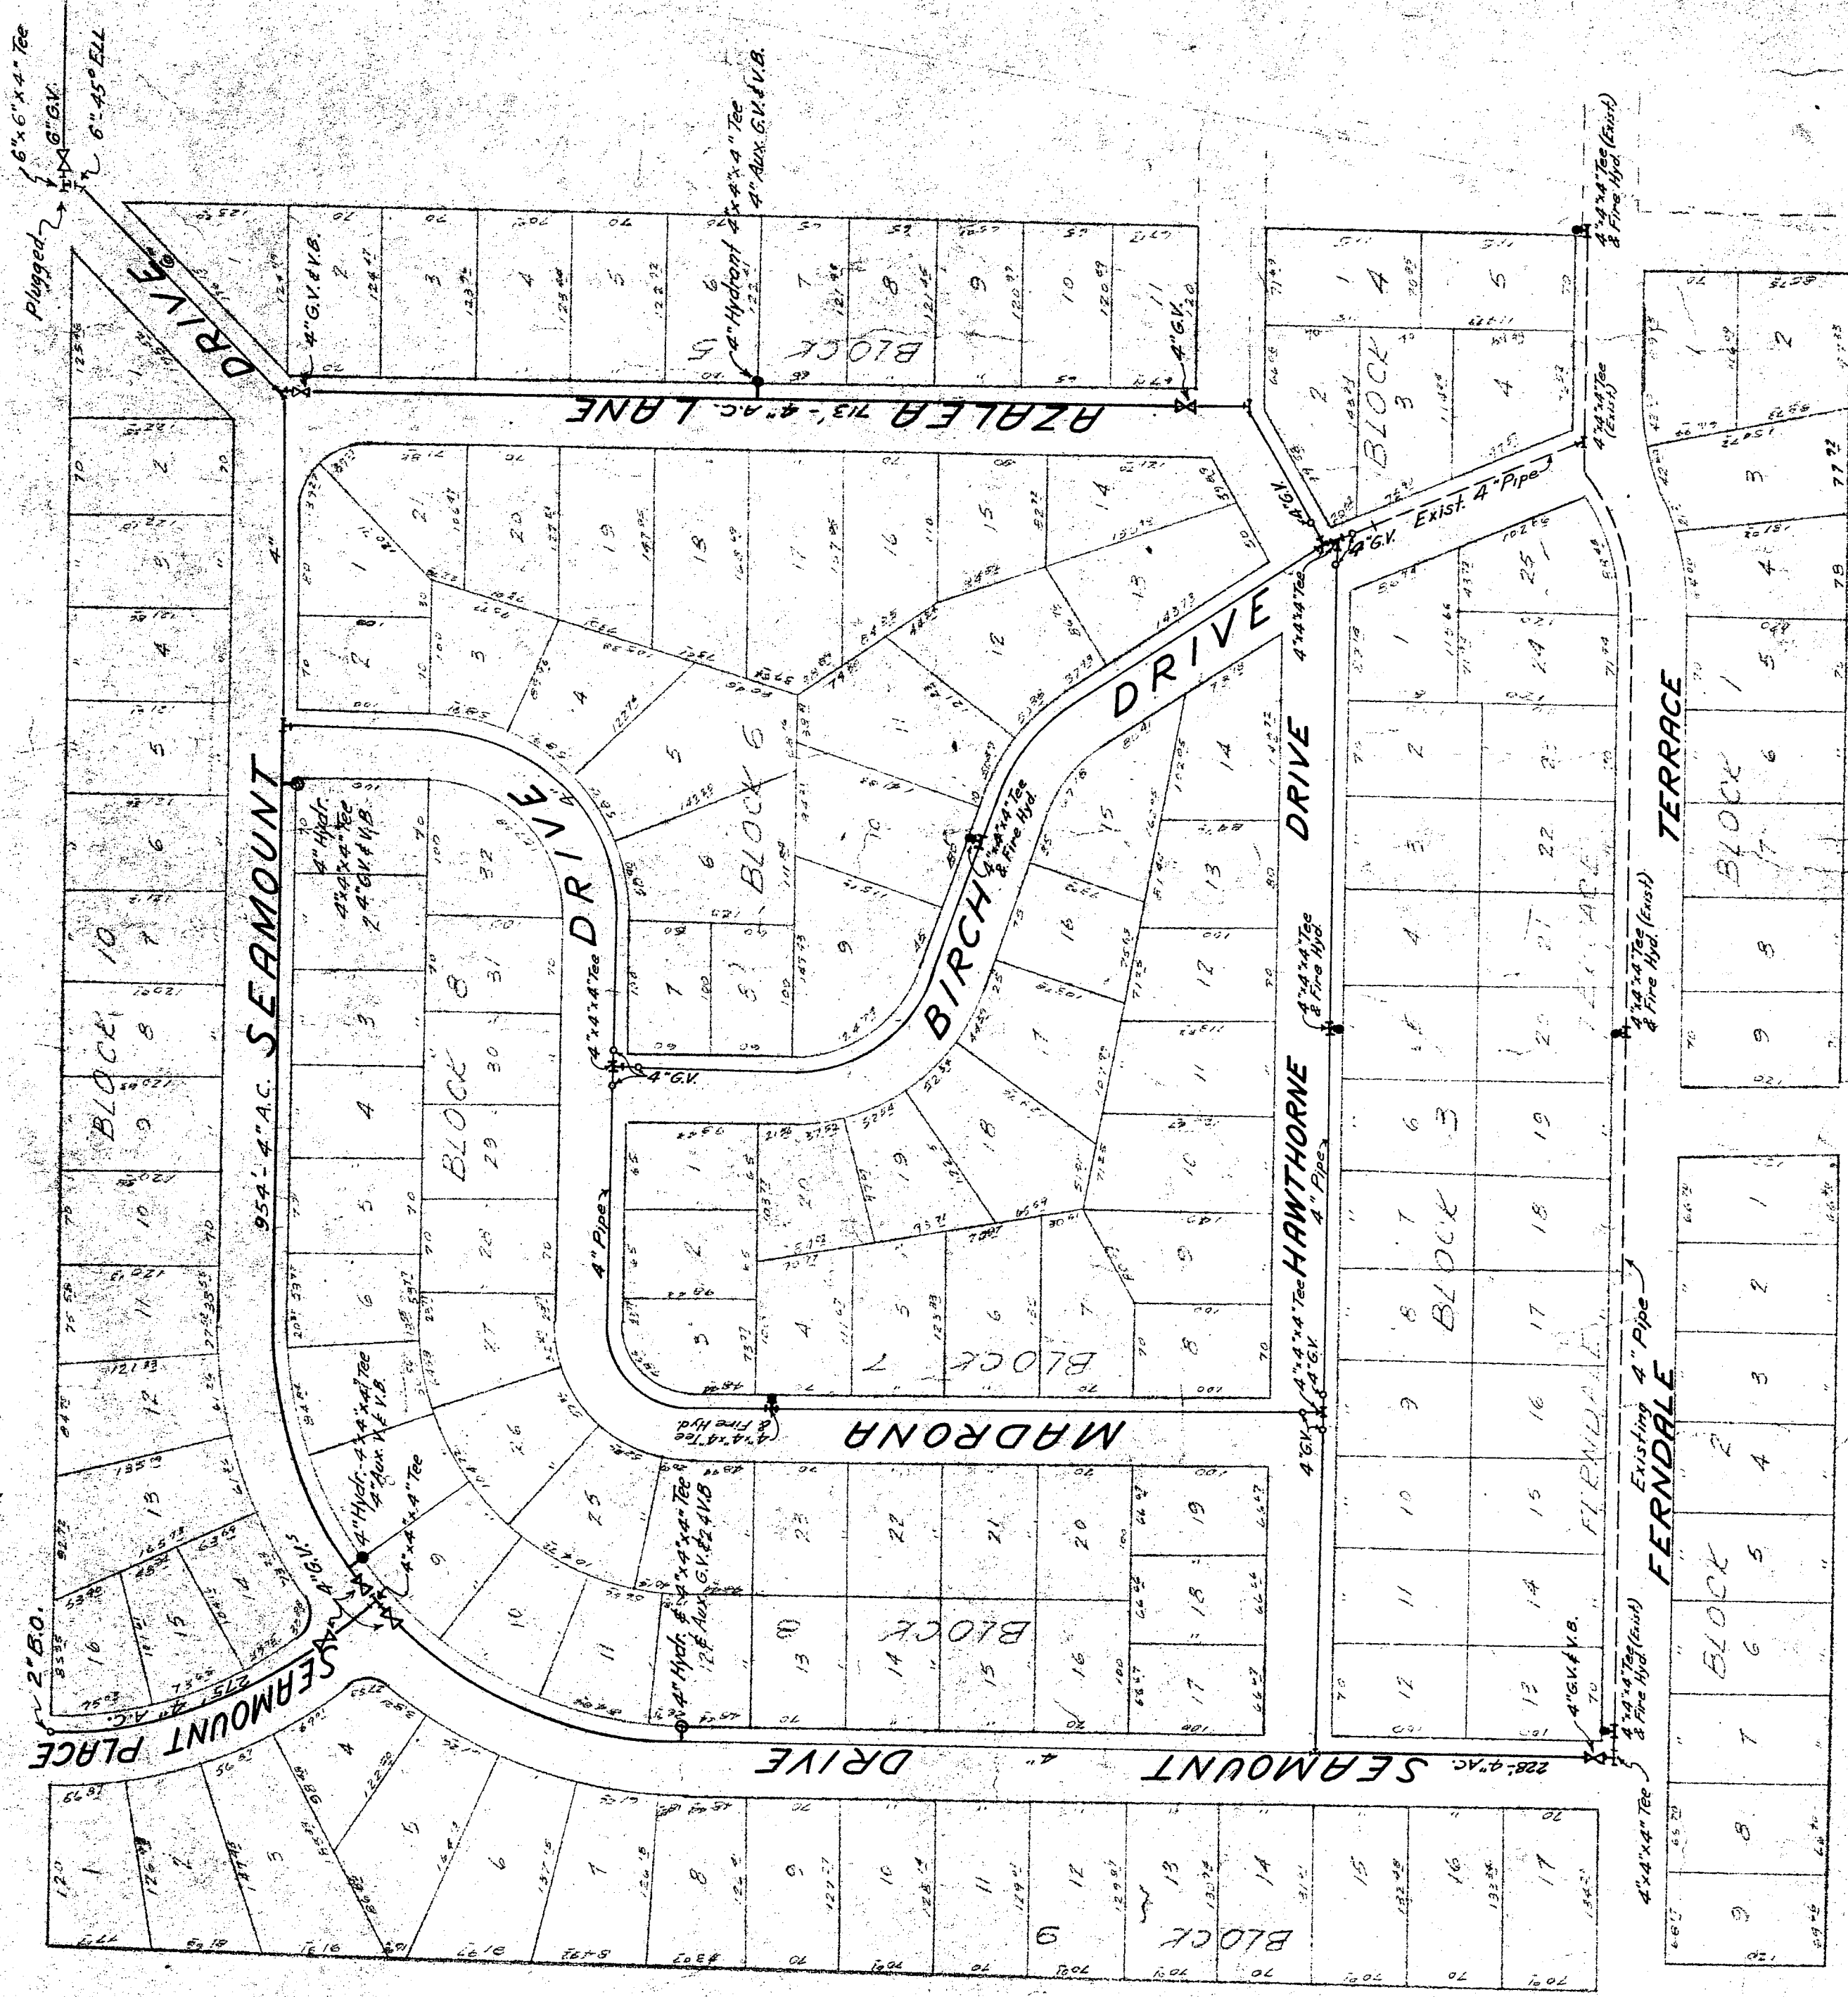

1"=100'

0071.004 C 1 17517

75055

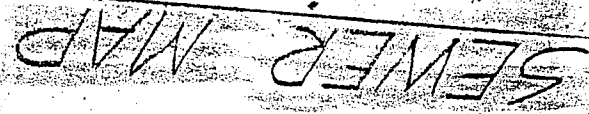

55035

Seamount

STEAMOUNT

力并