

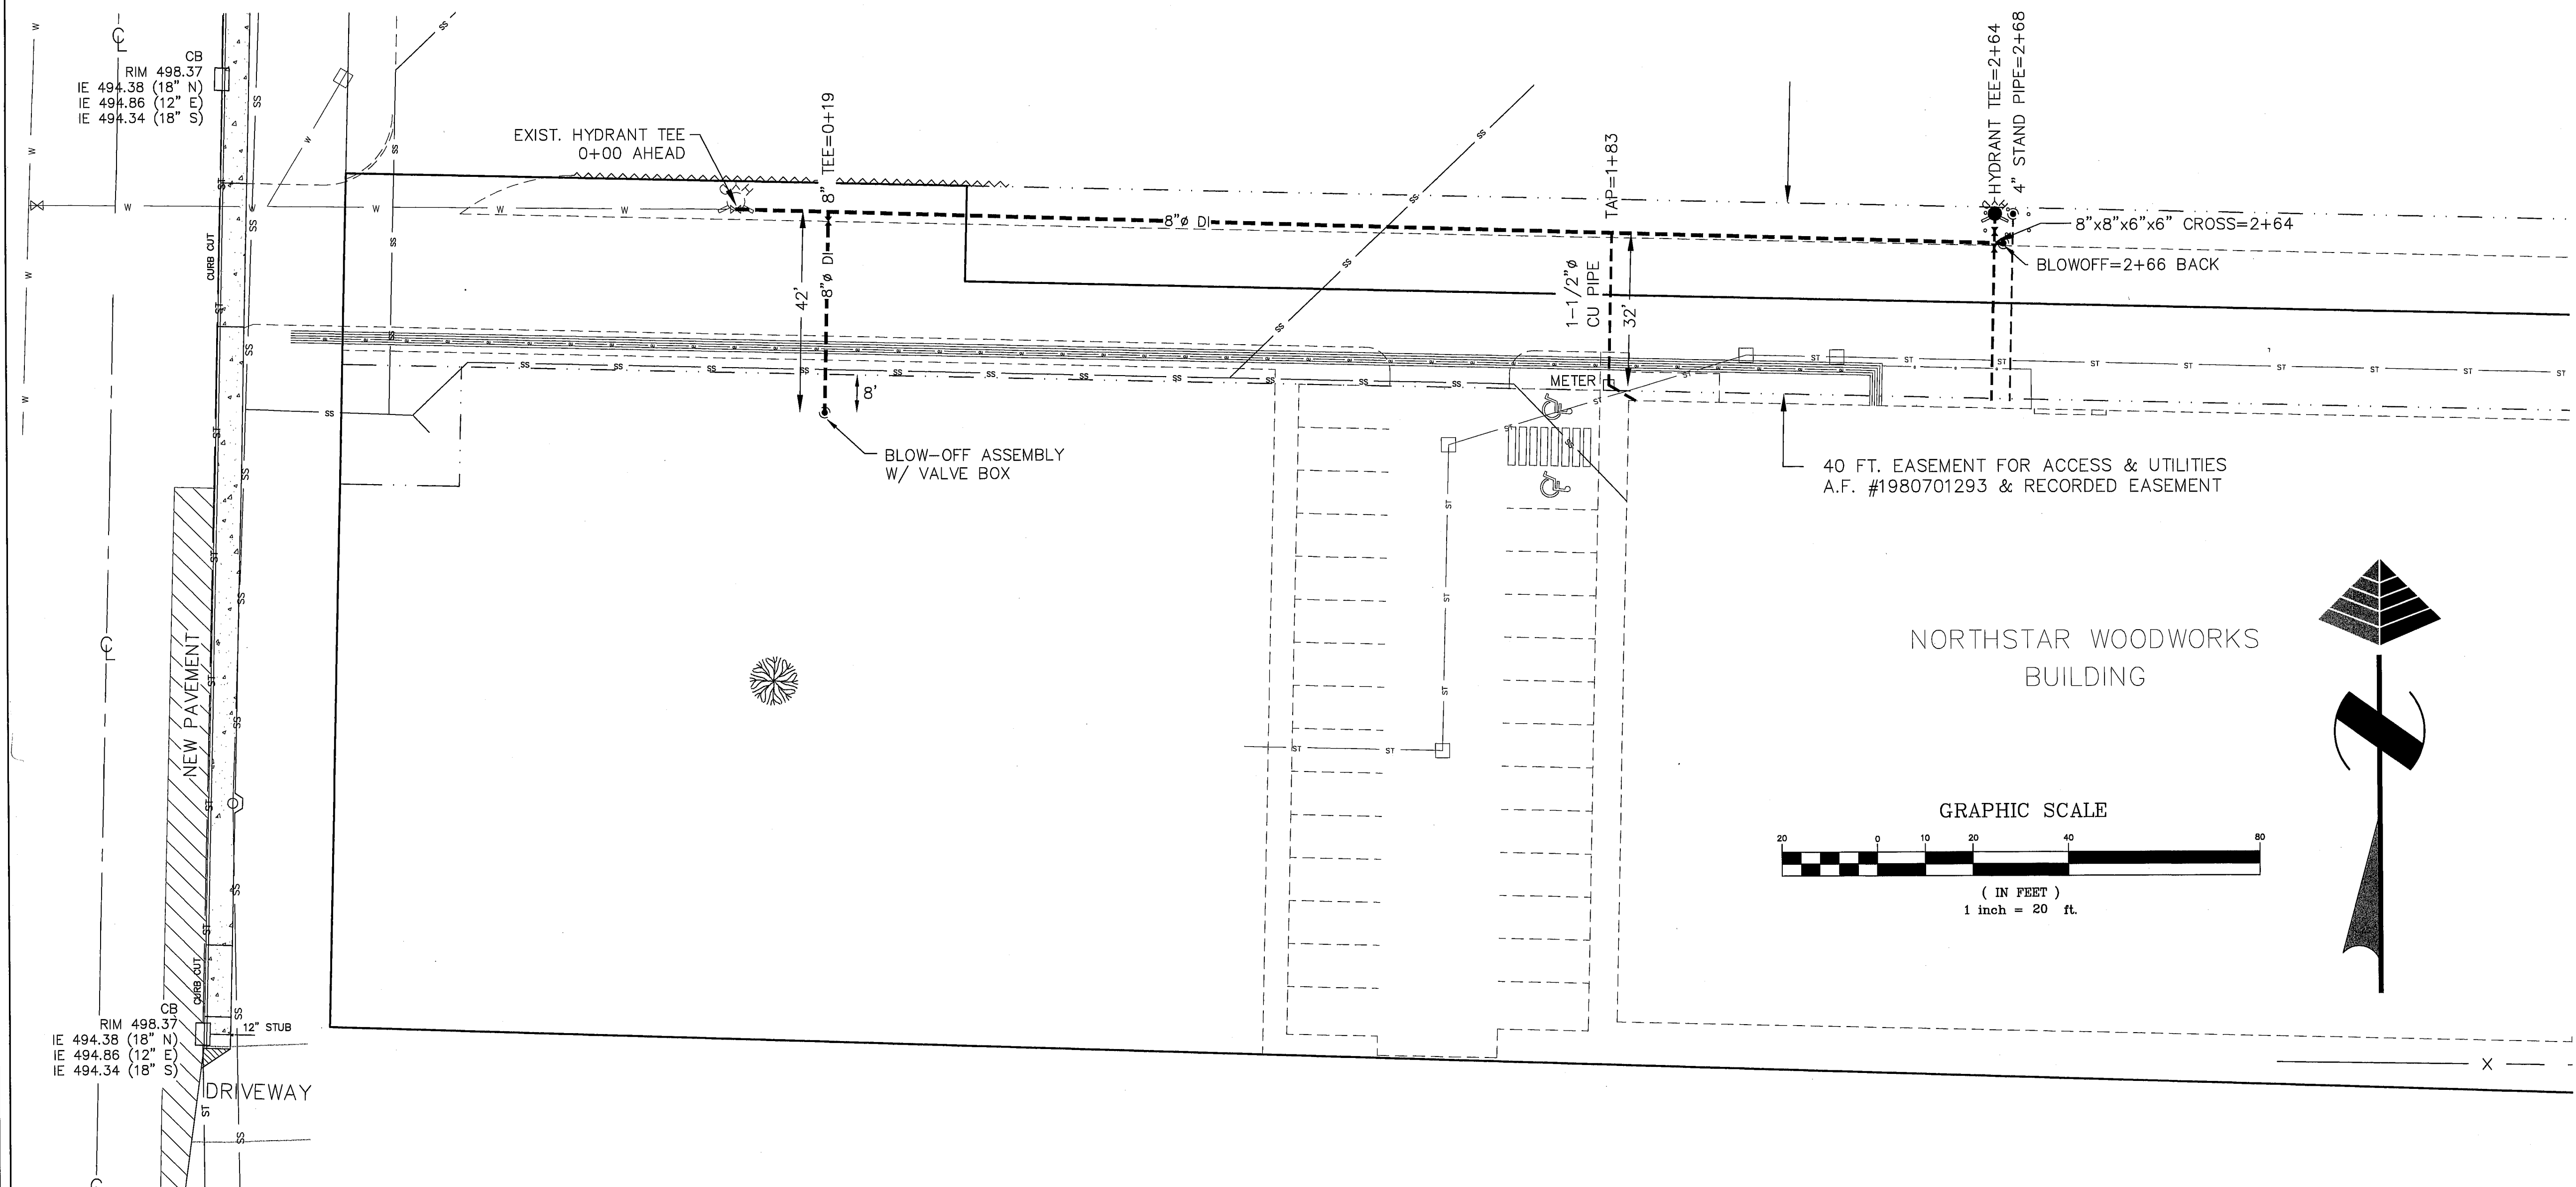


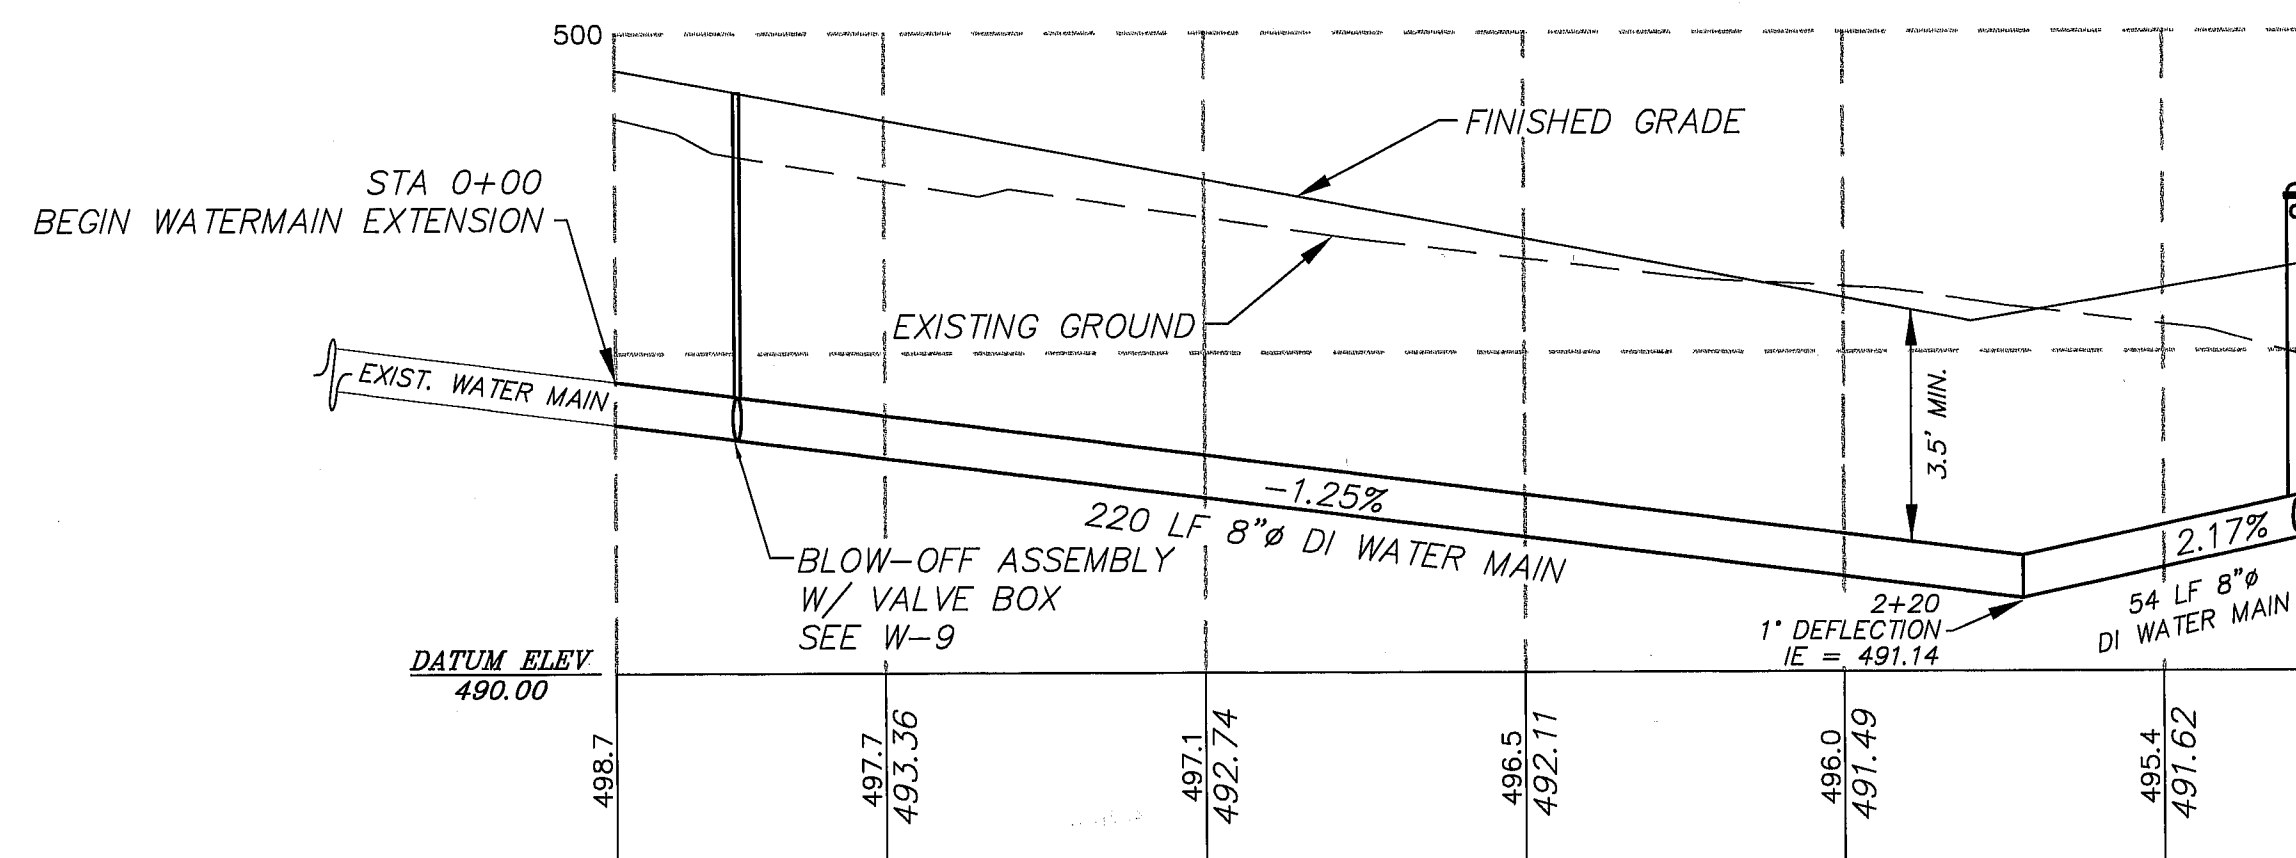

LEGEND	
	EXIST. WATER MAIN
	EXIST. FIRE HYDRANT
	EXIST. MAILBOX
	EXIST. SANITARY SEWER
	EXIST. ENTERPRISE ROAD PAVEMENT CENTERLINE (CROWN)
	EXIST. EDGE OF PAVEMENT
	EXIST. POWER POLE
	EASEMENT LINE
	EXIST. STORM MAIN
	EXIST. RETAINING WALL
496.1	PROFILE EXIST. GROUND ELEVATION
496.34	PROFILE PIPE INVERT ELEVATION
	AS-BUILT WATERMAIN
	AS-BUILT FIRE HYDRANT
	AS-BUILT WATER METER
	COMMON UTILITY LINES
	GAS LINE

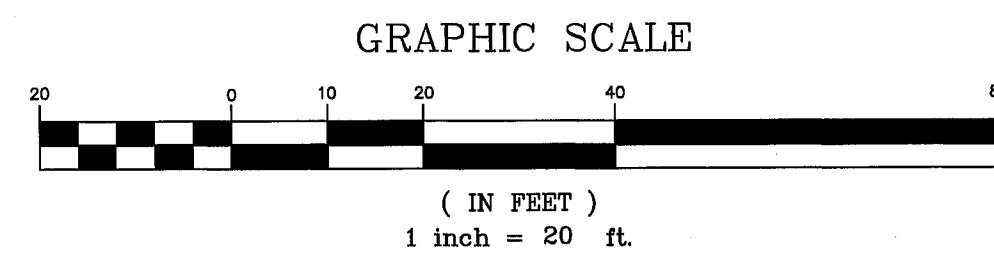


WATER MAIN EXTENSION

SCALE: 1" = 30' HORIZONTAL
1" = 3' VERTICAL

CALL BEFORE
YOU DIG
1-800-424-5555

I HEREBY CERTIFY THAT THE IMPROVEMENTS TO PORTAL WAY AND THE WATER MAIN EXTENSION SHOWN HAVE BEEN INSPECTED BY MILLENNIUM ENGINEERING AND THE CITY OF FERNDALE AND CONSTRUCTED IN CONFORMANCE WITH THE PLANS APPROVED BY THE PUBLIC WORKS DIRECTOR FOR SAID DEVELOPMENT AND THE GENERAL SPECIFICATIONS ADOPTED BY THE CITY OF FERNDALE DEPARTMENT OF PUBLIC WORKS.

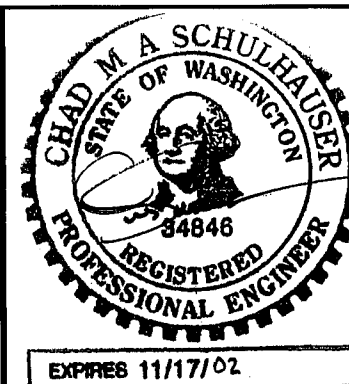

APPROVED
JUN 04 2001
BY *James J. Sperry*
CITY OF FERNDALE

APPROVAL STAMPS

DATUM
VERTICAL
T.B.M. ASSUMED 500.00
NWS&GPS TRAVERSE REBAR WITH RED CAP
N 788.82 E 8795.07
HORIZONTAL
ASSUMED COORDINATES AT SE PROPERTY CORNER
N 455.85 E 10445.23
BASIS OF BEARINGS
SOUTH PROPERTY LINE, SAID BEARING BEING S88°35'59"E.

MILLENNIUM
Engineering Group, Inc.
109-3rd ST., PO BOX 137, LYNDEN, WA 98264
PH: (360) 354-8141 FAX: (360) 354-3744
mail@2001egi.com www.2001egi.com

NORTHSTAR WOODWORKS, INC. OFFICE SITE		SCALE: VARIES
AS-BUILT WATER MAIN EXTENSION & PORTAL WAY FRONTAGE IMPROVEMENTS		DATE: 05/29/01
FOR NORTHSTAR WOODWORKS, INC.		DRAWN BY: CMAS
PTN. SW1/4, SE1/4, SEC.17, T39N, R2E, W.M. CITY OF FERNDALE, WHATCOM COUNTY, WASHINGTON		REVISION:
		SHEET: 1 OF 1
		JOB NUMBER: 00022