

the plat of Scenic Heights

Sec 19, Twp 39 N, R2E, W.M., Whatcom County, Washington

acknowledgement

State of Washington ss
County of Whatcom
This is to certify that on this 28th day of February, 1911, before me, the undersigned, a notary public in and for said county and state, personally appeared Peter Van Dyk to me known to be an agent for Bessie Hauge as described in the contract under Auditors File No. 1062450, and that he executed the within and foregoing dedication and acknowledged the said dedication to be his free and voluntary act and deed for the uses and purposes therein mentioned.
Witness my hand and official seal the day and year first above written.


[Signature]
Notary Public in and for the State of Washington
Residing at *[Address]*

certificate of description

I, Dale R. Rockey, do hereby certify that this plat was made upon an actual survey made in accordance with the laws of this state; that all distances, courses and angles are true; and that this plat covers and embraces that portion of the northeast quarter of the southwest quarter of Section 19, Township 39 North, Range 2 East, W.M., Whatcom County, Washington, described as follows:

Commencing at the southwest corner of said Government Lot 16, 50 feet to the East line of County Road No. 372 (Church St) Beginning; thence N 01° 30' 00" E parallel to the West line of said Church St 375.34 feet; thence S 88° 30' 00" E, 300.00 feet; thence N 01° 30' 00" E, 173.21 feet; thence N 01° 10' 00" E, 11.58 feet; thence S 88° 32' 06" E, 311.12 feet; thence S 2° 12' 46" W, 442.15 feet to the True Point of Beginning.

Existing 1188' R/W South of E
line Road

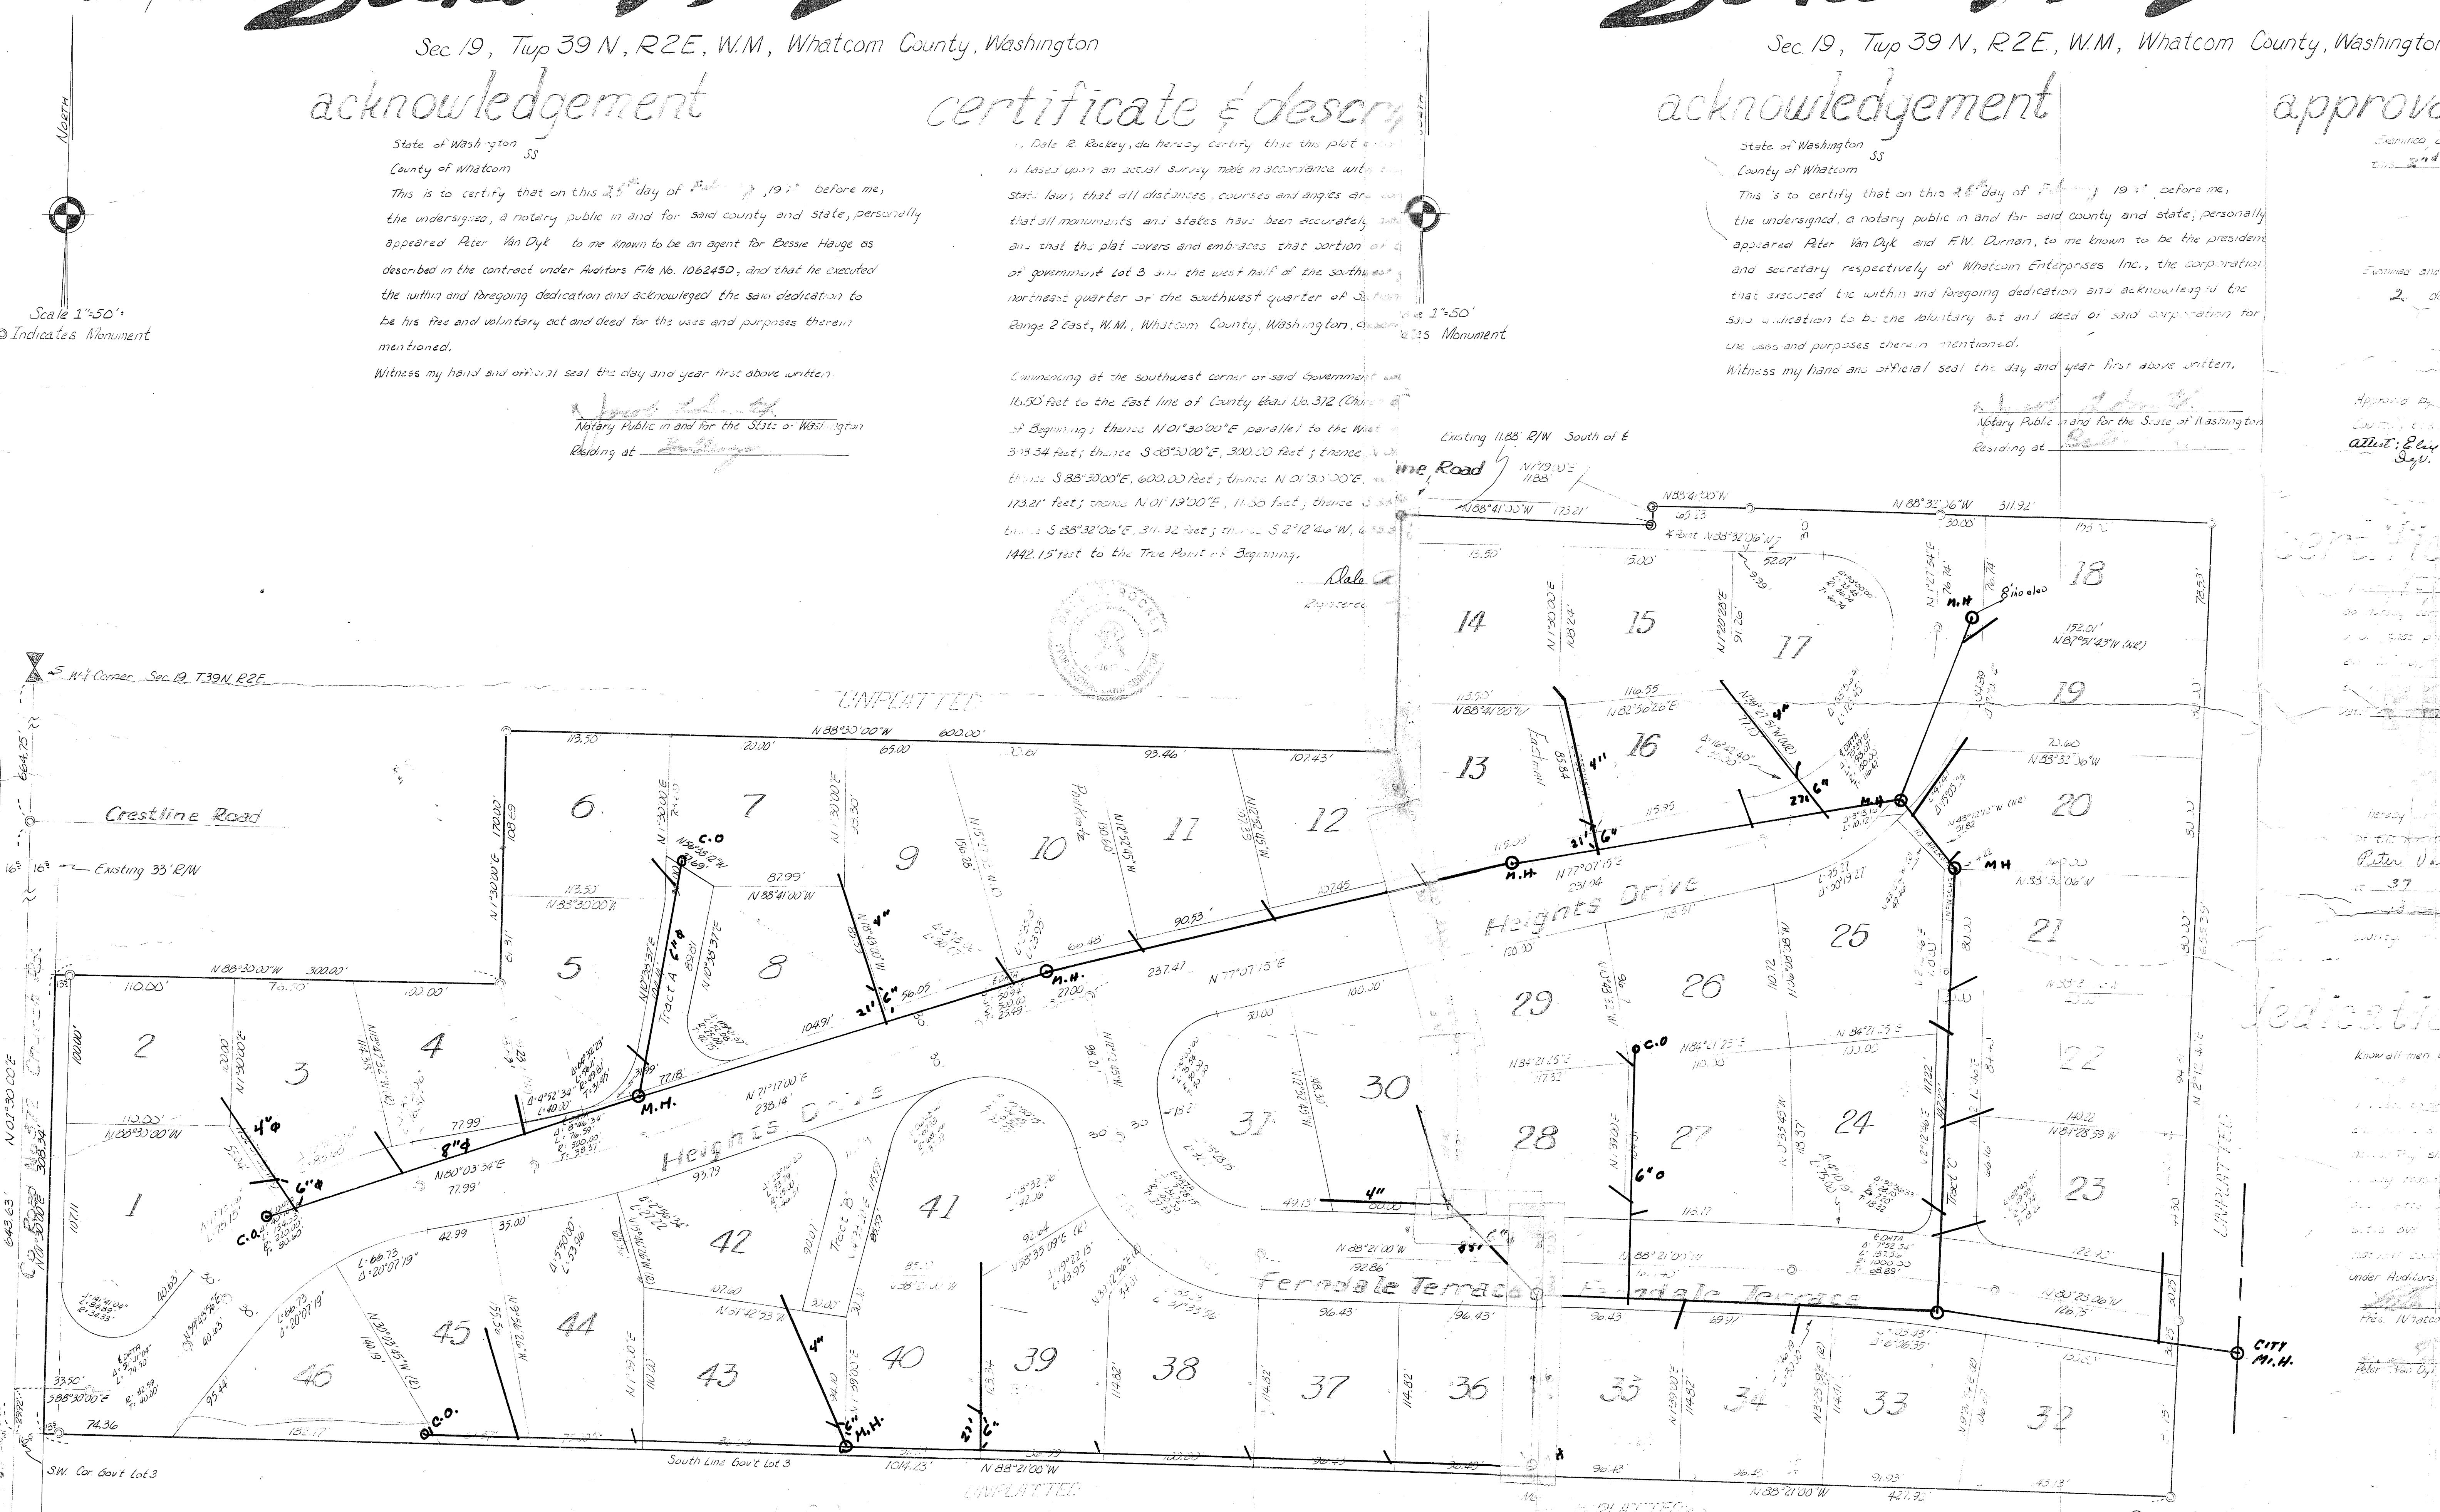

the plat of Scenic Heights

Sec 19, Twp 39 N, R2E, W.M., Whatcom County, Washington

acknowledgement

State of Washington ss
County of Whatcom
This is to certify that on this 28th day of February, 1911, before me, the undersigned, a notary public in and for said county and state, personally appeared Peter Van Dyk and F.W. Durnan, to me known to be the president and secretary respectively of Whatcom Enterprises Inc., the corporation that executed the within and foregoing dedication and acknowledged the said dedication to be the voluntary act and deed of said corporation for the uses and purposes therein mentioned.
Witness my hand and official seal the day and year first above written.

[Signature]
Notary Public in and for the State of Washington
Residing at *[Address]*

approval

Examined and approved by me, the President of the Central City Water Association, this 28th day of February, 1911.
[Signature]
Approved by order of the Board of Directors, this 28th day of February, 1911.
[Signature]
attest: Elmer J. [Signature]
Sgt. [Signature]

certified

By the Notary Public for the State of Washington, this 28th day of February, 1911.

dedication

Know all men by these presents, that I, Peter Van Dyk, do hereby dedicate the within and foregoing land to the Central City Water Association, for the use and purpose therein mentioned, and I do hereby acknowledge the said dedication to be my free and voluntary act and deed for the uses and purposes therein mentioned.
Witness my hand and official seal the day and year first above written.
Peter Van Dyk, for Bessie Hauge


Scenic Heights

Scenic Heights/Sewer asbuilts #7

DATE	BY
SURVEYED	
NOTE BOOK	
NO.	

DATE	BY
SURVEYED	
NOTE BOOK	
NO.	

2467 Crestline
12-29-98 JMK

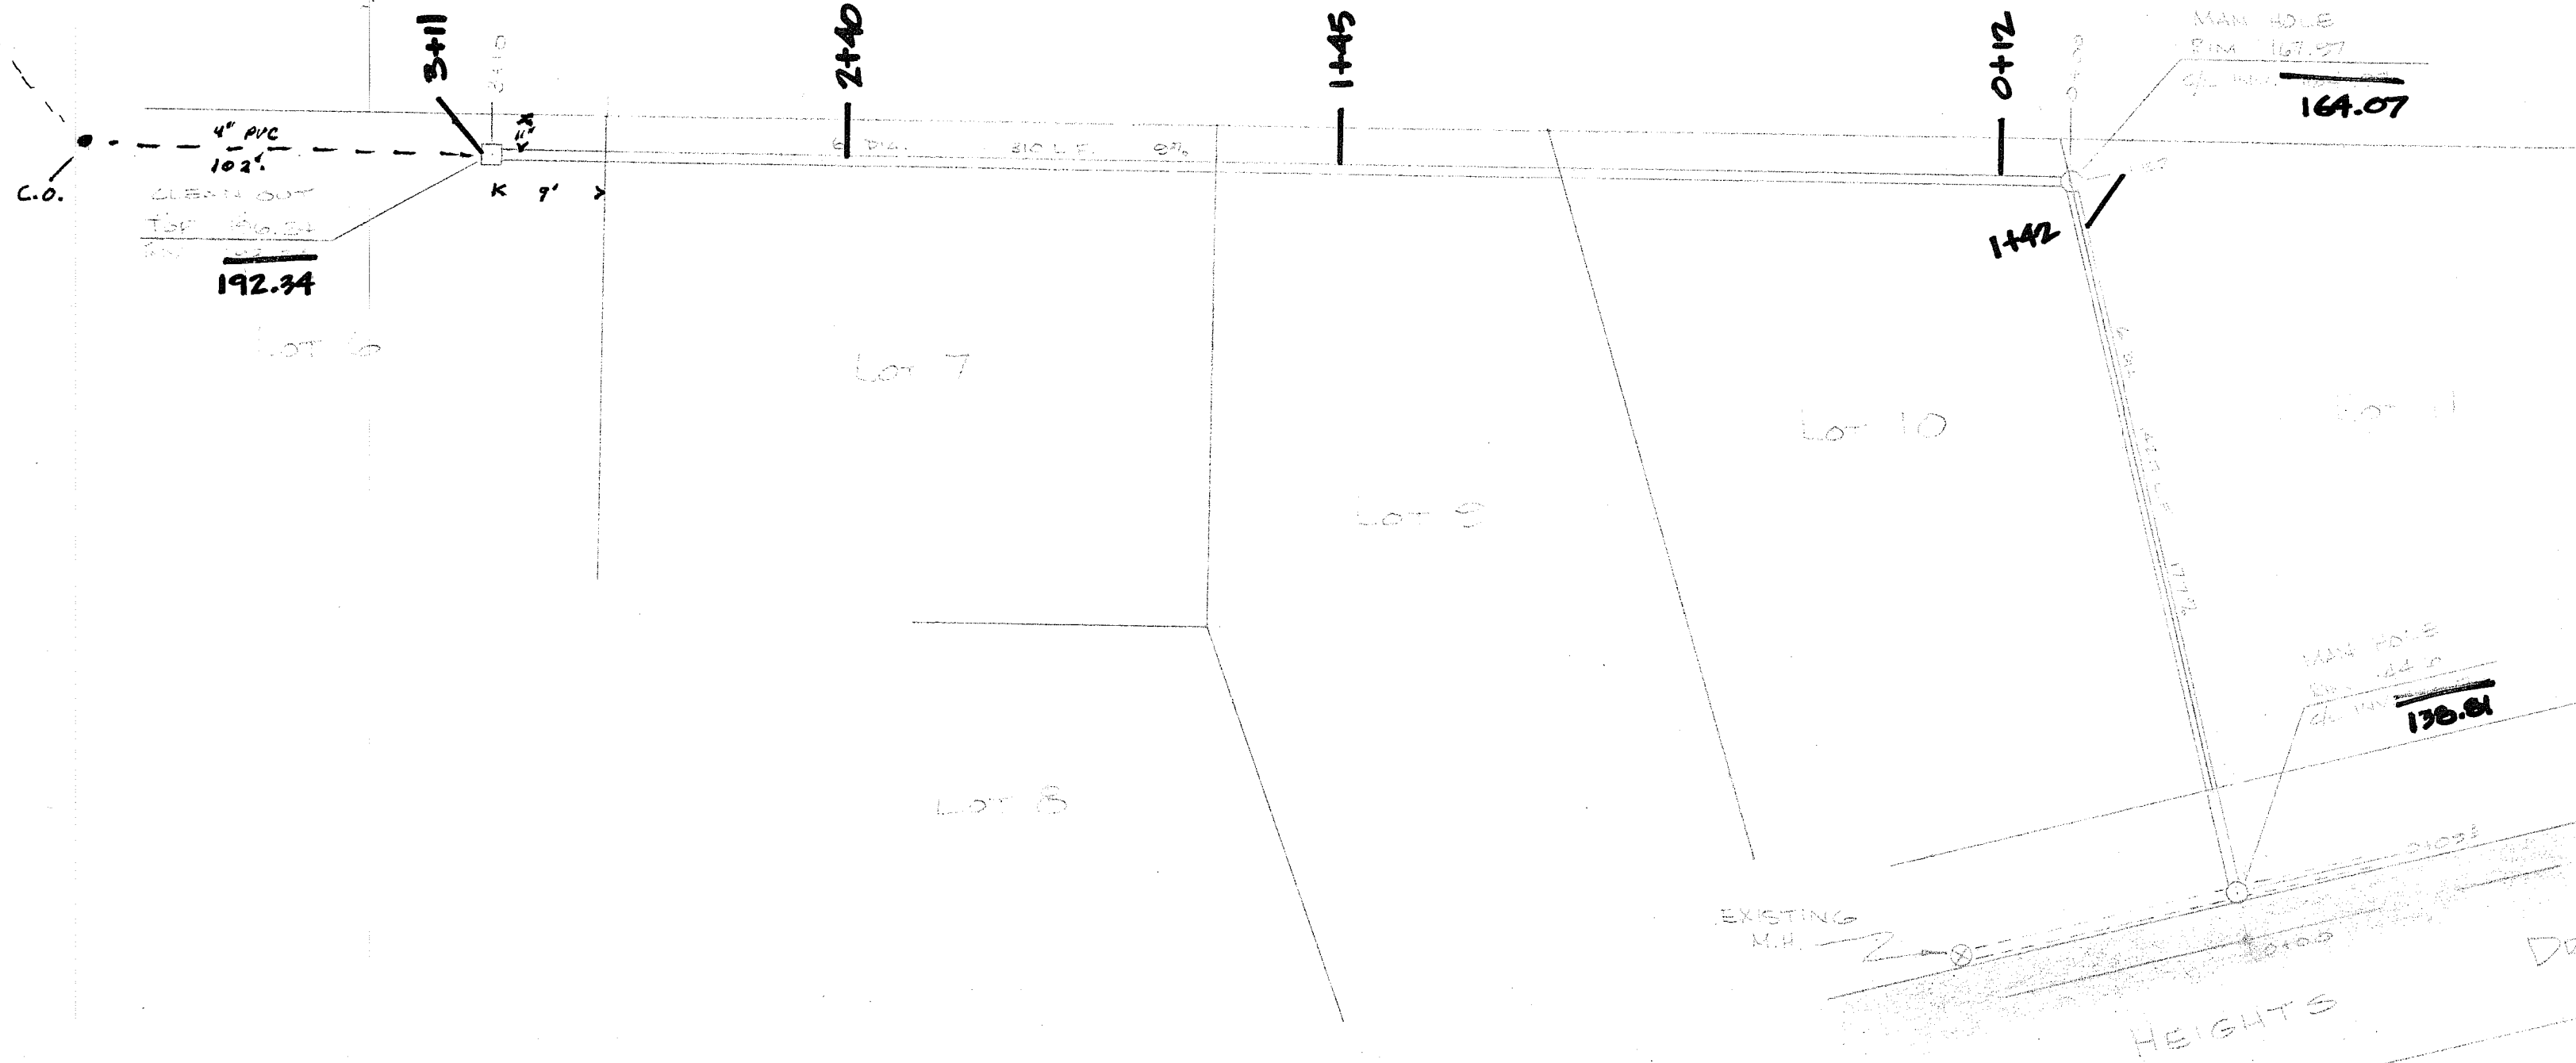

ASBUILT DRAWING
11/17/77

FRIBERG & FENTON EXCAVATING
2008 Iron Street
Bellingham, WA 98225

645602 S124/2cc

NOTES

A. OWNER - CENTRAL CITY WATER ASSOCIATION


B. REPRESENTATIVE - PAUL MATZ
5832 CHURCH ROAD
FERNDALE, WASHINGTON
PHONE - 384-3619

C. SYSTEM LAYOUT


1. STORAGE 50,000 GALLON REINFORCED CONCRETE RESERVOIR TANK AND A 2,000-GALLON PRESSURE TANK.
2. SOURCE 290 FT. 8" DIAMETER STEEL CASED WELL WITH SCREENS.
3. PUMP SUBMERSIBLE WELL PUMP CAPABLE OF DELIVERING 60 G.P.M. AT 300 FT. T.D.H. PUMP IS POWERED BY A 230 VOLT, 7 1/2 H.P. ELECTRIC MOTOR.

D. CUSTOMERS




1. AREA DARKENED IN REPRESENT THE PRESENT CUSTOMERS BEING SERVED BY THE SYSTEM.

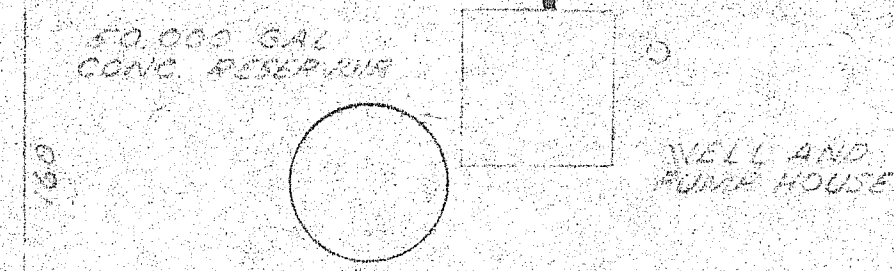

RESERVOIR & PUMP HOUSE DETAIL
SCALE 1"=30'

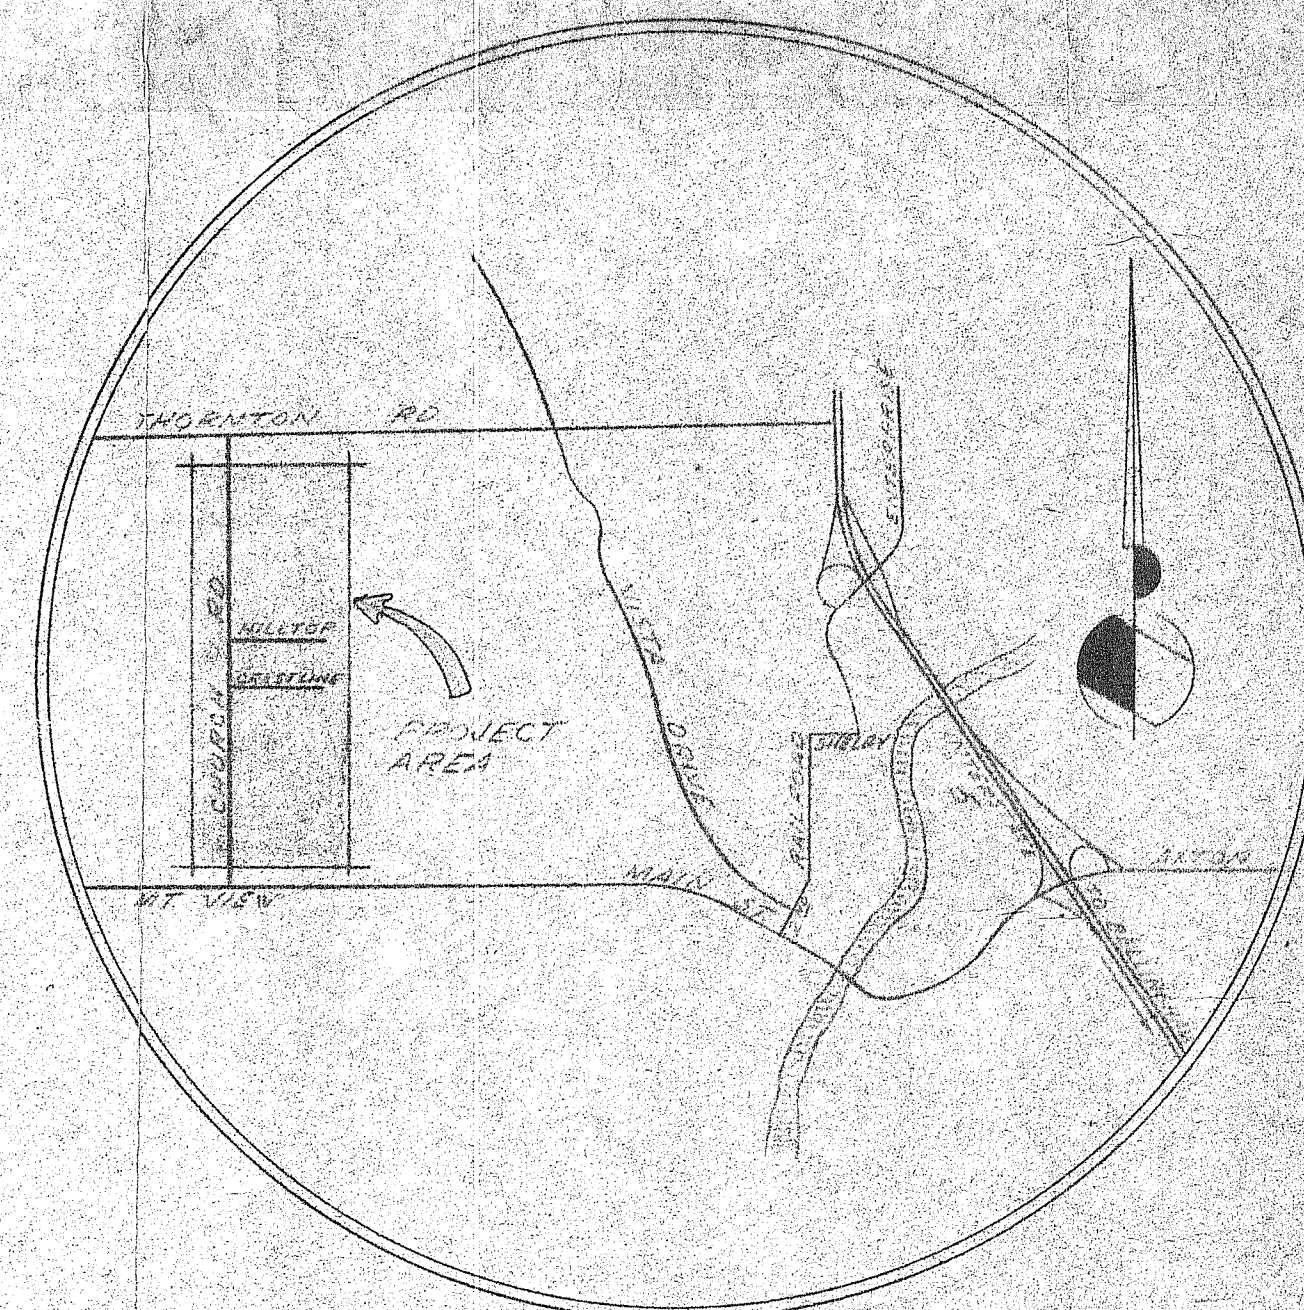

VICINITY MAP

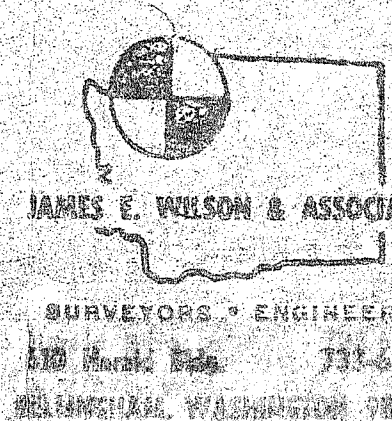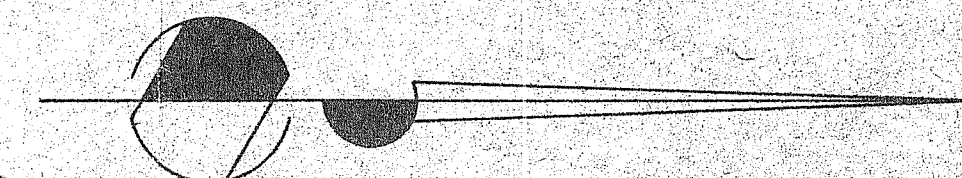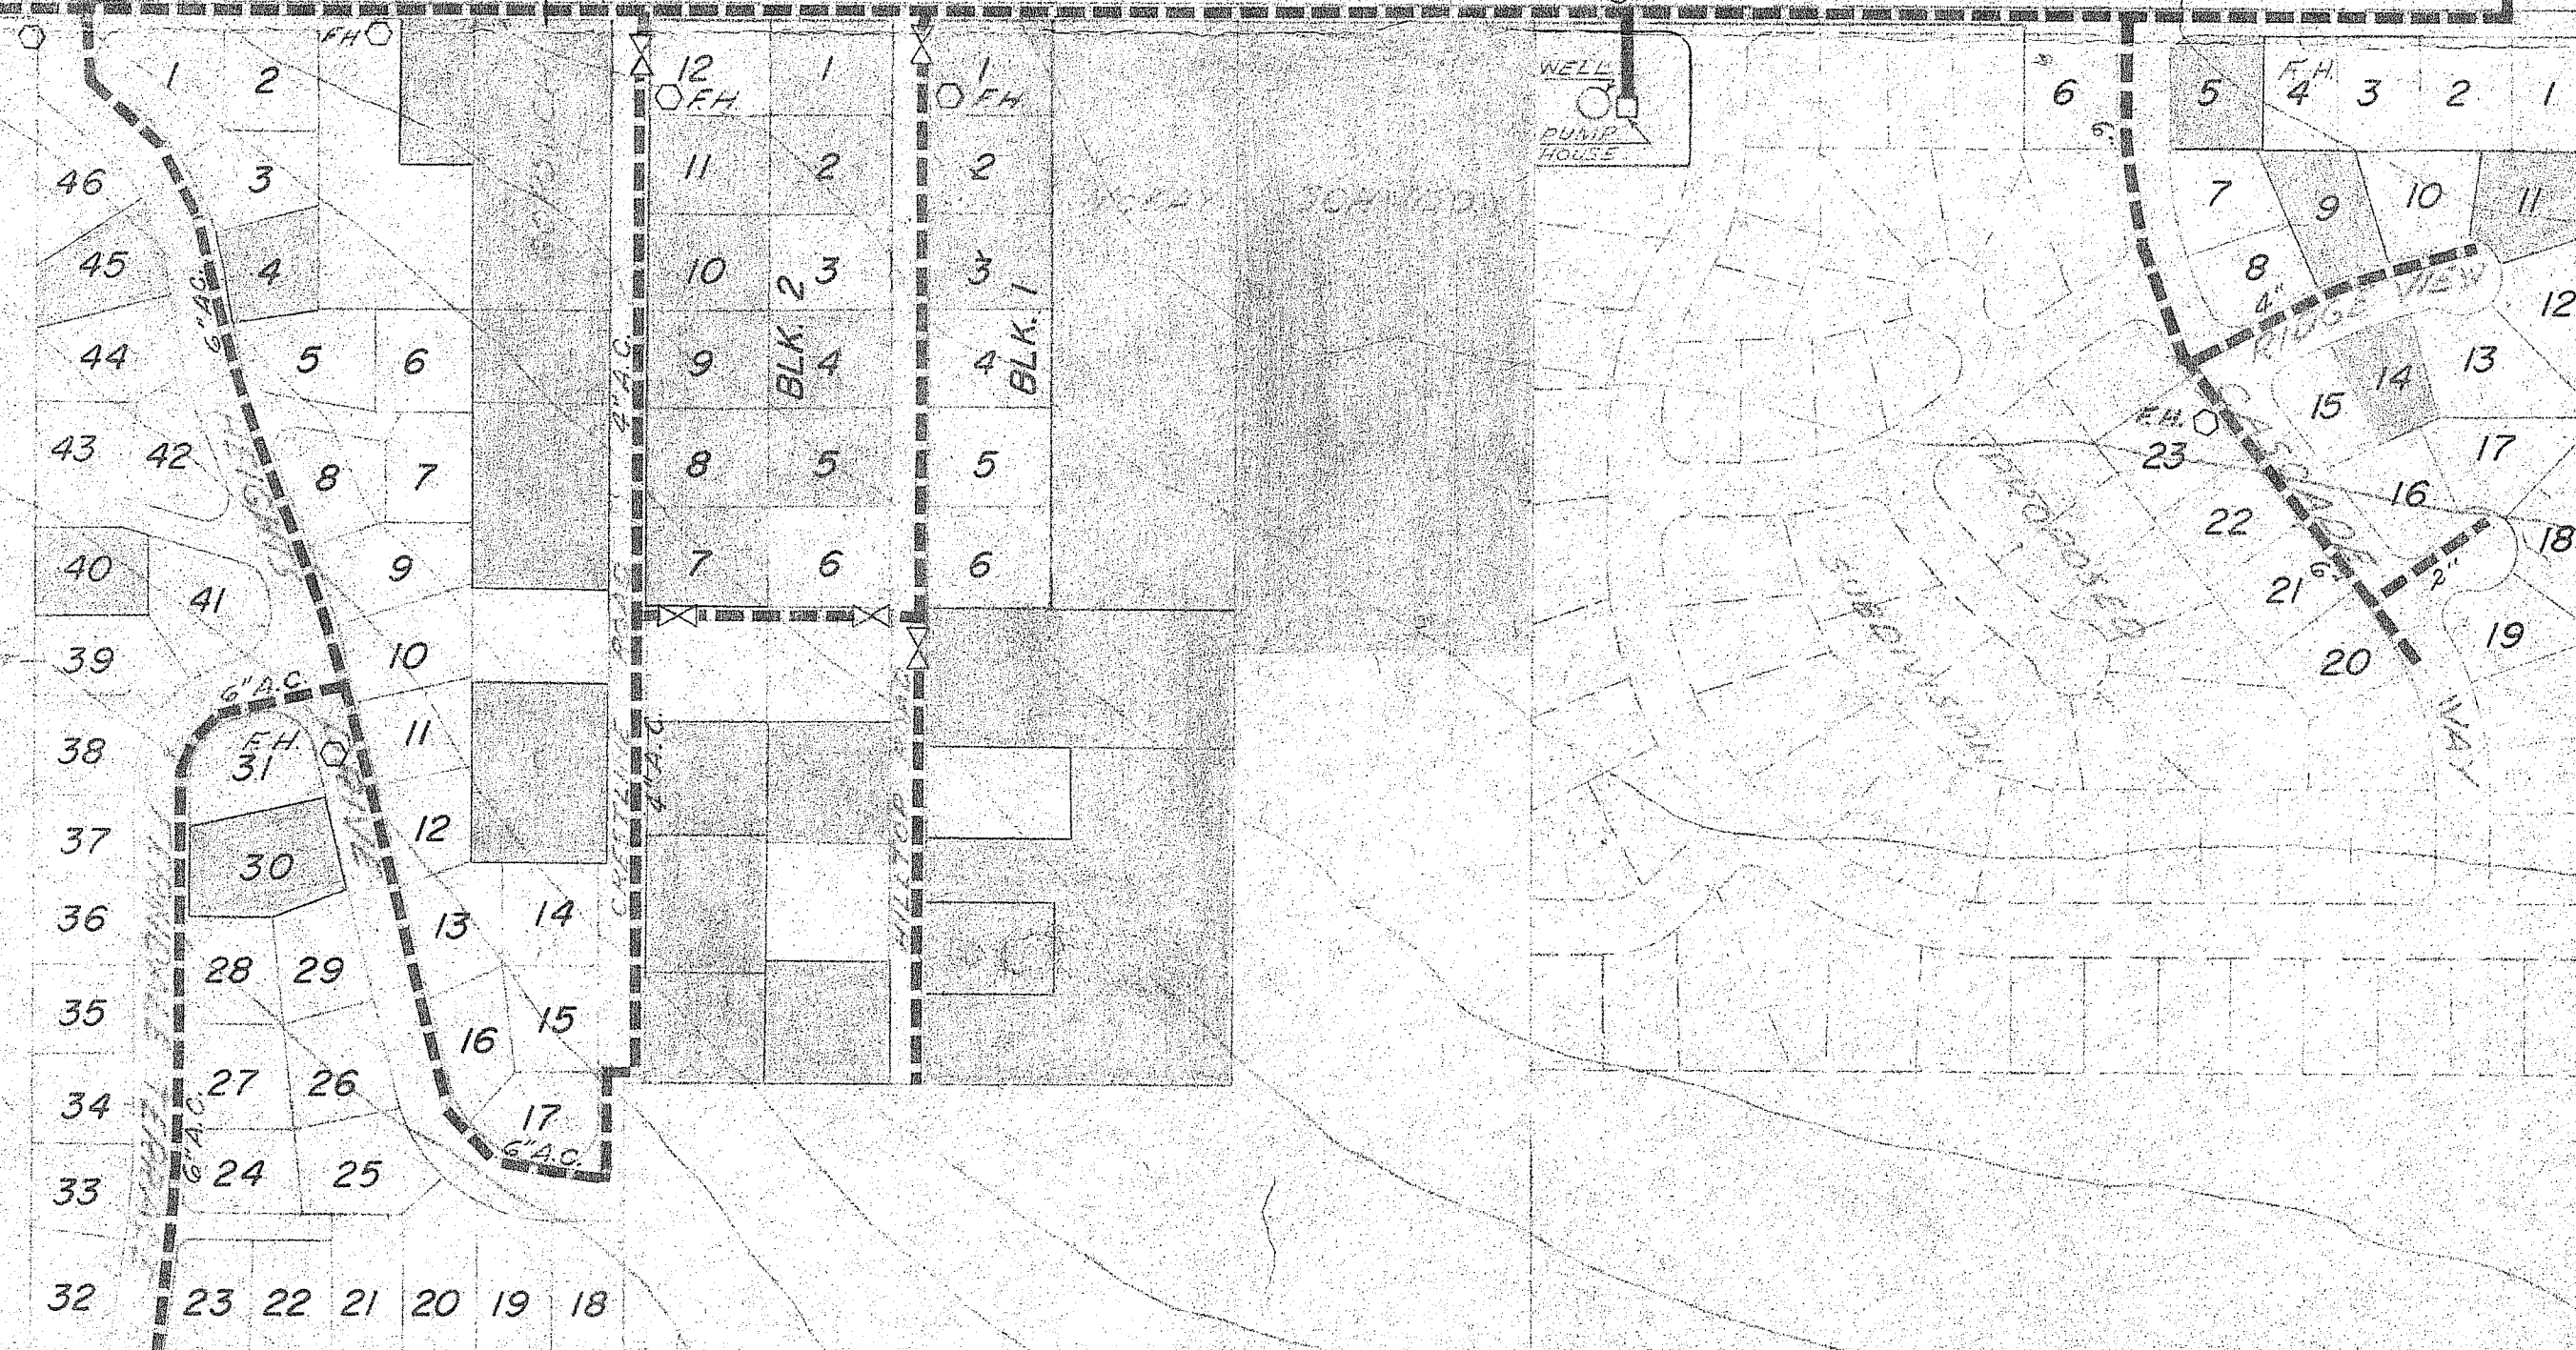

CENTRAL CITY WATER 153

SCALE: 1"=200'	APPROVED BY:	DRAWN BY:
----------------	--------------	-----------

WATER SYSTEM DRAWING

DRAWING NO.
78.37