


509.041 CL 7/15/12

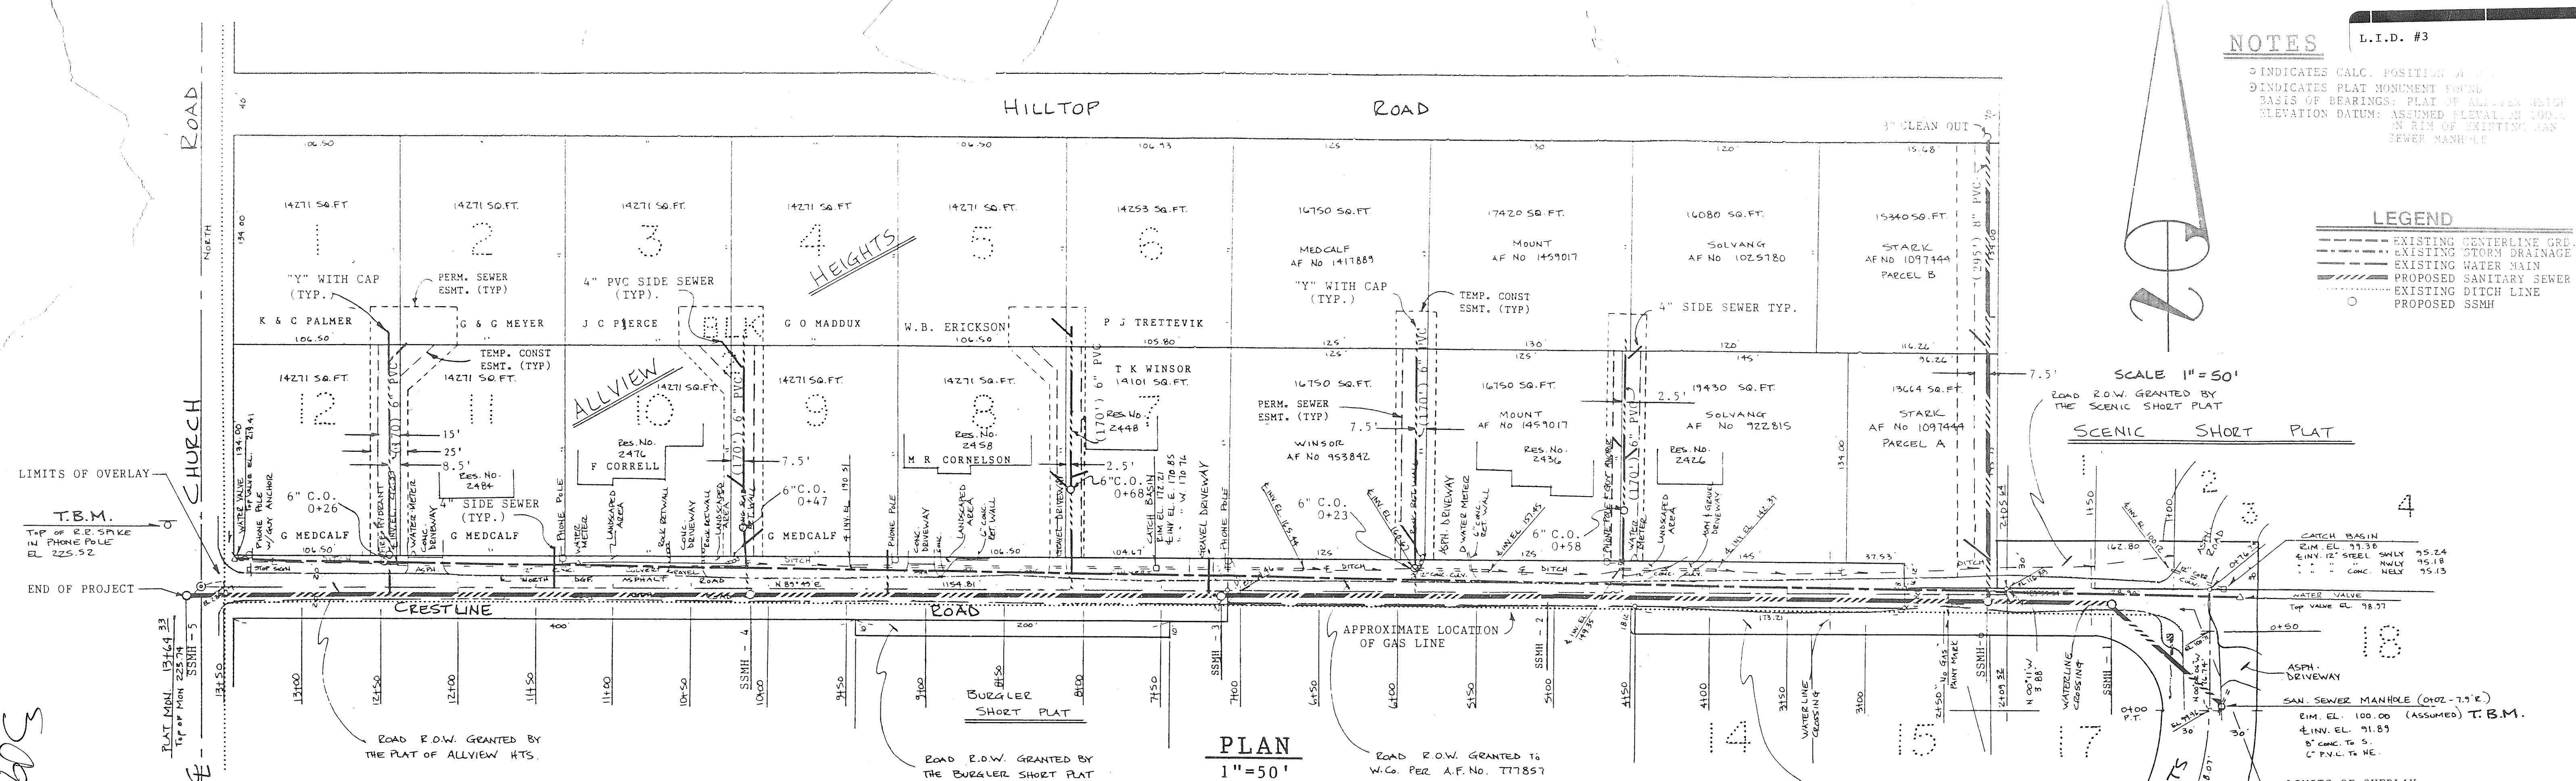

NOTES

INDICATES CALC. POSITION

INDICATES PLAT MONUMENT FOUND

BASIS OF BEARINGS: PLAT BY ALLIANCE

ELEVATION DATUM: ASSUMED ELEVATION 100.00

ON RIM OF EXISTING SAN SEWER MANHOLE

LEGEND

--- EXISTING CENTERLINE GRD.

--- EXISTING STORM DRAINAGE

--- EXISTING WATER MAIN

--- PROPOSED SANITARY SEWER

--- EXISTING DITCH LINE

○ PROPOSED SS MH

SCALE 1"=50'

ROAD R.O.W. GRANTED BY THE SCENIC SHORT PLAT


SCENIC SHORT PLAT

PLAN

1"=50'

SCENIC HEIGHTS

- GENERAL NOTES**
1. All workmanship and materials shall conform to applicable provisions of the "1988 Standard Specifications for Road, Bridge, and Municipal Construction", DOT/APWA, and shall comply with the Detailed Specifications contained within the Contract Documents.
 2. The Contractor is cautioned that underground utilities do exist in the construction area which may interfere with excavation. The Contractor shall make every effort to locate the utilities ahead of the excavation and shall be responsible for their maintenance and protection during his operation.
 3. Inspection by the City of Ferndale's consulting Engineer shall be required whenever any work other than maintenance of the Contractor's equipment is being done. Inspection shall be provided at no cost to the Contractor.
- Public and private utilities shall be moved by the owning companies. The Contractor shall conform to Section 1-07.17 of the Standard Specifications.
- Any delay or rescheduling of the Contractor's work caused by the relocation of any utilities shall be considered as incidental to construction and no additional compensation shall be allowed therefor.

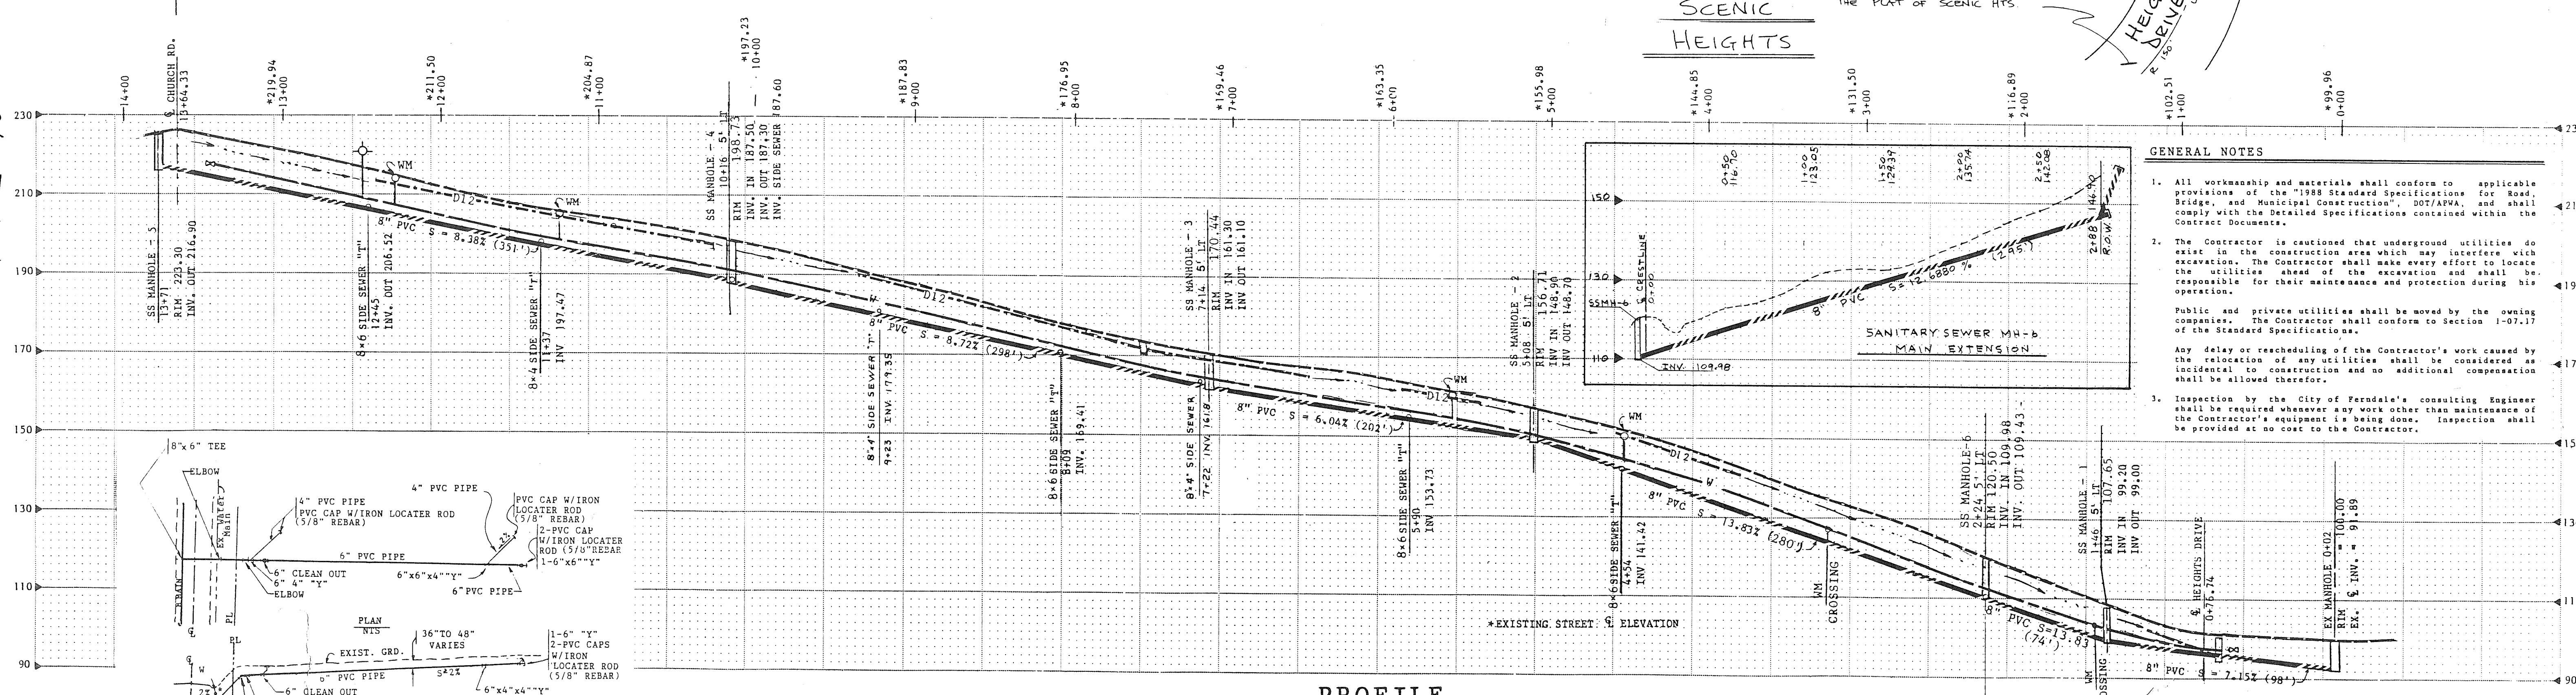

PROFILE

1"=50' (HORIZ)

1"=20' (VERT)

TYPICAL LATERAL SEWER DETAIL

RECORD DRAWING