
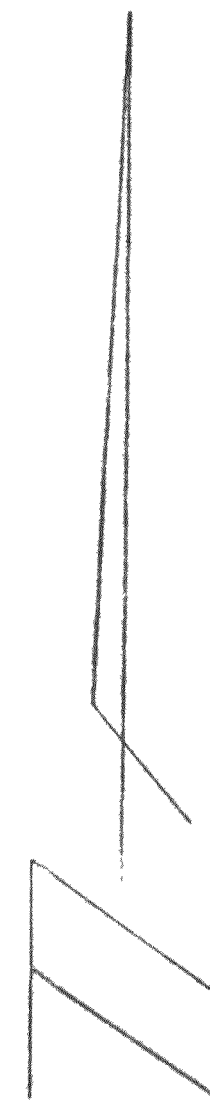


PLAN	SURVEYED	DATE
	NOTED	BY
NOTE BOOK	NOTED	DATE
	NOTED	BY

PROFILE	SURVEYED	DATE
	NOTED	BY
NOTE BOOK	NOTED	DATE
	NOTED	BY

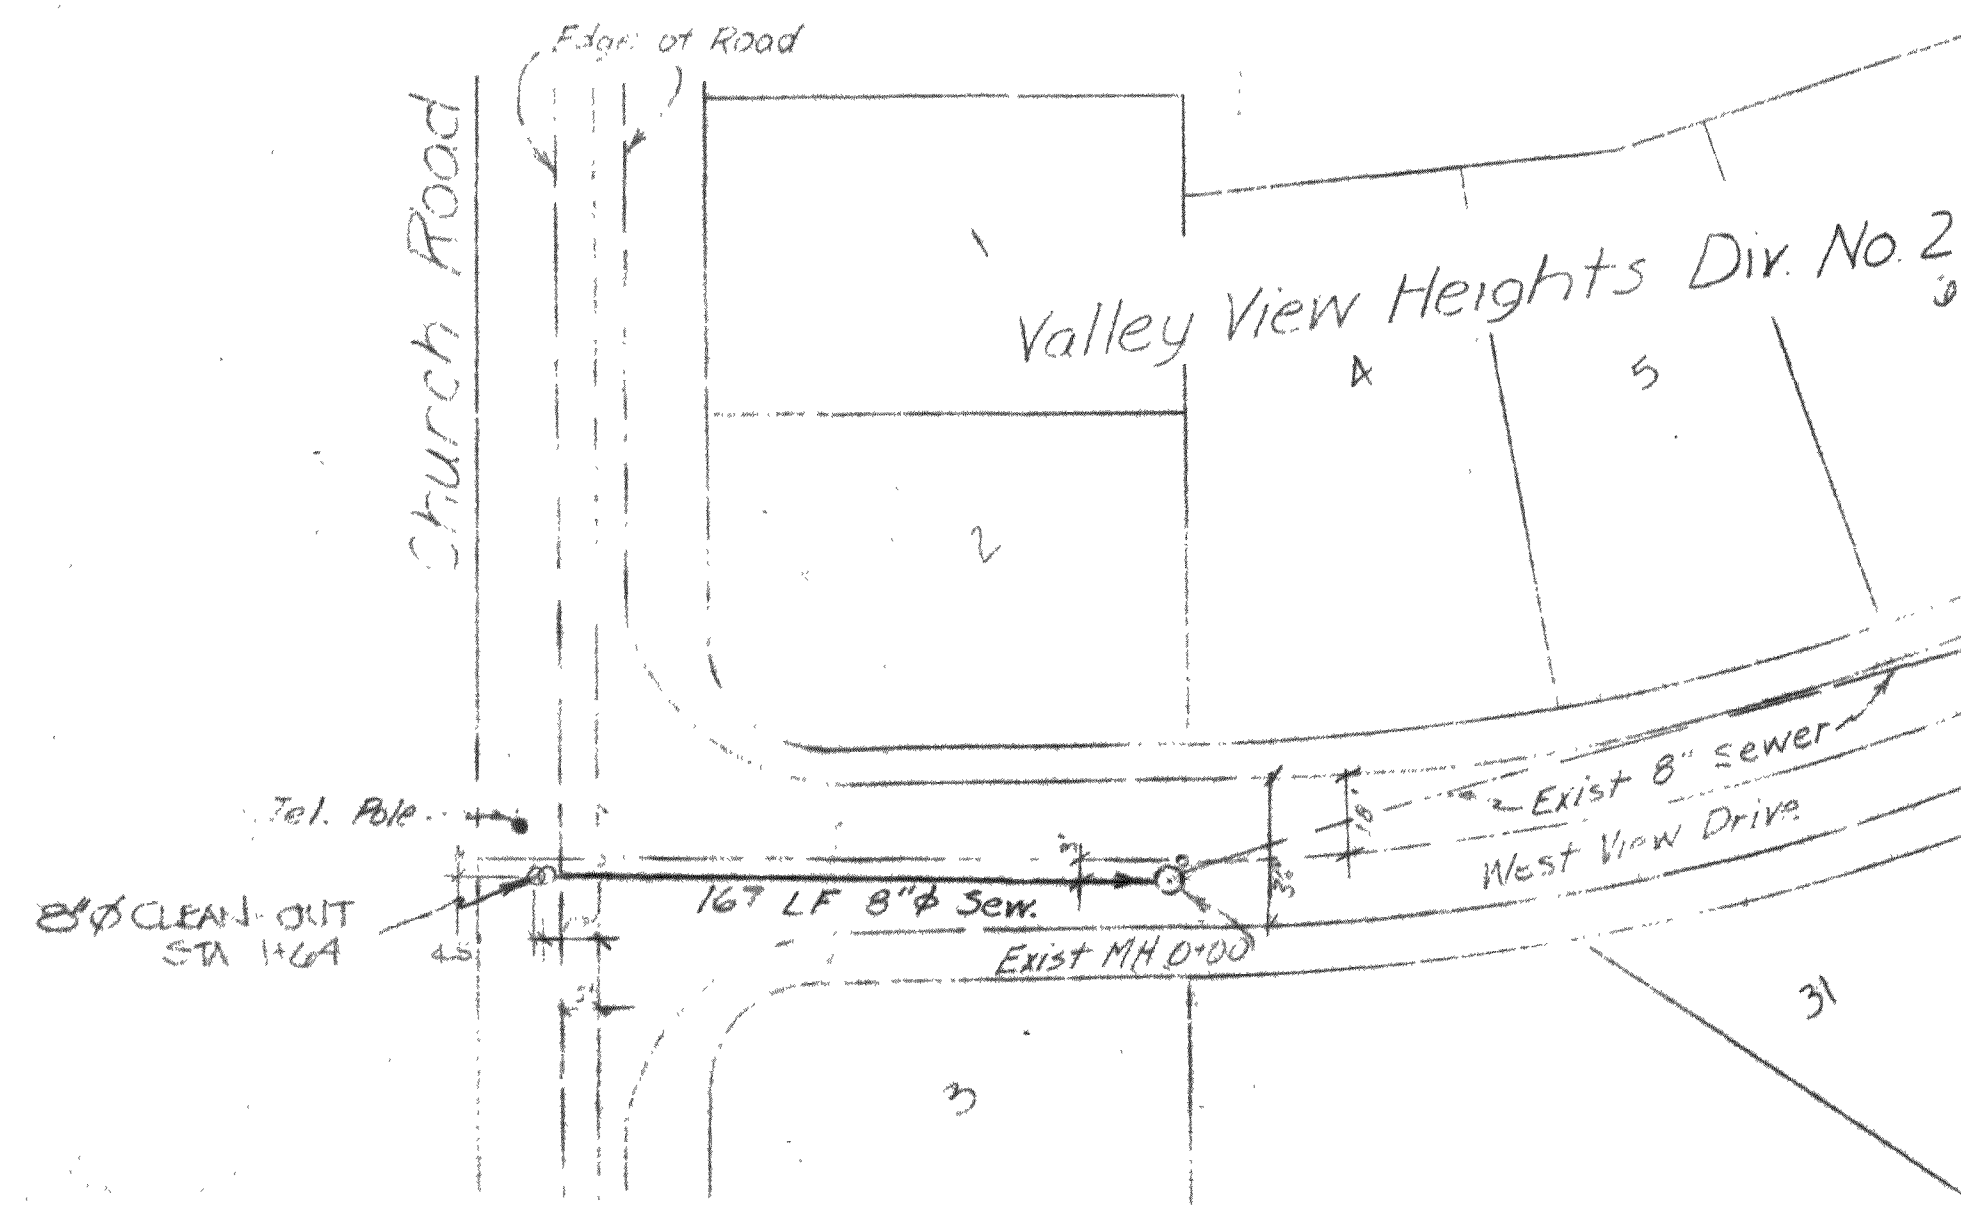


General Notes

1. All work and materials shall be in accordance with the APWA Standard Specifications, 1975 Edition, and shall be subject to the approval of the City Engineer.
2. The office of the City Engineer shall be contacted 24 hours prior to any construction.
3. Pipe shall conform with PSM-ASTM D 3034-74A standards.
4. Trench excavation and backfill shall be Class A in accordance to Section 61-2.01 of the Standard Specifications. Pipe bedding shall be in accordance with Section 61-3.03 D1.
5. Trench backfill shall be bank run gravel unless otherwise approved by the City Engineer. Trench compaction shall be 90% of maximum (at optimum moisture content) as determined by Modified Proctor Test. Top two feet shall be compacted to 95% of maximum.
6. Manholes shall be Type I-4B with offset cones. Manhole ring and cover shall be in accordance with Standard Plan No. 4-2.



W.C. FLINT	
Drawn: EN	Scale: 1" = 5'
Date: 6-7-78	Job No. 14478
FB#	Sheet 1 of 1
Harrison Surveyors 100 Central Ave. Bellingham, Washington Tel 734-1144	
Sewer Extension Plan & Profile	

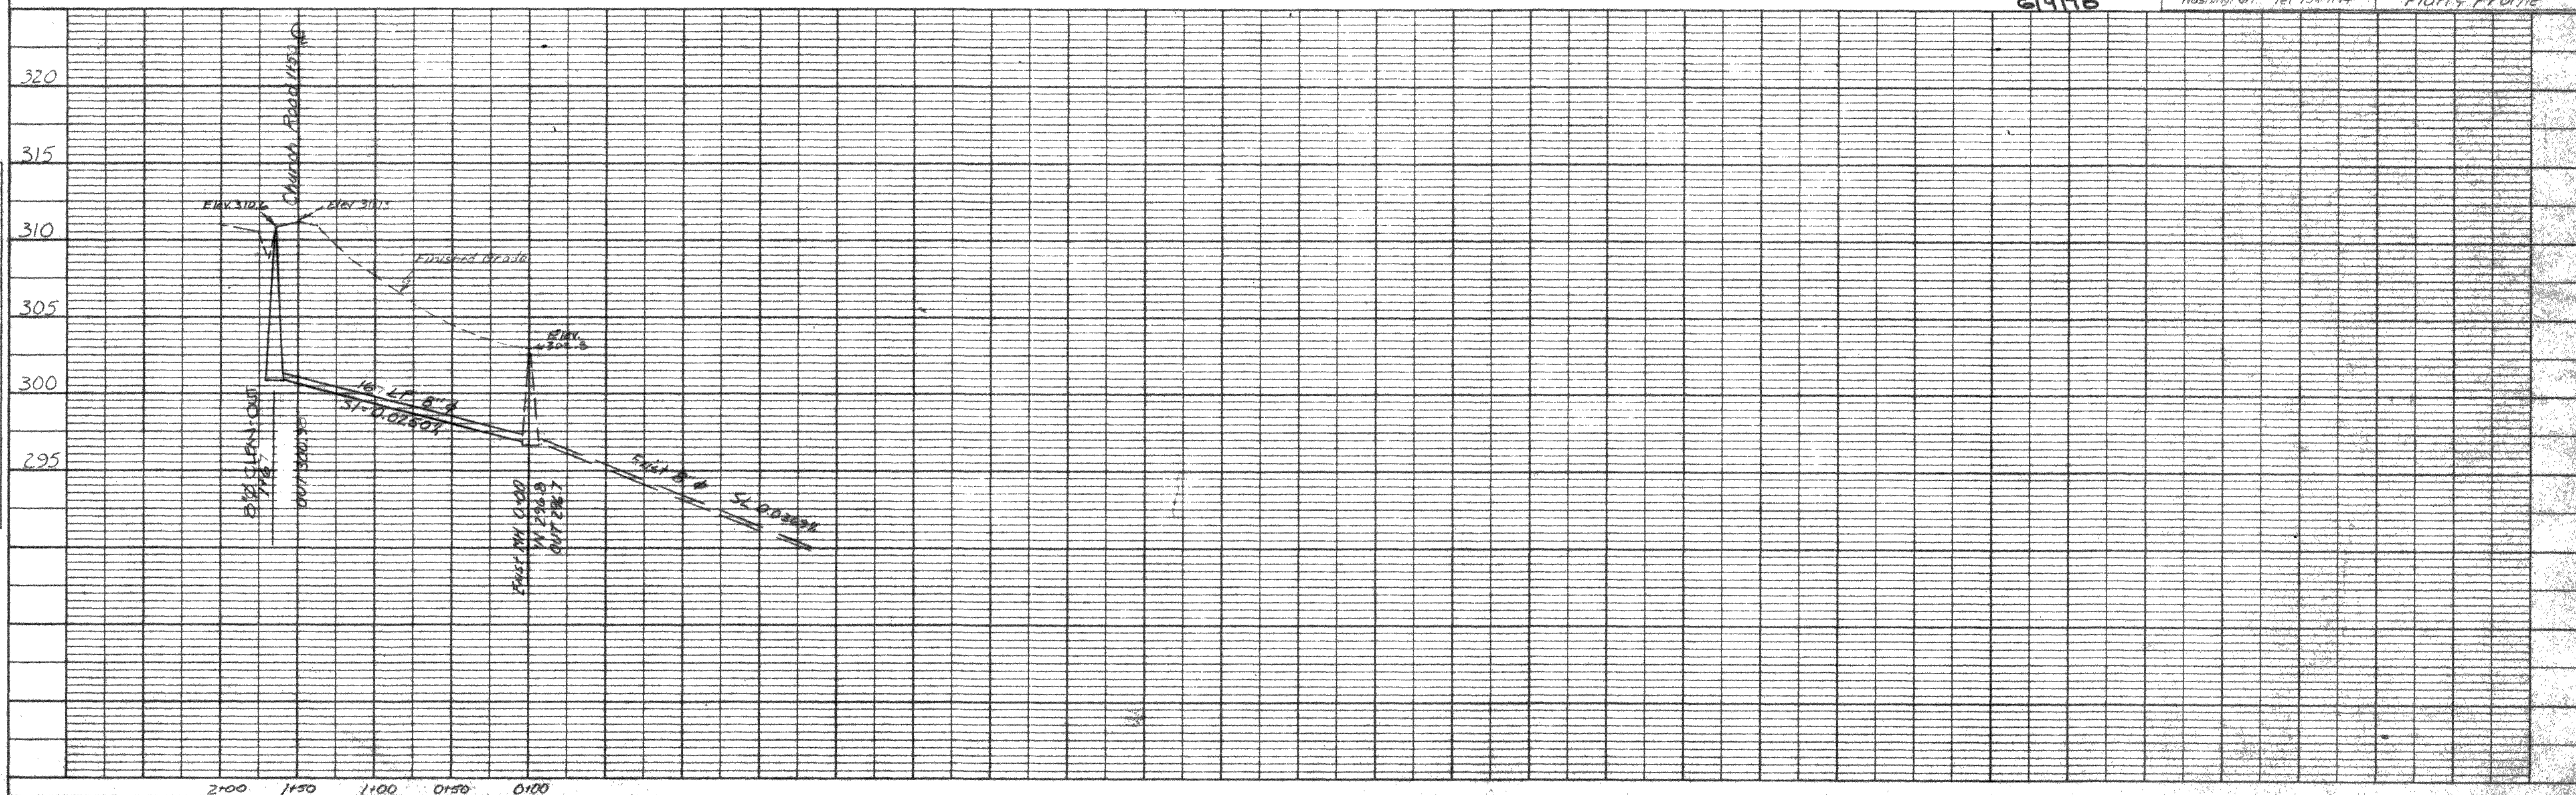

00244.001 2-16-04 RR