

CHURCH ROAD


STREET IMPROVEMENTS

CITY OF FERNDALE

FEDERAL AID NO. STPUS-8033(001) & TIB NO. 8-2-985(007)-1

VICINITY MAP

NTS

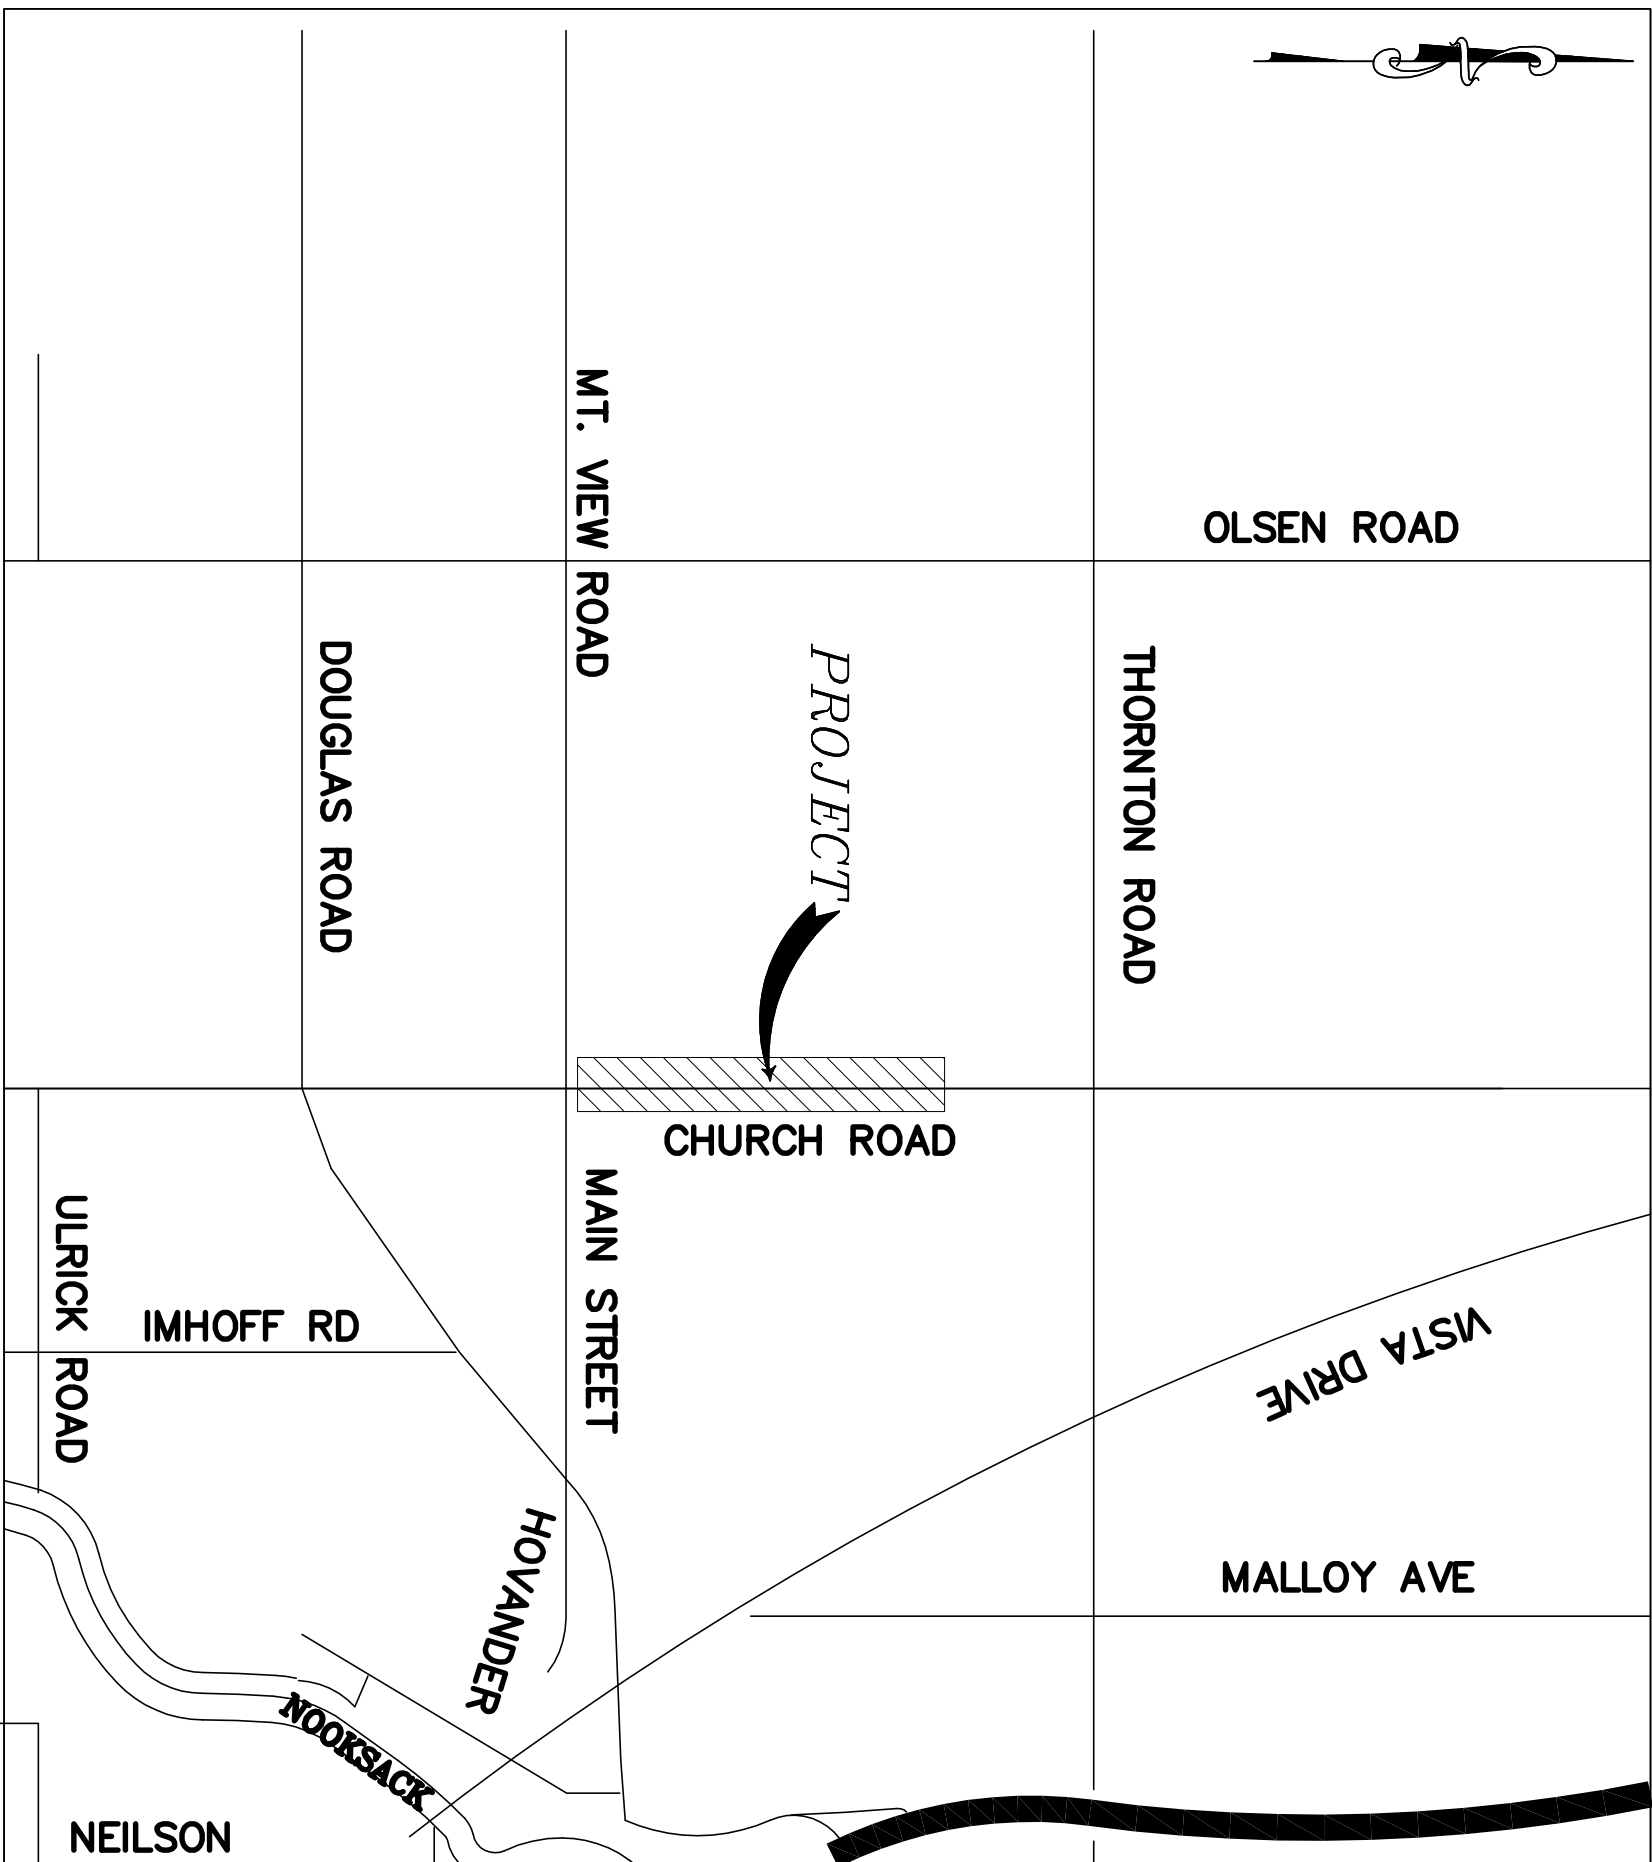

EXISTING

- BB = EX TOE OF BANK
- OHF = EX OVERHEAD POWER
- OHG = EXISTING OVERHEAD COMMUNICATIONS
- 95 = EX CONCRETE
- 95 = EX MINOR CONTOUR
- 95 = EX MAJOR CONTOUR
- 95 = EX DITCH CL
- X = EX FENCE
- FO = EX FIBER OPTICS LINE
- G = EX GAS MAIN
- G = EX GRAVEL
- PR = EX PROPERTY BOUNDARY
- PR = EX BURIED POWER LINE
- PR = EX ROAD CL
- PR = EX EDGE OF PAVEMENT
- PR = EX RIGHT OF WAY
- SD = EX STORM DRAIN
- SS = EX SANITARY SEWER
- SS = EX TRAFFIC STRIPING
- TB = EX TOP OF BANK
- T = EX BURIED TELEPHONE LINE
- TV = EX BURIED TV LINE
- W = EX WATER LINE
- W = EX SIDEWALK
- W = EX WETLANDS BOUNDARY
- W = EX EASEMENT
- W = EX GRADE BREAK
- W = EX FLOWLINE
- W = EX BUILDING
- W = EX CONCRETE
- W = EX CRUSHED SURFACING
- W = EX MONITORING WELL
- W = EX SOIL BORING LOCATION
- W = EX GUY WIRE
- W = EX SEWER CLEANOUT
- W = EX JBOX
- W = EX STREET LIGHT
- W = EX MAIL BOX
- W = EX WATER METER
- W = EX WATER SPIGOT
- W = EX WATER VALVE
- W = EX FIRE HYDRANT
- W = EX SEWER MANHOLE
- W = EX STORM DRAIN CATCH BASIN TYPE I
- W = EX STORM DRAIN CATCH BASIN TYPE II
- W = EX UTILITY POLE
- W = EX TRANSFORMER PAD
- W = EX SIGN
- W = EX POWER VAULT
- W = EX TELEPHONE PEDESTAL
- W = EX TREE STUMP
- W = EX TREE
- W = EX VEGETATION


LEGEND

PROPOSED

- BB = PROPOSED TOE OF BANK
- BB = PROPOSED CONDUIT
- TB = PROPOSED TOP OF BANK
- 95 = PROPOSED MAJOR CONTOUR
- 95 = PROPOSED MINOR CONTOUR
- 95 = PROPOSED FENCE
- 95 = PROPOSED CONSTRUCTION EASEMENT
- 95 = PROPOSED GRADE BREAK
- 95 = PROPOSED GRAVEL
- 95 = PROPOSED PATH
- 95 = PROPOSED TRAFFIC STRIPE
- 95 = PROPOSED CONC. WALL
- 95 = PROPOSED MODULAR BLOCK WALL
- 95 = PROPOSED BACK OF CURB
- 95 = PROPOSED ROAD CL
- 95 = PROPOSED ROAD EDGE OF PAVEMENT
- 95 = PROPOSED ROAD FACE OF CURB
- 95 = PROPOSED ROAD UP OF GUTTER
- 95 = PROPOSED SANICUT
- 95 = PROPOSED STORM DRAIN
- 95 = PROPOSED SILT FENCE
- 95 = PROPOSED SANITARY SEWER
- 95 = PROPOSED WATERMAIN
- 95 = PROPOSED SIDEWALK
- 95 = PROPOSED PAVEMENT VALLEY
- 95 = PROPOSED ASPHALT APRON
- 95 = PROPOSED CONC. SIDEWALK / DRIVEWAY
- 95 = PROPOSED CRUSHED SURFACING
- 95 = PROPOSED STORM DRAIN CATCH BASIN TYPE I
- 95 = PROPOSED STORM DRAIN CATCH BASIN TYPE II
- 95 = PROPOSED STORM DRAIN INLET
- 95 = PROPOSED SANITARY SEWER MANHOLE
- 95 = PROPOSED SANITARY SEWER CLEAN OUT
- 95 = PROPOSED HYDRANT
- 95 = PROPOSED WATER METER
- 95 = PROPOSED WATER VALVE
- 95 = PROPOSED COUPLER
- 95 = PROPOSED SIGN
- 95 = FLOW ARROW
- 95 = PROPOSED TREE


SHEET INDEX

1. COVER SHEET	26. WATER PLAN	55. CROSS SECTIONS
2. EXISTING CONDITIONS STA 1+00 TO 6+50	27. WATER PLAN	56. CROSS SECTIONS
3. EXISTING CONDITIONS STA 6+50 TO 12+00	28. STREET IMPROVEMENTS - STORM STA 1+00 TO 6+50	57. CROSS SECTIONS
4. EXISTING CONDITIONS STA 12+00 TO 17+50	29. STREET IMPROVEMENTS - STORM STA 6+50 TO 12+00	58. CROSS SECTIONS
5. EXISTING CONDITIONS STA 17+50 TO 23+50	30. STREET IMPROVEMENTS - STORM STA 12+00 TO 17+50	59. DETAIL SHEET
6. EXISTING CONDITIONS STA 23+50 TO 29+00	31. STREET IMPROVEMENTS - STORM STA 17+50 TO 23+50	60. DETAIL SHEET
7. EXISTING CONDITIONS STA 29+00 TO 35+00	32. STREET IMPROVEMENTS - STORM STA 23+50 TO 29+00	61. DETAIL SHEET
8. EXISTING CONDITIONS STA 35+00 TO 37+66	33. STREET IMPROVEMENTS - STORM STA 29+00 TO 35+00	62. DETAIL SHEET
9. TRAFFIC CONTROL PLAN	34. STREET IMPROVEMENTS - STORM STA 35+00 TO 39+00	63. DETAIL SHEET
10. TESC PLAN	35. INTERSECTION PROFILES	64. TYPICAL SECTIONS
11. TESC PLAN	36. DRIVEWAY PROFILES	
12. TESC PLAN	37. DRIVEWAY PROFILES	
13. TESC PLAN	38. WALL PLAN AND PROFILE	
14. DEMOLITION PLAN	39. WALL PLAN AND PROFILE	
15. DEMOLITION PLAN	40. GRADING PLAN	
16. DEMOLITION PLAN	41. GRADING PLAN	
17. DEMOLITION PLAN	42. GRADING PLAN	
18. SEWER PLAN & PROFILE - SEWER STA 1+00 TO 6+50	43. GRADING PLAN	
19. SEWER PLAN & PROFILE - SEWER STA 6+50 TO 12+00	44. CHANNELIZATION PLAN	
20. STREET IMPROVEMENTS - SEWER STA 12+00 TO 17+50	45. CHANNELIZATION PLAN	
21. STREET IMPROVEMENTS - SEWER STA 17+50 TO 23+50	46. CHANNELIZATION PLAN	
22. STREET IMPROVEMENTS - SEWER STA 23+50 TO 29+00	47. CROSS SECTIONS	
23. STREET IMPROVEMENTS - SEWER STA 29+00 TO 35+00	48. CROSS SECTIONS	
24. STREET IMPROVEMENTS - SEWER STA 35+00 TO 39+00	49. CROSS SECTIONS	
25. WATER PLAN	50. CROSS SECTIONS	
	51. CROSS SECTIONS	
	52. CROSS SECTIONS	
	53. CROSS SECTIONS	
	54. CROSS SECTIONS	

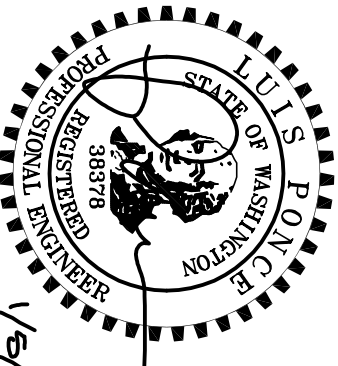

1/05/17
AS-BUILT

DESIGNED BY
LP / GKG
DRAWN BY
LMC
CHECKED BY
LP

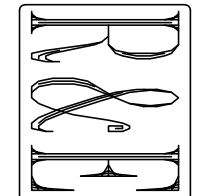



REICHHARDT & EBE
ENGINEERING, INC.
CONSULTING ENGINEERS
PO Box 978 423 Front St., Ste 201
Lynden, Washington 98264
Ph (360) 354-3887
Fax (360) 354-0407

NO.	DATE	REVISION


CITY OF FERNDALE
2095 MAIN STREET
FERNDAL, WA 98248

CHURCH ROAD
STREET IMPROVEMENTS
COVER SHEET

JOB# / DWG 07037	COVER	DATE 1-5-17
SCALE H: 1" / 4' V: 1" / 4'		SHEET 1 of 64

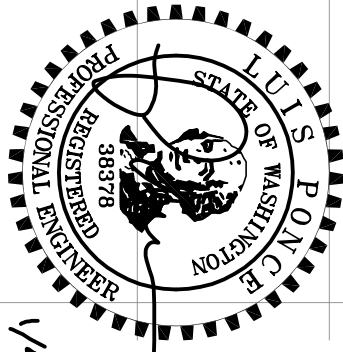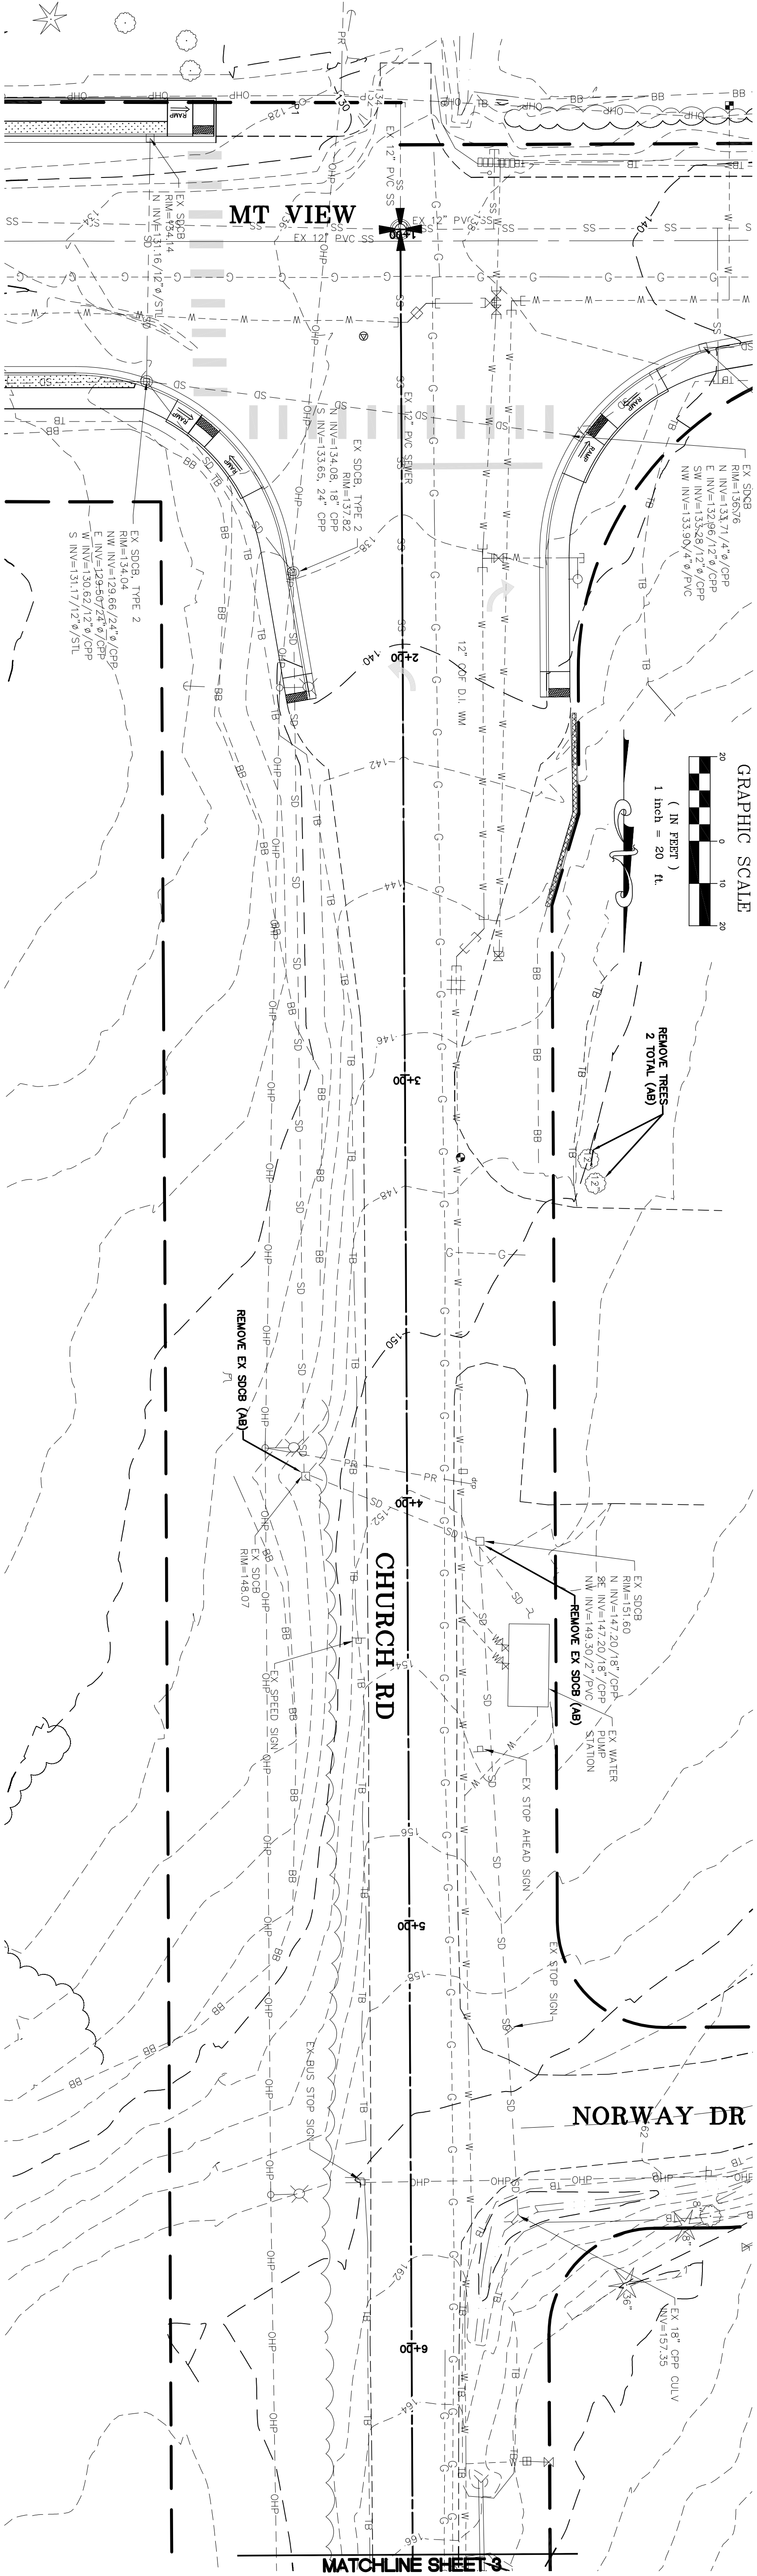


1/6/17

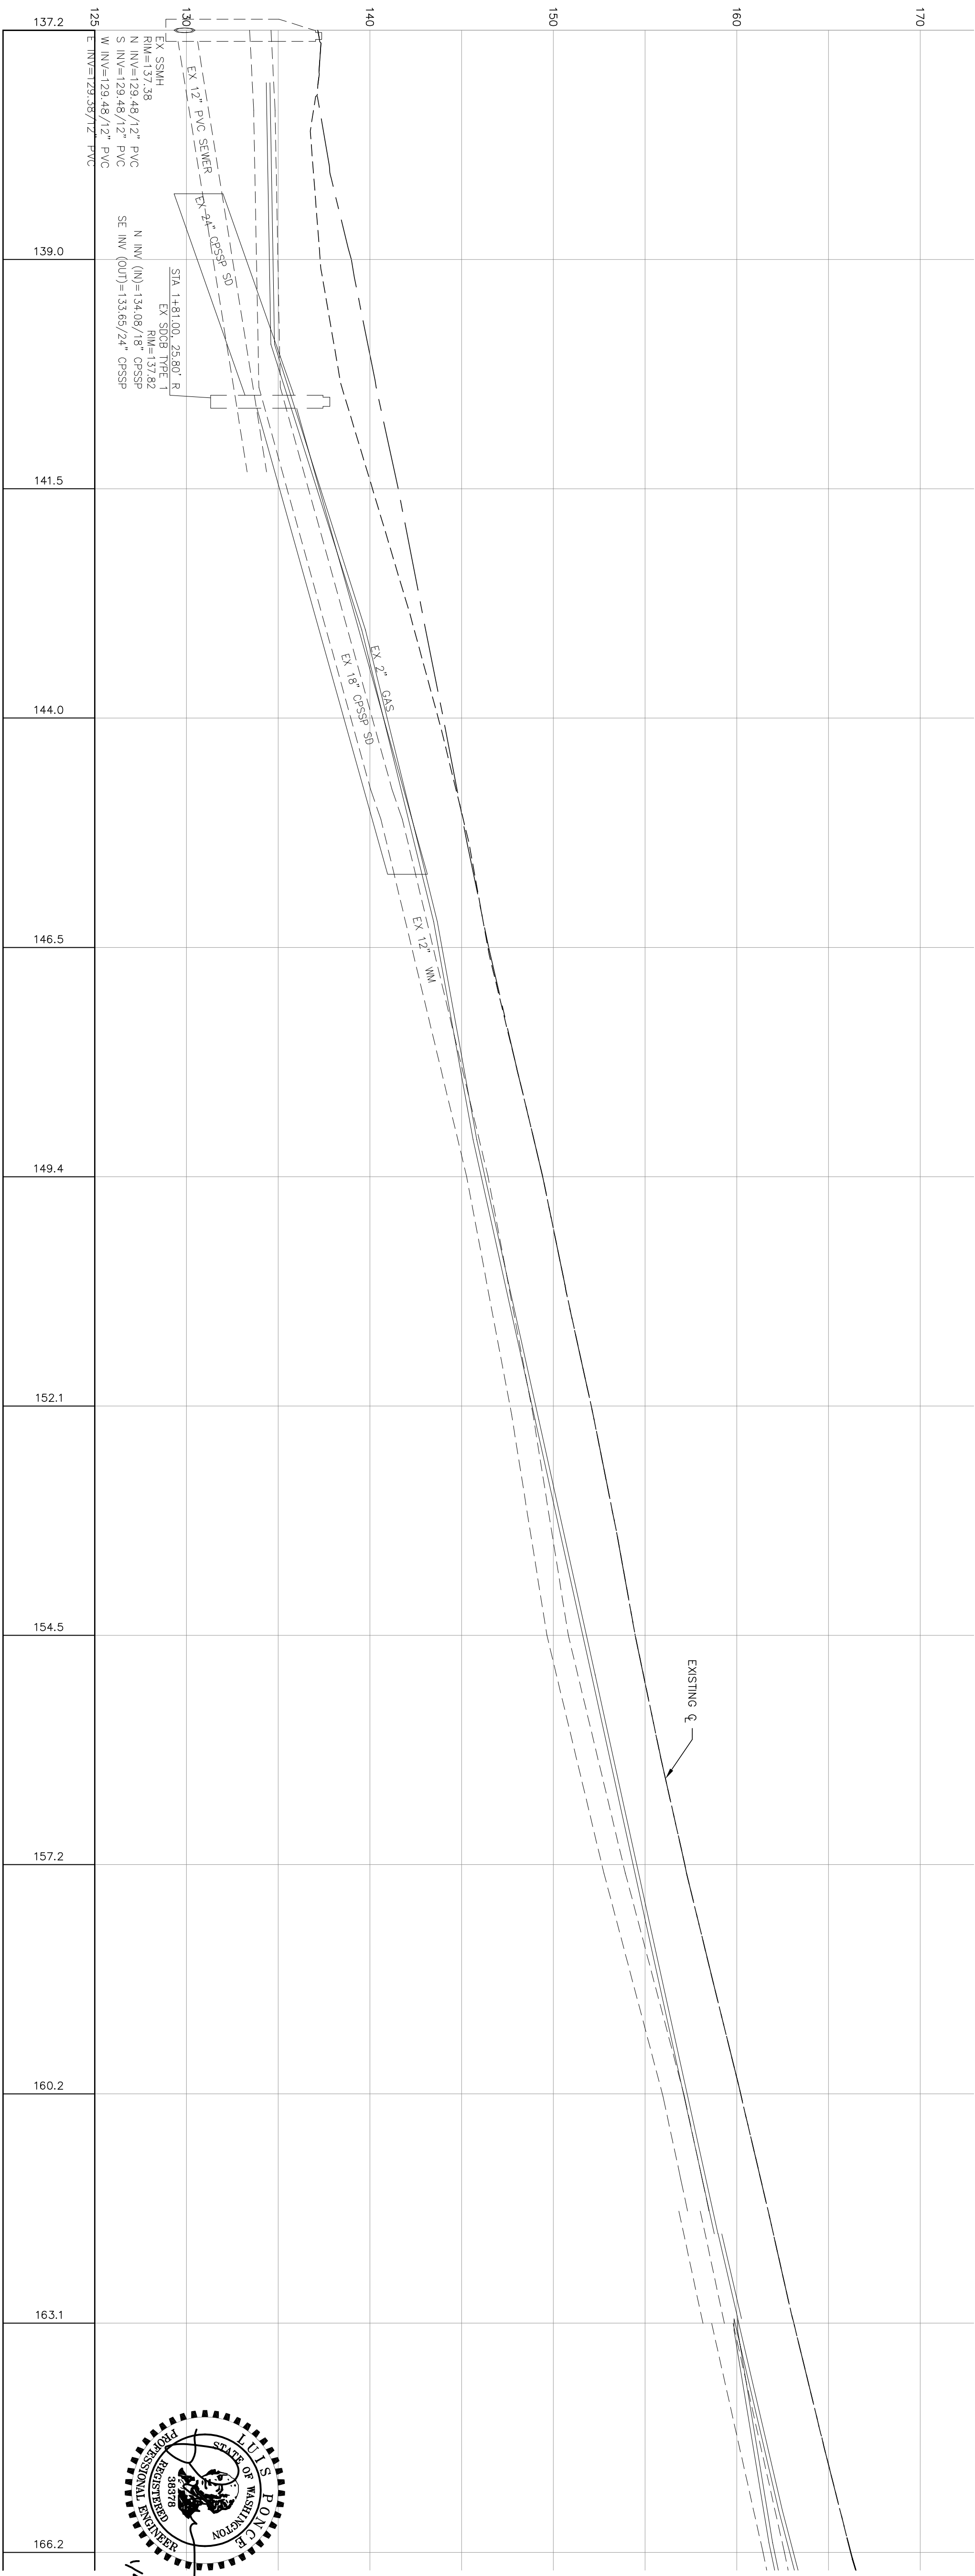

1/05/17
AS-BUILT

DESIGNED BY
LP /CKG
DRAWN BY
LMC
CHECKED BY
LP

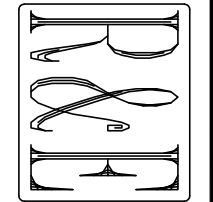




REICHHARDT & EBE
ENGINEERING, INC.
CONSULTING ENGINEERS
PO Box 978 423 Front St., Ste 201
Lynden, Washington 98264
Ph (360) 354-3687
Fax (360) 354-0407

NO.	DATE	REVISION	BY

CITY OF FERNDALE
2095 MAIN STREET
FERNDAL, WA 98248


CHURCH ROAD
STREET IMPROVEMENTS
EXISTING CONDITIONS - 1+00 TO 6+50

JOB# / DWG
07037 EX COND
SCALE
H: 1" = 20' V: 1" = 5'
DATE
1-5-17
SHEET
2 of 64

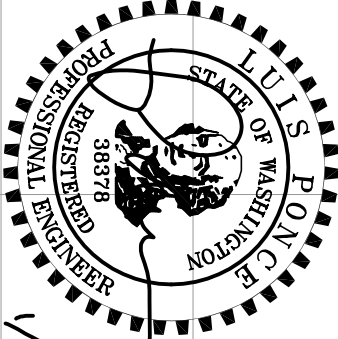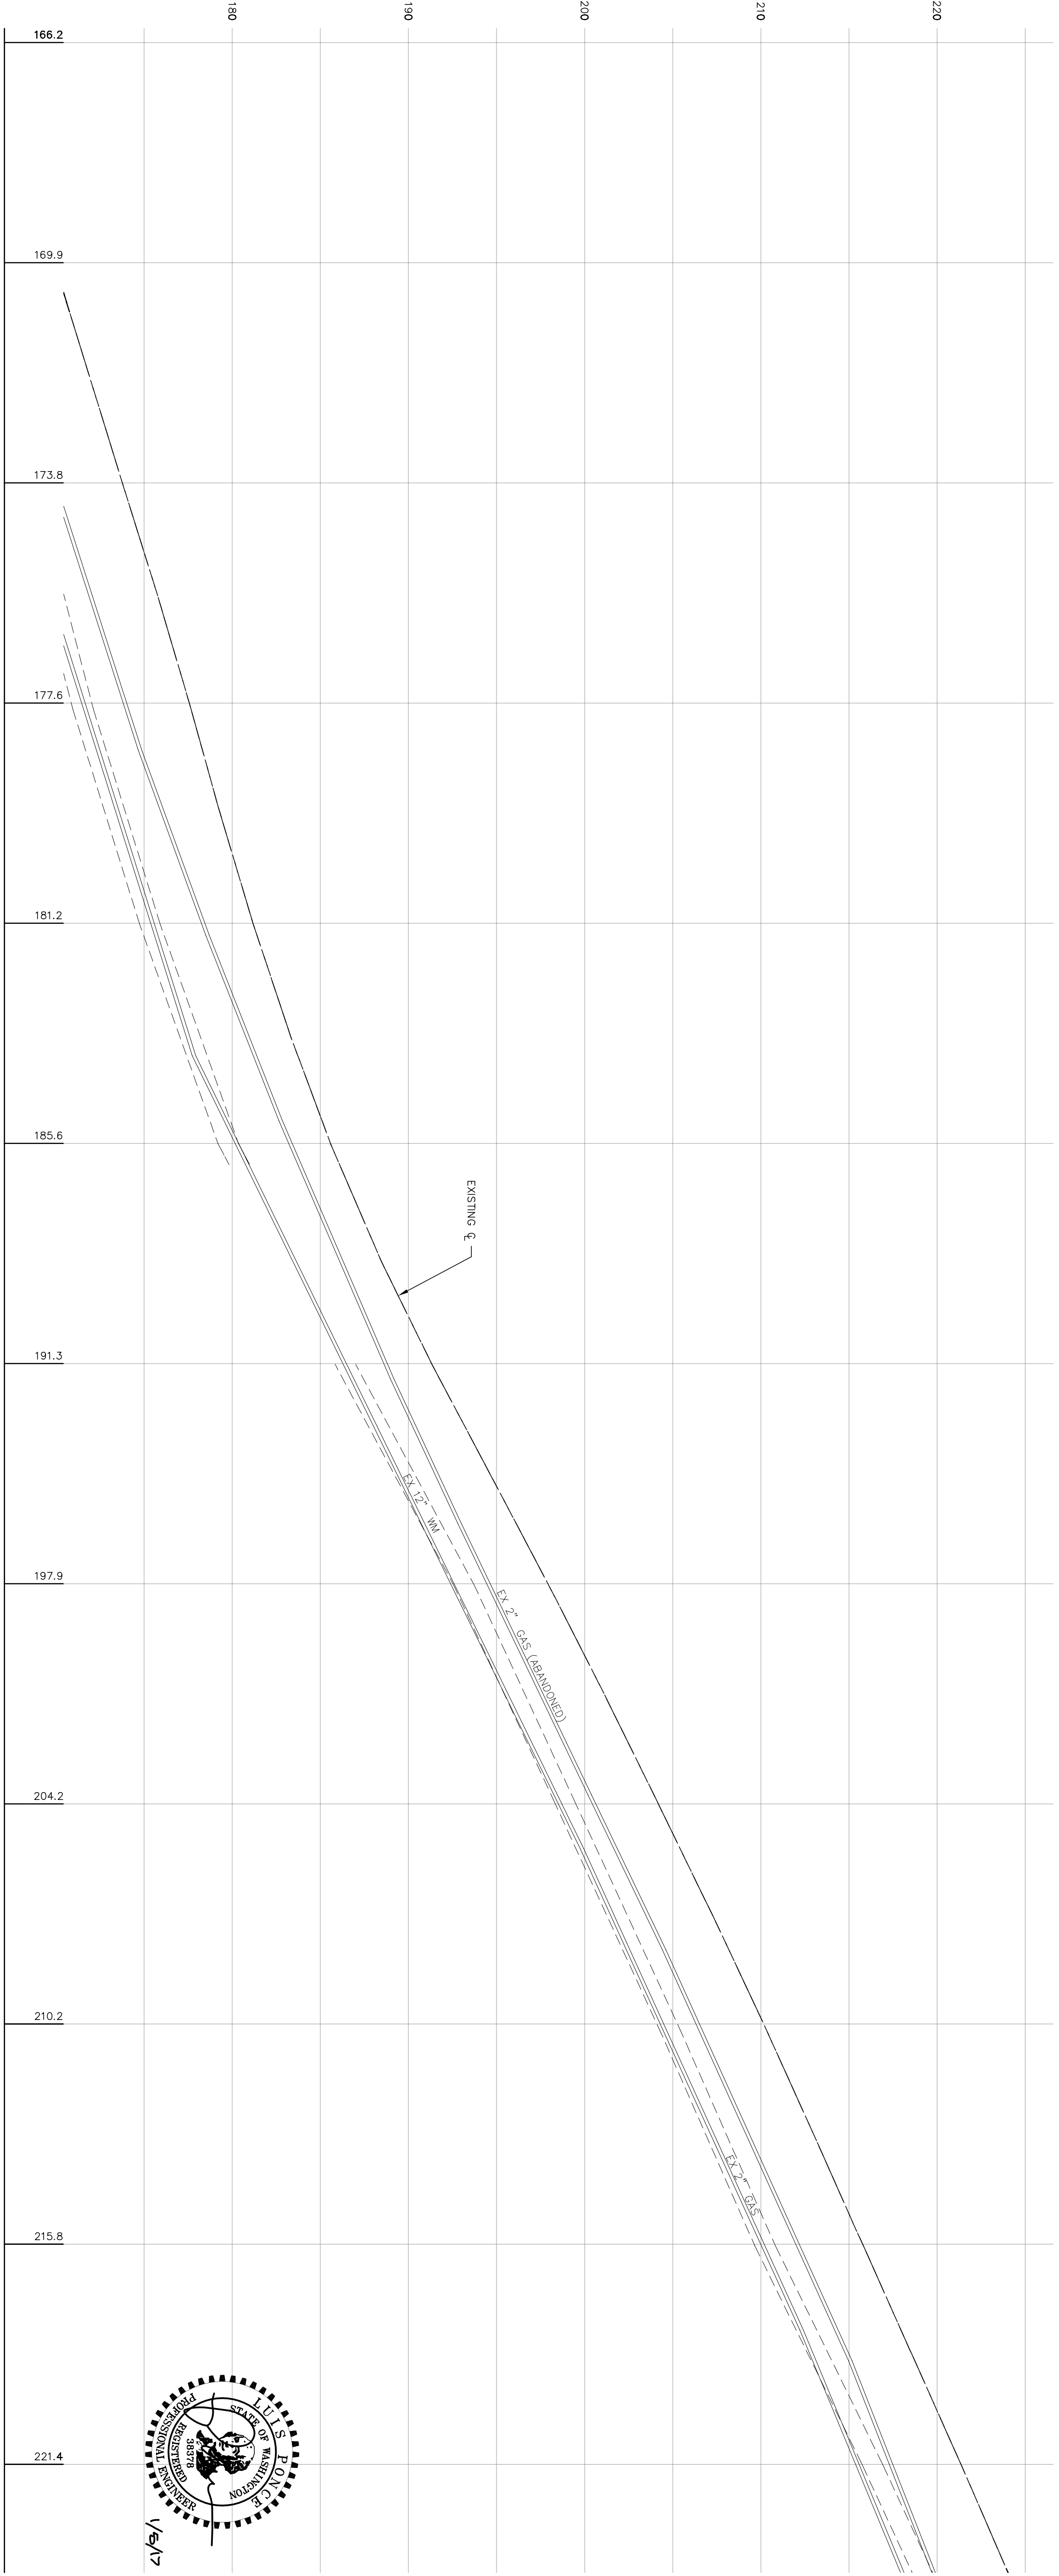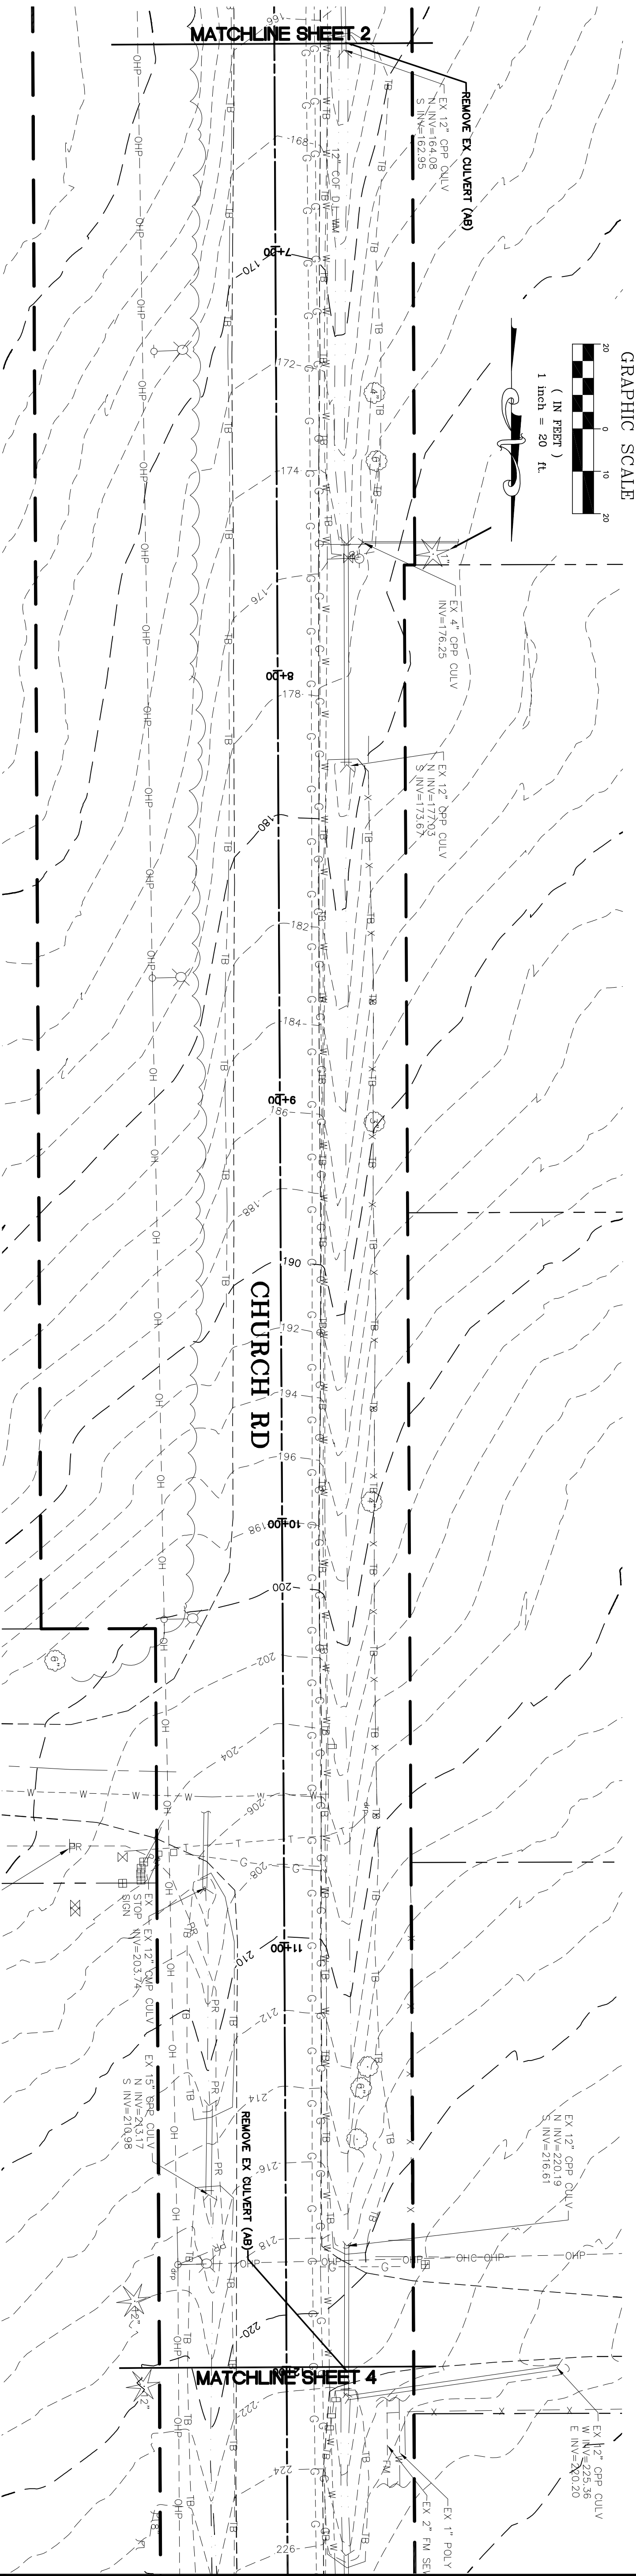

1/05/17
AS-BUILT

DESIGNED BY
LP/GKG
DRAWN BY
LMC
CHECKED BY
LP

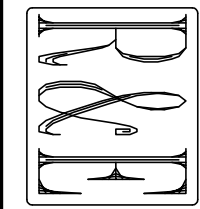

REICHHARDT & EBE
ENGINEERING, INC.
CONSULTING ENGINEERS
PO Box 978 423 Front St., Ste 201
Lynden, Washington 98264
Ph (360) 354-3687
Fax (360) 354-0407

NO. DATE

REVISION



BY

CITY OF FERNDALE
2095 MAIN STREET
FERNDAL, WA 98248


CHURCH ROAD
STREET IMPROVEMENTS
EXISTING CONDITIONS - 6+50 TO 12+00

JOB# / DWG
07037 EX COND
SCALE
H: 1" = 20'
V: 1" = 5'

DATE
1-5-17
SHEET
3 of 64

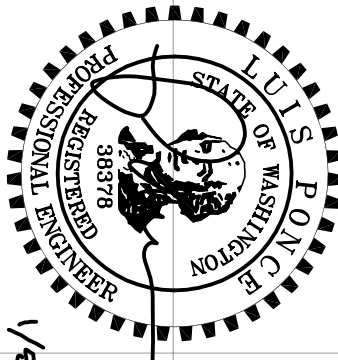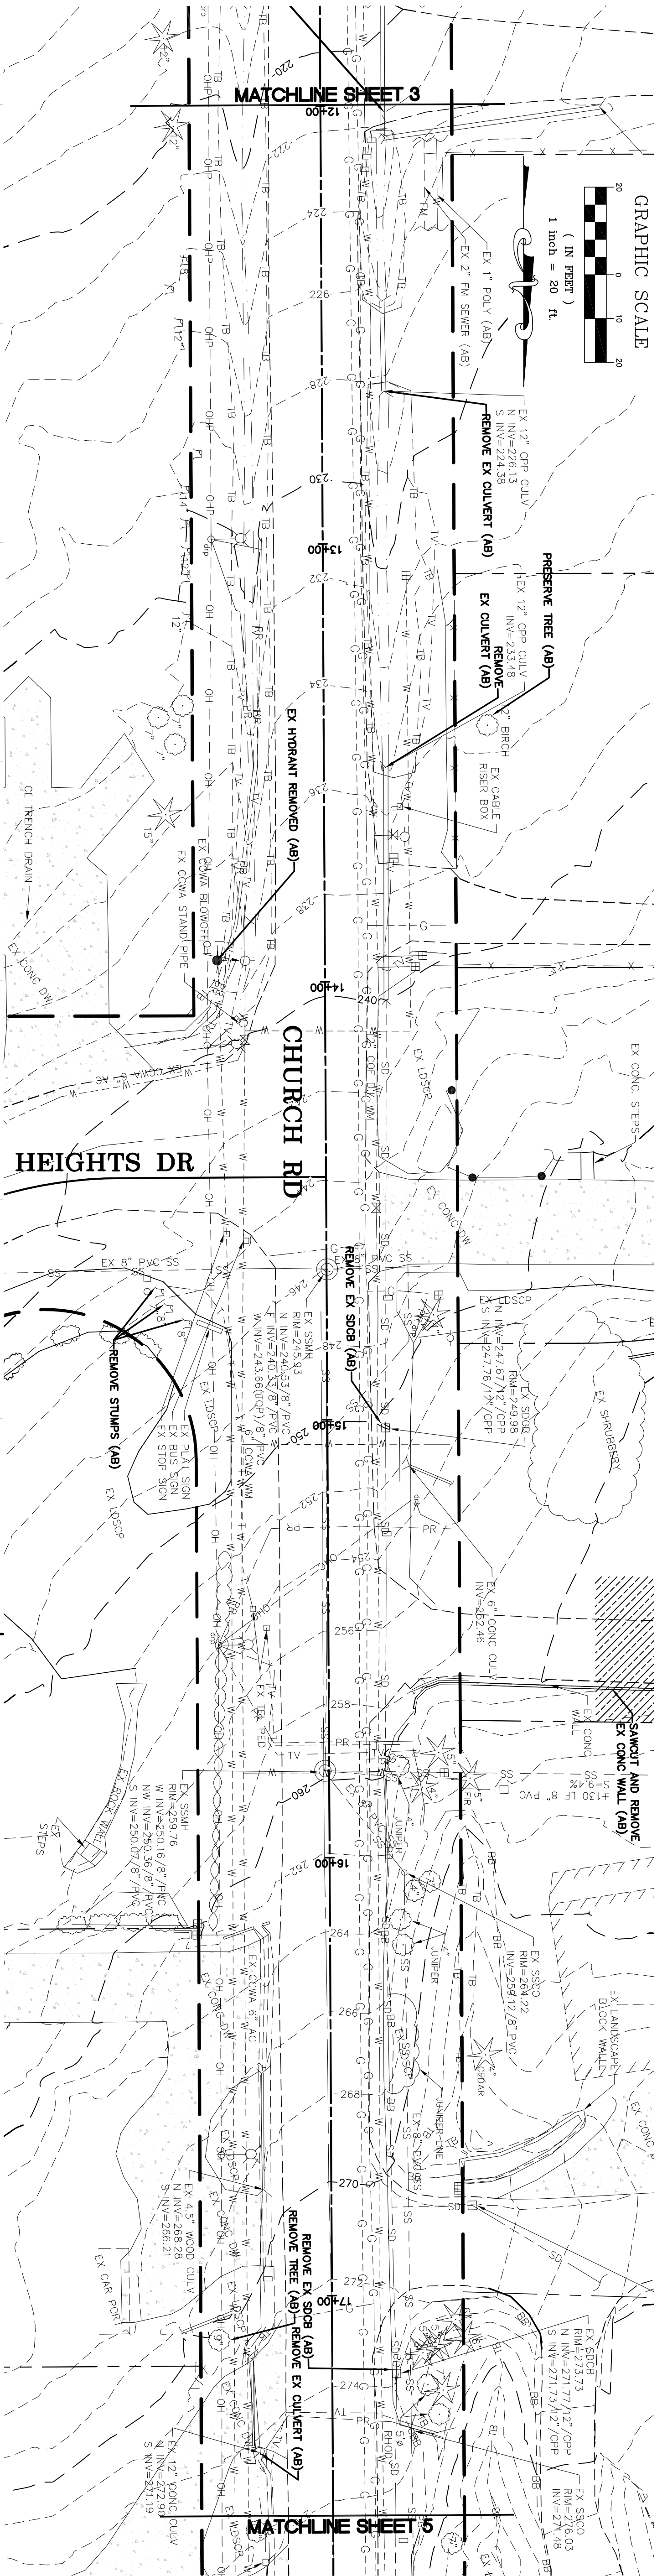


1/05/17		DESIGNED BY LP/GKG		DRAWN BY LMC		CHECKED BY LP		REICHARDT & EBE ENGINEERING, INC. CONSULTING ENGINEERS PO Box 978 423 Front St., Ste 201 Lynden, Washington 98264 Ph (360) 354-3687 Fax (360) 354-0407		NO.		DATE		REVISION		BY		CITY OF FERNDALE 2095 MAIN STREET FERNDAL, WA 98248		CHURCH ROAD STREET IMPROVEMENTS EXISTING CONDITIONS - 12+00 TO 17+50		JOB# / DWG 07037 EX COND		SCALE H: 1" = 20' V: 1" = 5'		DATE 1-5-17		SHEET 4 of 64	
---------	--	-----------------------	--	-----------------	--	------------------	--	--	--	-----	--	------	--	----------	--	----	--	---	--	--	--	-----------------------------	--	---------------------------------	--	----------------	--	------------------	--

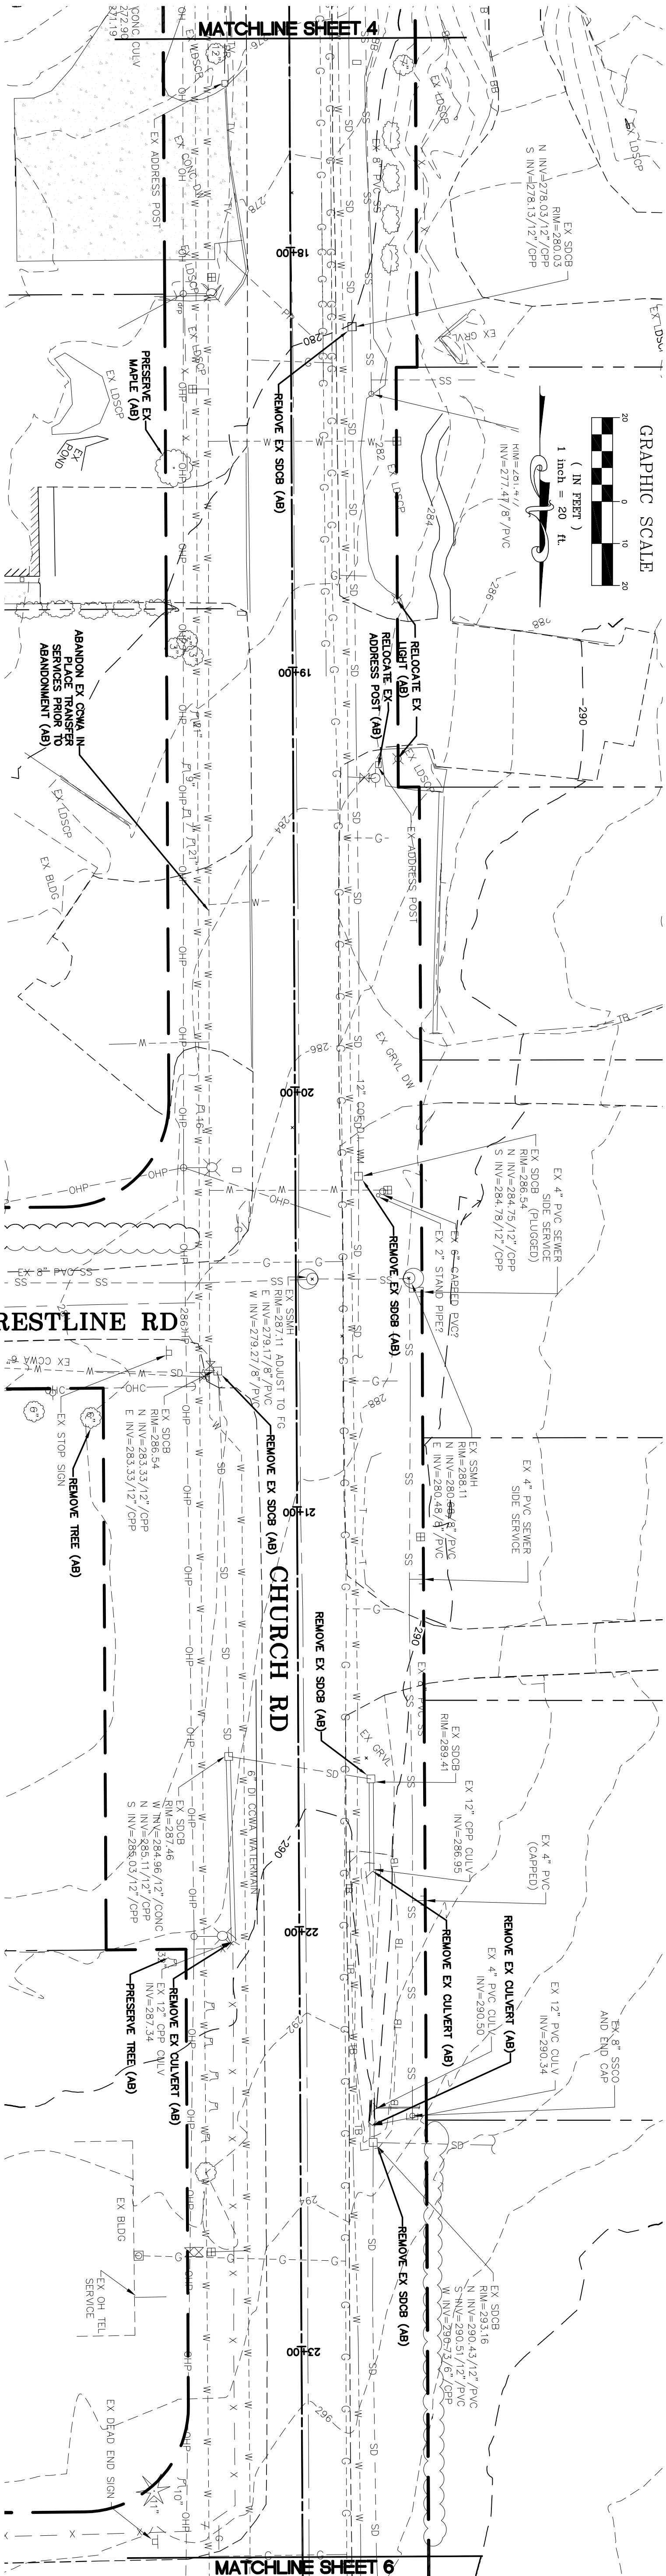

1/05/17
AS-BUILT

DESIGNED BY
LP/GKG
DRAWN BY
LMC
CHECKED BY
LP

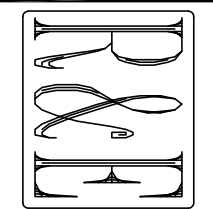

REICHHARDT & EBE
ENGINEERING, INC.
CONSULTING ENGINEERS
PO Box 978 423 Front St., Ste 201
Lynden, Washington 98264
Ph (360) 354-3687
Fax (360) 354-0407

NO. DATE

REVISION

BY


CITY OF FERNDALE
2095 MAIN STREET
FERNDAL, WA 98248

CHURCH ROAD
STREET IMPROVEMENTS
EXISTING CONDITIONS - 17+50 TO 23+50

JOB# / DWG
07037 EX COND


SCALE
H: 1" = 20'
V: 1" = 5'

DATE
1-5-17
SHEET
5 of 64

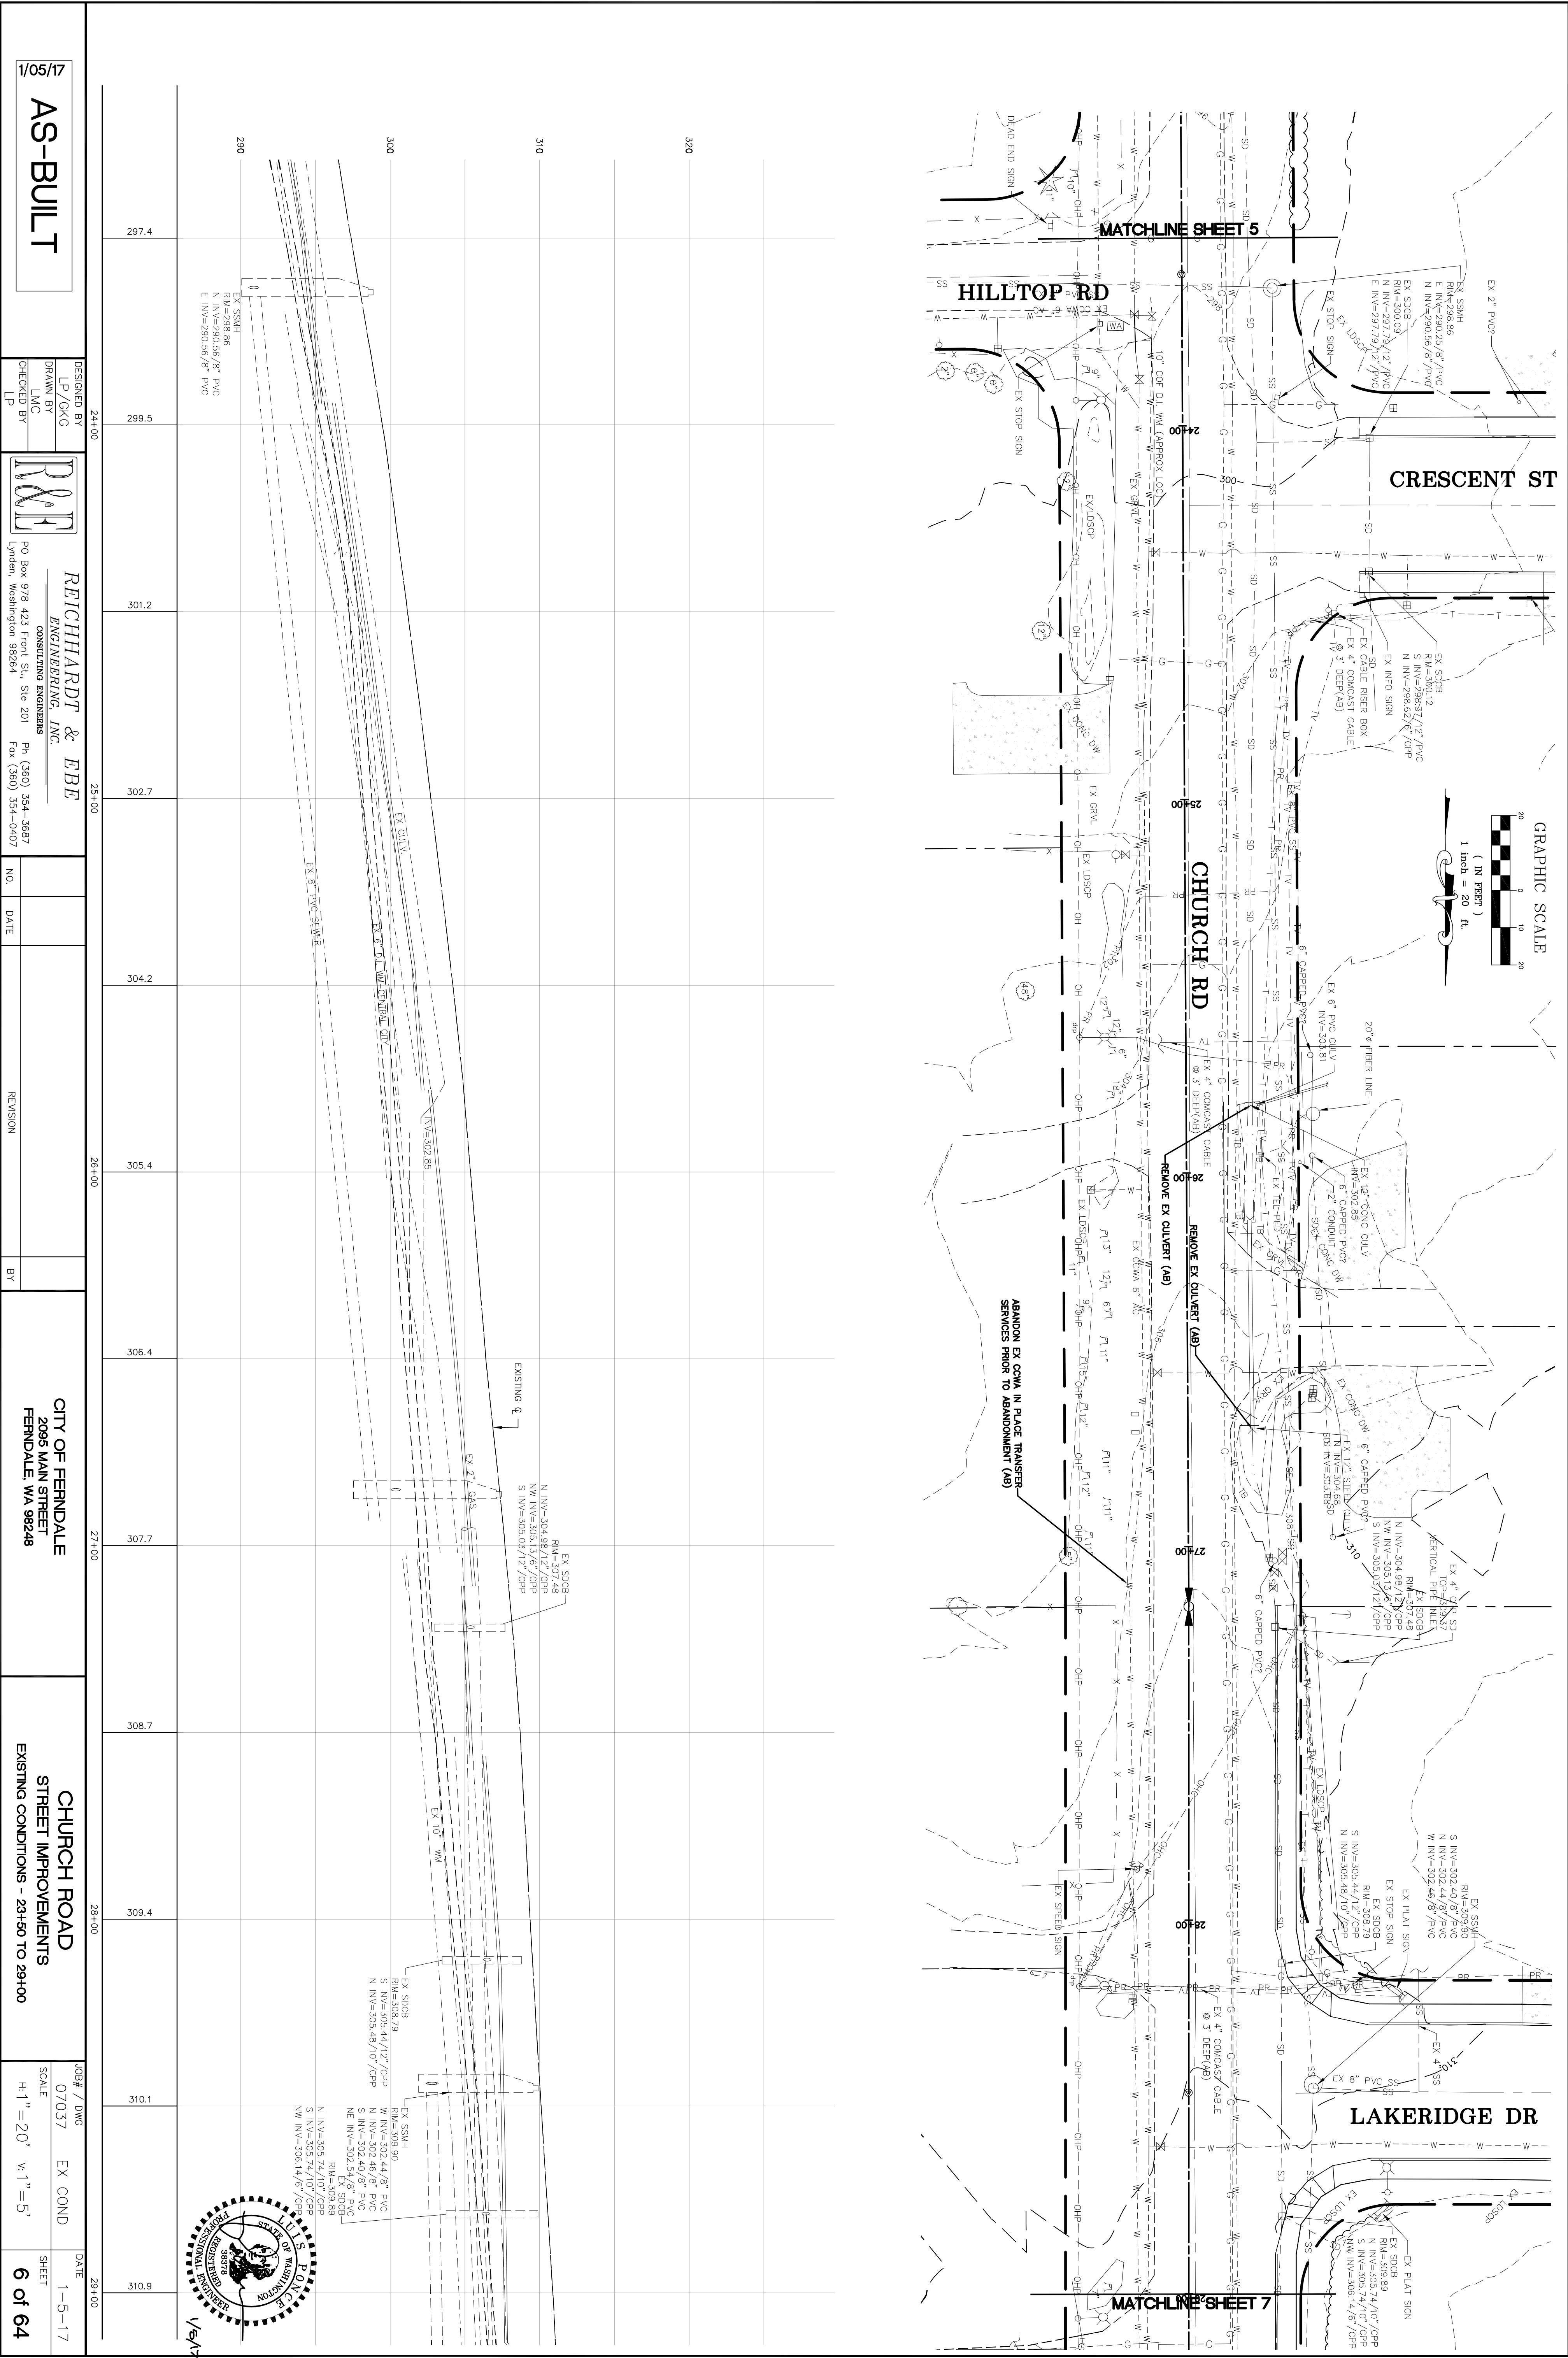

1/05/17
AS-BUILT

DESIGNED BY
LP /CKG
DRAWN BY
LMC
CHECKED BY
LP

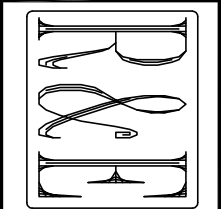



REICHHARDT & EBE
ENGINEERING, INC.
CONSULTING ENGINEERS
PO Box 978 423 Front St., Ste 201
Lynden, Washington 98264
Ph (360) 354-3687
Fax (360) 354-0407


NO.	DATE	REVISION

CITY OF FERNDALE
2095 MAIN STREET
FERNDALE, WA 98248

CHURCH ROAD
STREET IMPROVEMENTS
EXISTING CONDITIONS - 35+00 TO 37+66

JOB# / DWG
07037 EX COND
SCALE
H: 1" = 20' V: 1" = 5'
DATE
1-5-17
SHEET
8 of 64

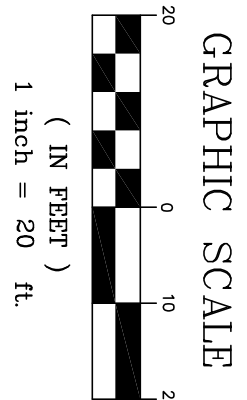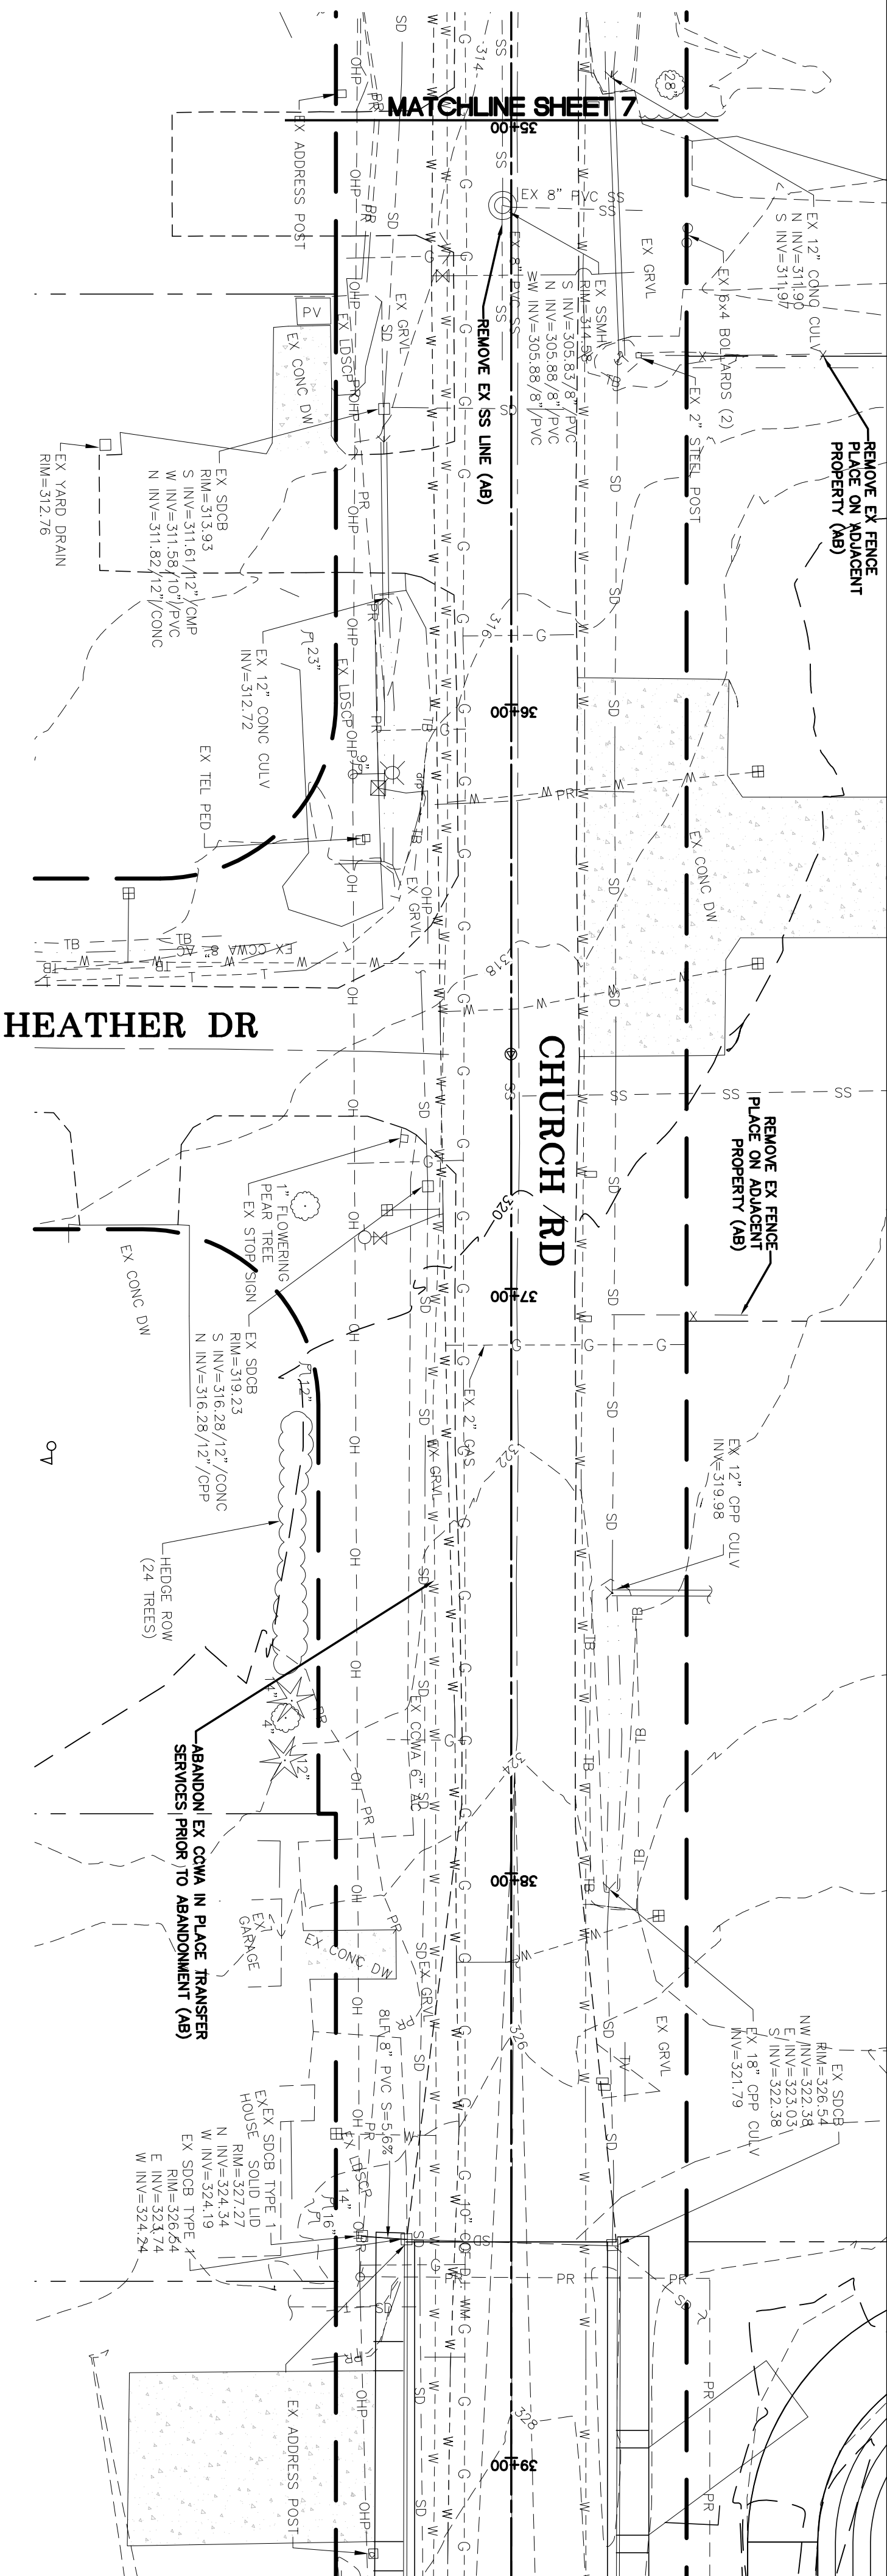

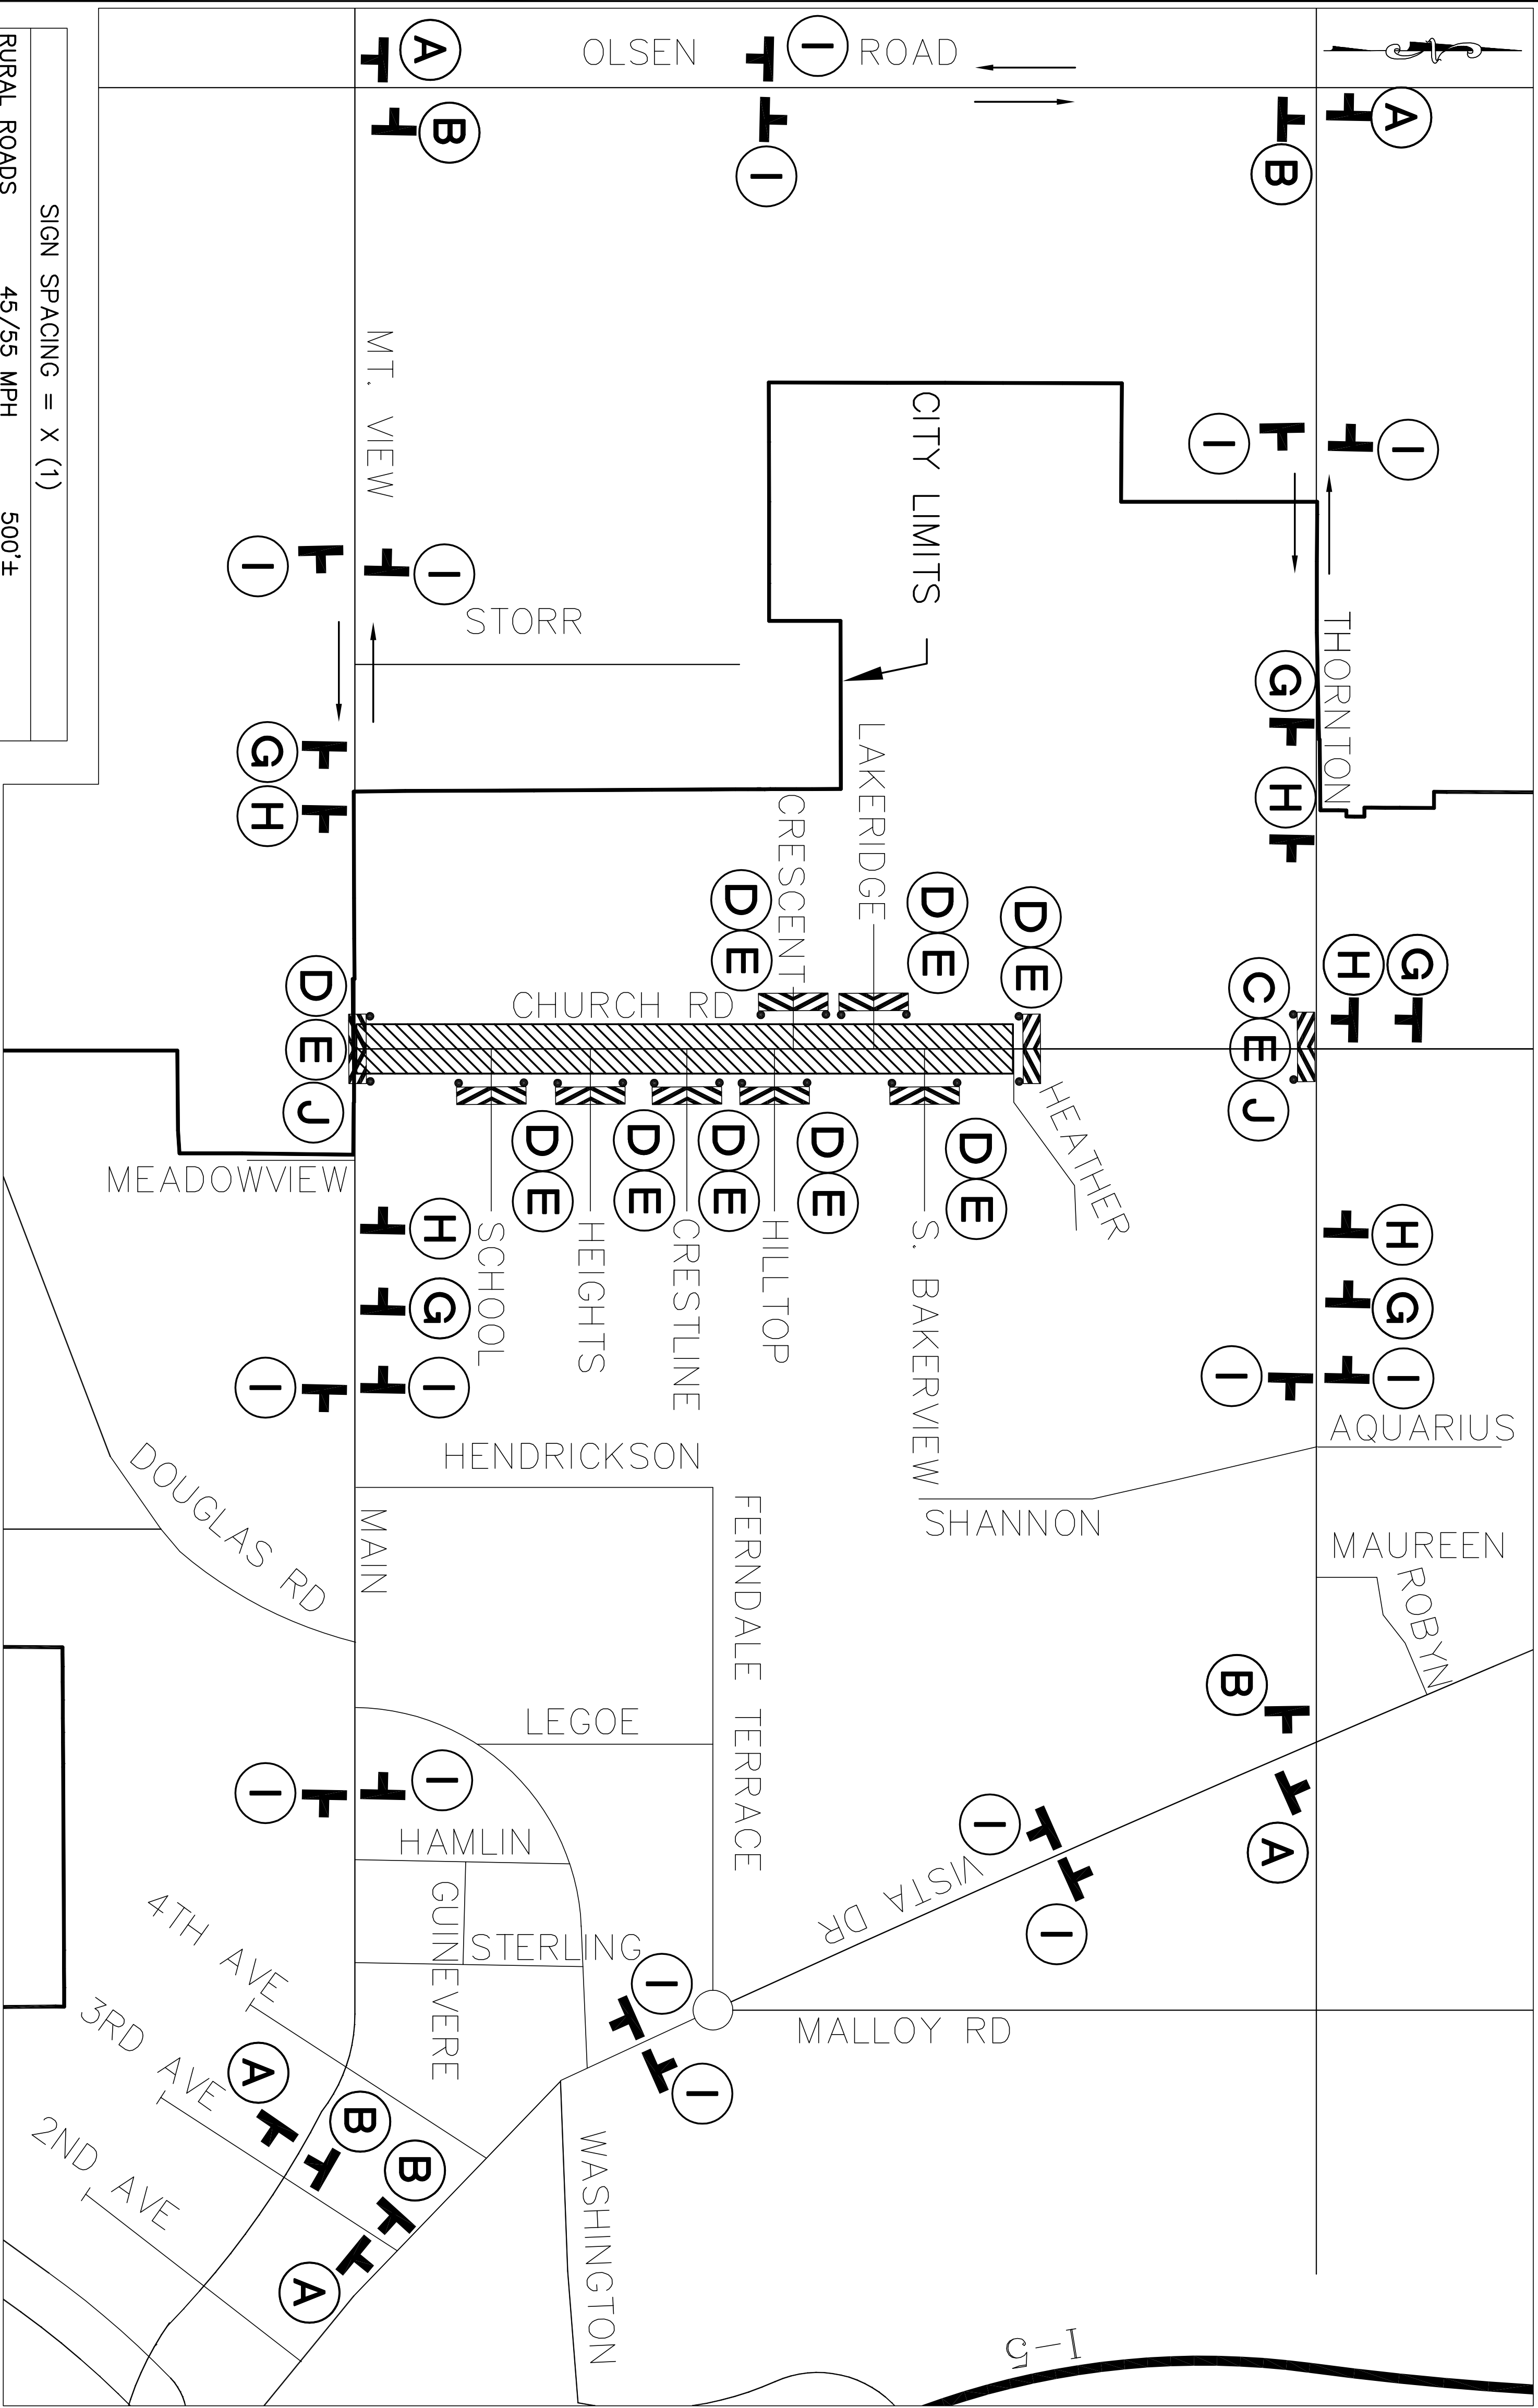

SIGN SPACING = X (1)		
RURAL ROADS	45/55 MPH	500'±
URBAN ARTERIALS & RURAL ROADS	35/40 MPH	350'±
RURAL ROADS, URBAN ARTERIALS, RESIDENTIAL & BUSINESS DISTRICTS	25/30 MPH	200'± (2)
URBAN STREETS	25 MPH OR LESS	100'± (2)
ALL SIGNS ARE BLACK ON ORANGE UNLESS DESIGNATED OTHERWISE		

(1) ALL SPACING MAY BE ADJUSTED TO ACCOMMODATE AT-GRADE INTERSECTIONS AND DRIVEWAYS.
(2) THIS SIGN SPACING MAY BE REDUCED IN URBAN AREAS TO FIT ROADWAY CONDITIONS.

SUBMITTED WITH

DESIGN PLAN

DESIGNED BY

DRAWN BY

CHECKED BY

LP

CMS

CMS

CMS

REICHHARDT & EBE
ENGINEERING, INC.
CONSULTING ENGINEERS
Ph (360) 354-3687
Fax (360) 354-0407
Po Box 978 423 Front St., Ste 201
Lynden, Washington 98264

NO.

DATE


REVISION

BY

CITY OF FERNDALE
2095 MAIN STREET
FERNDALE, WA 98248

CHURCH ROAD
STREET IMPROVEMENTS
TRAFFIC CONTROL PLAN

JOB# / DWG
AB 07037 TRAFFIC-CONST.DWG-5-17
SCALE
H:1/4" / V:1/4" / DATE
SHEET
9 of 64

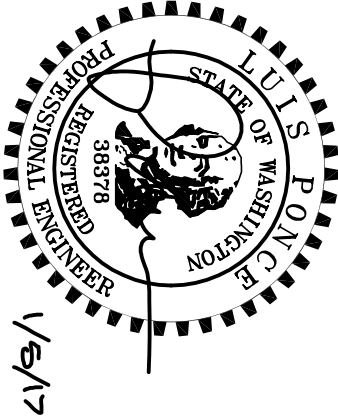

LEGEND

= DIRECTION OF TRAFFIC

= SIGN (SHOWN FACING LEFT)

= PROPOSED WORK AREA

A

M4-10L

B

M4-10R

C

R 11-3

D

R 11-4

E

TYPE III R AND TYPE III L, BARRICADE WITH 2 TYPE A FLASHING WARNING LIGHTS

F

M4-8A

G

W 20-3

H


W20-2

I

M4-8

J

M6-4

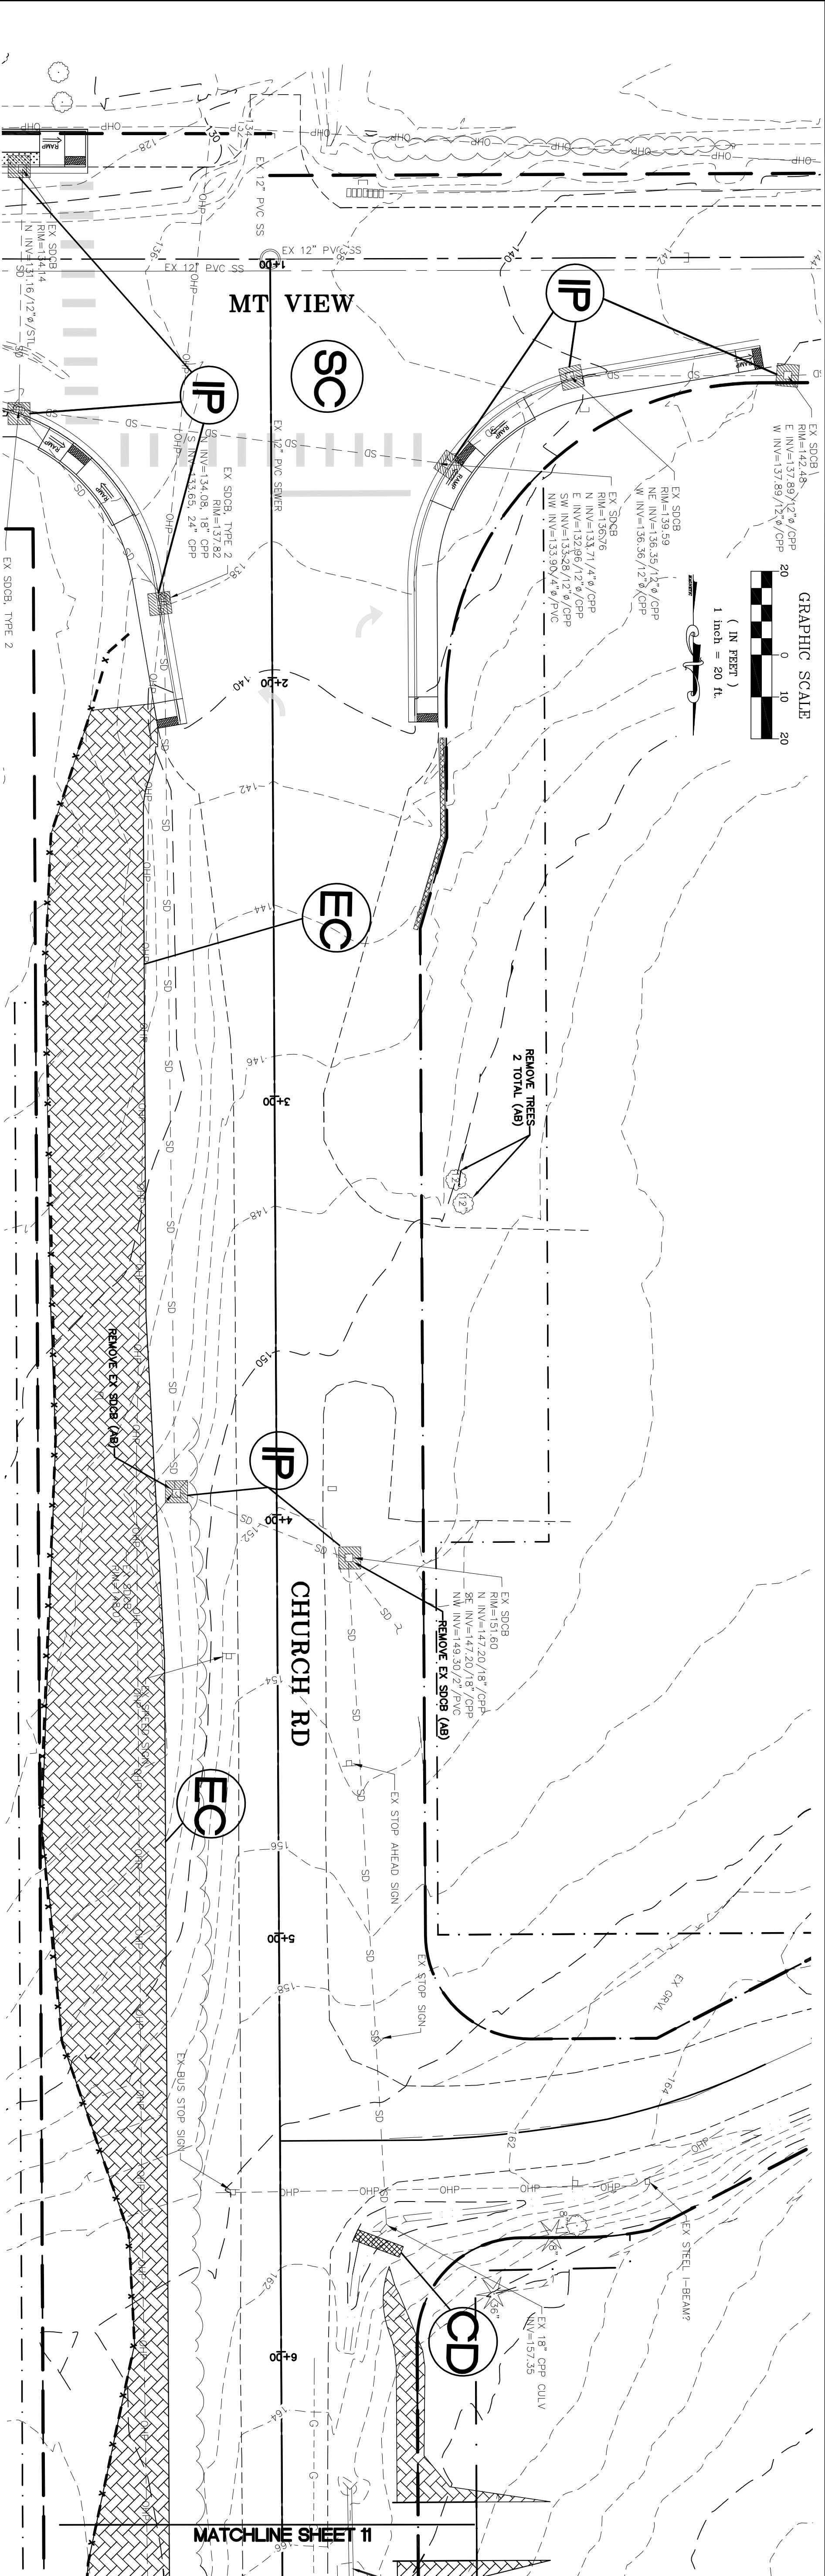

LEGEND

WASHINGTON STATE DEPT. OF ECOLOGY
BEST MANAGEMENT PRACTICES (BMP)
REF.: STORMWATER MANAGEMENT MANUAL
FOR WESTERN WASHINGTON, 2005



BMP E2.10 STABILIZED CONSTRUCTION
ENTRANCE AND TREE WASH
SEE DETAIL THIS SHEET



BMP E3.10 FILTER FENCE – SEE DETAIL THIS SHEET



BMP E3.30 INLET PROTECTION – PLACE SEDIMENT
FILTER AROUND OR OVER CATCH BASINS




PROPOSED EROSION CONTROL BLANKET



GEOTEXTILE ENCASED CHECK DAM



STREET CLEANING

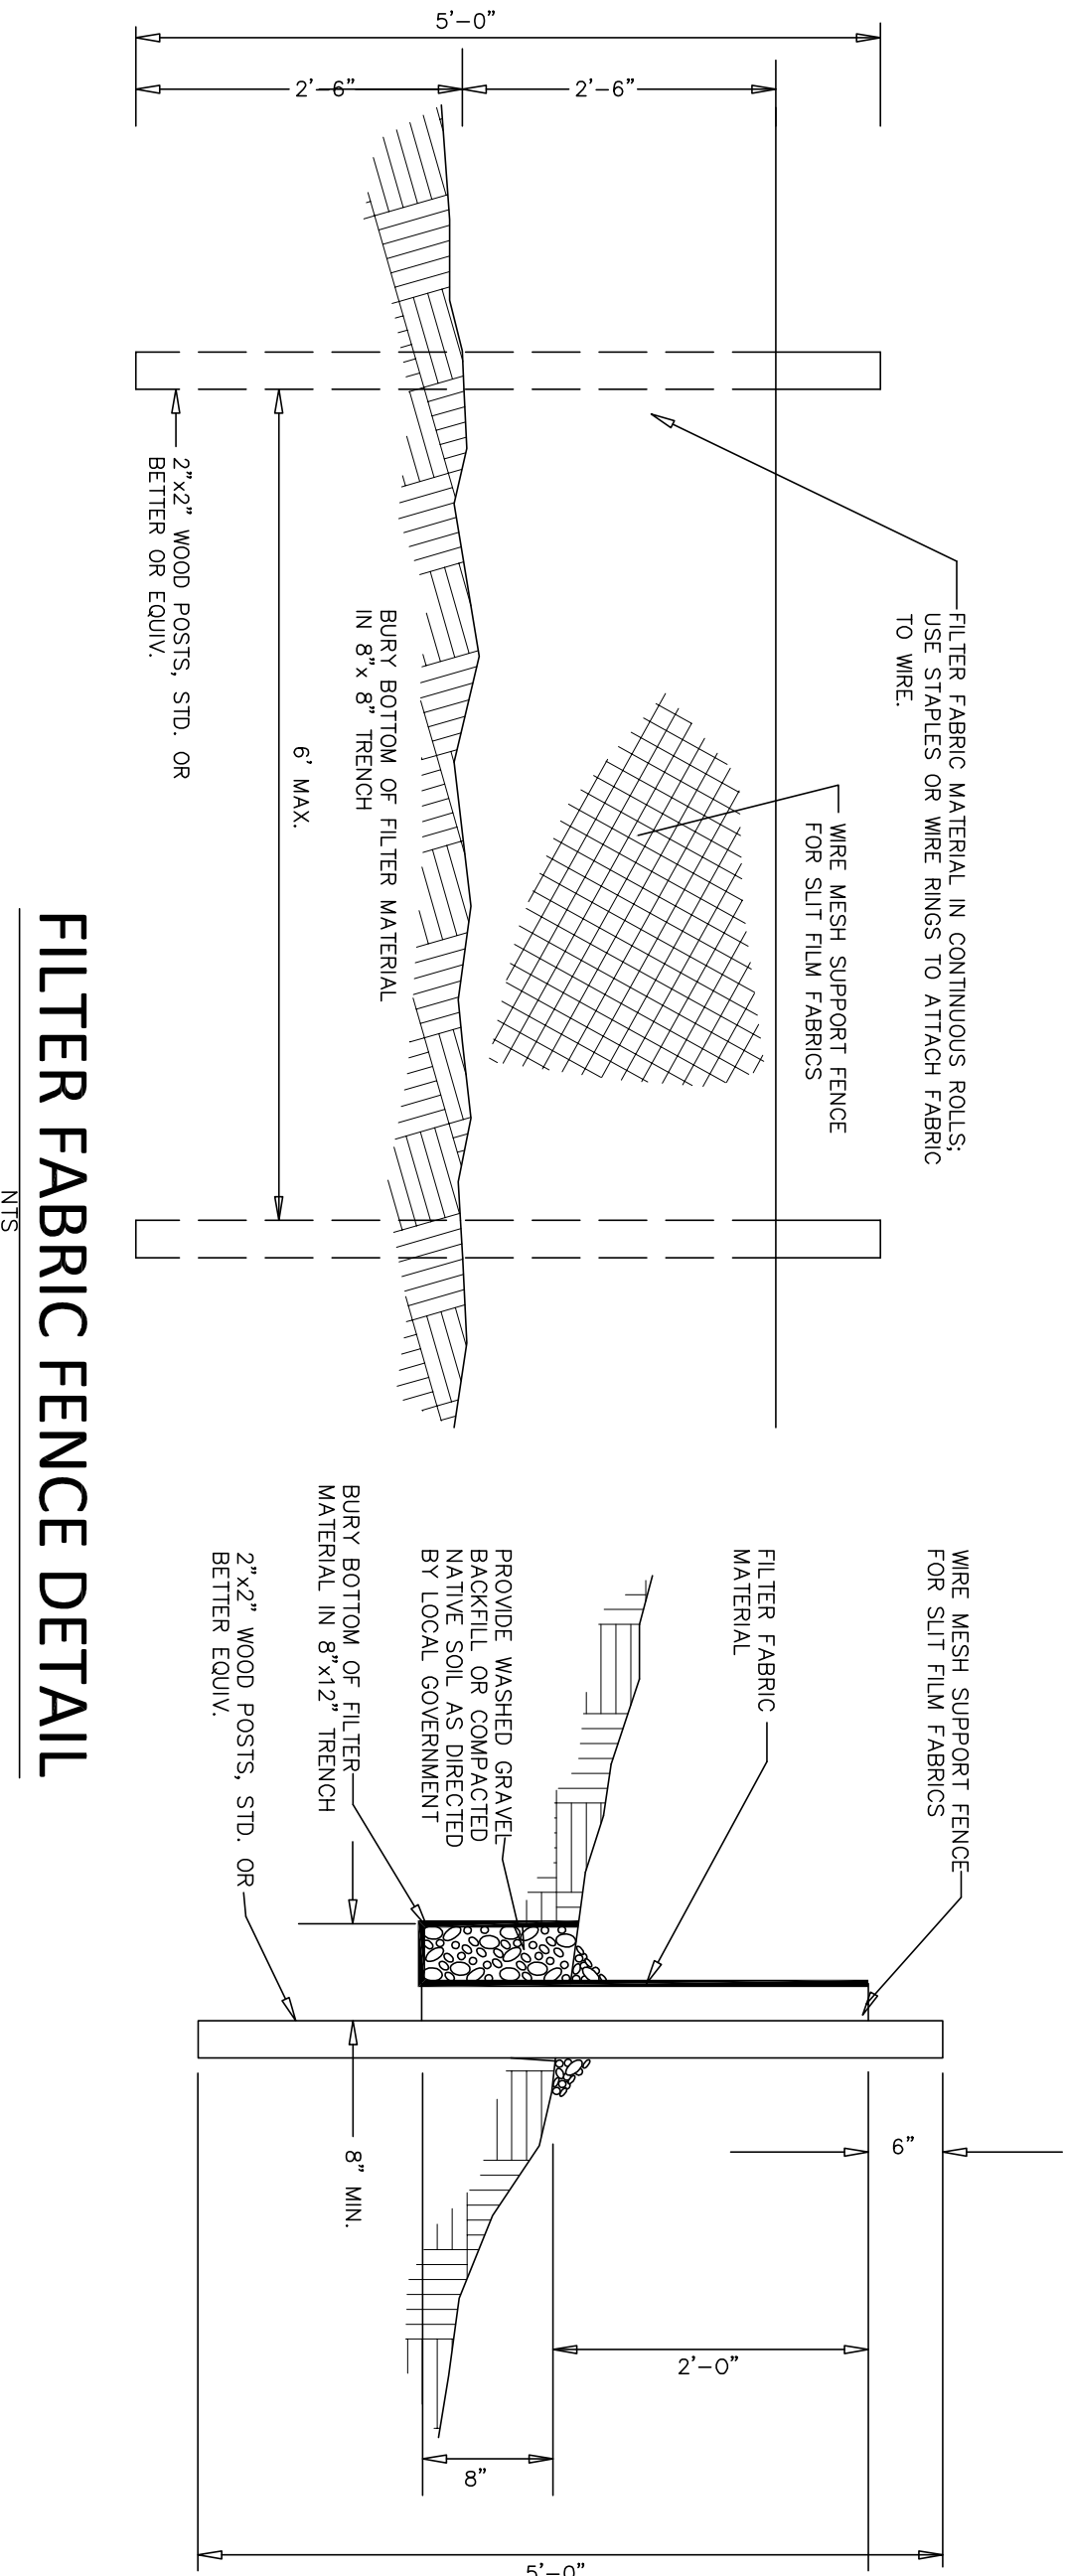


FILTER FABRIC FENCE DETAIL

NIS


STABILIZED CONSTRUCTION ENTRANCE

NIS

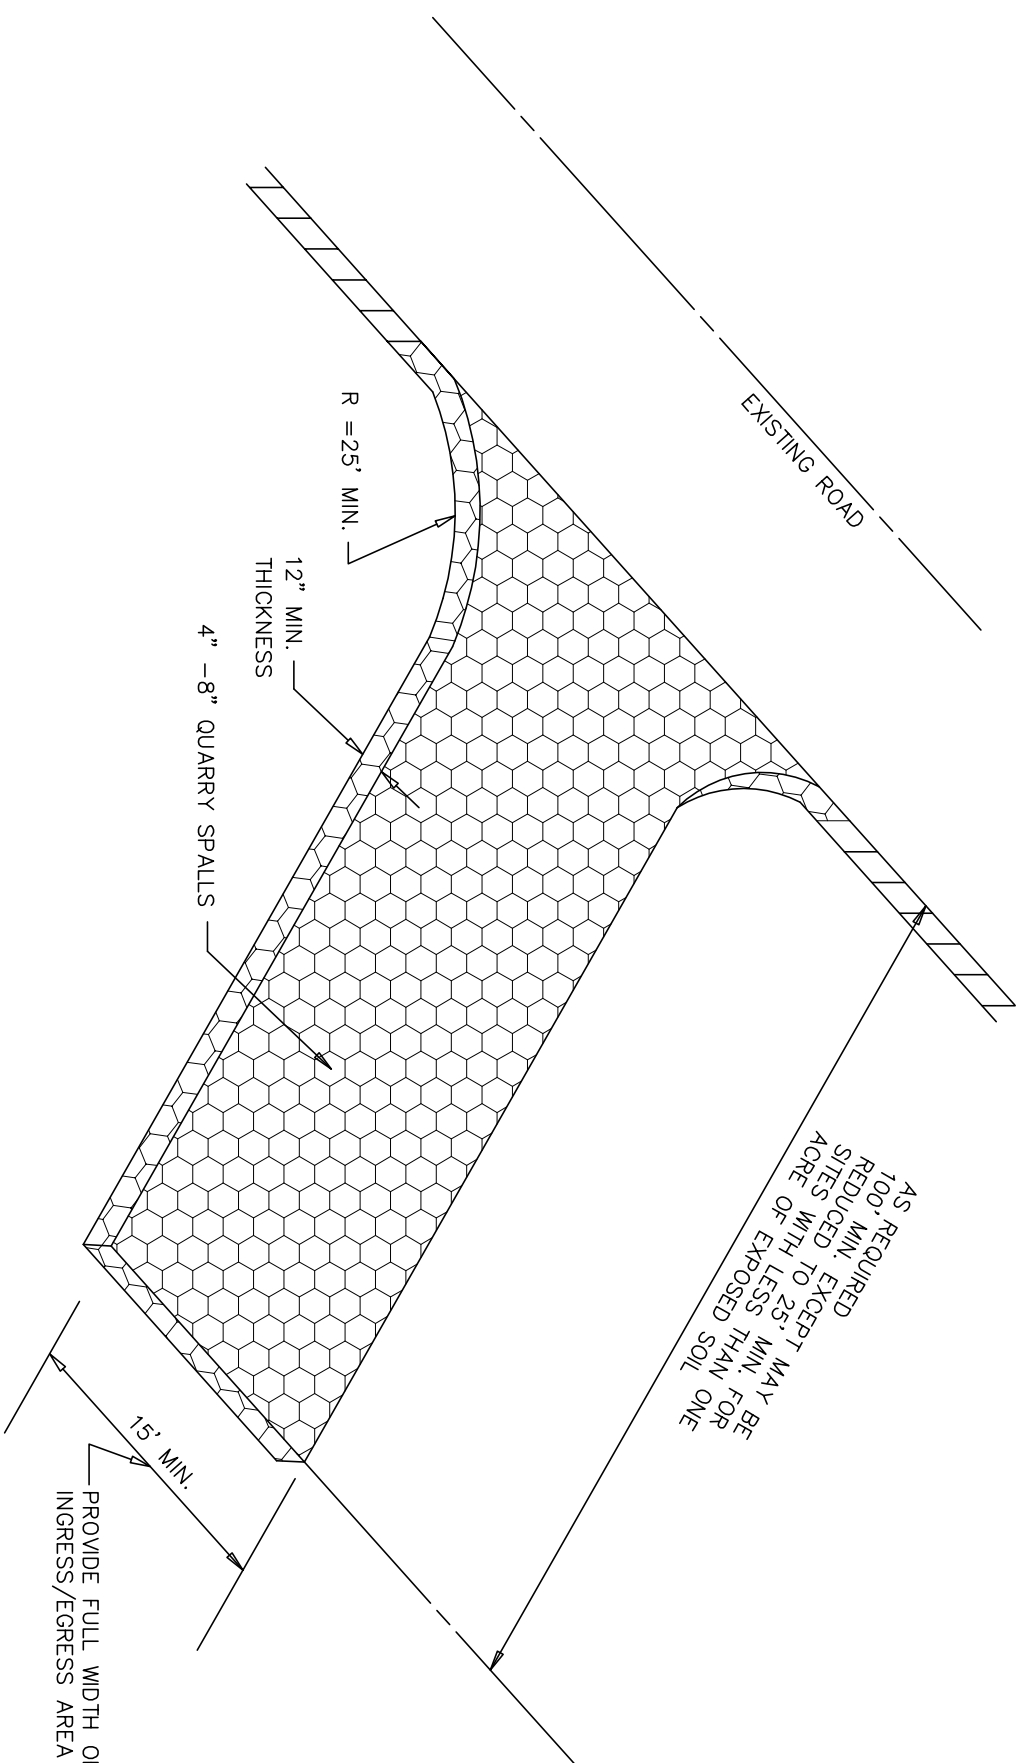

1/05/17
AS-BUILT

DESIGNED BY
LP /CKG
DRAWN BY
LMC
CHECKED BY
LP

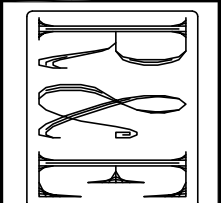

REICHHARDT & EBE
ENGINEERING, INC.
CONSULTING ENGINEERS
Ph (360) 354-3687
Fax (360) 354-0407
Po Box 978 423 Front St., Ste 201
Lynden, Washington 98264

NO. DATE

REVISION

BY

CITY OF FERNDALE
2095 MAIN STREET
FERNDAL, WA 98248


CHURCH ROAD
STREET IMPROVEMENTS
TEMP. EROSION AND SEDIMENTATION CONTROL PLAN

JOB# / DWG
07037 TESC
SCALE
H: 1" = 20' V: N/A

DATE
1-5-17
SHEET
10 of 64

1/05/17
AS-BUILT

DESIGNED BY
LP/CKG
DRAWN BY
LMC
CHECKED BY
LP

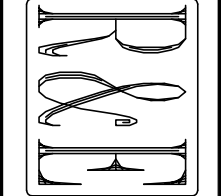

REICHHARDT & EBE
ENGINEERING, INC.
CONSULTING ENGINEERS
Ph (360) 354-3687
Fox (360) 354-0407
Lynden, Washington 98264

NO. DATE



REVISION





BY

CITY OF FERNDALE
2095 MAIN STREET
FERNDAL, WA 98248

CHURCH ROAD
STREET IMPROVEMENTS - SEWER
6+50 TO 12+00


JOB# / DWG
07037 PLANPRO
SCALE
H: 1"=20' V: 1"=5'
DATE
1/5/17
SHEET
19 of 64

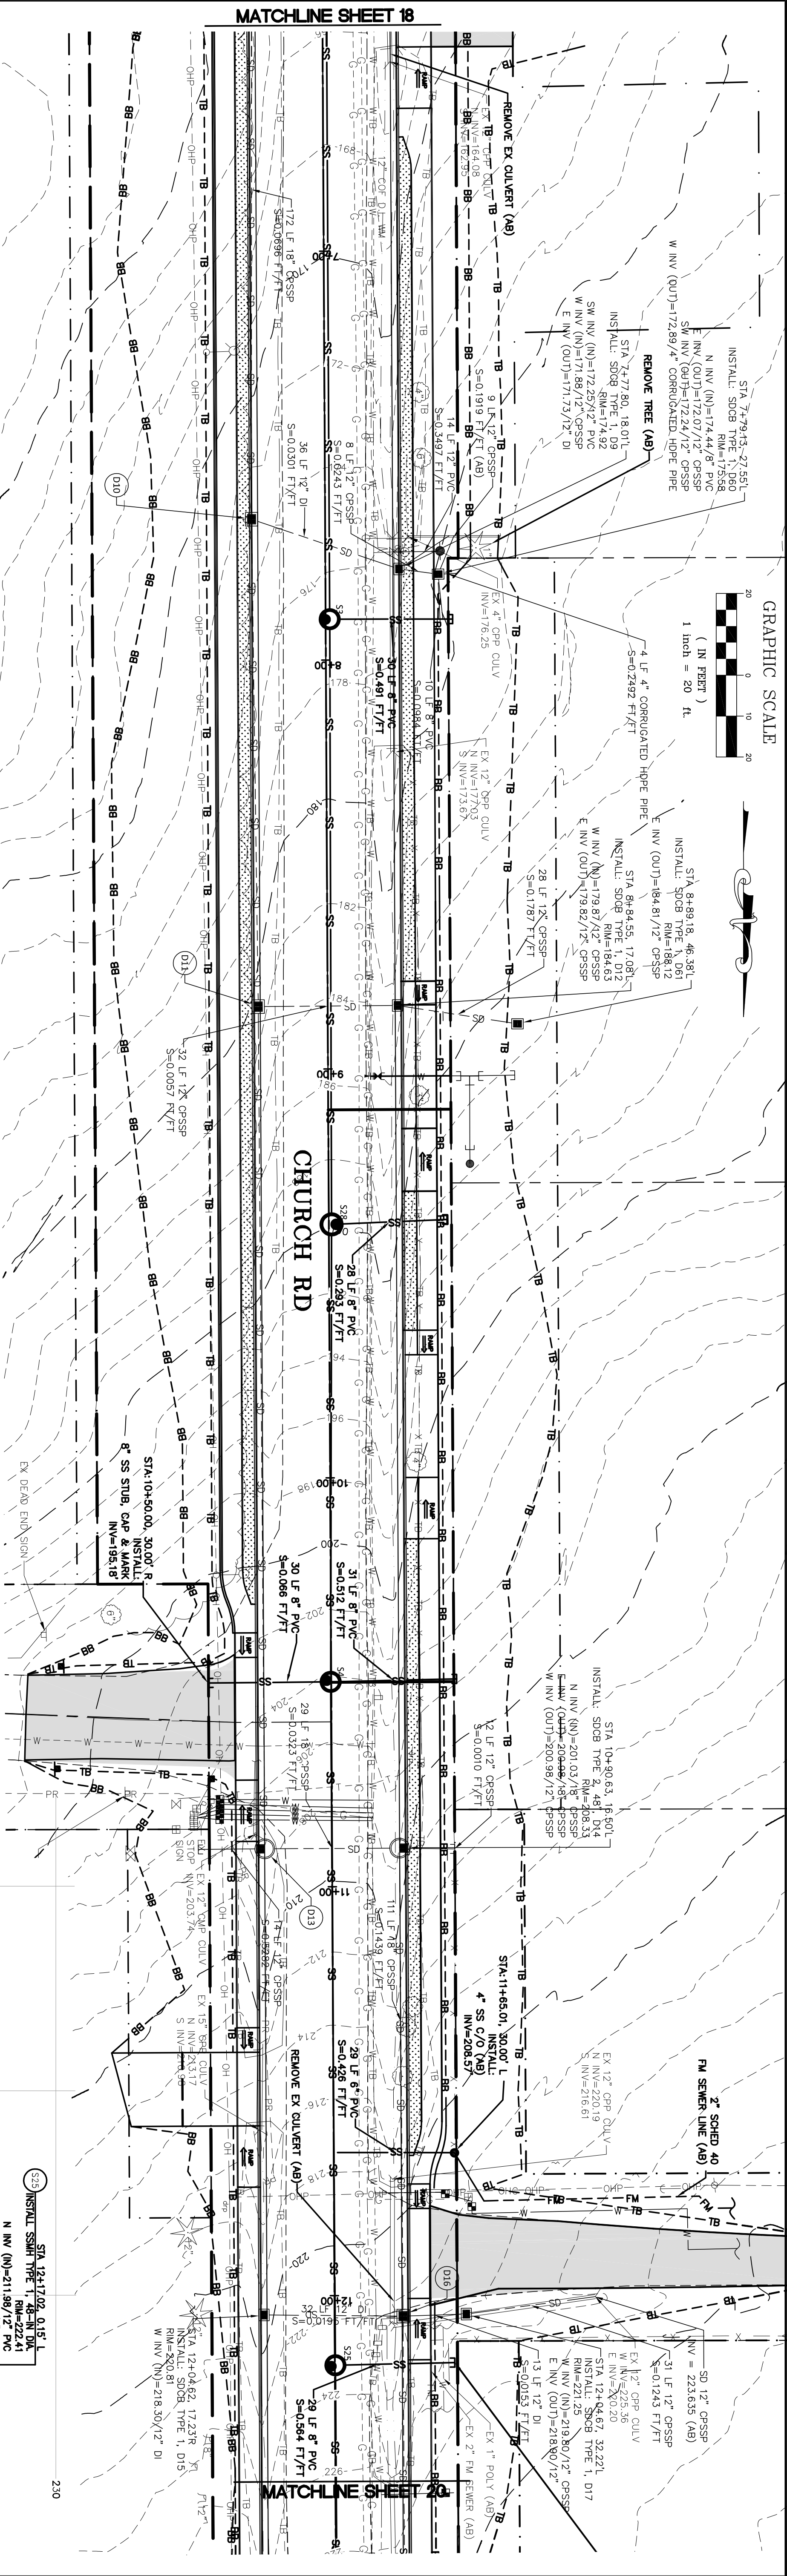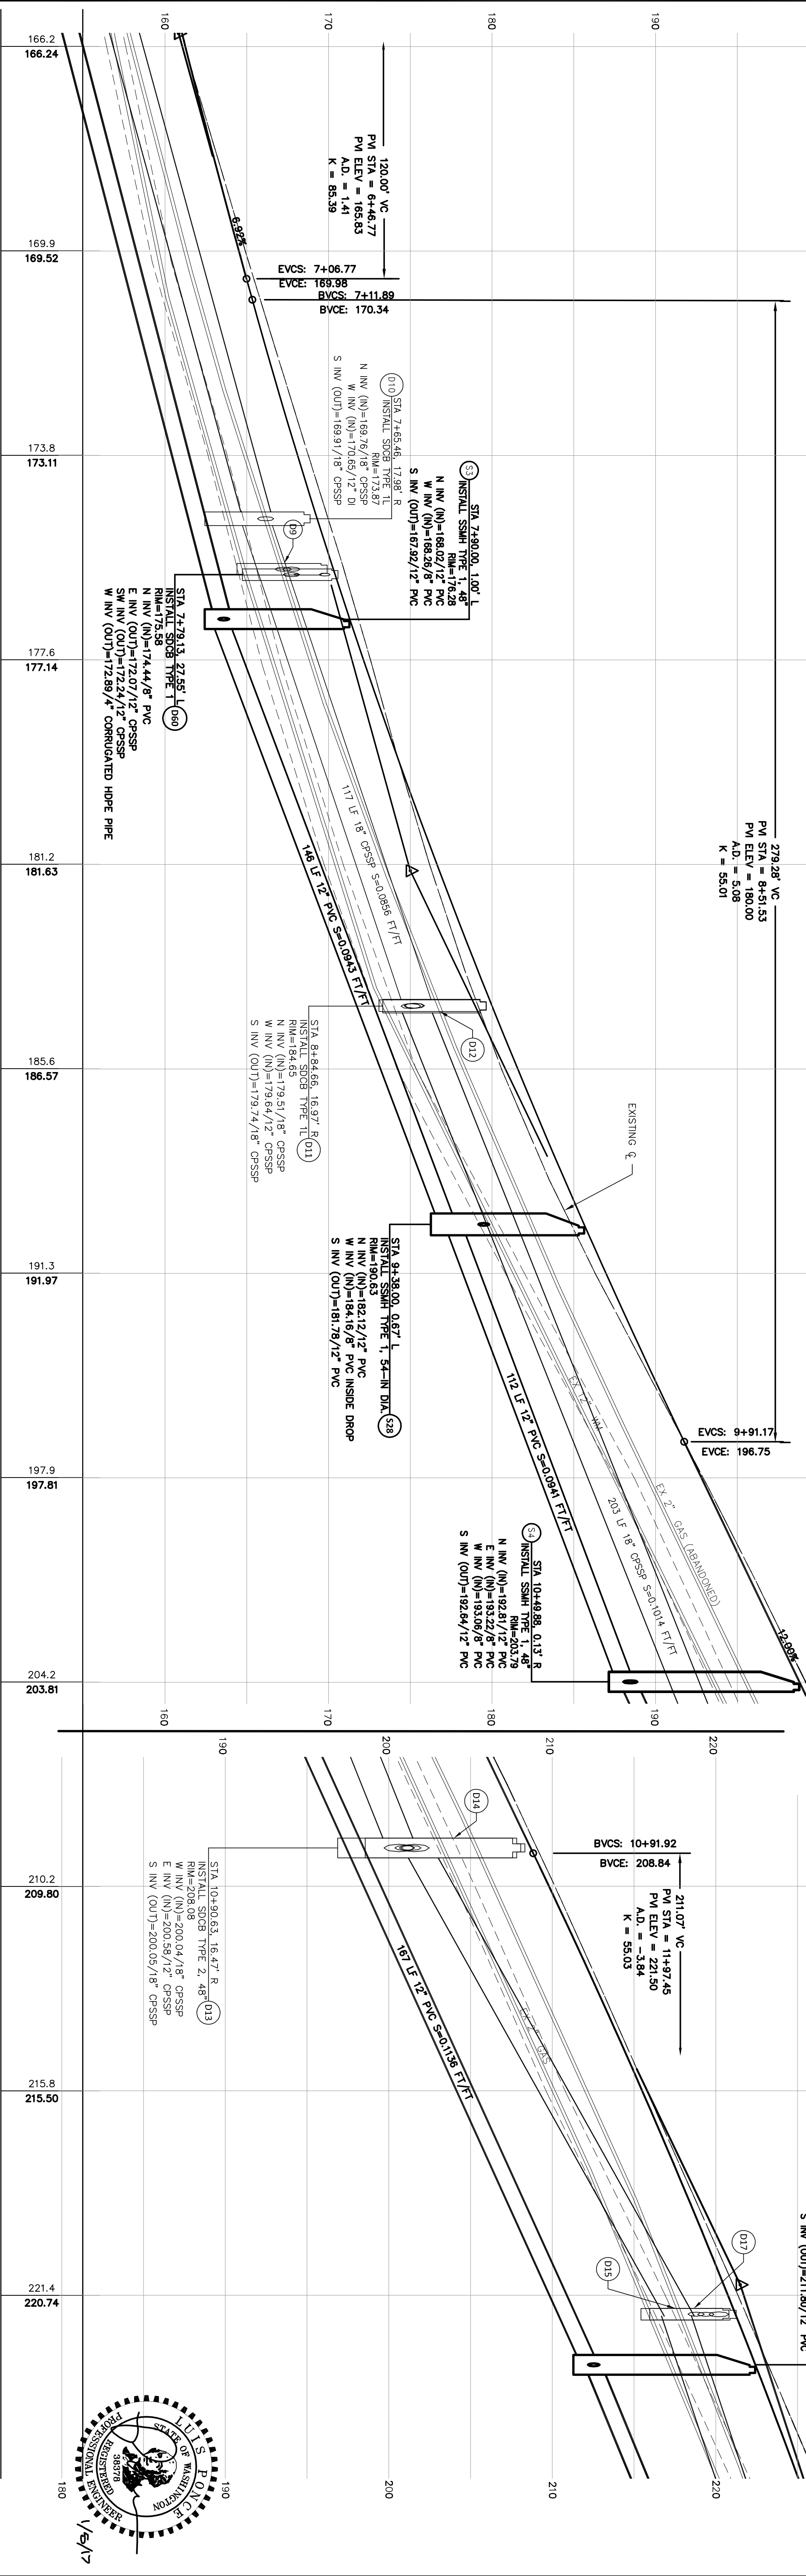

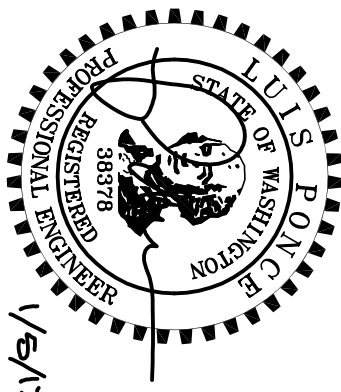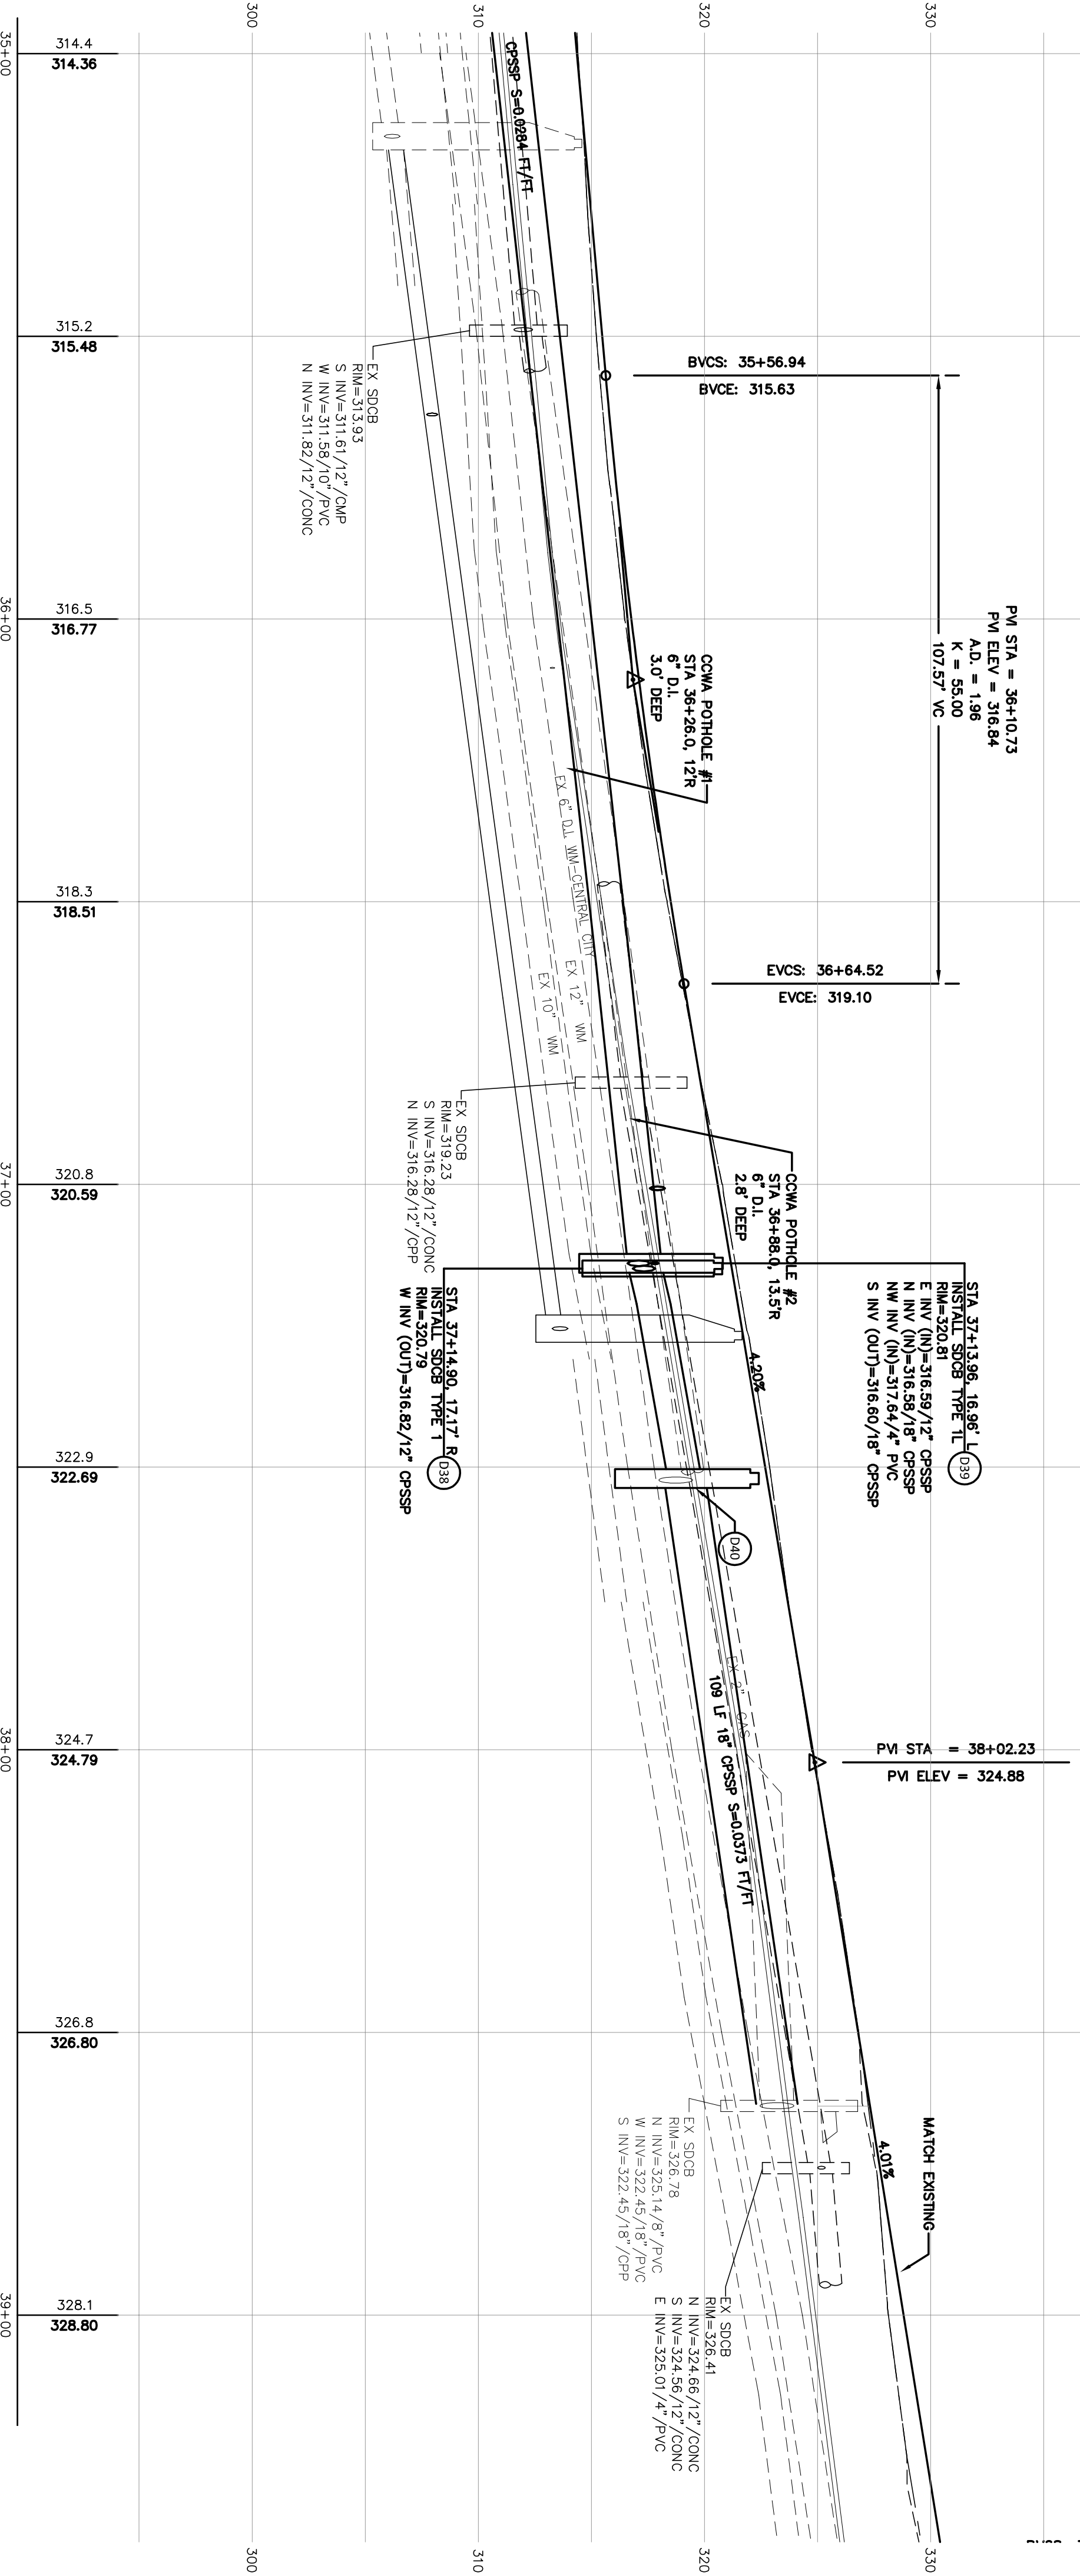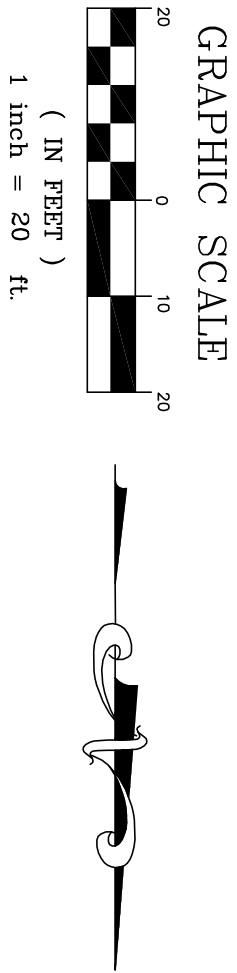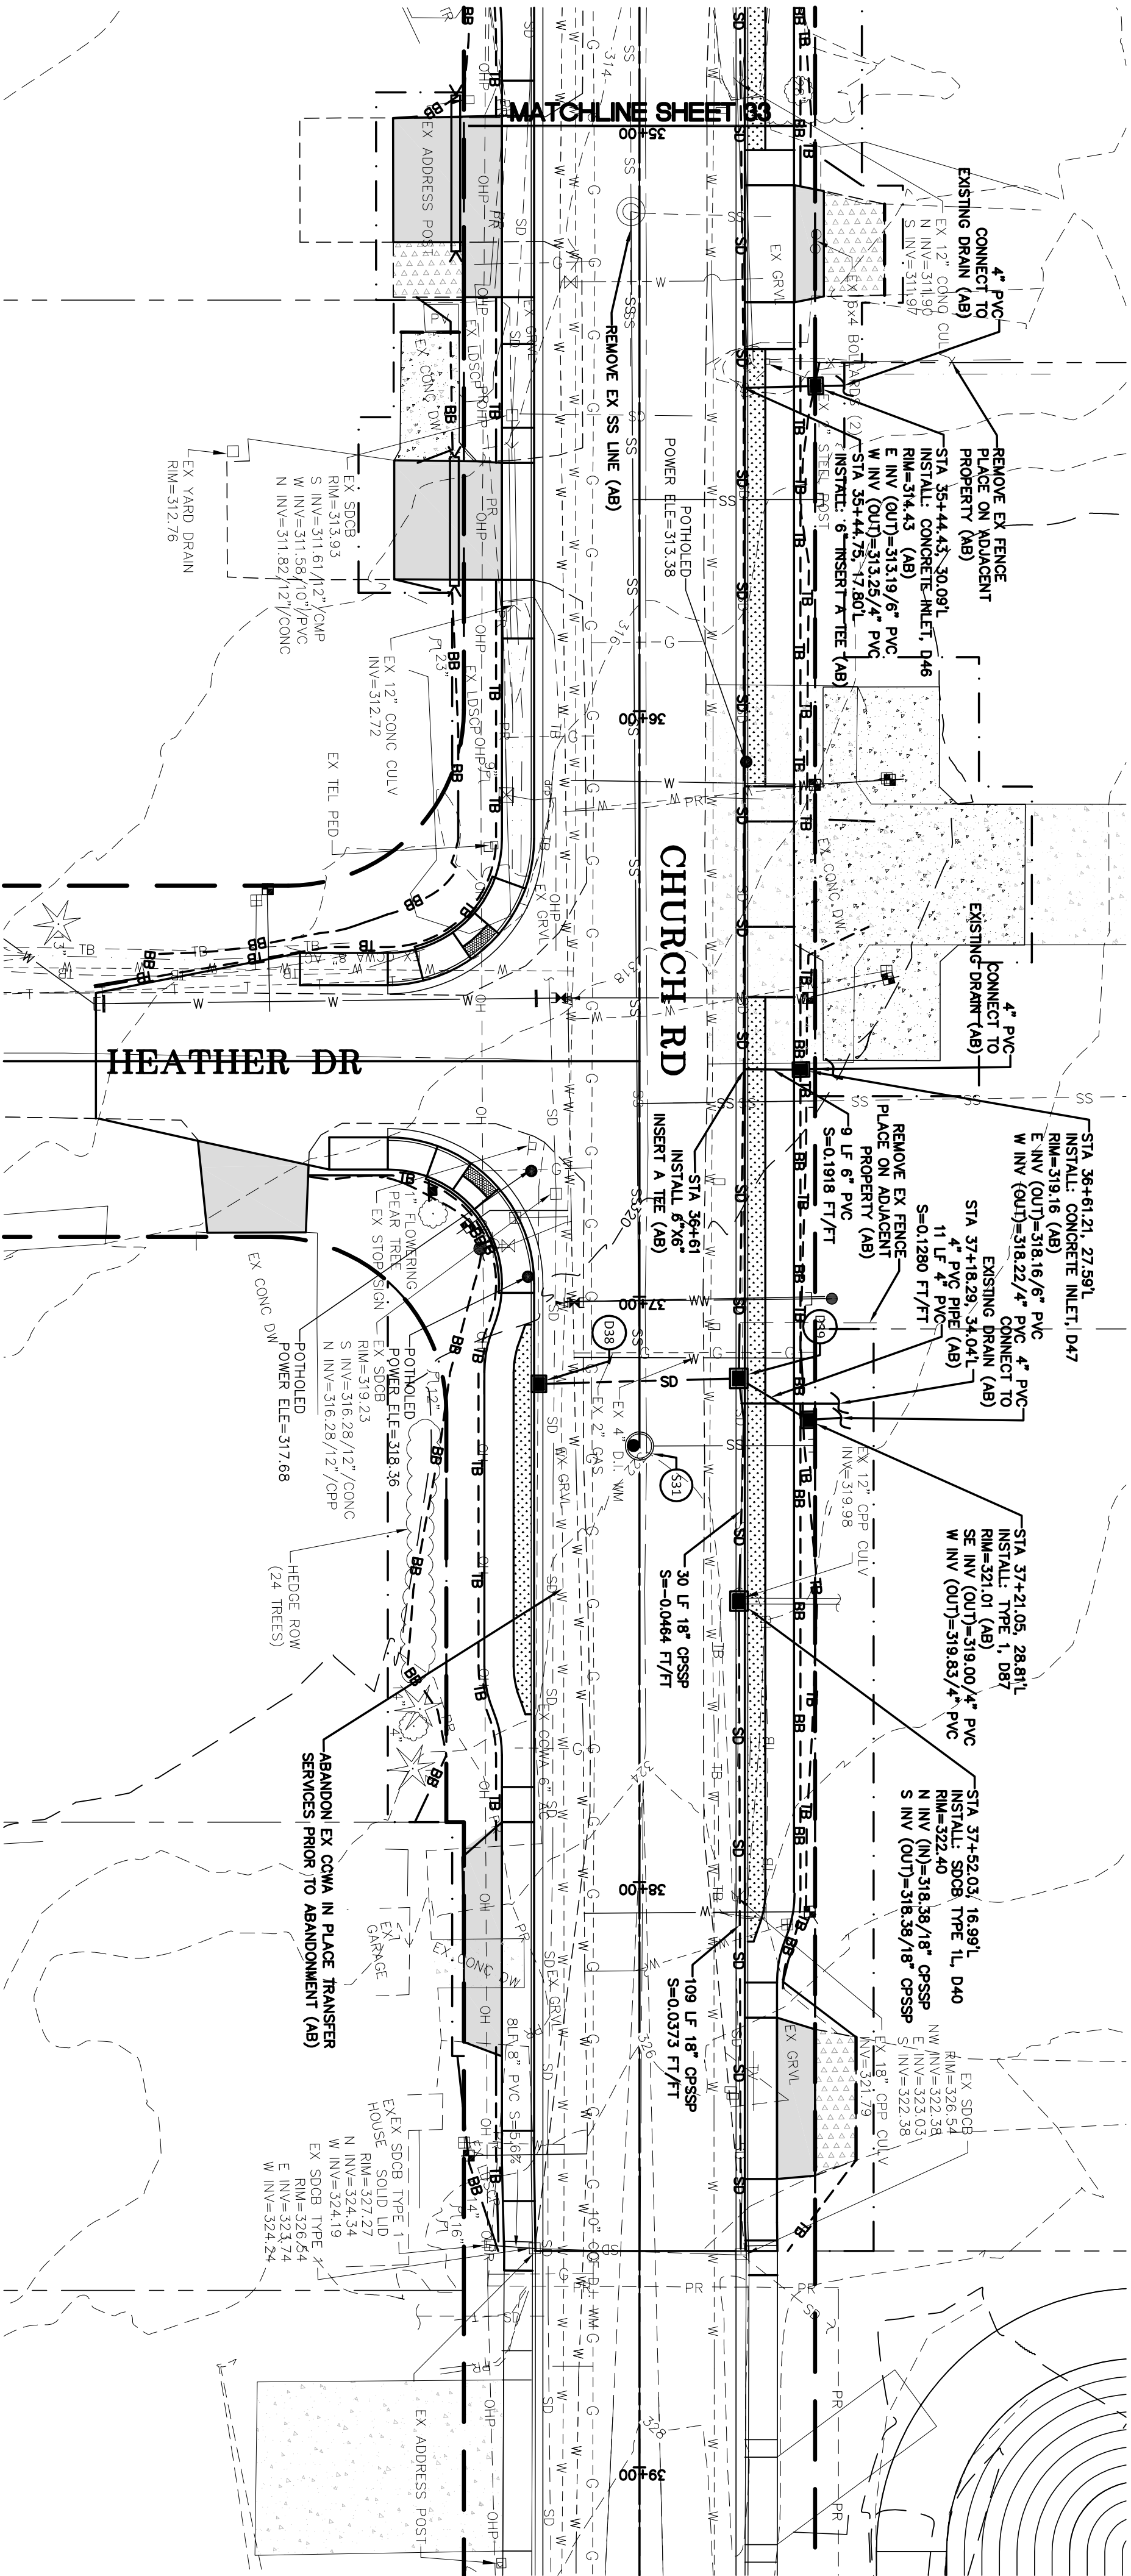

1/05/17
AS-BUILT

DESIGNED BY
LP /CKG
DRAWN BY
LMC
CHECKED BY
LP

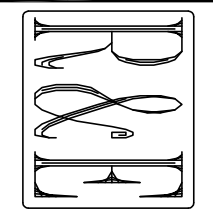

REICHHARDT & EBE
ENGINEERING, INC.
CONSULTING ENGINEERS
PO Box 978 423 Front St., Ste 201
Lynden, Washington 98264
Ph (360) 354-3687
Fax (360) 354-0407









NO.	DATE	REVISION

CITY OF FERNDALE
2095 MAIN STREET
FERNDALE, WA 98248

CHURCH ROAD
STREET IMPROVEMENTS - STORM
35+00 TO 39+00


JOB# / DWG
07037
PLANPRO
SCALE
H: 1" = 20'
V: 1" = 5'

DATE
1-5-17
SHEET
34 of 64

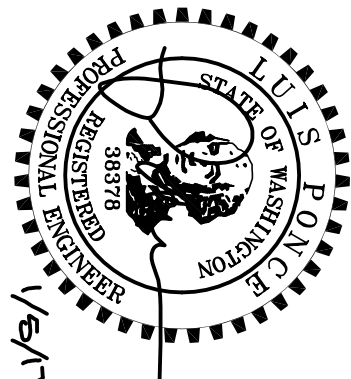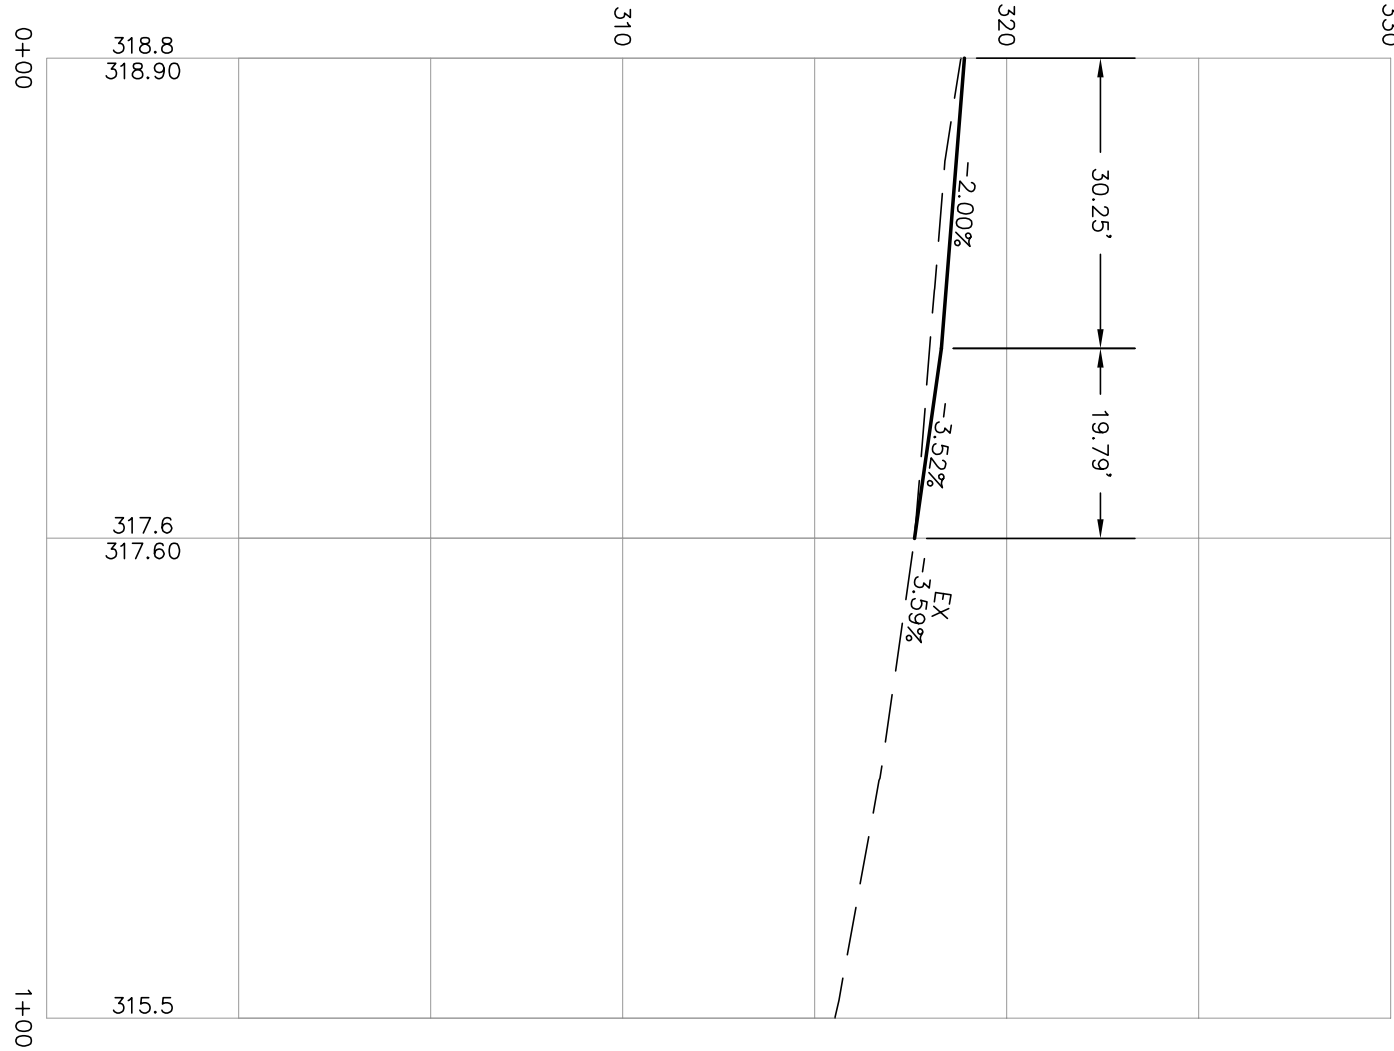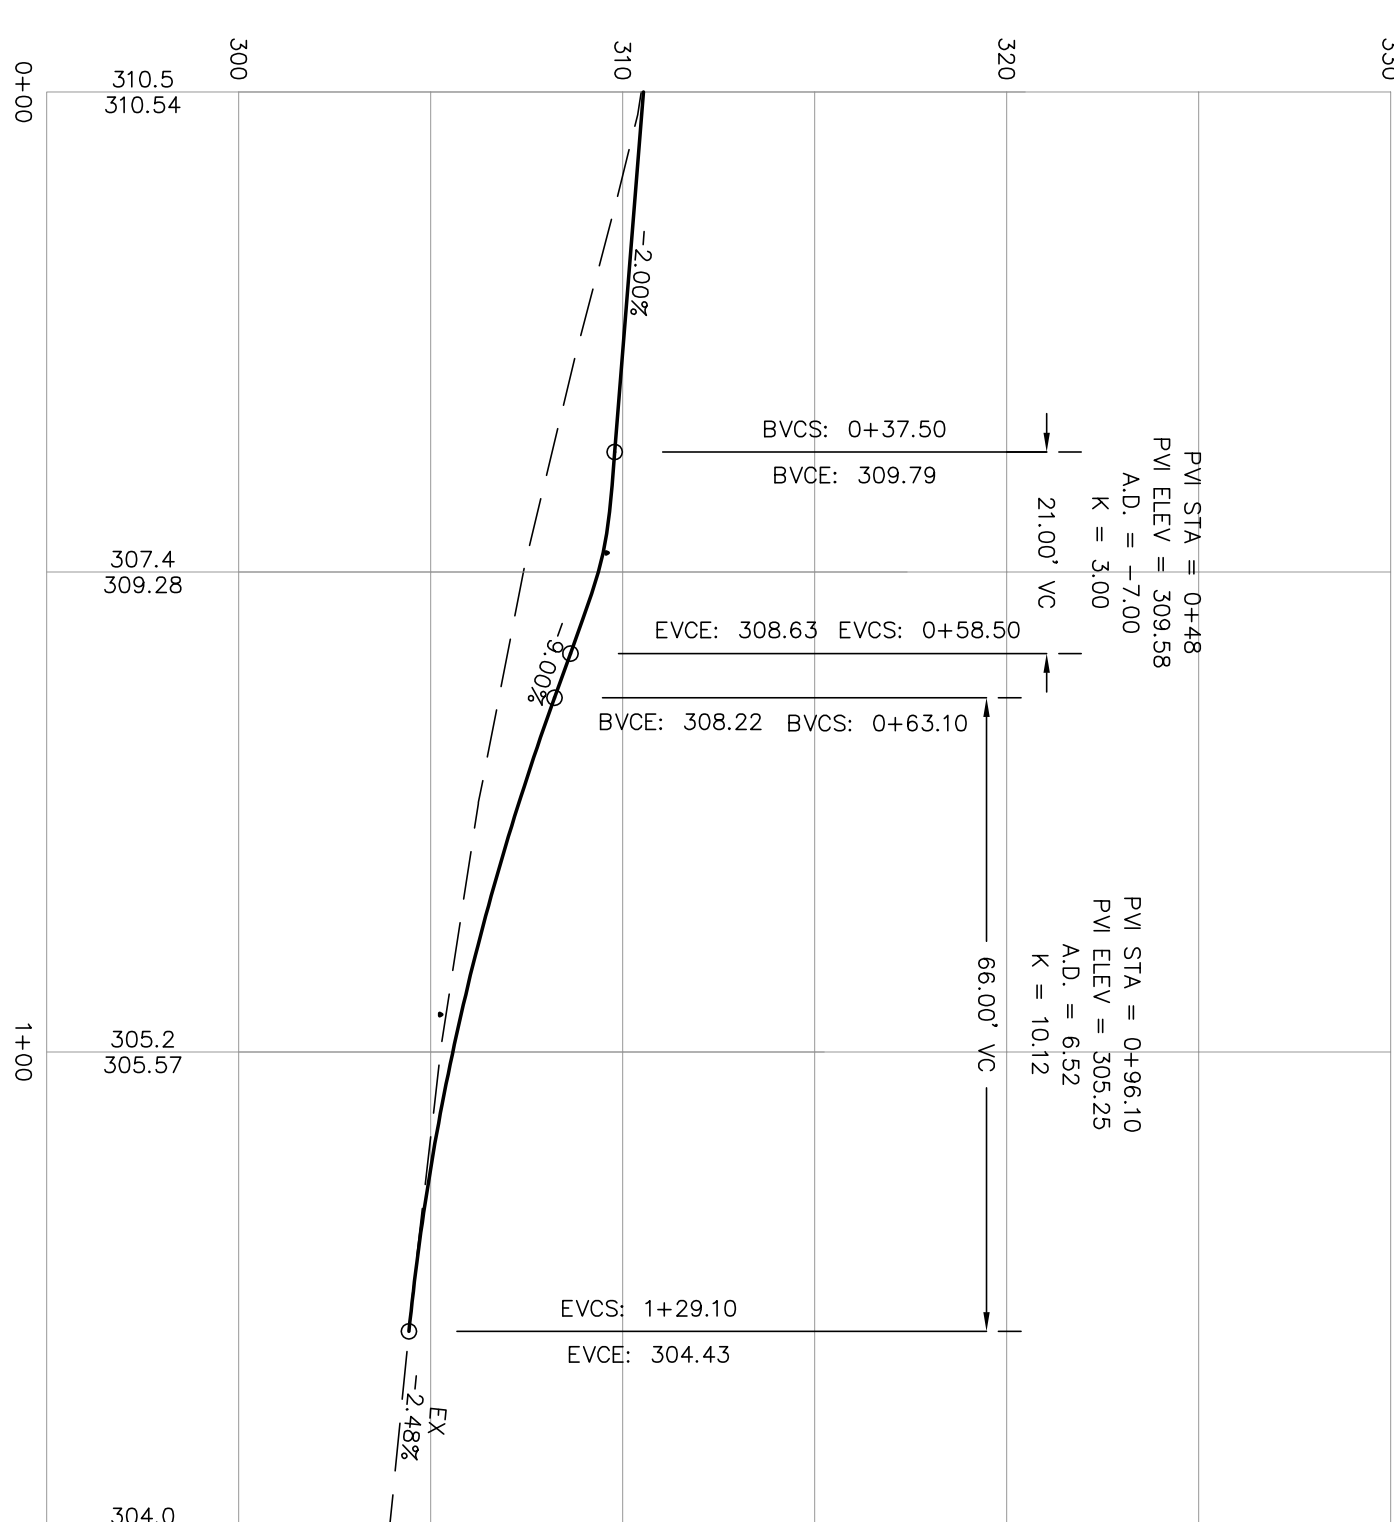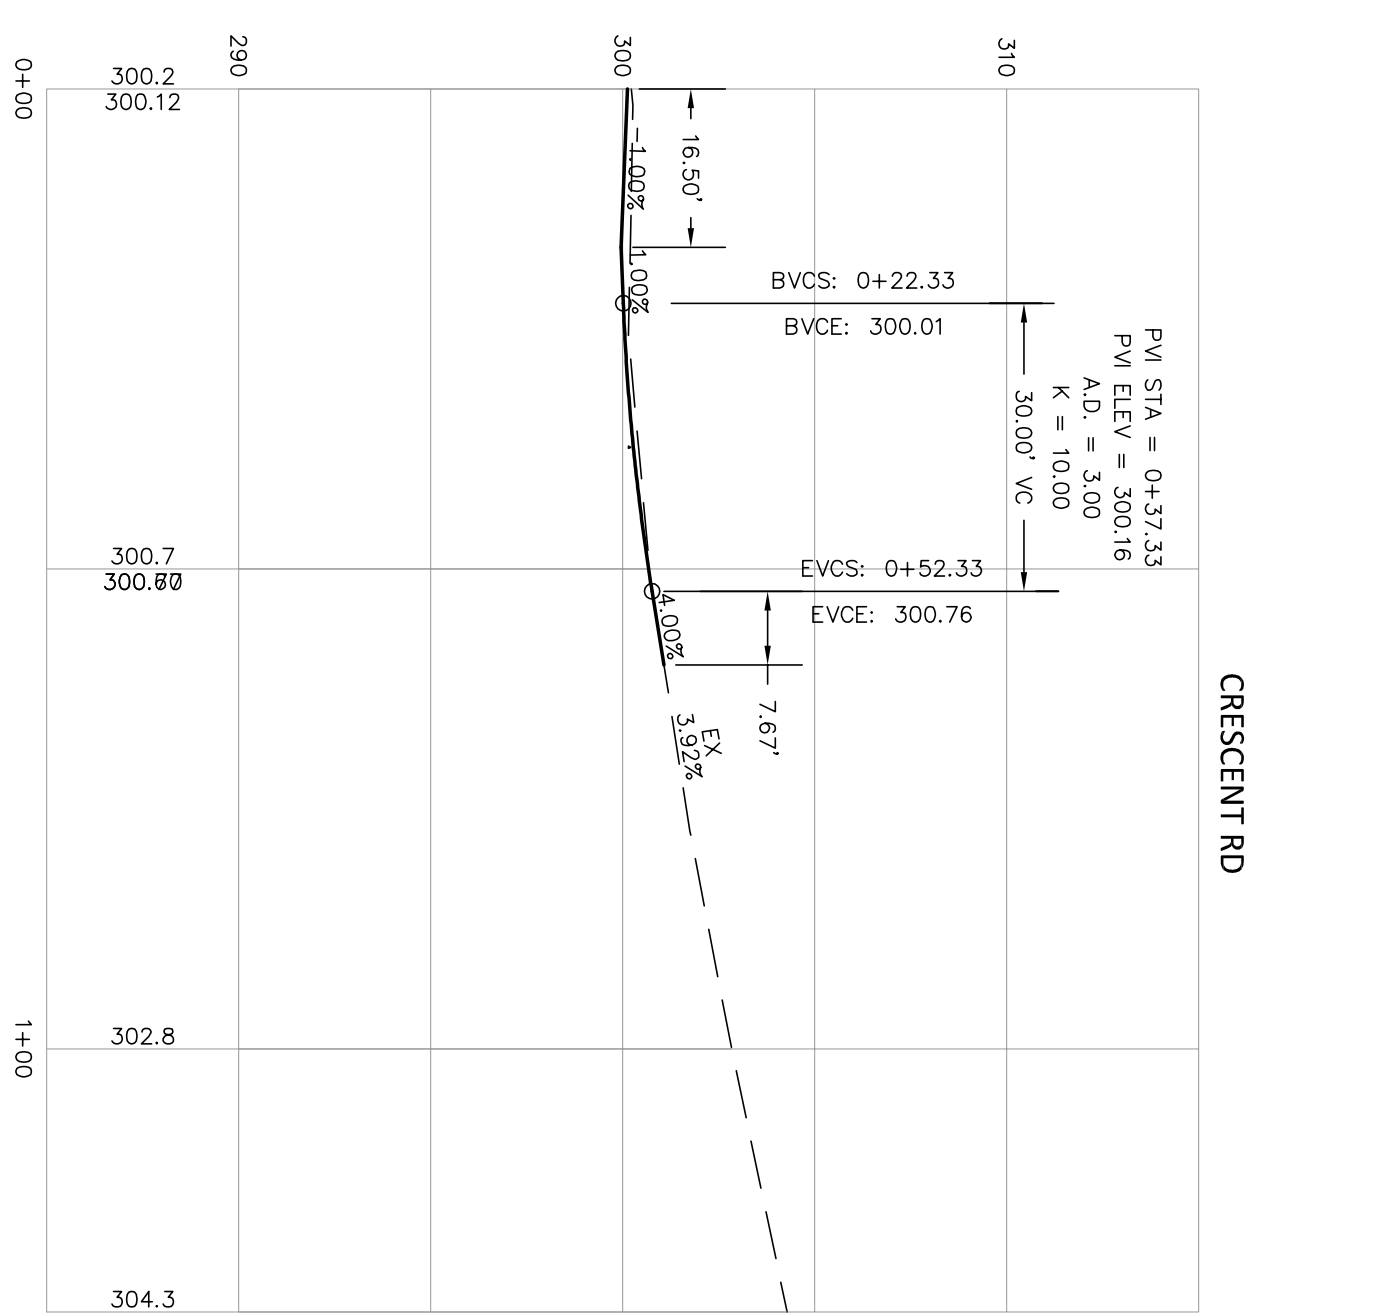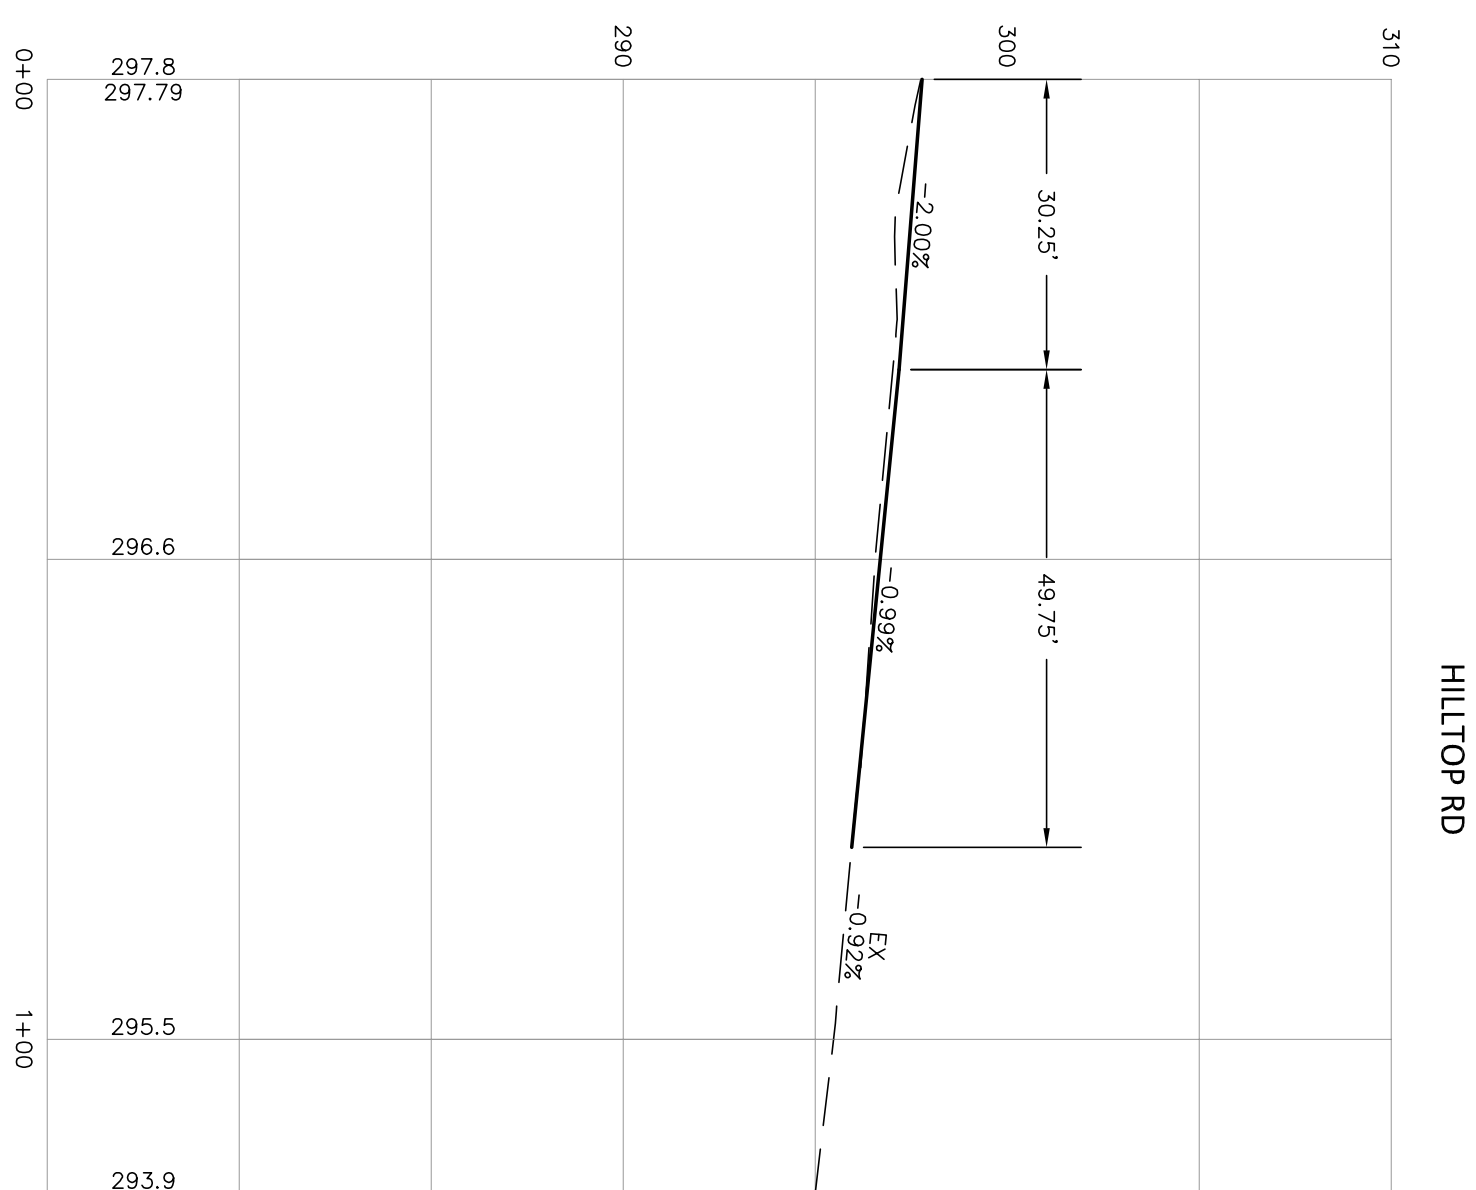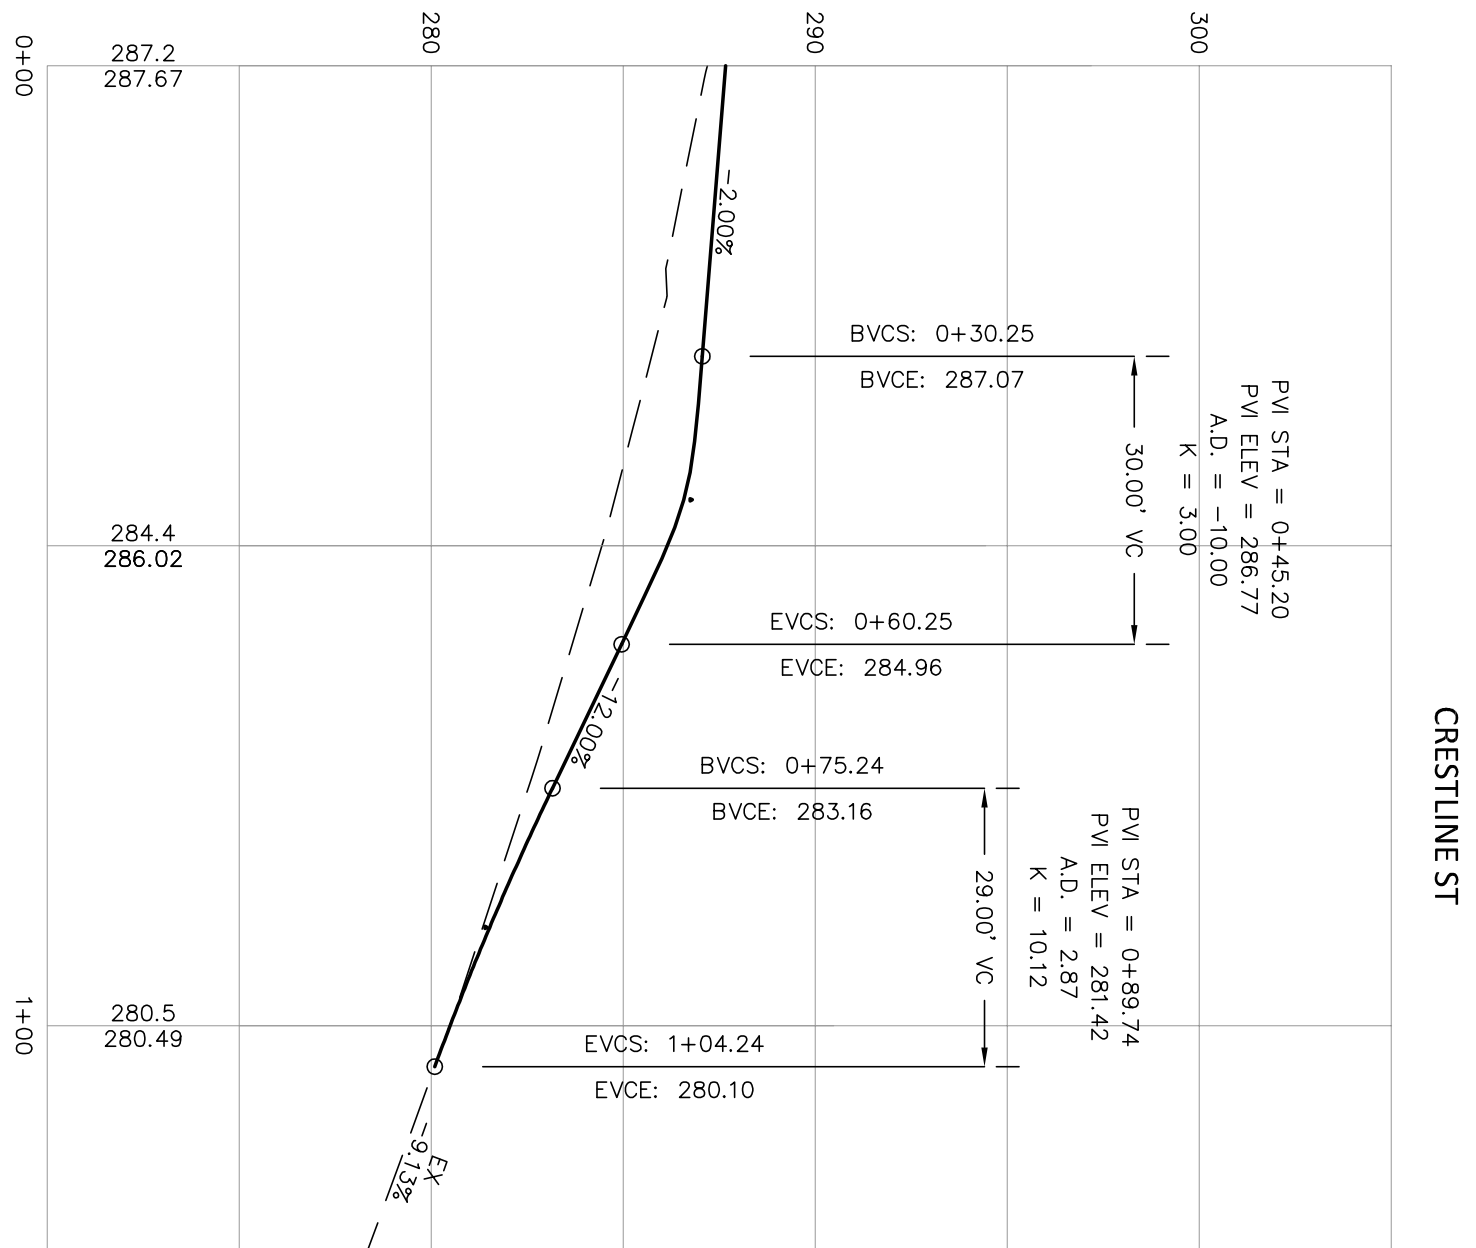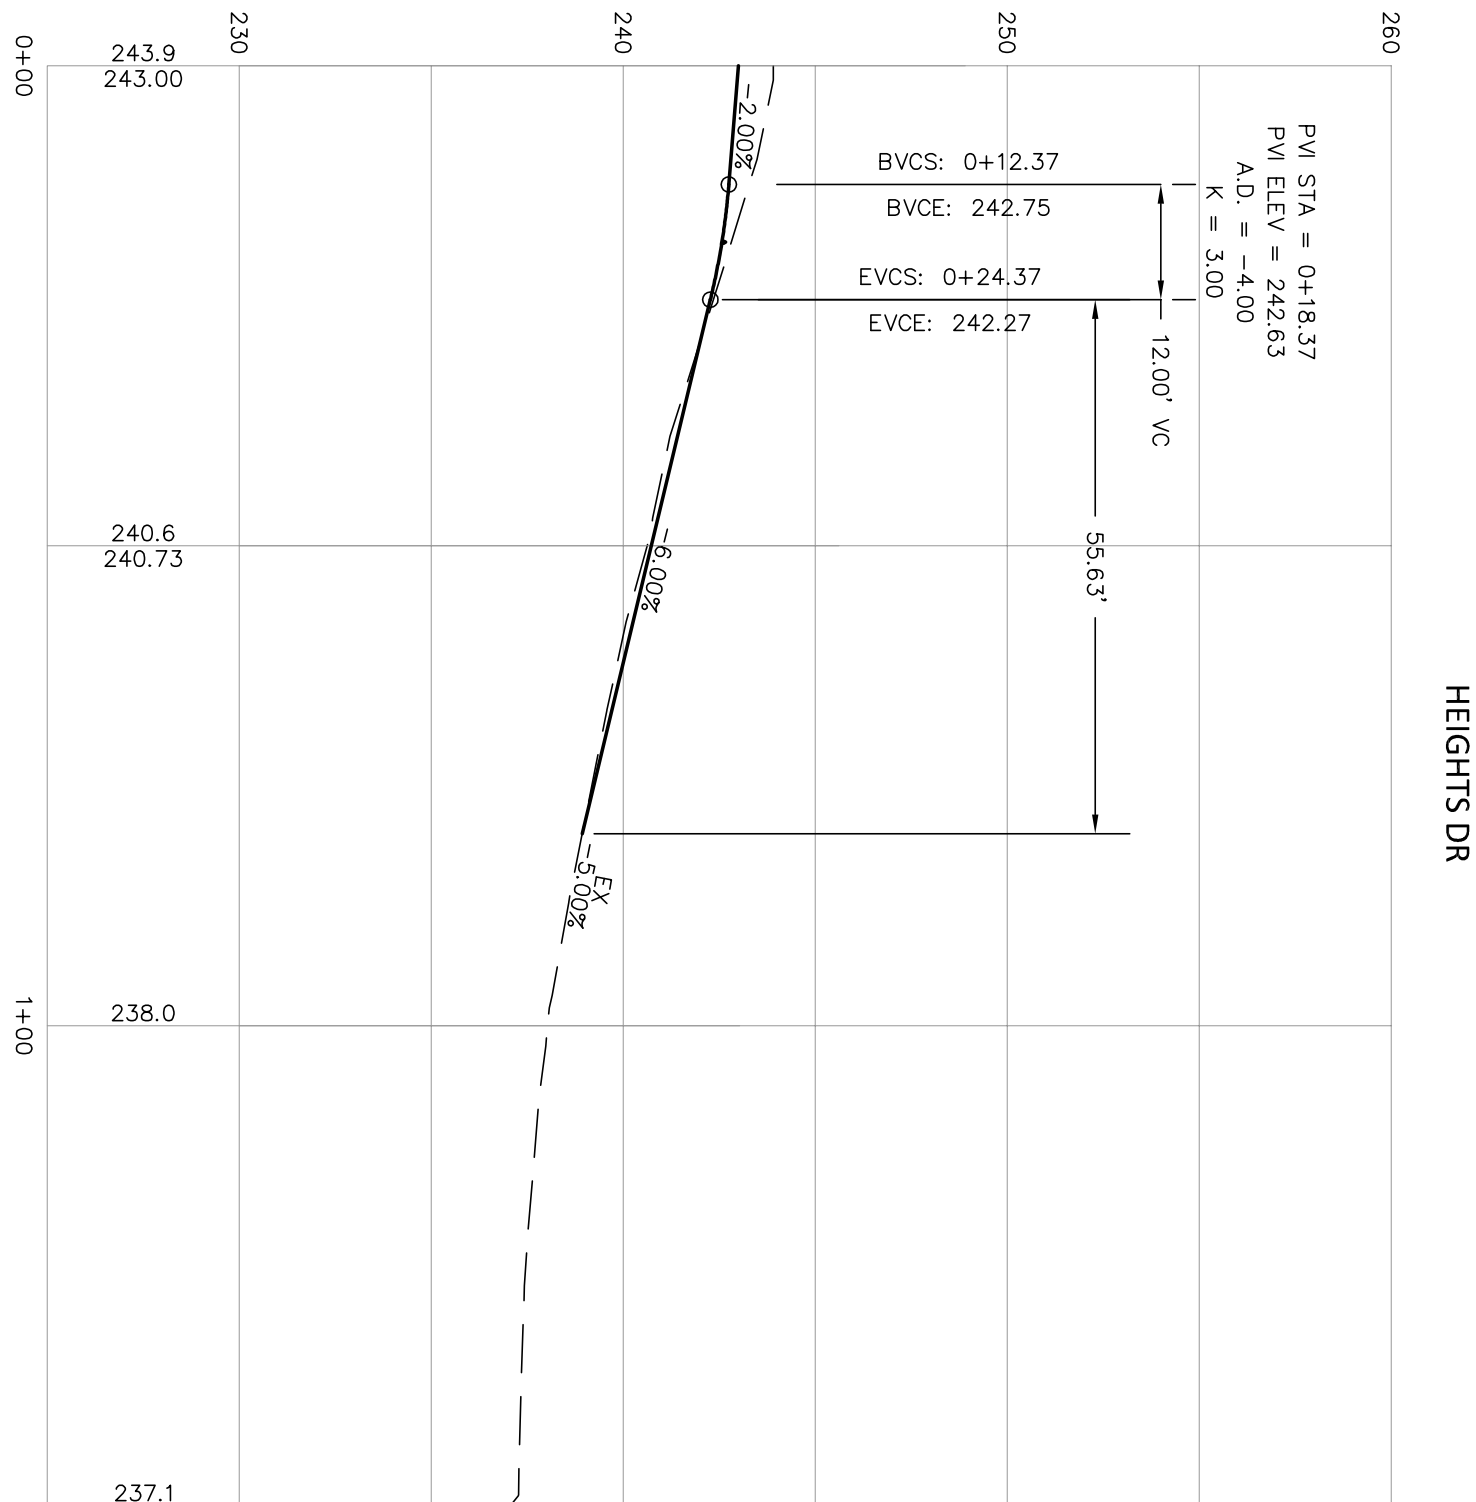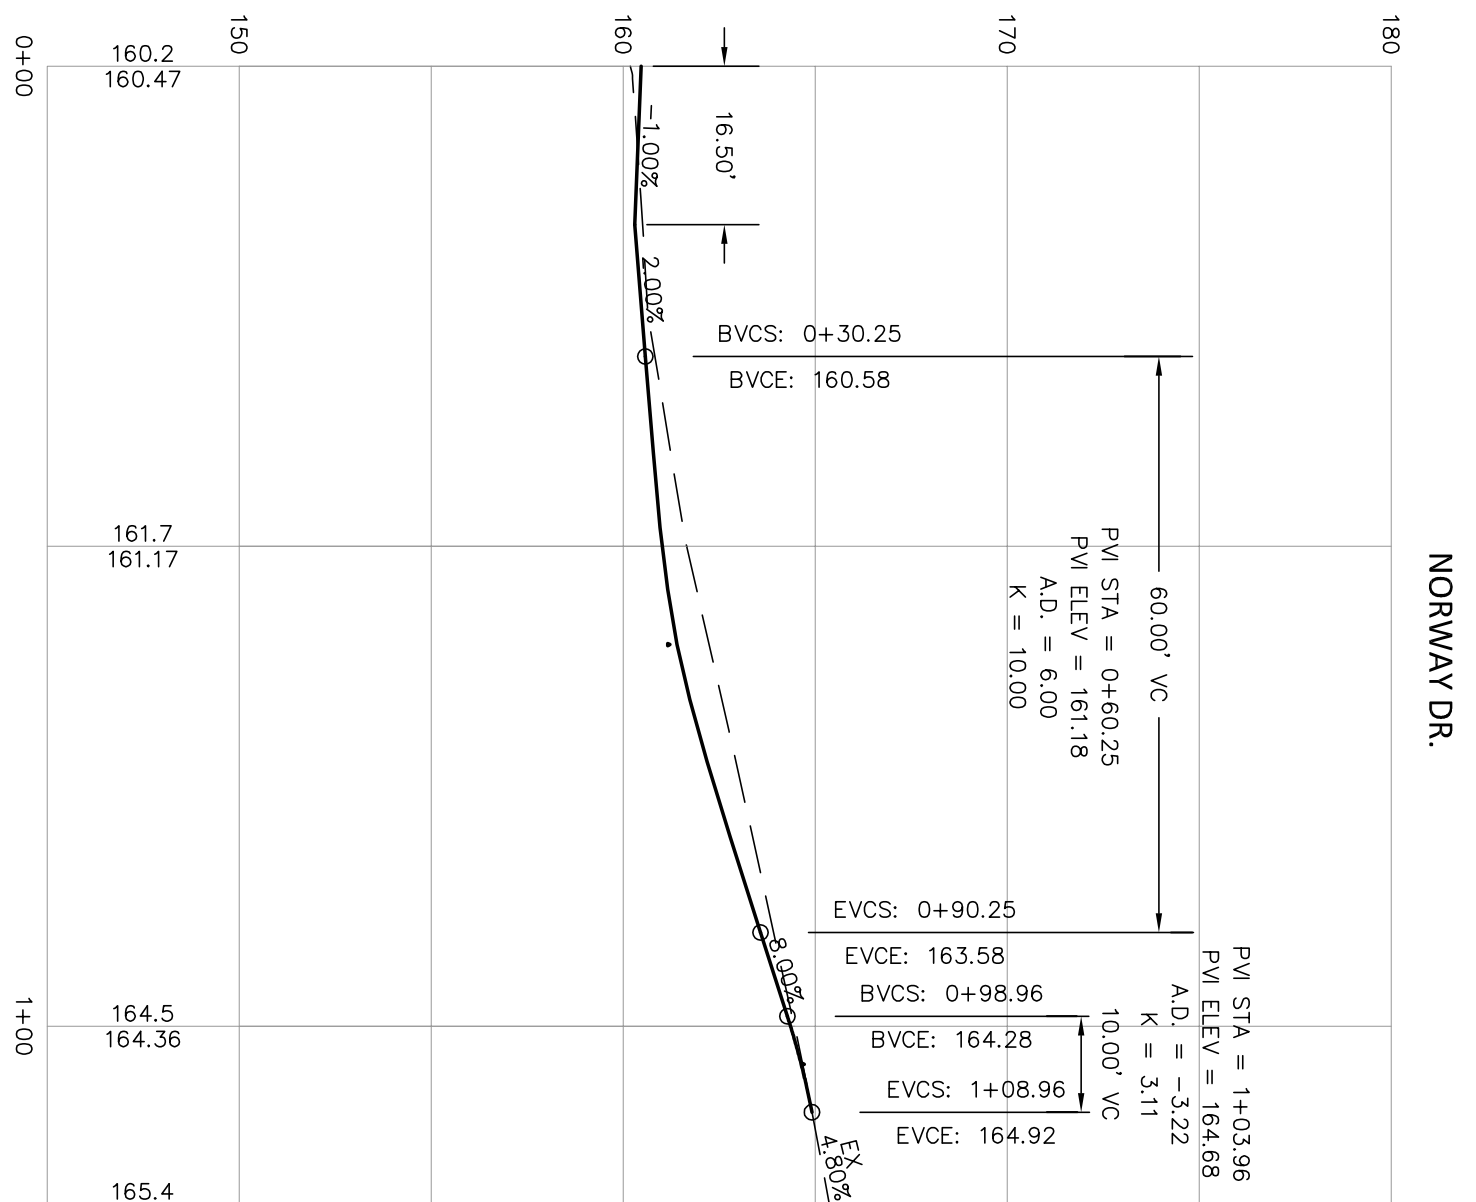

1/05/17
AS-BUILT

DESIGNED BY
LP
DRAWN BY
ARS
CHECKED BY
LP

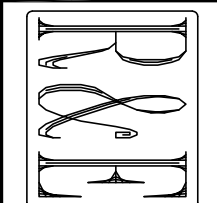

REICHHARDT & EBE
ENGINEERING, INC.
CONSULTING ENGINEERS
PO Box 978 423 Front St., Ste 201
Lynden, Washington 98264
Ph (360) 354-3687
Fax (360) 354-0407

NO. DATE

REVISION

BY

CITY OF FERNDALE
2095 MAIN STREET
FERNDAL, WA 98248

CHURCH ROAD
STREET IMPROVEMENTS
INTERSECTION PROFILES

JOB# / DWG
07037 DWY-INT
SCALE
H: 1" = 20' V: N/A

DATE
1-5-17
SHEET
35 of 64

1/05/17

AS-BUILT

DESIGNED BY

LP

DRAWN BY

ARS

CHECKED BY

LP

REICHHARDT & EBE
ENGINEERING, INC.
CONSULTING ENGINEERS
Po Box 978 423 Front St., Ste 201
Lynden, Washington 98264

Ph (360) 354-3687
Fax (360) 354-0407

NO.	DATE	REVISION	BY

CITY OF FERNDALE
2095 MAIN STREET
FERNDALE, WA 98248

CHURCH ROAD
STREET IMPROVEMENTS
DRIVEWAY PROFILES

J08# / DWG

07037

DWY-INT

SCALE














H: 1" = 20' V: N/A


DATE

1-5-17


SHEET

36 of 64

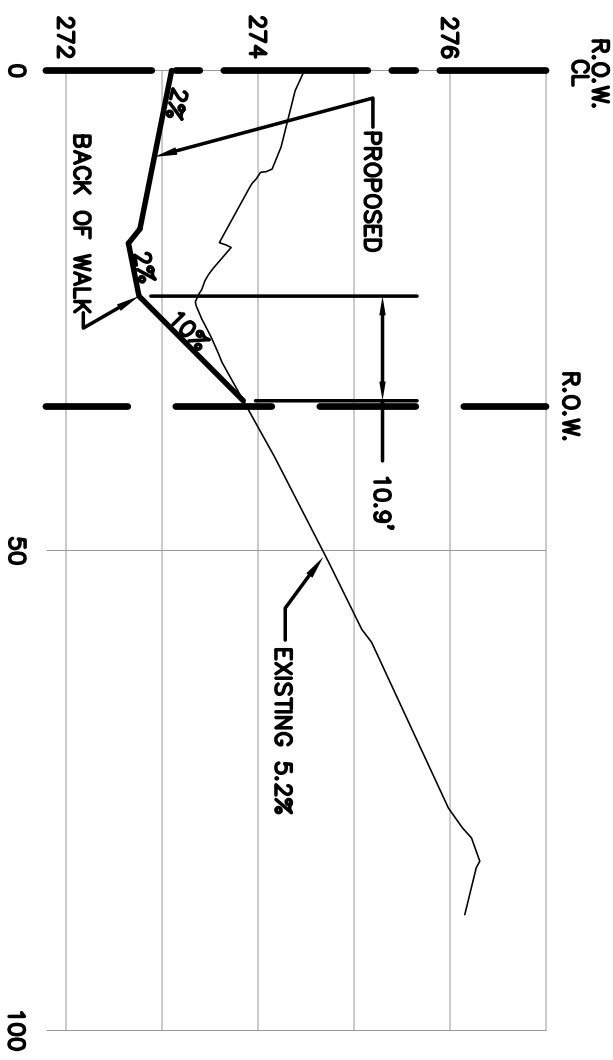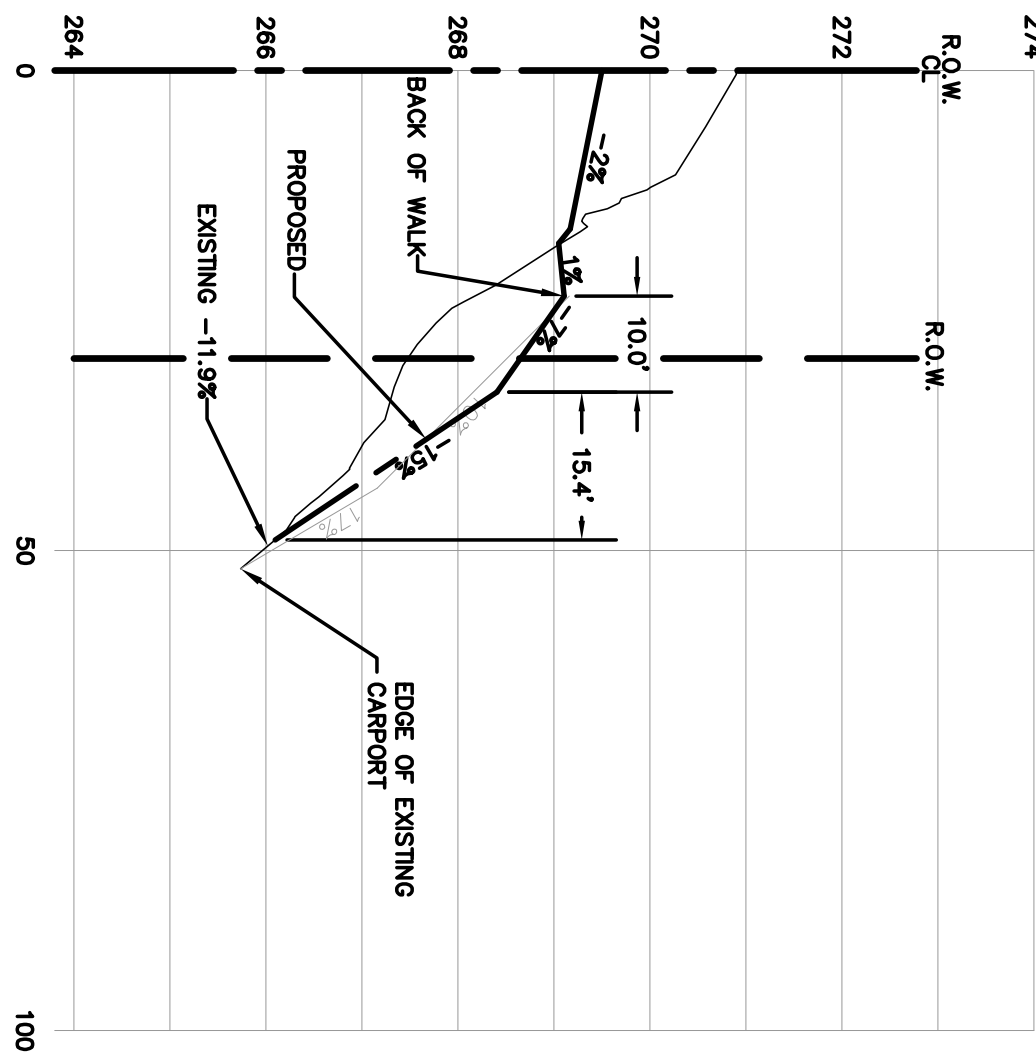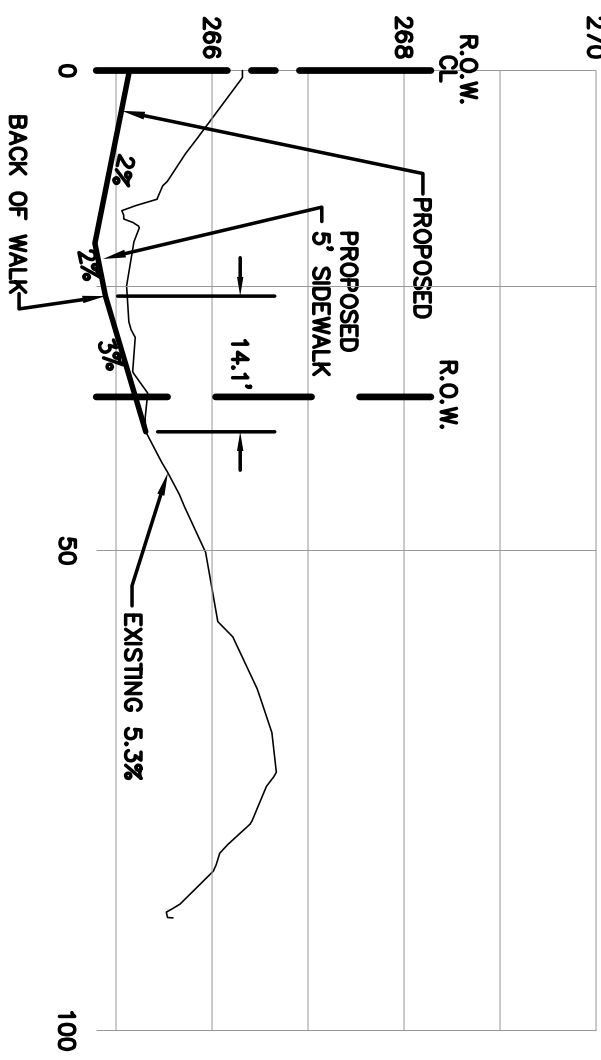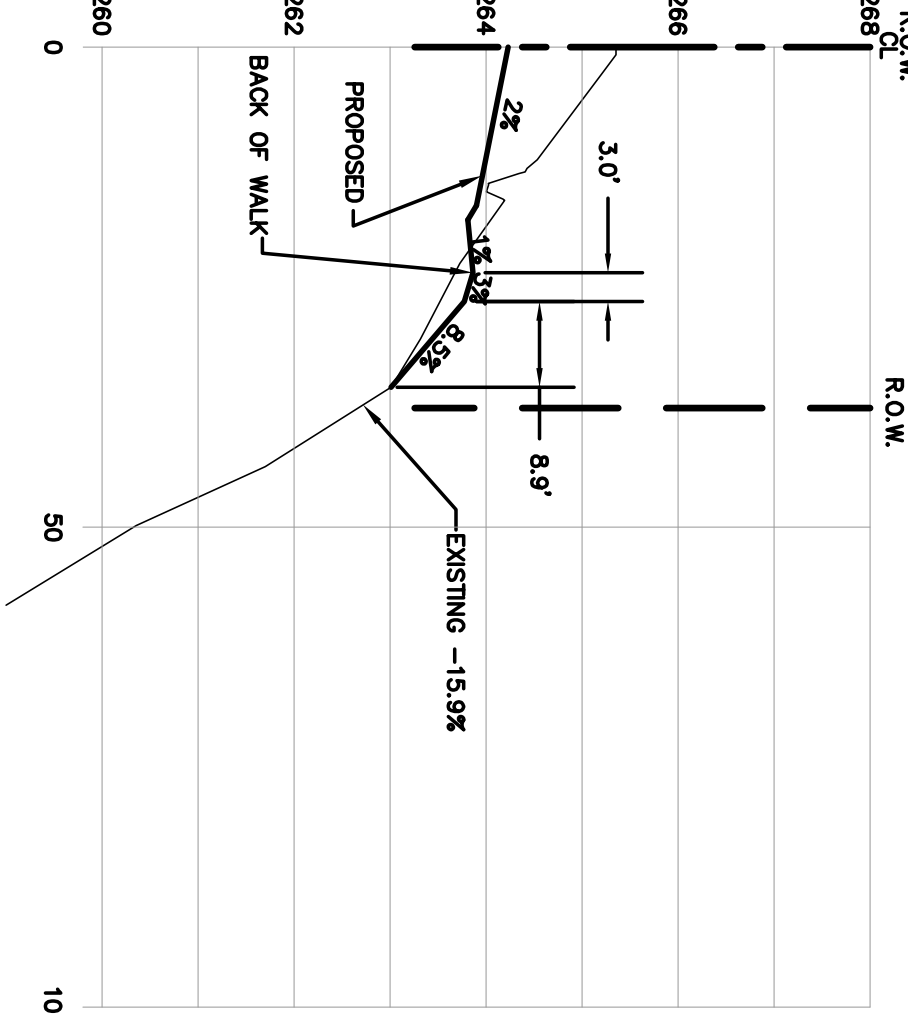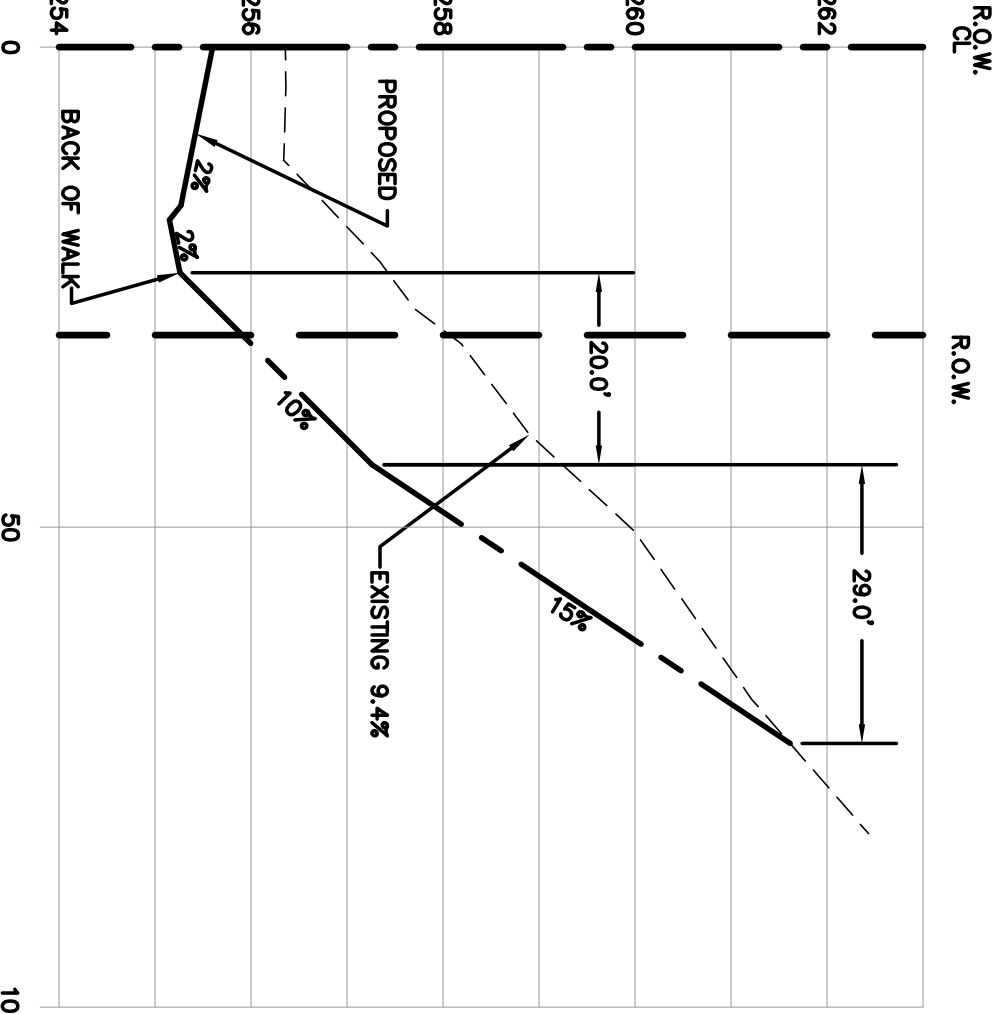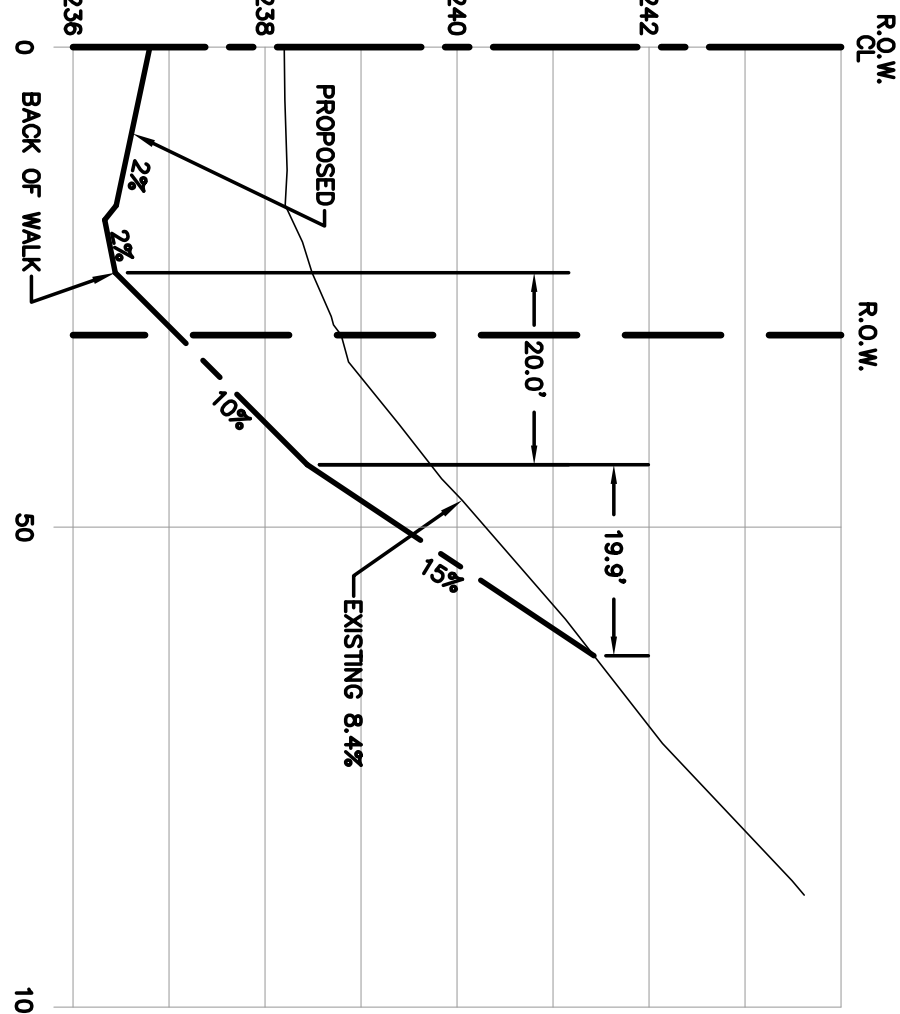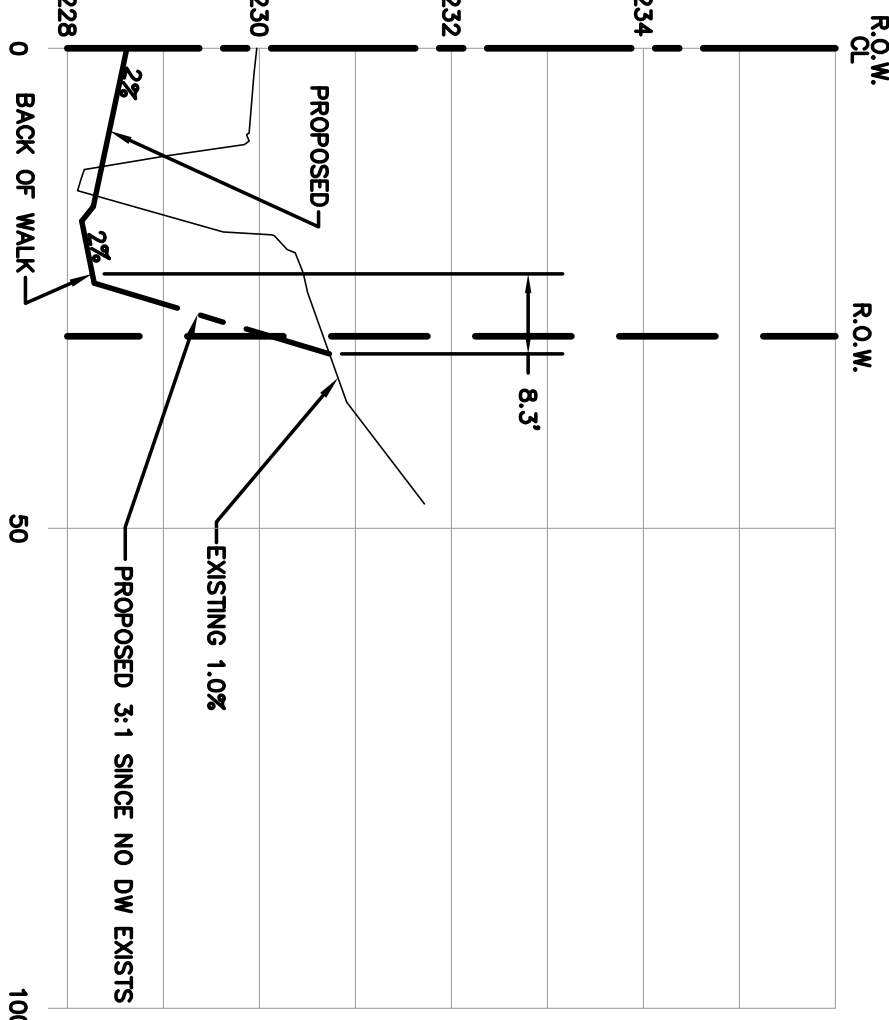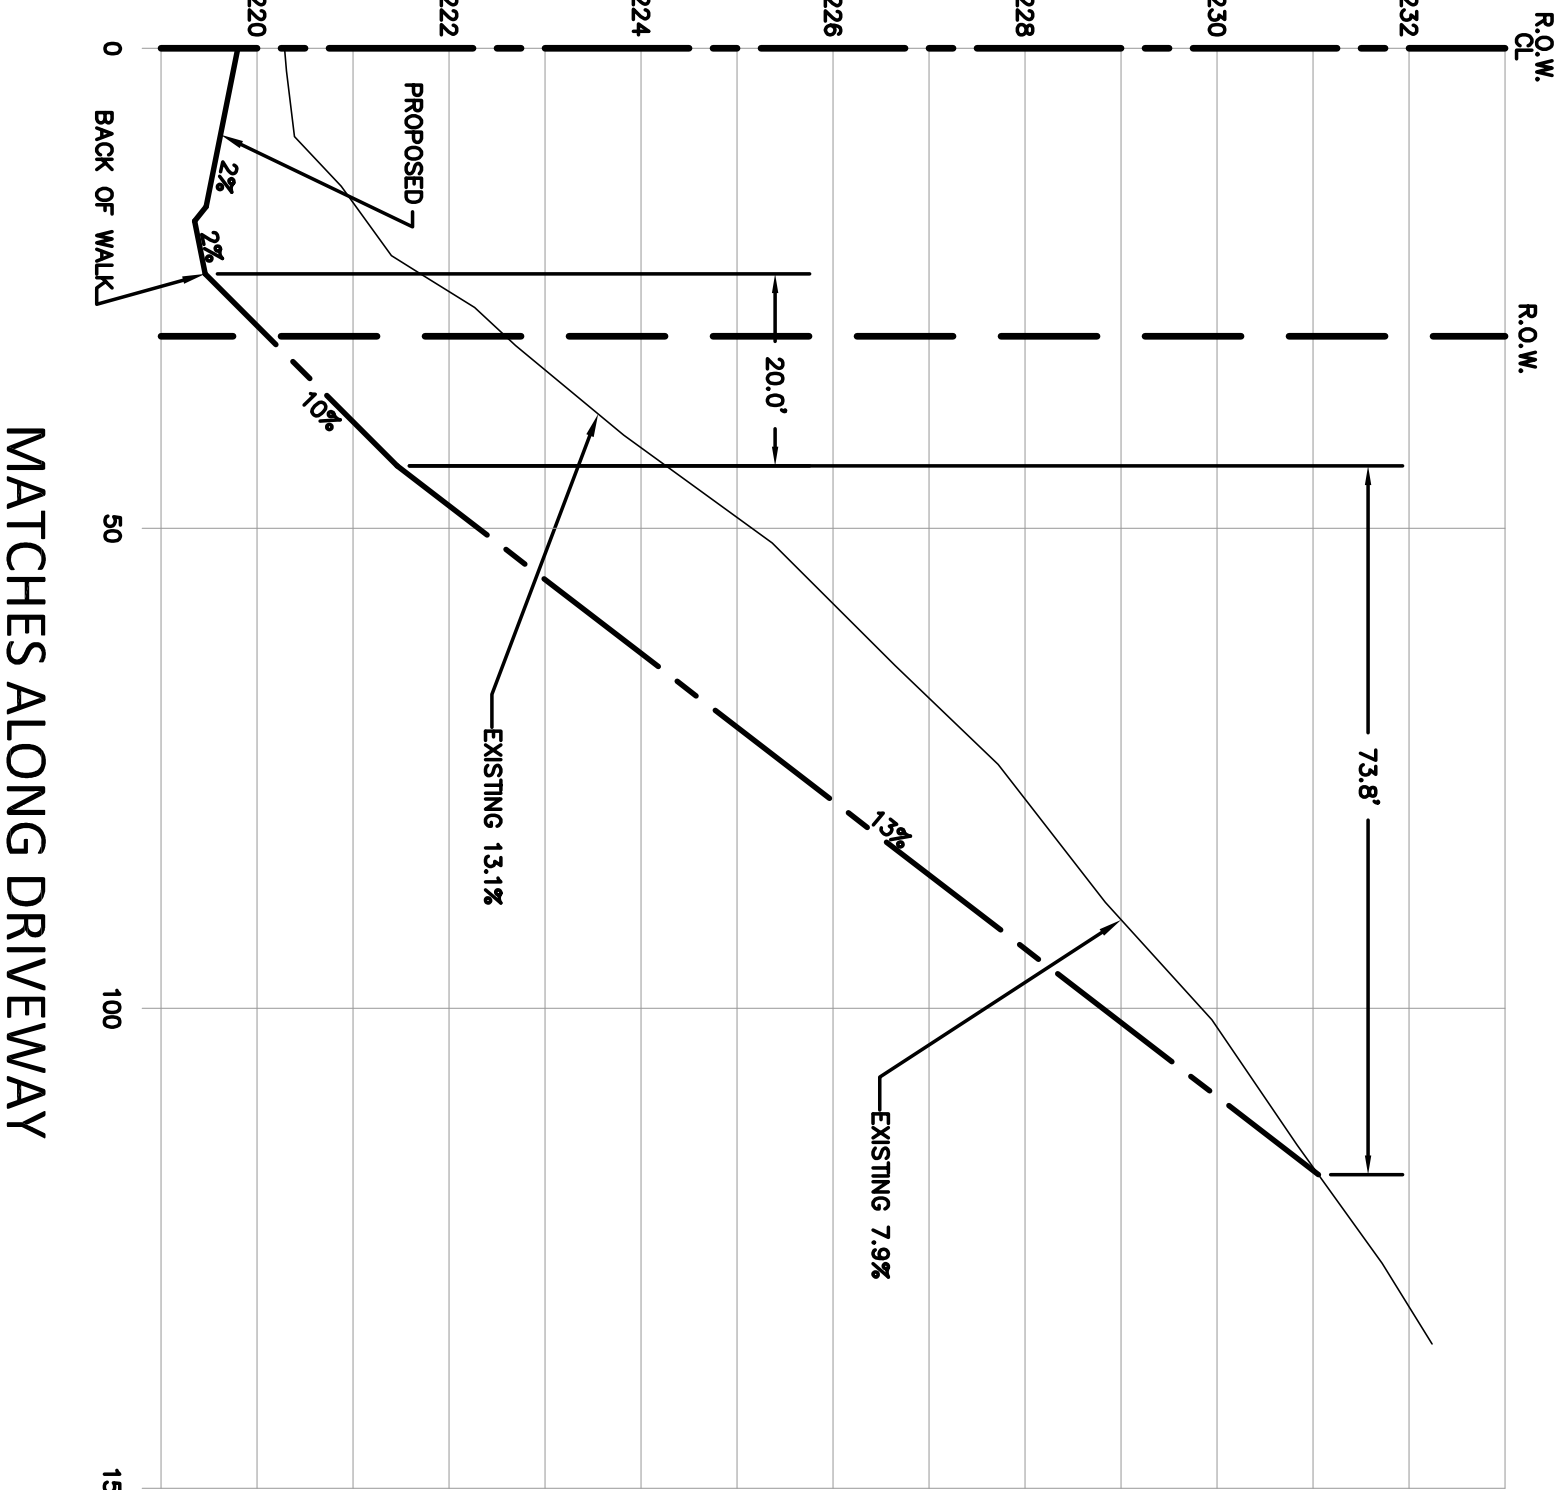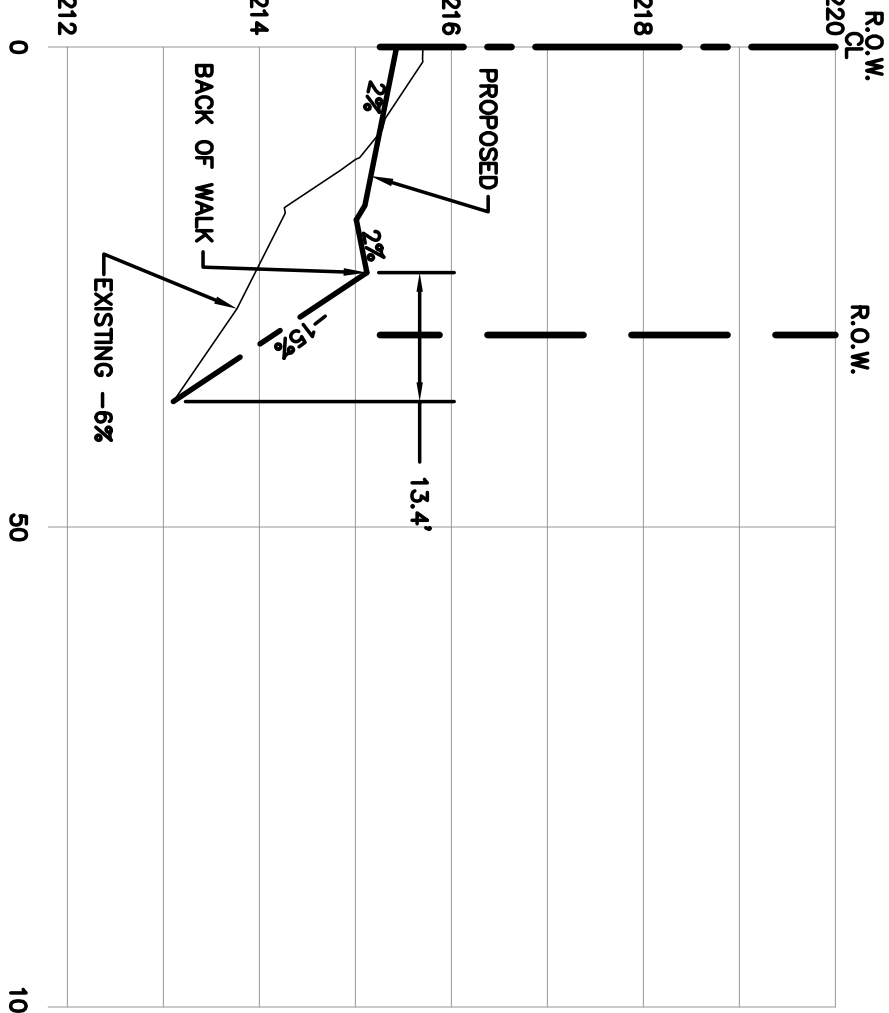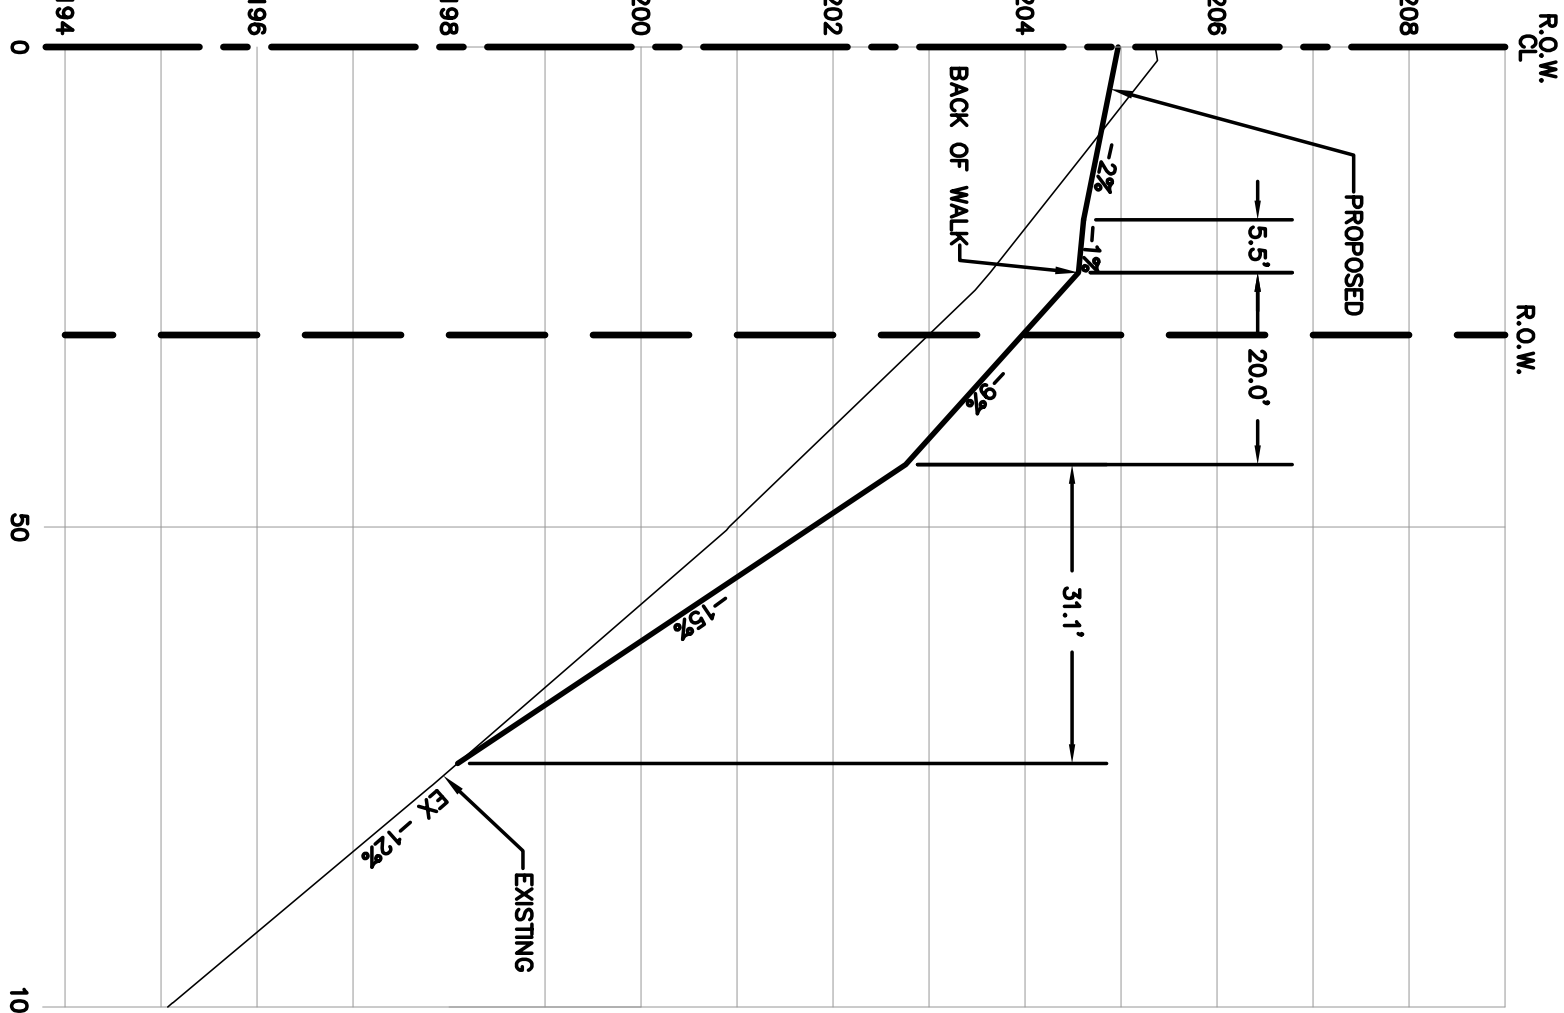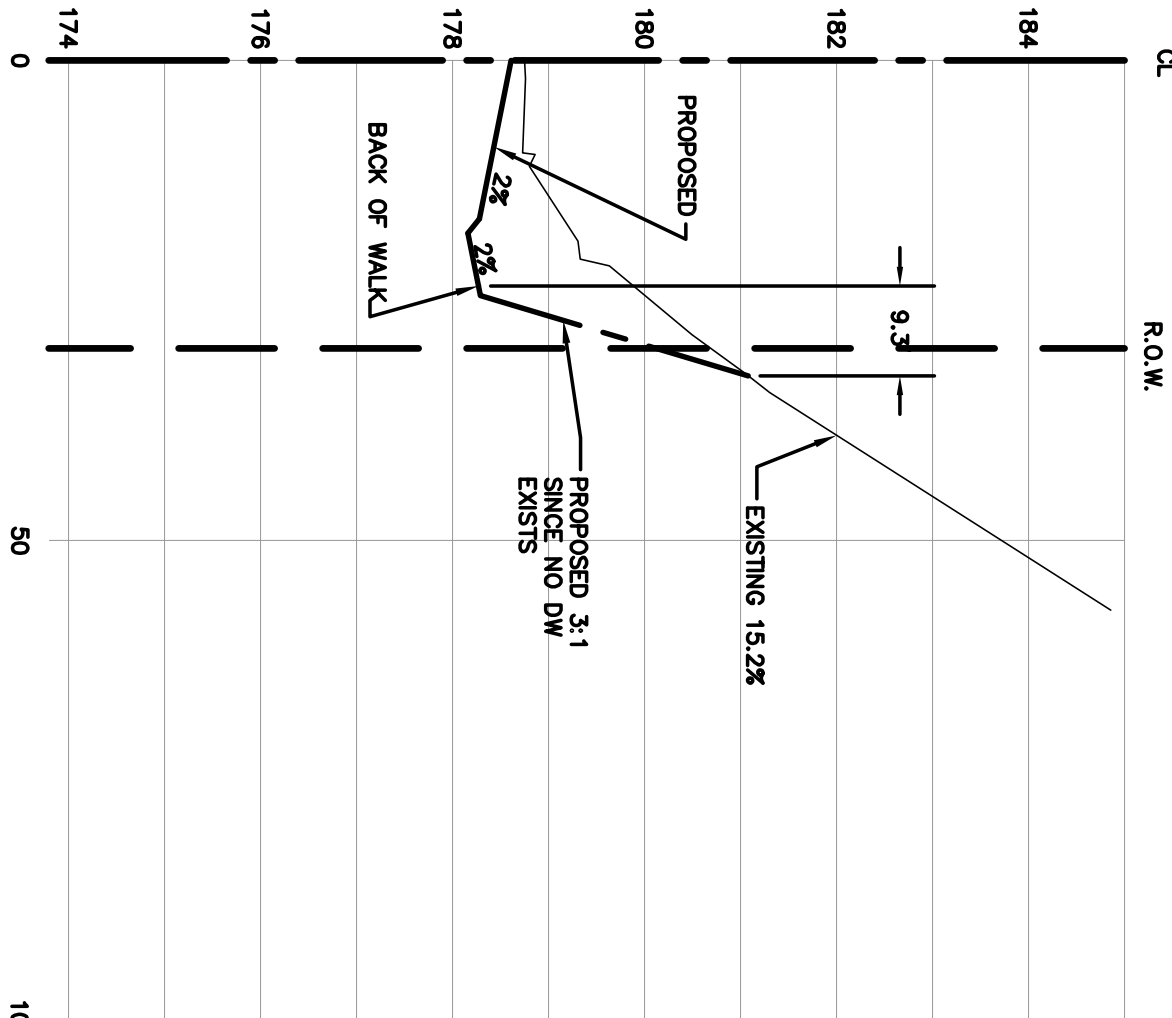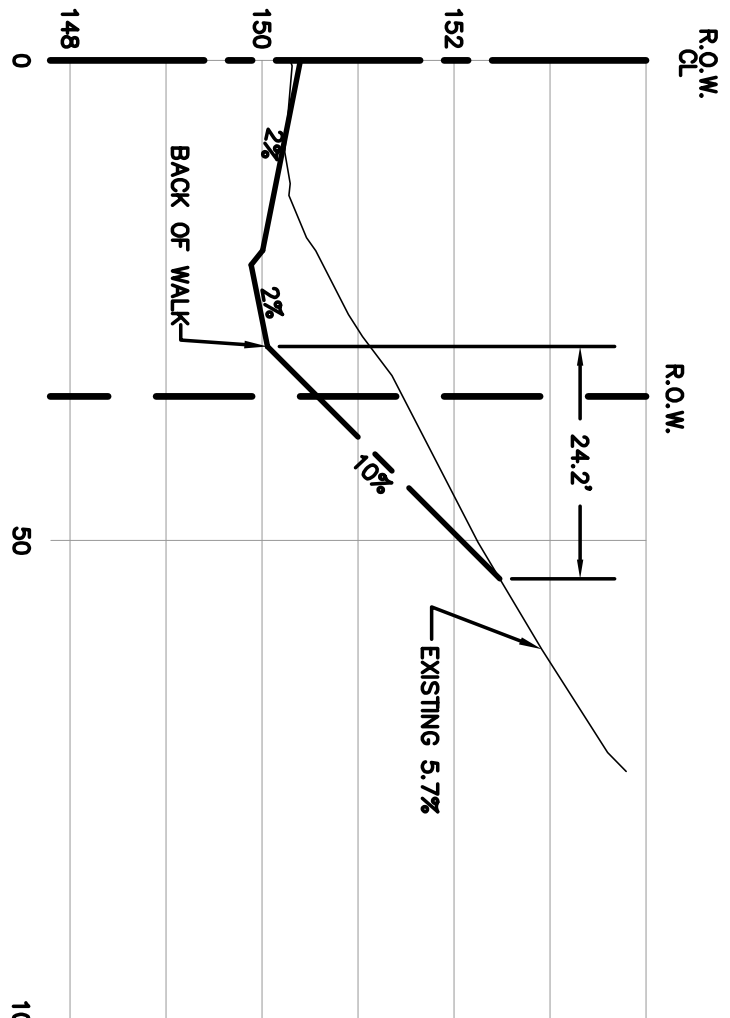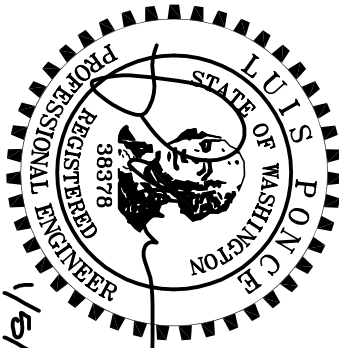


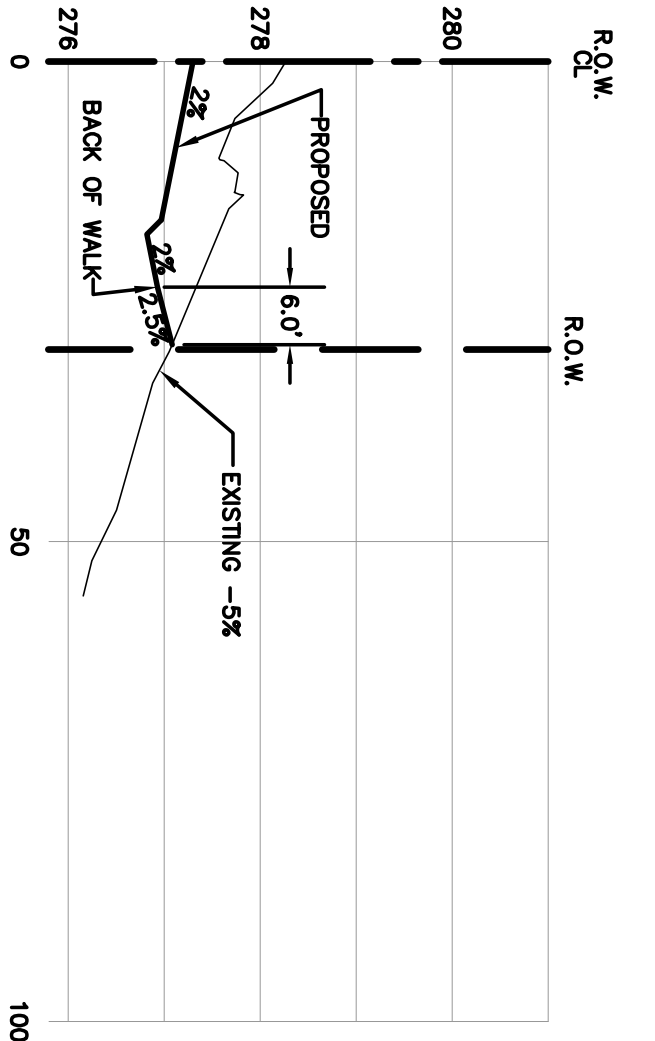


MATCHES ALONG DRIVEWAY
STATION 17+83, RT

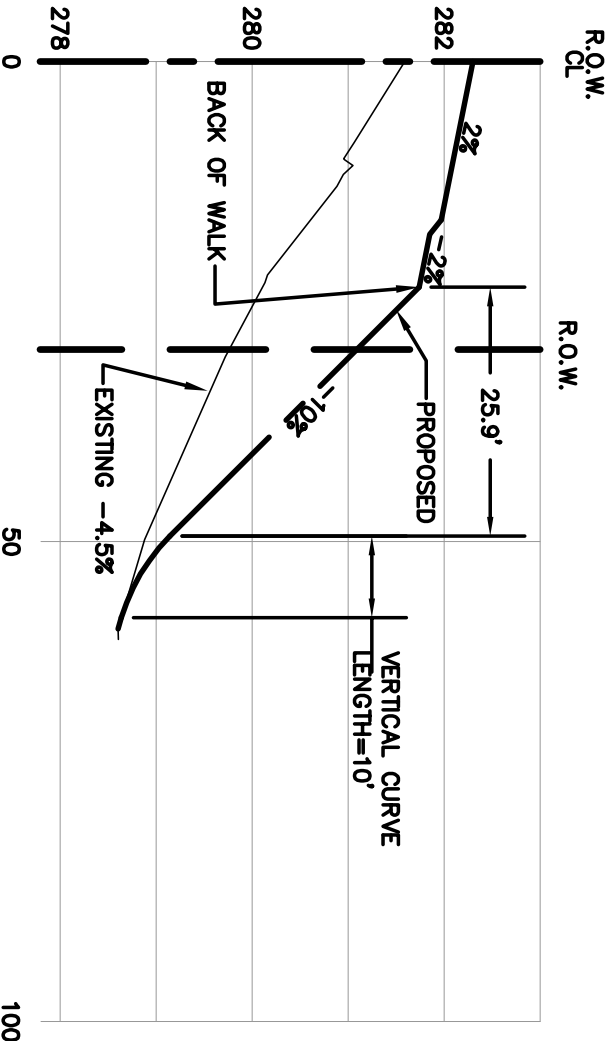


MATCHES ALONG DRIVEWAY
STATION 18+71, RT

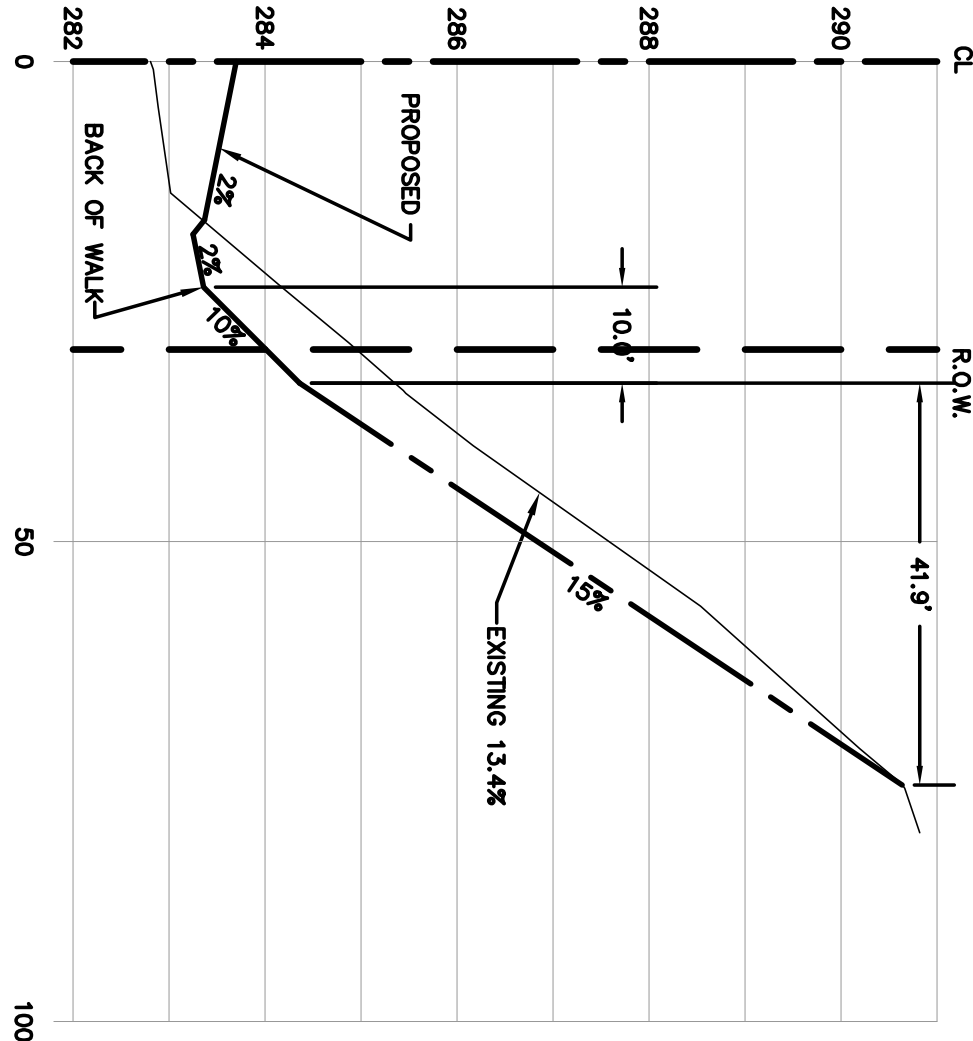


MATCHES ALONG DRIVEWAY
STATION 19+04, LT

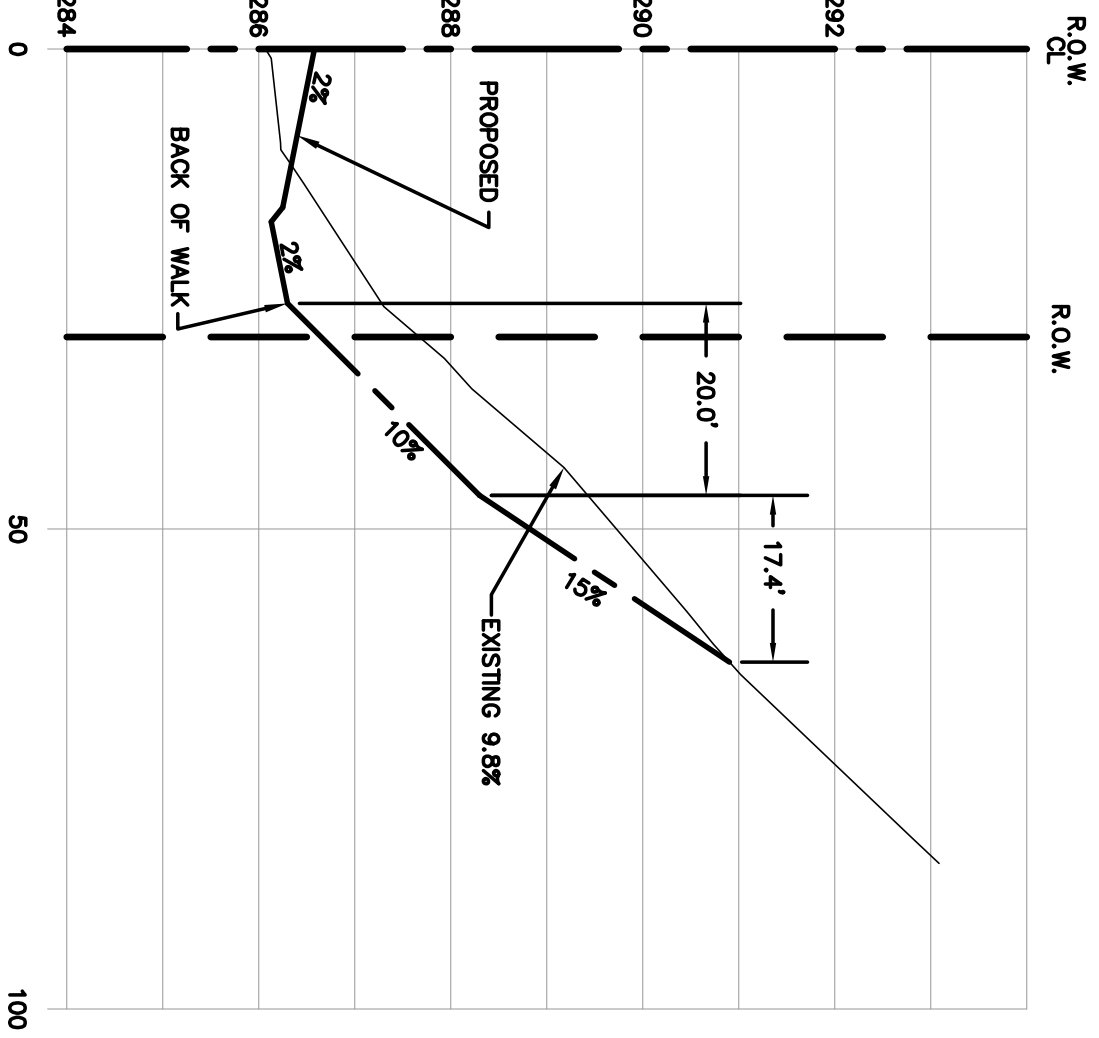


MATCHES ALONG DRIVEWAY
STATION 19+97, LT

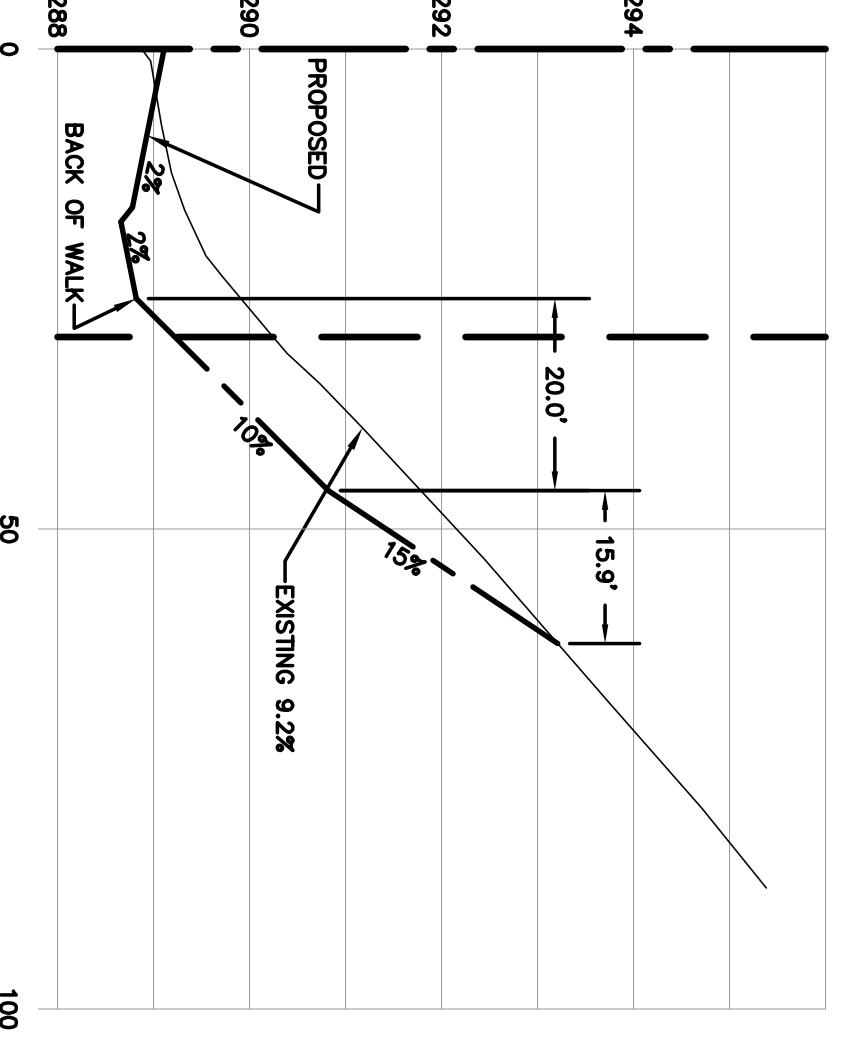


MATCHES ALONG DRIVEWAY
STATION 21+36, LT

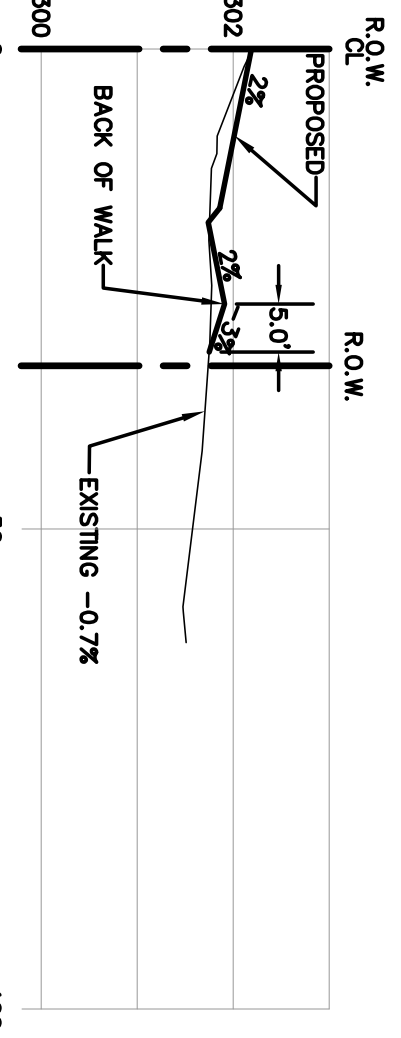


MATCHES ALONG DRIVEWAY
STATION 24+83, RT

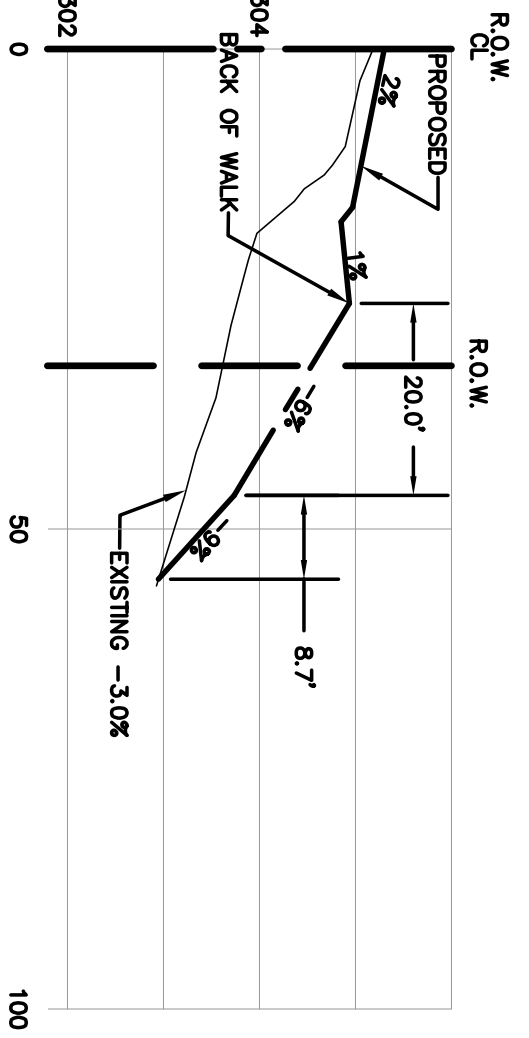


MATCHES ALONG DRIVEWAY
STATION 25+91, RT

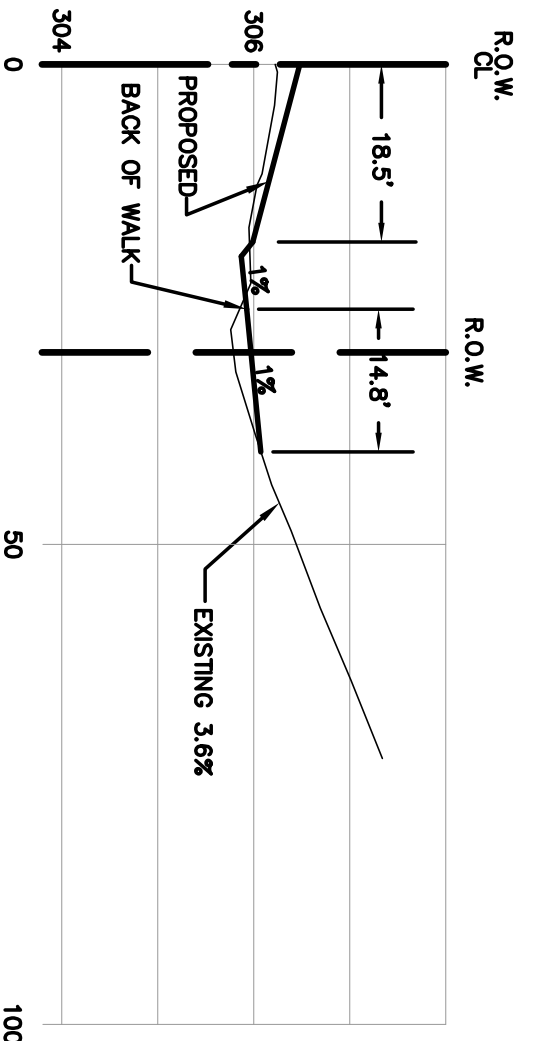


MATCHES ALONG DRIVEWAY
STATION 26+41, LT

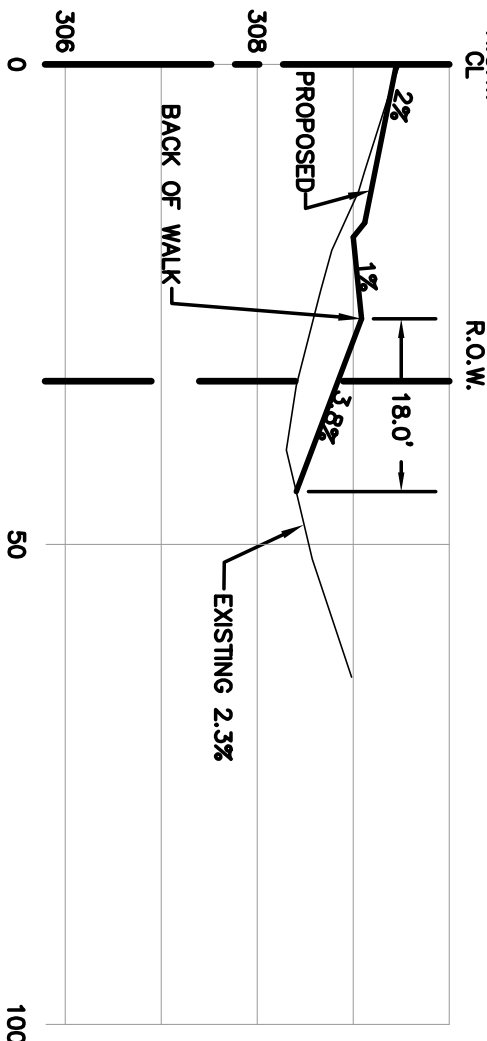


MATCHES ALONG DRIVEWAY
STATION 28+09, RT

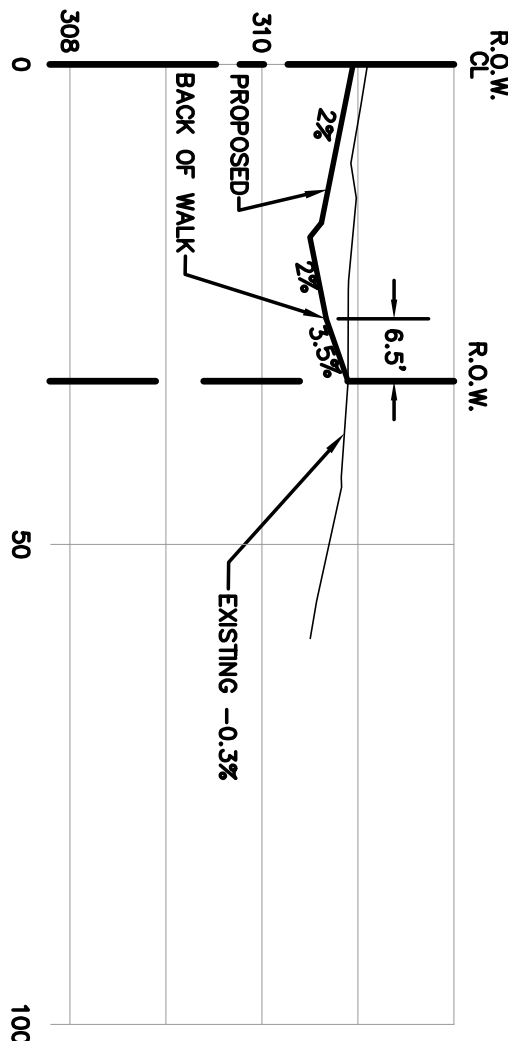


MATCHES ALONG DRIVEWAY
STATION 29+18, RT

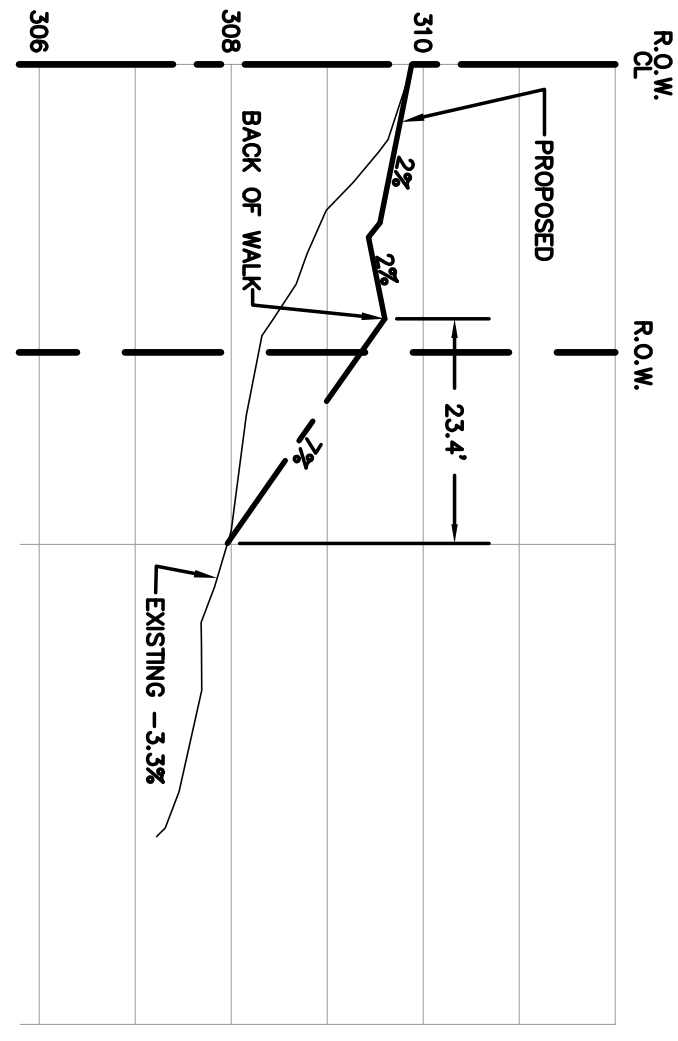


MATCHES ALONG DRIVEWAY
STATION 30+95, RT

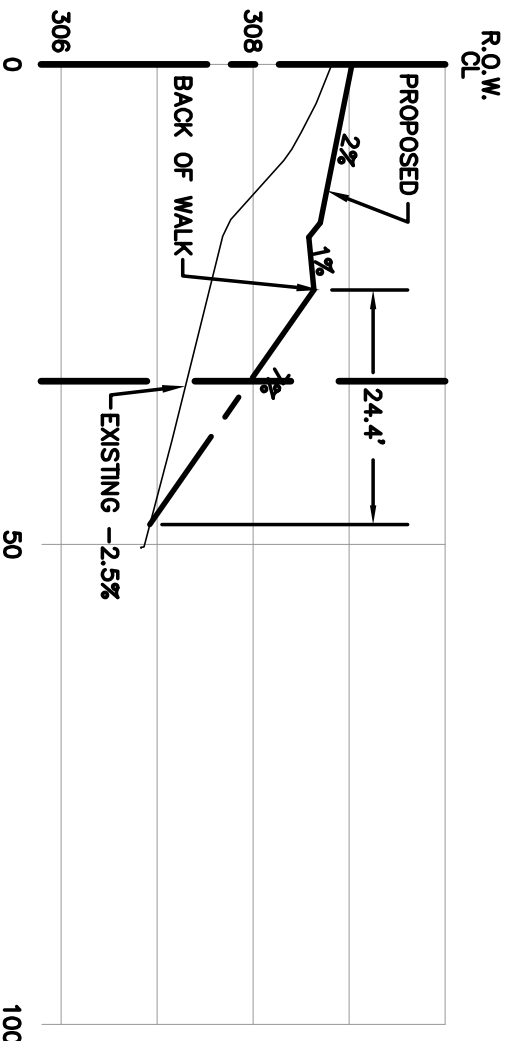


MATCHES ALONG DRIVEWAY
STATION 32+18, RT

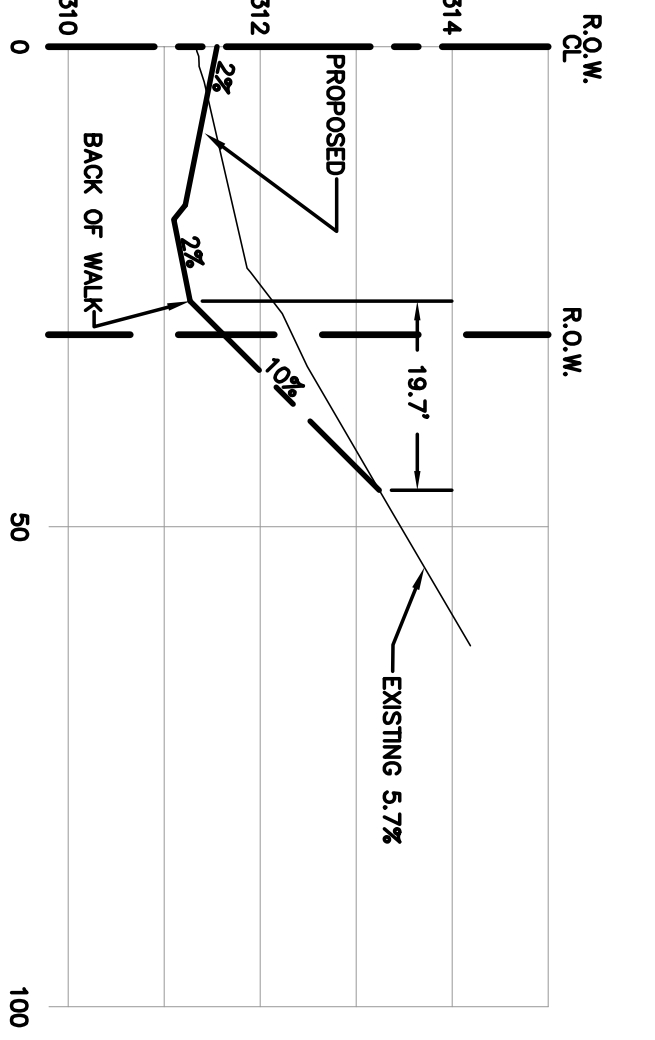


MATCHES ALONG DRIVEWAY
STATION 33+75, LT

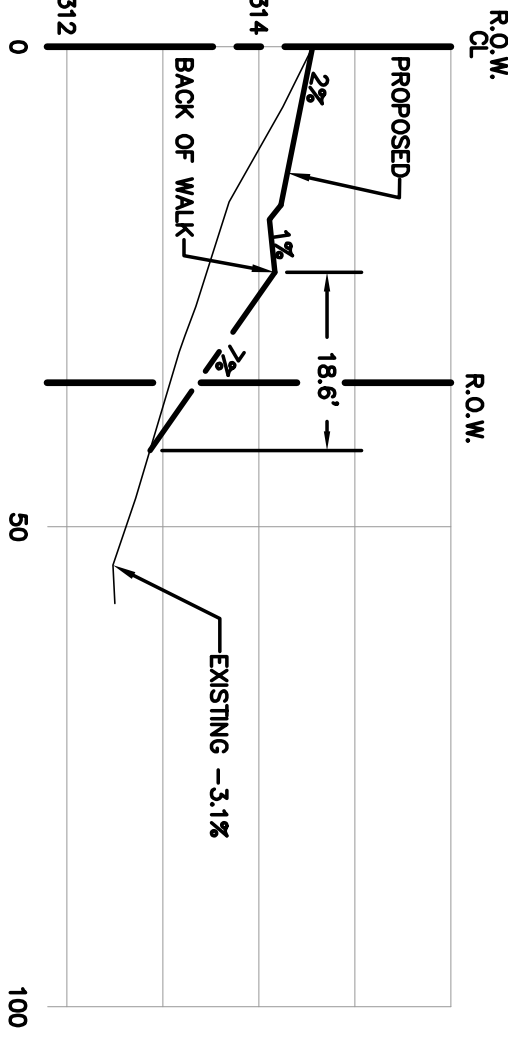


MATCHES ALONG DRIVEWAY
STATION 35+09, RT

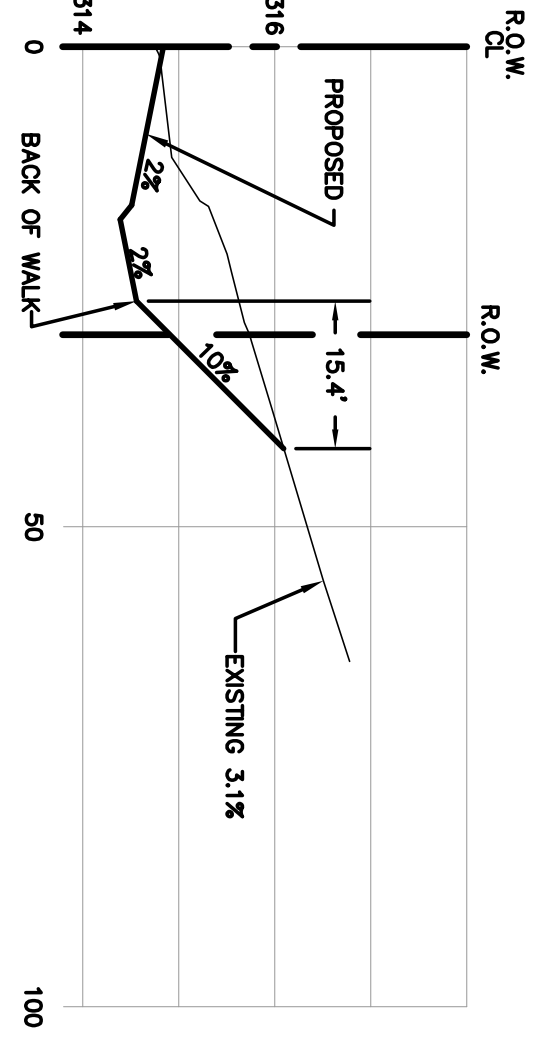


MATCHES ALONG DRIVEWAY
STATION 35+22, LT

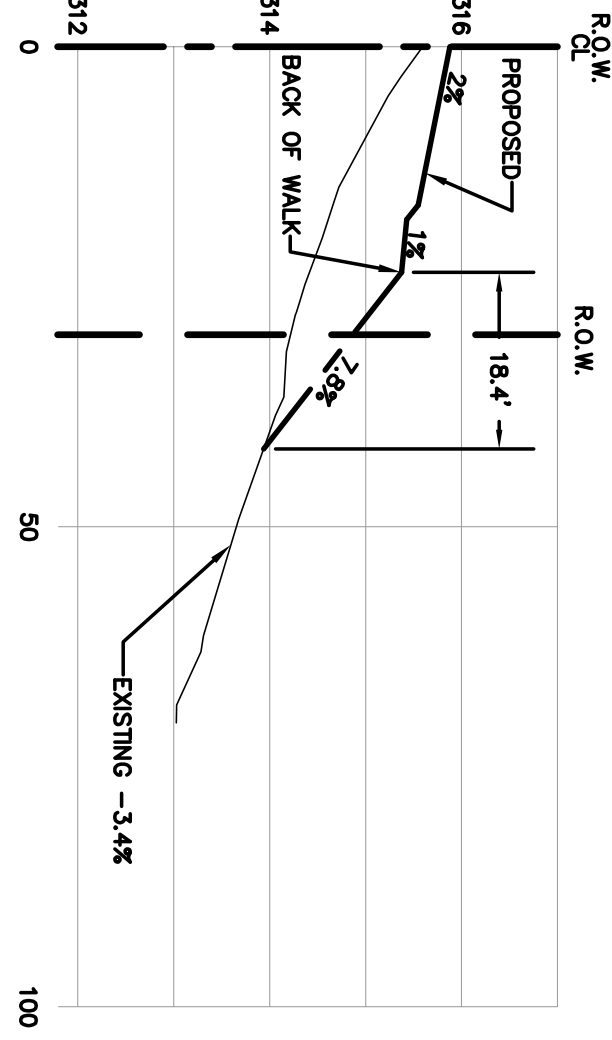


MATCHES ALONG DRIVEWAY
STATION 35+68, RT

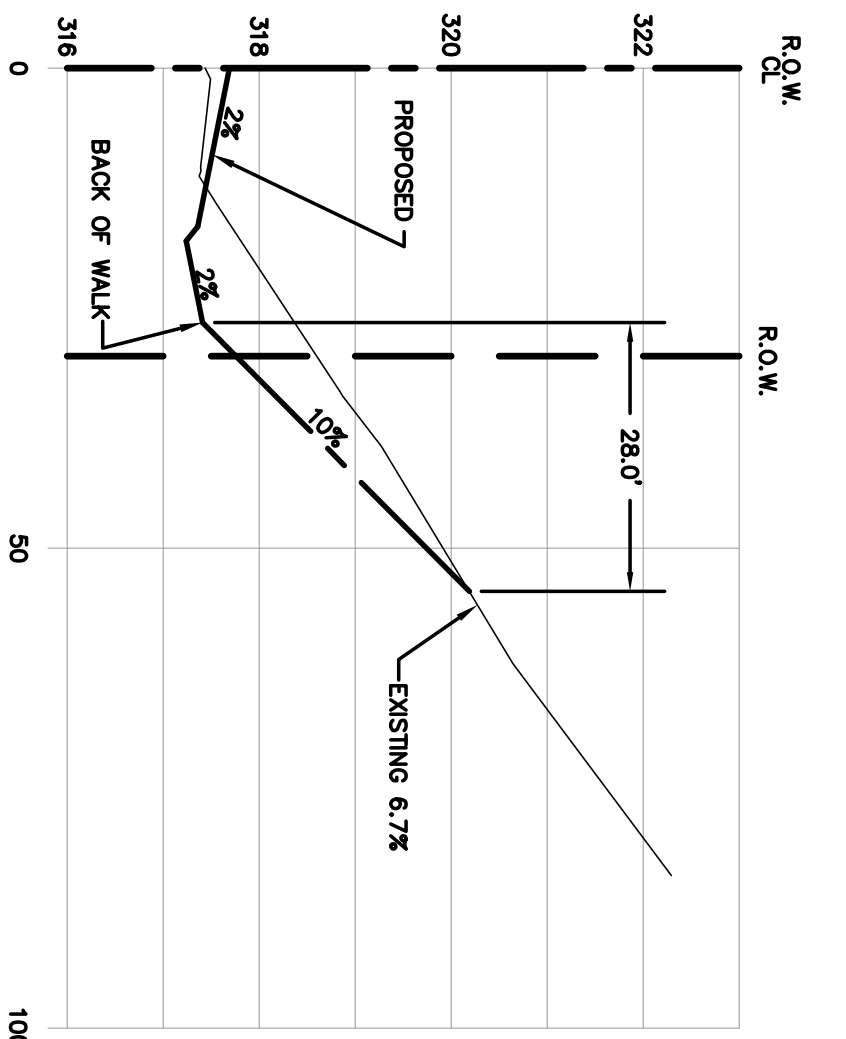

MATCHES ALONG DRIVEWAY
STATION 36+28, LT

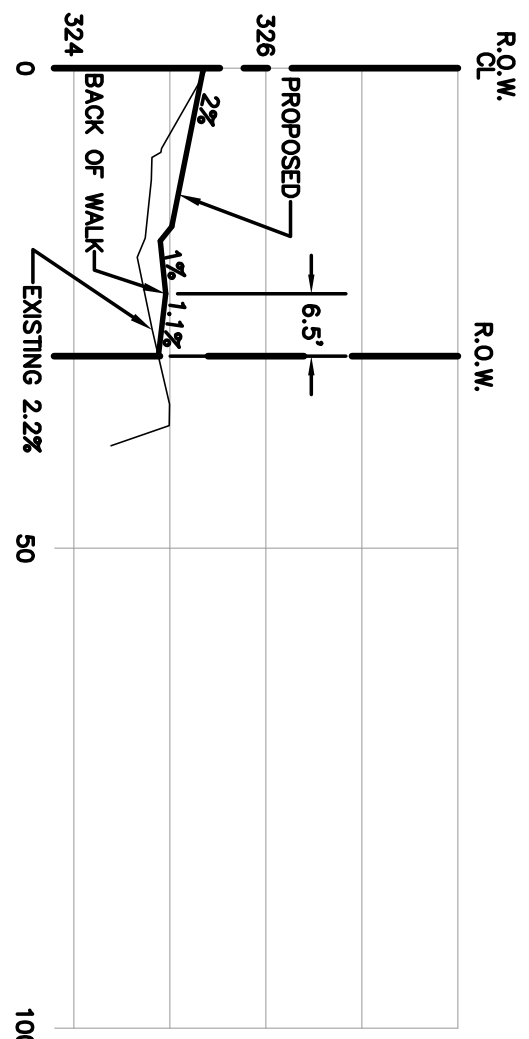

MATCHES ALONG DRIVEWAY
STATION 38+14, RT

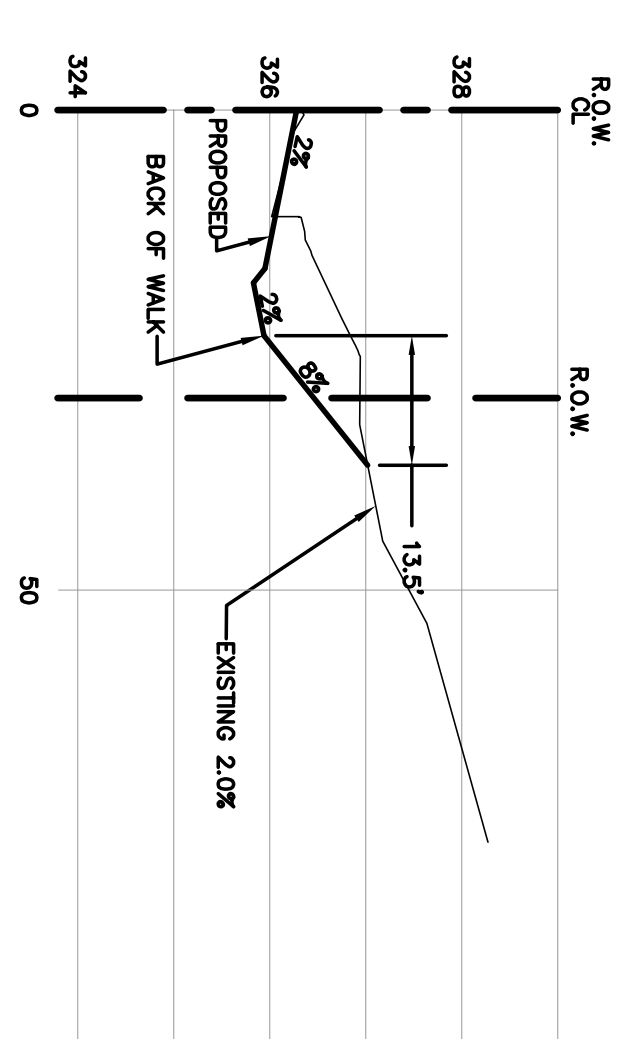


MATCHES ALONG DRIVEWAY
STATION 38+37, LT



1/05/17
AS-BUILT

DESIGNED BY
LP
DRAWN BY
ARS
CHECKED BY
LP

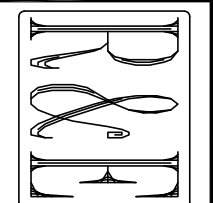

REICHHARDT & EBE
ENGINEERING, INC.
CONSULTING ENGINEERS
PO Box 978 423 Front St., Ste 201
Lynden, Washington 98264
Ph (360) 354-3687
Fax (360) 354-0407

NO.

DATE

REVISION

BY

CITY OF FERNDALE
2095 MAIN STREET
FERNDAL, WA 98248

CHURCH ROAD
STREET IMPROVEMENTS
DRIVEWAY PROFILES

JOB# / DWG
07037








DWY-INT

DATE

1-5-17


SHEET

37 of 64

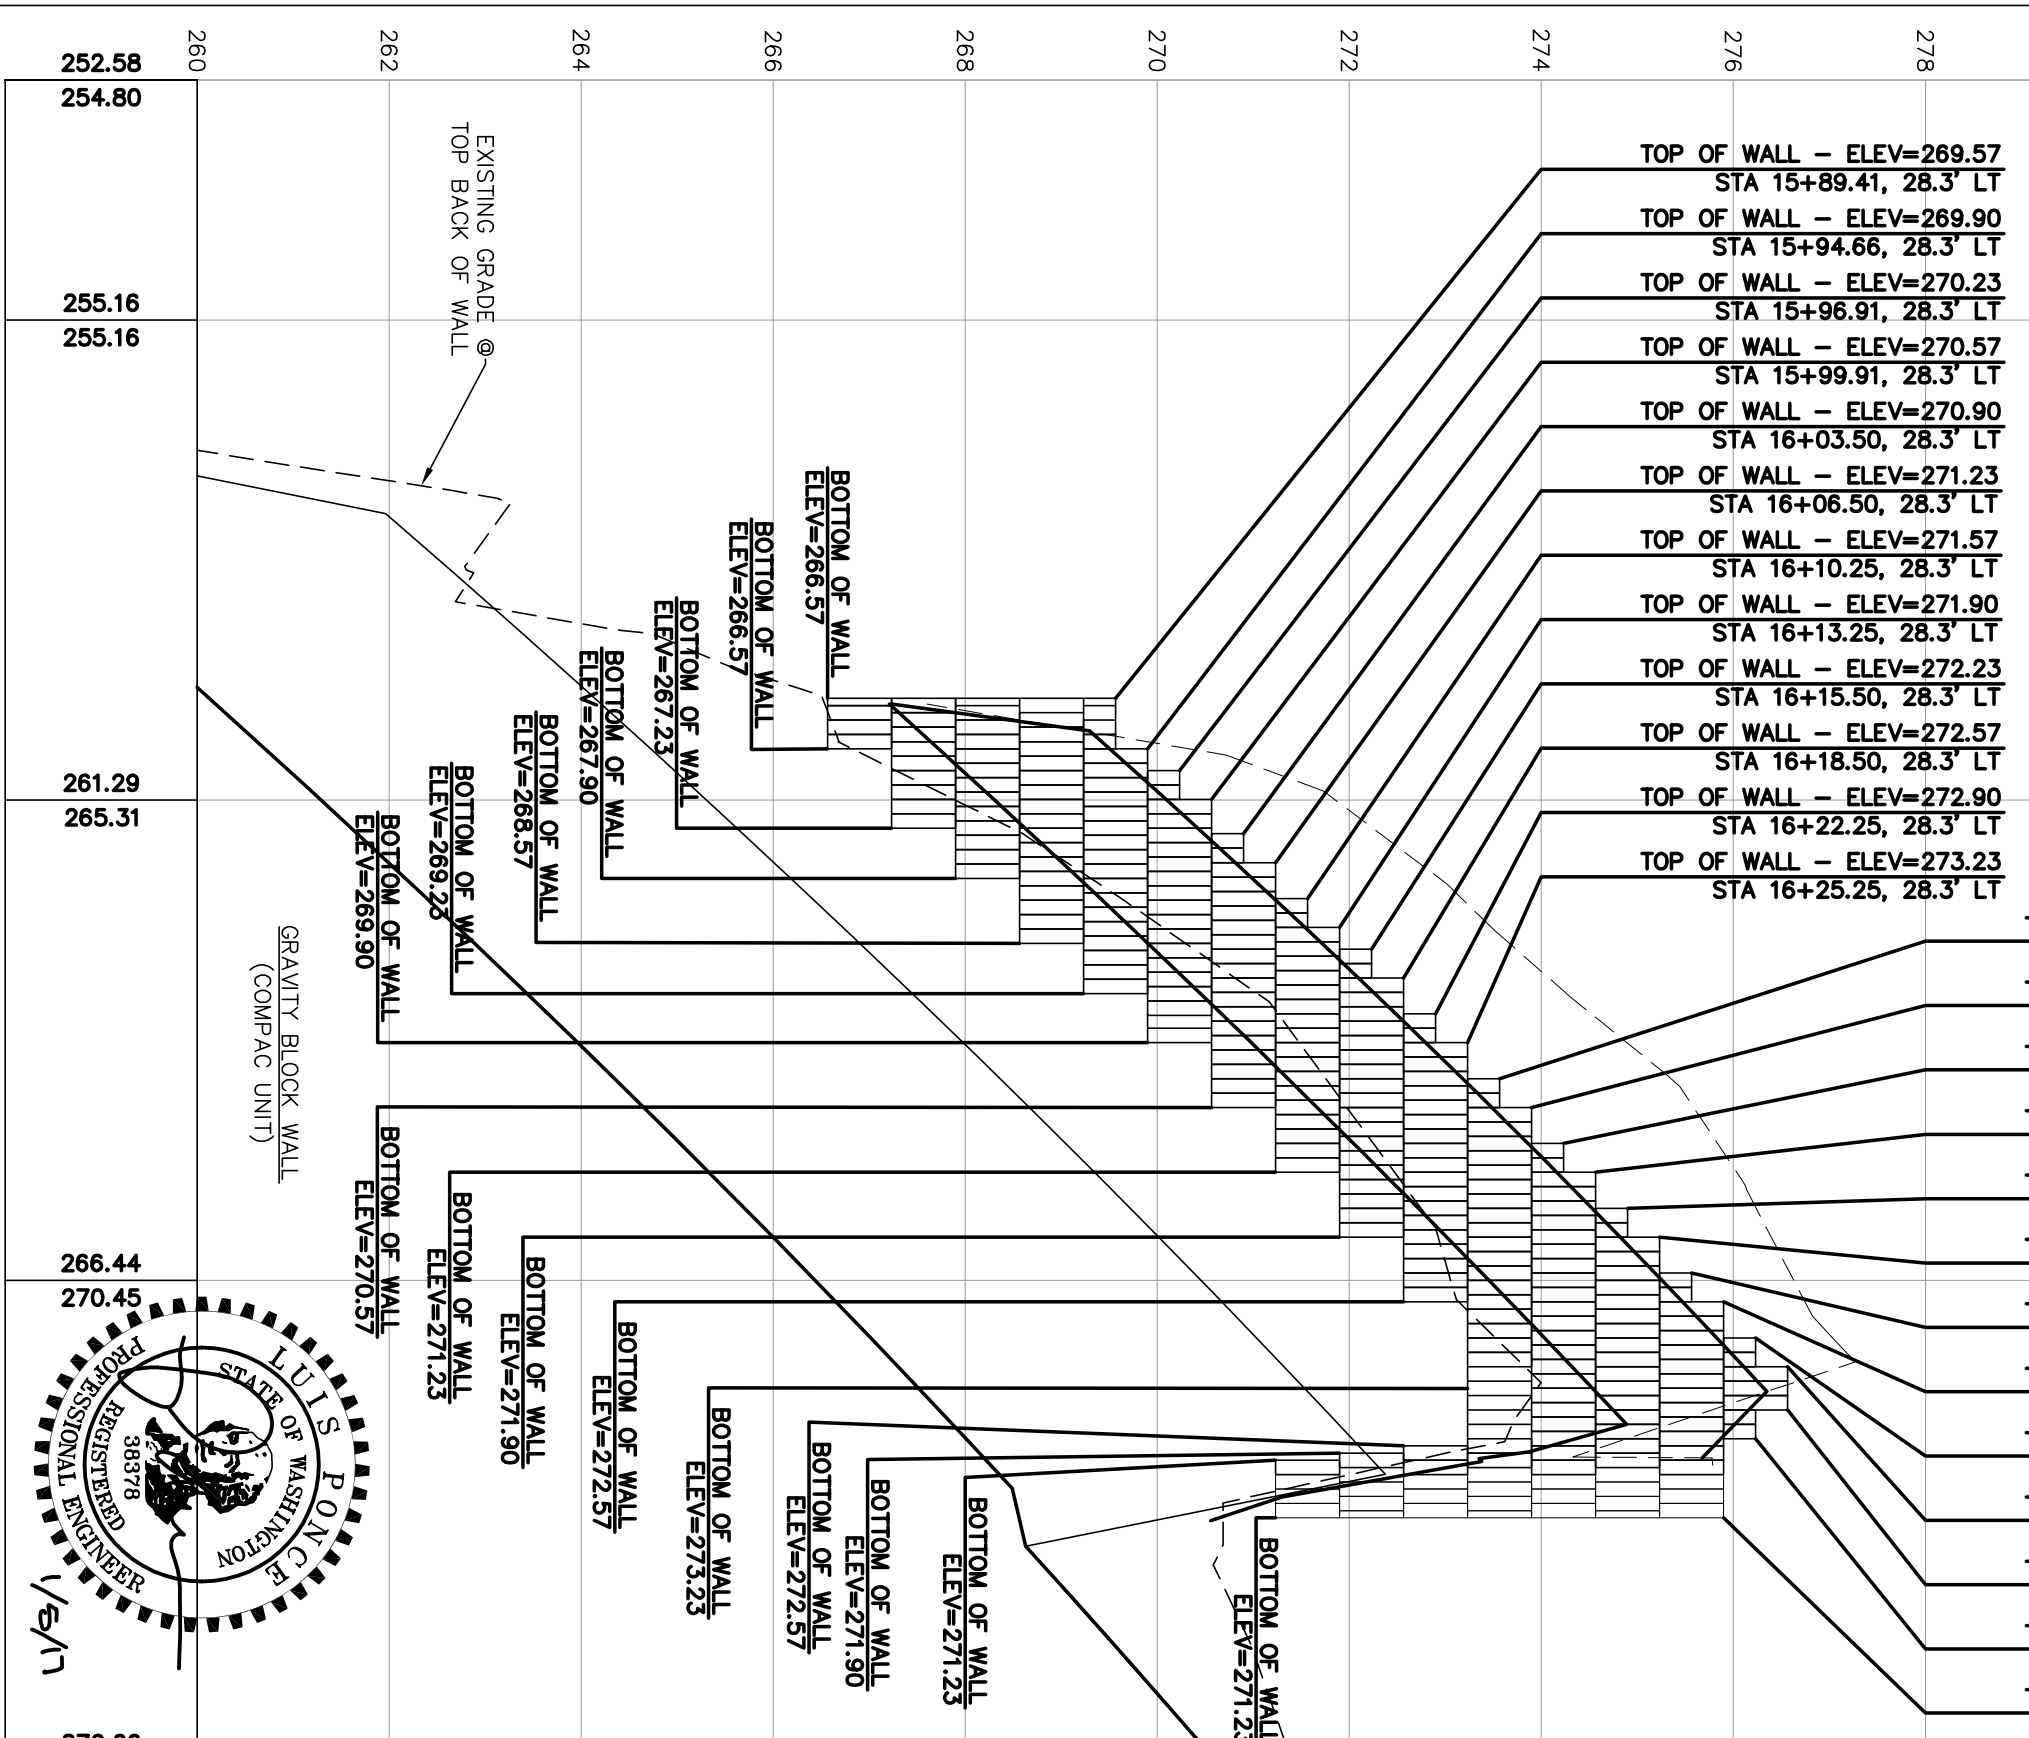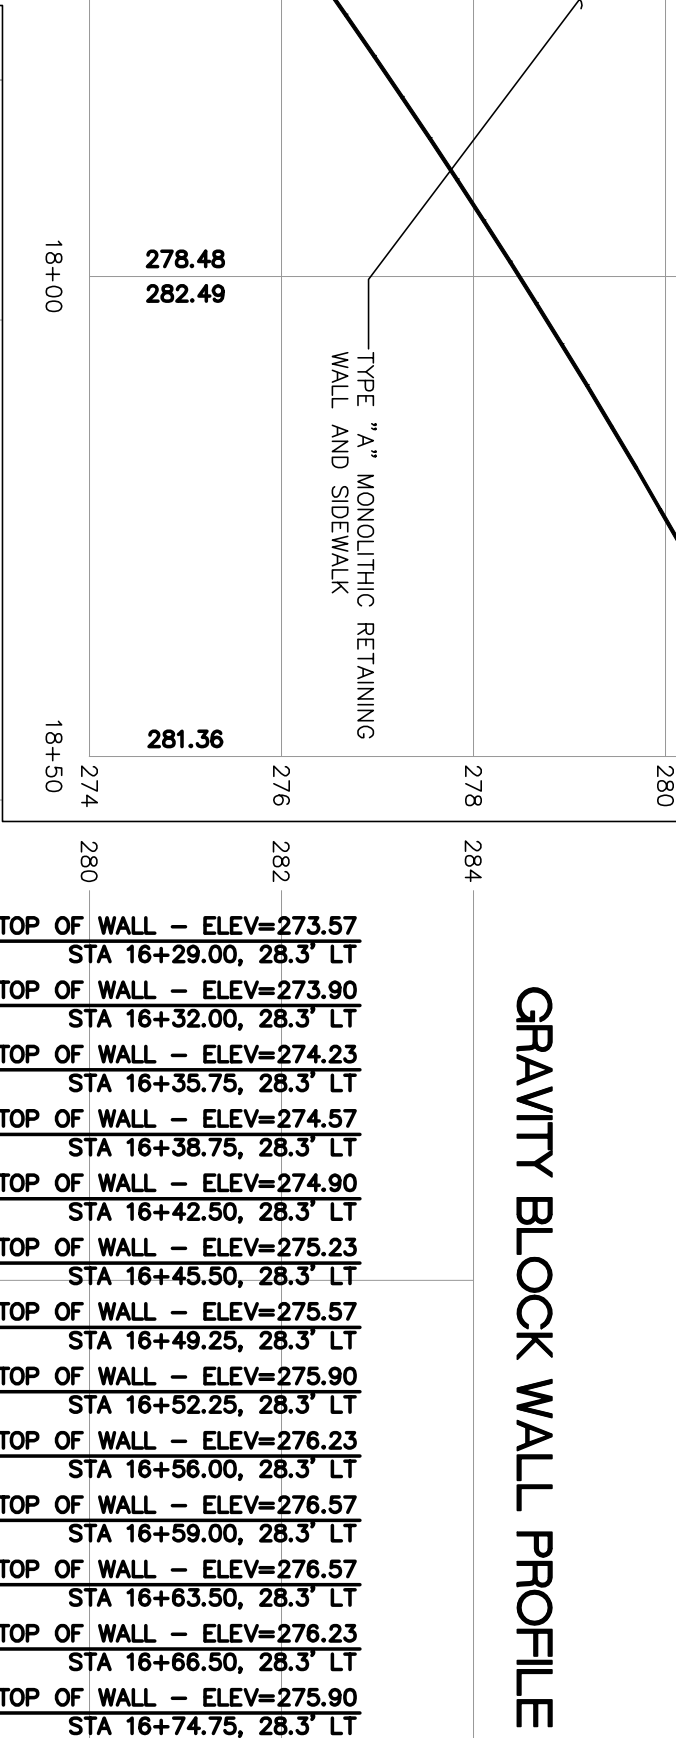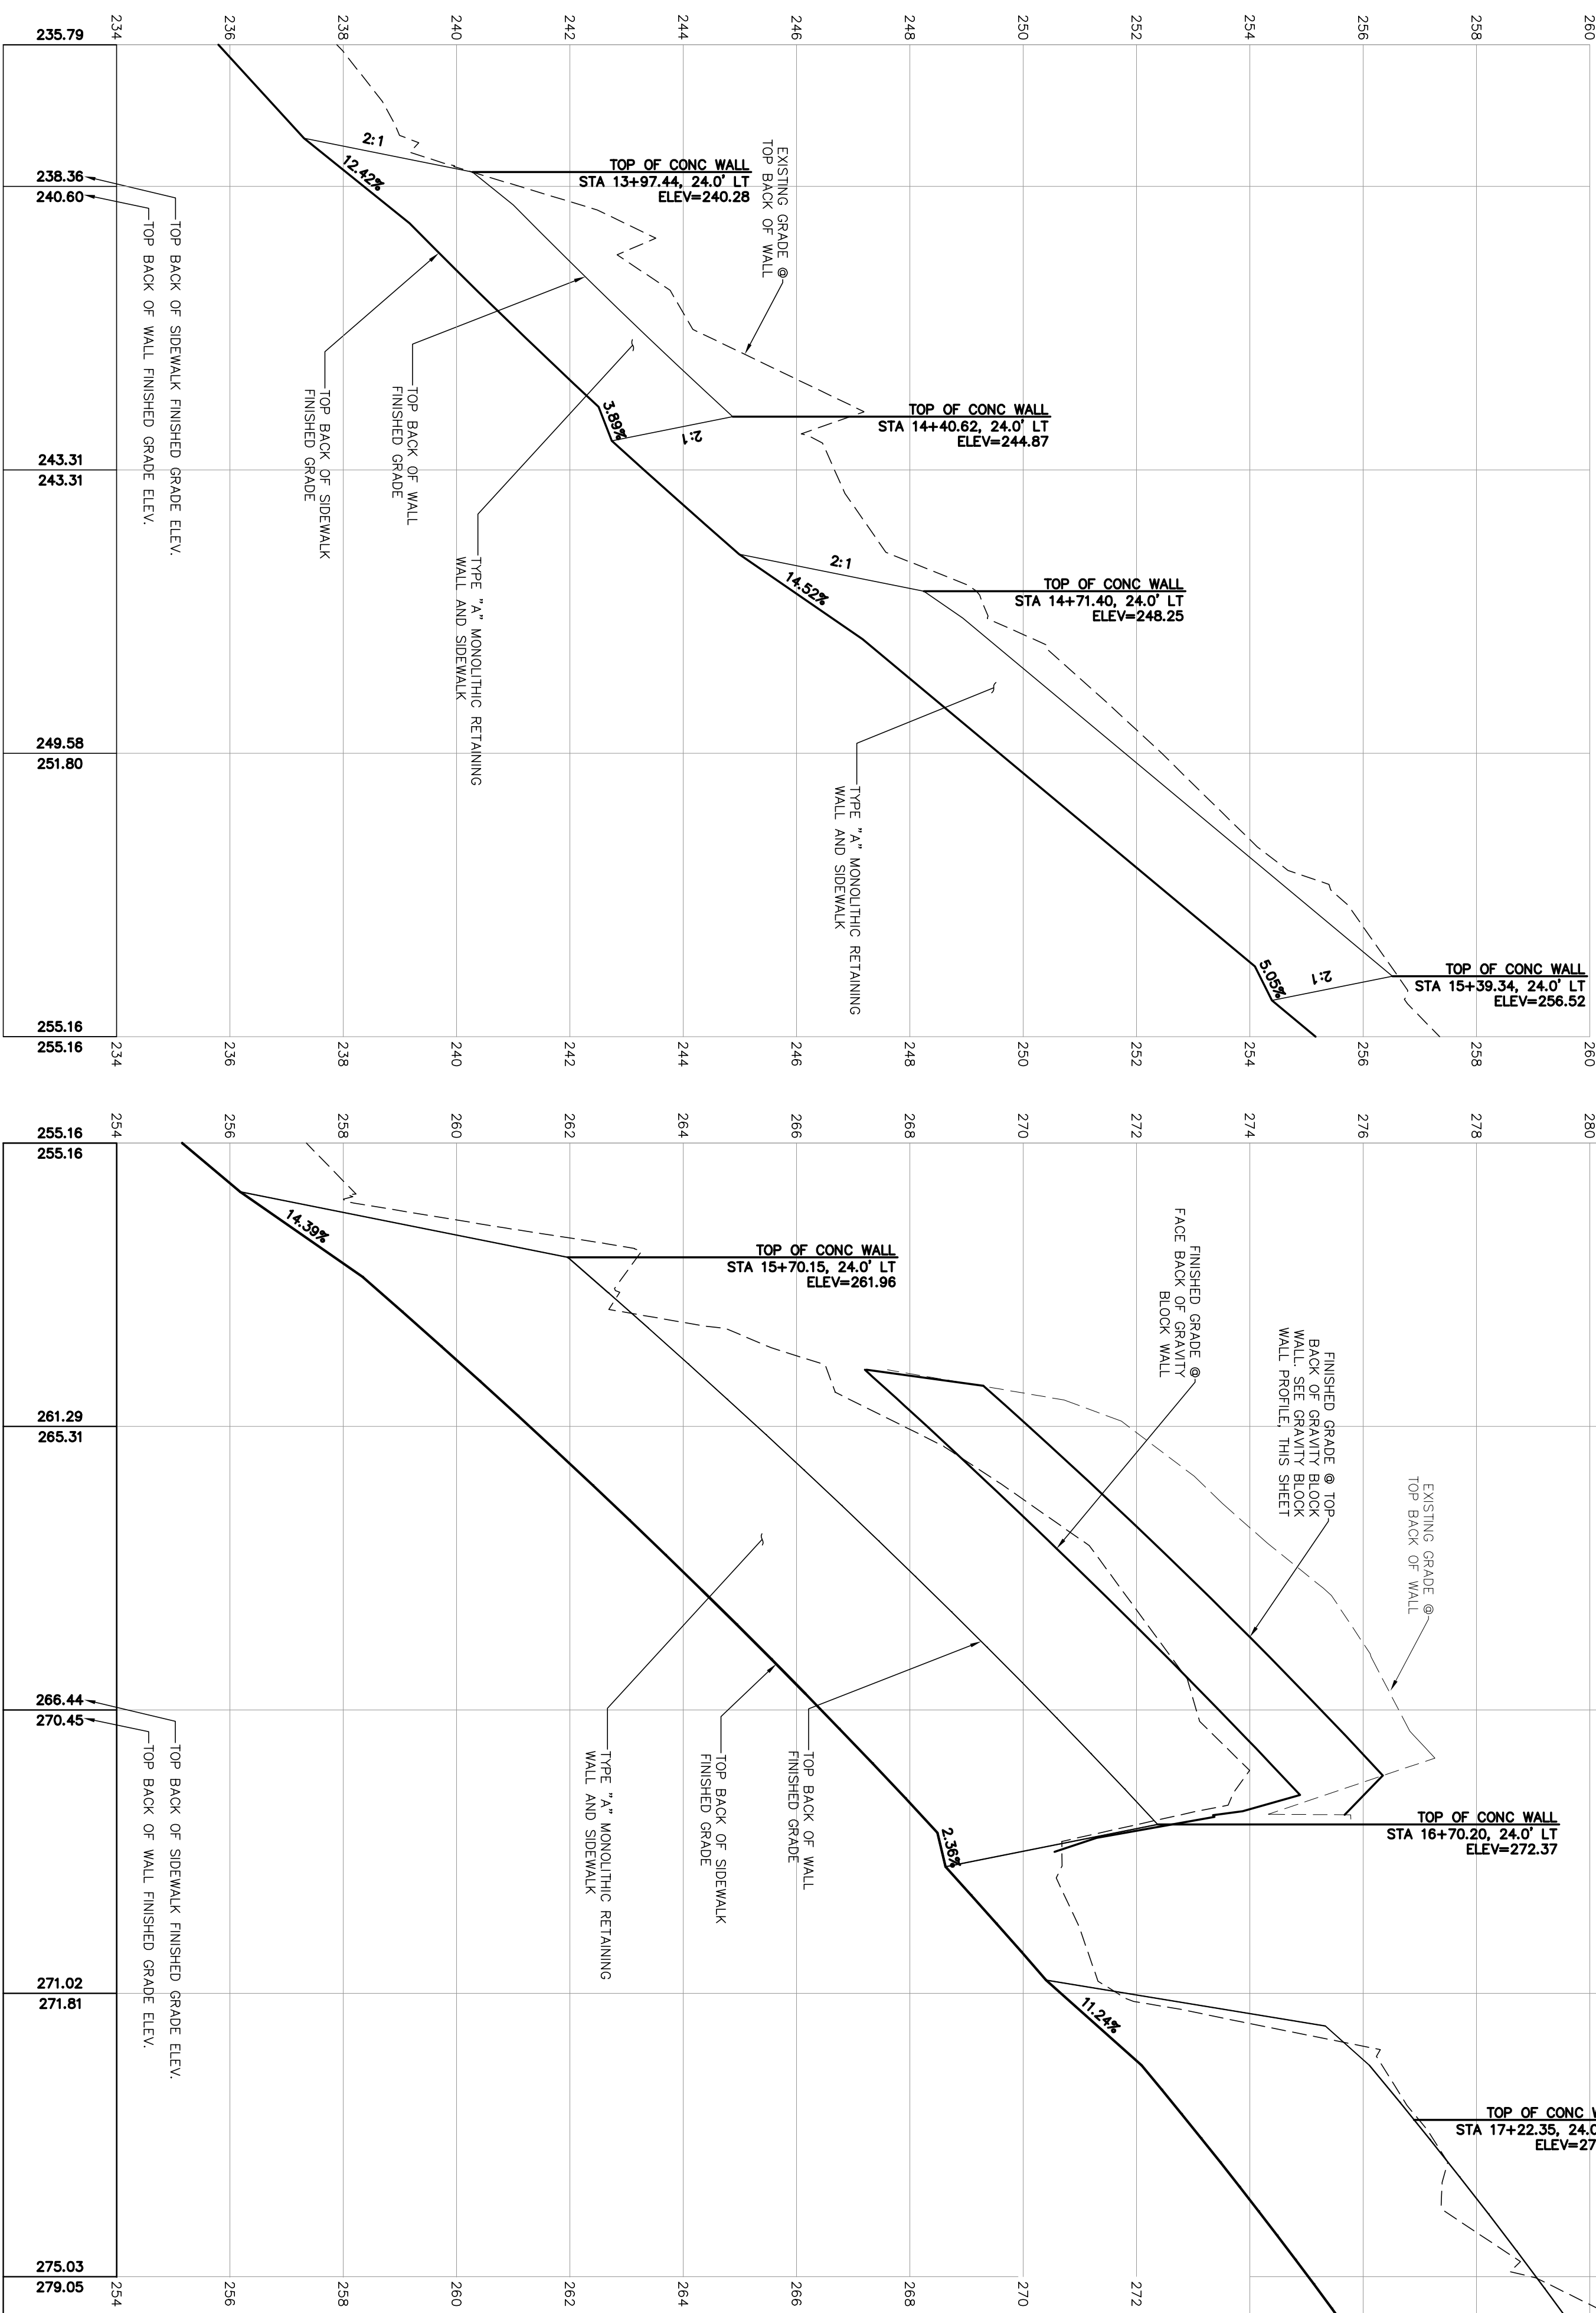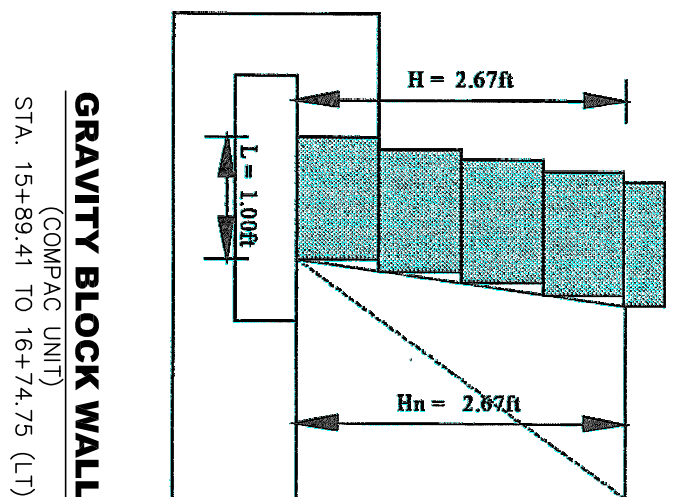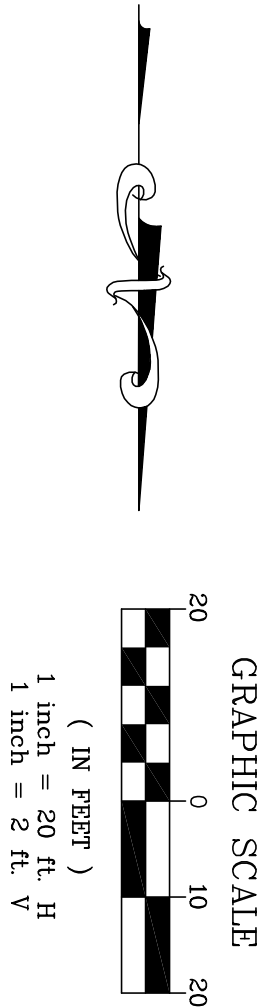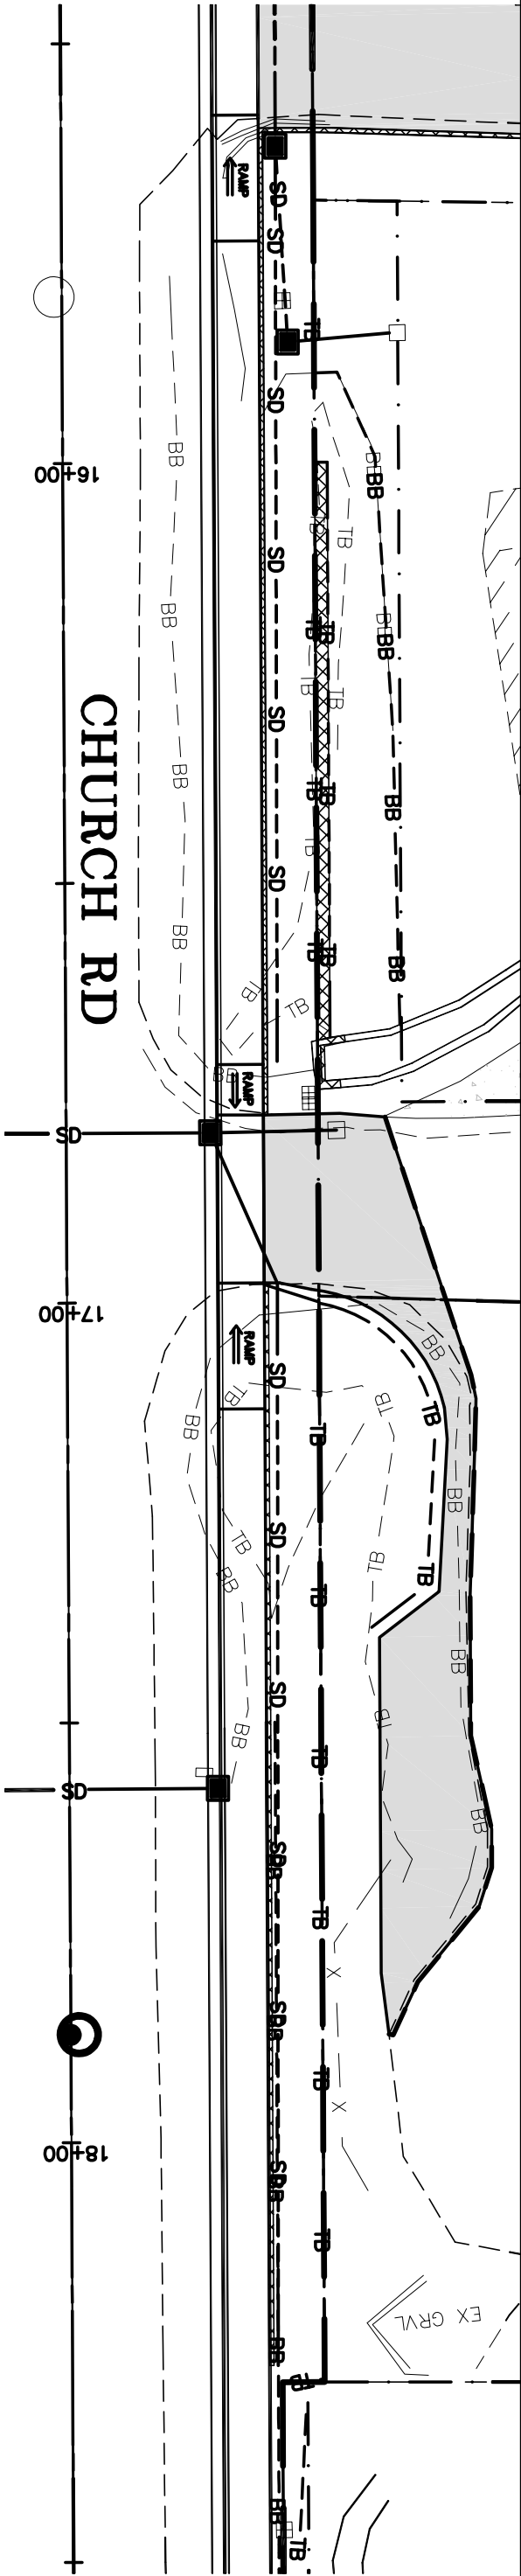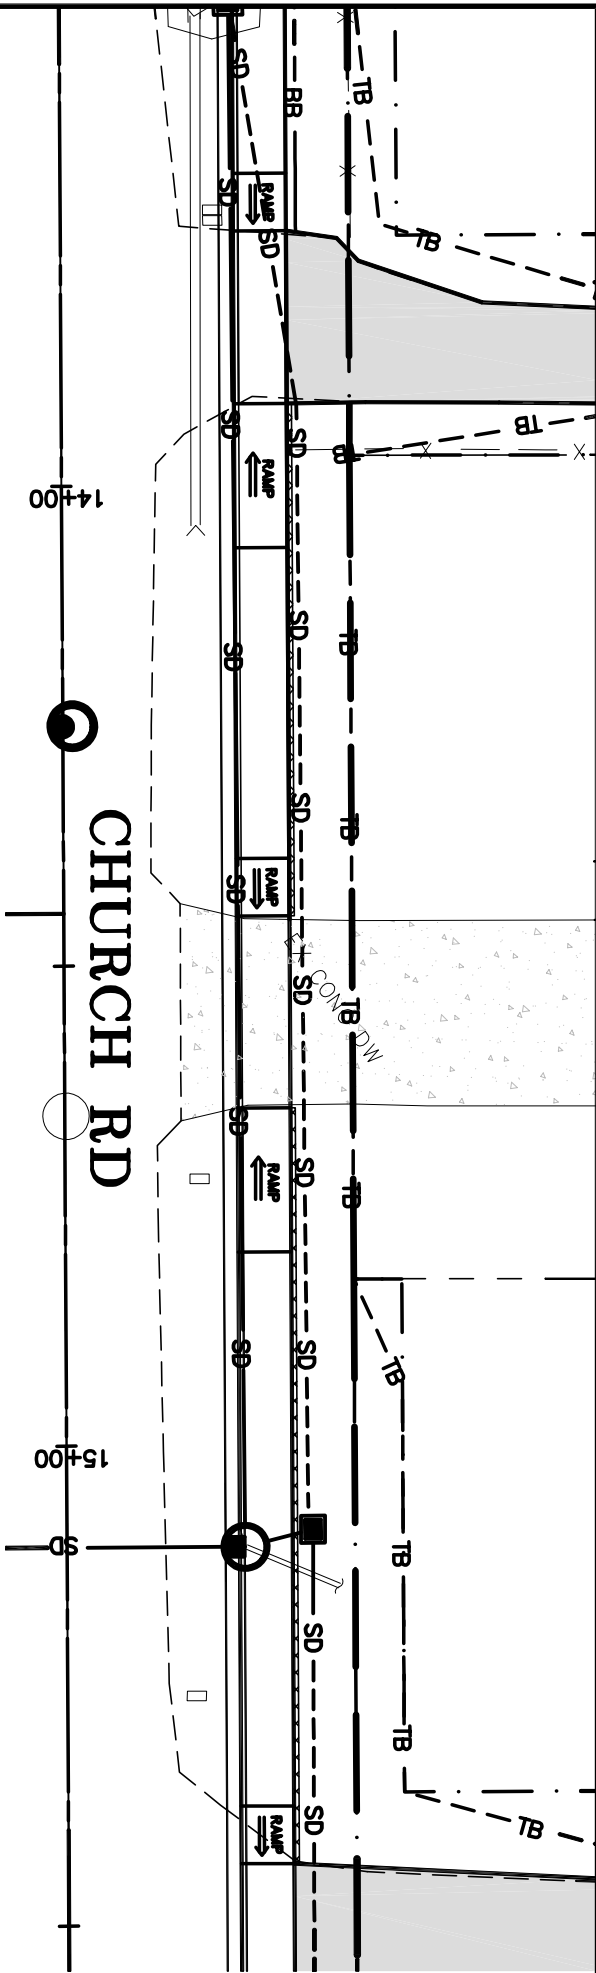

1/05/17
AS-BUILT

DESIGNED BY
LP/GKG
DRAWN BY
LMC
CHECKED BY
LP

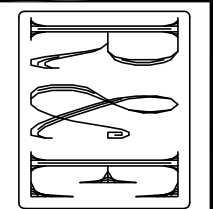

REICHHARDT & EBE
ENGINEERING, INC.
CONSULTING ENGINEERS
PO Box 978 423 Front St., Ste 201
Lynden, Washington 98264
Ph (360) 354-3687
Fax (360) 354-0407

NO. DATE

REVISION





BY

CITY OF FERNDALE
2095 MAIN STREET
FERNDAL, WA 98248


CHURCH ROAD
STREET IMPROVEMENTS
WALL PLAN AND PROFILE

JOB# / DWG
07037 WALL


DATE
1-5-17
SHEET
38 of 64

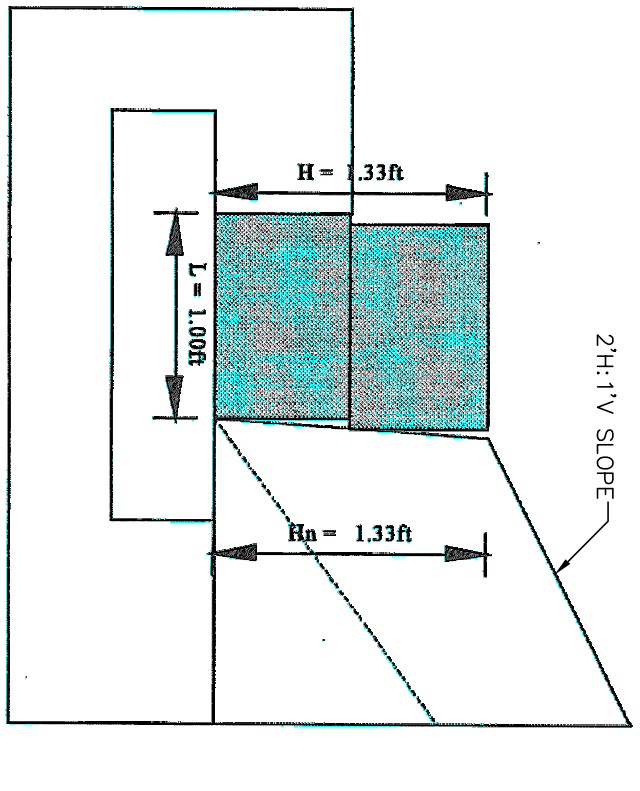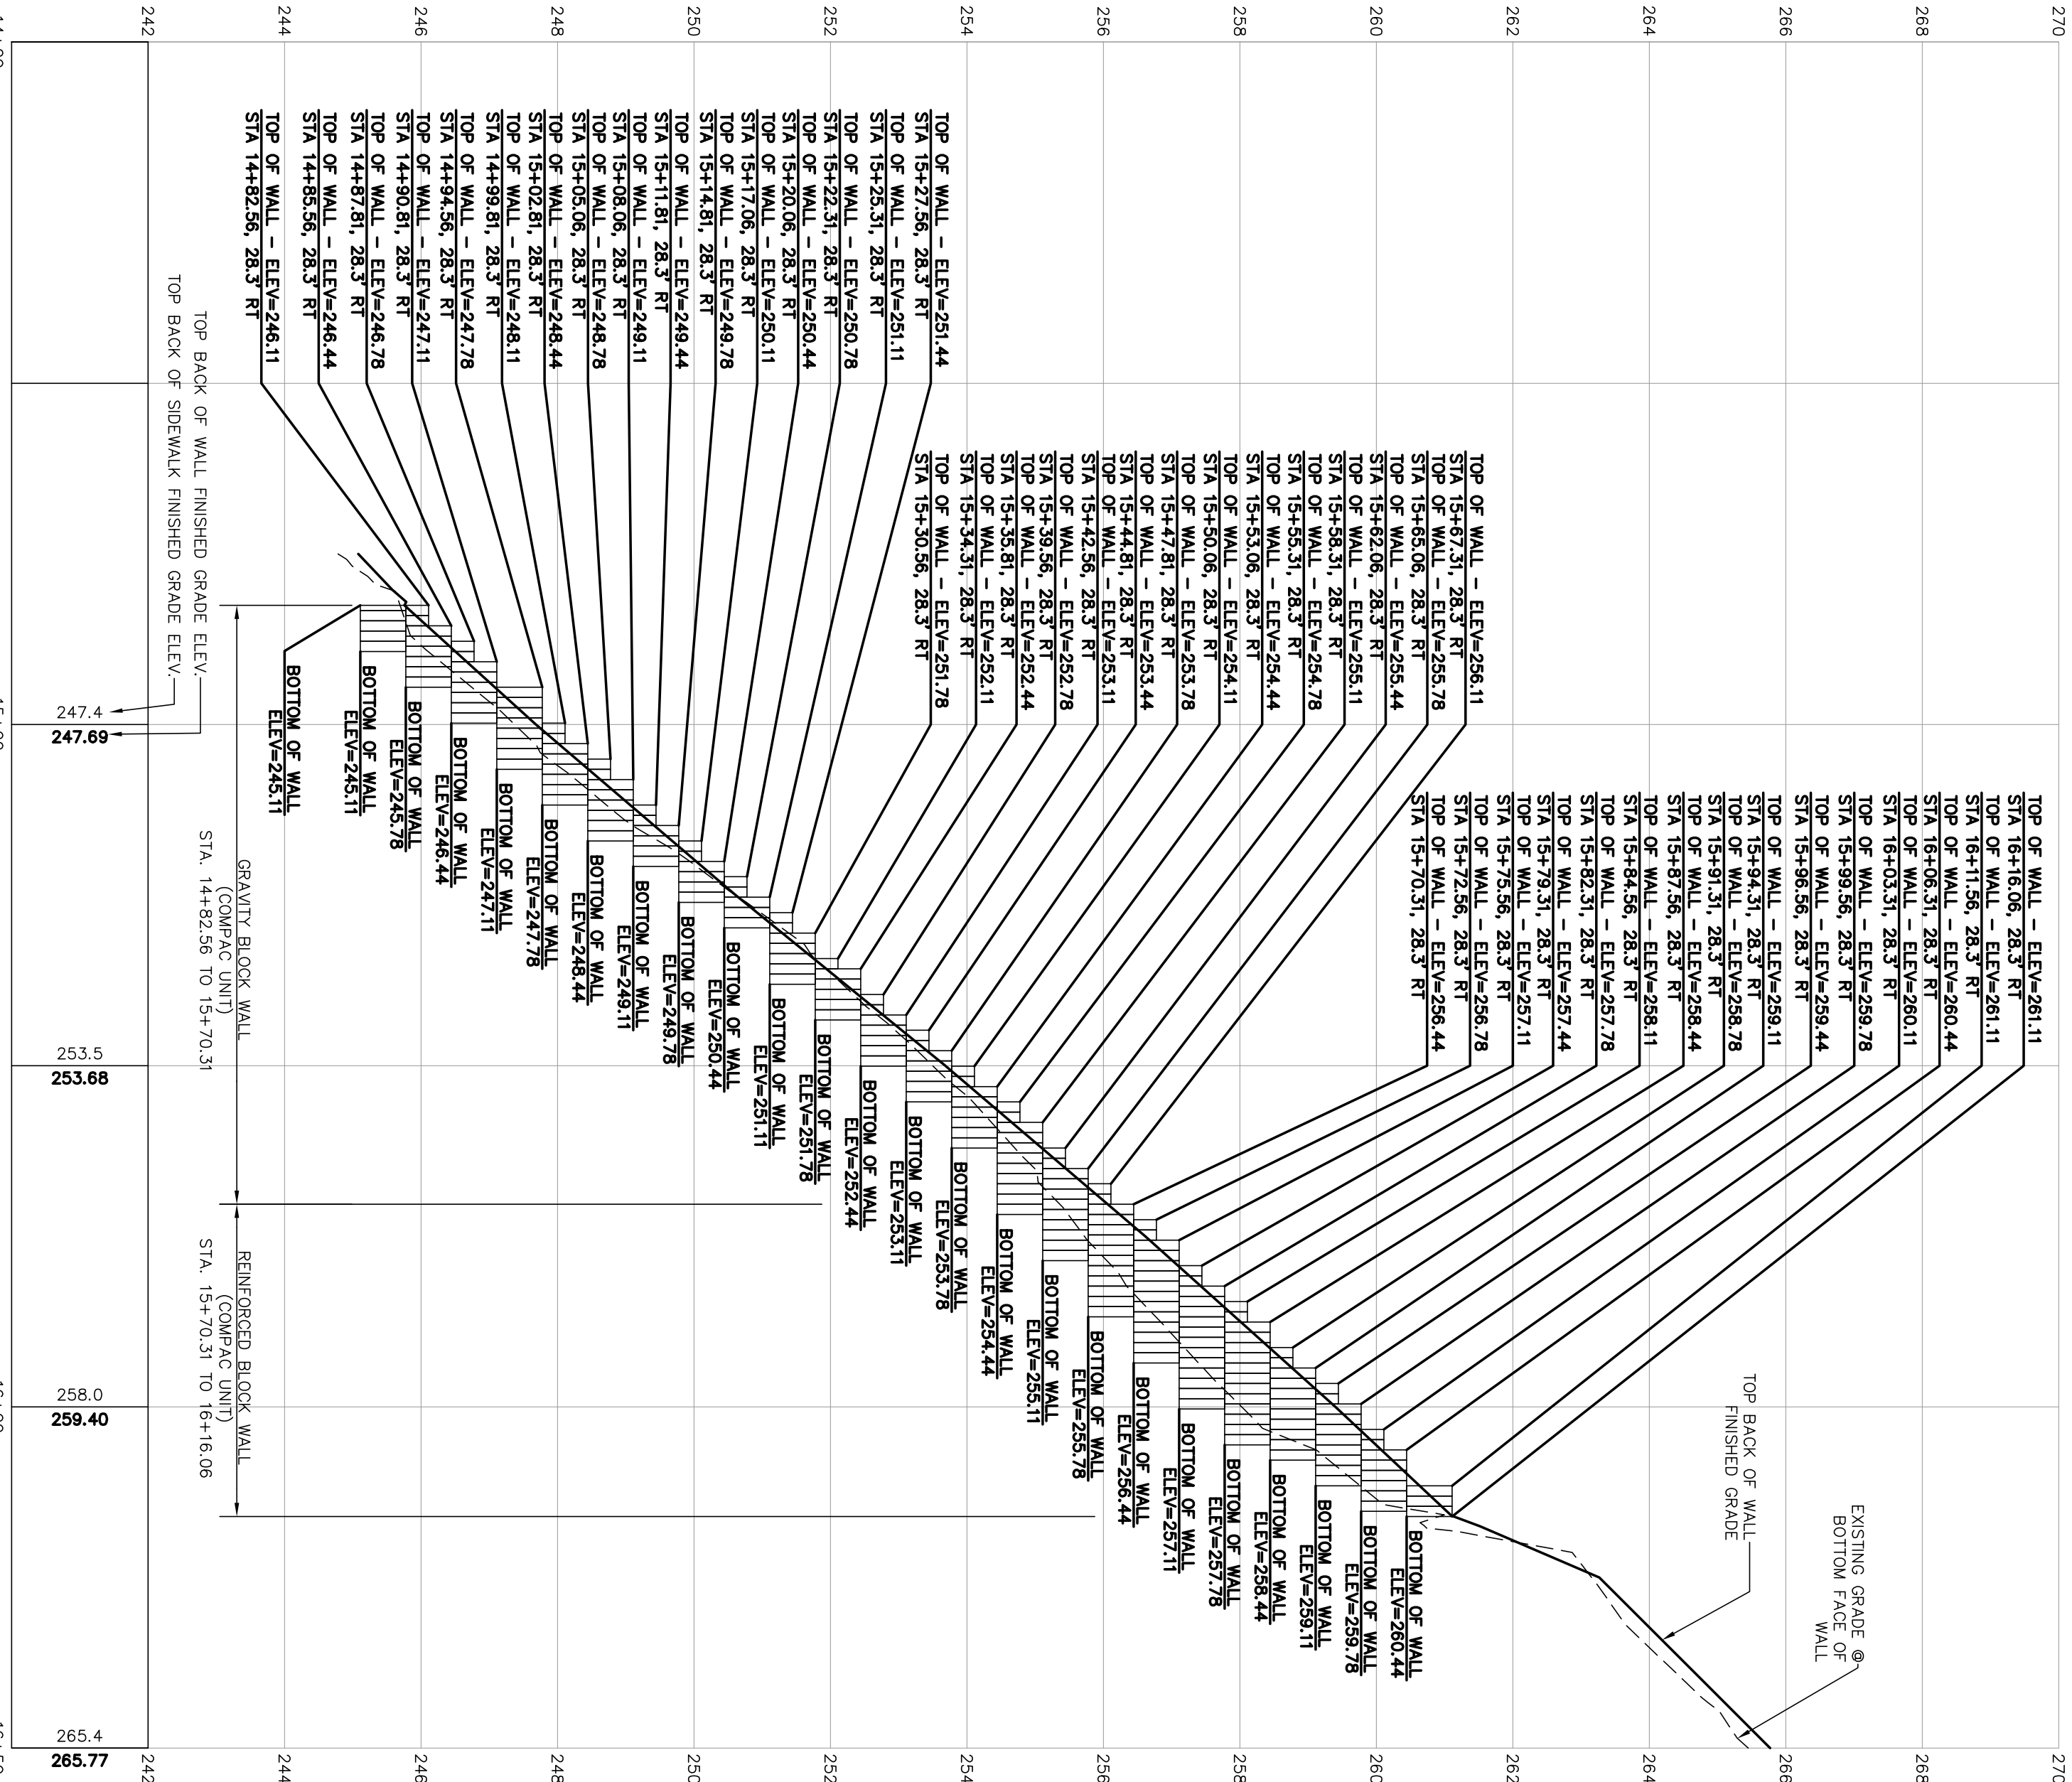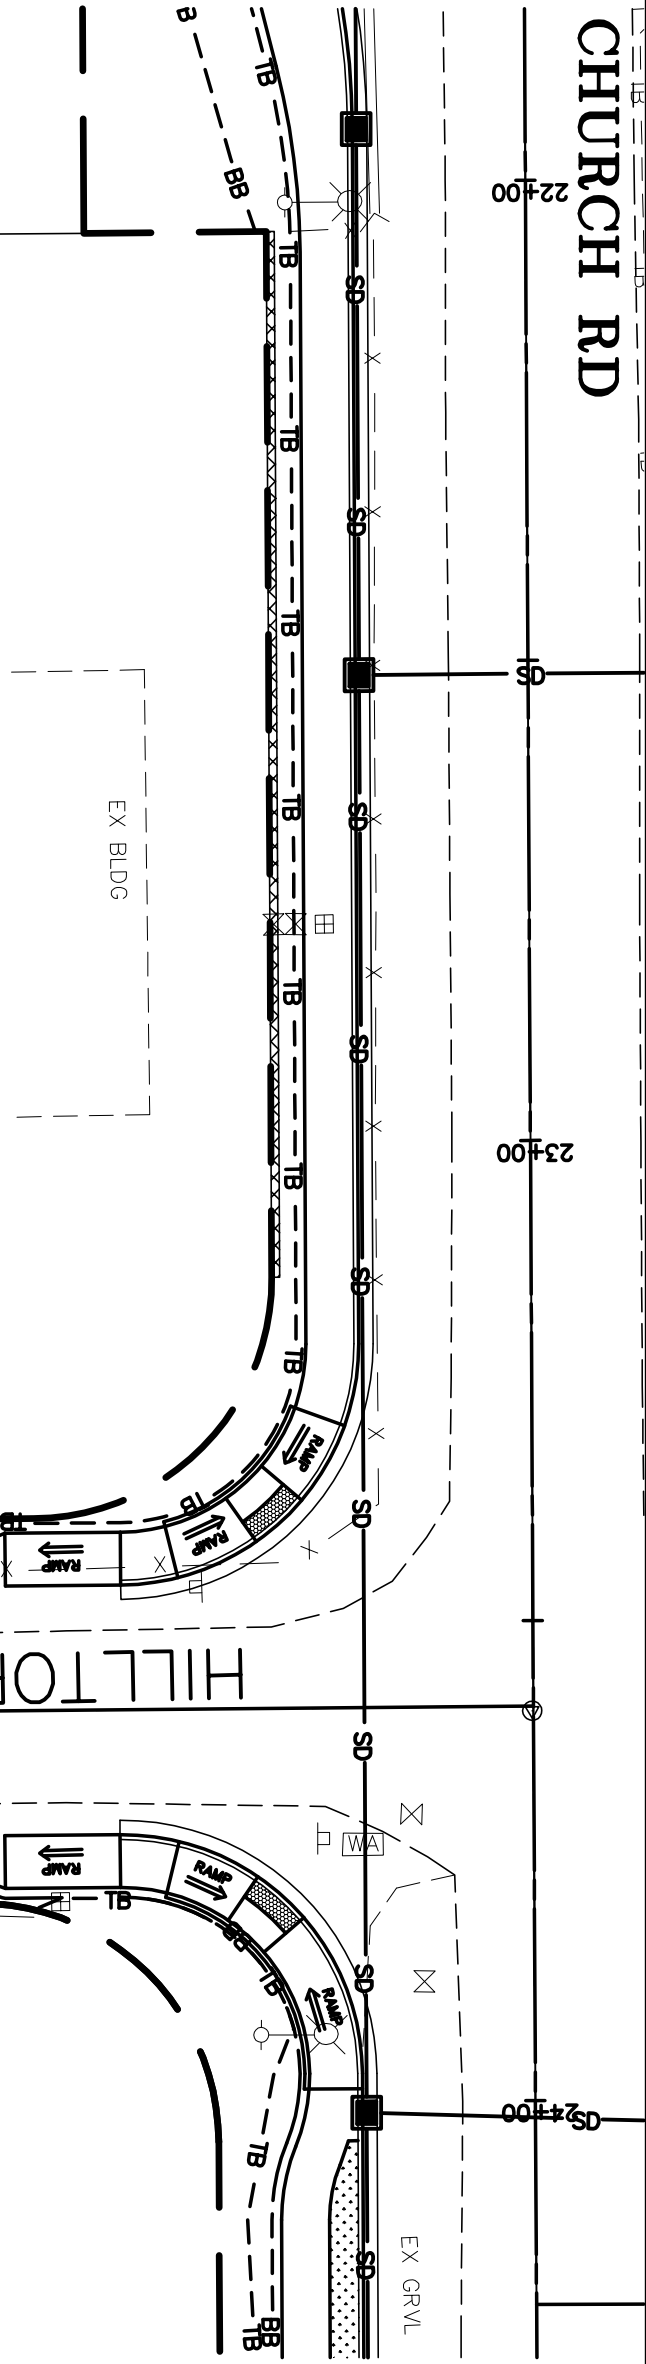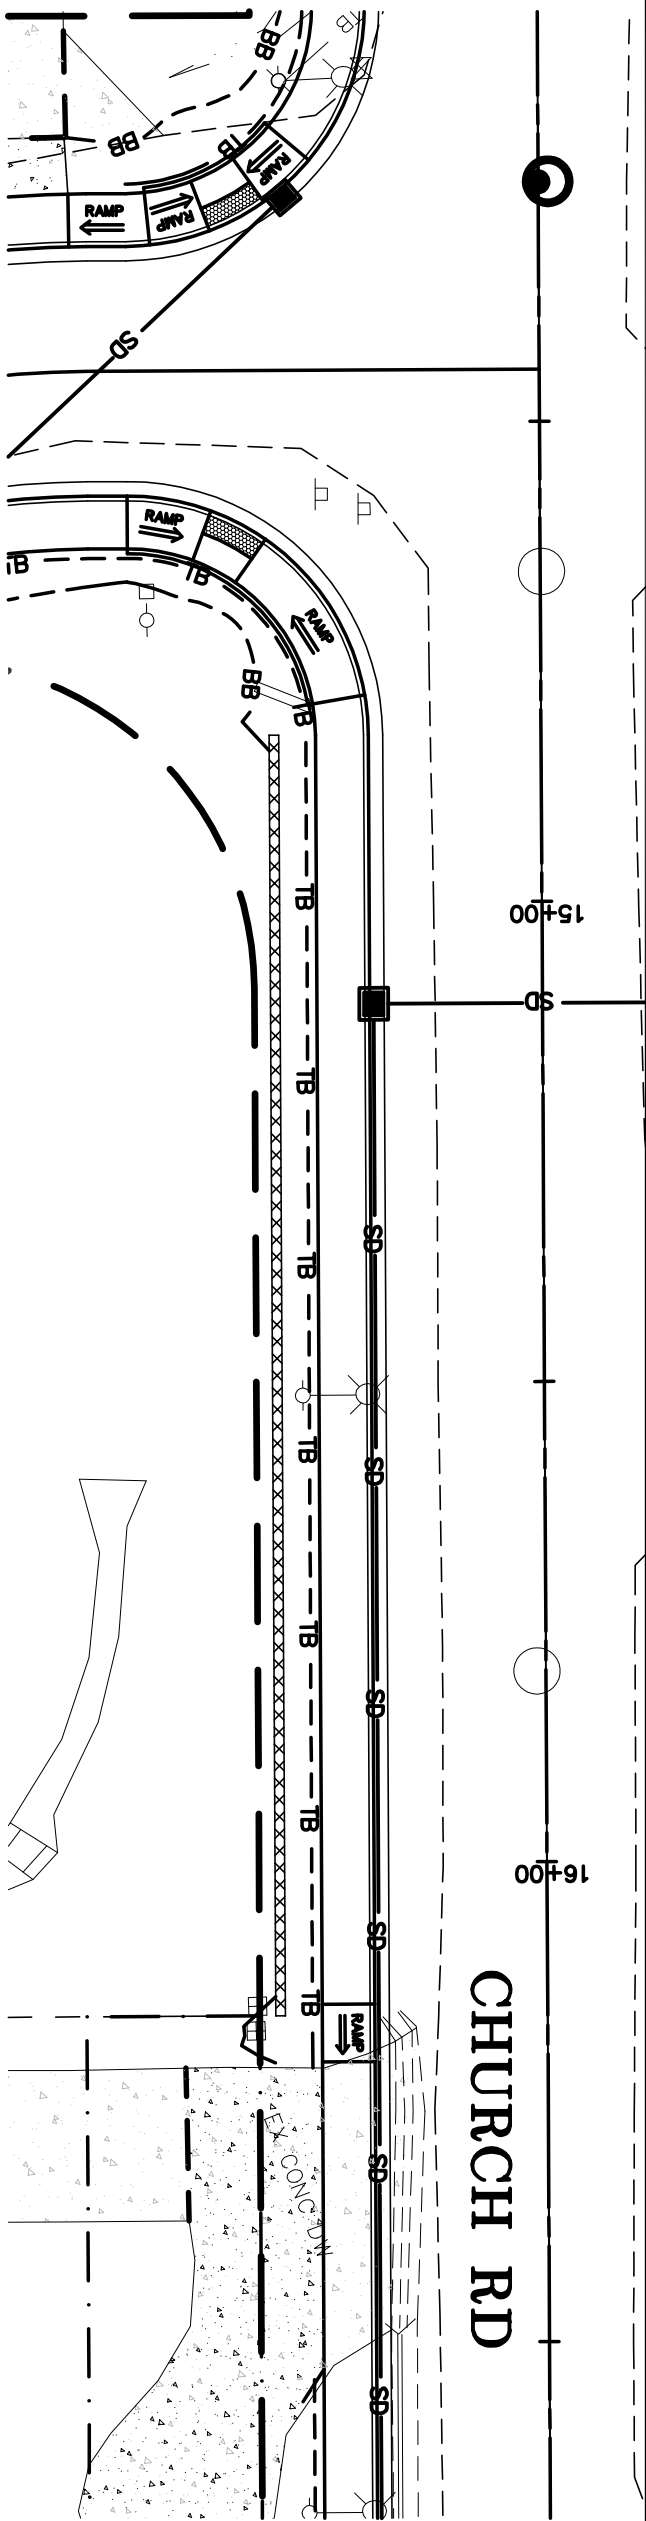

GRAVITY BLOCK WALL
(COMPACT UNIT)
STA. 14+82.56 TO 15+70.31 (RT)

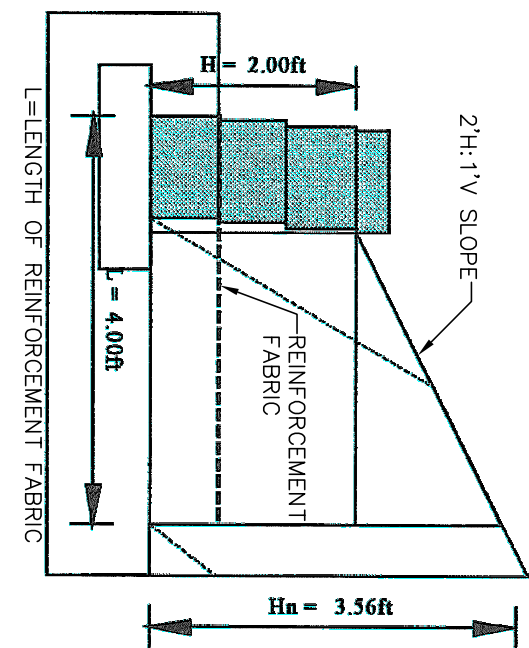


REINFORCED BLOCK WALL
(COMPACT UNIT)
STA. 15+70.31 TO 16+16.06 (RT)

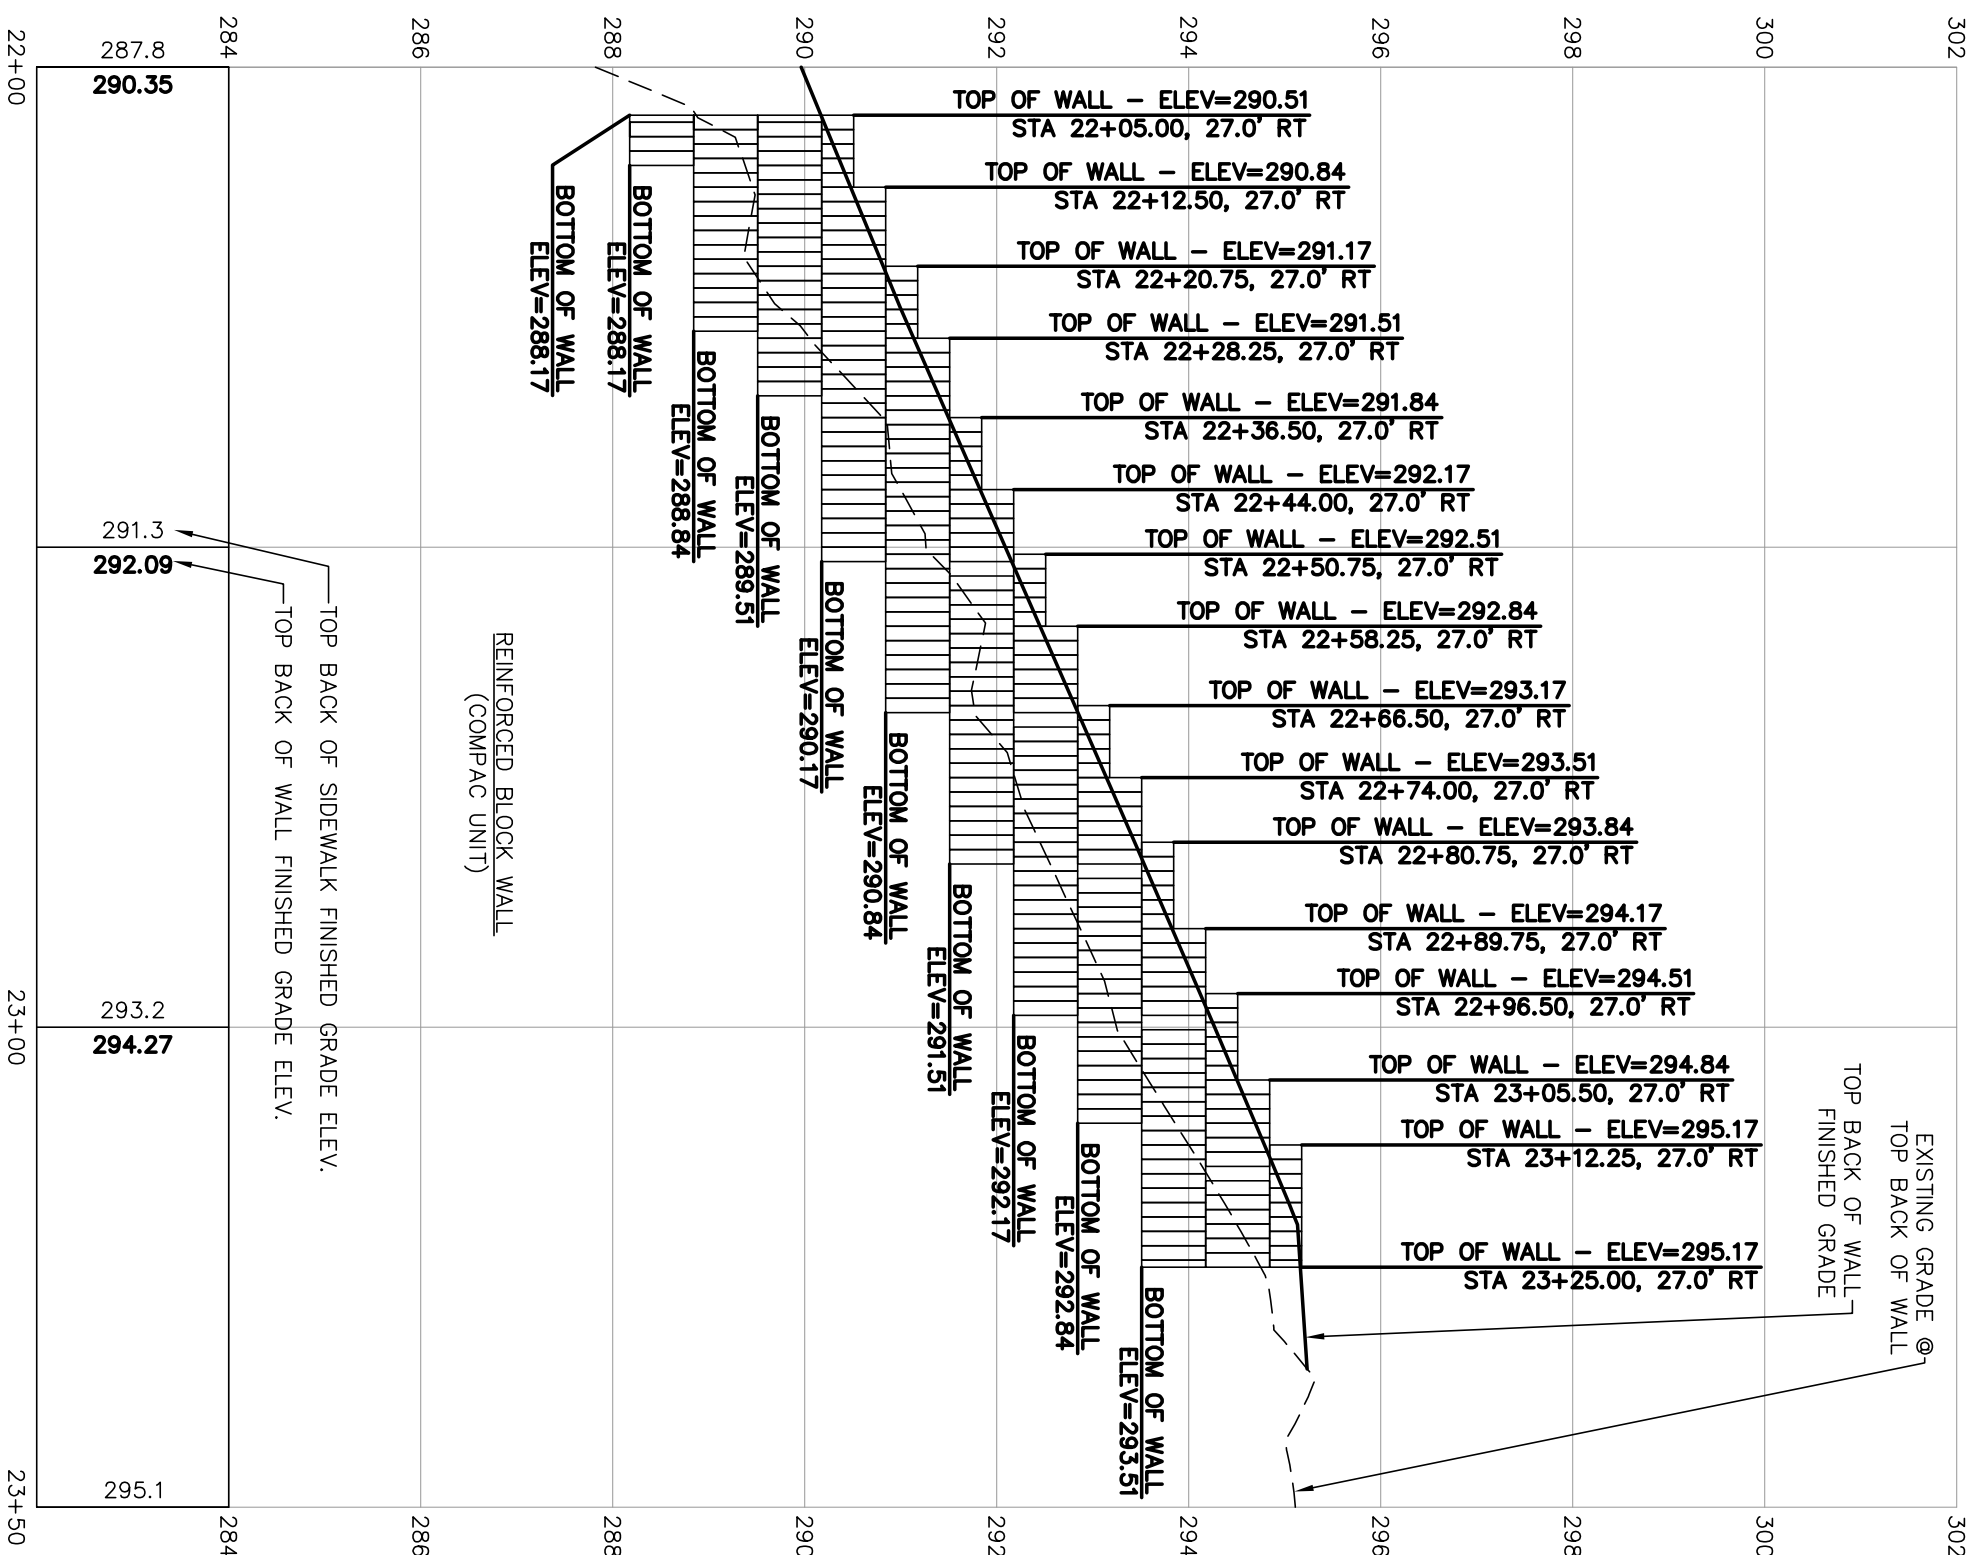

1/05/17
AS-BUILT

DESIGNED BY
LP /CKG
DRAWN BY
LMC
CHECKED BY
LP

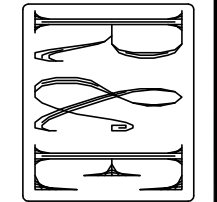

REICHHARDT & EBE
ENGINEERING, INC.
CONSULTING ENGINEERS
PO Box 978 423 Front St., Ste 201
Lynden, Washington 98264
Ph (360) 354-3687
Fax (360) 354-0407

NO. DATE REVISION

BY

CITY OF FERNDALE
2095 MAIN STREET
FERNDALE, WA 98248

CHURCH ROAD
STREET IMPROVEMENTS
WALL PLAN AND PROFILE


DATE
07/03/17
SCALE
H: 1" = 20' V: 1" = 2'

SHEET
39 of 64



1/05/17
AS-BUILT

DESIGNED BY
LP /CKG
DRAWN BY
LMC
CHECKED BY
LP

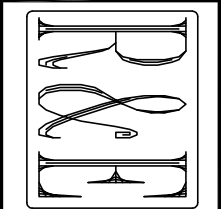

REICHHARDT & EBE
ENGINEERING, INC.
CONSULTING ENGINEERS
PO Box 978 423 Front St., Ste 201
Lynden, Washington 98264
Ph (360) 354-3687
Fax (360) 354-0407

NO.	DATE	REVISION	BY

CITY OF FERNDALE
2095 MAIN STREET
FERNDALE, WA 98248

CHURCH ROAD
STREET IMPROVEMENTS
GRADING PLAN


JOB# / DWG
07037 GRADE
SCALE
H: 1" = 20' V: N/A
DATE
1-5-17
SHEET
40 of 64

GRAPHIC SCALE
(IN FEET)
1 inch = 20 ft.



CURB	RADIUS	LENGTH	A
C1	25.00'	41.45'	93°
C2	25.00'	37.09'	85°

MT VIEW

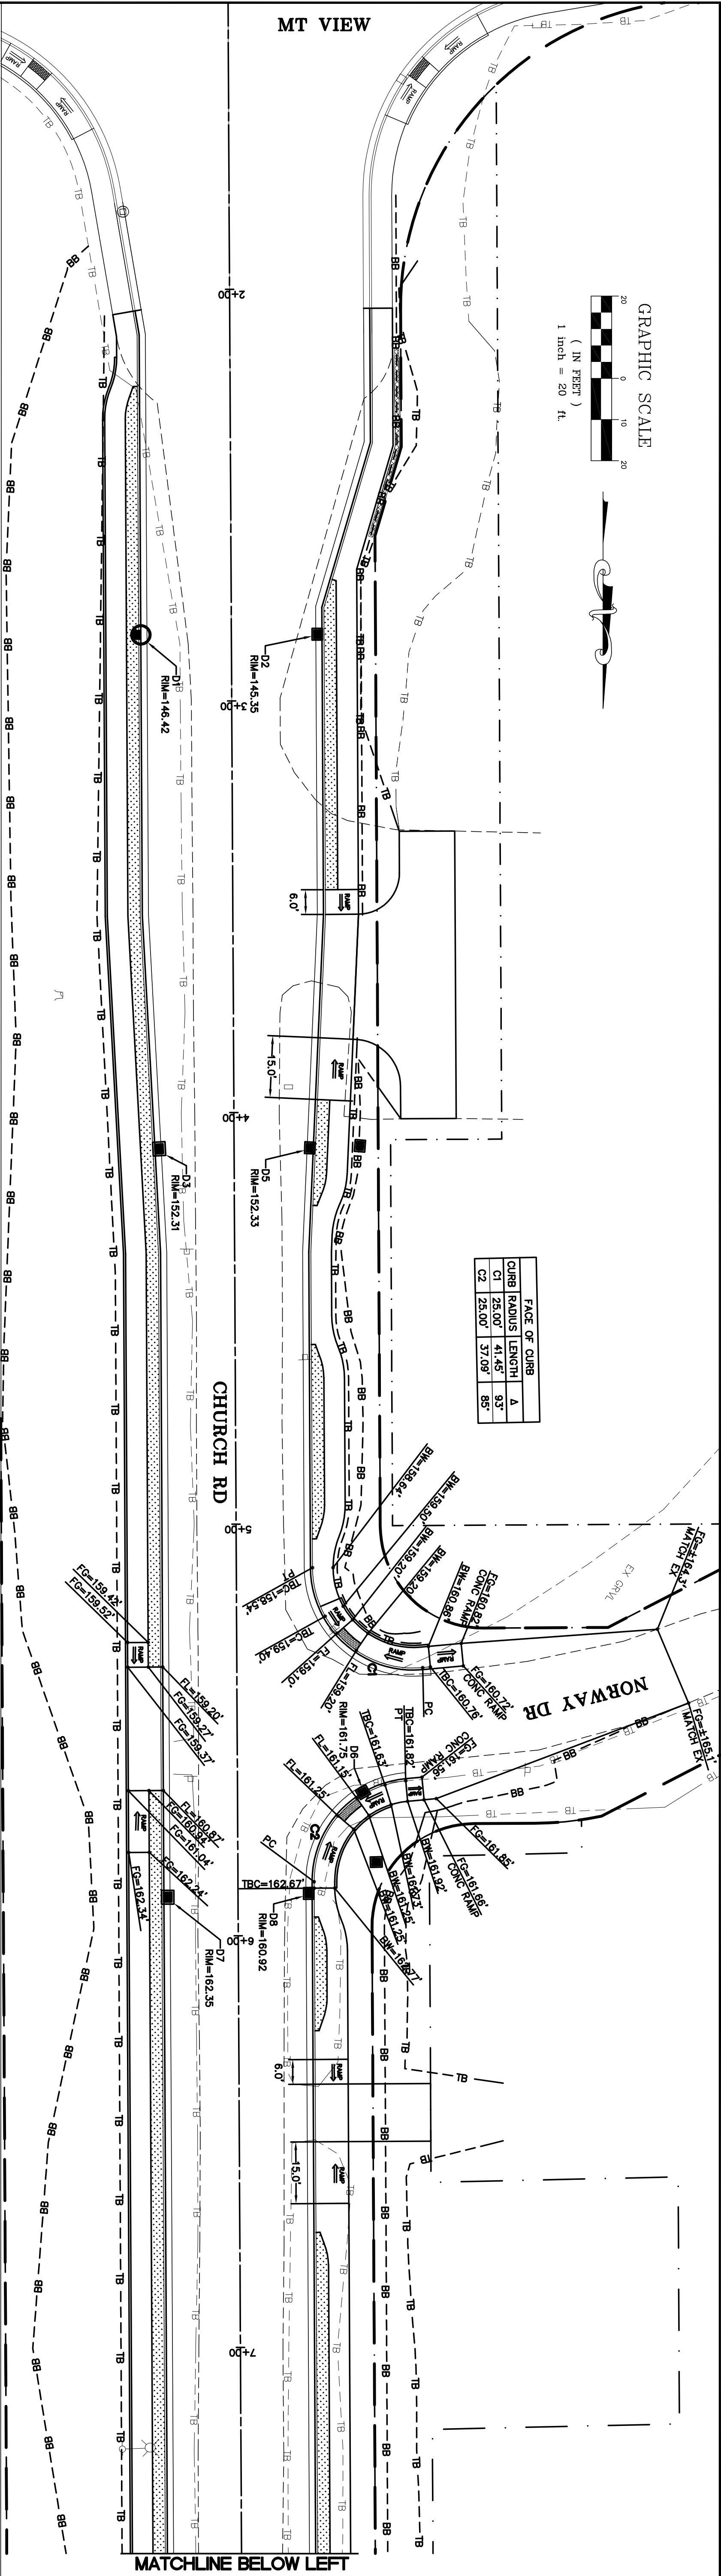


MATCHLINE BELOW LEFT

MATCHLINE ABOVE RIGHT

MATCHLINE SHEET 41

1/05/17
AS-BUILT

DESIGNED BY
LP /CKG
DRAWN BY
LMC
CHECKED BY
LP

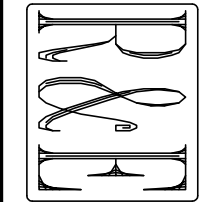

REICHHARDT & EBE
ENGINEERING, INC.
CONSULTING ENGINEERS
Ph (360) 354-3687
Lynden, Washington 98264
Fax (360) 354-0407

NO. DATE

REVISION


BY




CITY OF FERNDALE
2095 MAIN STREET
FERNDAL, WA 98248

CHURCH ROAD
STREET IMPROVEMENTS
GRADING PLAN

JOB# / DWG
07037
GRADE
SCALE
H: 1" = 20' V: N/A


DATE
1/5/17
SHEET
41 of 64

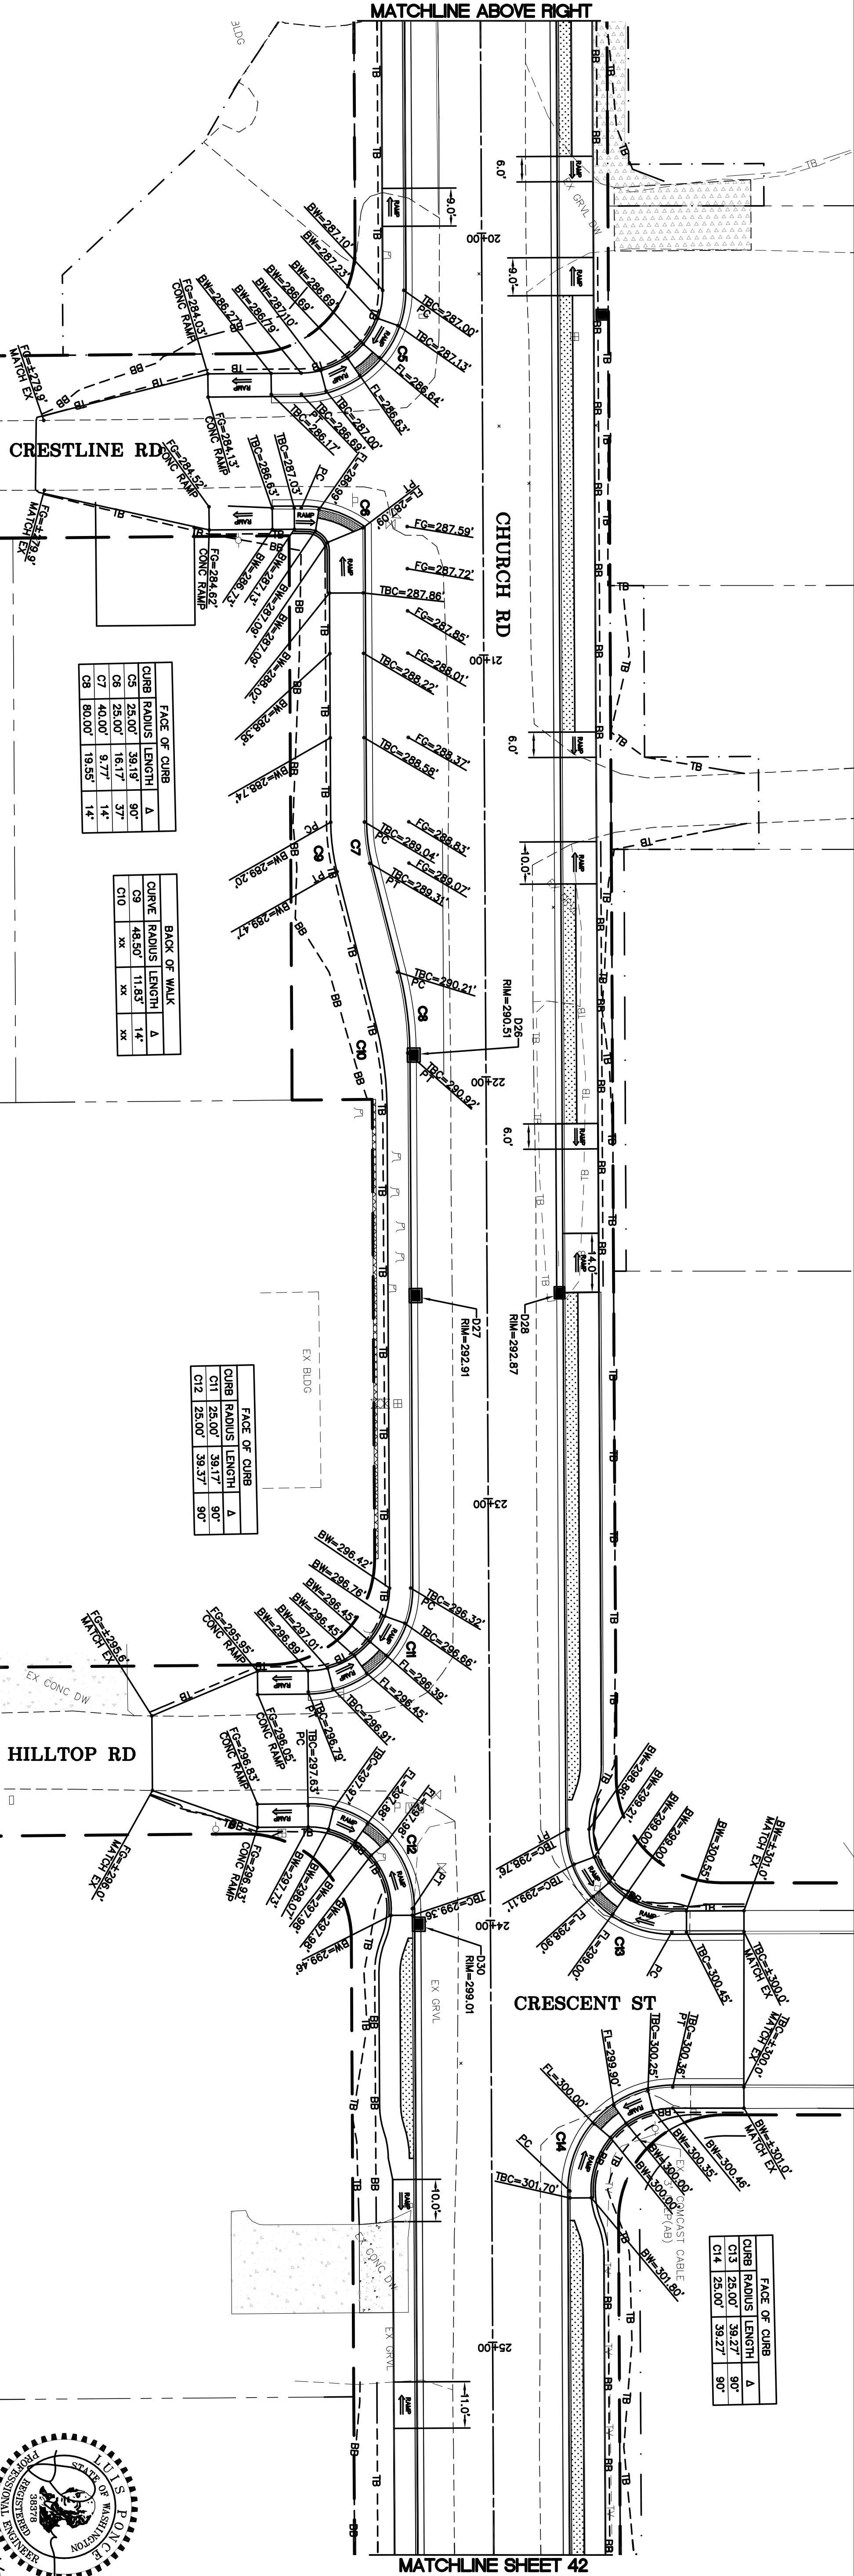

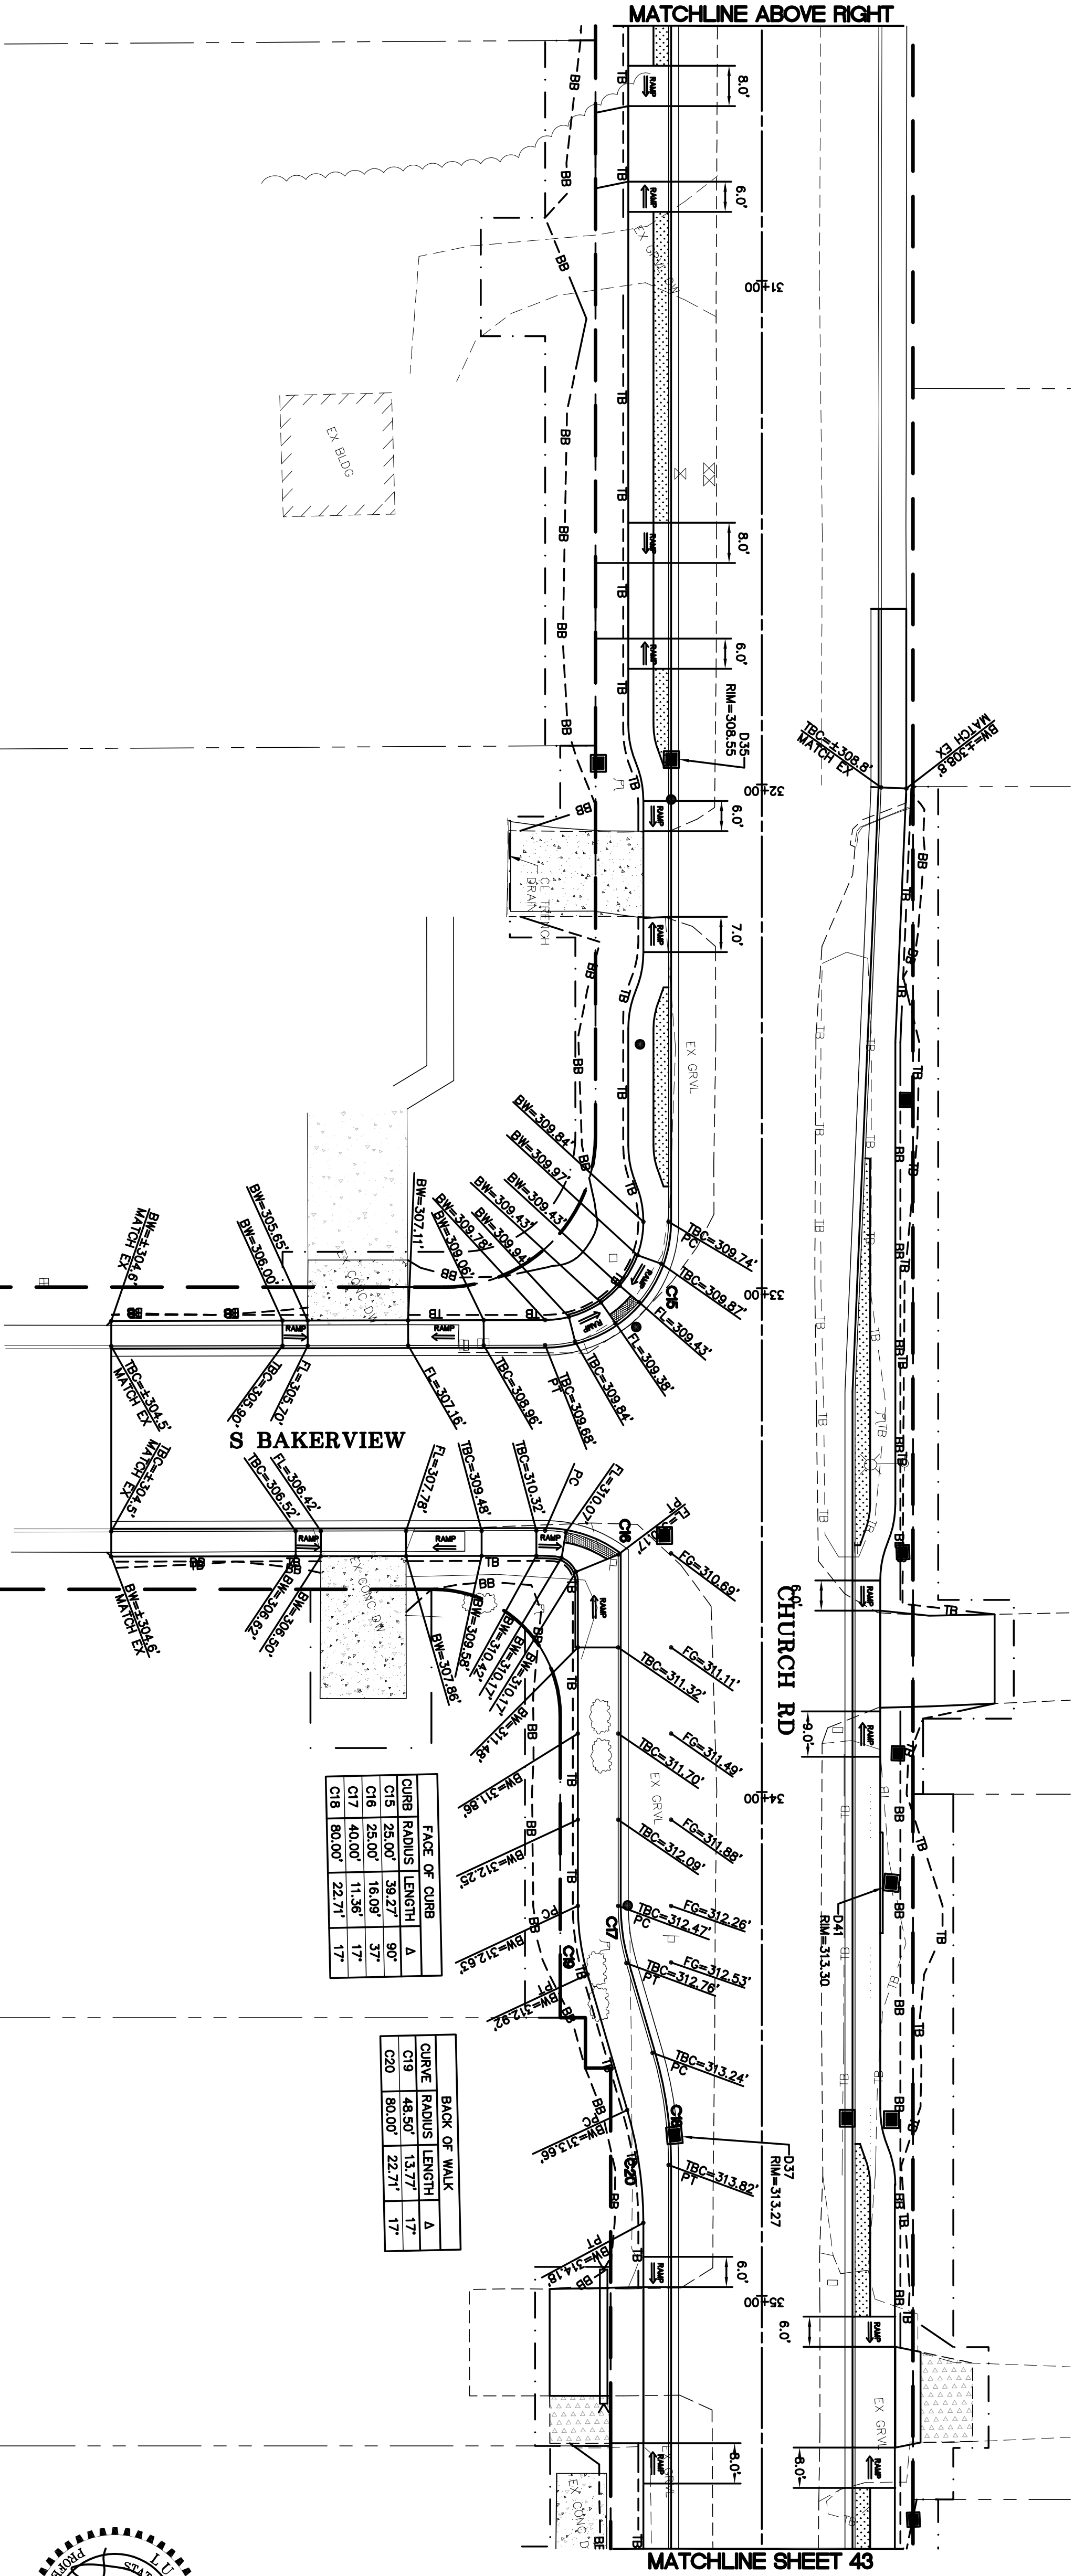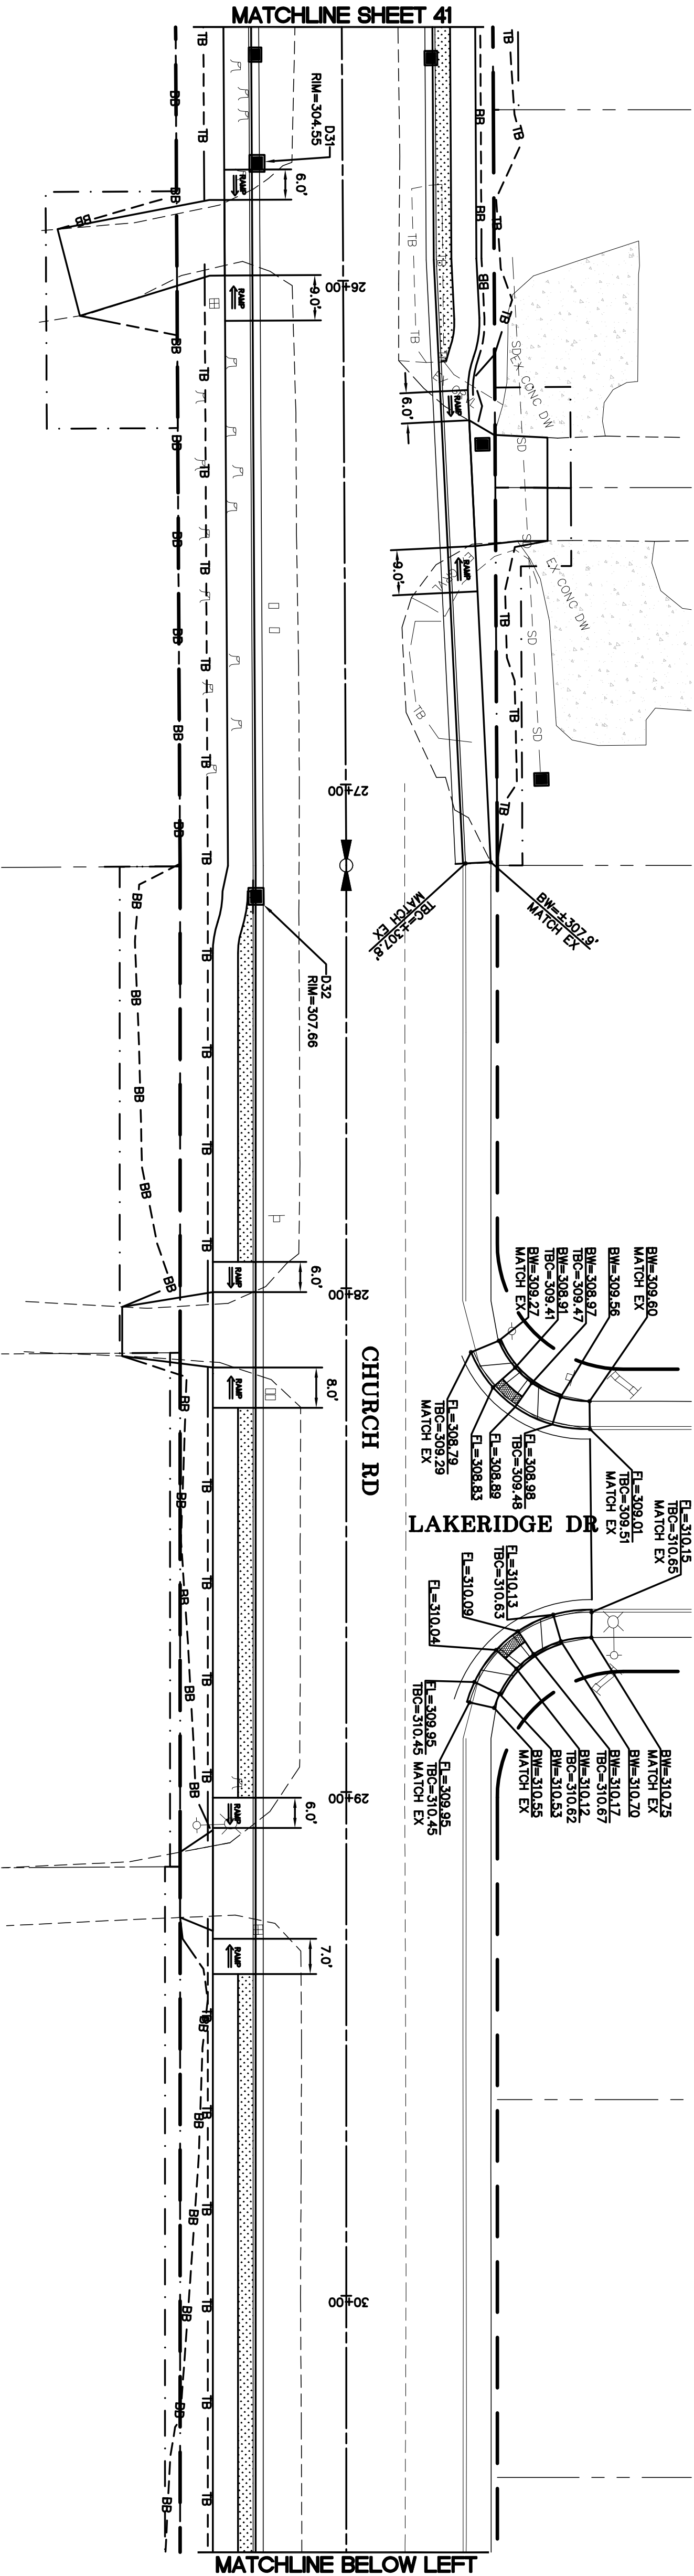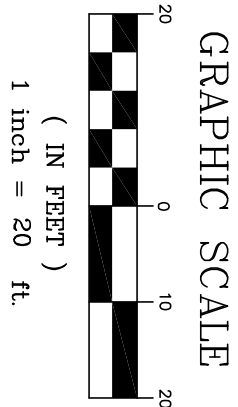


FACE OF CURB			
CURB	RADIUS	LENGTH	A
C15	25.00'	39.27'	90°
C16	25.00'	16.09'	37°
C17	40.00'	11.36'	17°
C18	80.00'	22.71'	17°

BACK OF WALK			
CURVE	RADIUS	LENGTH	A
C19	48.50'	13.77'	17°
C20	80.00'	22.71'	17°

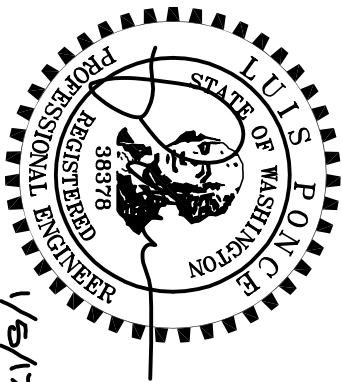

1/05/17
AS-BUILT

DESIGNED BY
LP /CKG
DRAWN BY
LMC
CHECKED BY
LP

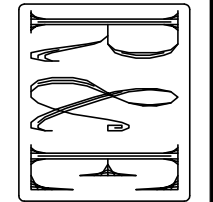

REICHHARDT & EBE
ENGINEERING, INC.
CONSULTING ENGINEERS
Ph (360) 354-3687
Fox (360) 354-0407
PO Box 978 423 Front St., Ste 201
Lynden, Washington 98264

NO. DATE

REVISION


BY

CITY OF FERNDALE
2095 MAIN STREET
FERNDALE, WA 98248

CHURCH ROAD
STREET IMPROVEMENTS
GRADING PLAN

JOB# / DWG
07037 GRADE
SCALE
H: 1" = 20' V: N/A

DATE
1-5-17
SHEET
42 of 64

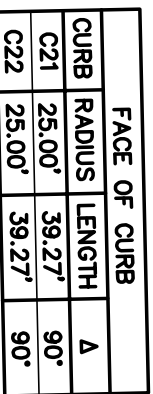


1/05/17

AS-BUILT

DESIGNED BY
LP /CKG

DRAWN BY
LMC

CHECKED BY
LP

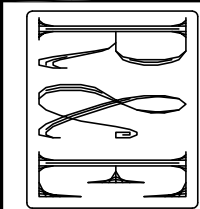

REICHHARDT & EBE

ENGINEERING, INC.

CONSULTING ENGINEERS

Po Box 978 423 Front St., Ste 201
Lynden, Washington 98264

Ph (360) 354-3687
Fax (360) 354-0407

NO.	DATE	REVISION	BY

CITY OF FERNDALE

2095 MAIN STREET

FERNDALE, WA 98248

CHURCH ROAD



STREET IMPROVEMENTS





CHANNELIZATION PLAN

JOB# / DWG 07037	CHAN	DATE 1-5-17
SCALE H: 1" = 30'	V: N/A	SHEET 46 of 64



V/e/17

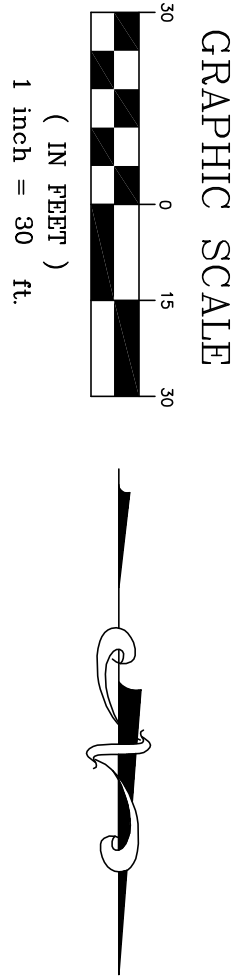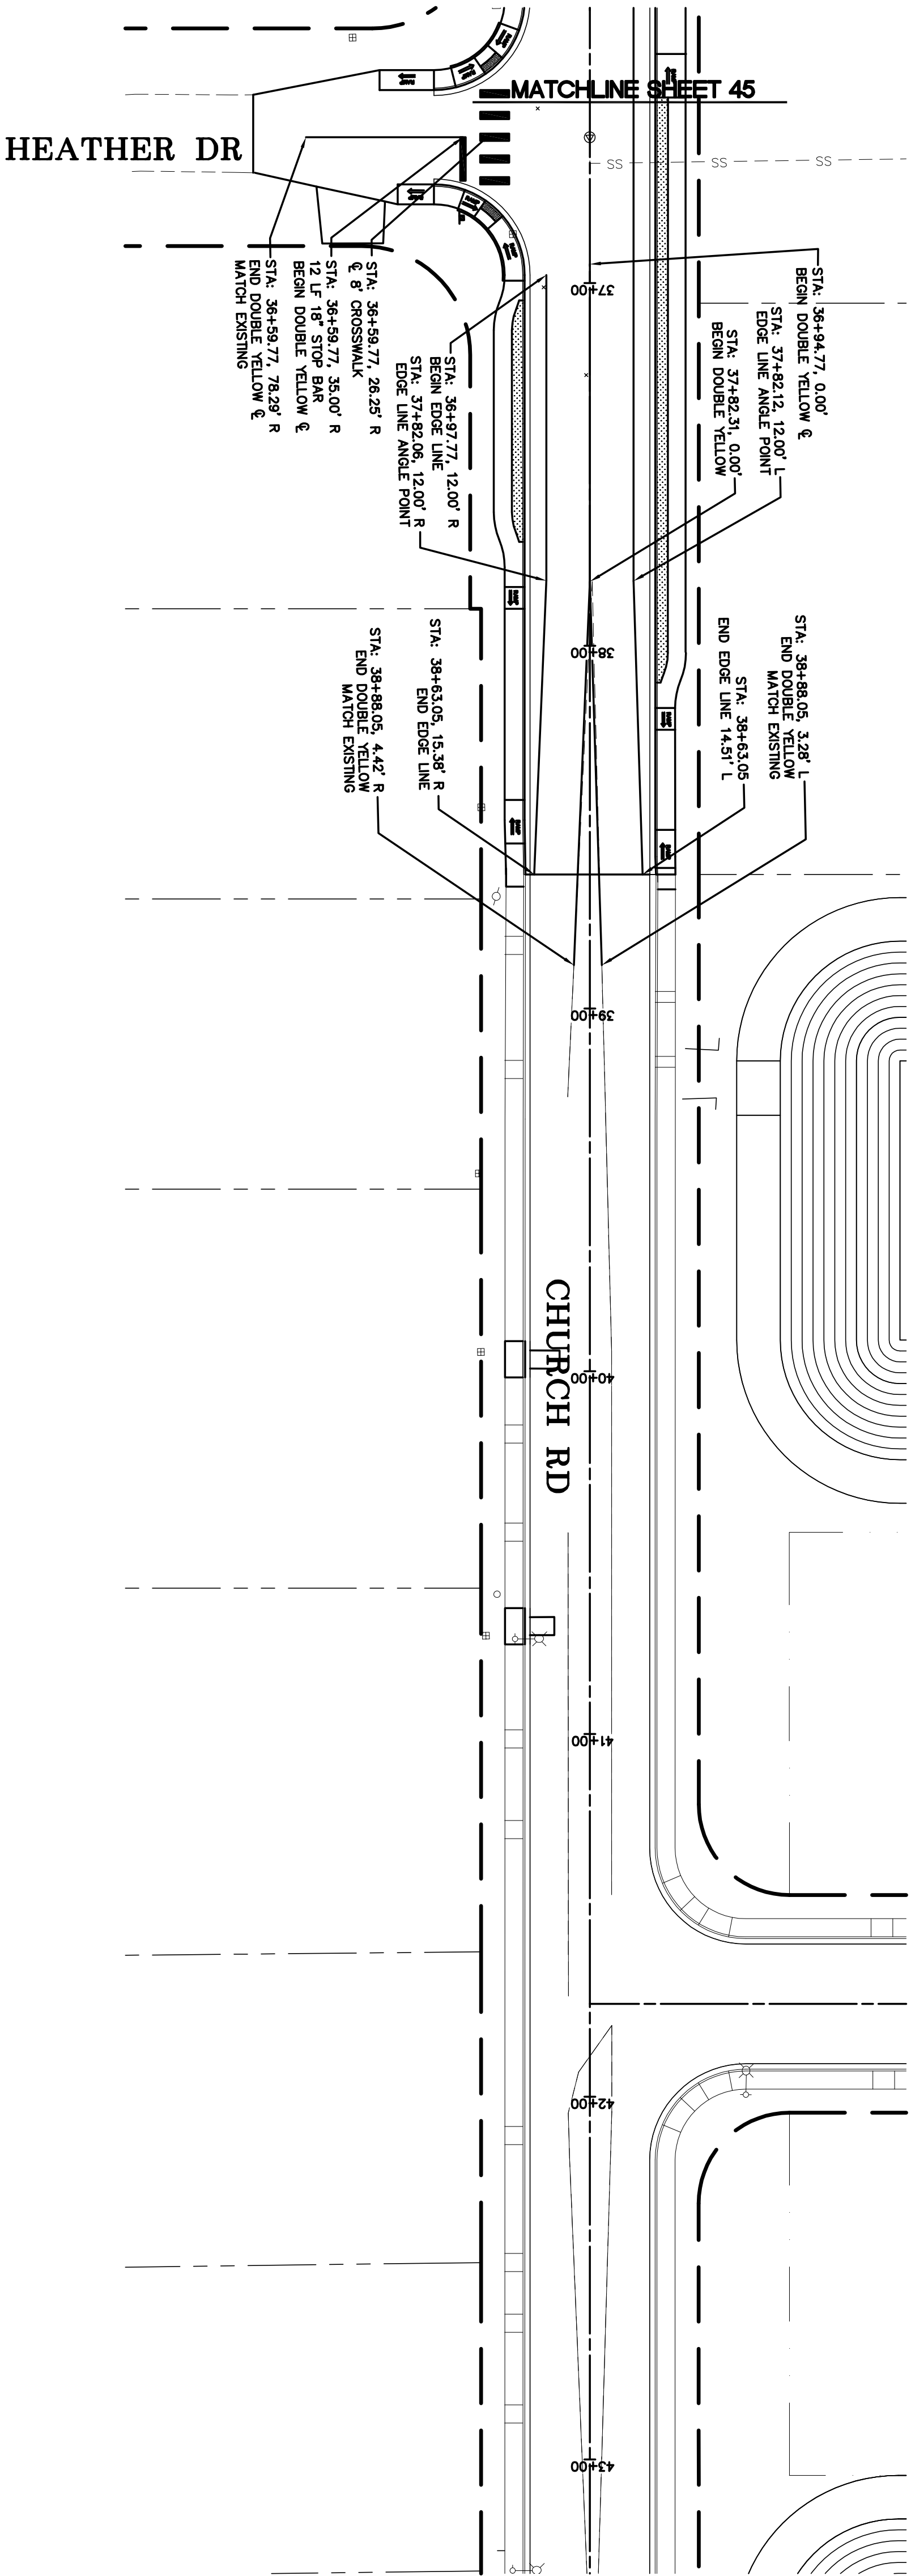

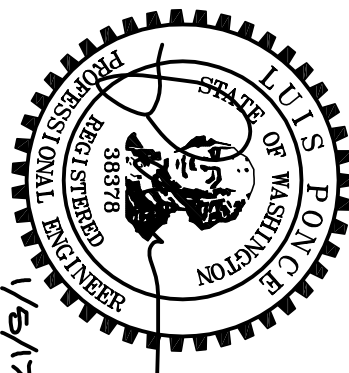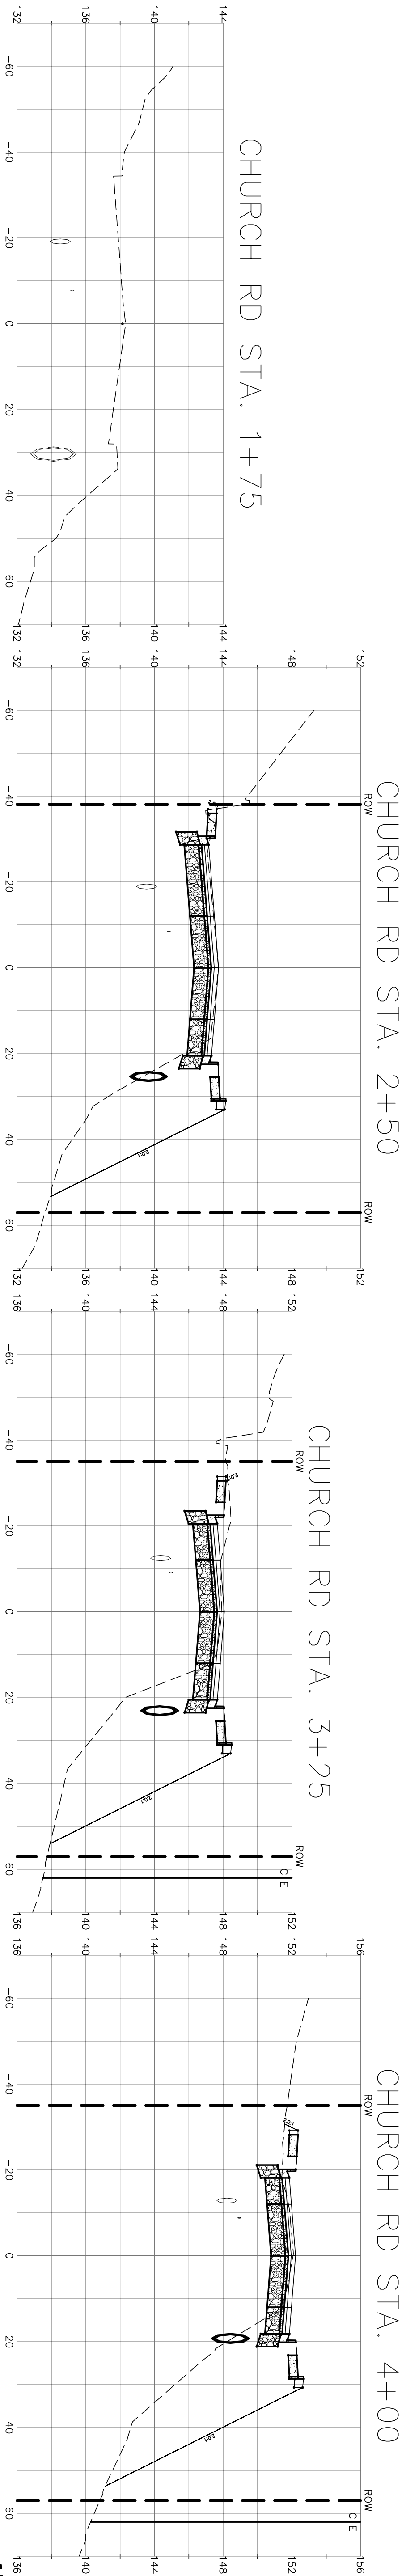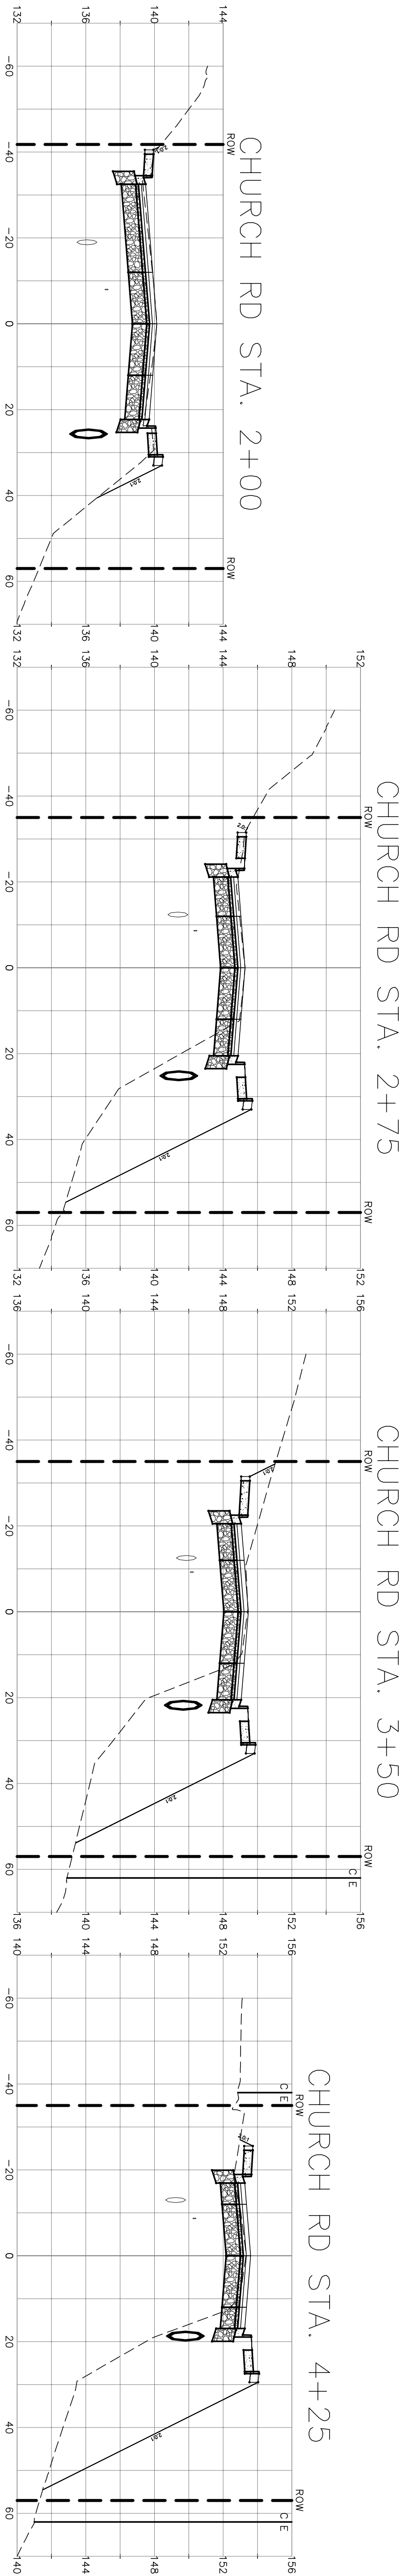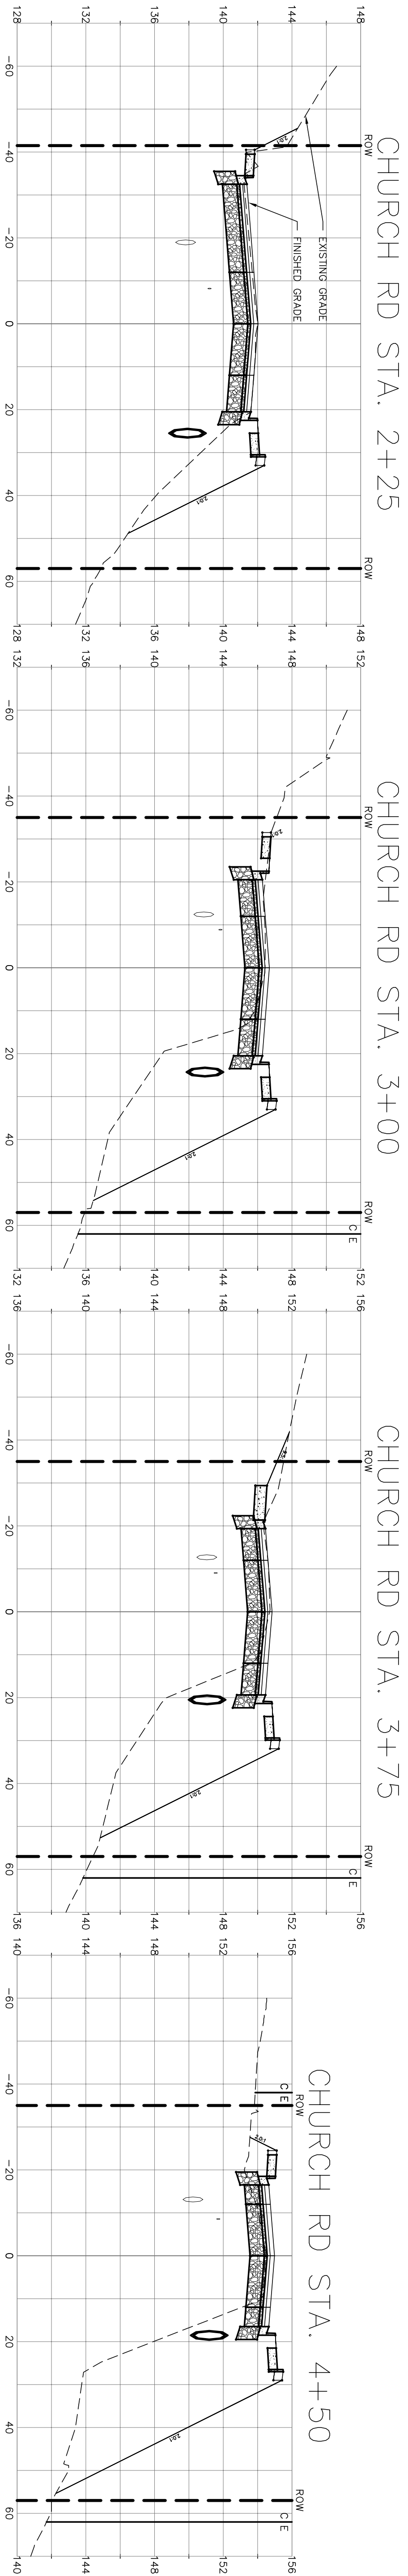


1/05/17

AS-BUILT

DESIGNED BY
LP/GKG

DRAWN BY
LMC

CHECKED BY
LP

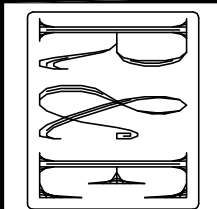

REICHHARDT & EBE
ENGINEERING, INC.
CONSULTING ENGINEERS
PO Box 978 423 Front St., Ste 201
Lynden, Washington 98264
Ph (360) 354-3687
Fax (360) 354-0407

NO.	DATE	REVISION	BY

CITY OF FERNDALE
2095 MAIN STREET
FERNDAL, WA 98248



CHURCH ROAD
STREET IMPROVEMENTS
CROSS SECTIONS

JOB# / DWG
AB07037 ALIGN_PROFILE


SCALE
H: 1" = 20' V: 1" = 5'


DATE
1-5-17




SHEET
47 of 64

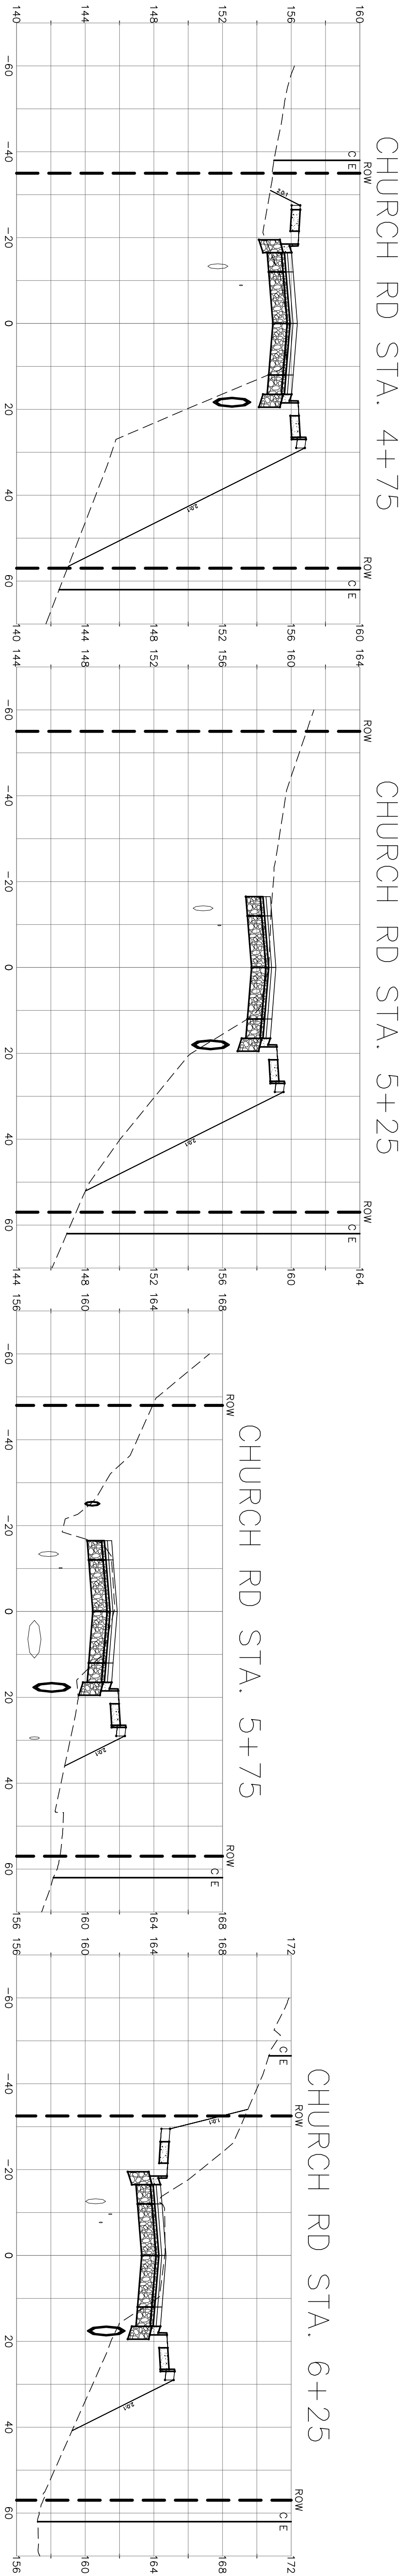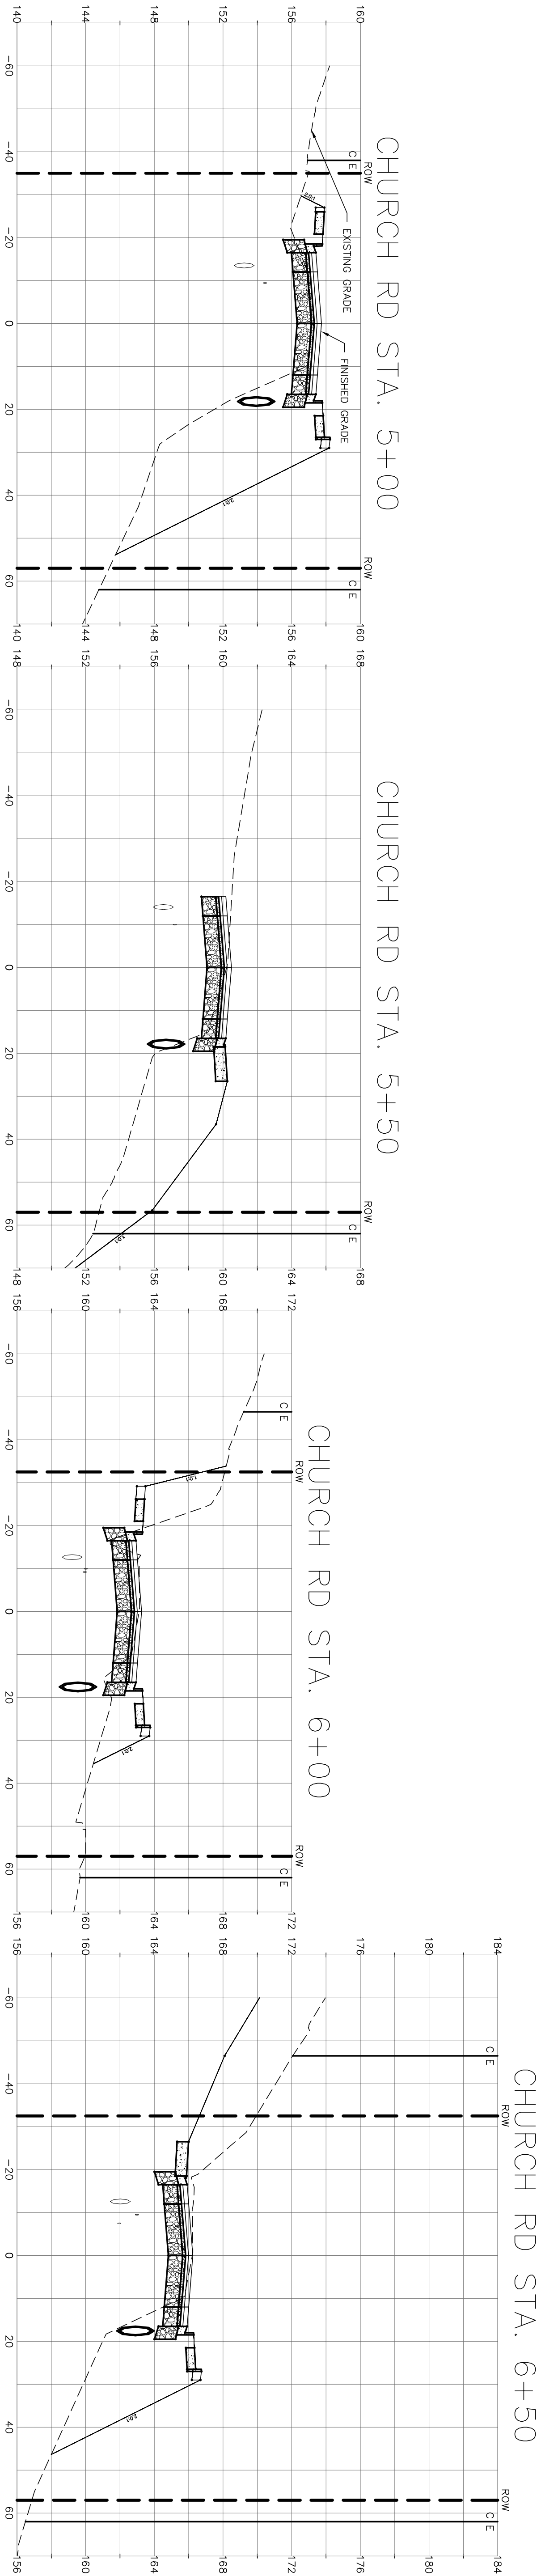

00616.048 4/17/17 KJ

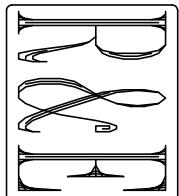
1/05/17		DESIGNED BY LP/GKG				REICHHARDT & EBE ENGINEERING, INC. PO Box 978 423 Front St., Ste 201 Lynden, Washington 98264 Ph (360) 354-3687 Fax (360) 354-0407	
AS-BUILT		DRAWN BY LMC					
		CHECKED BY LP					
NO.		DATE		REVISION		BY	
						CITY OF FERNDALE 2095 MAIN STREET FERNDAL, WA 98248	
CHURCH ROAD STREET IMPROVEMENTS CROSS SECTIONS		JOB# / DWG A807037 ALIGN_PROFILE		DATE 1-5-17		SHEET 48 of 64	

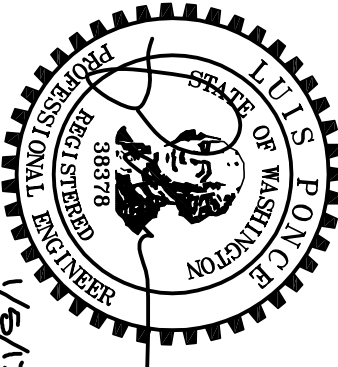

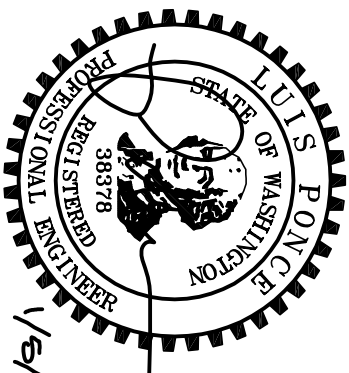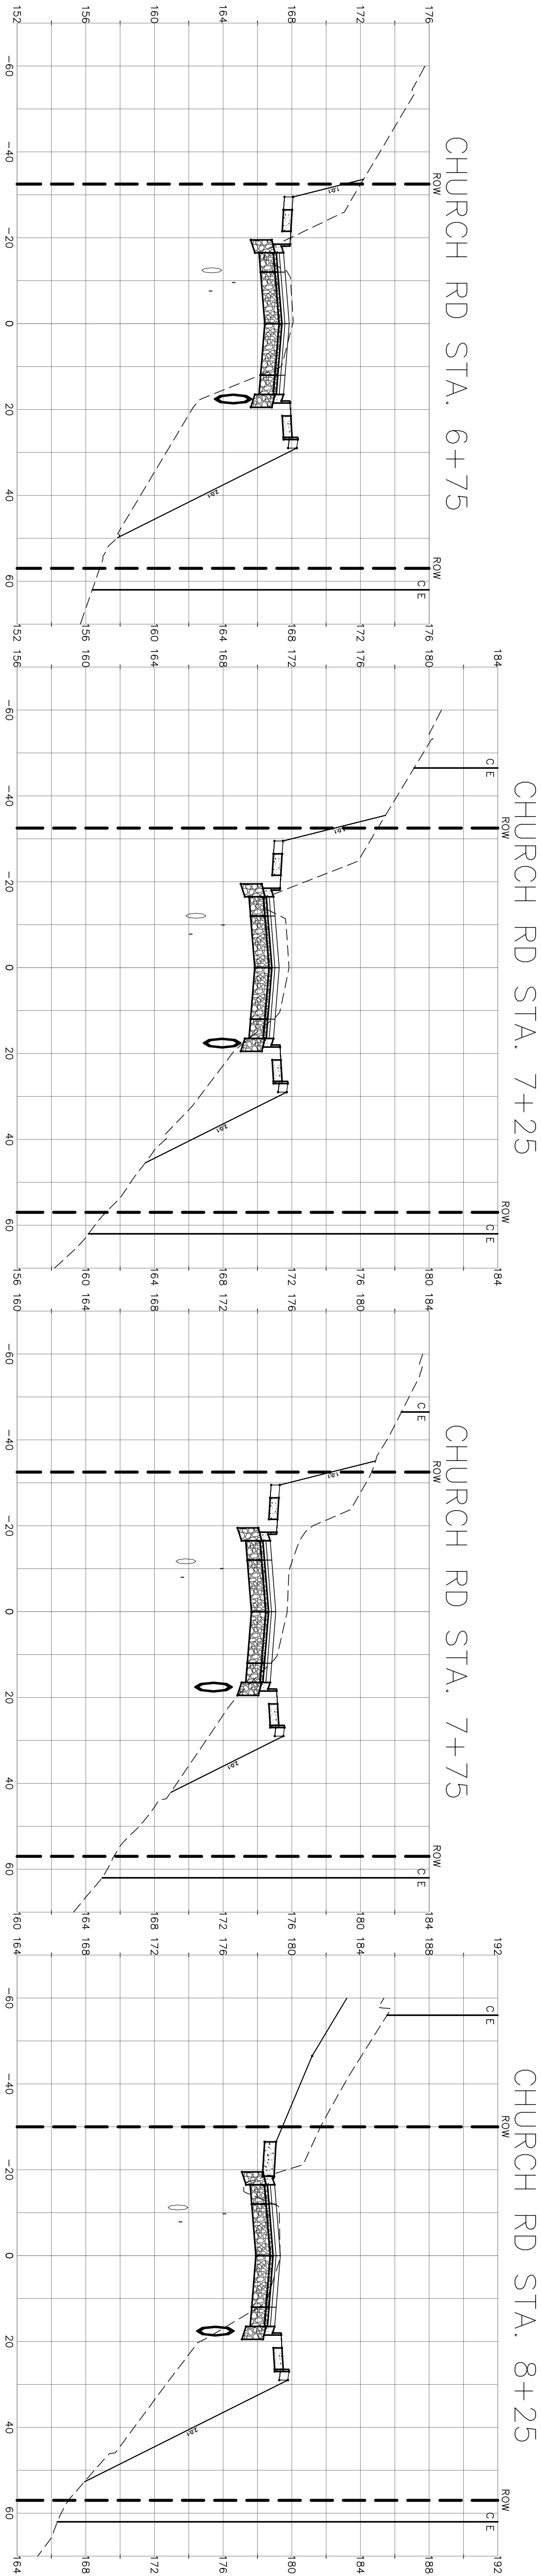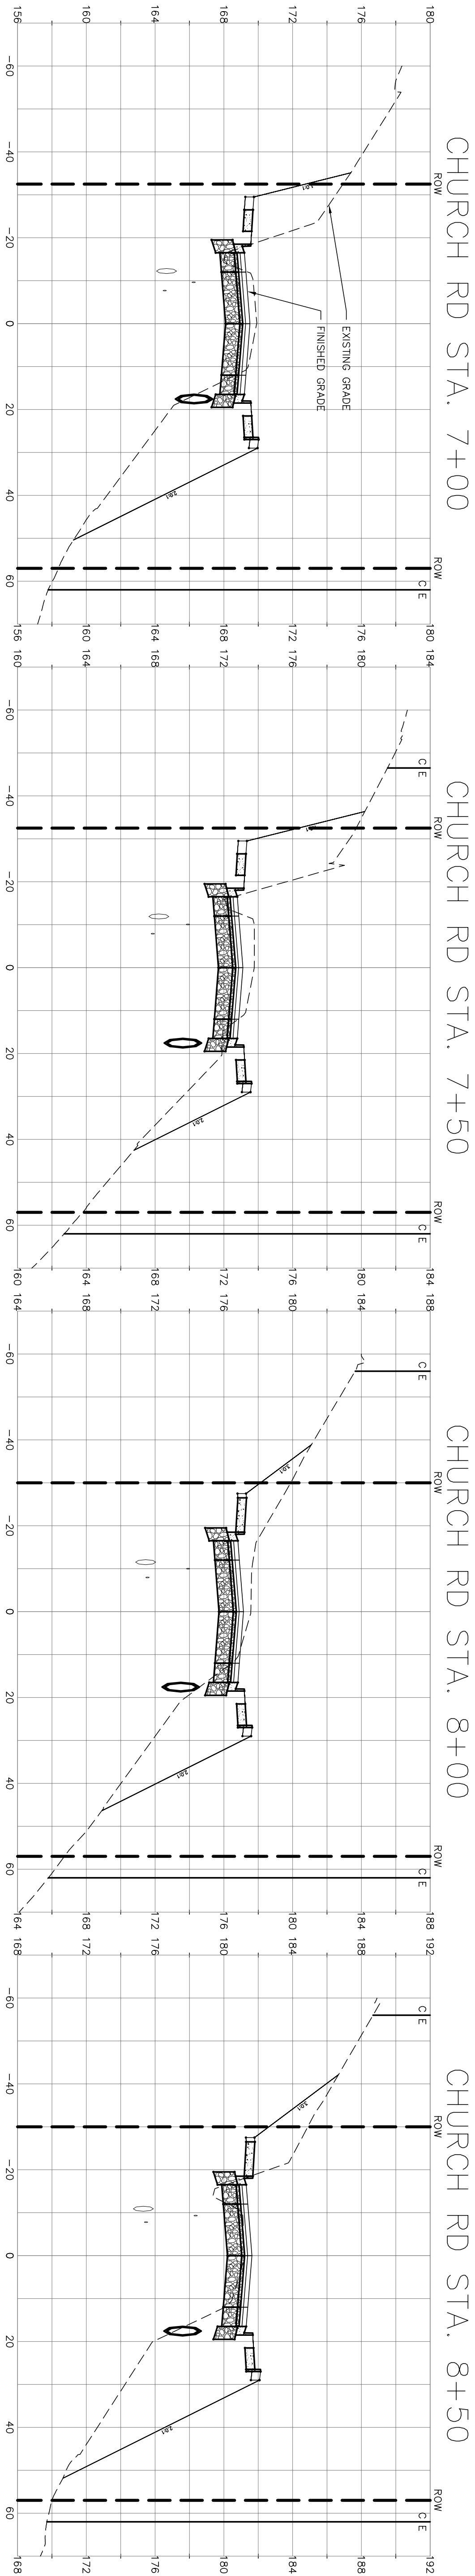

1/05/17
AS-BUILT

DESIGNED BY
LP/GKG
DRAWN BY
LMC
CHECKED BY
LP

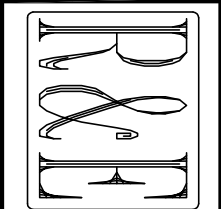



REICHHARDT & EBE
ENGINEERING, INC.
CONSULTING ENGINEERS
PO Box 978 423 Front St., Ste 201
Lynden, Washington 98264
Ph (360) 354-3687
Fax (360) 354-0407

NO.	DATE	REVISION	BY

CITY OF FERNDALE
2095 MAIN STREET
FERNDAL, WA 98248

CHURCH ROAD
STREET IMPROVEMENTS
CROSS SECTIONS


JOB# / DWG
AB07037 ALIGN_PROFILE
SCALE
H: 1" = 20' V: 1" = 5'
DATE
1-5-17
SHEET
49 of 64

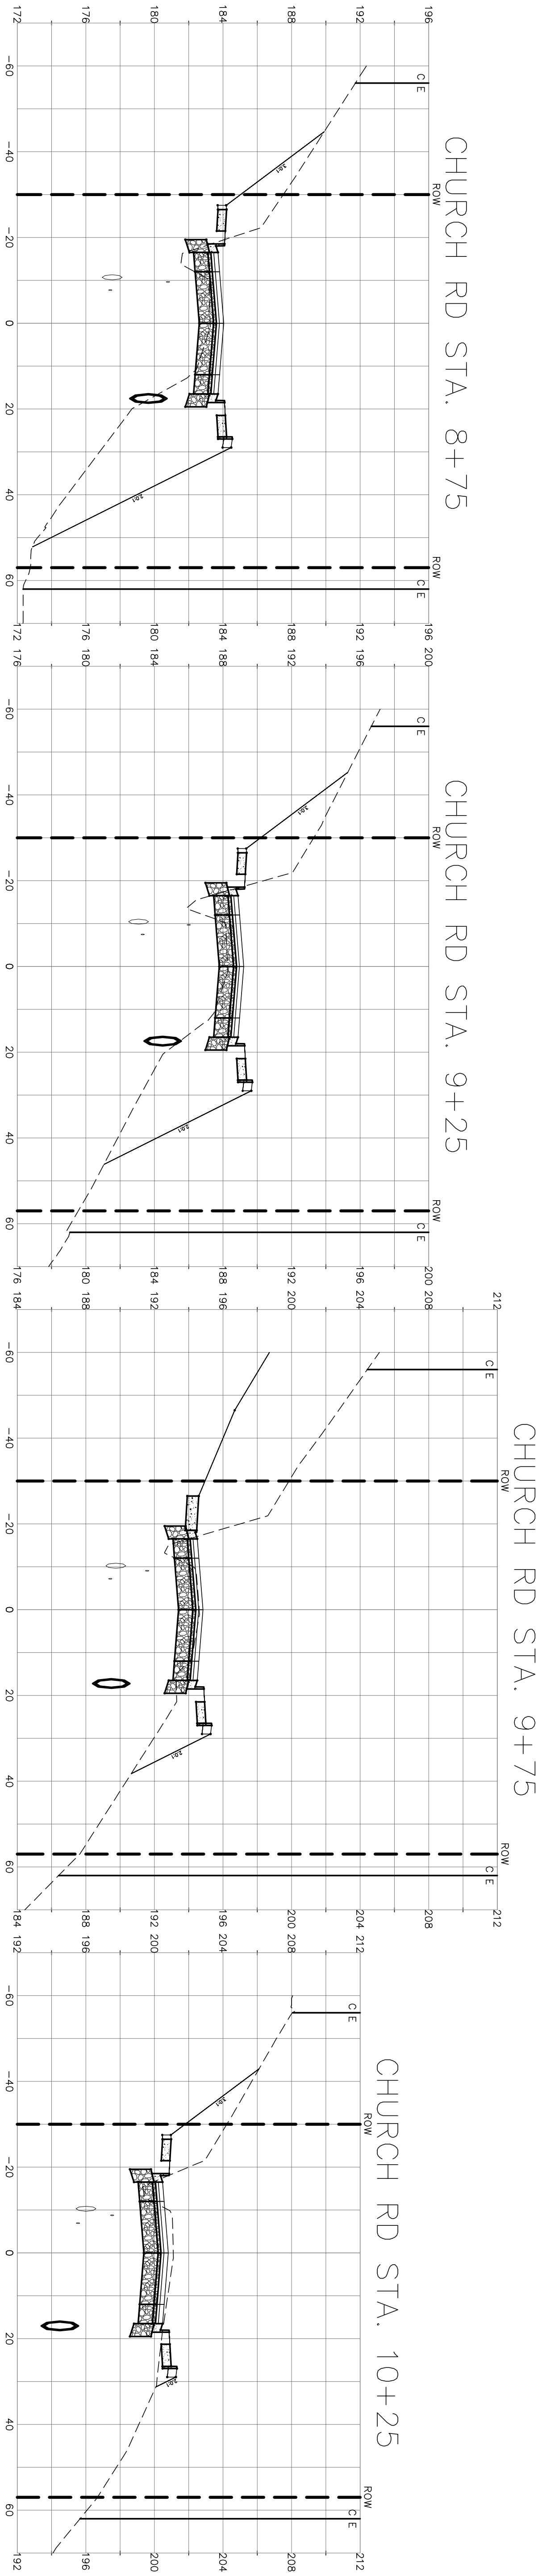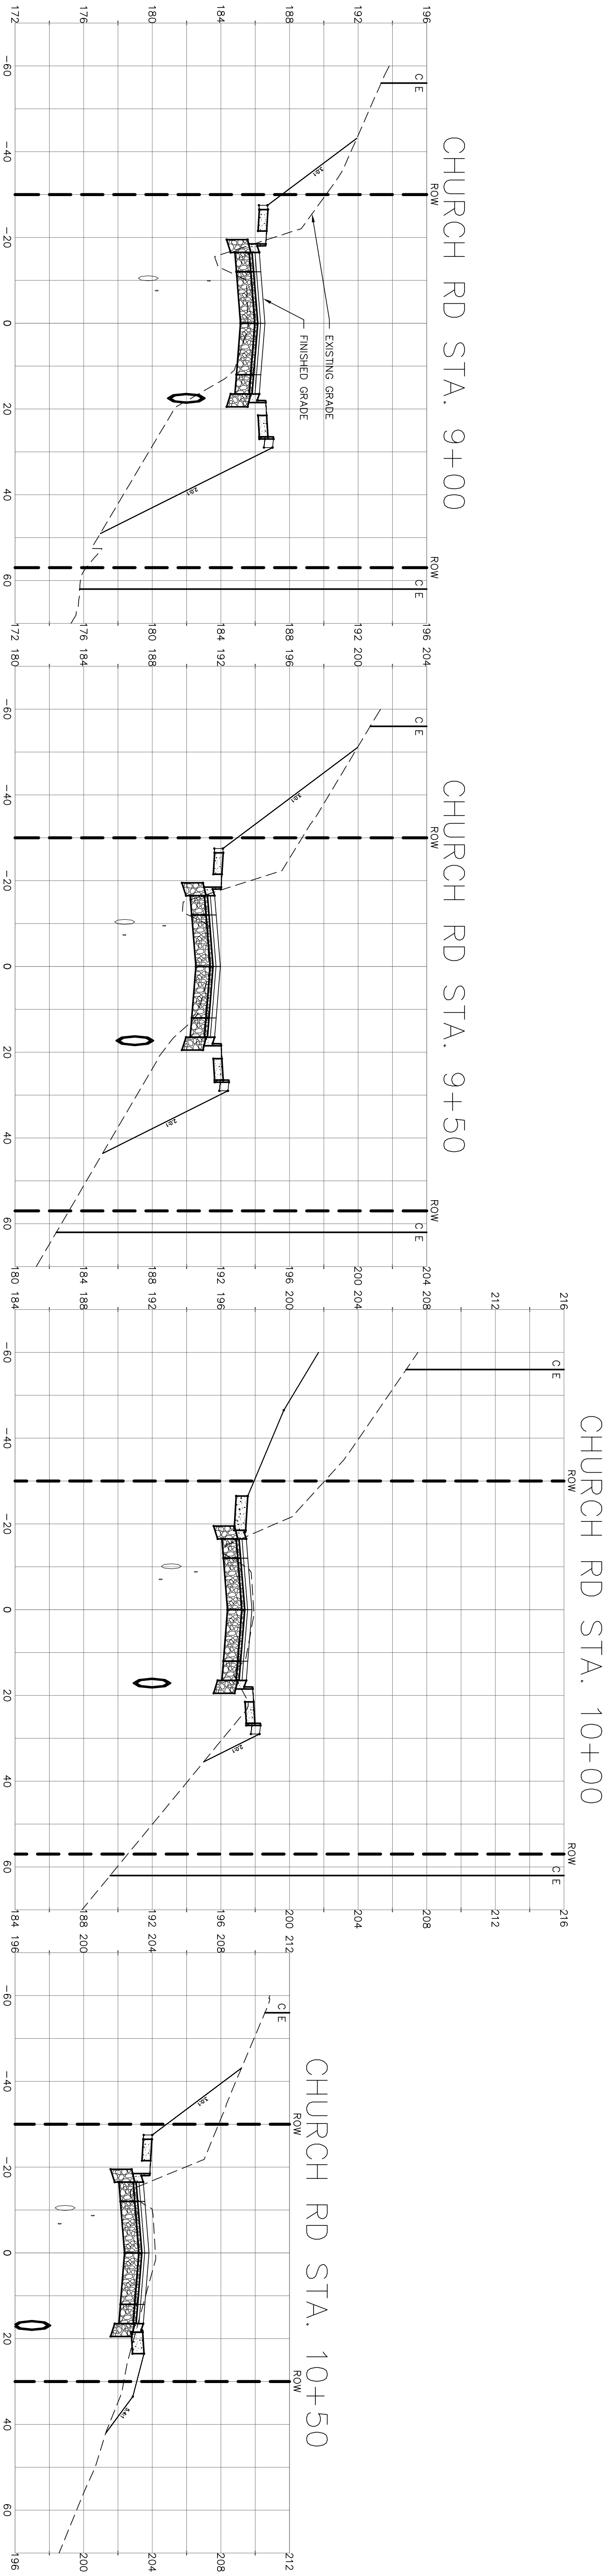

00616.050 4/17/17 KJ

1/05/17
AS-BUILT

DESIGNED BY
LP/GKG
DRAWN BY
LMC
CHECKED BY
LP

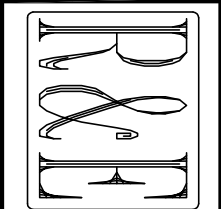

REICHHARDT & EBE
ENGINEERING, INC.
CONSULTING ENGINEERS
PO Box 978 423 Front St., Ste 201
Lynden, Washington 98264
Ph (360) 354-3687
Fax (360) 354-0407


NO.	DATE	REVISION	BY




CITY OF FERNDALE
2095 MAIN STREET
FERNDAL, WA 98248

CHURCH ROAD
STREET IMPROVEMENTS
CROSS SECTIONS

JOB# / DWG
A807037 ALIGN_PROFILE
SCALE
H: 1" = 20' V: 1" = 5'

DATE
1-5-17
SHEET
50 of 64

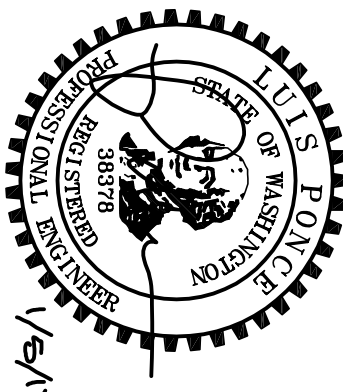


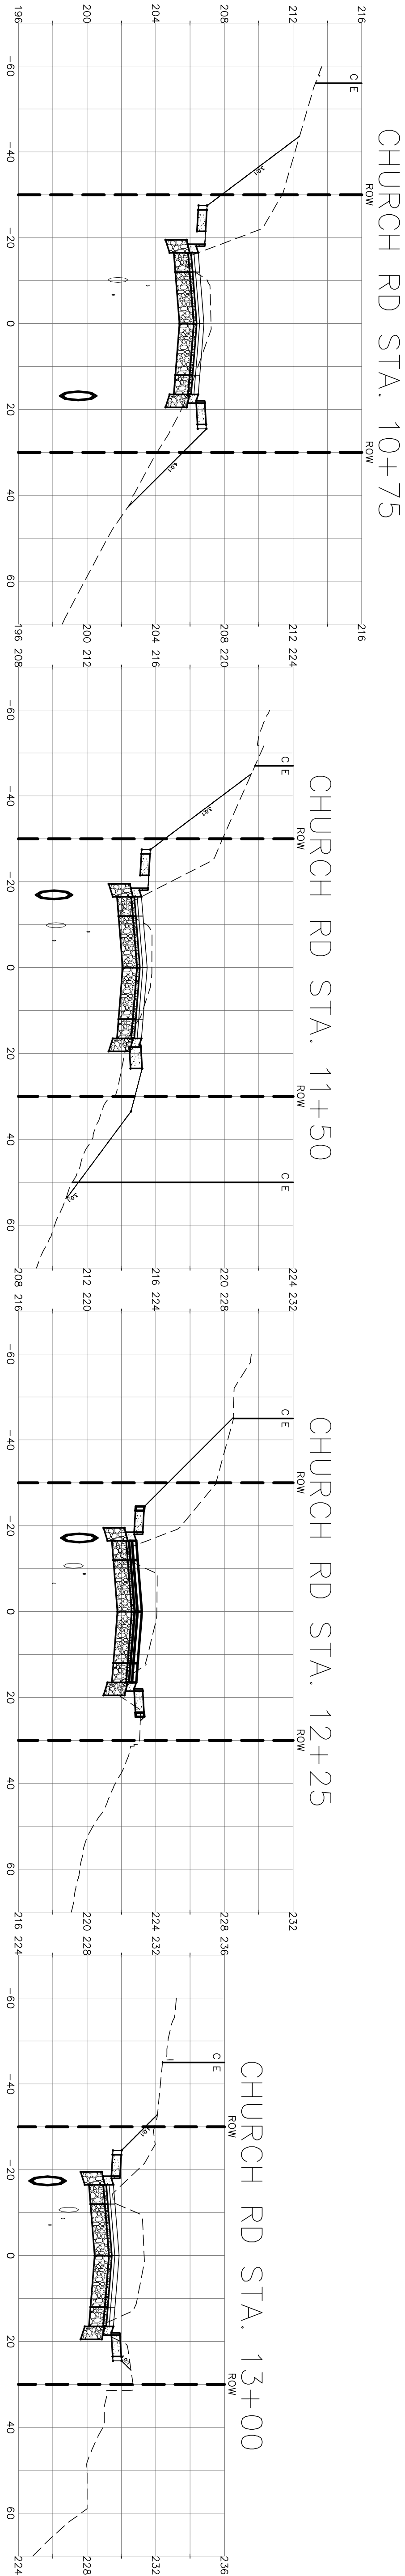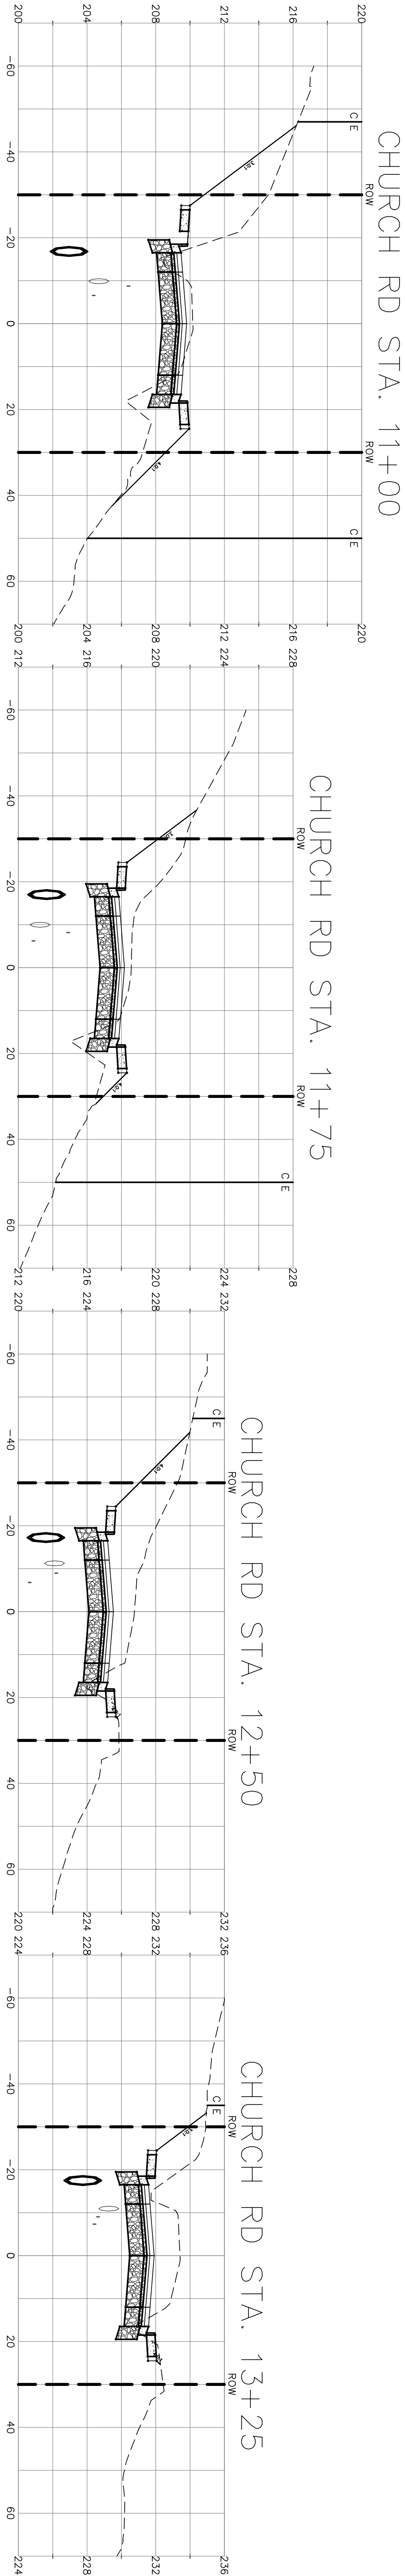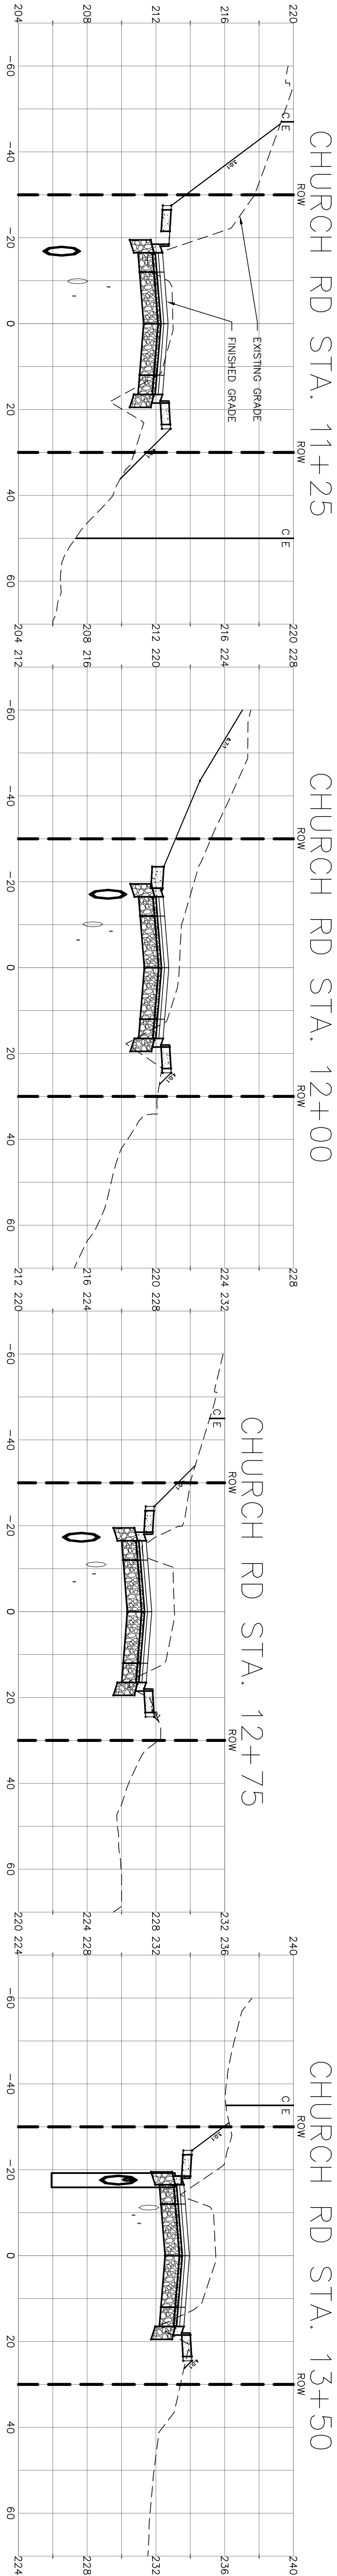

1/05/17

AS-BUILT

DESIGNED BY
LP/GKG
DRAWN BY
LMC
CHECKED BY
LP

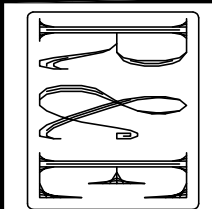

REICHHARDT & EBE
ENGINEERING, INC.
CONSULTING ENGINEERS
PO Box 978 423 Front St., Ste 201
Lynden, Washington 98264
Ph (360) 354-3687
Fax (360) 354-0407


NO.	DATE	REVISION	BY




CITY OF FERNDALE
2095 MAIN STREET
FERNDAL, WA 98248

CHURCH ROAD
STREET IMPROVEMENTS
CROSS SECTIONS




JOB# / DWG
AB07037 ALIGN_PROFILE
SCALE
H: 1" = 20' V: 1" = 5'

DATE
1-5-17
SHEET
51 of 64

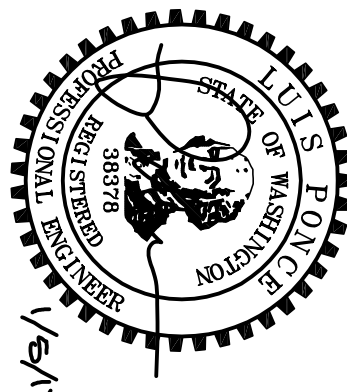

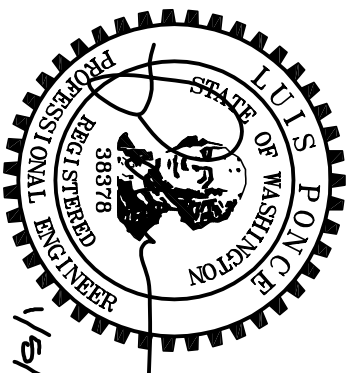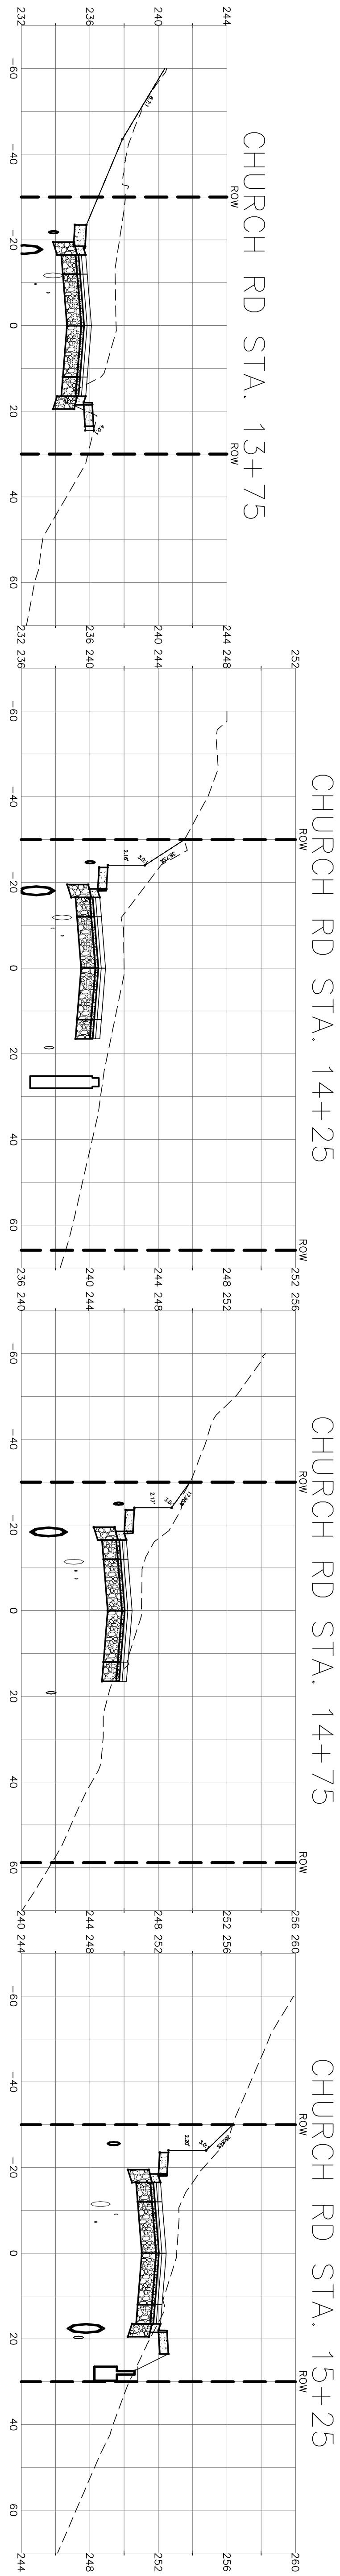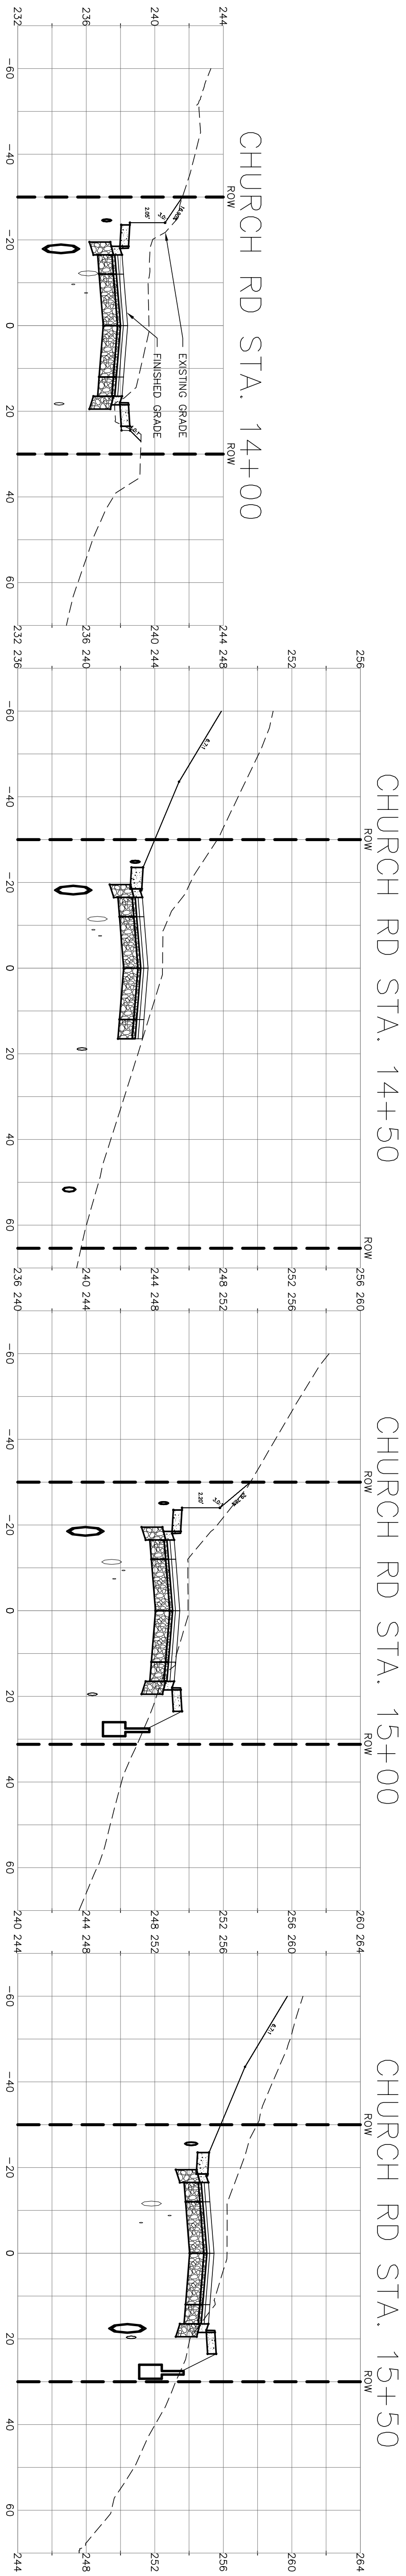

1/05/17		DESIGNED BY LP /GKG			REICHARDT & EBE ENGINEERING, INC. CONSULTING ENGINEERS PO Box 978 423 Front St., Ste 201 Lynden, Washington 98264 Ph (360) 354-3687 Fax (360) 354-0407												
		DRAWN BY LMC															
		CHECKED BY LP															
AS-BUILT																	
CITY OF FERNDALE 2095 MAIN STREET FERNDAL, WA 98248																	
CHURCH ROAD STREET IMPROVEMENTS CROSS SECTIONS																	
JOB# / DWG AB07037 ALIGN_PROFILE		DATE 1-5-17															
SCALE h: 1" = 20' v: 1" = 5'		SHEET 52 of 64															

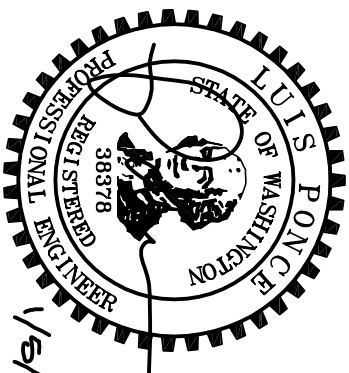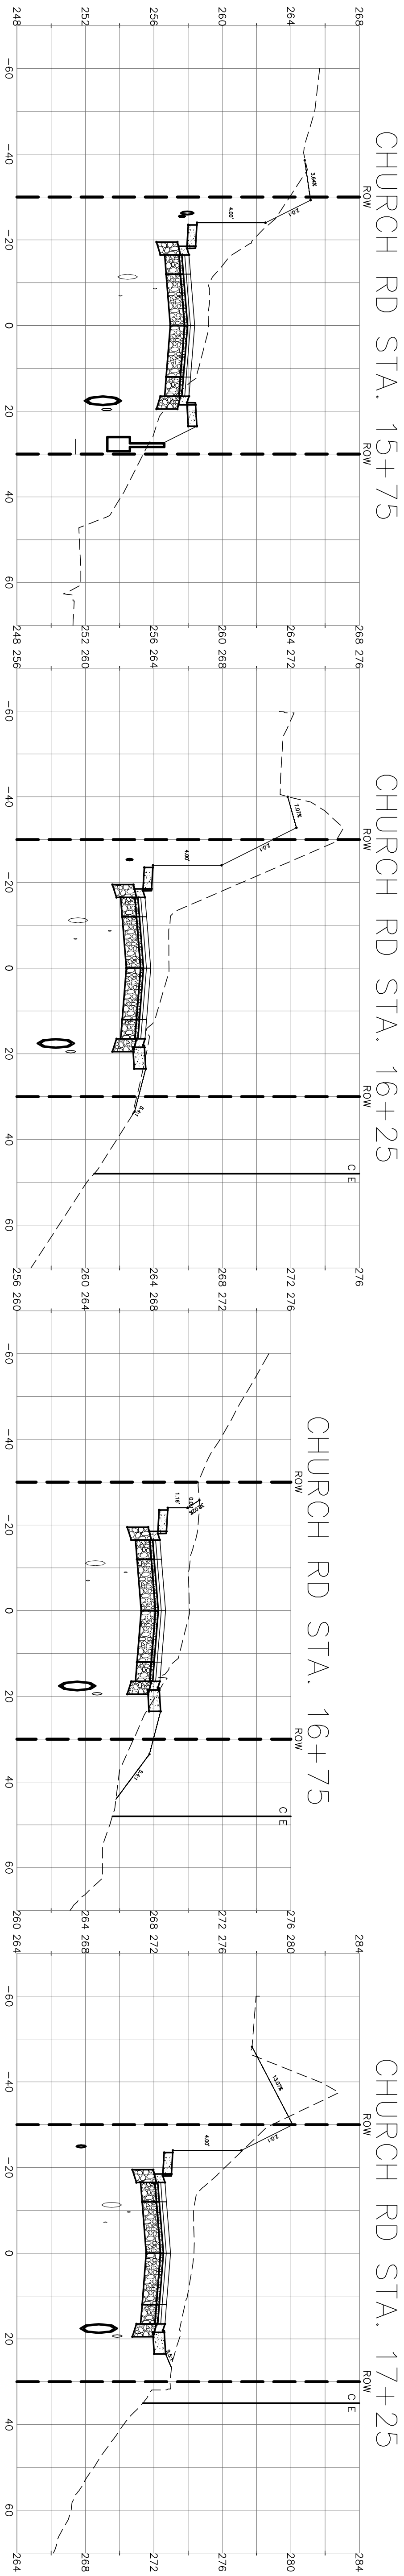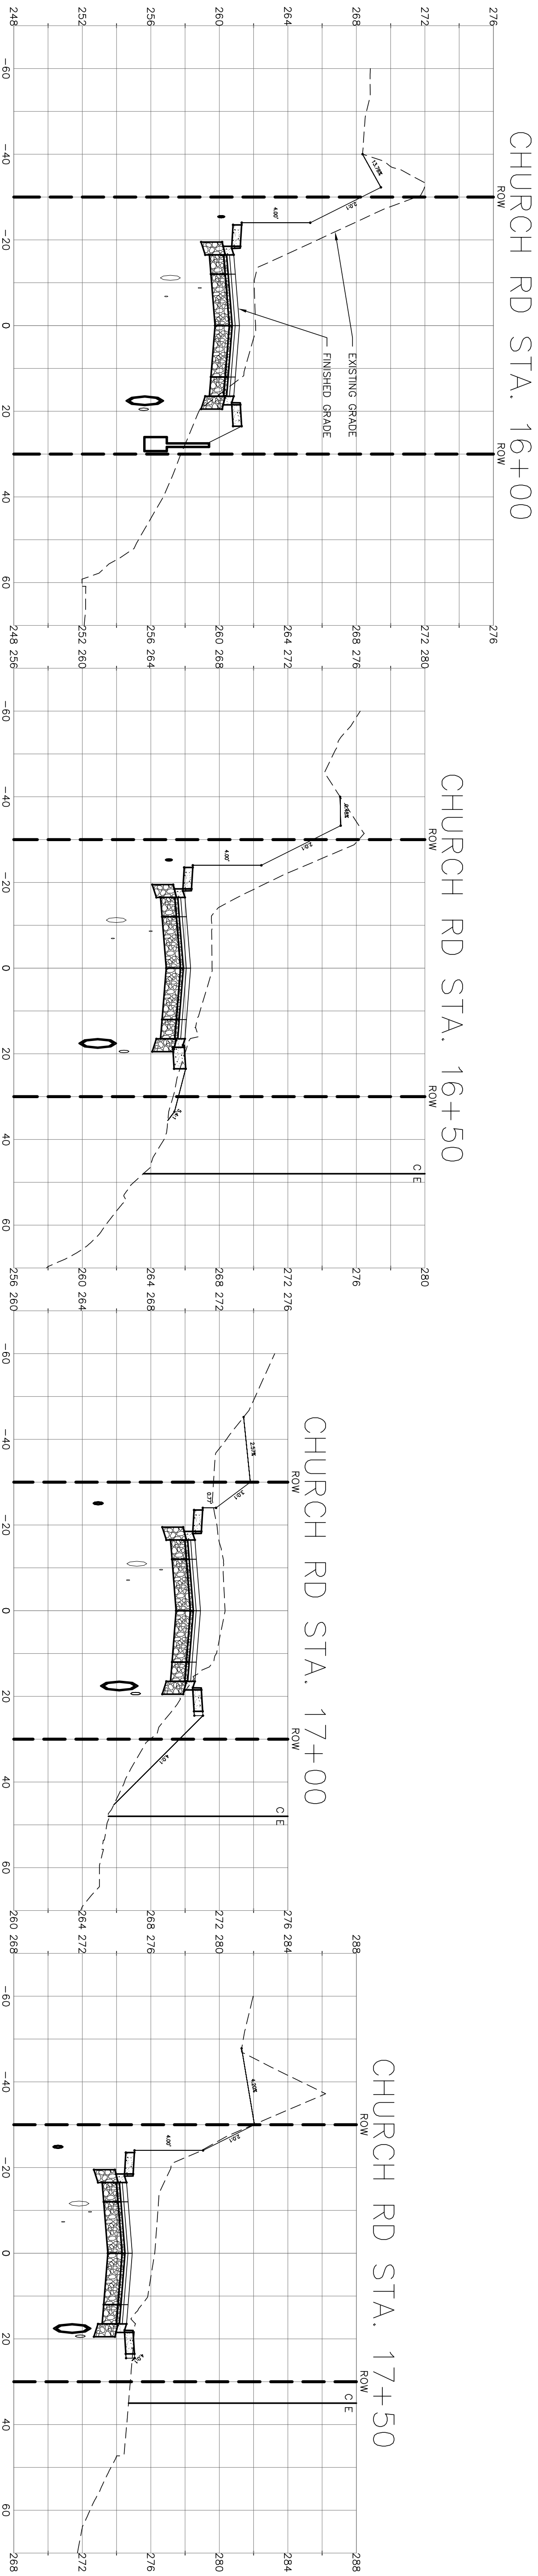


1/05/17

AS-BUILT

DESIGNED BY
LP / GKG

DRAWN BY
LMC

CHECKED BY
LP

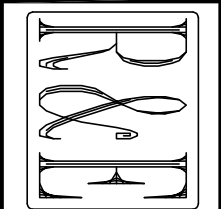

REICHHARDT & EBE
ENGINEERING, INC.
CONSULTING ENGINEERS
PO Box 978 423 Front St., Ste 201
Lynden, Washington 98264
Ph (360) 354-3687
Fax (360) 354-0407

NO.

DATE

REVISION

BY

CITY OF FERNDALE
2095 MAIN STREET
FERNDAL, WA 98248





CHURCH ROAD
STREET IMPROVEMENTS
CROSS SECTIONS

JOB# / DWG
AB07037 ALIGN_PROFILE

SCALE
H: 1" = 20' V: 1" = 5'

DATE
1-5-17

SHEET
53 of 64

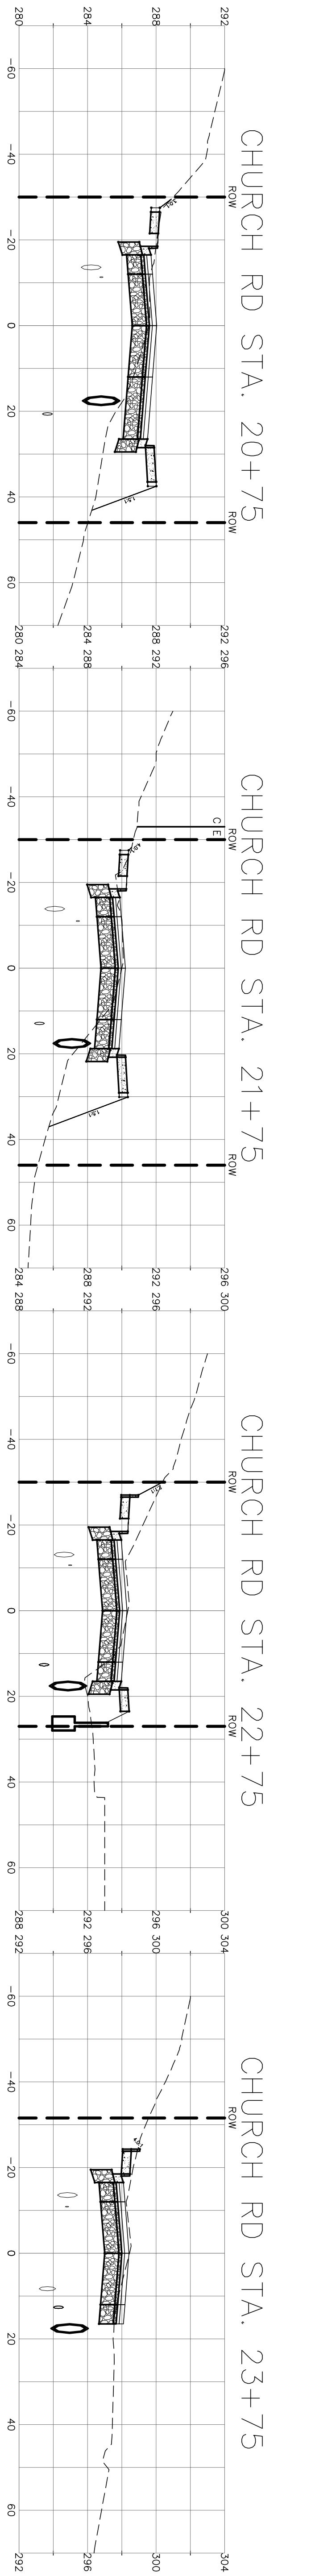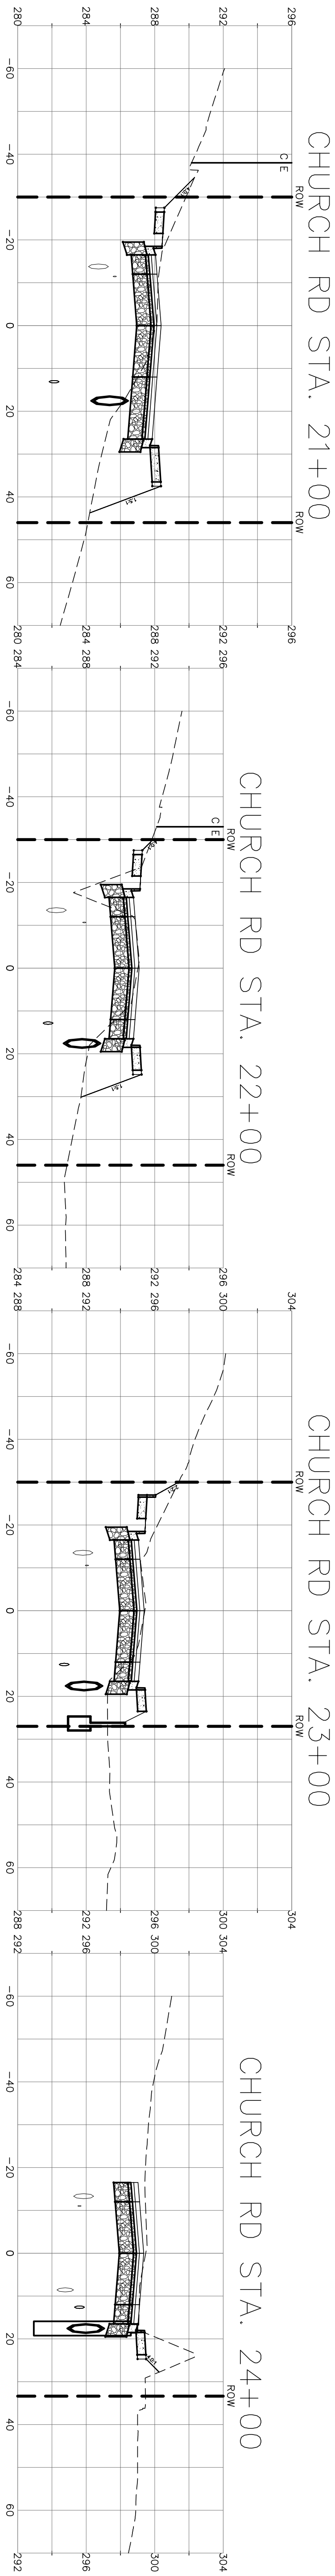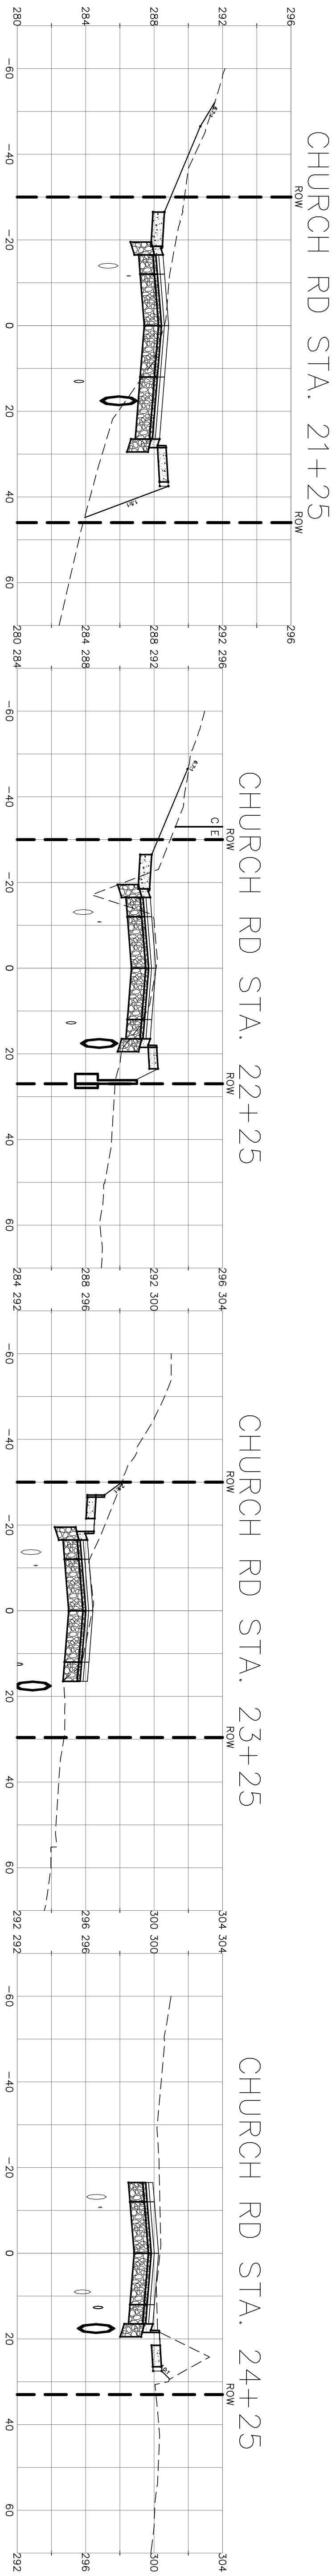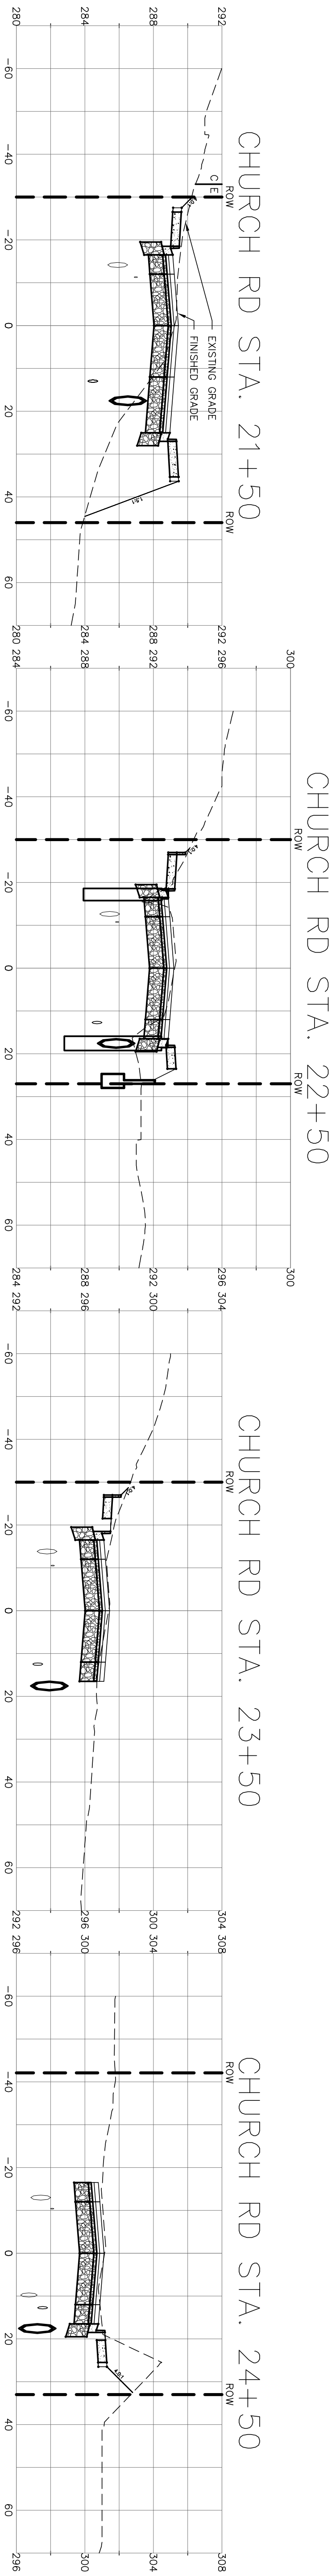

1/05/17

AS-BUILT

DESIGNED BY
LP/GKG

DRAWN BY
LMC

CHECKED BY
LP

REICHARDT & EBE
ENGINEERING, INC.
CONSULTING ENGINEERS
PO Box 978 423 Front St., Ste 201
Lynden, Washington 98264

Ph (360) 354-3687
Fax (360) 354-0407

NO.

DATE

REVISION

CITY OF FERNDALE
2095 MAIN STREET
FERNDAL, WA 98248


CHURCH ROAD
STREET IMPROVEMENTS
CROSS SECTIONS






JOB# / DWG
AB07037 ALIGN_PROFILE

SCALE
H: 1" = 20' V: 1" = 5'

DATE
1-5-17
SHEET
55 of 64

1/6/17

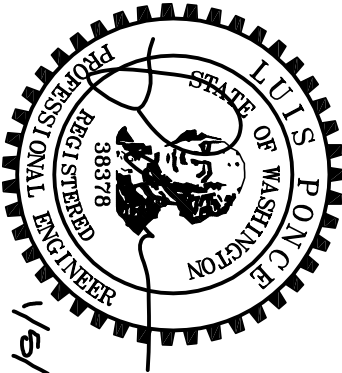


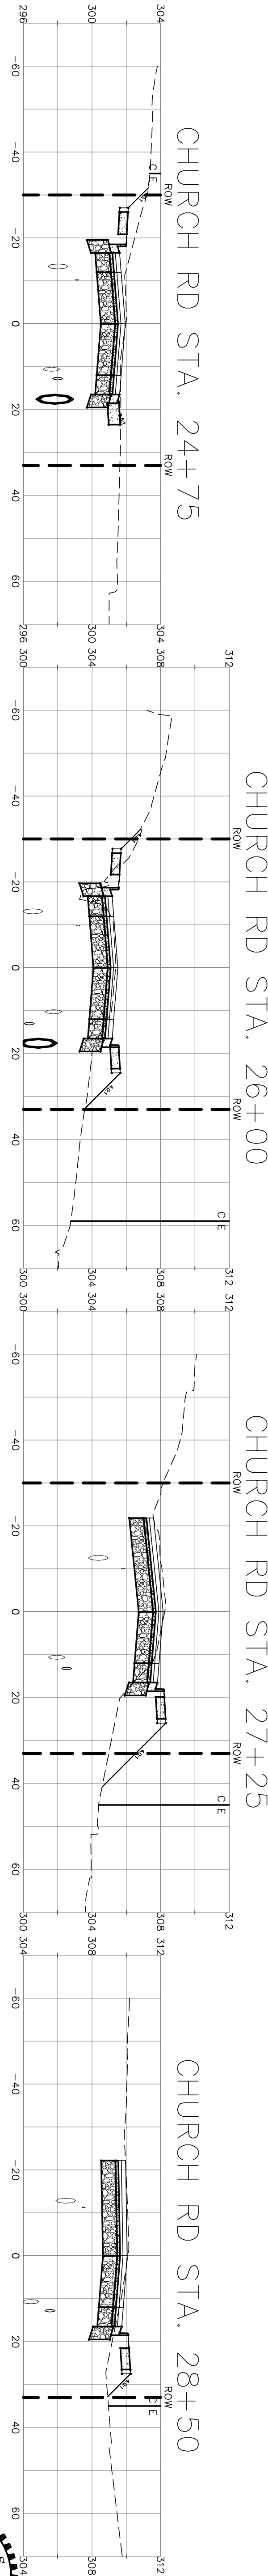
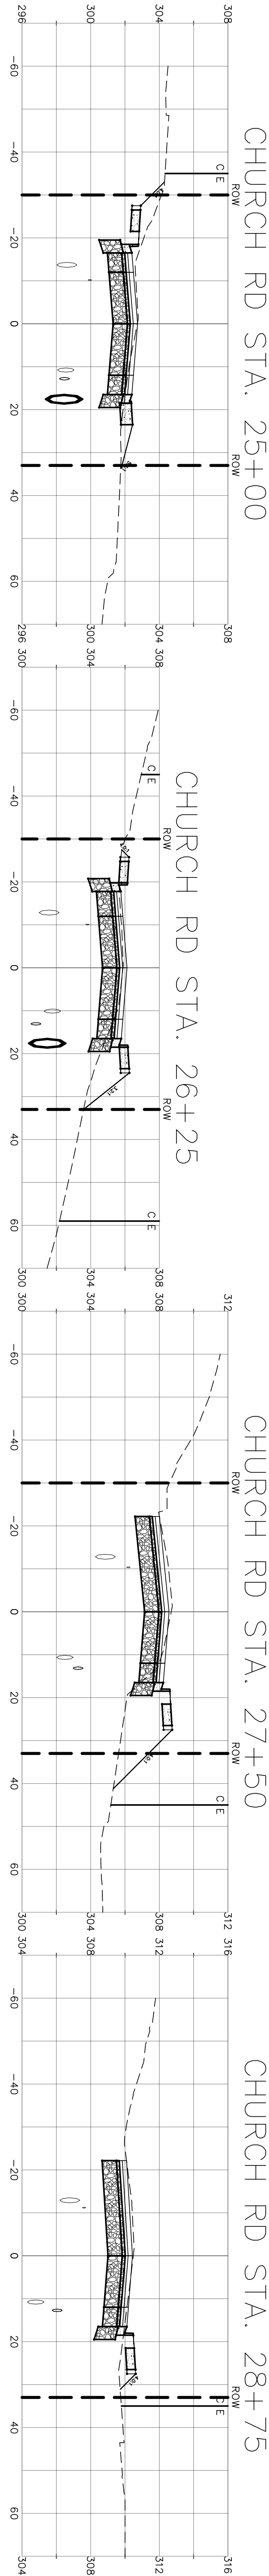
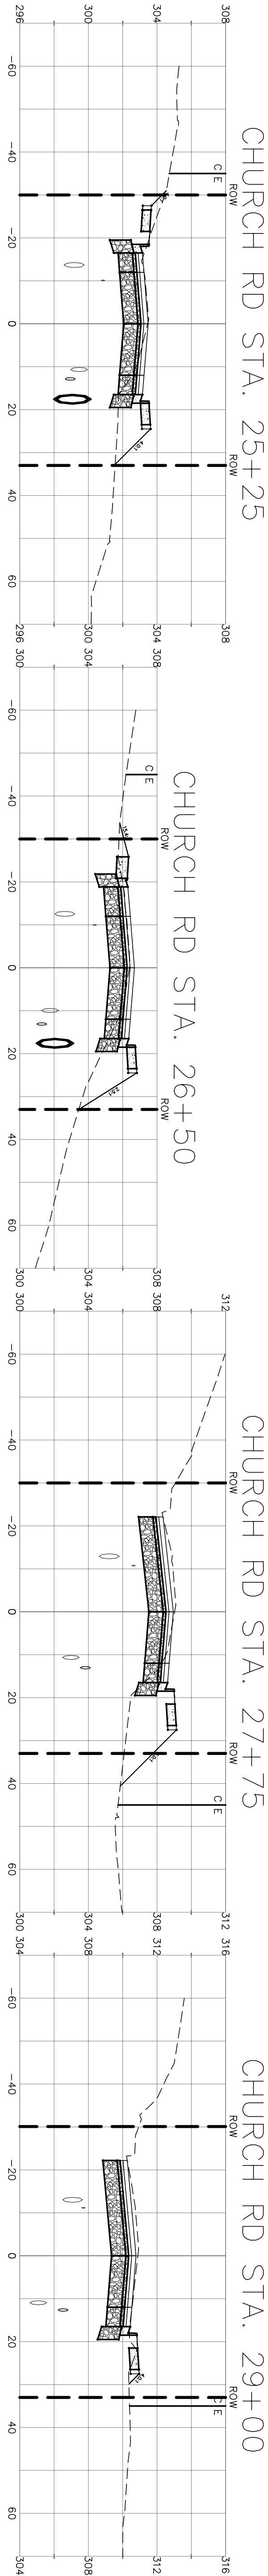
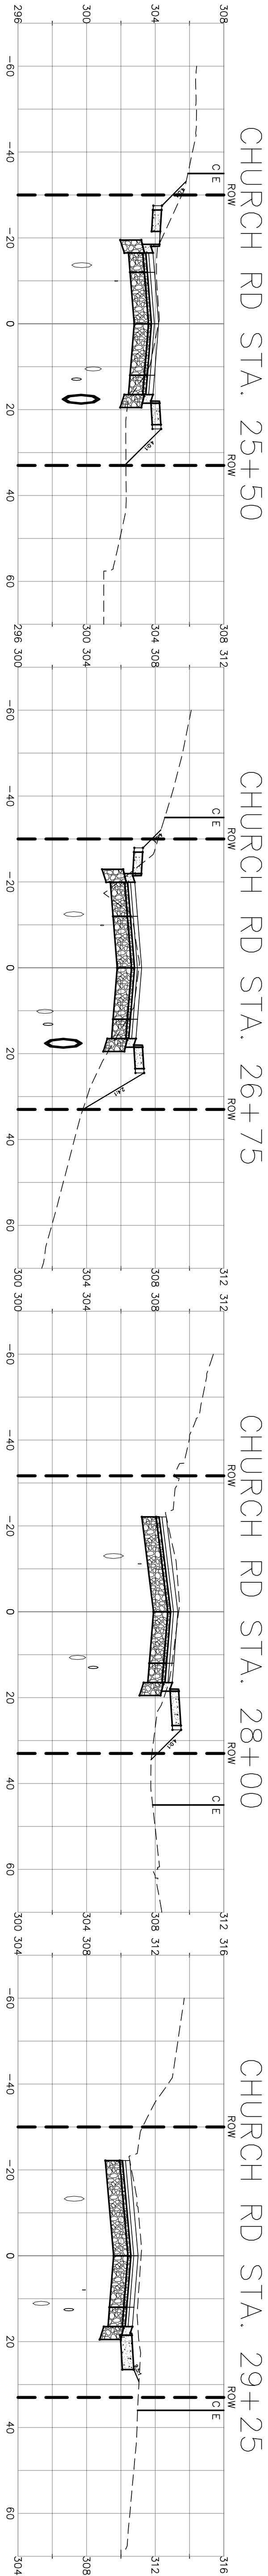
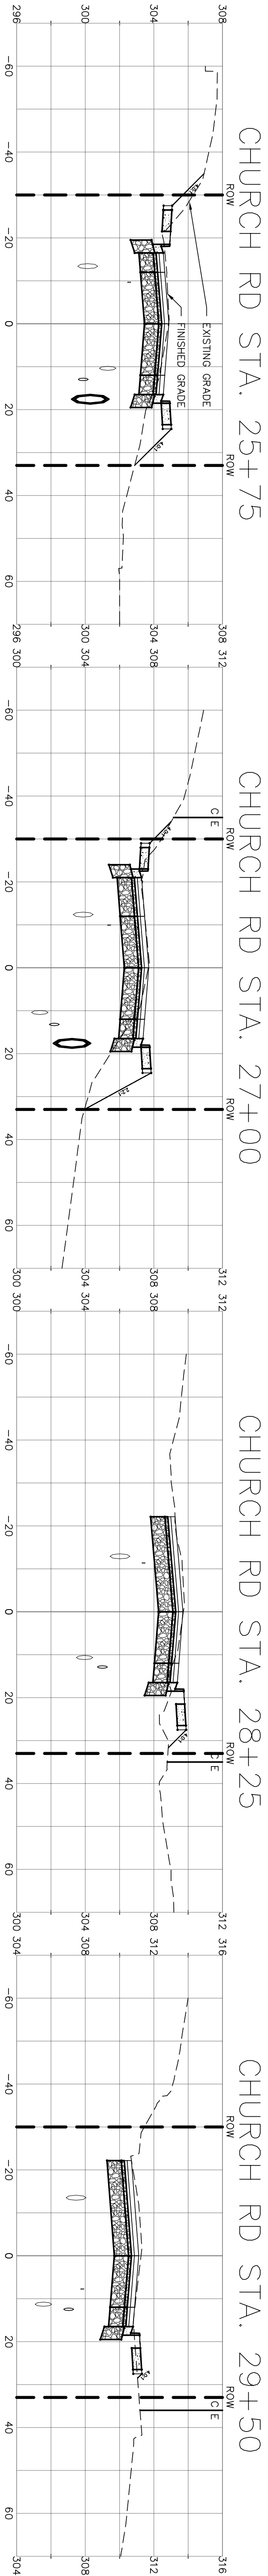


00616.056 4/17/17 KJ

1/05/17 AS-BUILT				DESIGNED BY LP/GKG		DRAWN BY LMC		CHECKED BY LP		REVISION		BY		CITY OF FERNDALE 2095 MAIN STREET FERNDAL, WA 98248		CHURCH ROAD STREET IMPROVEMENTS CROSS SECTIONS		JOB# / DWG AB07037 ALIGN_PROFILE		DATE 1-5-17		SHEET 56 of 64	

REICHHARDT & EBE
ENGINEERING, INC.
CONSULTING ENGINEERS
PO Box 978 423 Front St., Ste 201
Lynden, Washington 98264
Ph (360) 354-3687
Fax (360) 354-0407

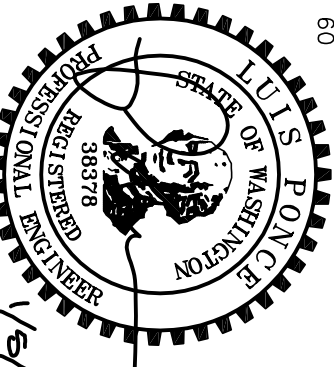

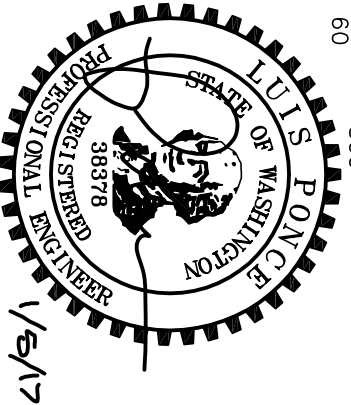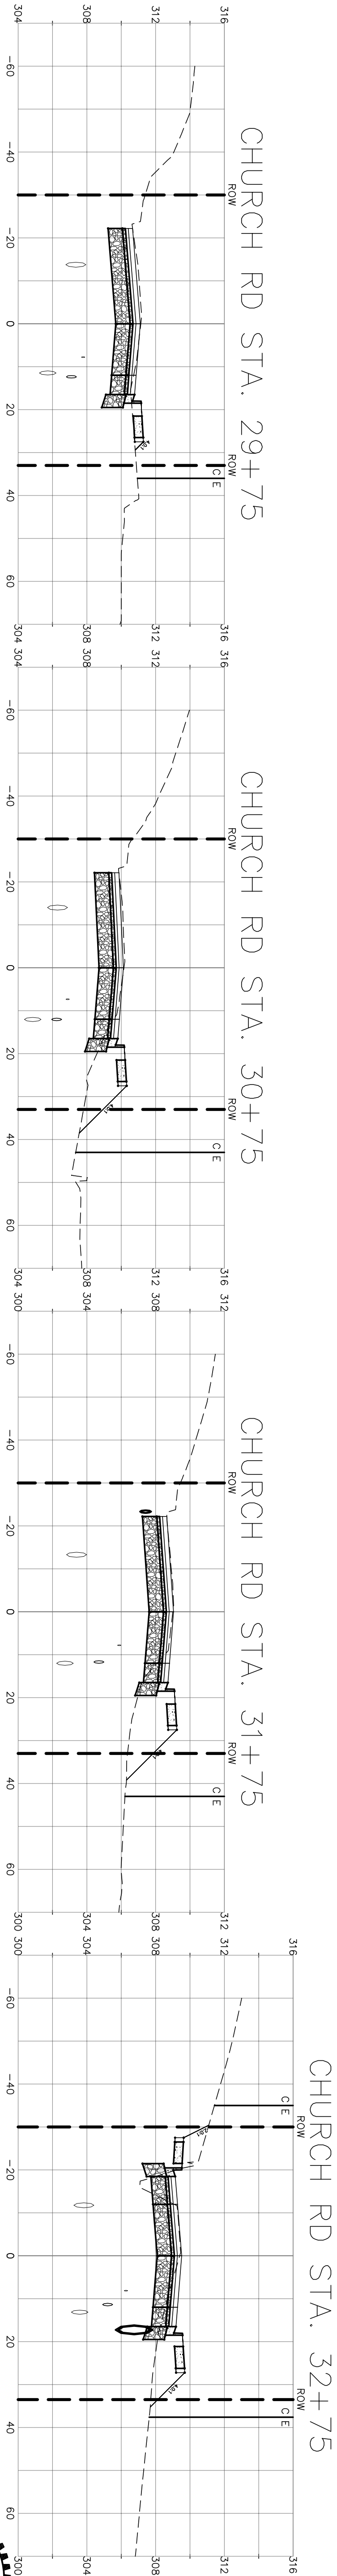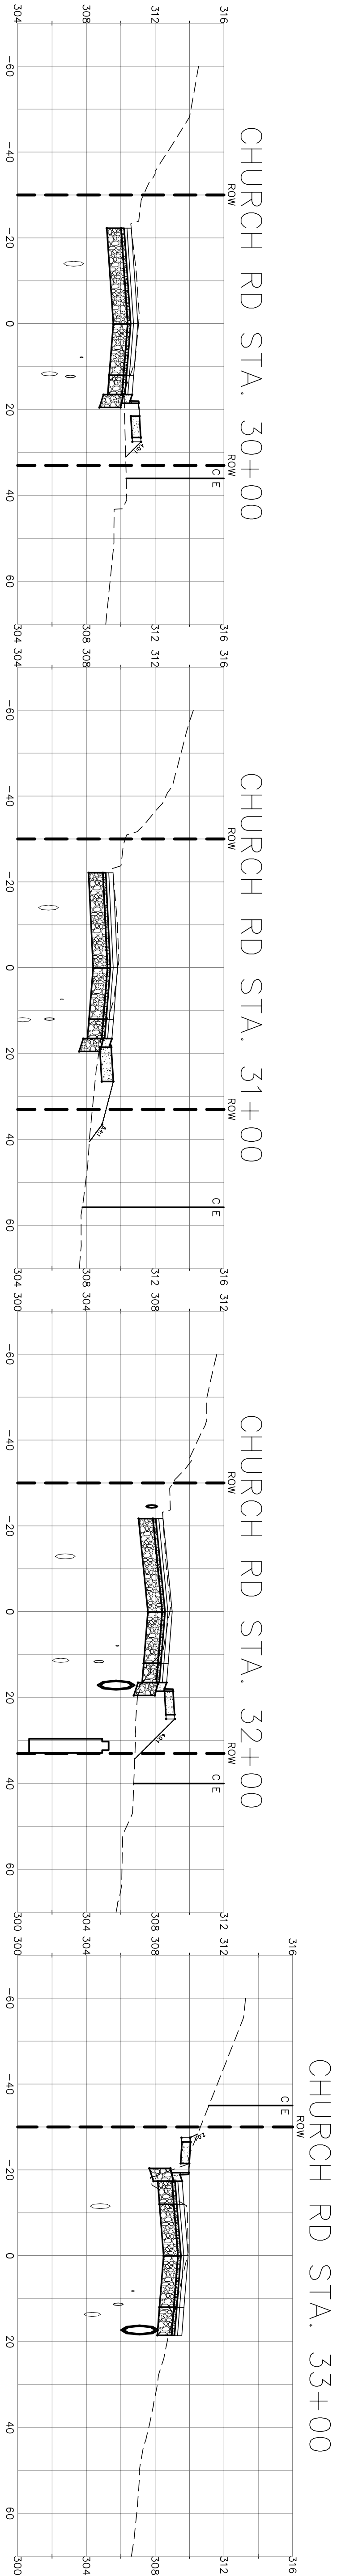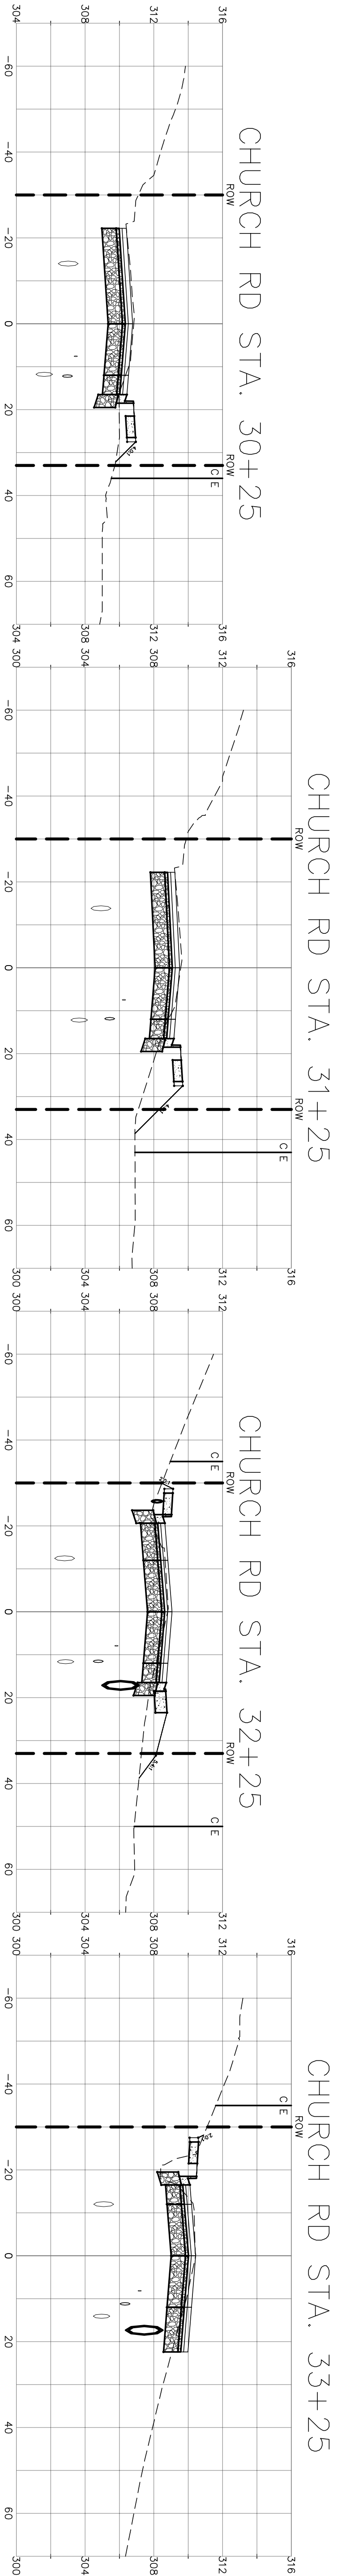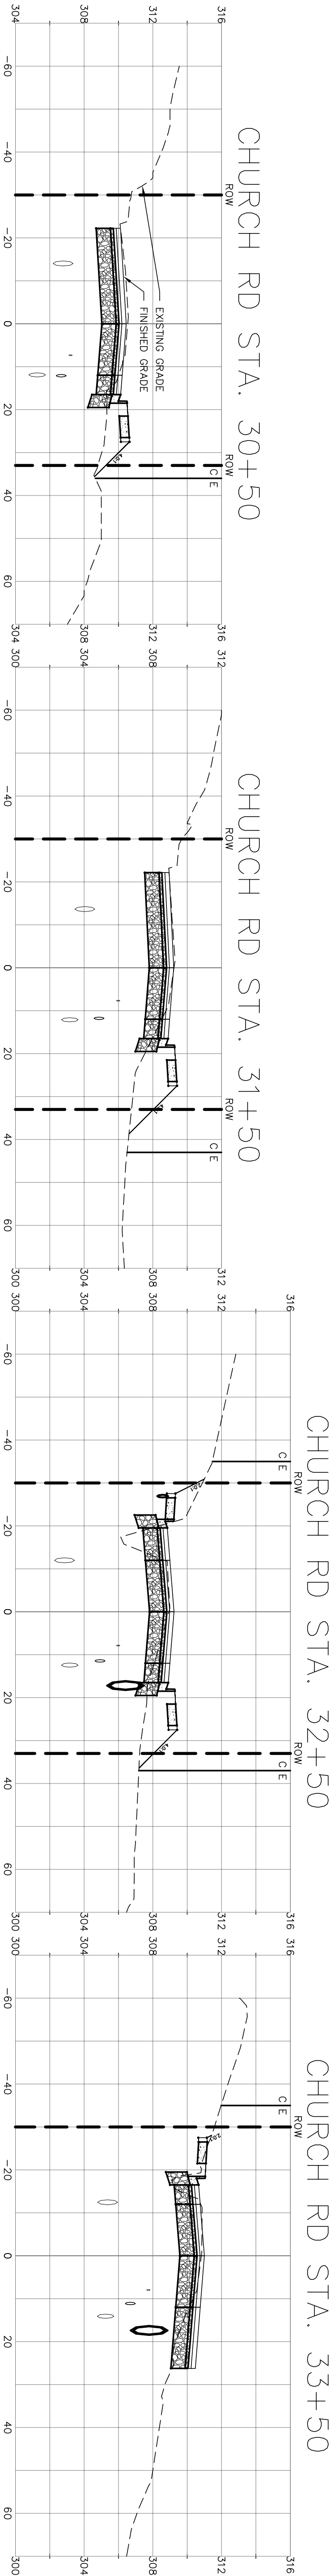

1/05/17

AS-BUILT

DESIGNED BY
LP/GKG
DRAWN BY
LMC
CHECKED BY
LP

R&E

REICHARDT & EBE
ENGINEERING, INC.
CONSULTING ENGINEERS
PO Box 978 423 Front St., Ste 201
Lynden, Washington 98264
Ph (360) 354-3687
Fax (360) 354-0407

NO. DATE

REVISION





BY

CITY OF FERNDALE
2095 MAIN STREET
FERNDAL E, WA 98248


CHURCH ROAD
STREET IMPROVEMENTS
CROSS SECTIONS


JOB# / DWG
AB07037 ALIGN_PROFILE
SCALE
H: 1" = 20' V: 1" = 5'

DATE
1-5-17
SHEET
57 of 64

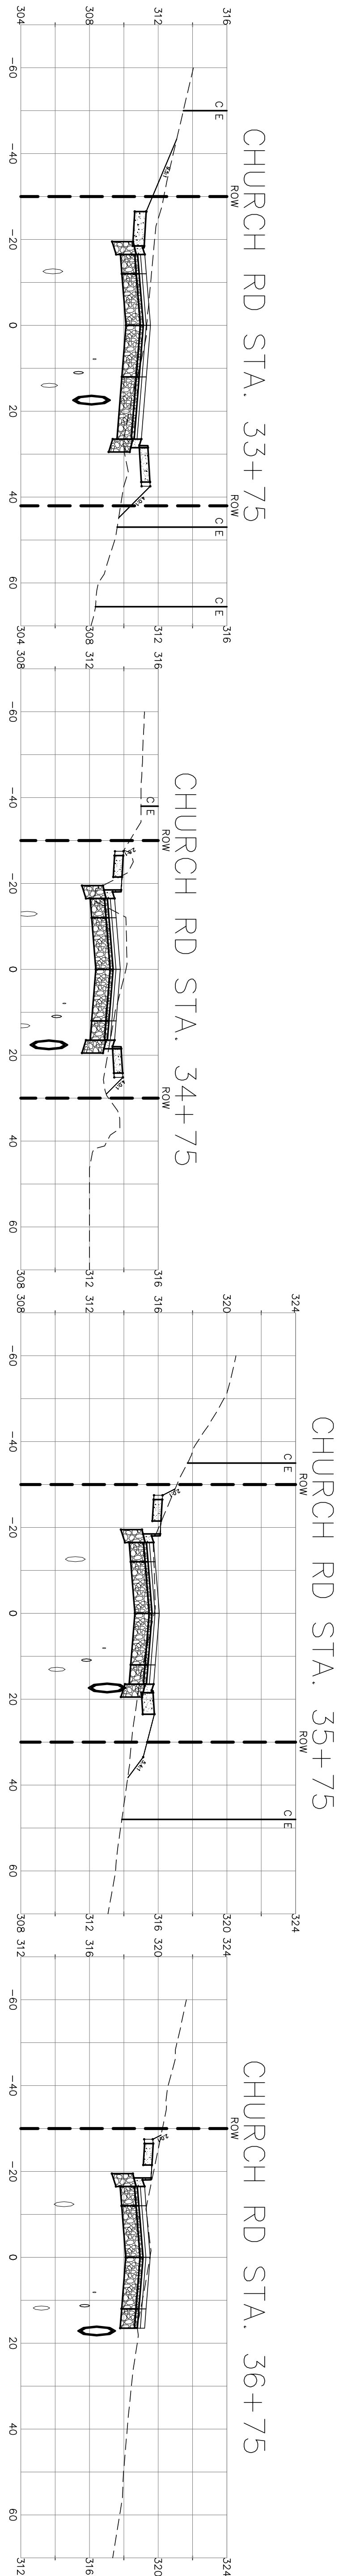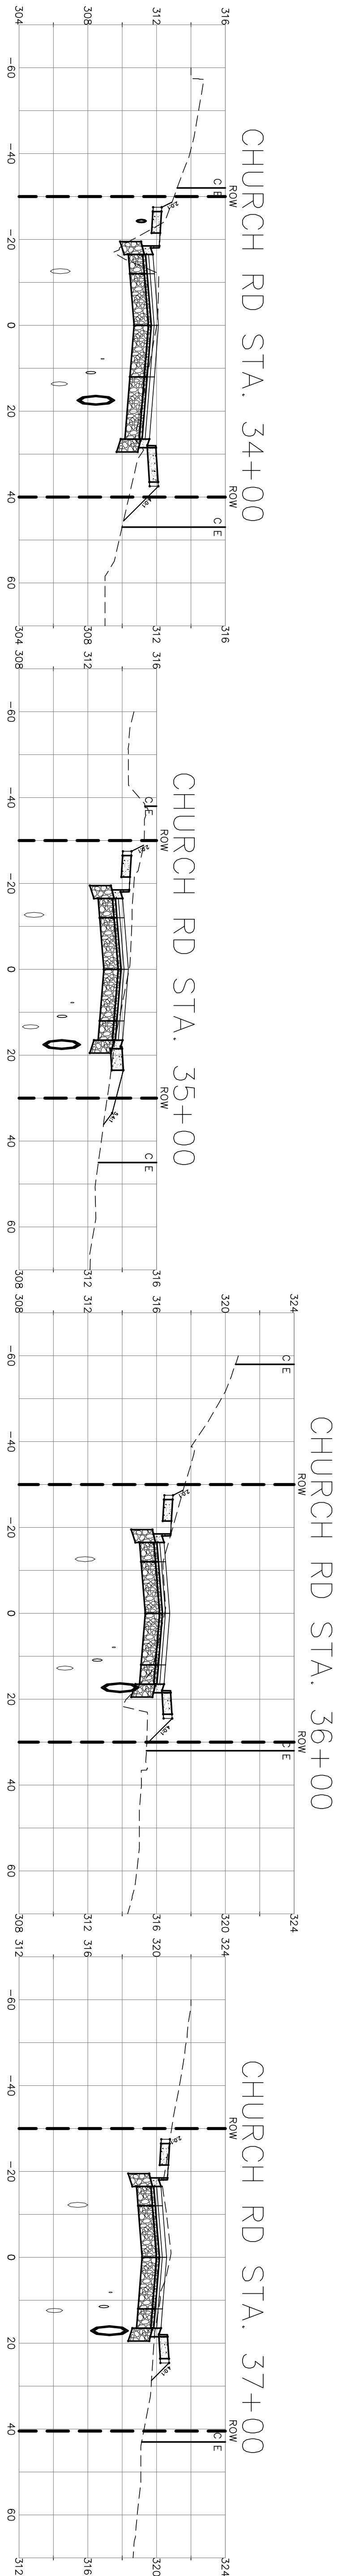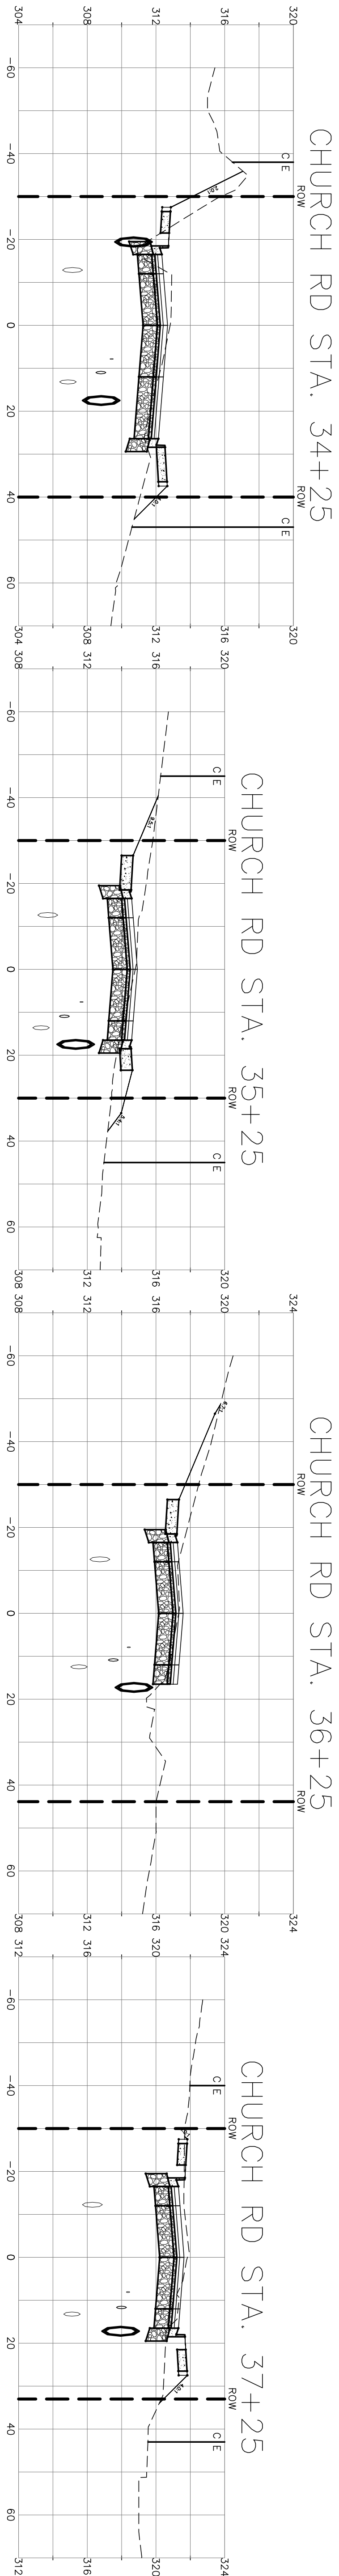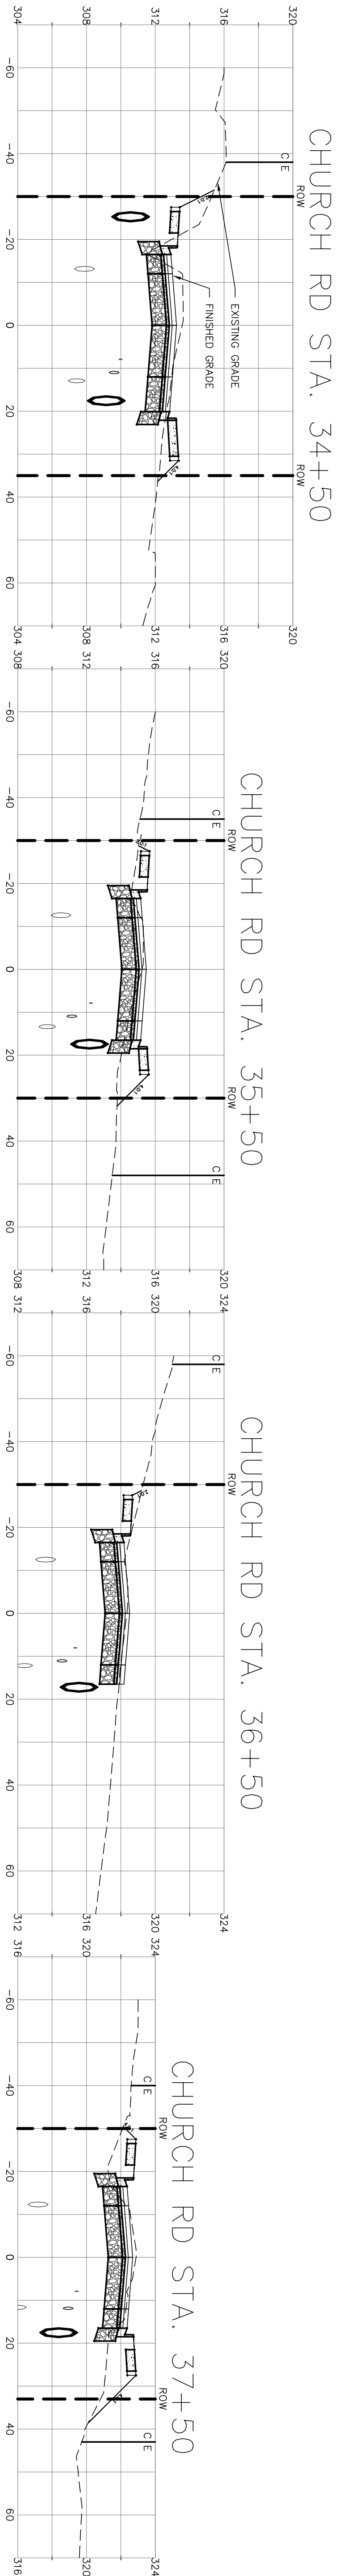

1/05/17		DESIGNED BY LP/GKG		CITY OF FERNDALE 2095 MAIN STREET FERNDALE, WA 98248		JOB# / DWG AB07037 ALIGN_PROFILE		DATE 1-5-17	
AS-BUILT		DRAWN BY LMC		REICHARDT & EBE ENGINEERING, INC. PO Box 978 423 Front St., Ste 201 Lynden, Washington 98264		STREET IMPROVEMENTS CROSS SECTIONS		SHEET 58 of 64	
		CHECKED BY LP		R&E		NO.		DATE	
				REVISION		BY			

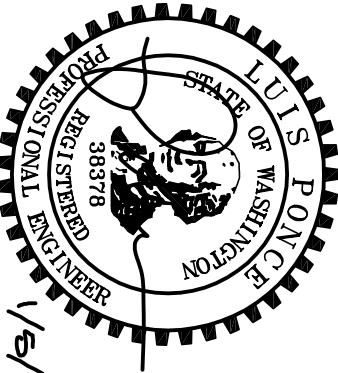


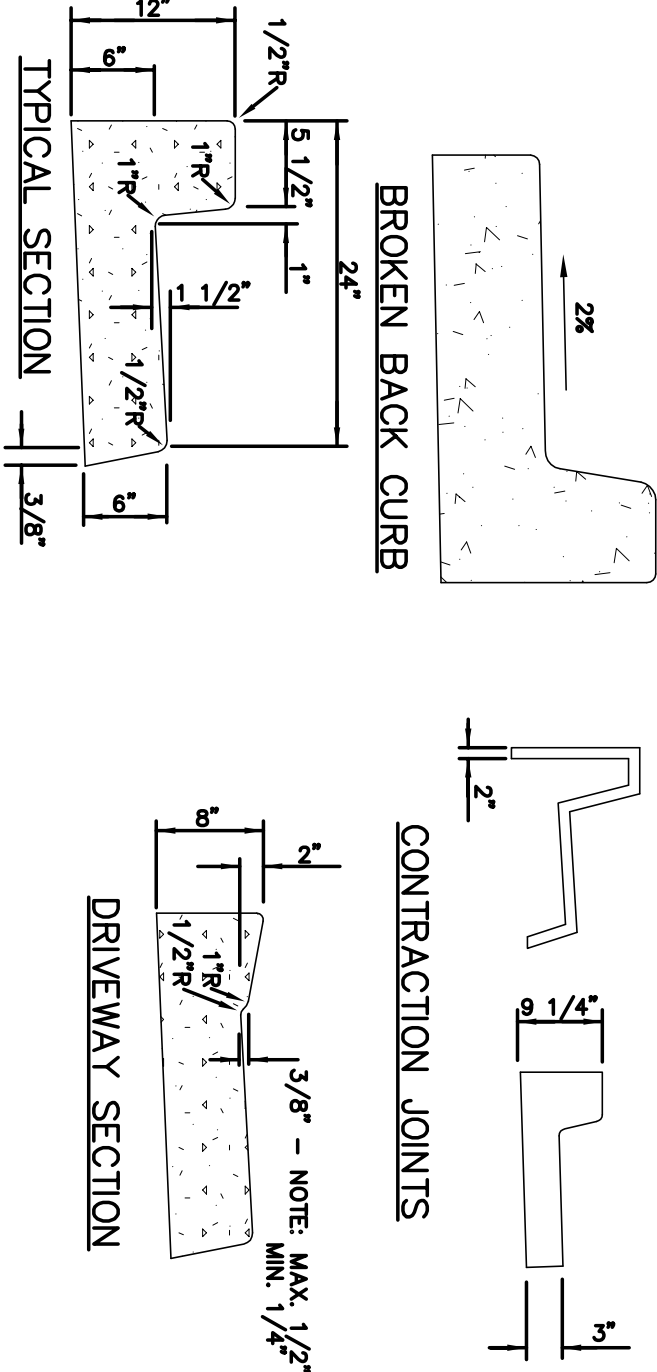

NOTES:
CONTRACTION JOINTS OF ONE OF THE TYPES SHOWN ABOVE TO BE PLACED 10' C/C. JOINTS COMPLETELY SEPAR THE STRUCTURE TO THE POINTS SHOWN. JOINTS MAY BE MADE BY INSERTING MIN. 3/8" BITUMINOUS FILLED DOWEL JOINTS. JOINTS SHALL BE CLEANED AND EGED
3/4" EXPANSION JOINTS TO BE PLACED AT DRIVEWAY SECTIONS, CURB RETURNS, CURB RAMPS AND GOLF JOINTS OR A MAX. OF 80' C/C. EXPANSION JOINTS SHALL PROTRUDE 1" BELOW THE BOTTOM OF THE CUTTER.
CURB RAMPS SHALL BE CONSTRUCTED OF 2" PVC PIPE OR OTHER MATERIAL SUBJECT TO APPROVAL OF THE ENGINEER. CURB RAMPS SHALL BE 18" MIN. TO 24" MAX. IN WIDTH AND 12" MIN. TO 18" MAX. IN HEIGHT. THE CURB RAMP SHALL BE PLACED AT THE CENTER OF THE DRIVEWAY AND AT SUCH LOCATIONS AS DESIGNATED BY THE ENGINEER.


CURB AND GUTTER DETAILS

NTS

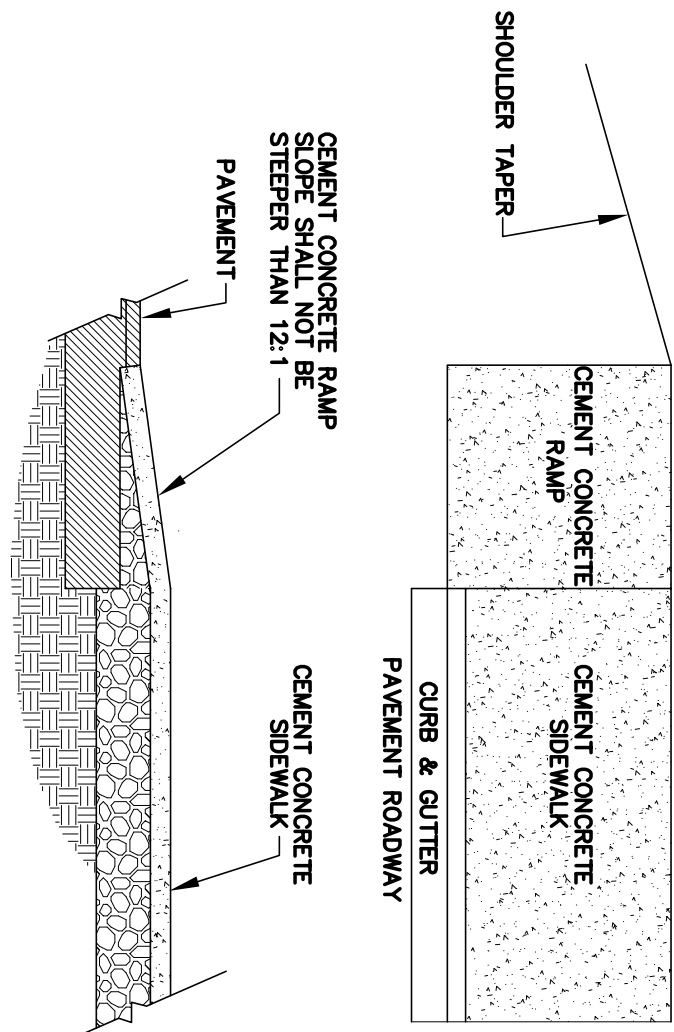


CEMENT CONCRETE SIDEWALK RAMP DETAIL

NTS

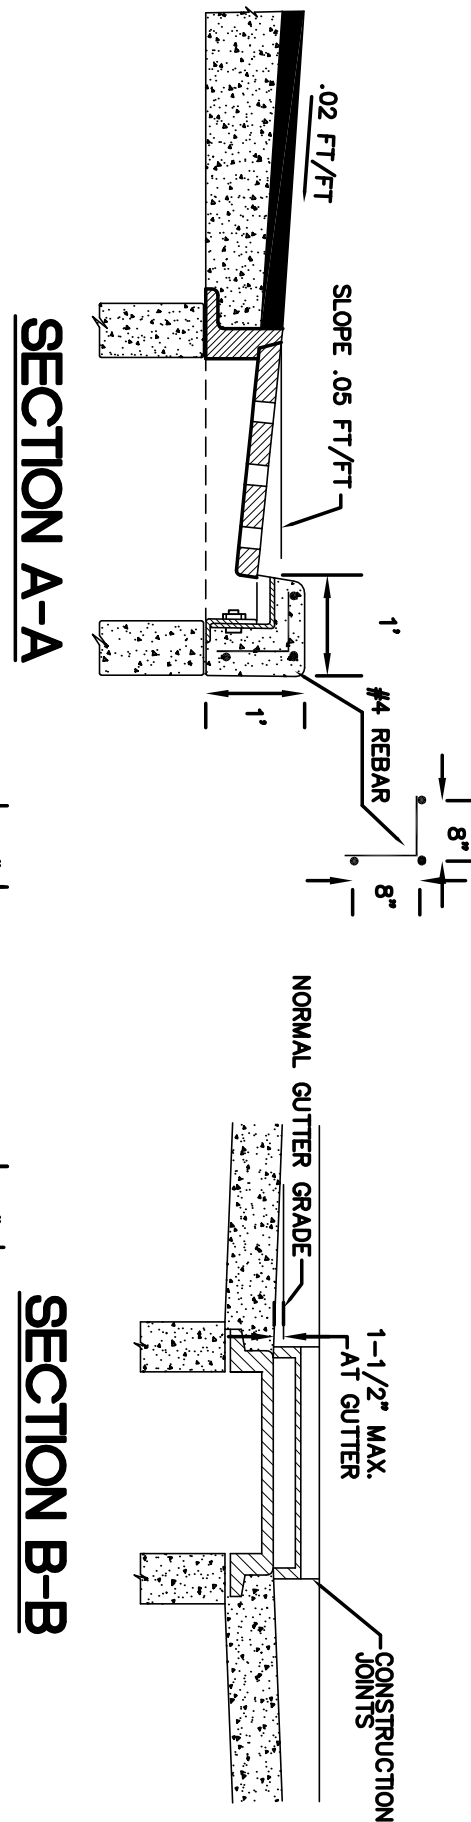

THRU CURB INLET DETAIL


NTS

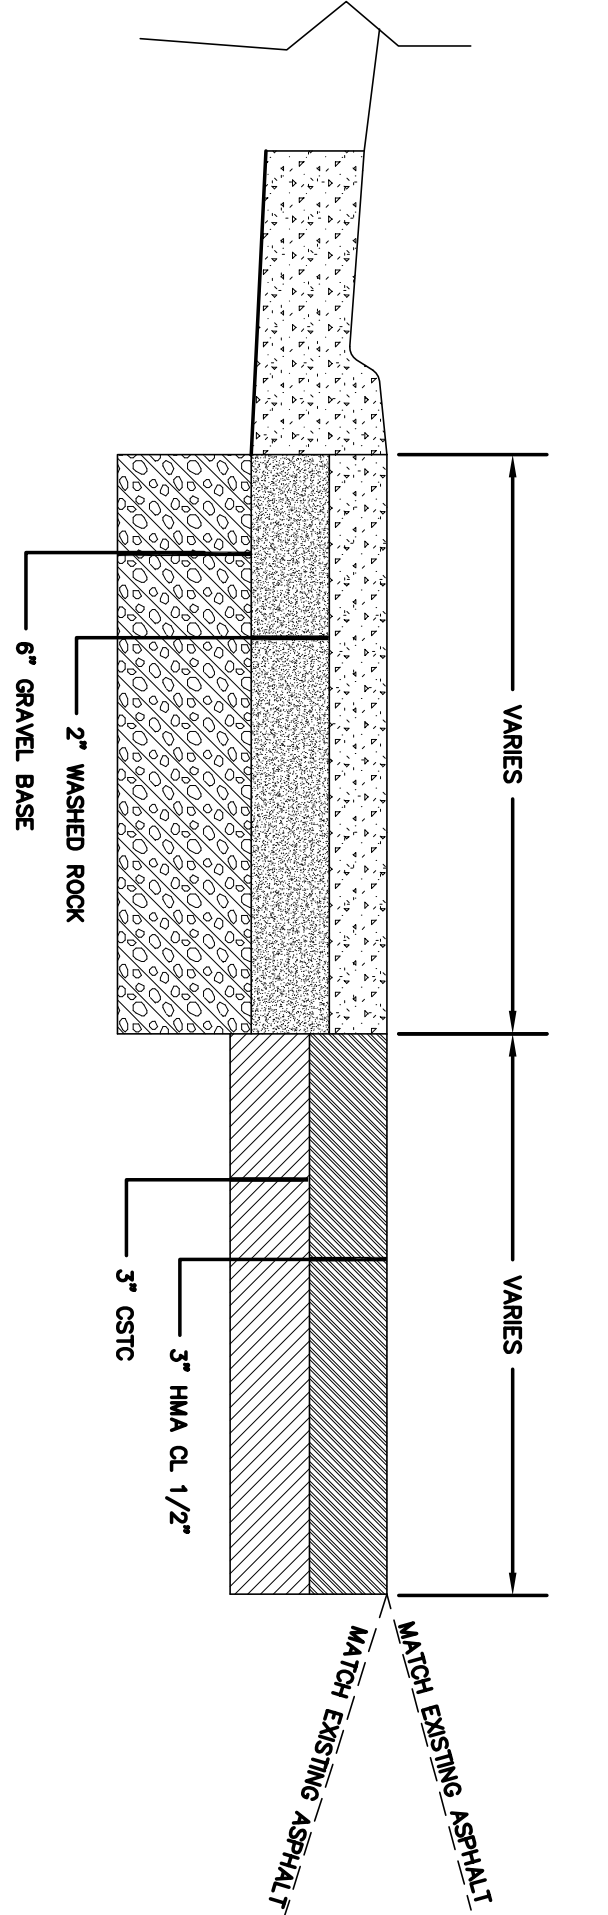

PROPOSED ASPHALT APRON AND ASPHALT SECTION


NTS

- NOTES:
- ALL FRAMES, COVERS AND VALVE BOXES SHALL BE ADJUSTED TO FINISHED GRADE AFTER THE FINAL LIFT OF PAVING HAS BEEN COMPLETED. THE FOUNDATION COURSE SHALL BE USED.
 - CUT THE ASPHALT IN AN EVEN CIRCLE AROUND THE STRUCTURE CASTING TO BE ADJUSTED.
 - REMOVE THE FILL MATERIAL WITHIN THE CUT PAVEMENT AREA TO 8 INCHES MIN. BELOW FINISH GRADE.
 - PLACE THE CASTING AT FINISH GRADE.
 - PLACE PORTLAND CEMENT CONCRETE TO WITHIN THE TOP 2 INCHES OF FINISH GRADE.
 - APPLY TACK TO THE STRUCTURE CASTING, CUT PAVEMENT, AND PC CONCRETE.
 - PLACE AND COMPACT 2 INCHES OF HMA TO FINISH GRADE.
 - SEAL PAVEMENT JOINTS WITH HOT AR4000 AND TOP WITH SAND.

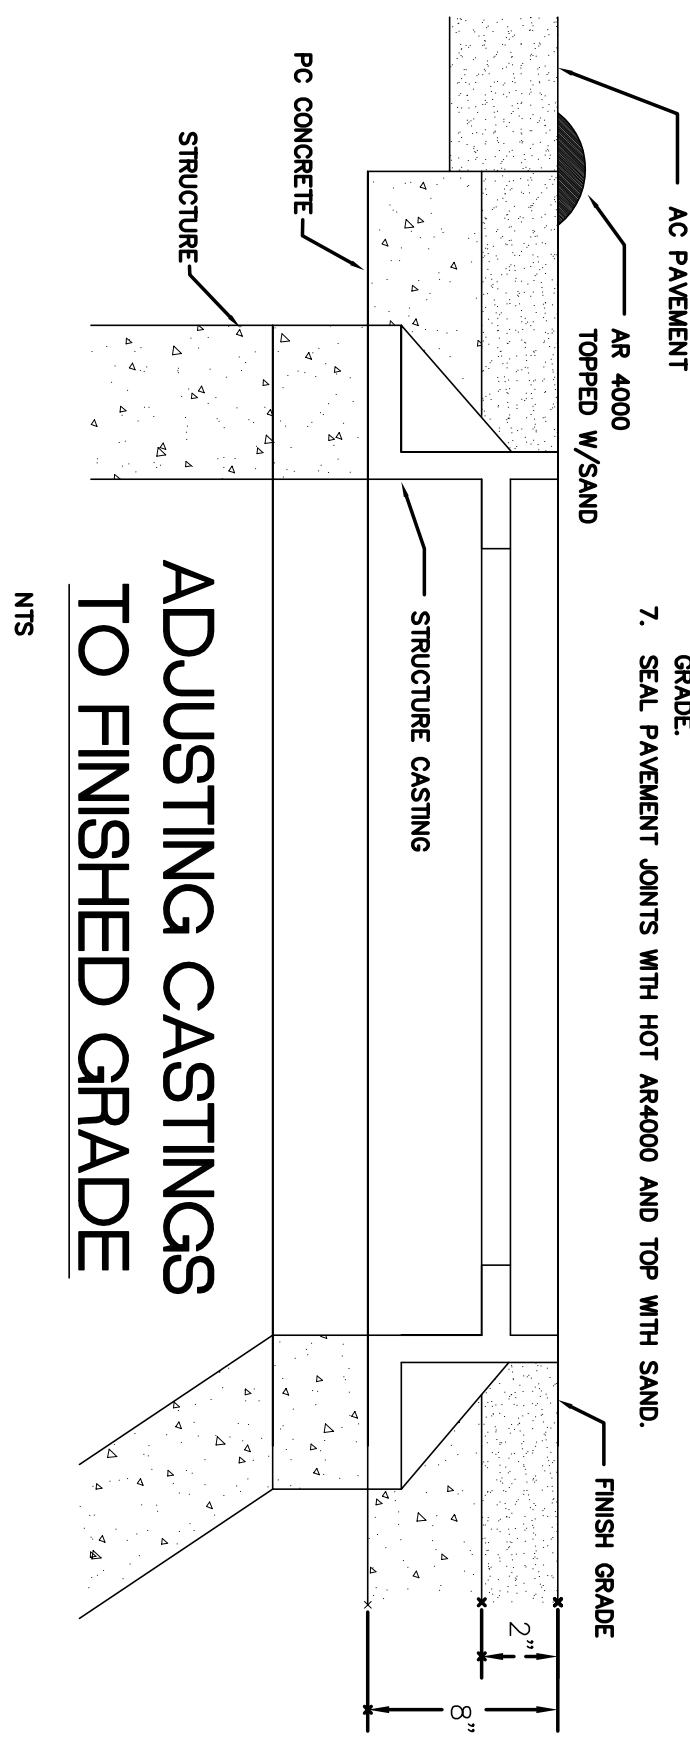


ADJUSTING CASTINGS TO FINISHED GRADE

NTS

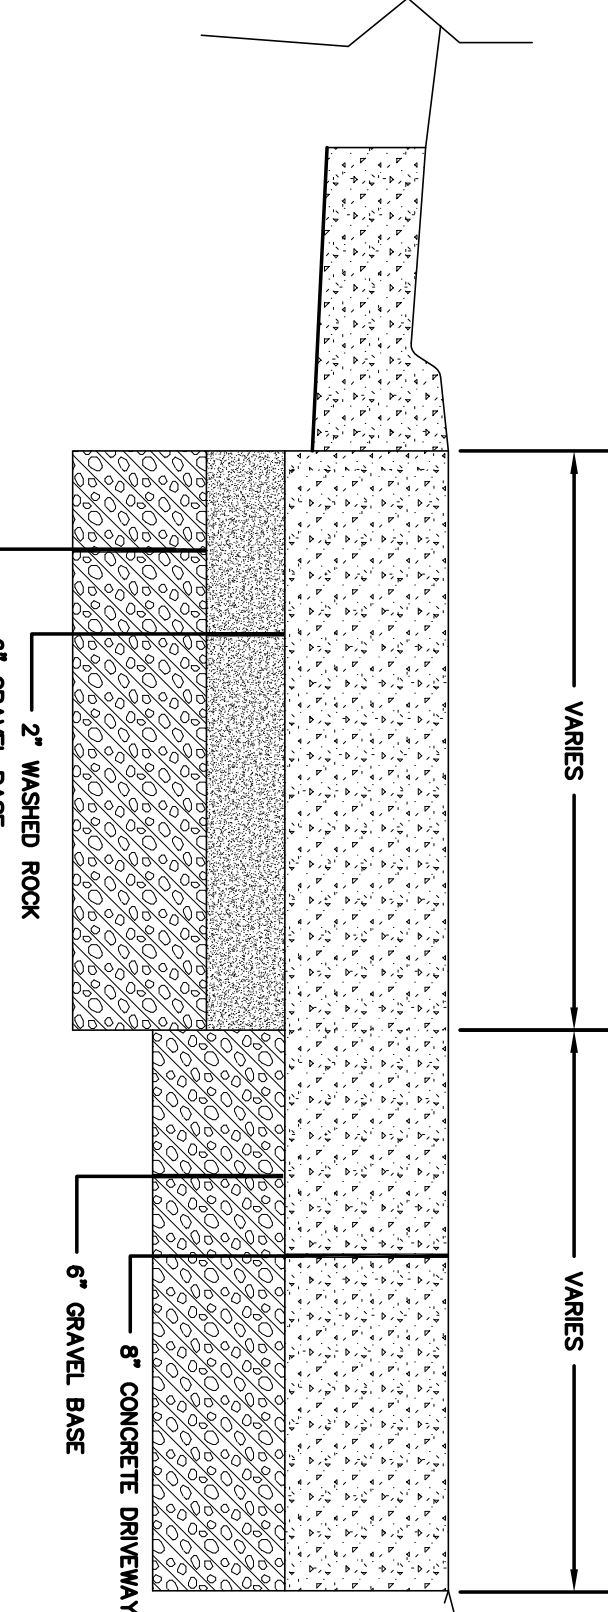

PROPOSED CONCRETE DRIVEWAY SECTION

NTS

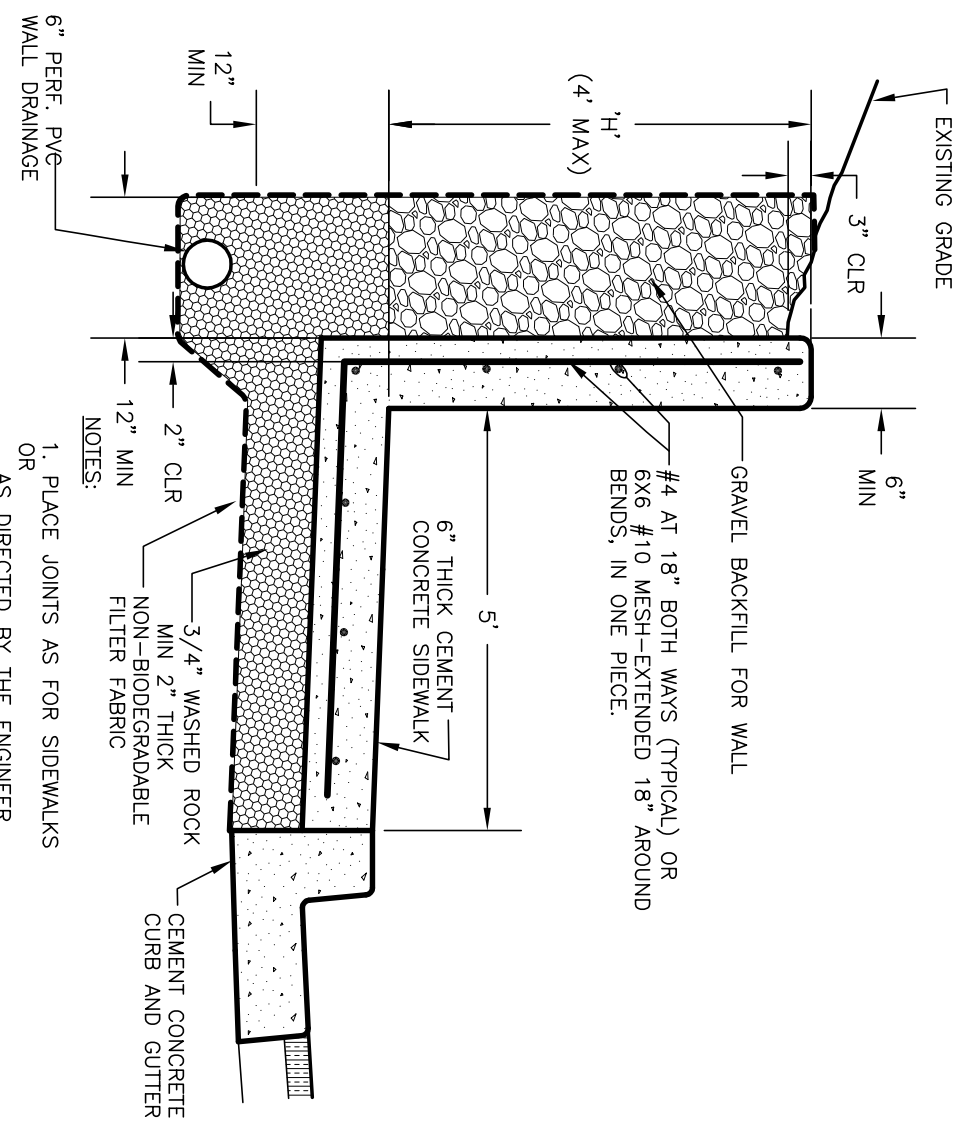


TYPE "A" MONOLITHIC RETAINING WALL AND SIDEWALK (TYP)

NTS

SUBMITTED WITH
DESIGN PLAN

DESIGNED BY
LP /GKG
DRAWN BY
LMC
CHECKED BY
LP

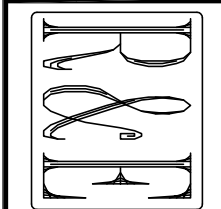

REICHHARDT & EBE
ENGINEERING, INC.
CONSULTING ENGINEERS
PO Box 978 423 Front St., Ste 201
Lynden, Washington 98264
Ph (360) 354-3687
Fax (360) 354-0407

NO. DATE

REVISION

BY

CITY OF FERNDALE
2095 MAIN STREET
FERNDAL, WA 98248


CHURCH ROAD
STREET IMPROVEMENTS
DETAIL SHEET







JOB# / DWG
07037
SCALE
H:1 / V:1

DET

DATE




1-5-17
SHEET
59 of 64

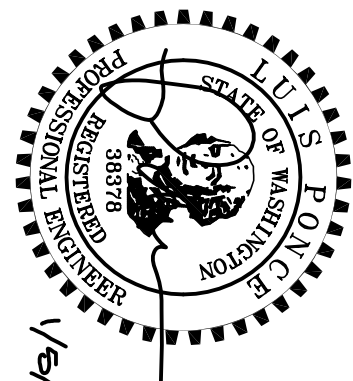

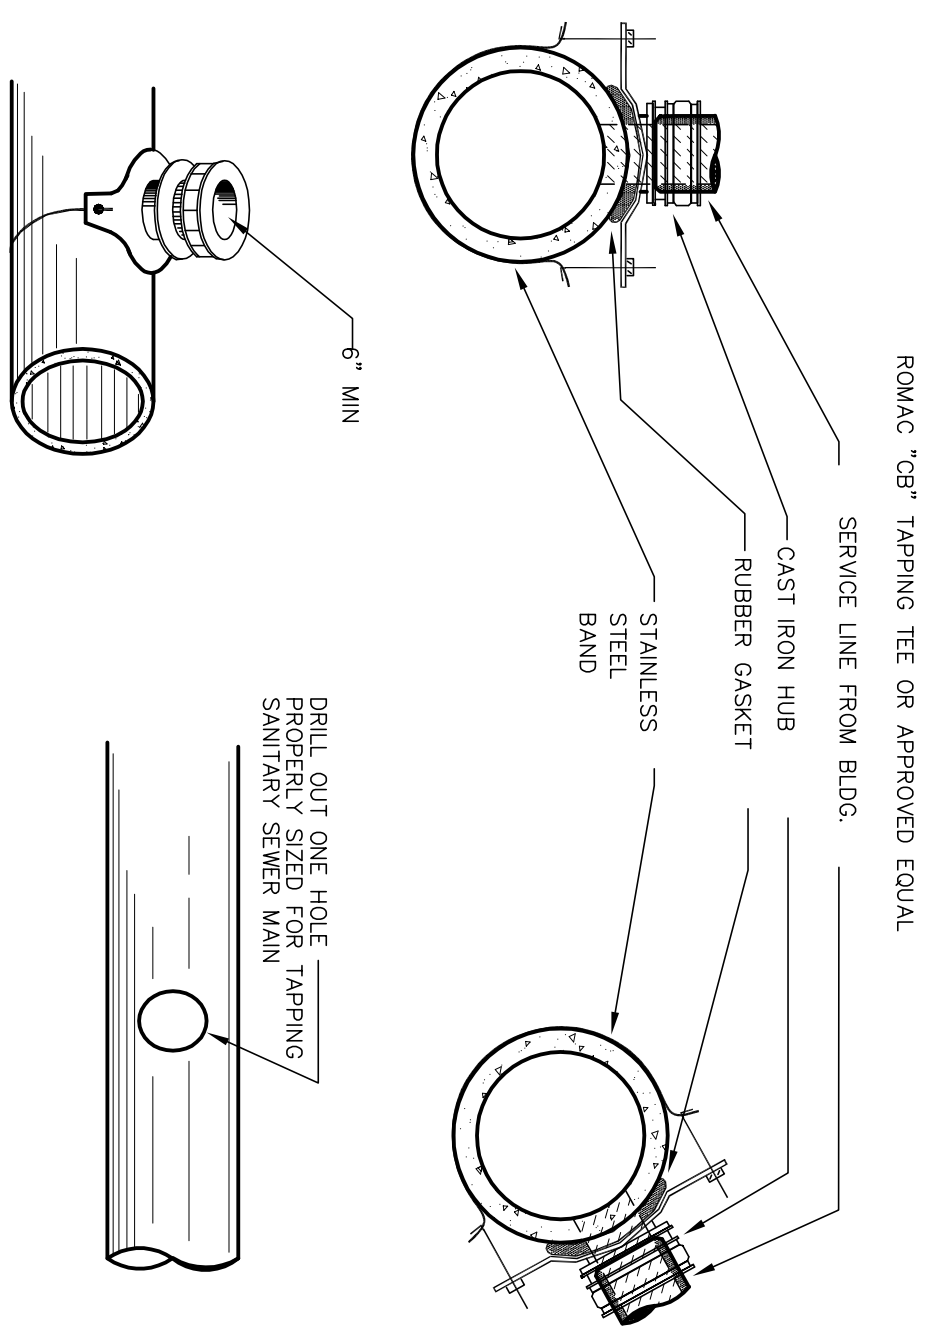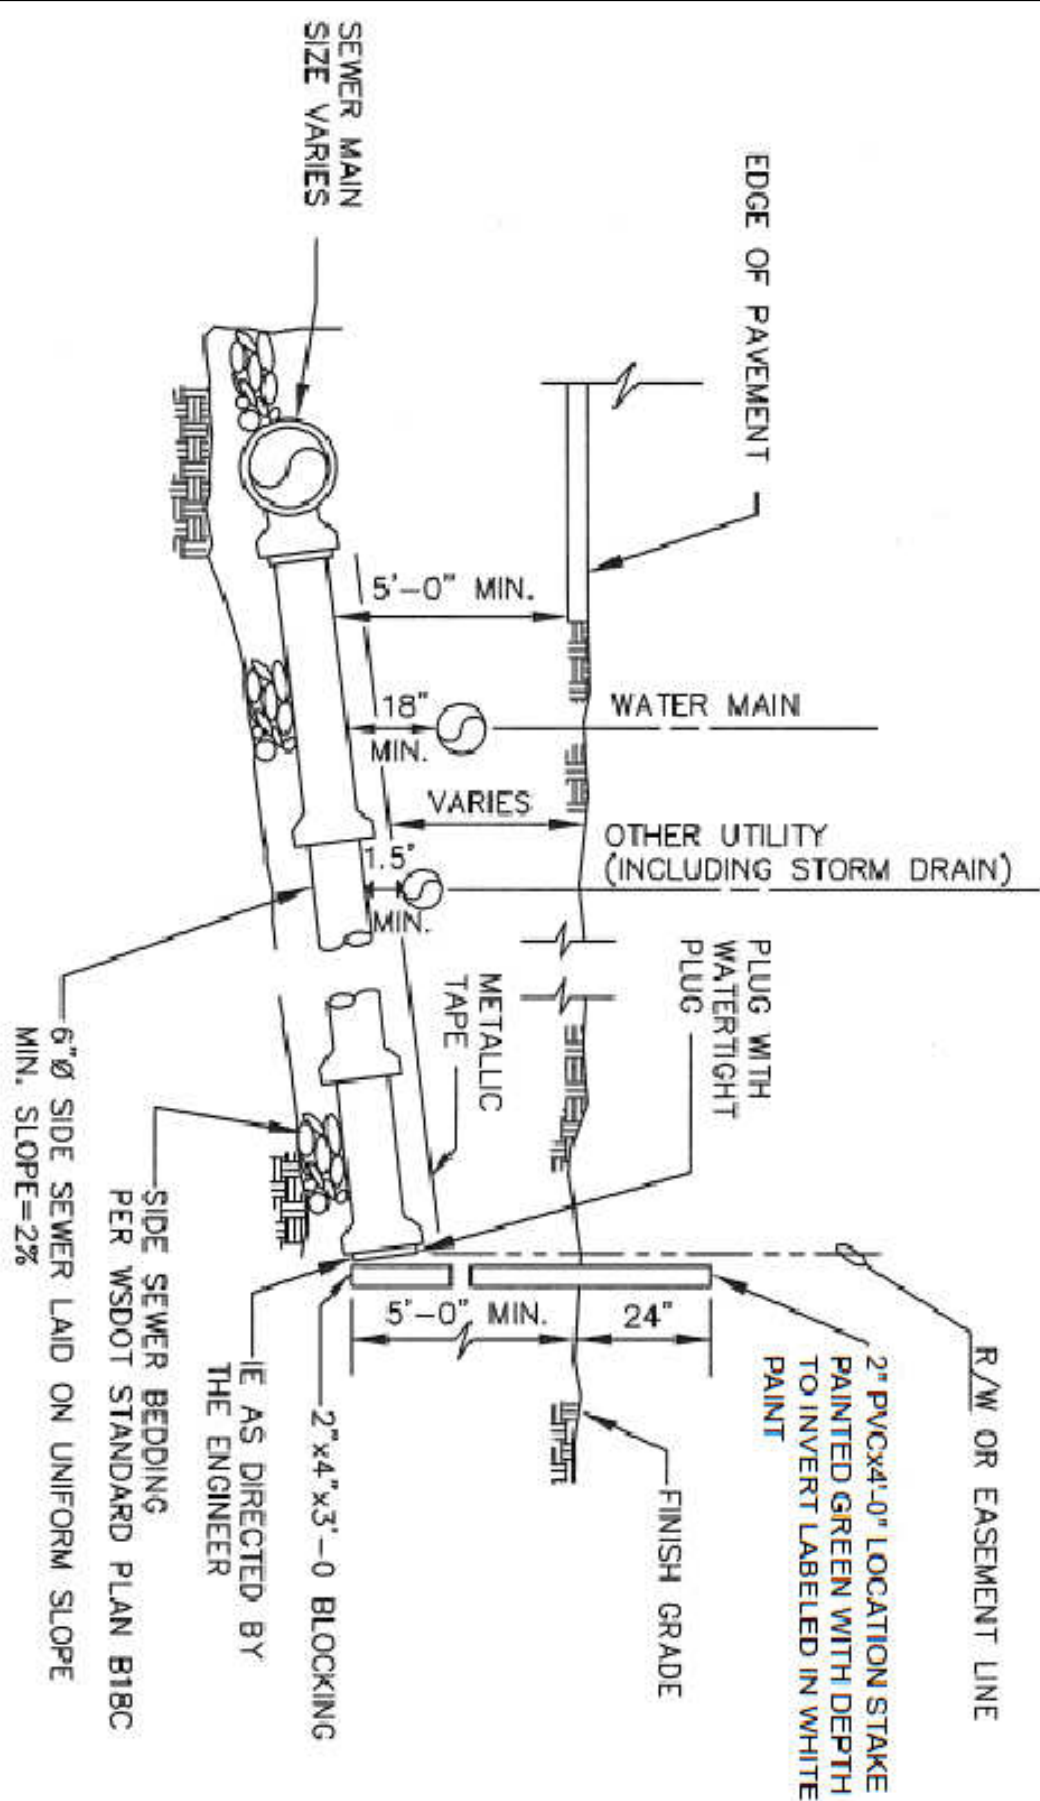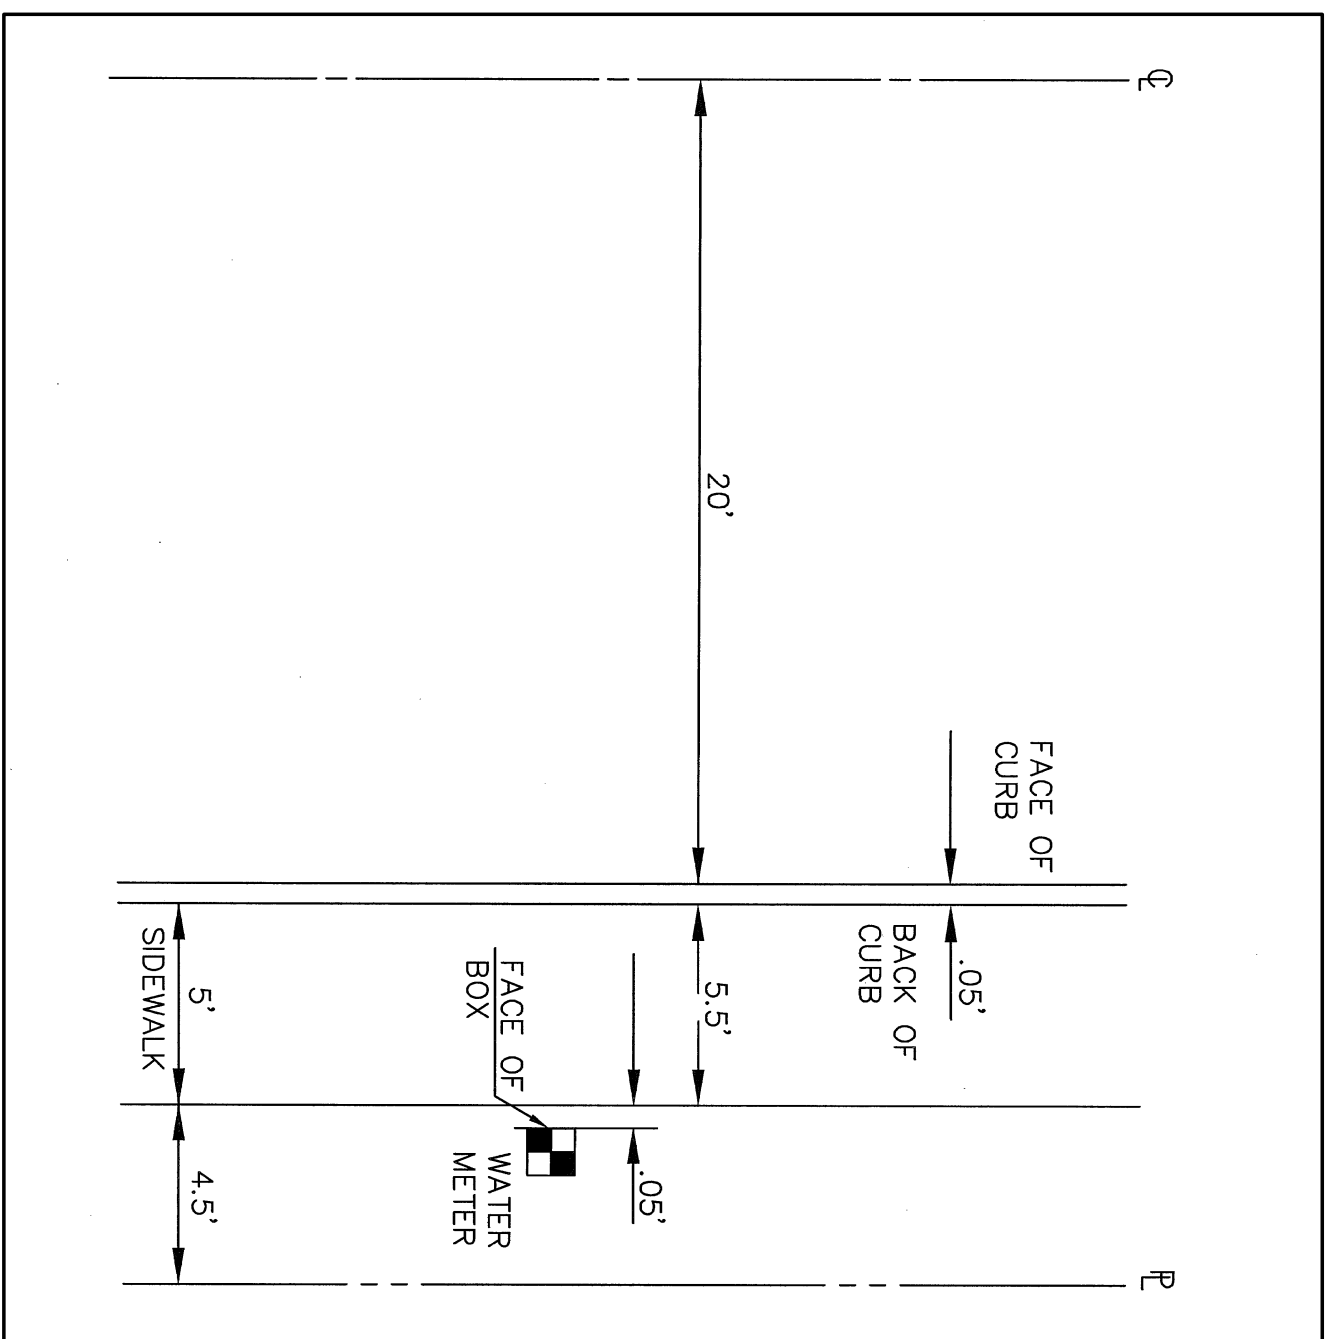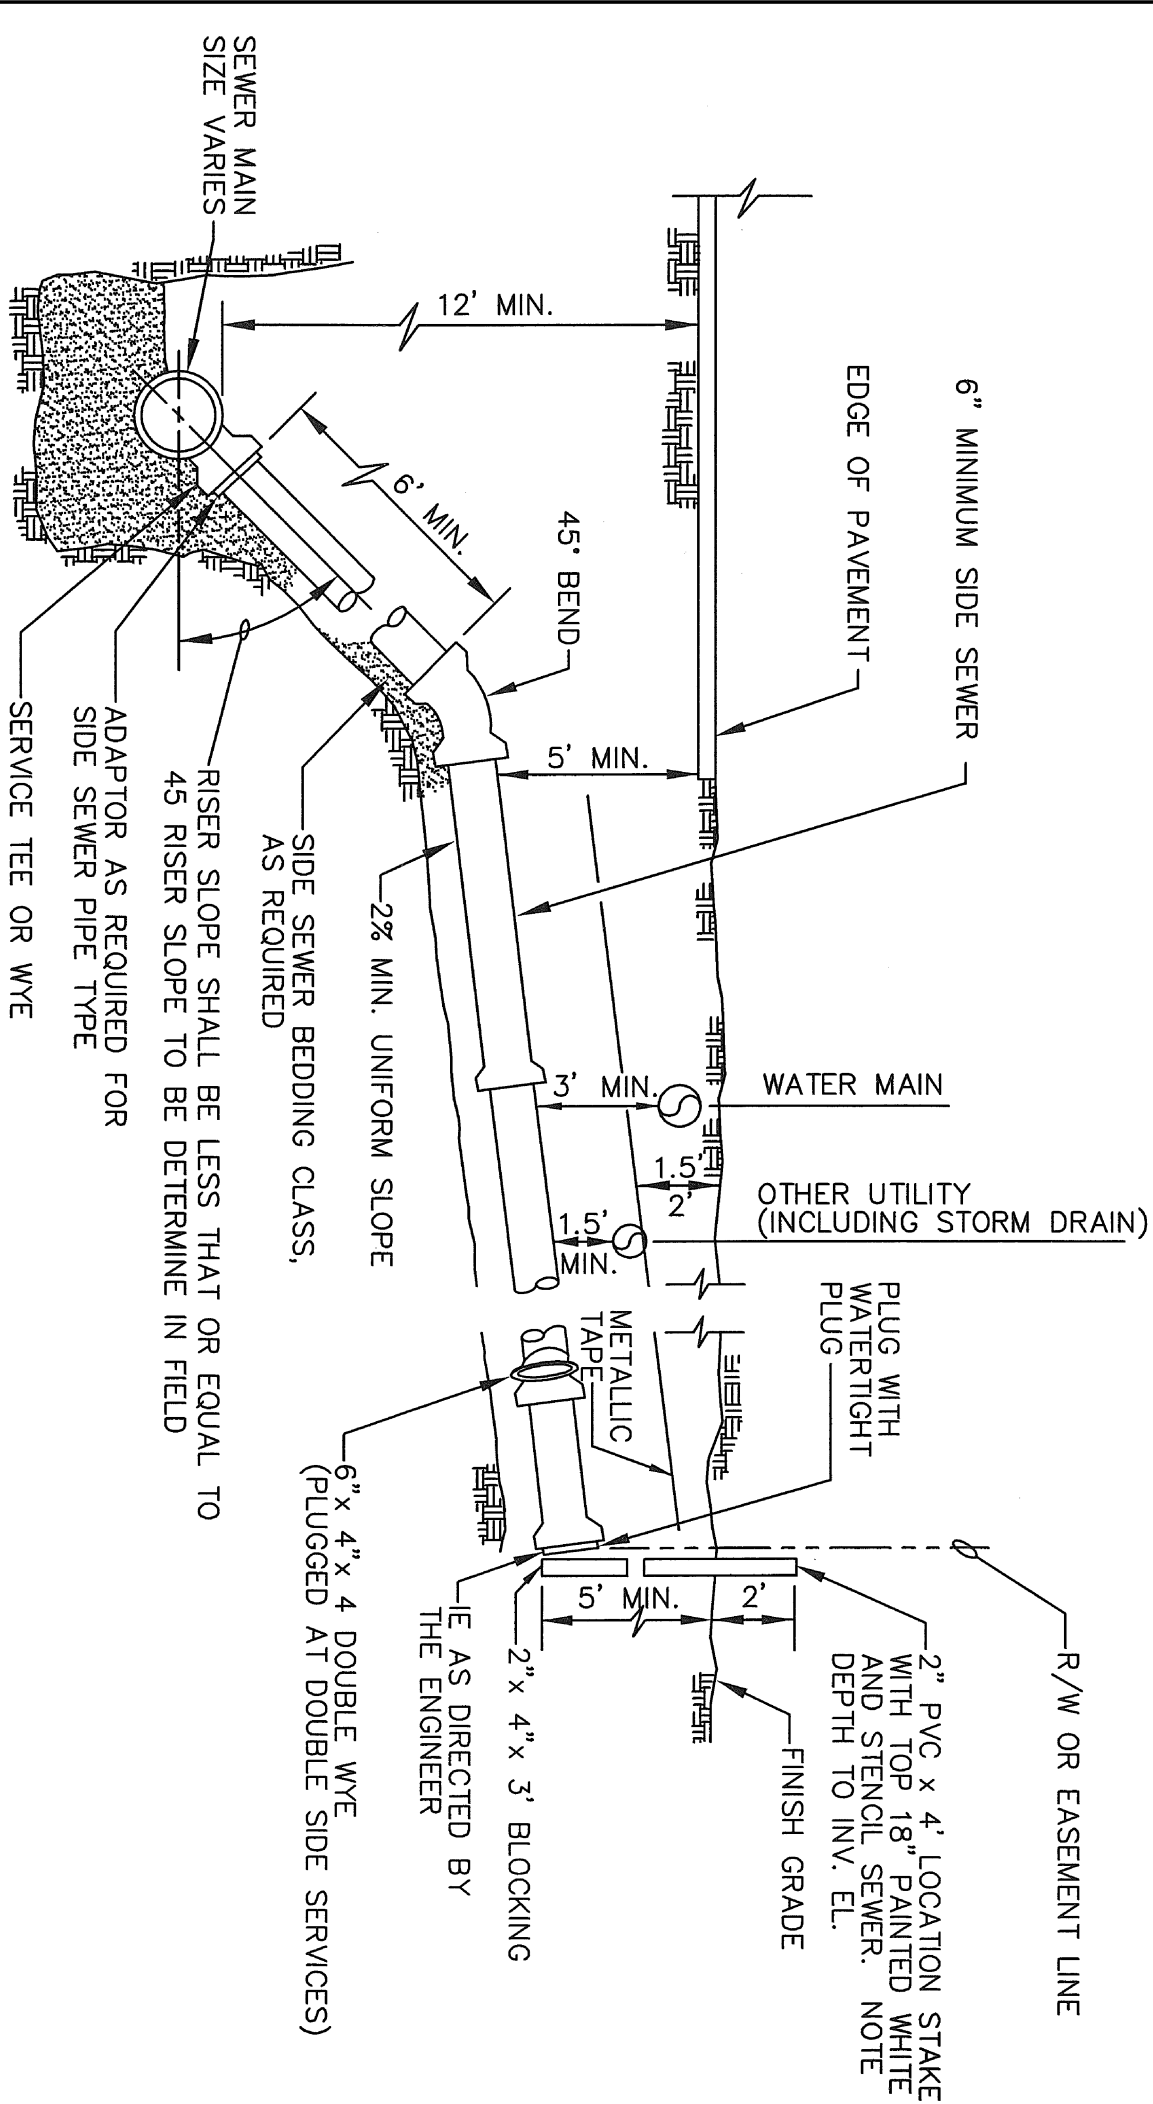
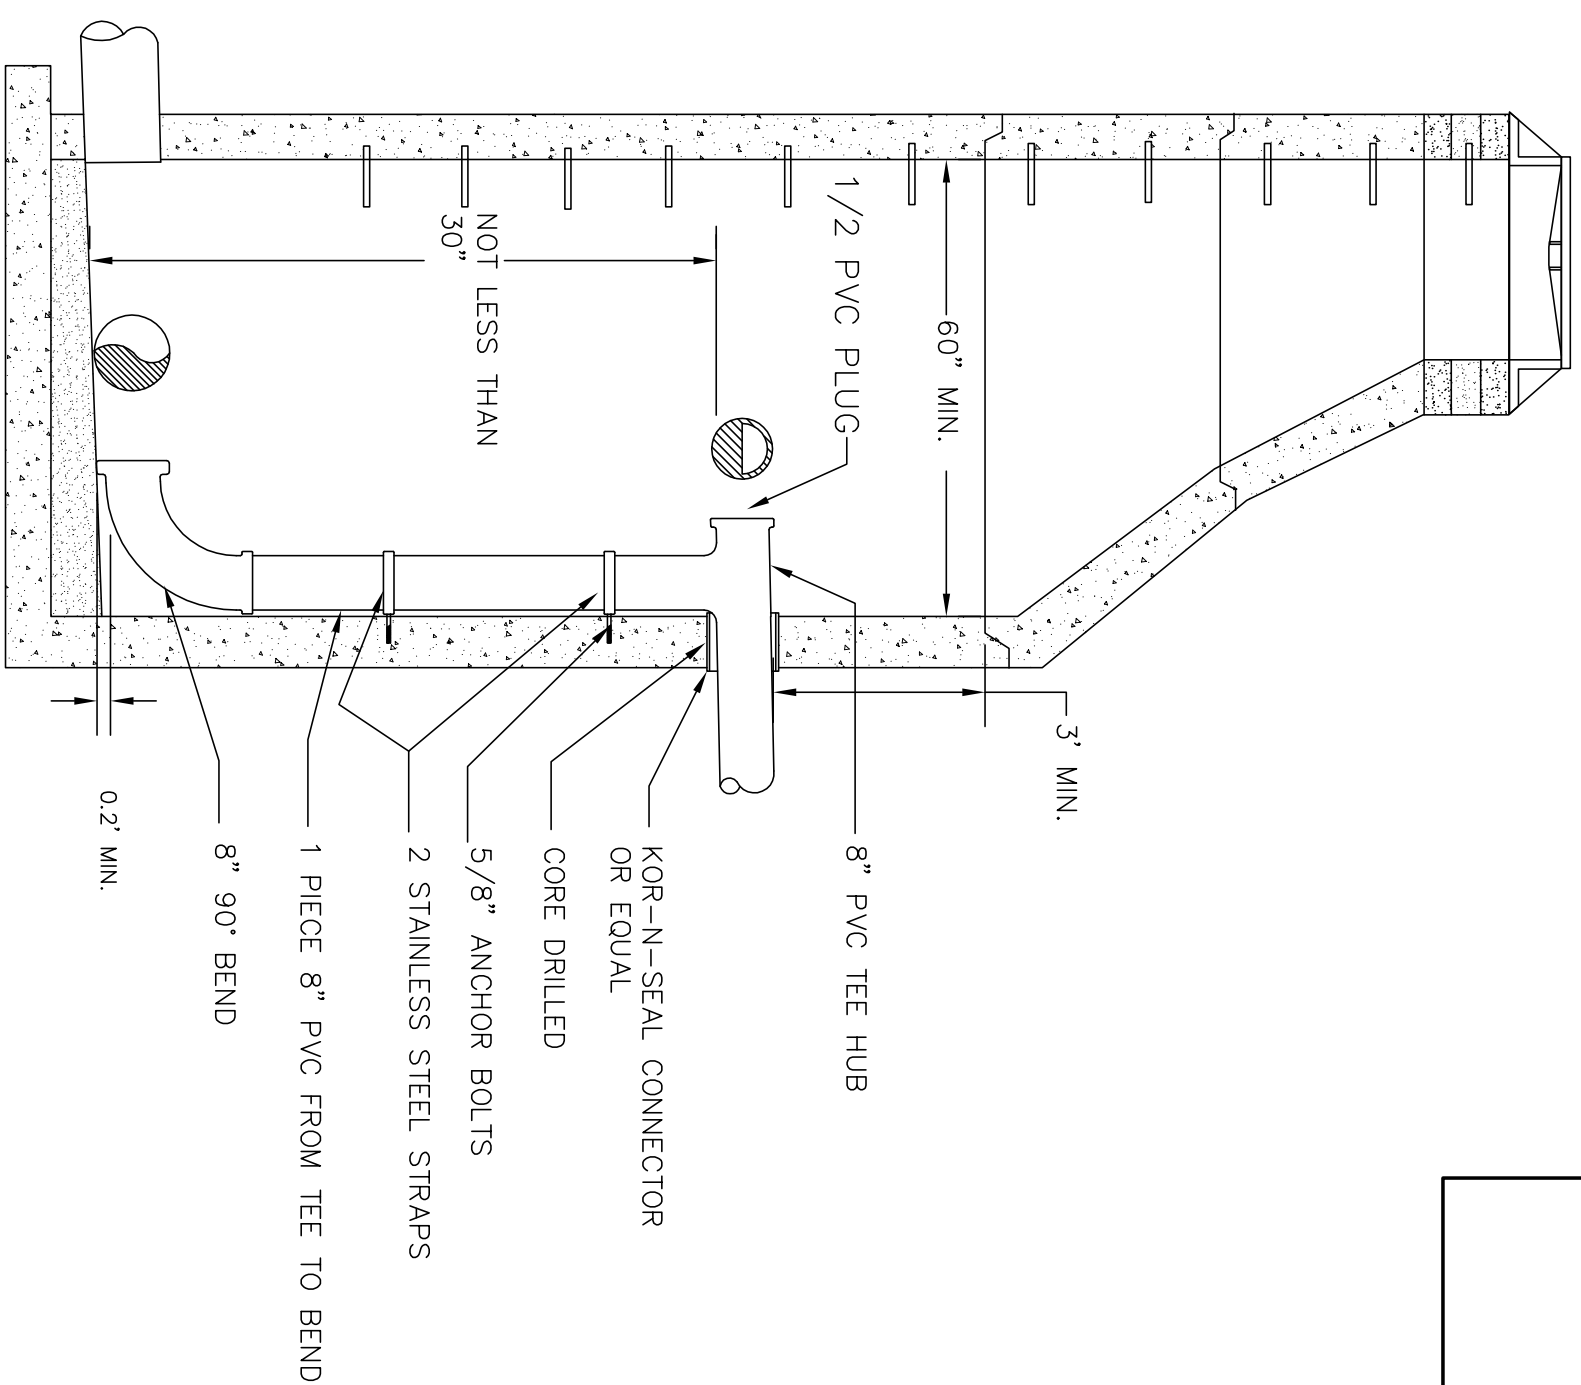
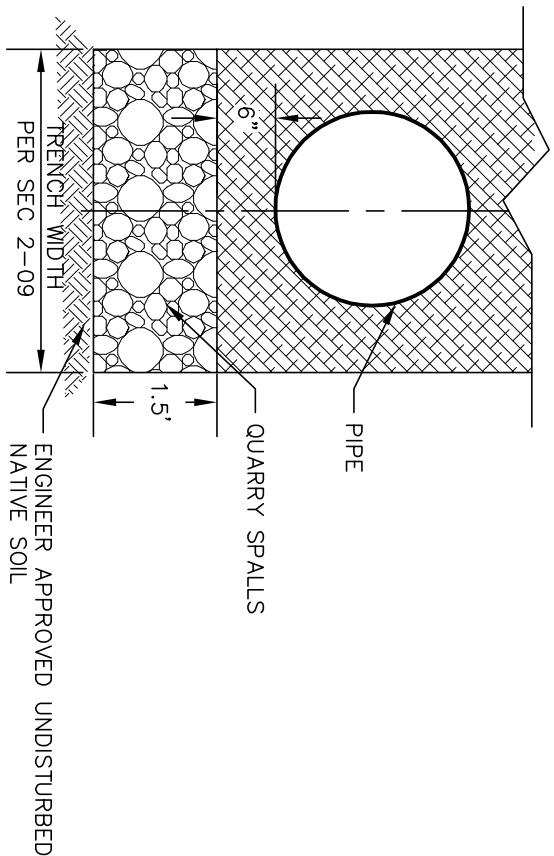





1. CUT THE ASPHALT IN A DIAMOND AROUND THE STRUCTURE CASTING TO BE ADJUSTED.
2. REMOVE THE FILL MATERIAL WITHIN THE CUT PAVEMENT AREA TO 8 INCHES MIN. BELOW FINISH GRADE.
3. PLACE THE CASTING AT FINISH GRADE.
4. PLACE PORTLAND CEMENT CONCRETE TO WITHIN THE TOP 2 INCHES OF FINISH GRADE.
5. APPLY TACK TO THE STRUCTURE CASTING, CUT PAVEMENT, & PC CONCRETE.
6. PLACE & COMPACT 2 INCHES OF COMMERCIAL HMA TO FINISH GRADE.
7. SEAL PAVEMENT JOINTS W/ HOT AR4000 & TOP W/ SAND.

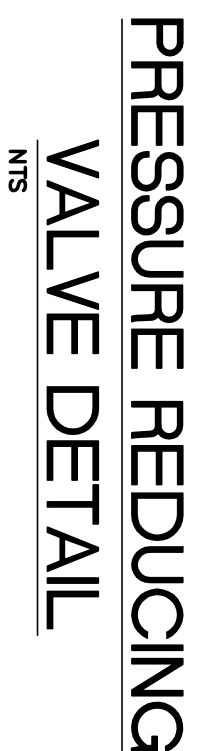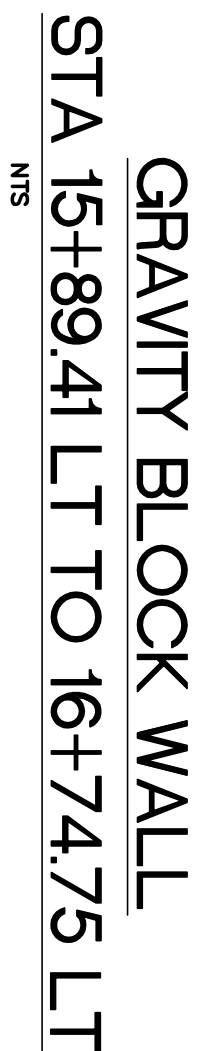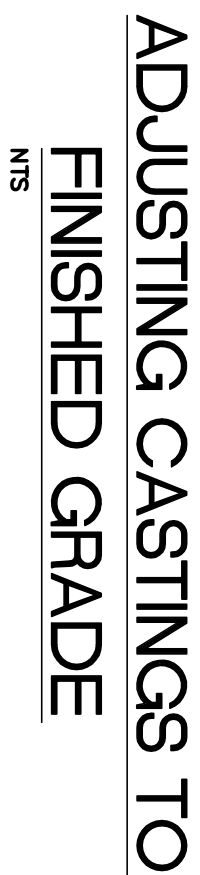

CHURCH RD 15+60 LT
MONOLITHIC RETAINING WALL
NTS

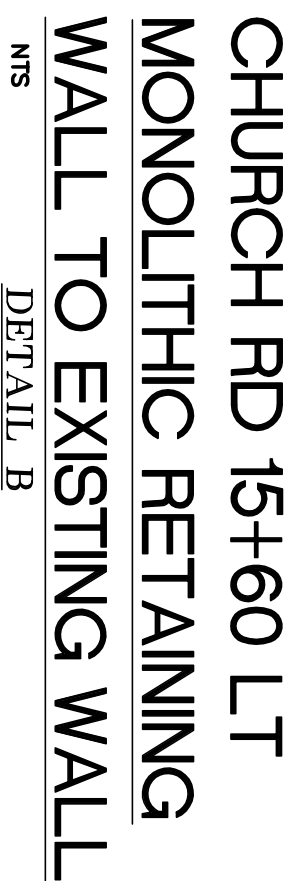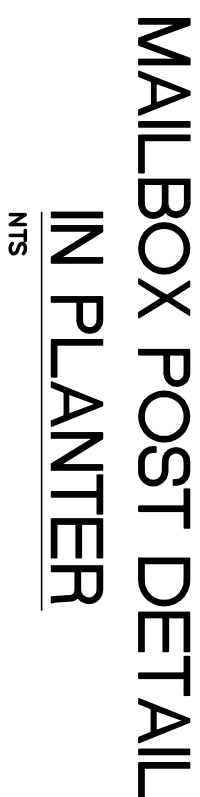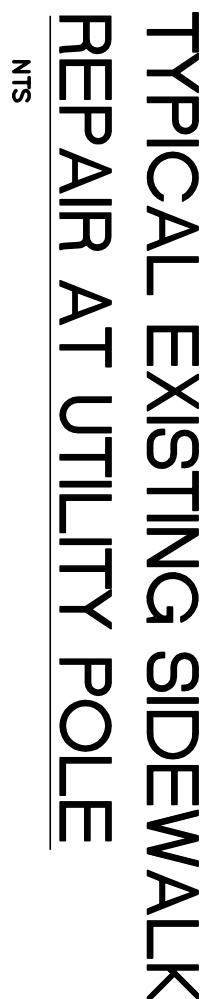

DESIGNED BY	LP/GKG
DRAWN BY	LMC
CHECKED BY	LP

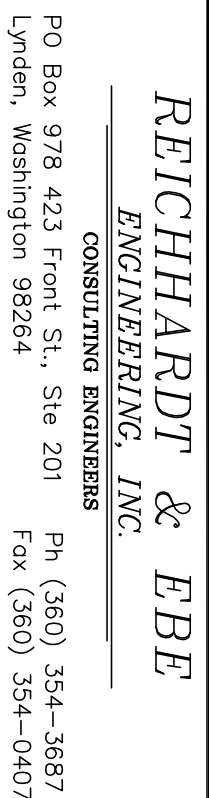

REVISION

By

CITY OF FERNDALE
2095 MAIN STREET
FERNDALE, WA 98248

**CHURCH ROAD
STREET IMPROVEMENTS
DETAIL SHEET**

JOB# / DWG
07037

DE

63 of 64

