


DATE: \_\_\_\_\_ BY: \_\_\_\_\_  
 APPROVED: \_\_\_\_\_  
 PLANNING CHECKED: \_\_\_\_\_  
 NOTE BOOK: \_\_\_\_\_  
 NO. OF SHEETS: \_\_\_\_\_

DATE: \_\_\_\_\_ BY: \_\_\_\_\_  
 APPROVED: \_\_\_\_\_  
 GRADING CHECKED: \_\_\_\_\_  
 NOTE BOOK: \_\_\_\_\_  
 NO. OF SHEETS: \_\_\_\_\_

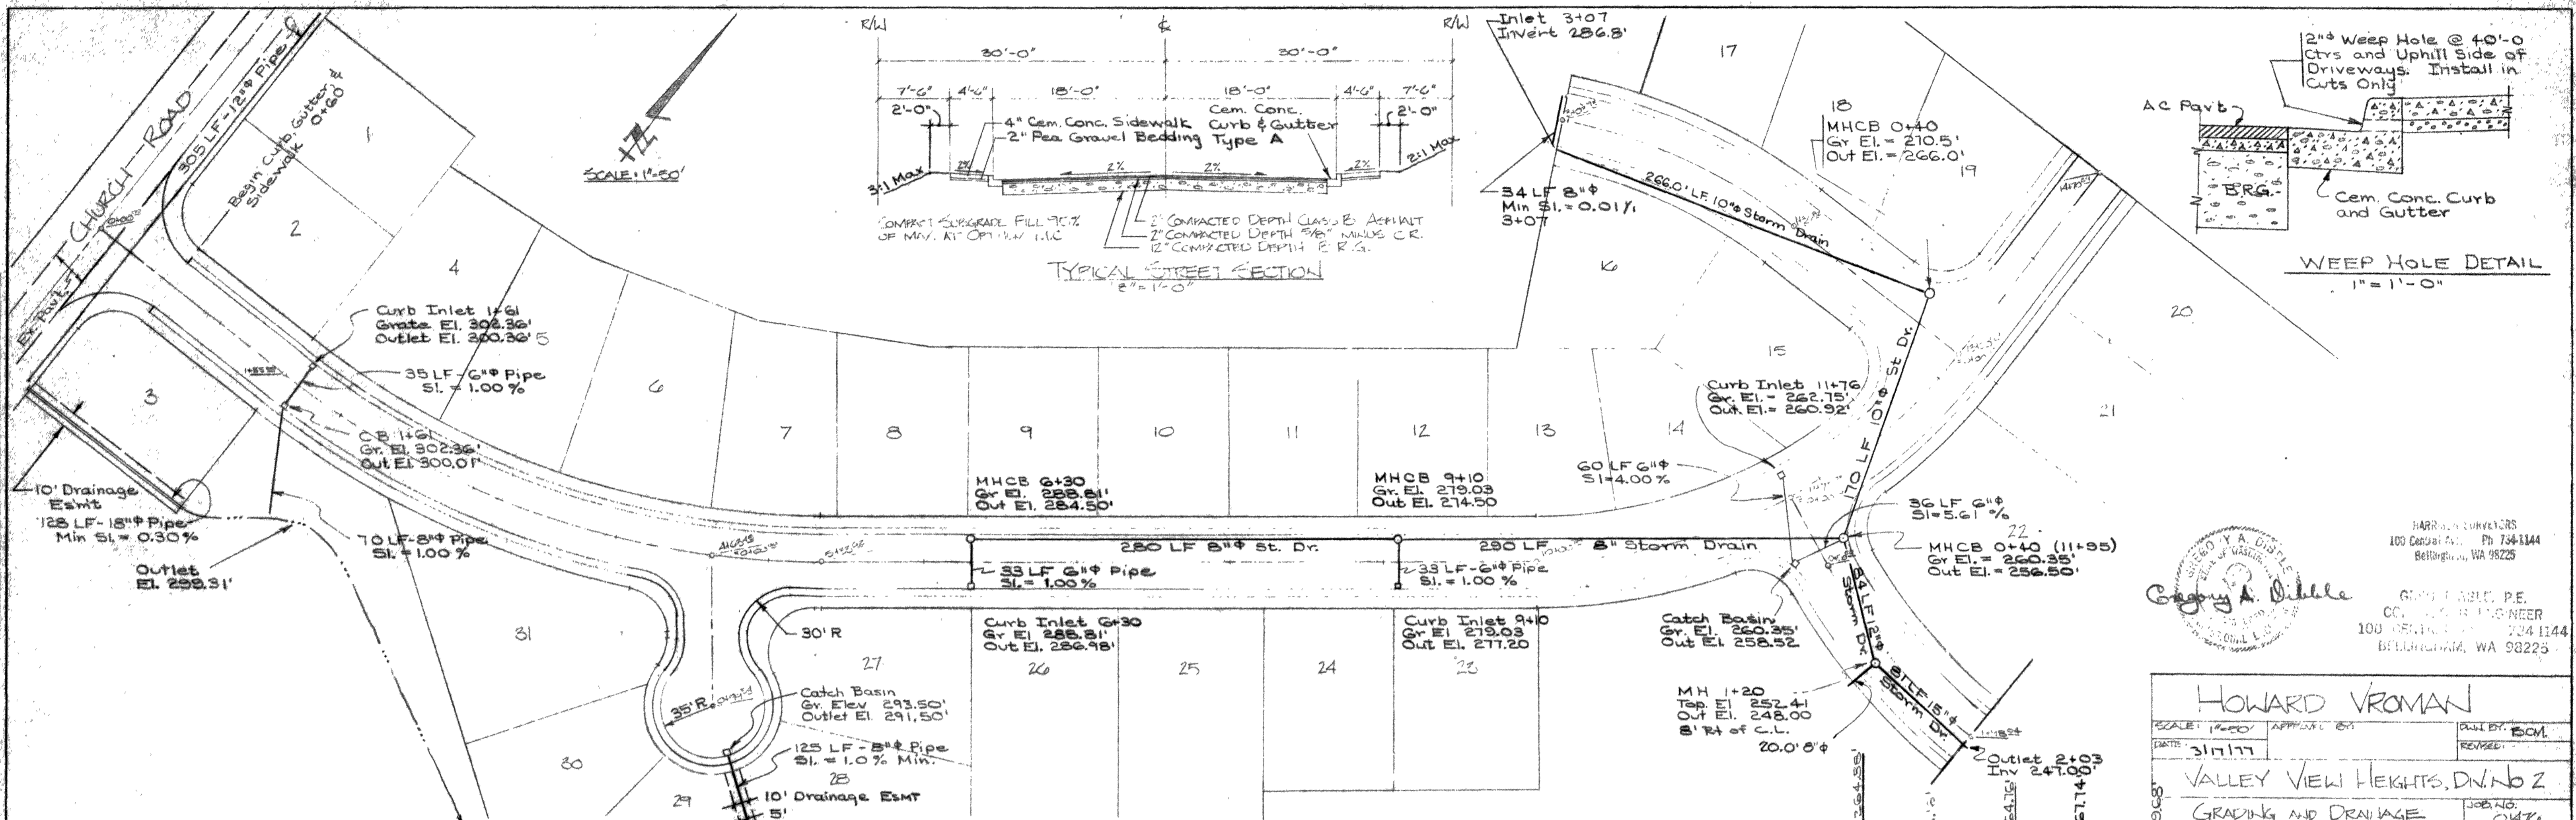

**WEEP HOLE DETAIL**  
 1" = 1'-0"

2" Weep Hole @ 40'-0 Ctrs and Uphill Side of Driveways. Install in Cuts Only

Ac Pavt


Cem Conc. Curb and Gutter

BRG


HARRISON SURVEYORS  
 100 Central Ave., Ph. 734-1144  
 Bellevue, WA 98225

GARY A. DILLE, P.E.  
 CC, LE, R, INC-NEER  
 100 Central Ave., Ph. 734-1144  
 Bellevue, WA 98225

**HOWARD VROMAN**  
 SCALE: 1"=40'  
 PART: 317177  
 VALLEY VIEW HEIGHTS, DN, No 2  
 GRADING AND DRAINAGE  
 JOB NO. 0176

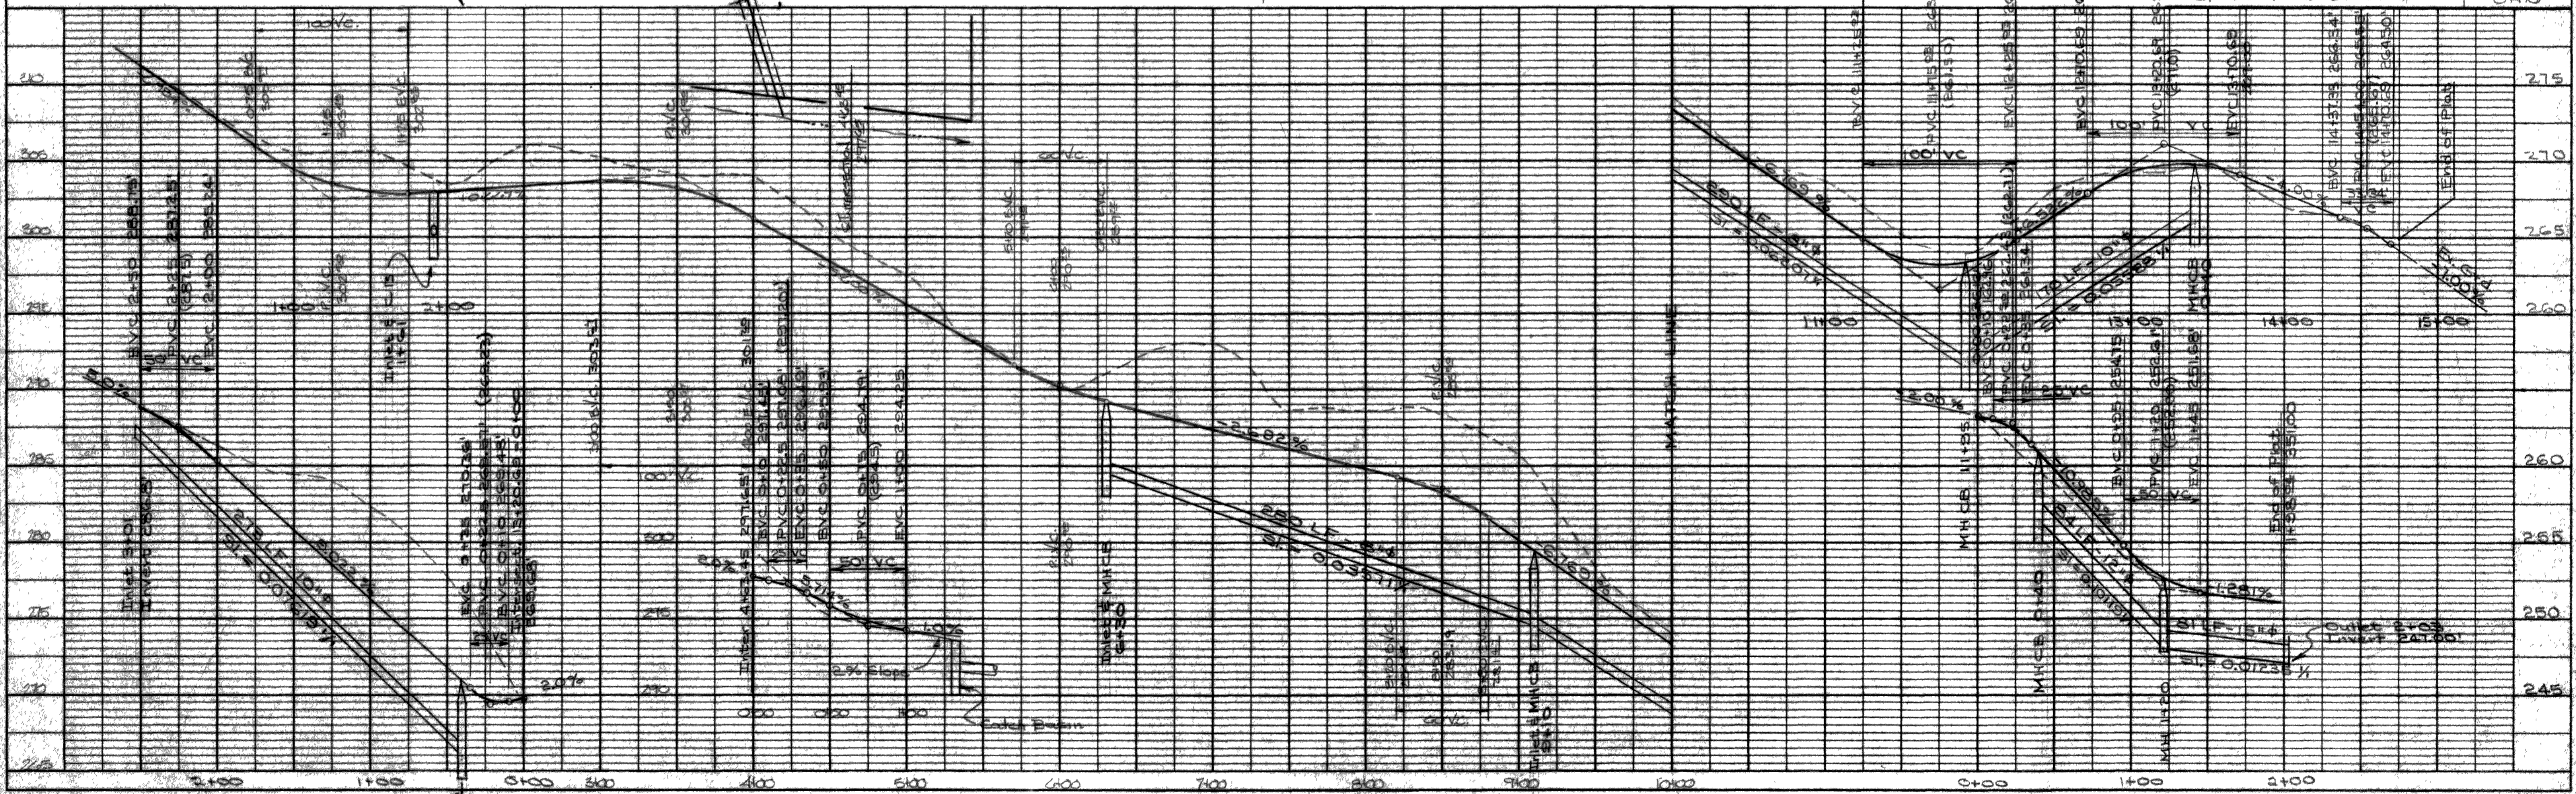

00243.002 2-11-04 KR

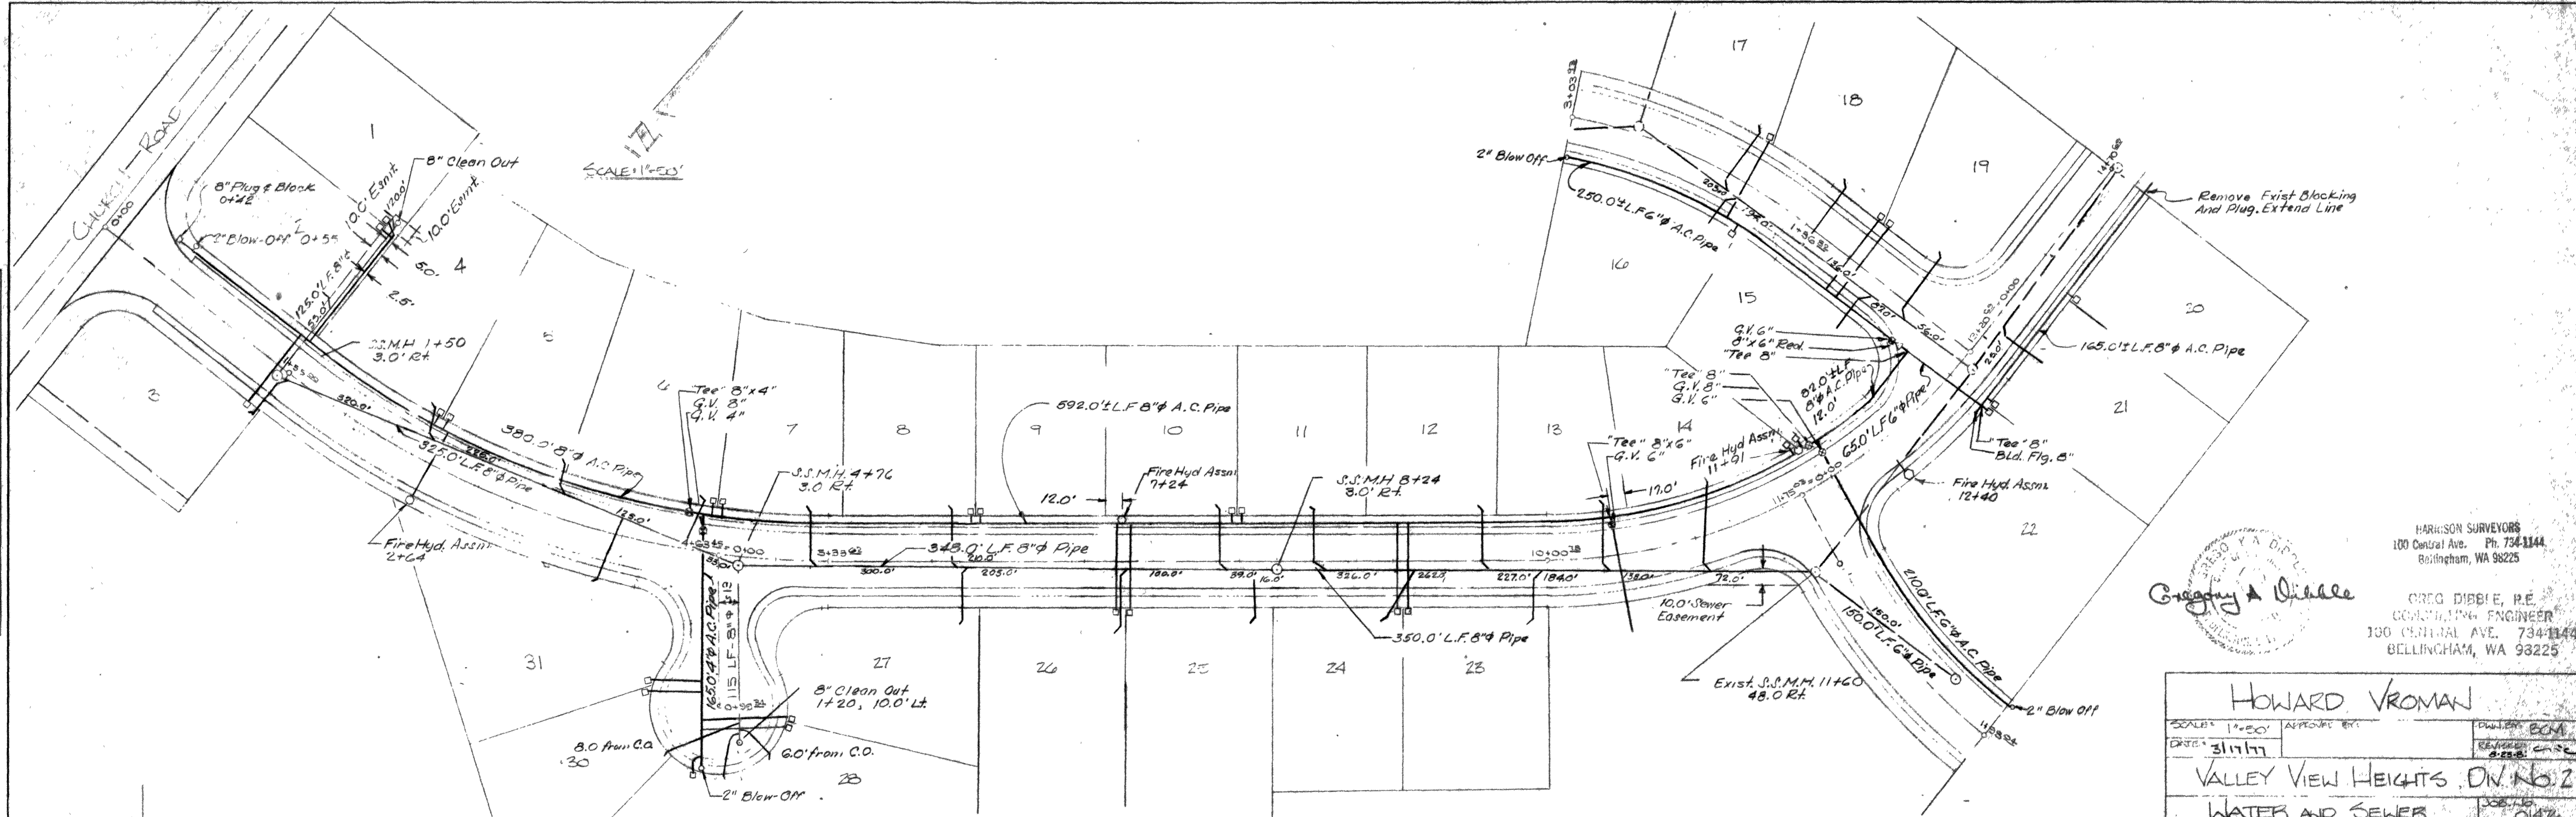

HARRISON SURVEYORS  
 100 Central Ave. Ph. 734-1144  
 Bellingham, WA 98225

Gregory A. Dille  
 CONSULTING ENGINEER  
 100 CENTRAL AVE. 734-1144  
 BELLINGHAM, WA 98225

HOWARD VROMAN  
 SCALE: 1"=50' APPROVE BY: [Signature]  
 DATE: 3/17/77  
 VALLEY VIEW HEIGHTS, DN No. 2  
 WATER AND SEWER

DATE	BY	REVISIONS
		1. SURVEYED
		2. GRADES CHECKED
		3. ALIGNMENT CHECKED
		4. RT. OF WAY CHECKED
		5. NO. [blank]

DATE	BY	REVISIONS
		1. SURVEYED
		2. GRADES CHECKED
		3. B.M. E. NOTED
		4. STRUCTURE NOTATIONS CHECKED
		5. NO. [blank]

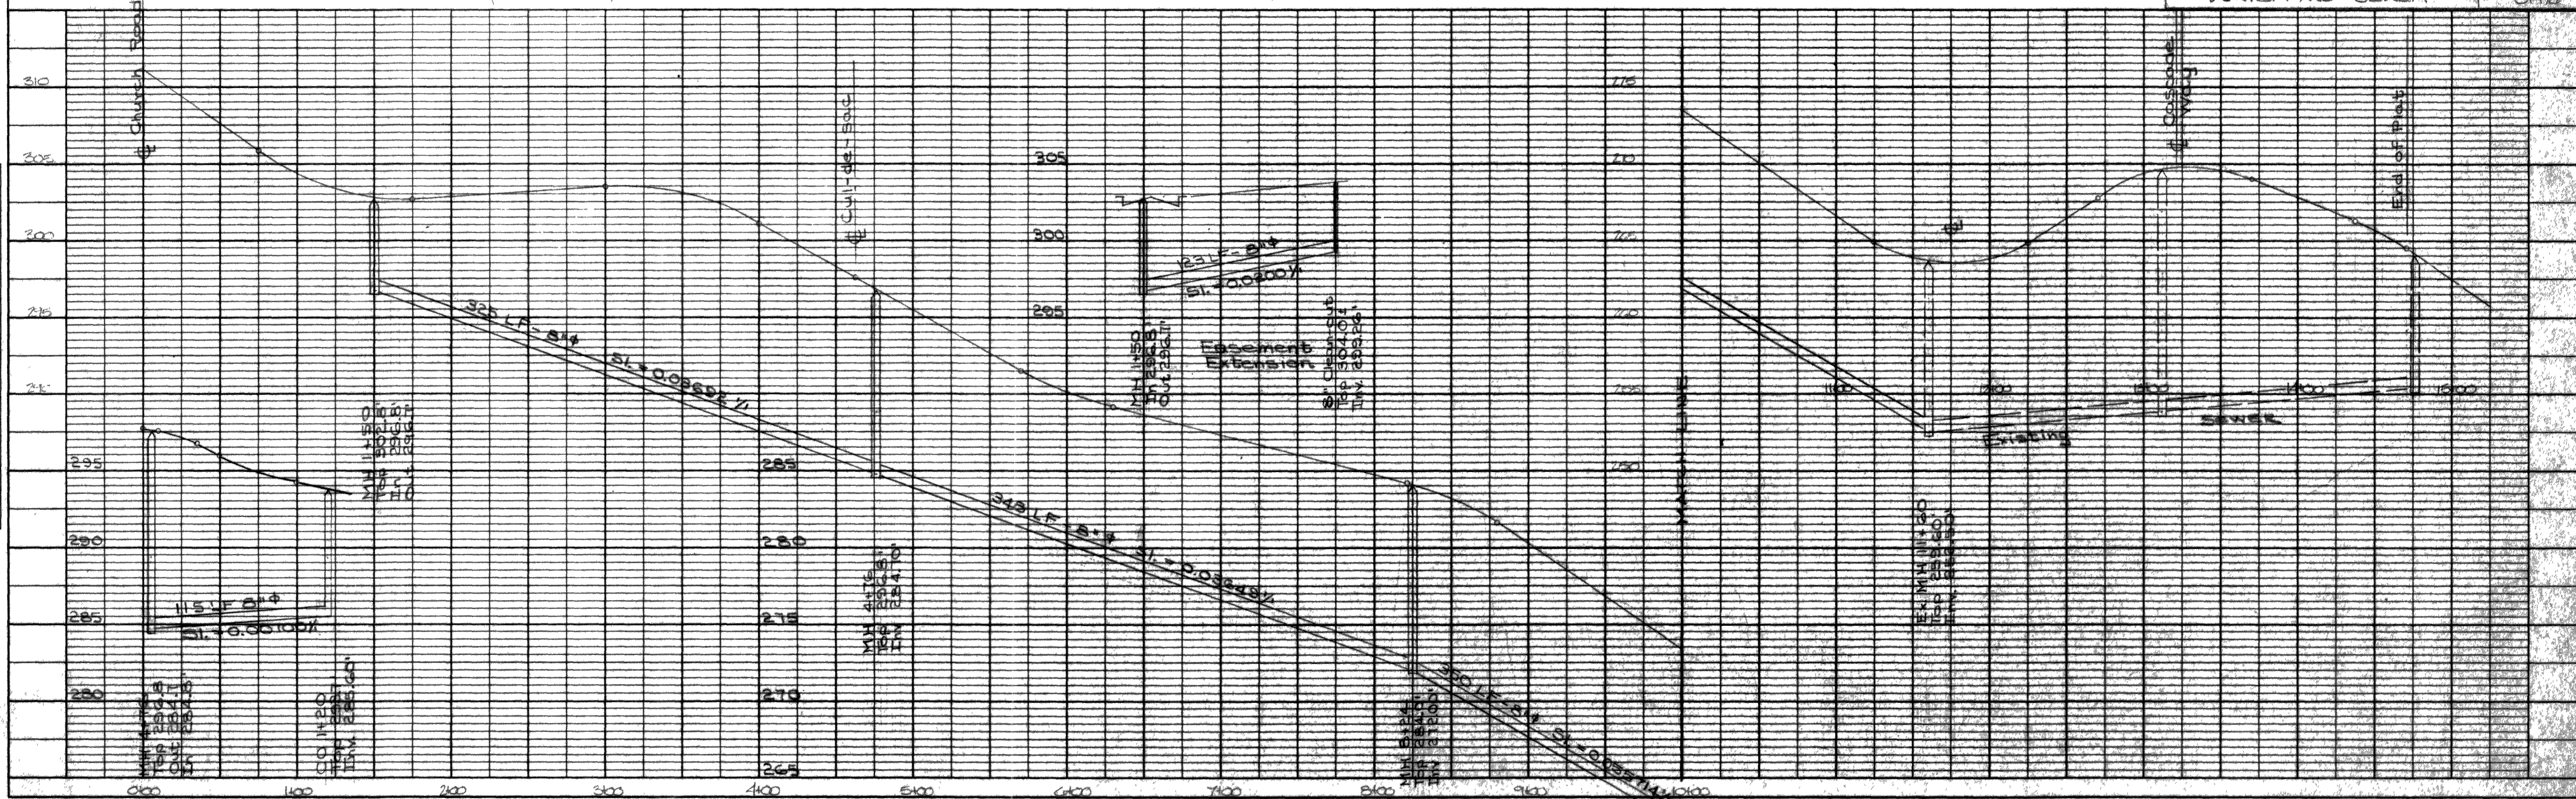


PLATE 1 - PLAN - PROFILE - F.A.S.  
 CLEARPRINT PAPER CO., S.F. CAL.  
 NO. 1000-1

01476  
 11031