
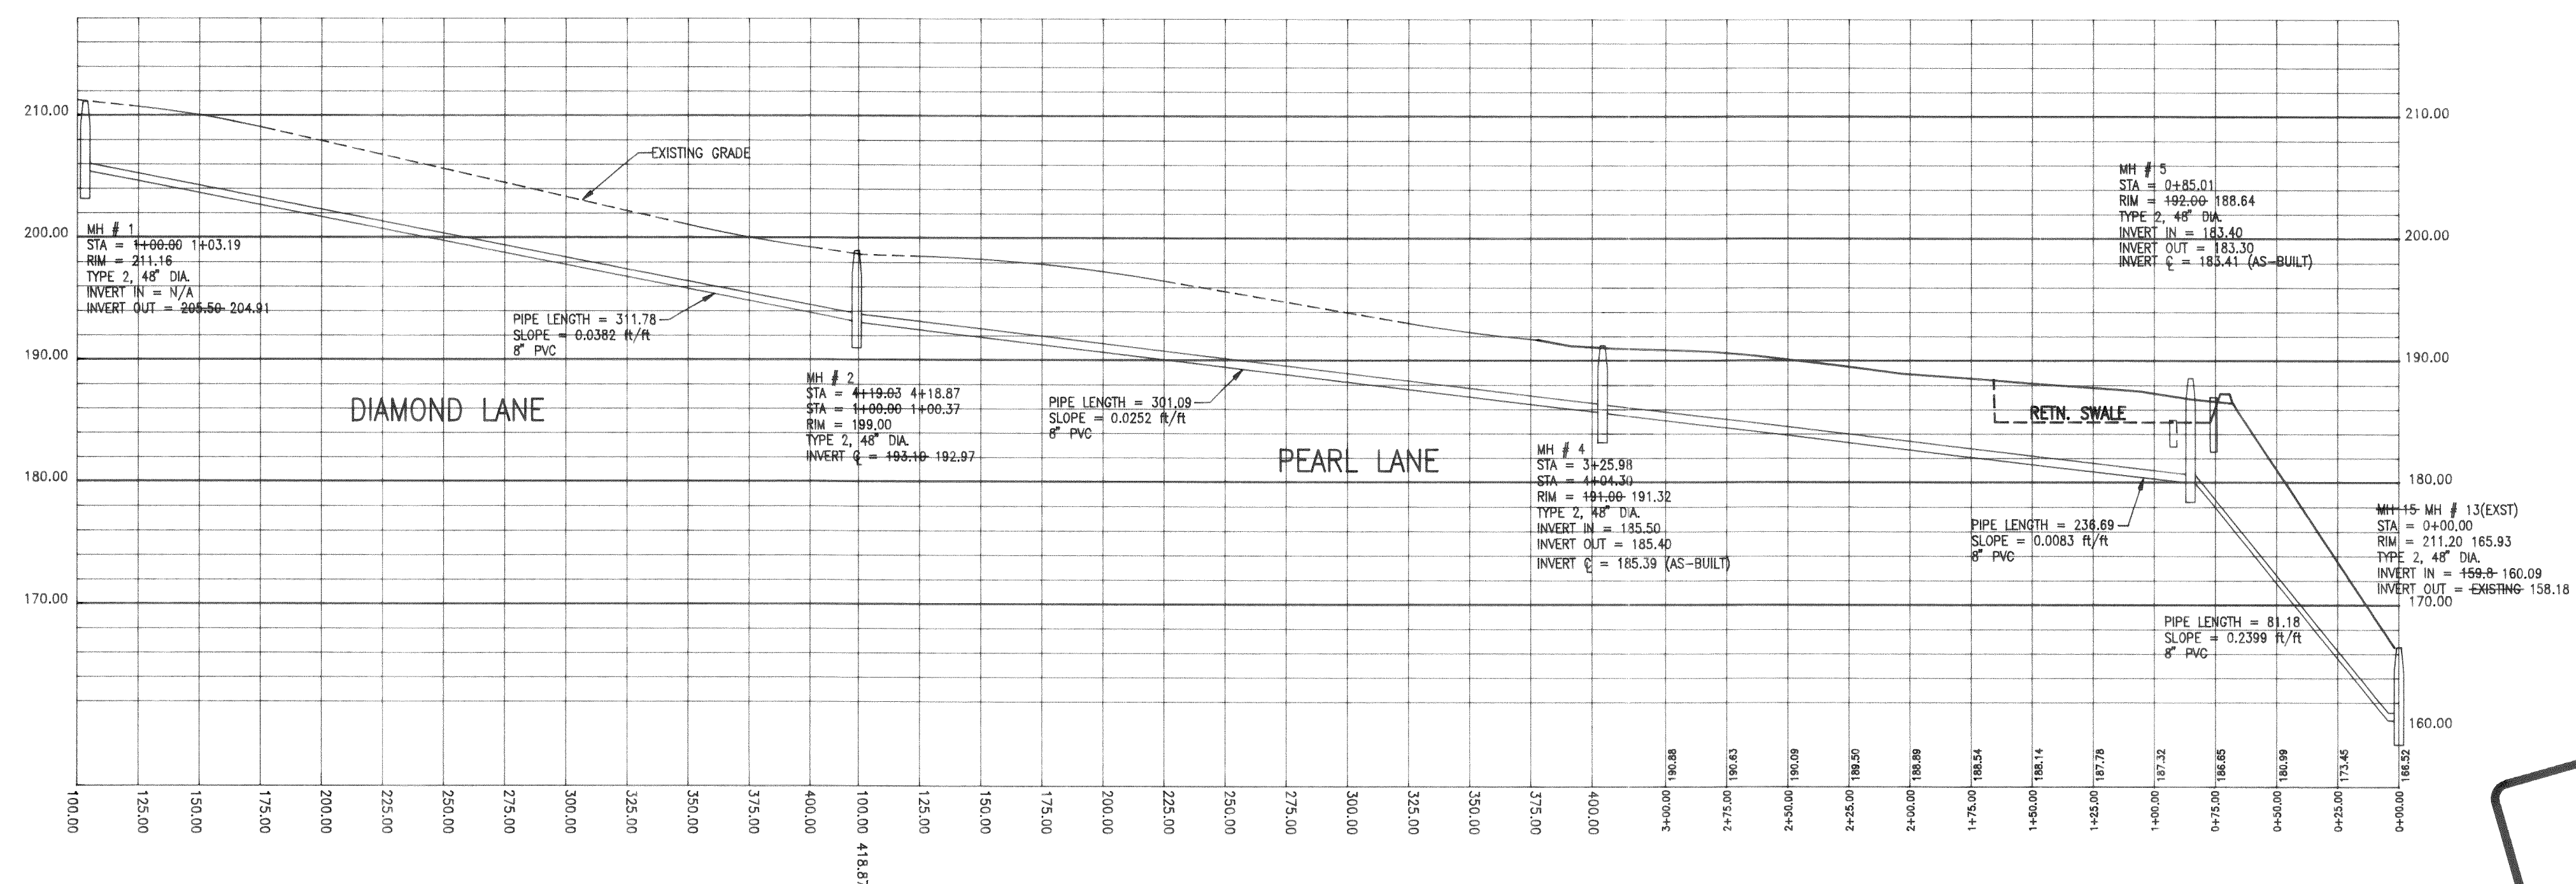


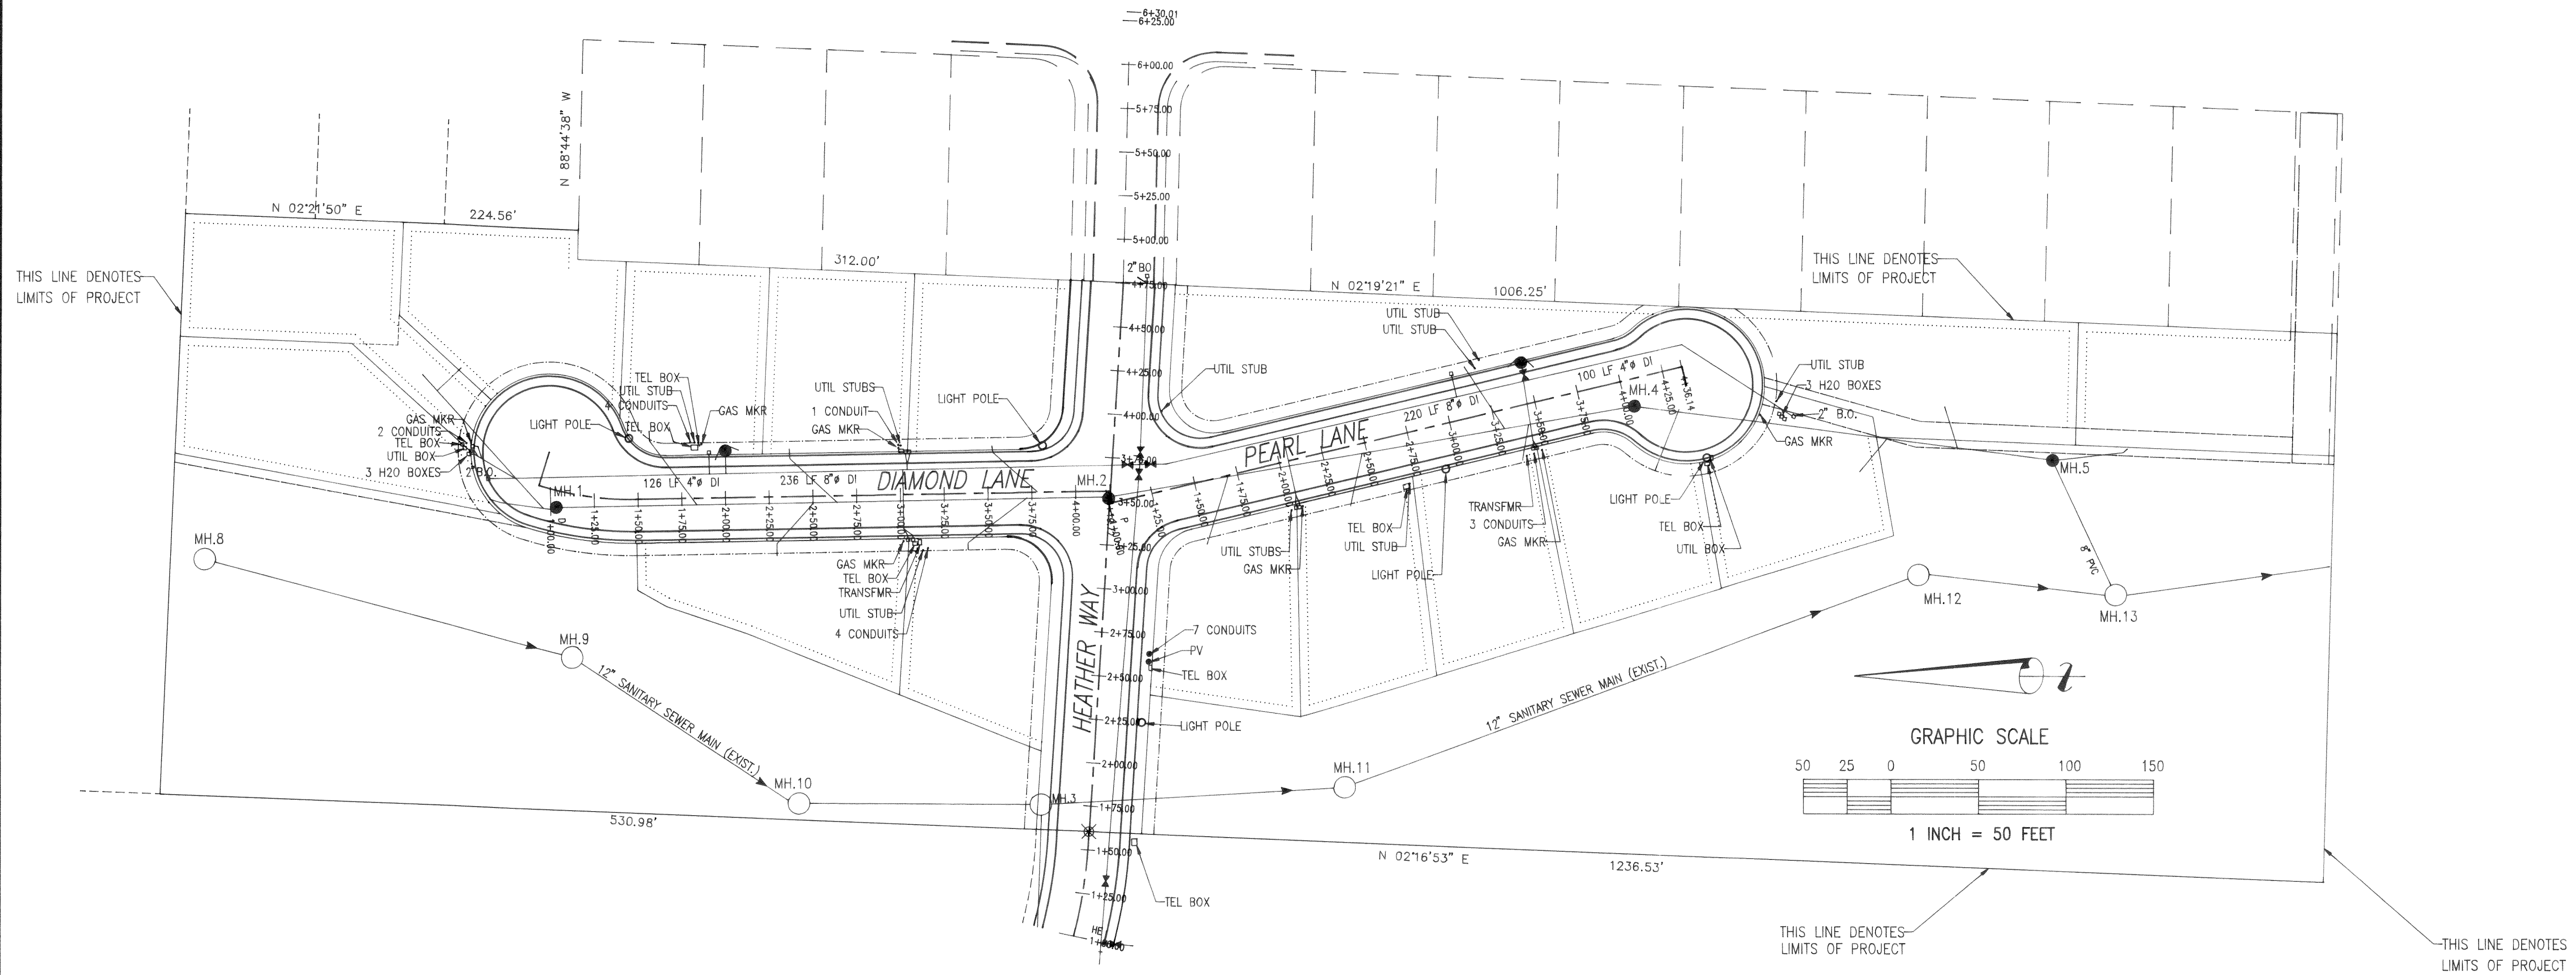

AMETRON
CONSULTING GROUP, INC.
6951 Hannegan Rd. Suite 14
Lynden, Washington 98264 206-354-7617

DRAWN: D. A. TILTON

CHECKED:

FILE: 3E20A02.DWG




CONSTRUCTION DRAWINGS
EMERALD TERRACE
A RESIDENTIAL SUBDIVISION
FERNDALE, WASHINGTON

REVISIONS
NO. DATE DESCRIPTION
1 9/29/93 ISSUE

PROJECT NO. DATE
3E20A 5-20-93


SHEET TITLE
SANITARY SEWER
& WATER SERV.
AS BUILT

SHEET NO.
2 OF 5

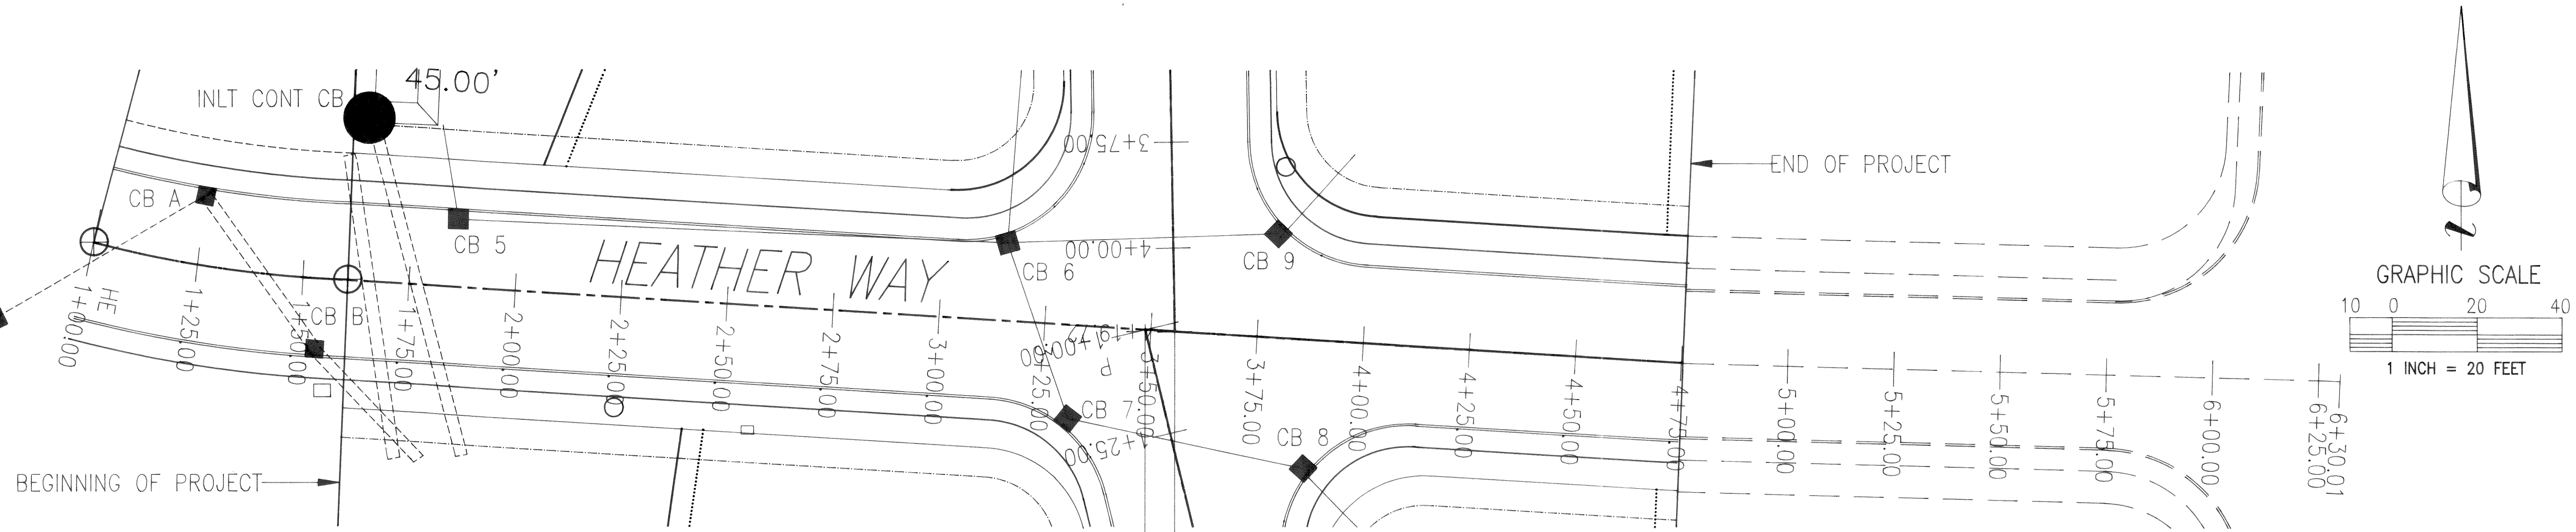

HEATHER WAY
Elevation displayed at 5x Scale

APPROX. INT.
IN GARDNER PLAT

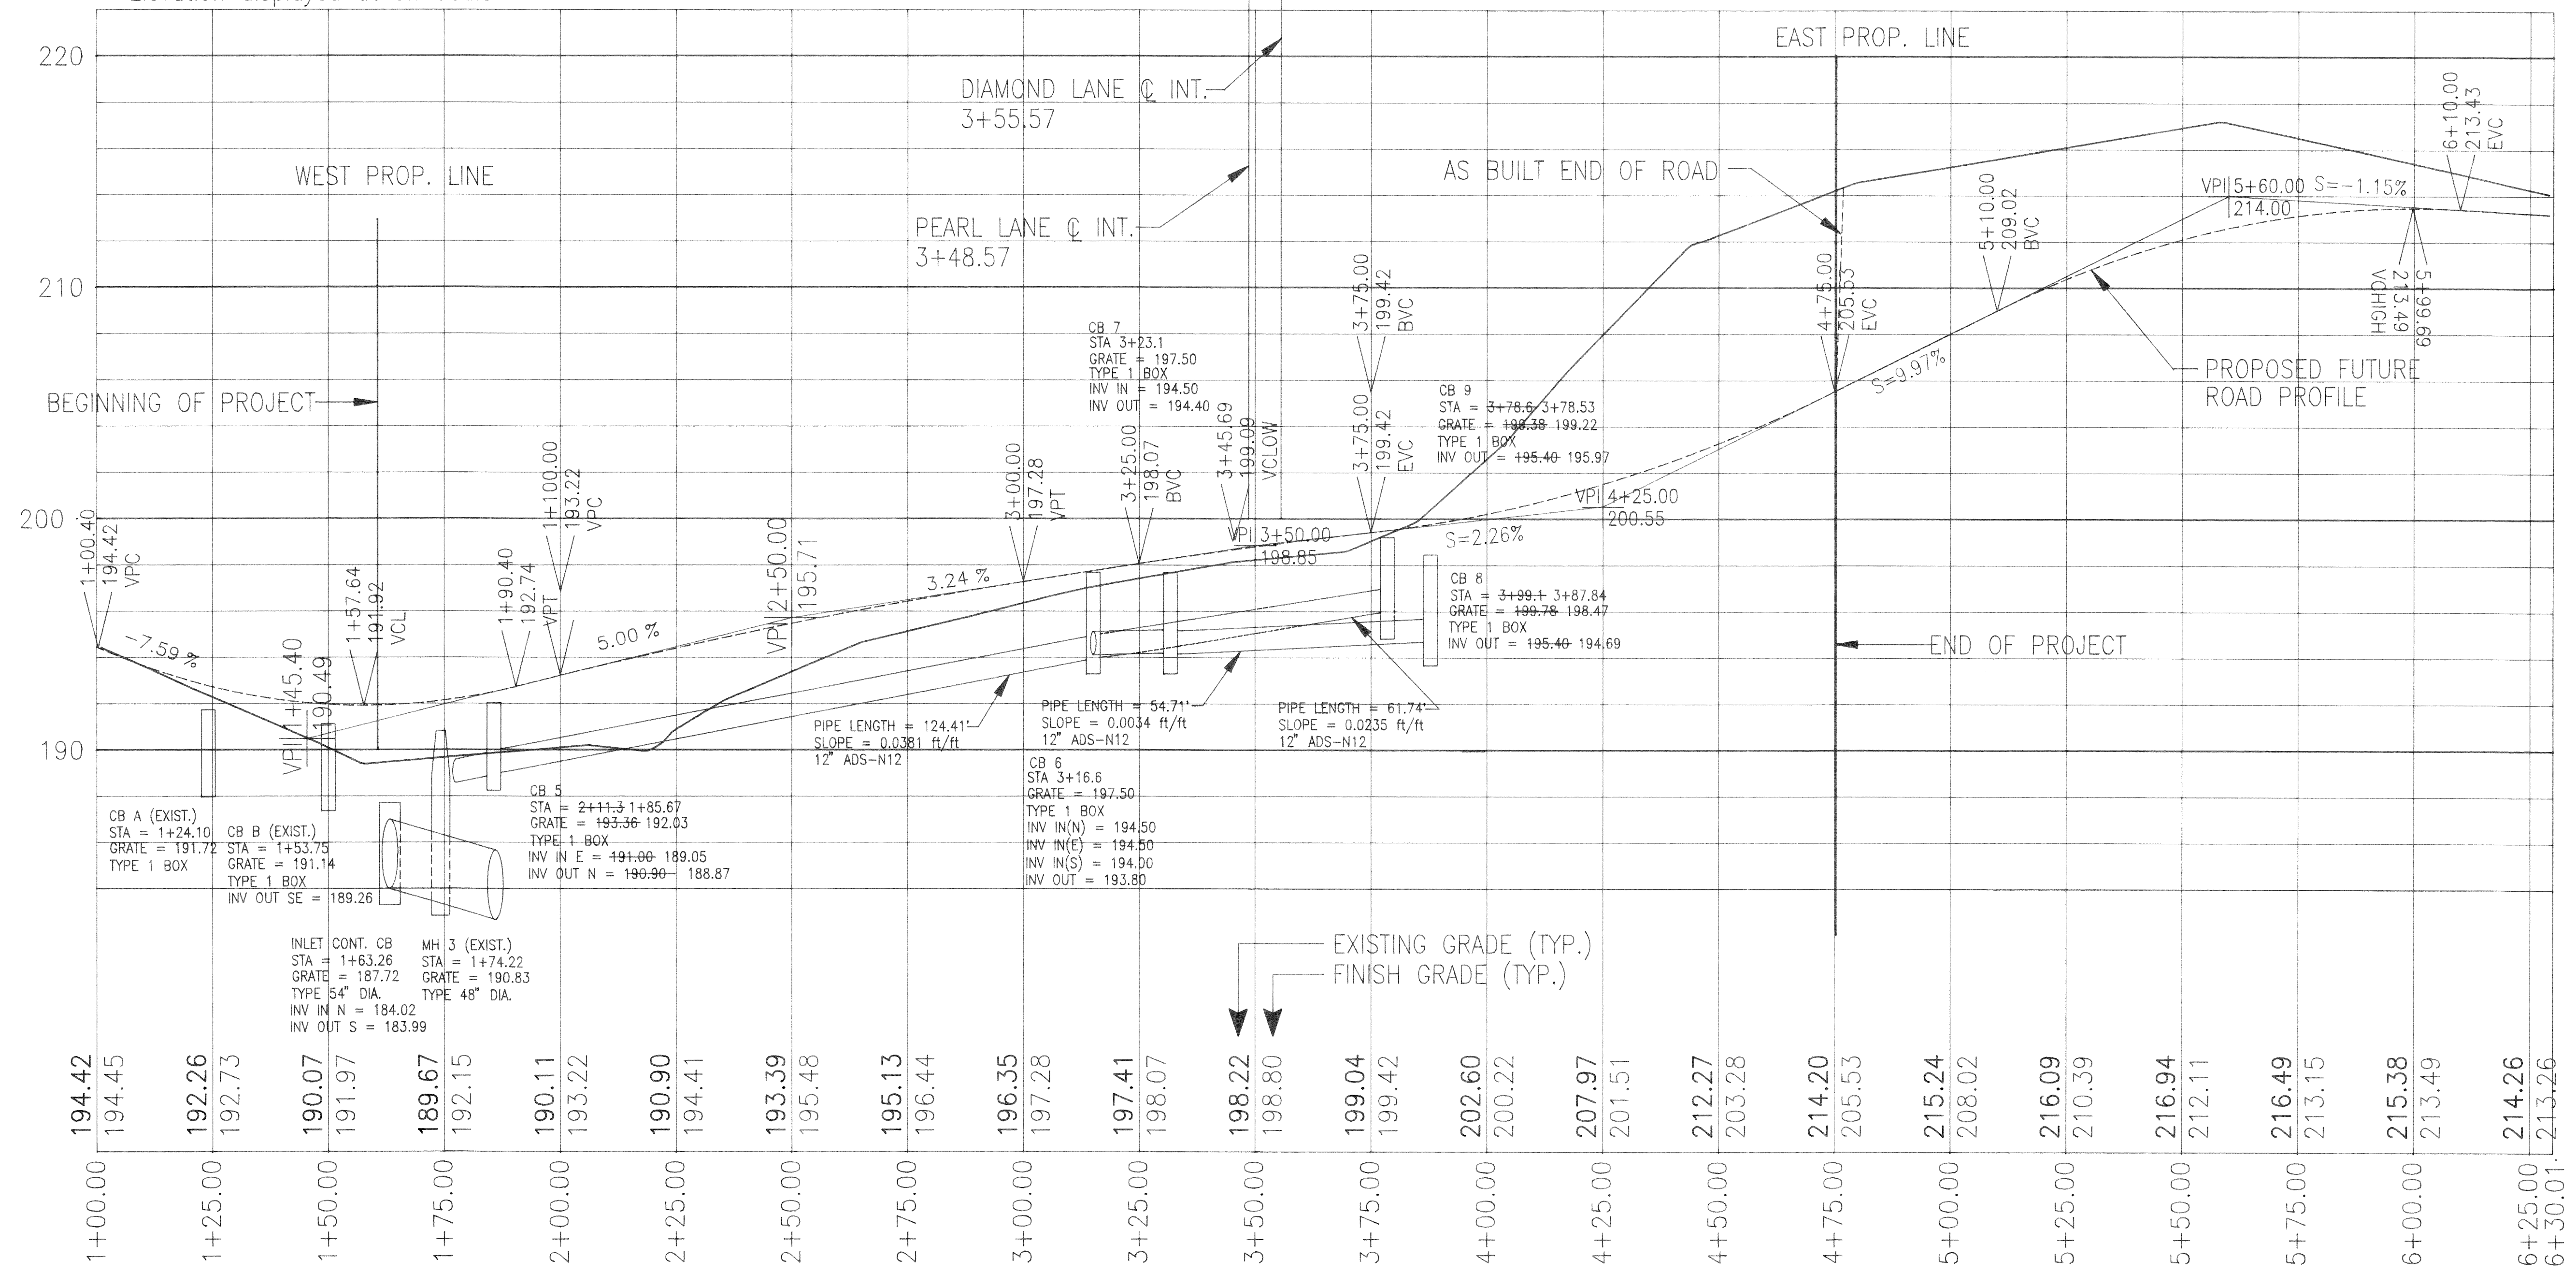

6951 Hannegan Rd. Suite 14
Lynden, Washington 98264 206-354-7617

DRAWN: D. A. TILTON

CHECKED: _____

FILE: 3E20A03.DWG

CONSTRUCTION DRAWINGS

EMERALD TERRACE

A RESIDENTIAL SUBDIVISION

FERDALE, WASHINGTON

REVISIONS

NO.	DATE	DESCRIPTION
1	5/13/94	ISSUE

PROJECT NO. 3E20A

DATE 5-20-93

SHEET TITLE

HEATHER WAY



ROAD PROFILE

& STM. SEWER


AS BUILT

SHEET NO.

3 OF 5

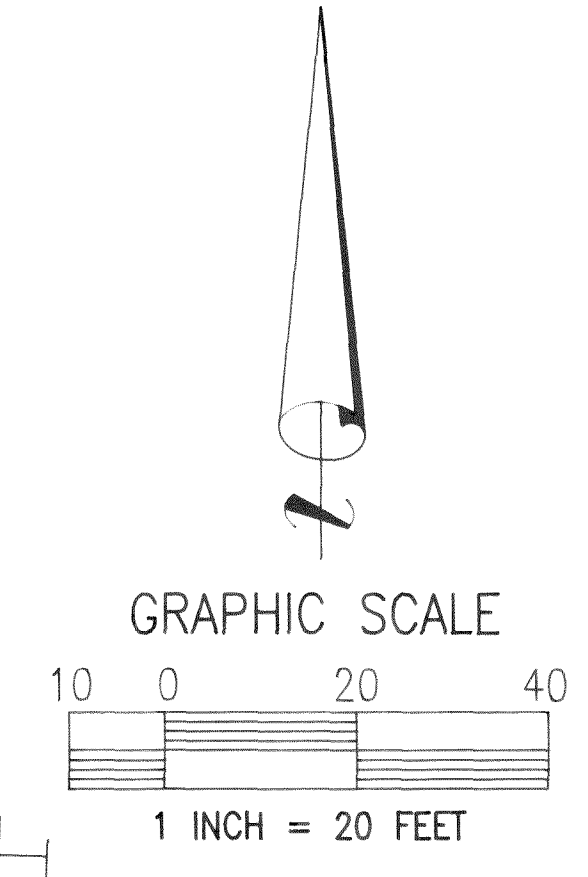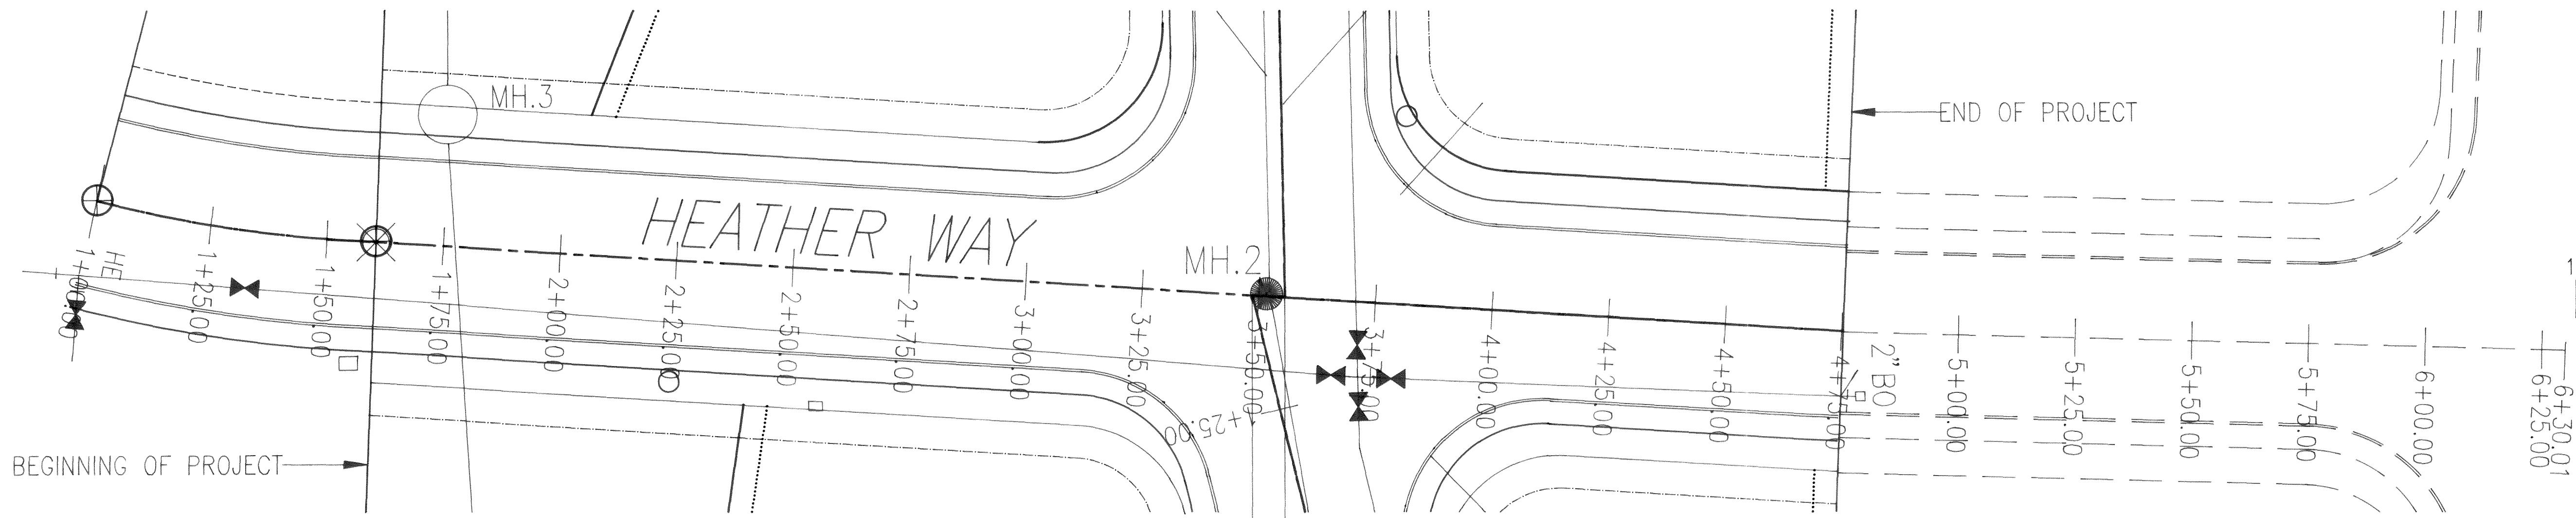

HEATHER WAY
Elevation displayed at 5x Scale

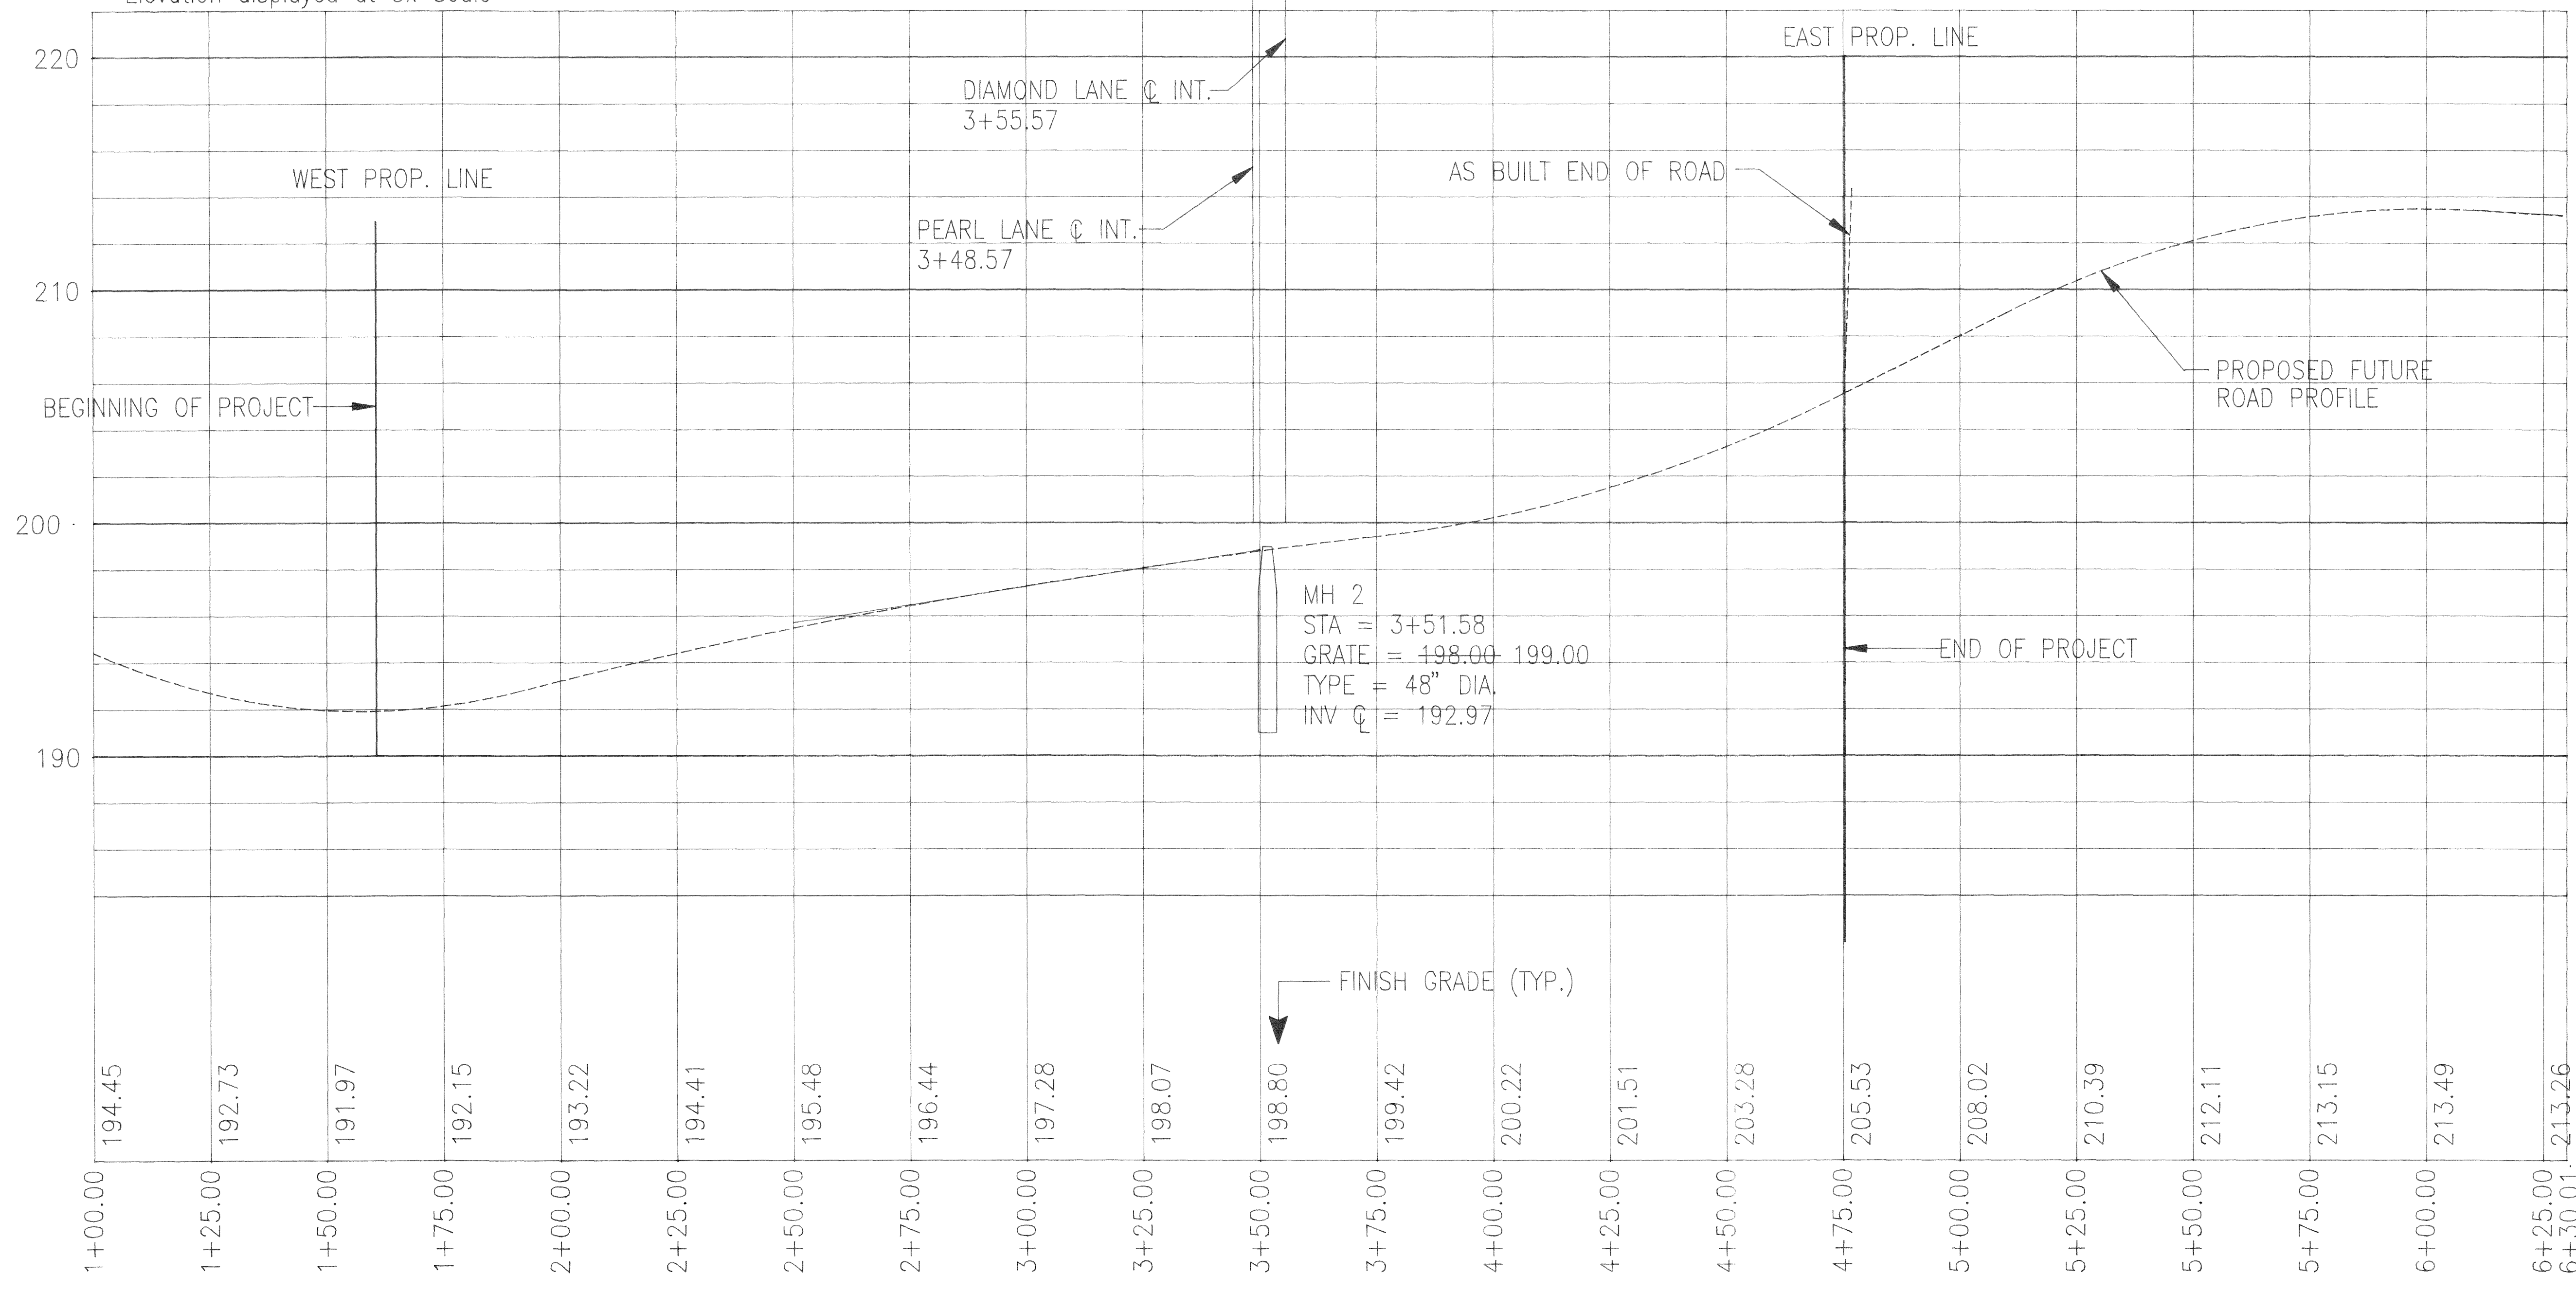

AS-BUILT

6951 Hannegan Rd. Suite 14
Lynden, Washington 98264 206-354-7617

DRAWN: D. A. TILTON

CHECKED: _____

FILE: 3E20A04.DWG

C. STIMMONS
REGISTERED PROFESSIONAL ENGINEER
04/05/94
DATE

CONSTRUCTION DRAWINGS

EMERALD TERRACE

A RESIDENTIAL SUBDIVISION

FERNDAL, WASHINGTON

REVISIONS

NO.	DATE	DESCRIPTION
1	5/13/94	ISSUE

PROJECT NO. DATE

3E20A 5-20-93

SHEET TITLE

HEATHER WAY
SAN. SEWER
& WATER
AS BUILT


SHEET NO.

4 OF 5

DRAWN: D. A. TILTON

CHECKED: _____

FILE: 3E20A05.DWG

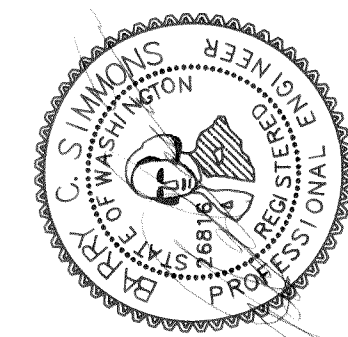

CONSTRUCTION DRAWINGS
EMERALD TERRACE
FERNDALE, WASHINGTON






REVISIONS		
NO.	DATE	DESCRIPTION
1	5-15-94	ISSUE

PROJECT NO. DATE
3E20A 8-21-91


SHEET TITLE
CULVERT SYSTEM

SHEET NO.
5 OF 5

00004.dwg 2-10-06 KT

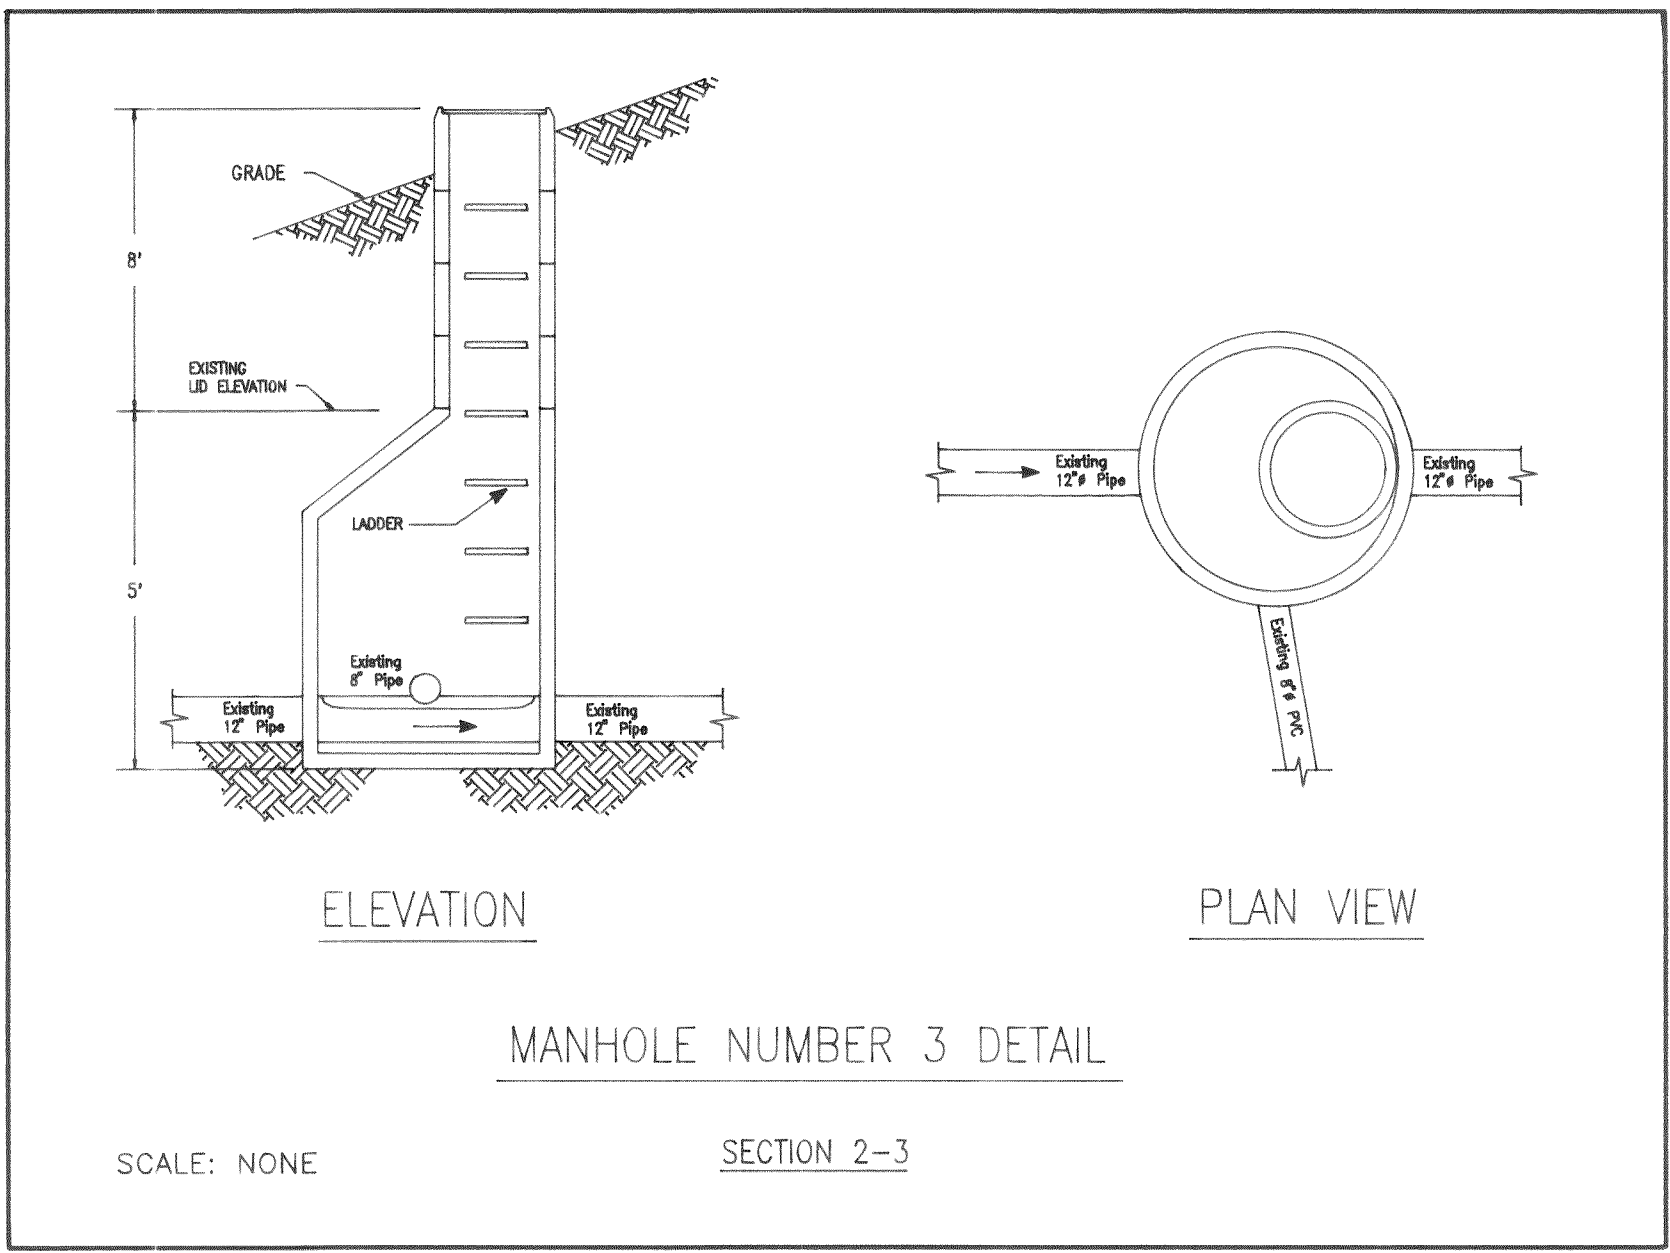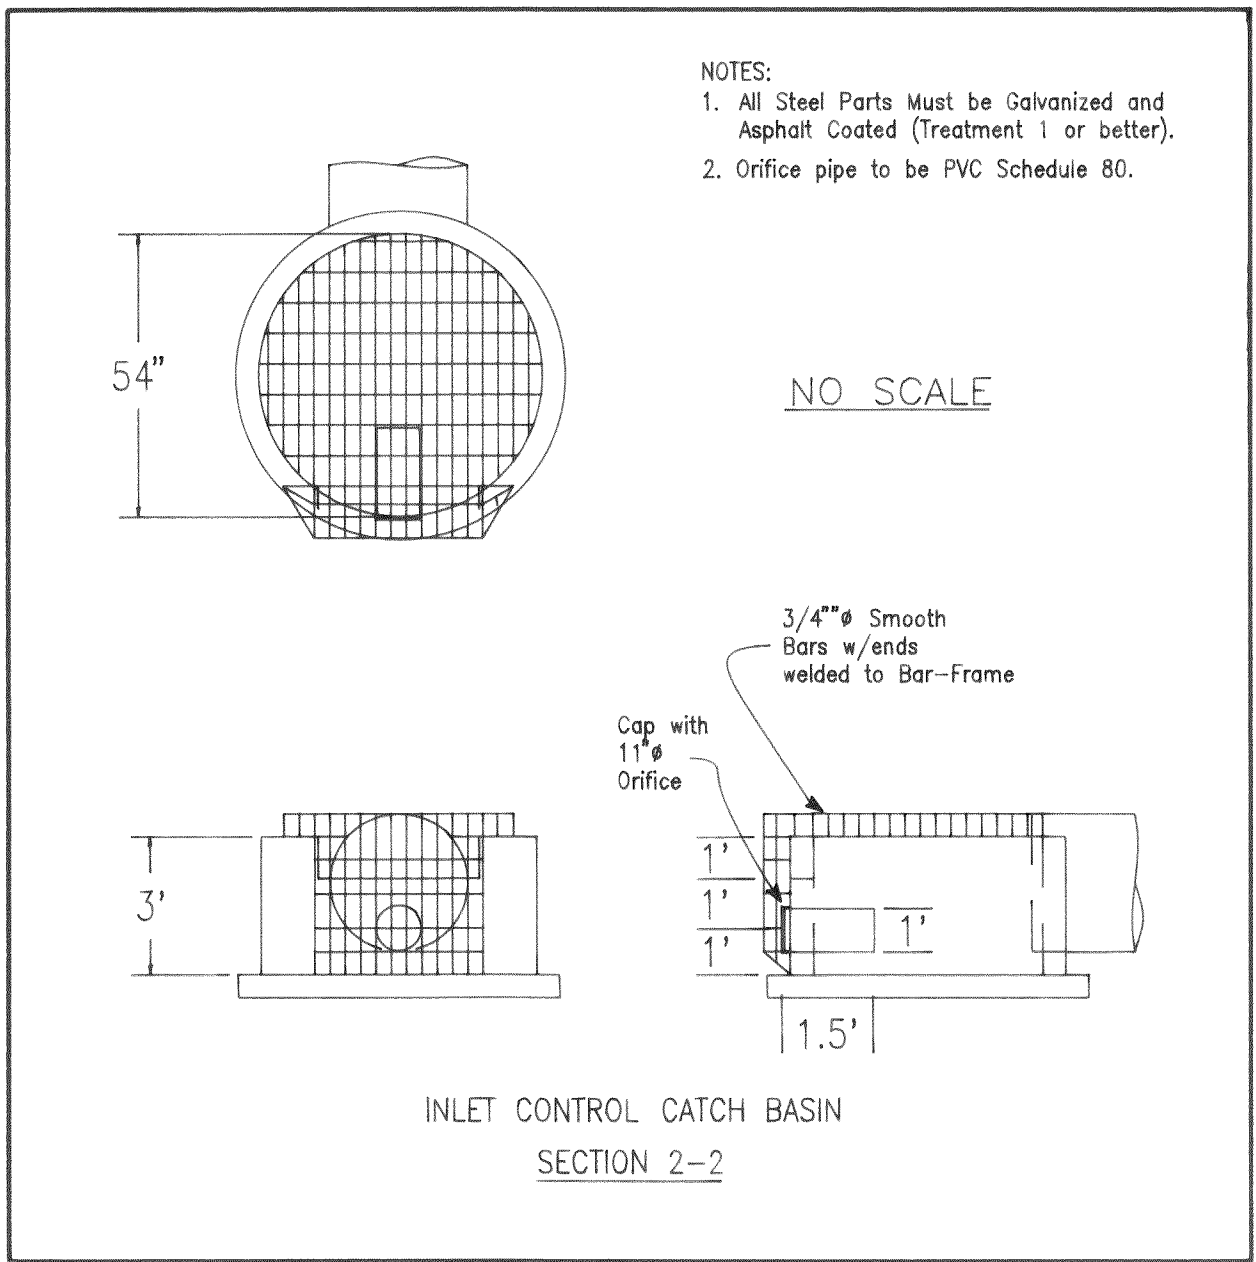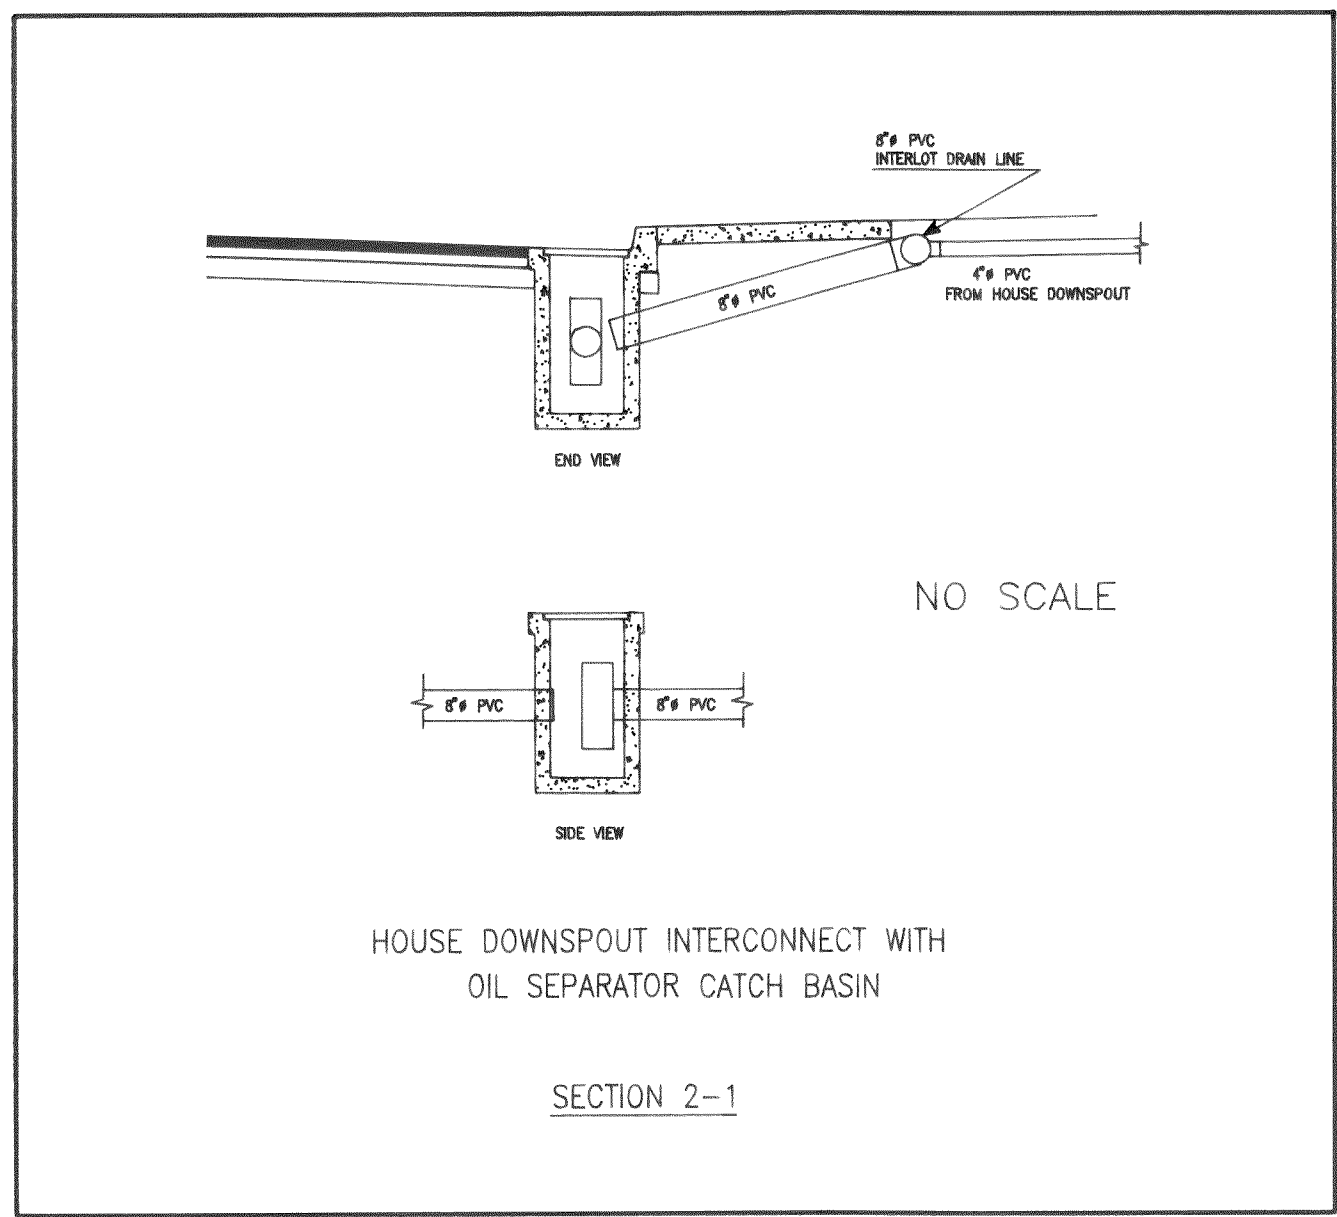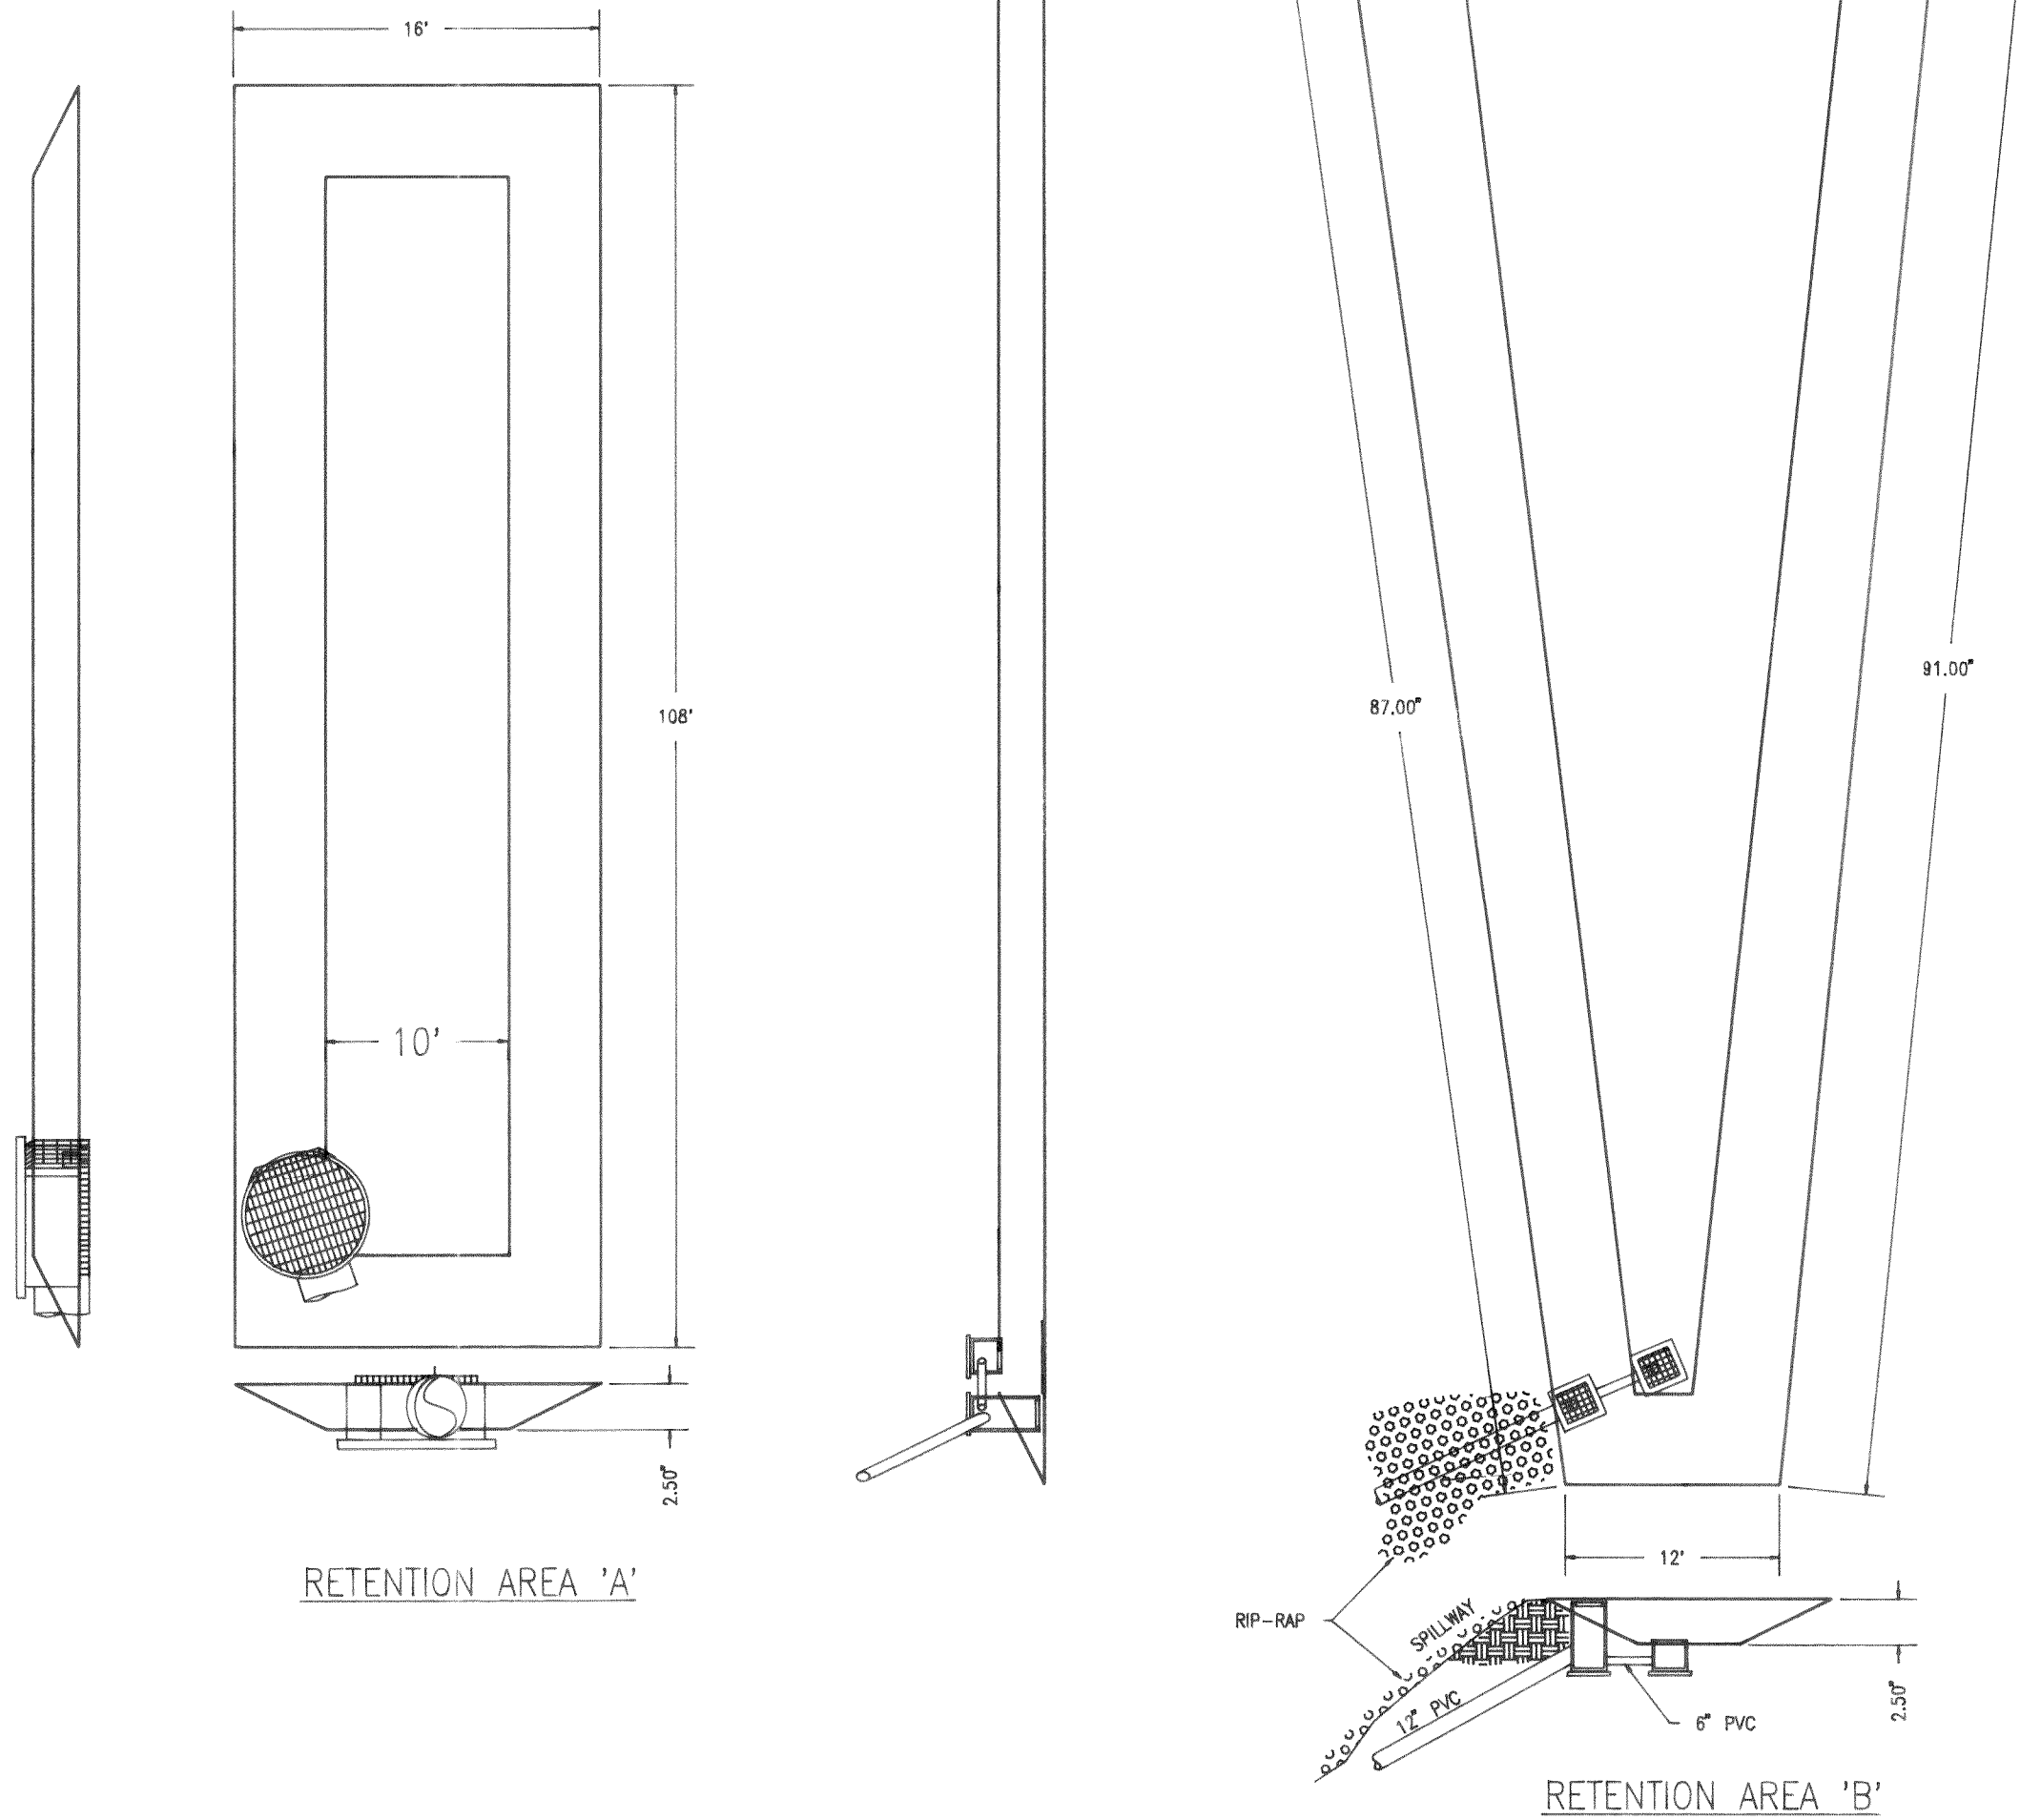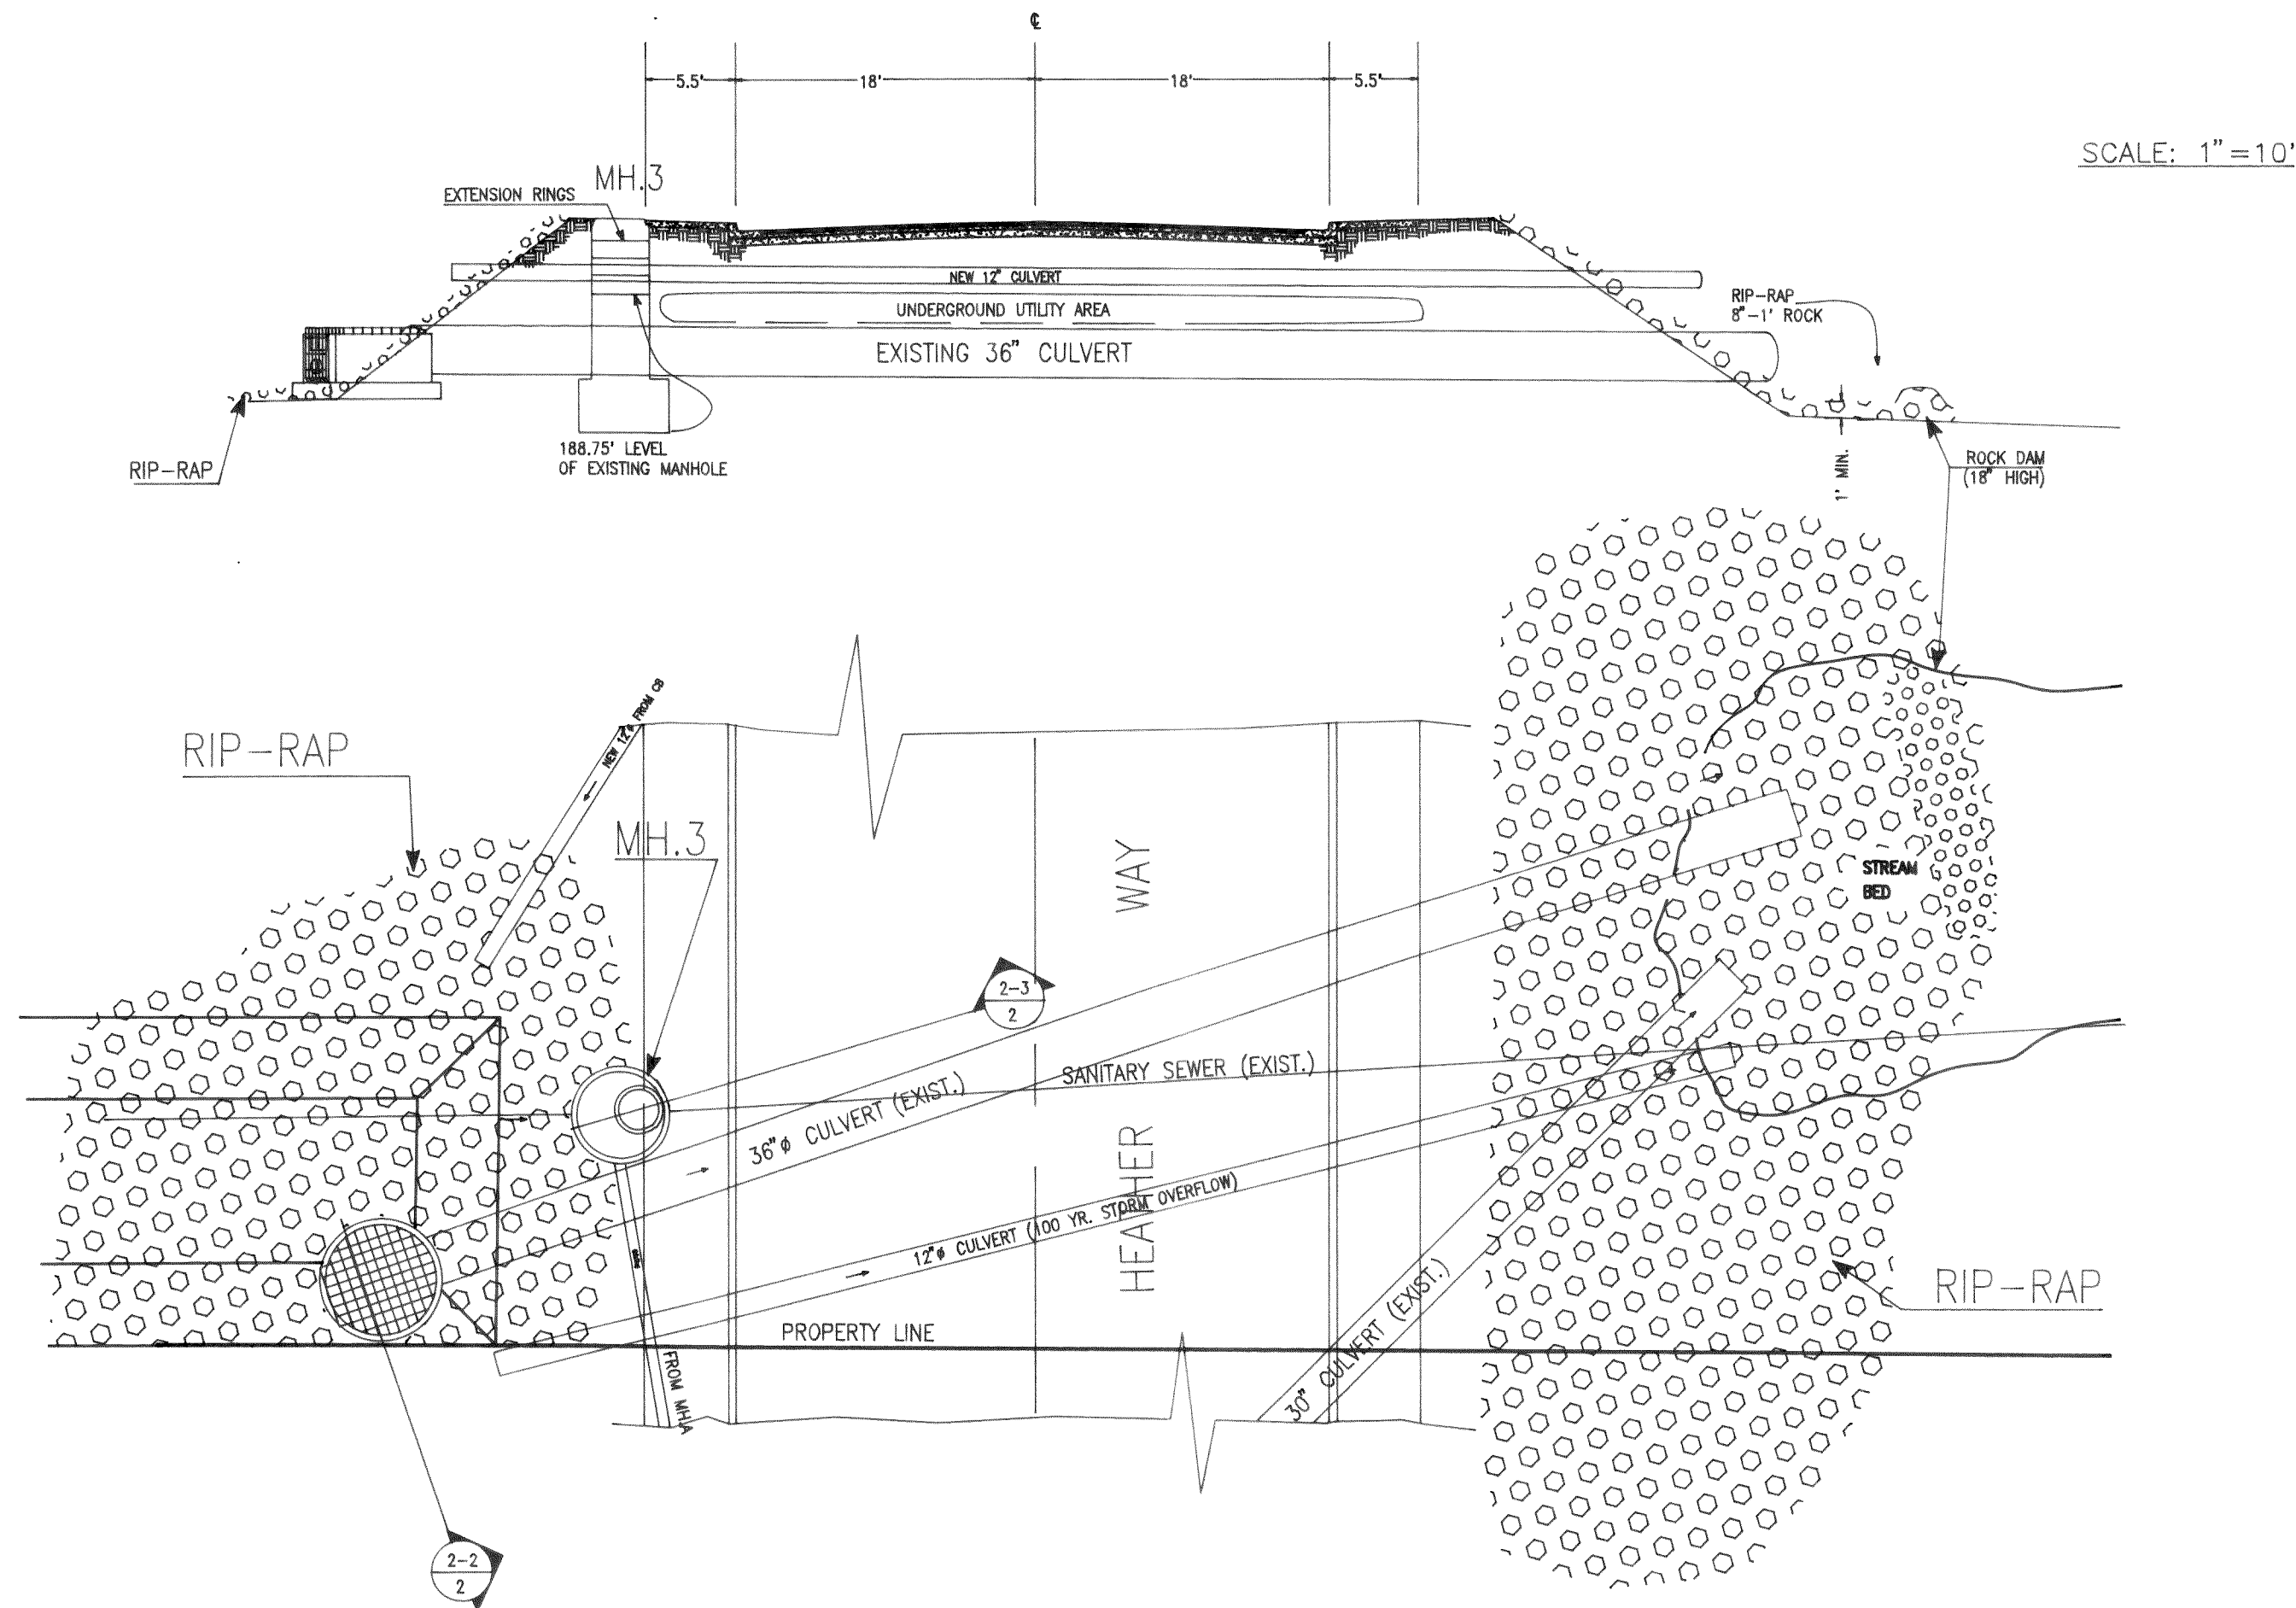


AS-BUILT

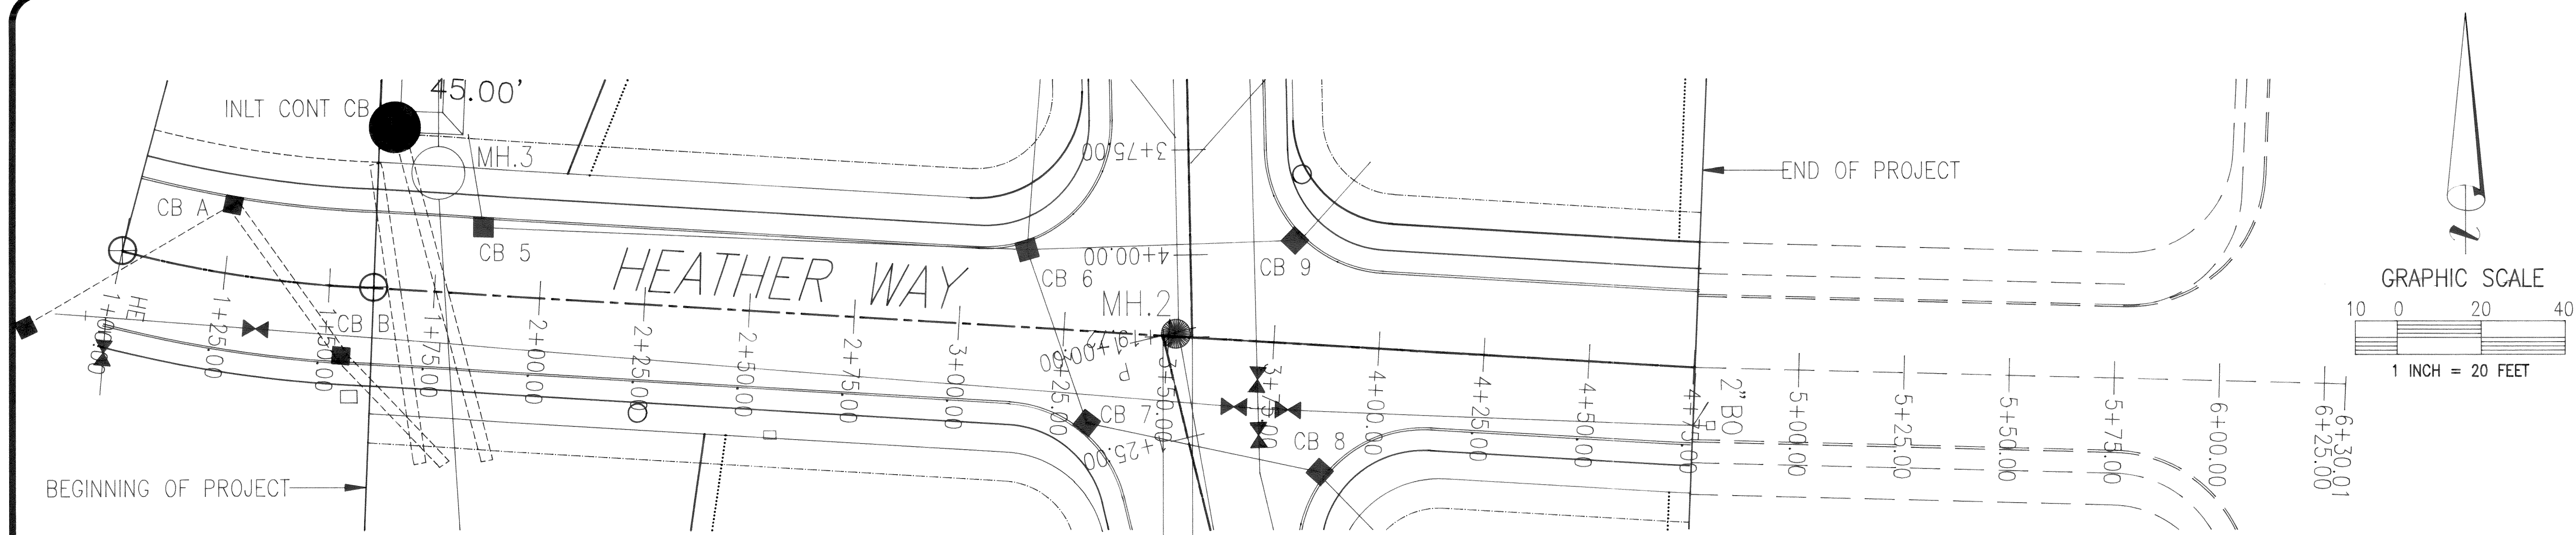


HEATHER WAY
Elevation displayed at 5x Scale

APPROX. INT.
IN GARDNER PLAT

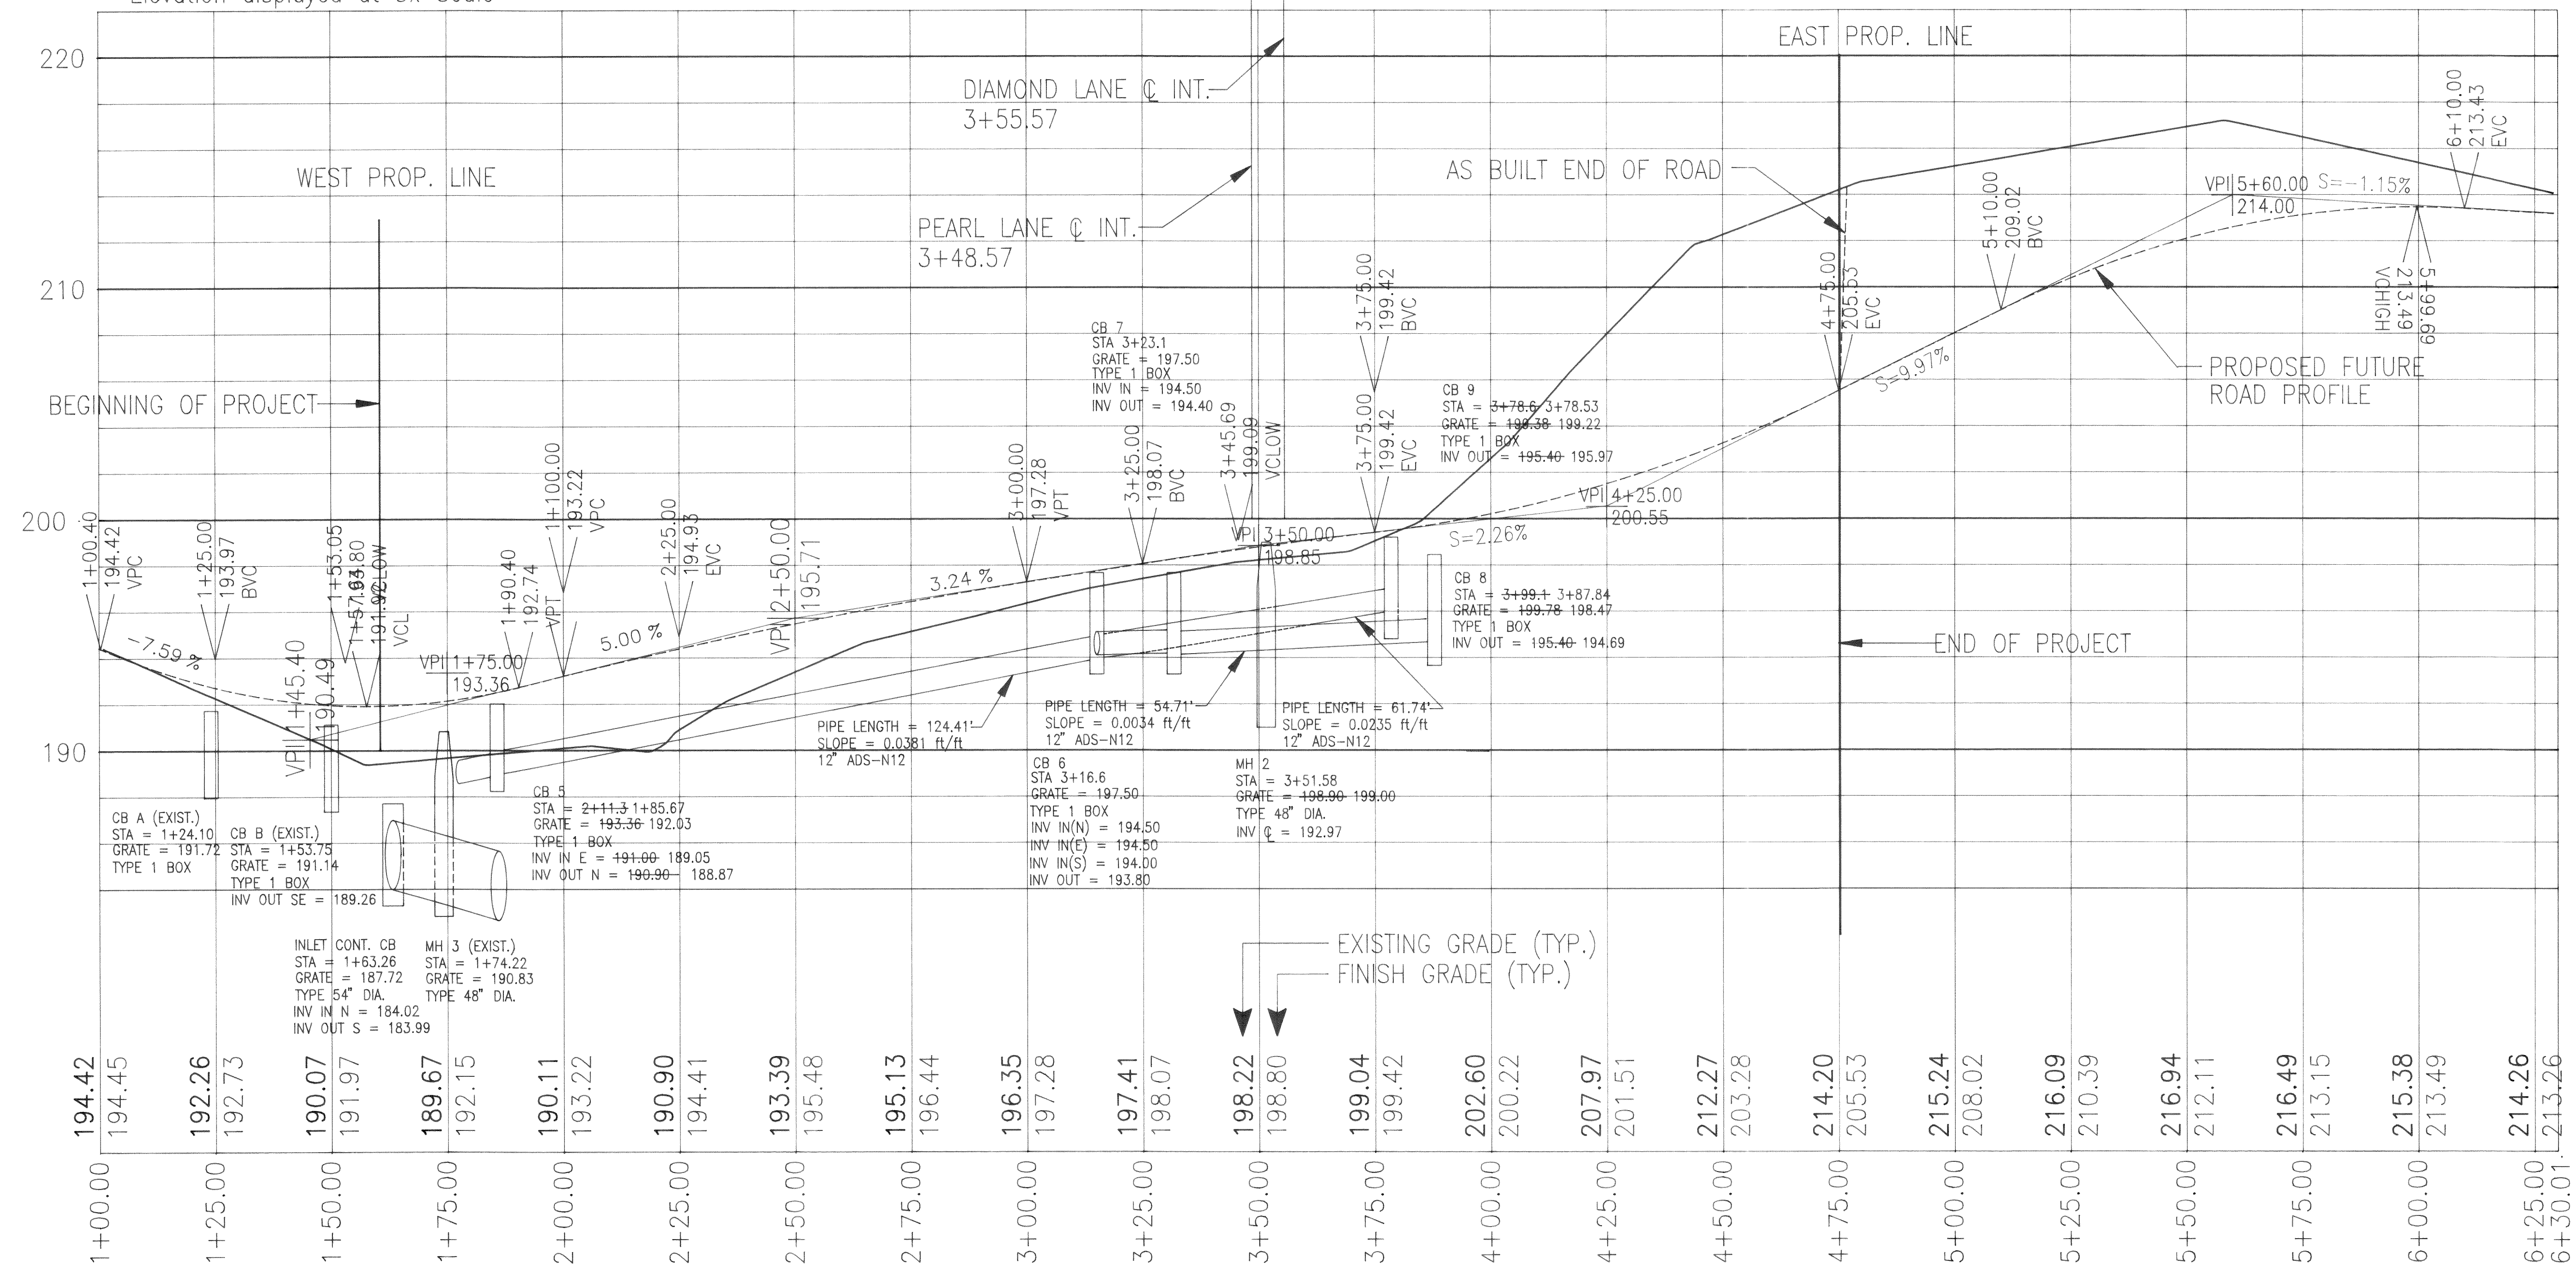

AS-BUILT

DRAWN: D. A. TILTON
CHECKED: _____
FILE: 3E20A02.DWG

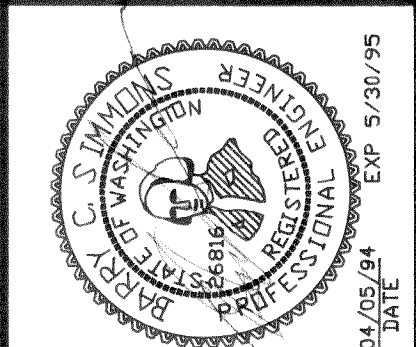

CONSTRUCTION DRAWINGS
EMERALD TERRACE
A RESIDENTIAL SUBDIVISION
FERDALE, WASHINGTON

REVISIONS







NO.	DATE	DESCRIPTION
1	9/29/93	ISSUE

PROJECT NO. DATE
3E20A 5-20-93

SHEET TITLE
HEATHER WAY
ROAD PROFILE
AS BUILT

SHEET NO.
2 OF 3

00039.007 2-10-06 K12

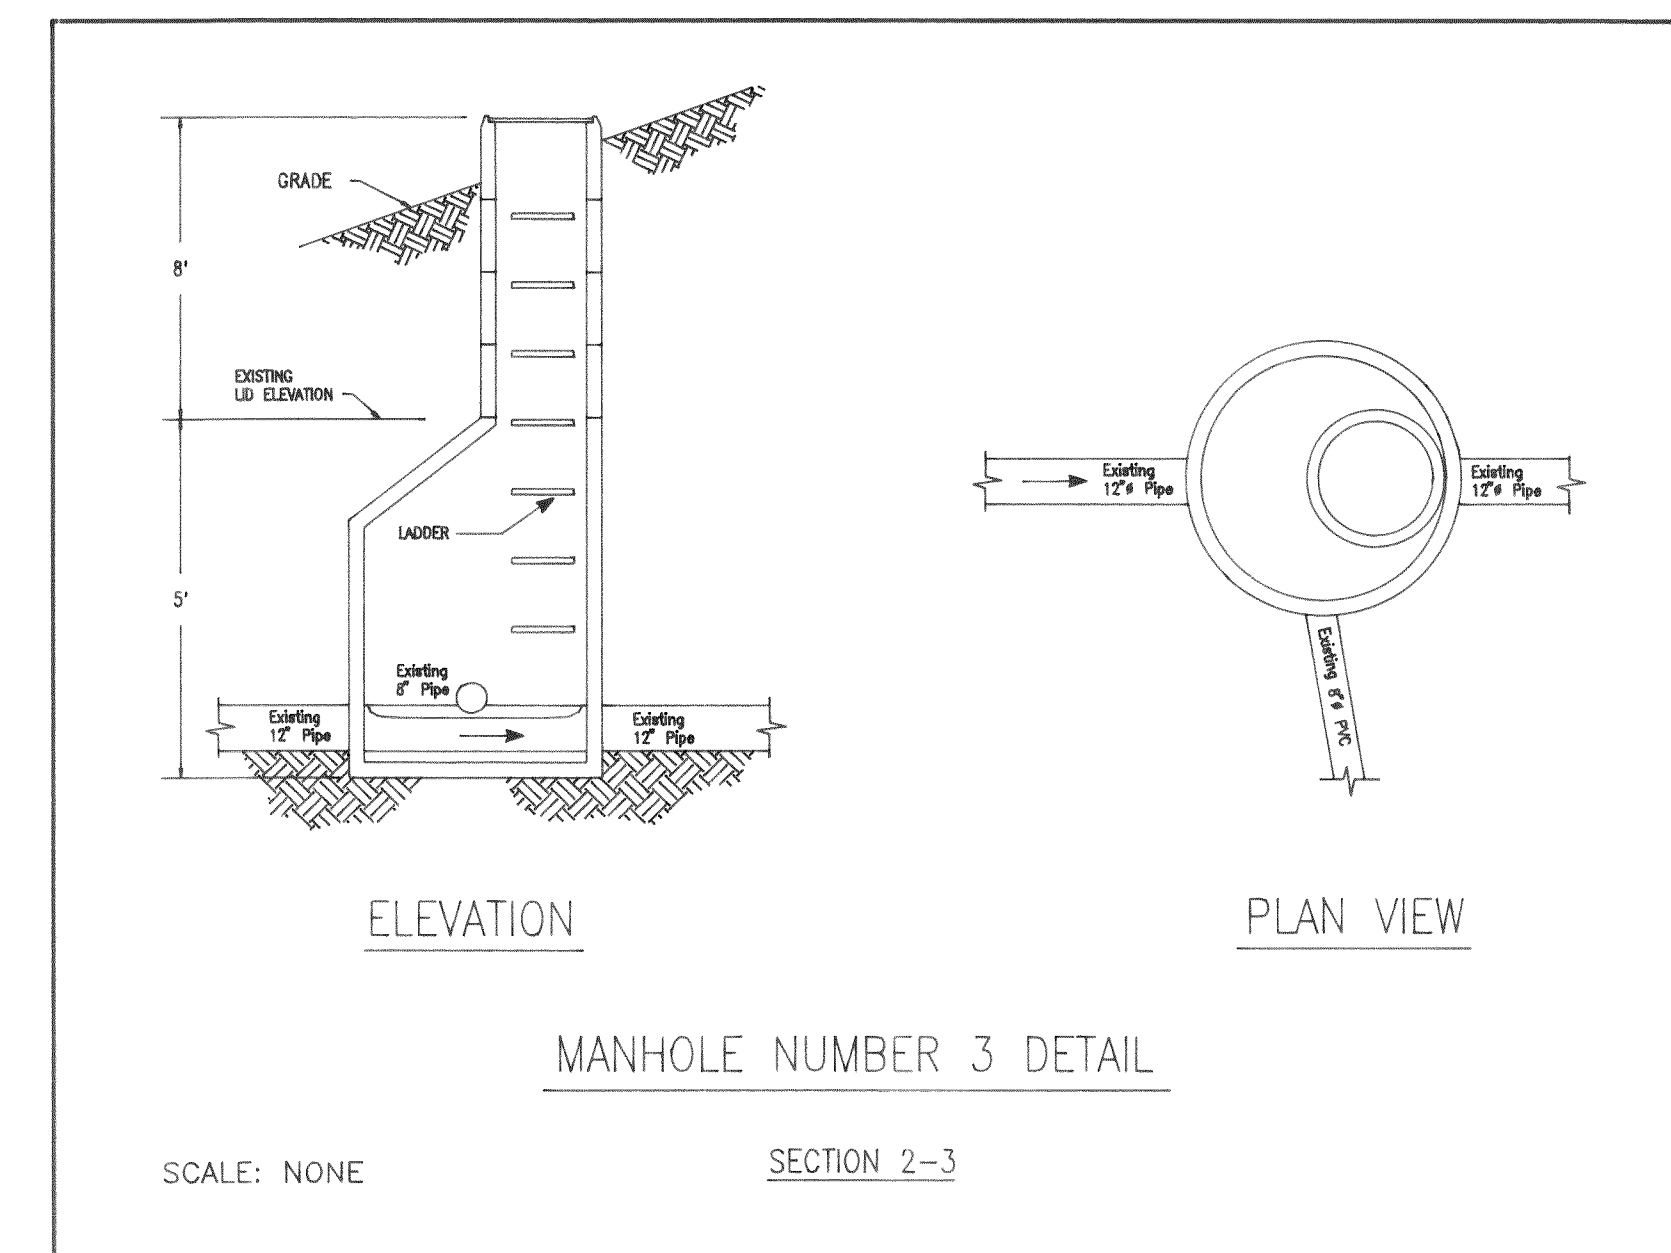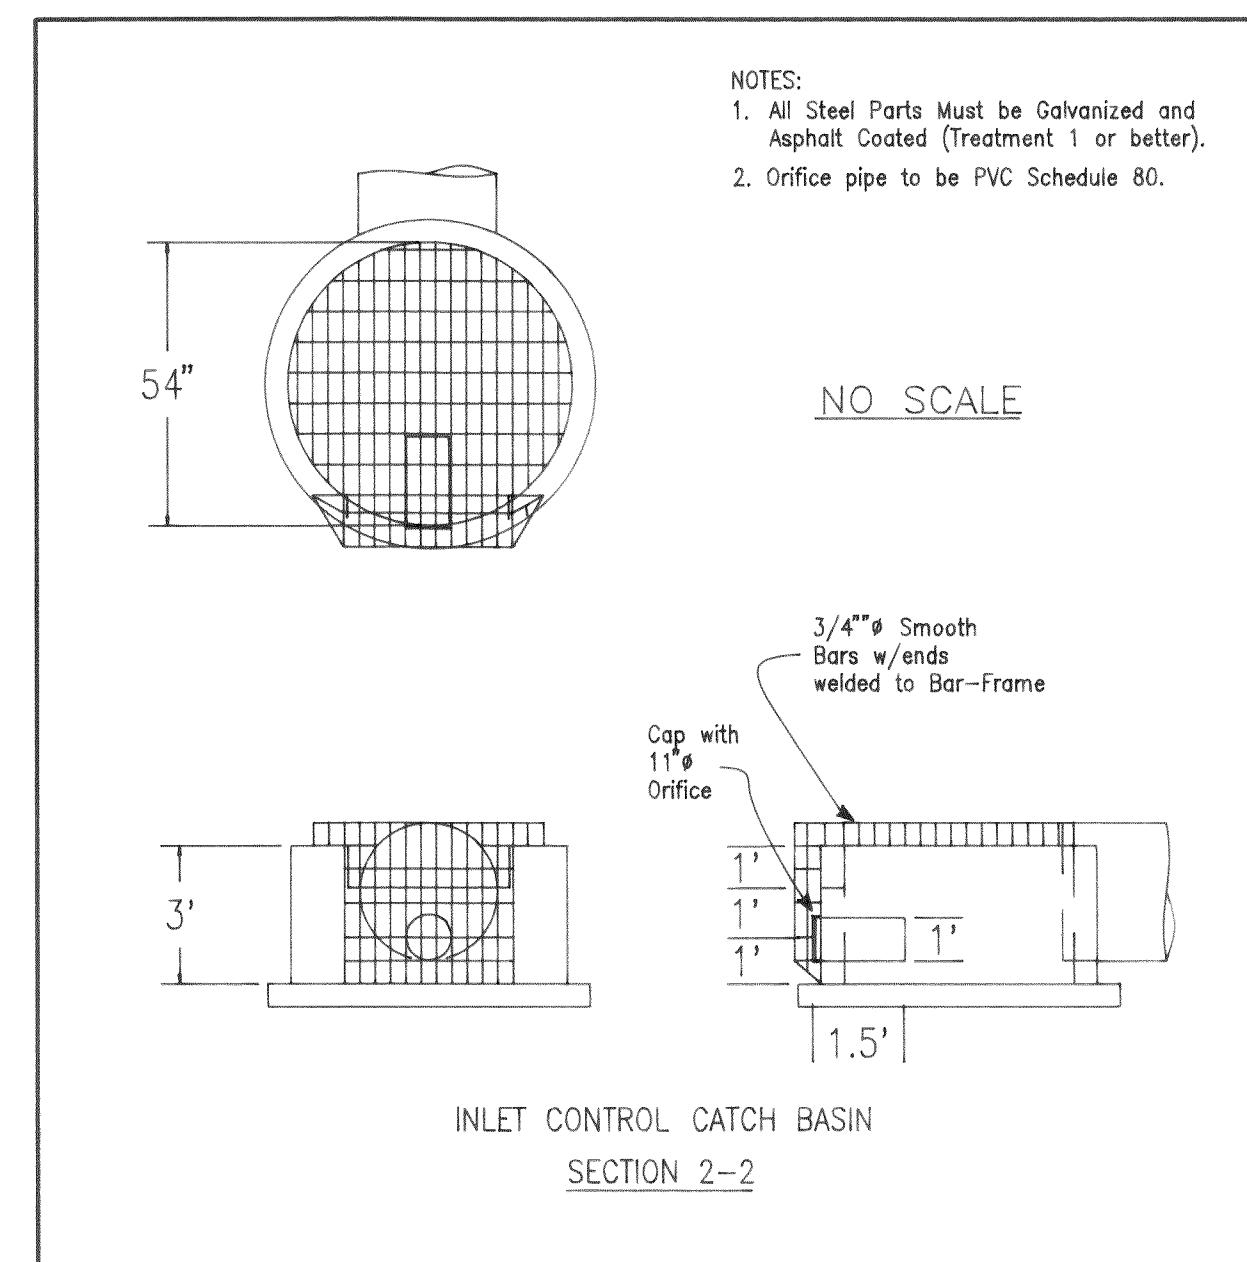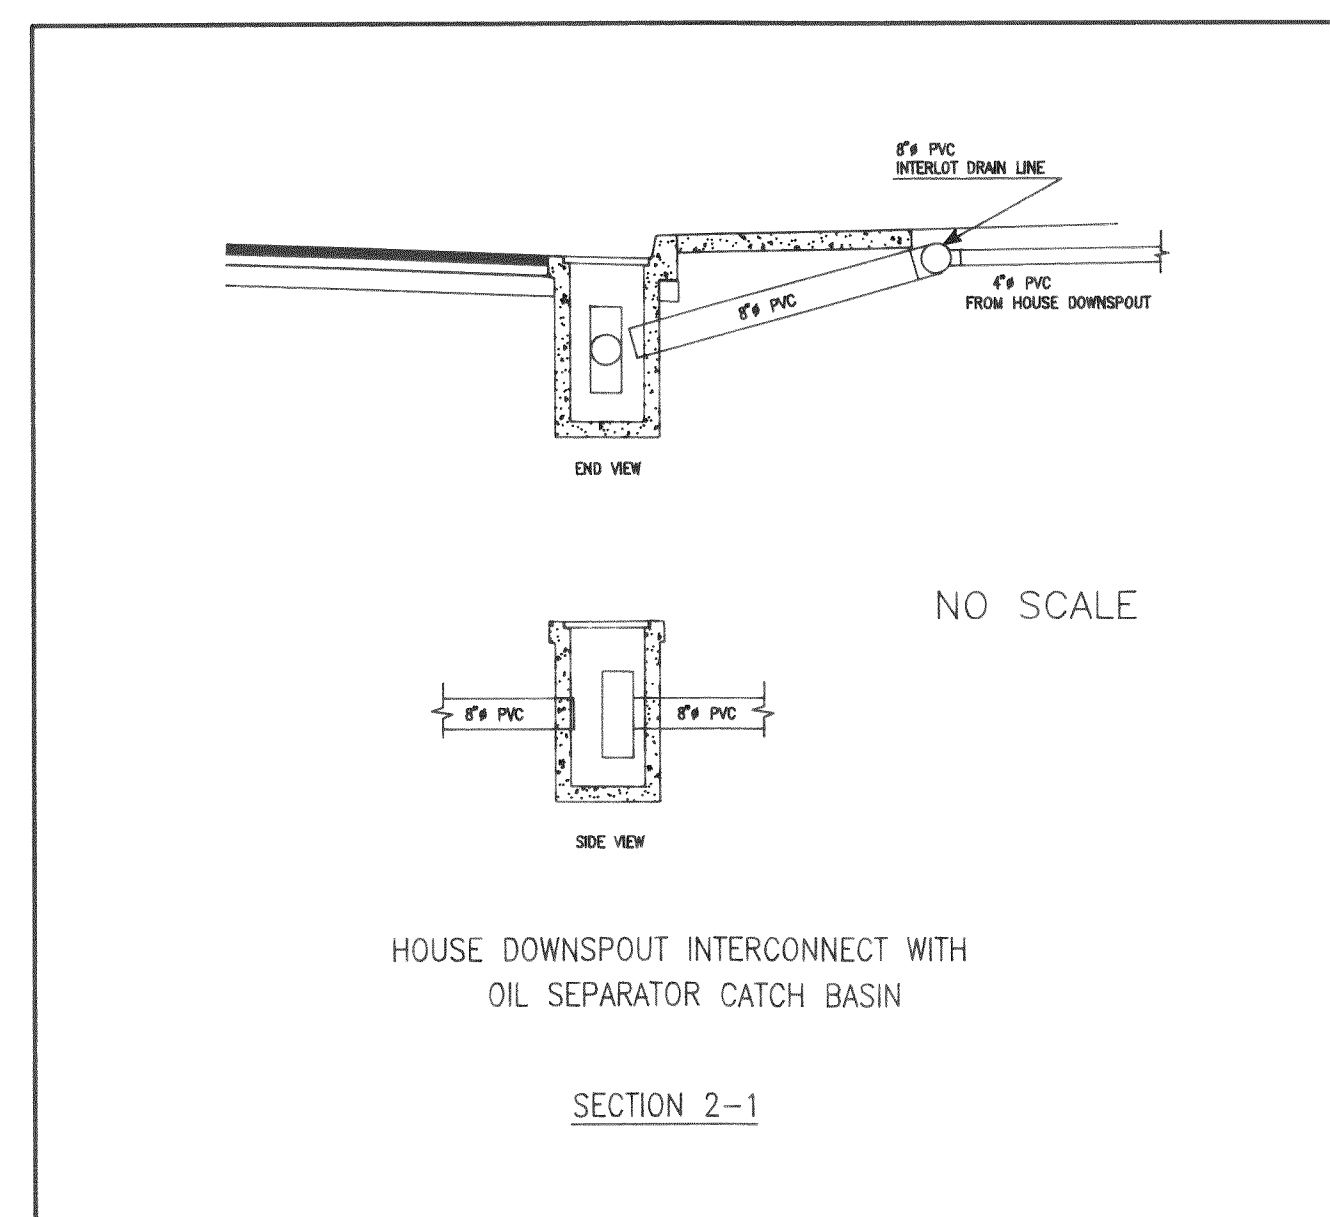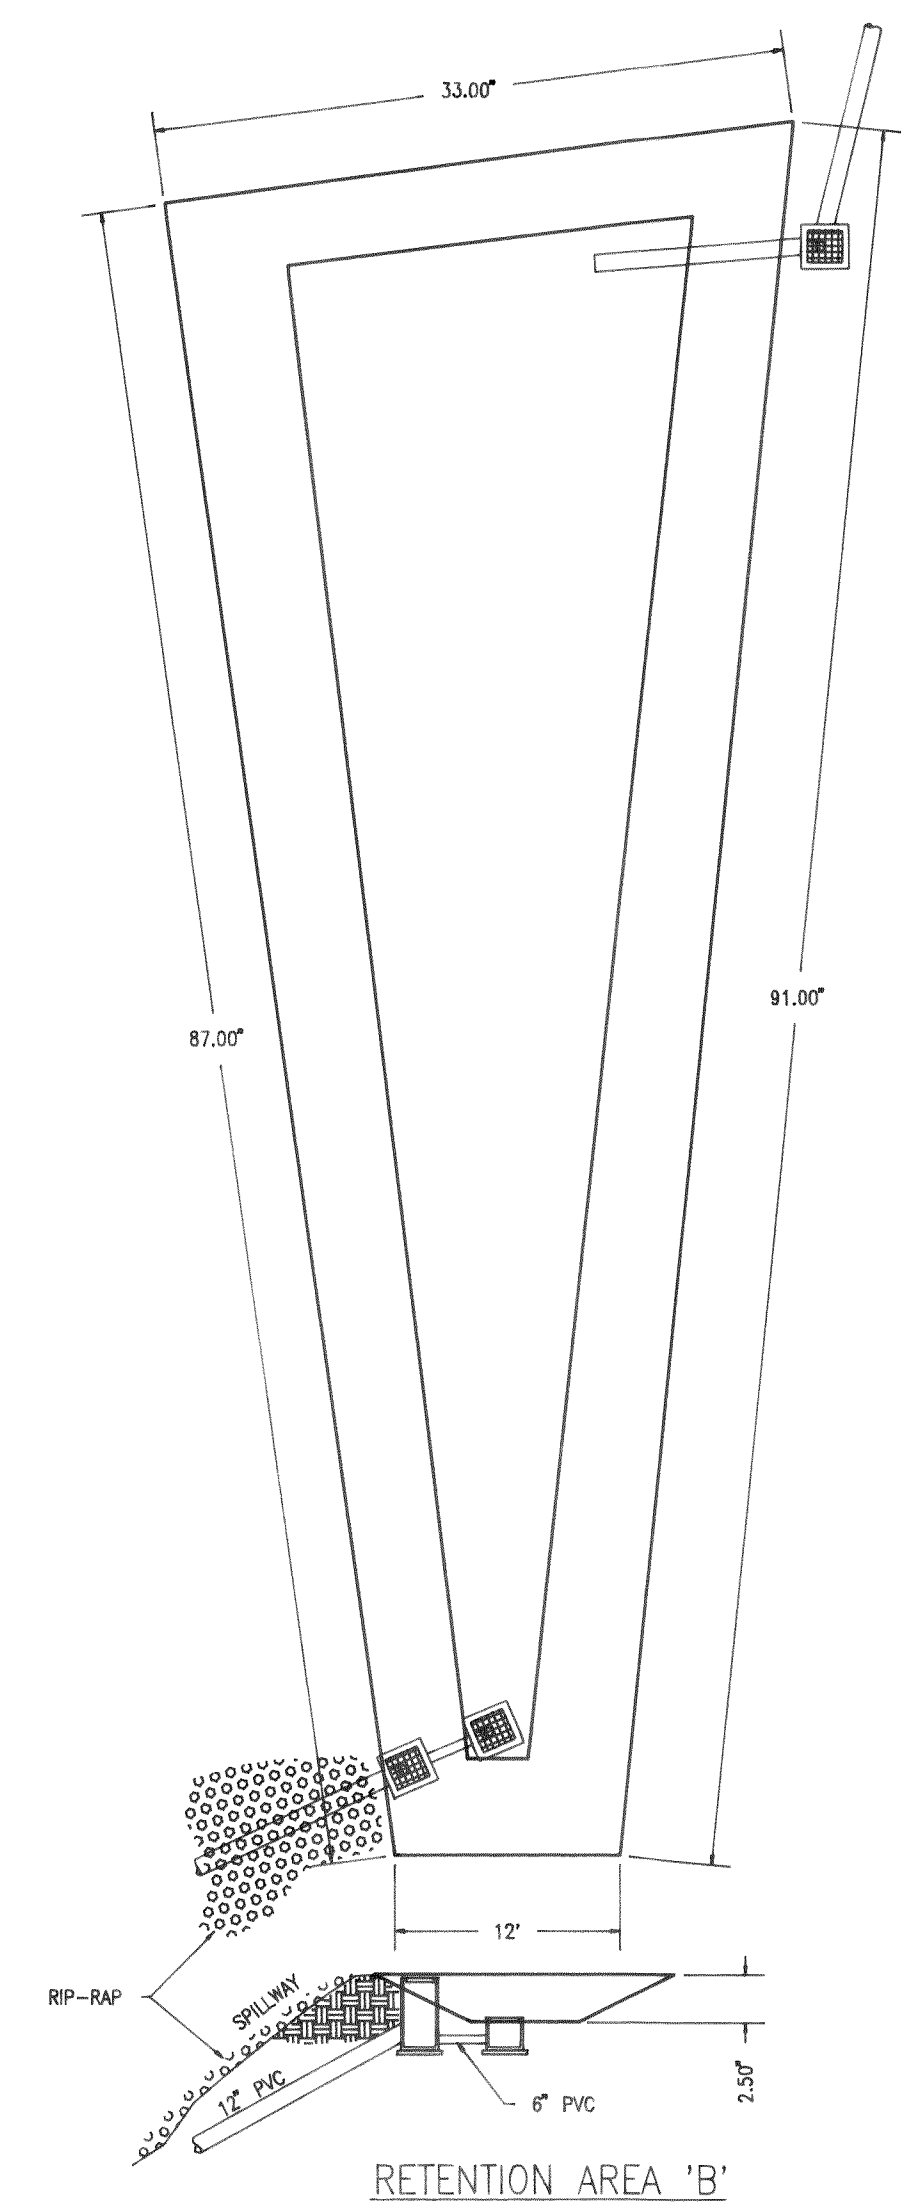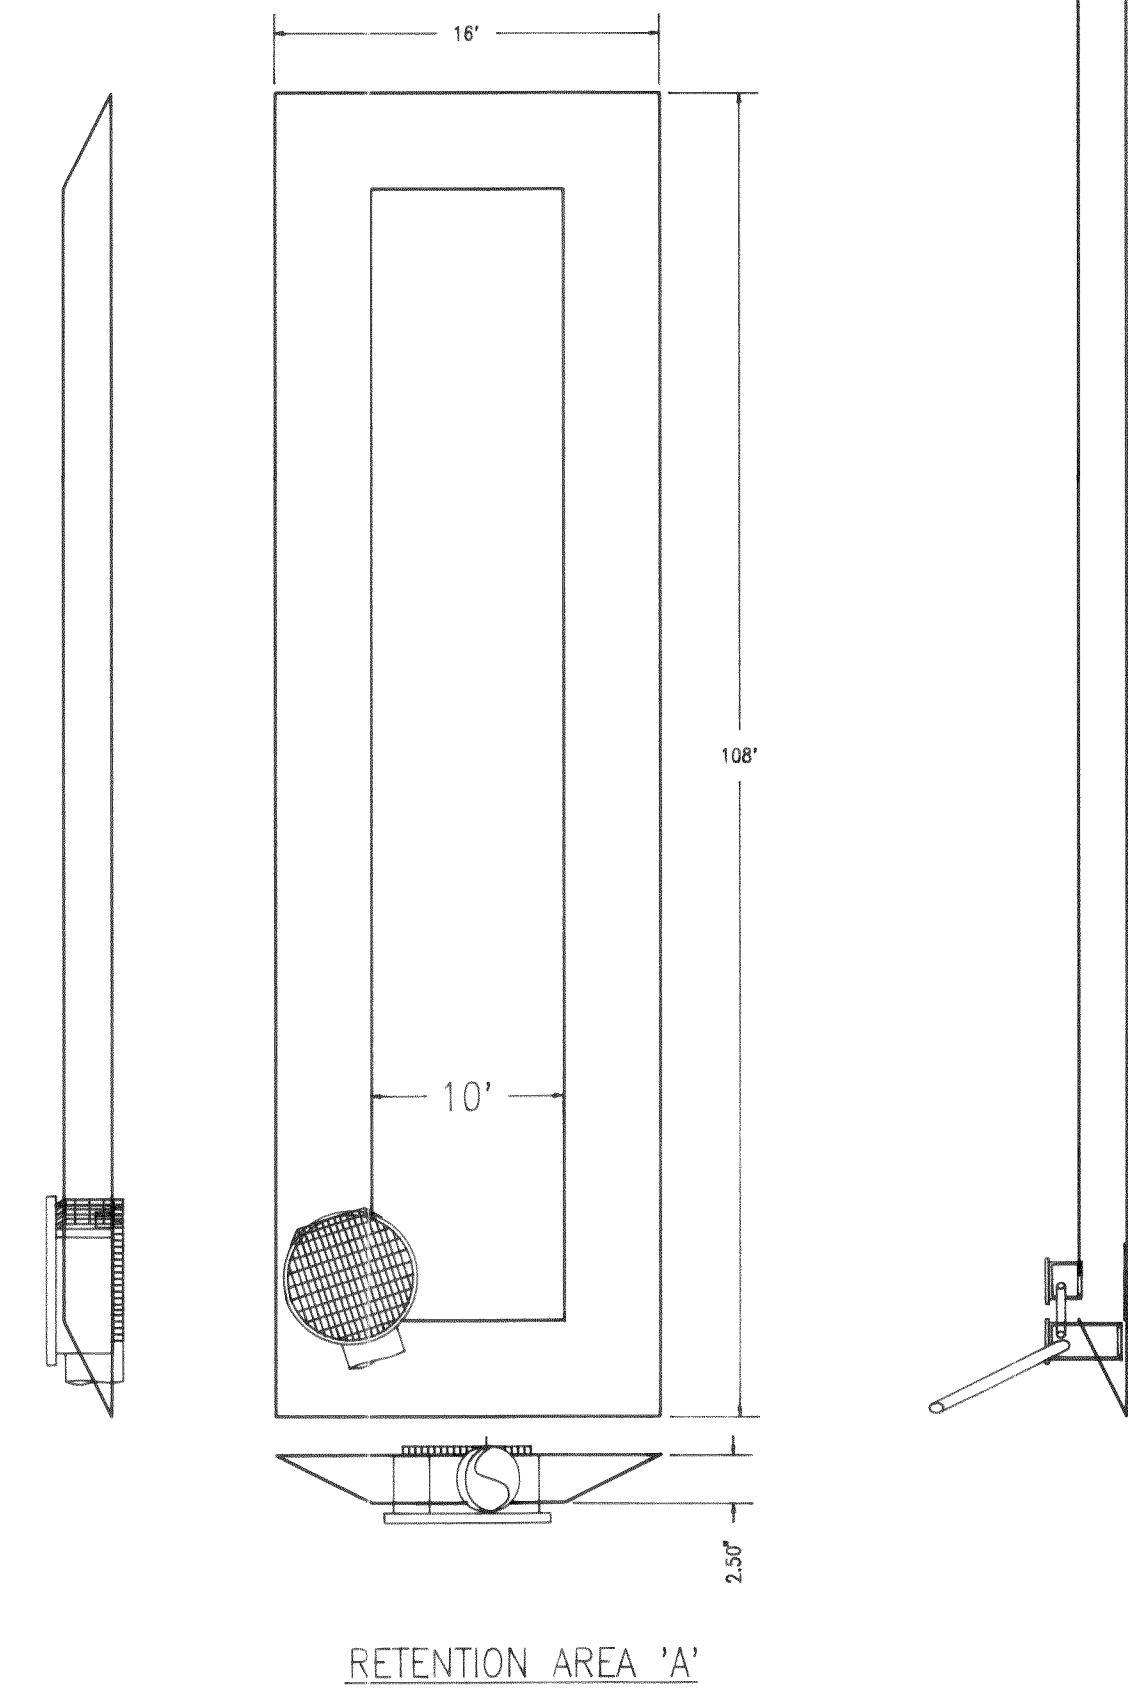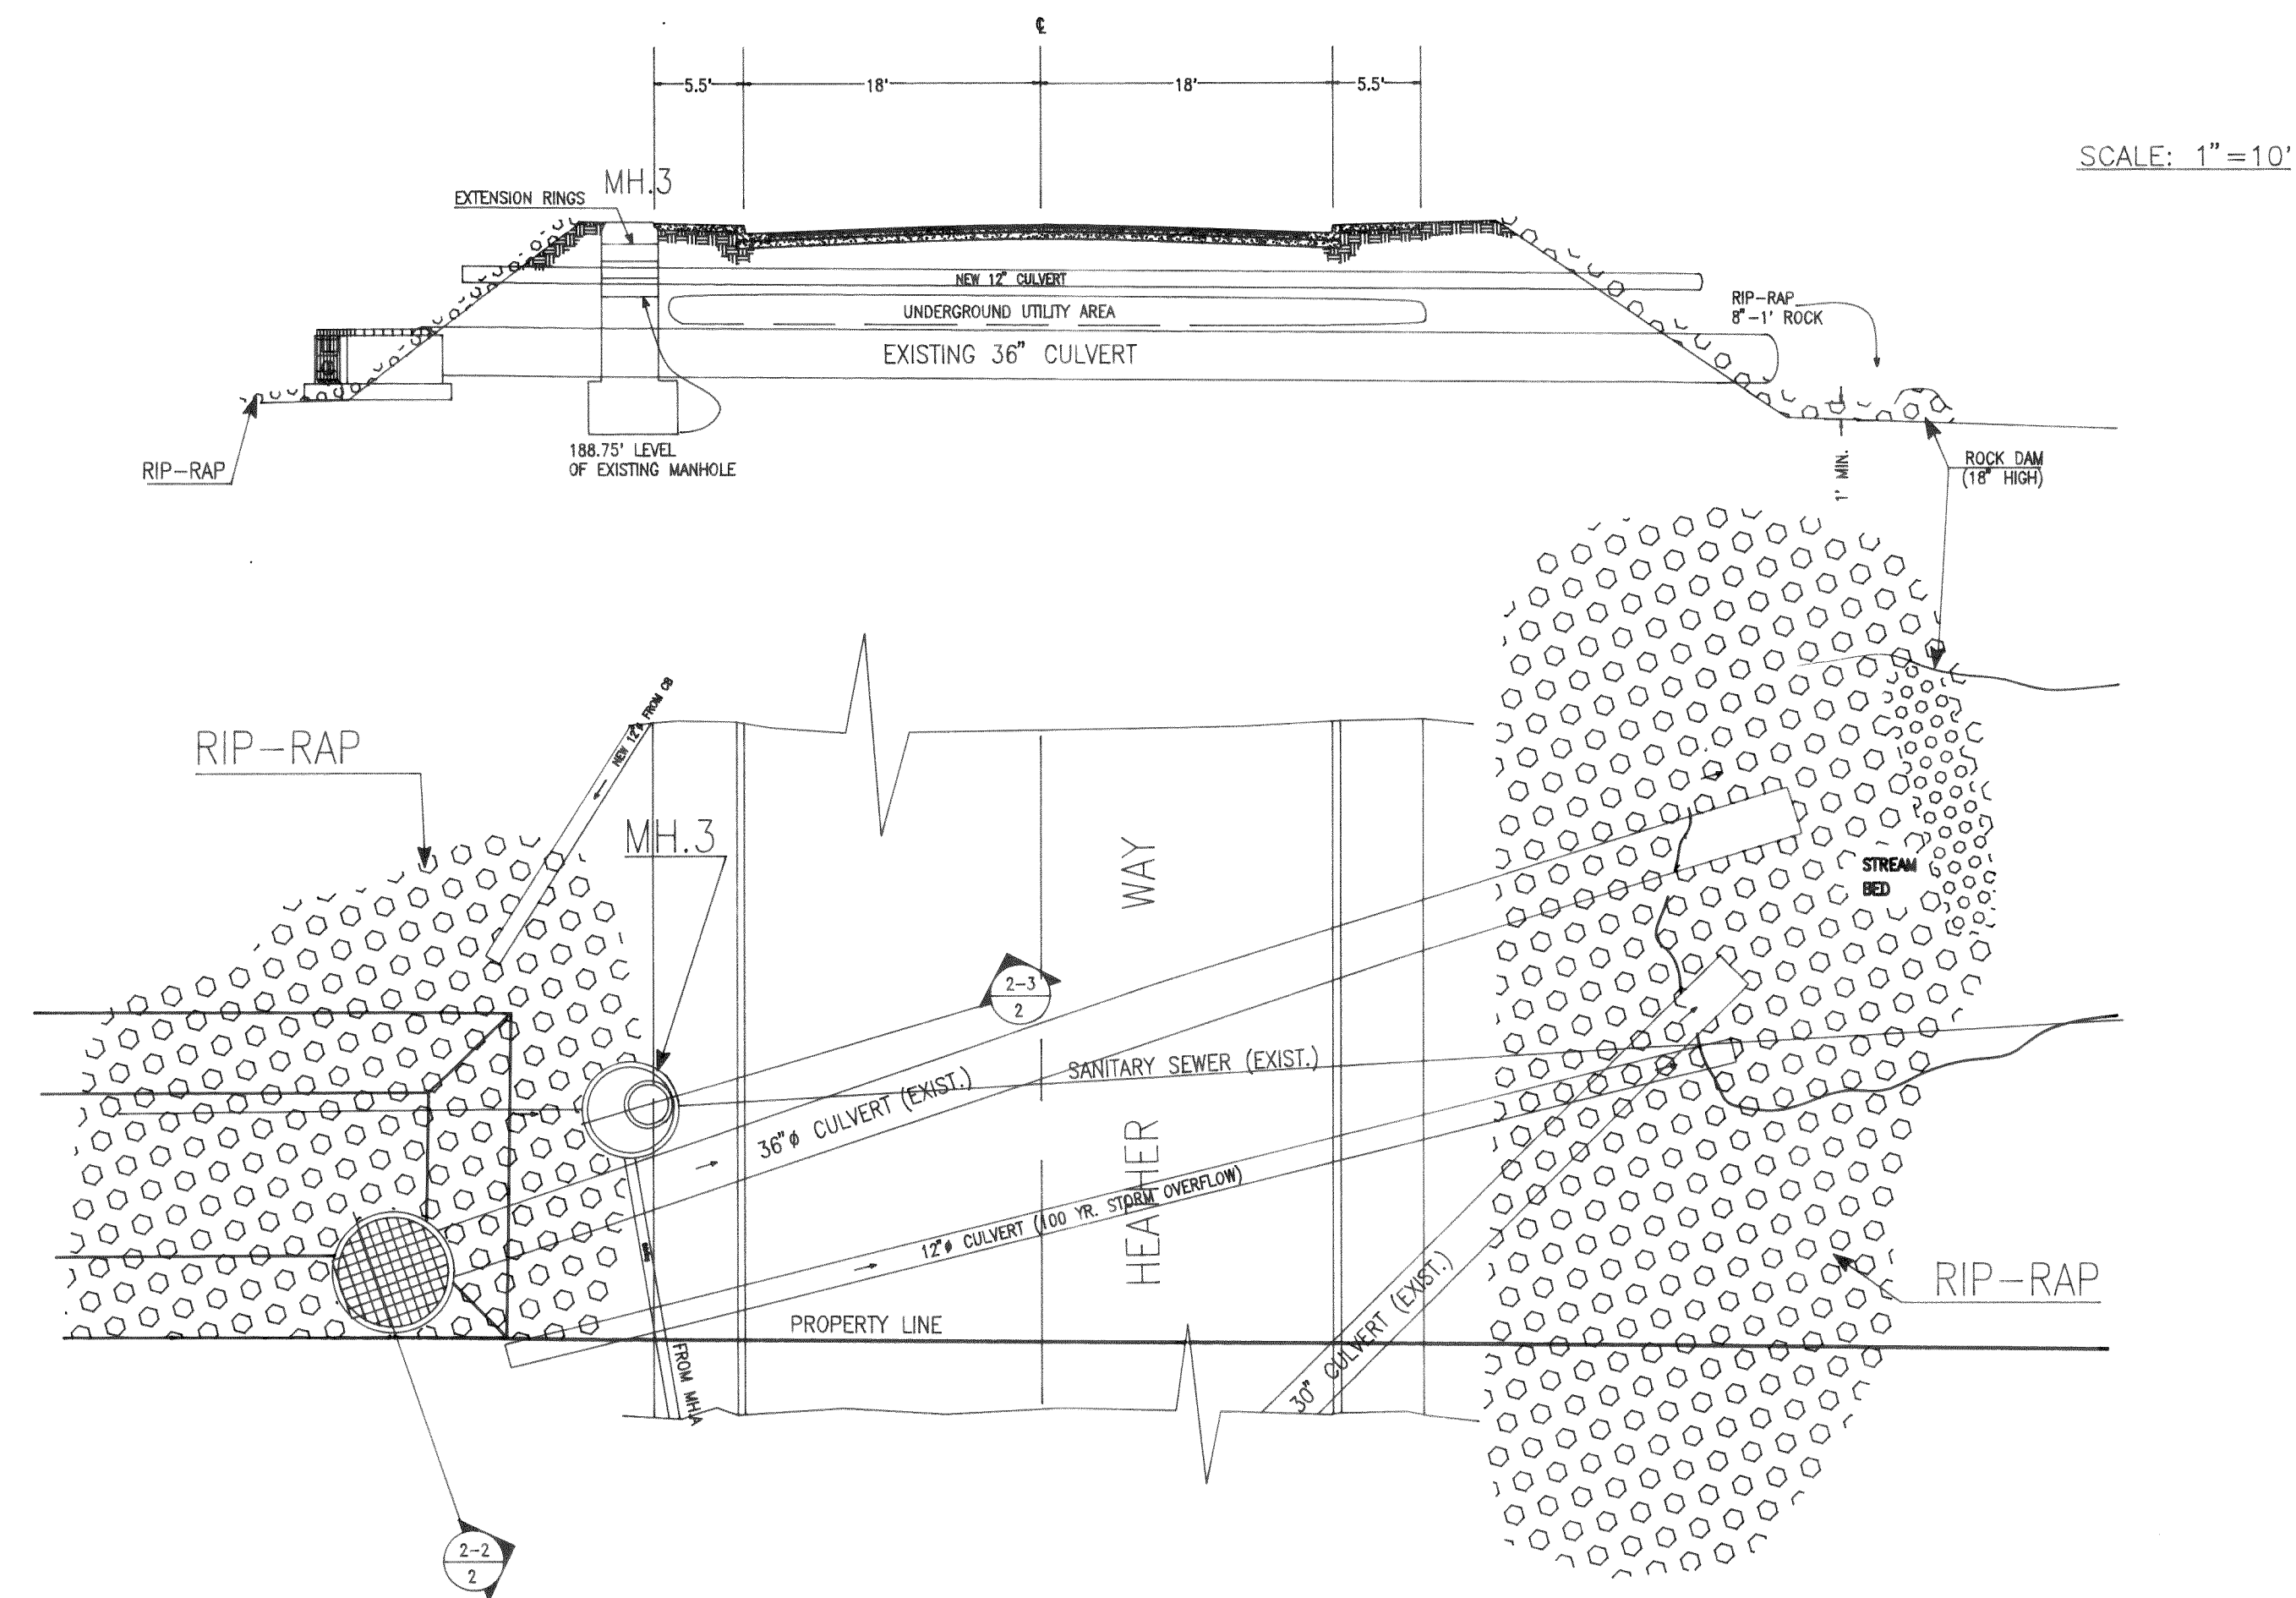

AS-BUILT


AMETRON
CONSULTING GROUP, INC.

6951 Hannegan Rd. Suite 14
Lynden, Washington 98264 206-354-7617

DRAWN: D. A. TILTON

CHECKED: _____

FILE: 3E20SEC1.DWG

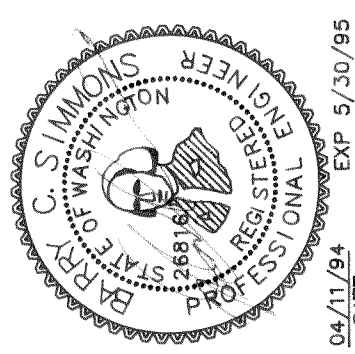

CONSTRUCTION DRAWINGS
EMERALD TERRACE
FERNDALE, WASHINGTON

REVISIONS	
NO.	DATE DESCRIPTION
1	8-21-91 MH. CHNG.
2	8-30-91 INLET CHNG
3	10-16-91 POND A C
4	4-11-94 AS-BUILT

PROJECT NO. DATE
3E20A 8-21-91

SHEET TITLE

CULVERT SYSTEM

SHEET NO.
3 OF 3