


- LEGEND**
- - FND BR CAP SURFACE MONUMENT
  - - FND REBAR AND PLAST. CAP (ROCKEY)
  - - SET REBAR AND CAP PLS#24218
  - - SET SCRIBED "X" IN CONC. SIDEWALK
  - ▲ - SET SPIKE FOR WORK POINT
  - x100.0 - SPOT ELEVATION
  - - INDICATES DRAINAGE

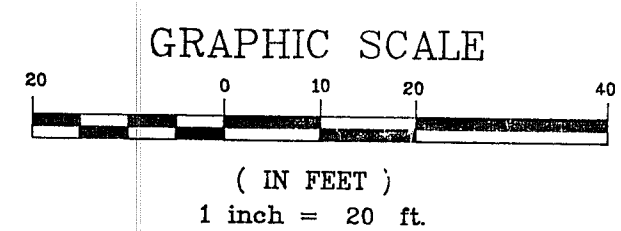

**NOTES**

- 1) THIS MAP DOES NOT REPRESENT A BOUNDARY SURVEY NOR ANY INTENTION TO SHOW OTHERWISE.
- 2) CONTOUR INTERVAL: CONTOURS ARE 1 FOOT INTERVALS AND ARE COMPUTER GENERATED FROM FIELD DATA GATHERED FOR THIS SURVEY UTILIZING ELECTRONIC DATA COLLECTION.
- 3) VERTICAL DATUM: TOP OF BRASS CAP SURFACE MON. (POINT #10) IN CENTERLINE OF HEATHER WAY AT WEST LINE OF SUNSHINE HEIGHTS DIV. #2 AS SHOWN. ELEVATION IS ASSUMED 100.00'.
- 4) BENCH MARKS ARE AS SHOWN.
- 5) PACIFIC SURVEYING AND ENGINEERING, INC. ASSUMES NO LIABILITY FOR ANY SUBSURFACE CONDITIONS OR FEATURES THAT ARE UNDETECTABLE AND/OR NOT VISIBLE OR ARE NOT IN THE SCOPE OF WORK.

# TOPOGRAPHY MAP

OF LOTS 17 & 18, SUNSHINE HEIGHTS DIVISION #2  
 SITUATE IN A PORTION OF THE NORTHWEST 1/4 OF SECTION 19, TOWNSHIP 39 NORTH,  
 RANGE 2 EAST OF W.M., WHATCOM COUNTY, WASHINGTON

*[Signature]*  
 #26327  
 7/29/91

**SUNSHINE HEIGHTS DIV. #2**  
**LOTS 17 & 18**

**PACIFIC**  
 SURVEYING & ENGINEERING  
 INCORPORATED  
 215 WEST HOLLY, SUITE B-25 (BAY ST.)  
 BELLINGHAM, WASHINGTON 98225  
 PHONE: 671-7387  
 FAX LINE: 671-4685

DRAWN BY: AMM	DATE: 11/27/90
CHECKED BY: KTH	JOB NO.: 90123
FIELD BOOK NO.:	DWG. #: 90123TC.DWG
26	PAGE: 1 OF 1