



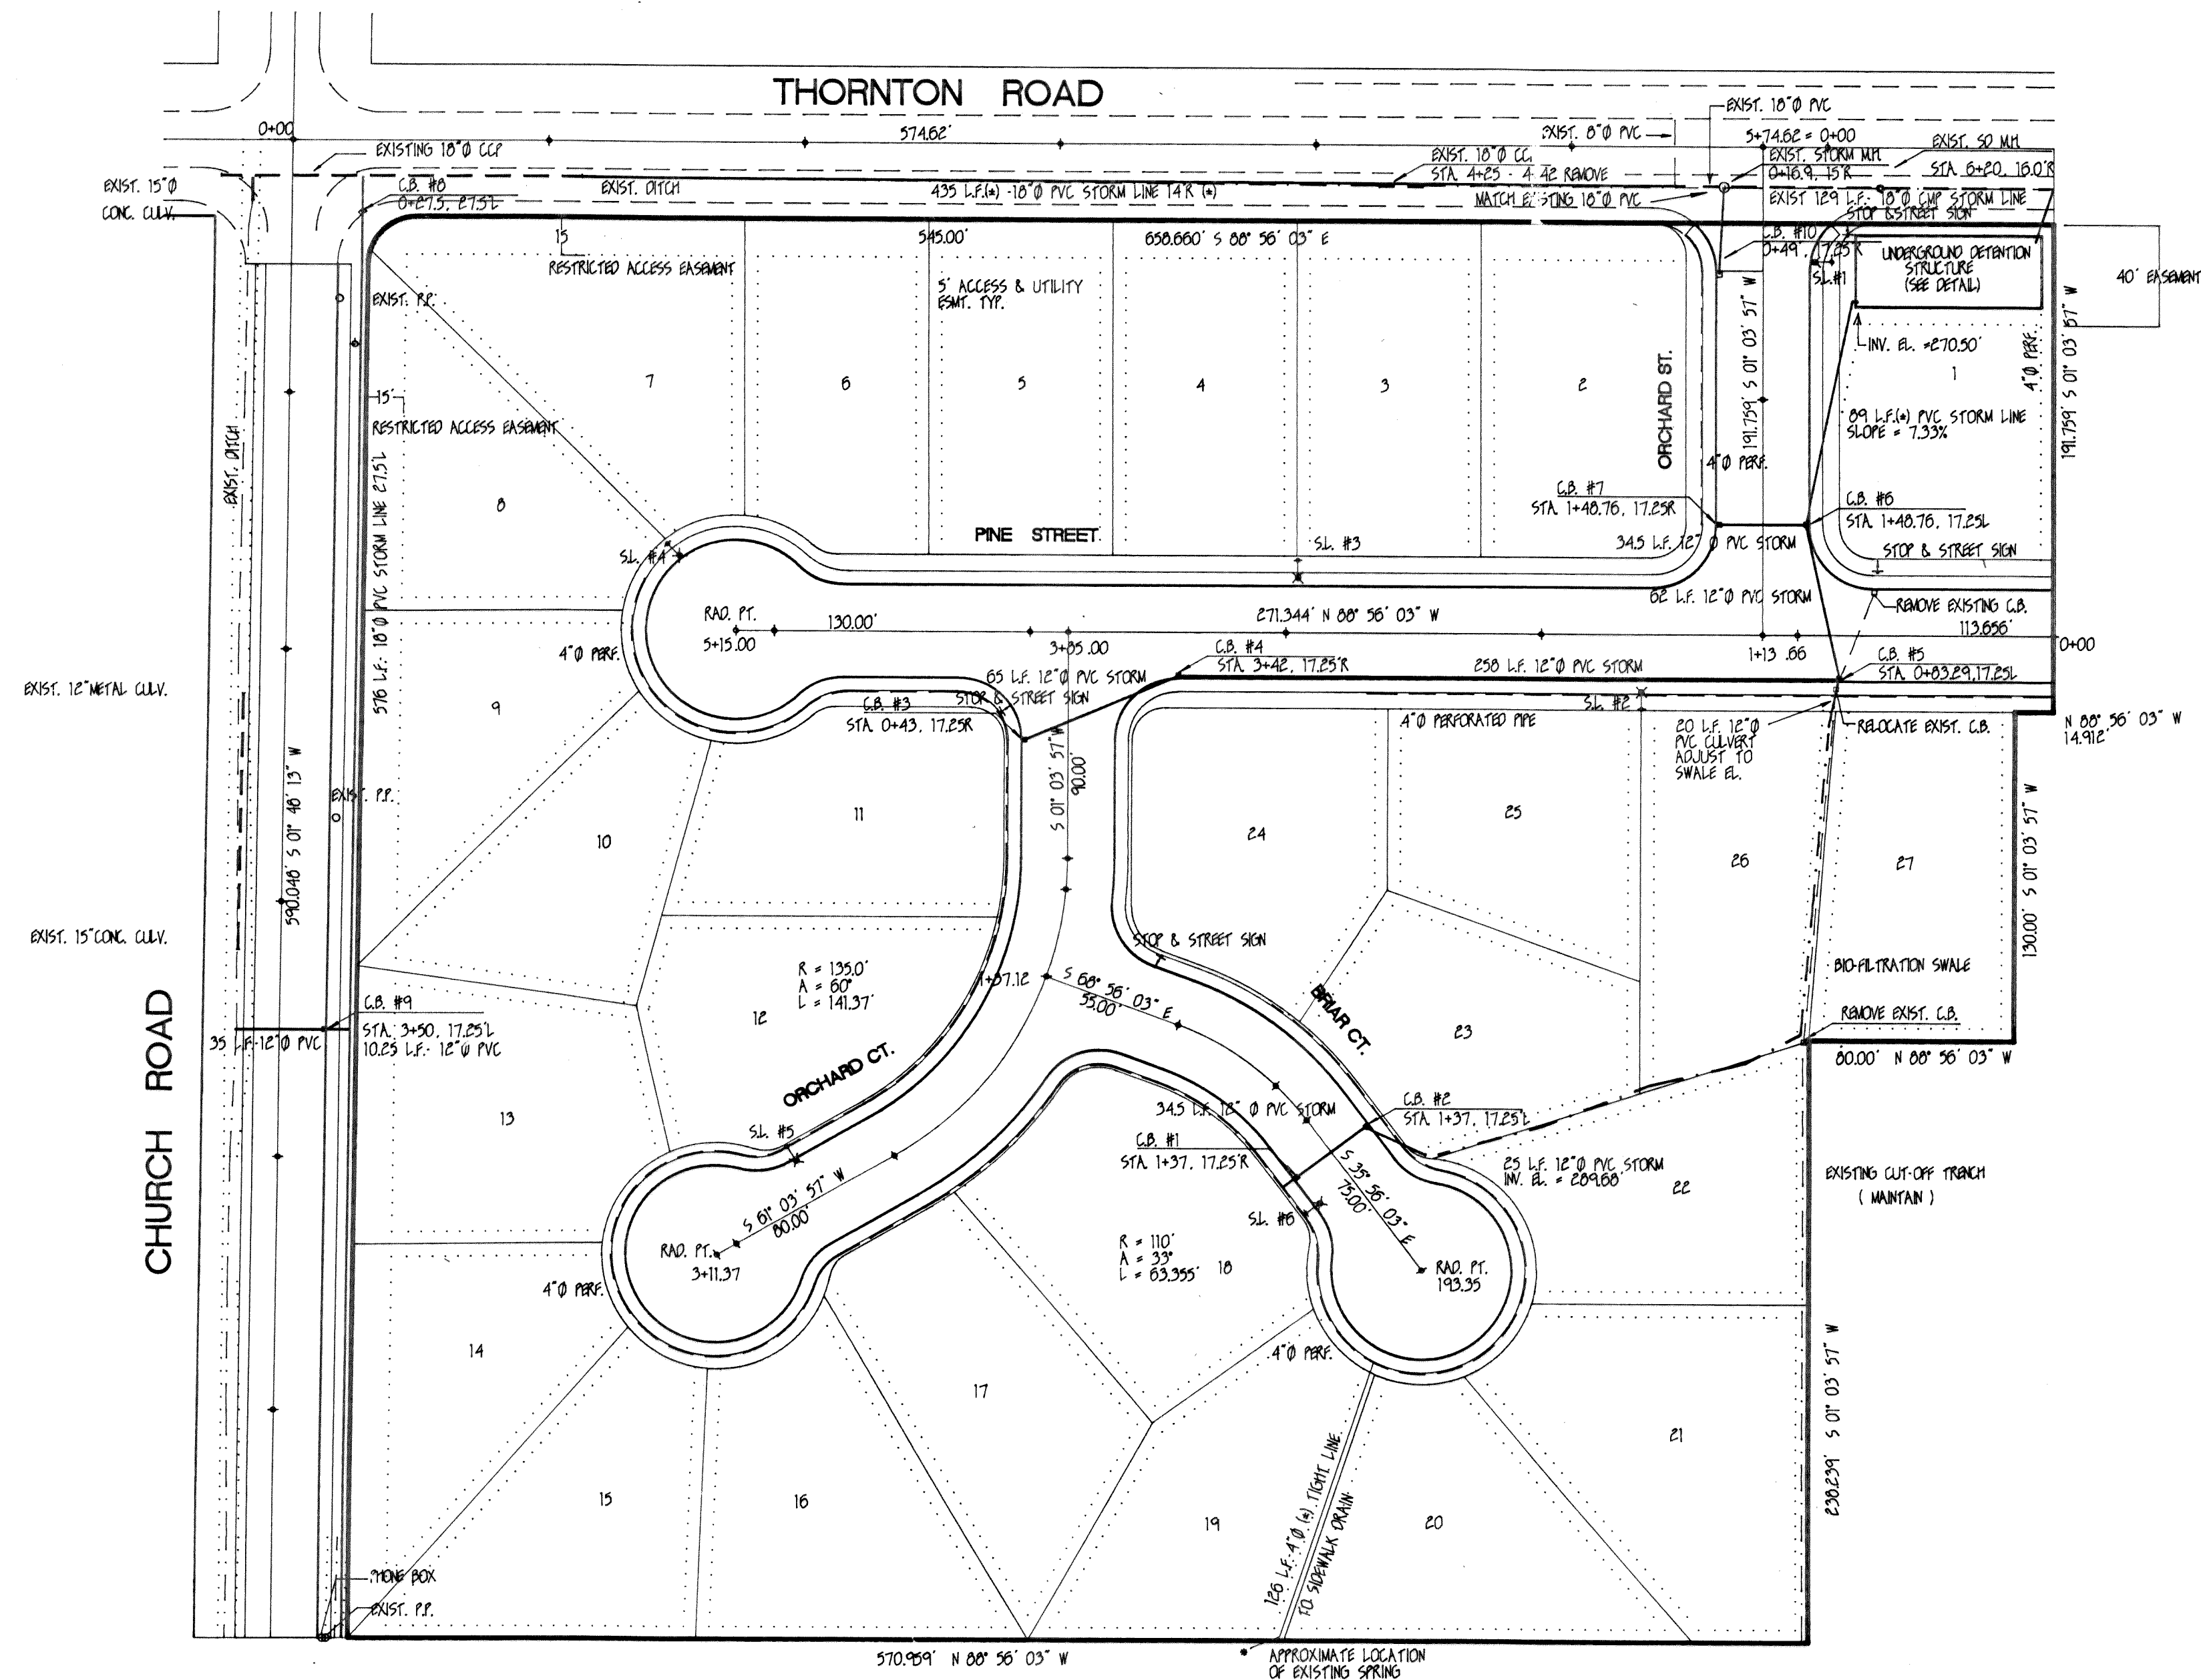

ROAD AND STORM - PLAN VIEW

SCALE = 1" = 50.0'

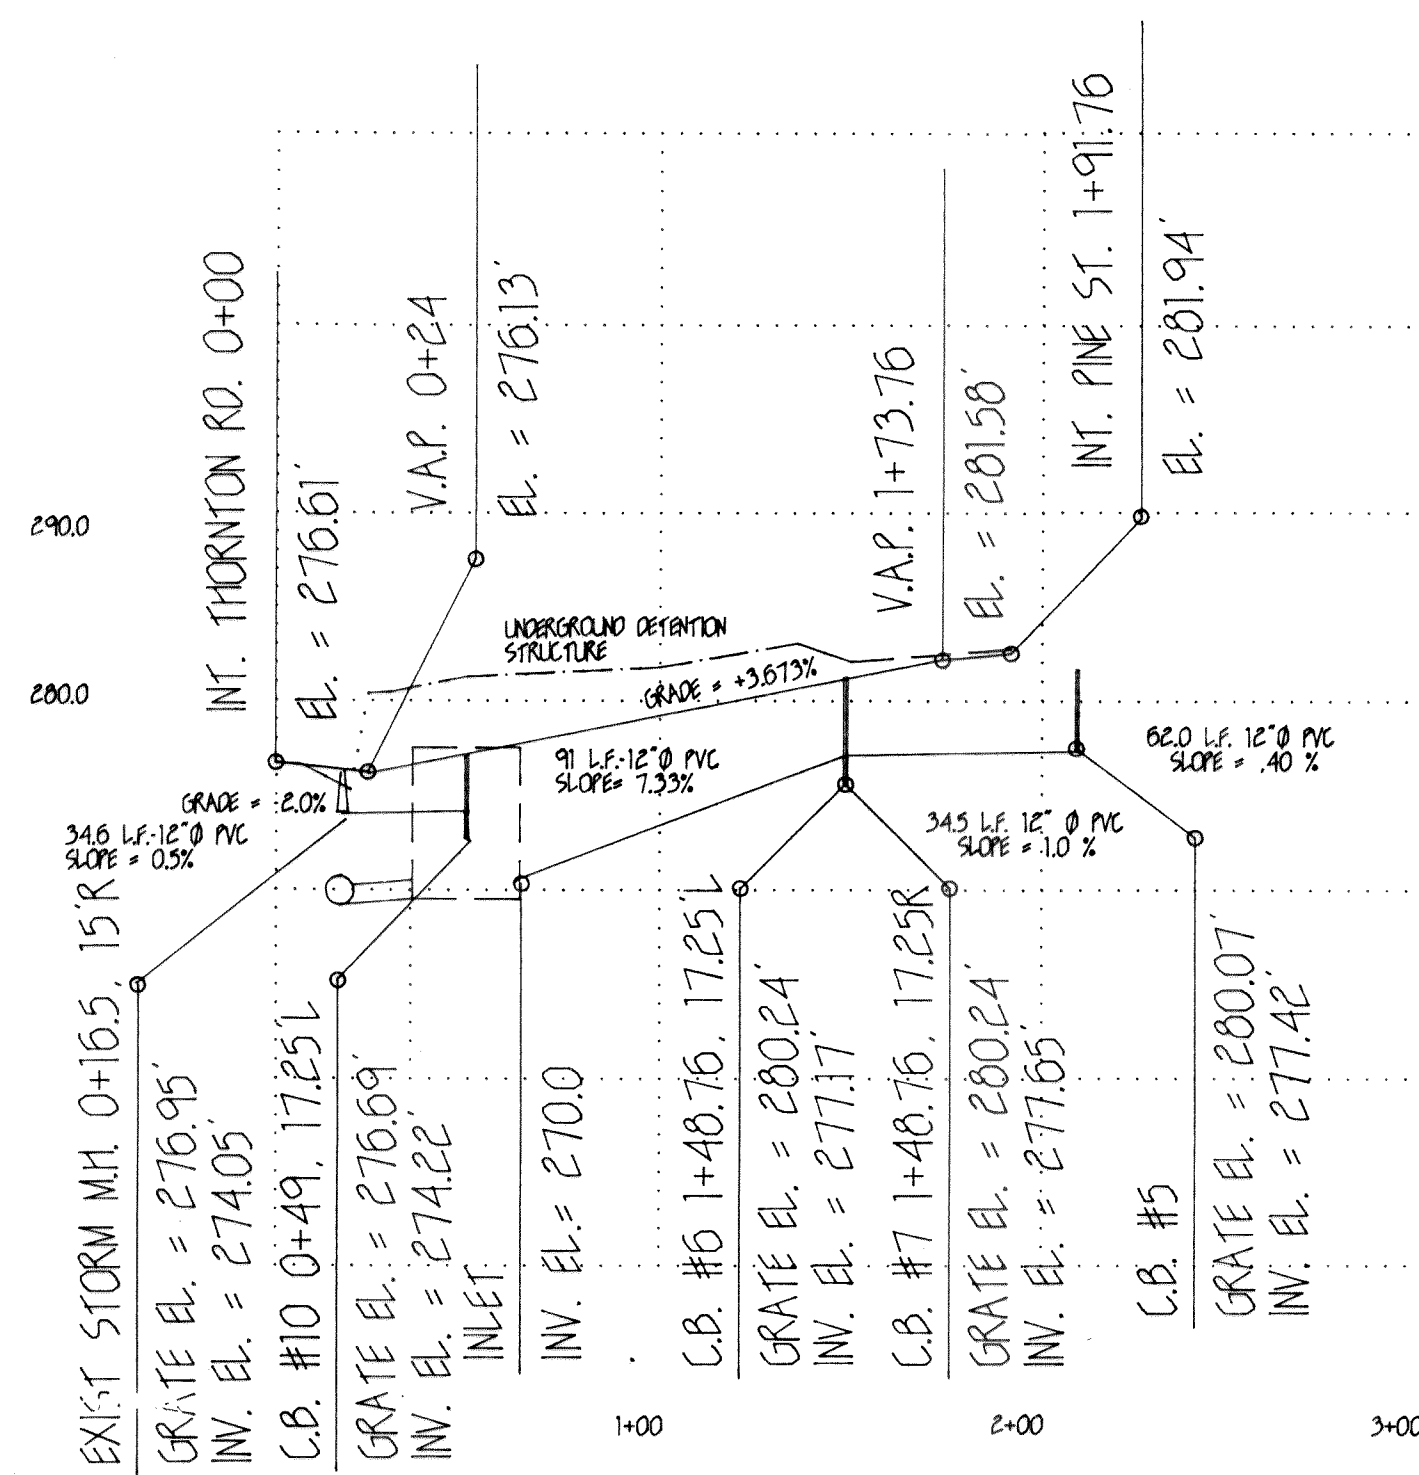


ROAD + STORM PROFILE - ORCHARD ST.

SCALE = 1" = 50.0' HORIZ.
1" = 10.0' VERT.


AS - BUILT DRAWING

BY: Craig Dubble
DATE: 6/28/91

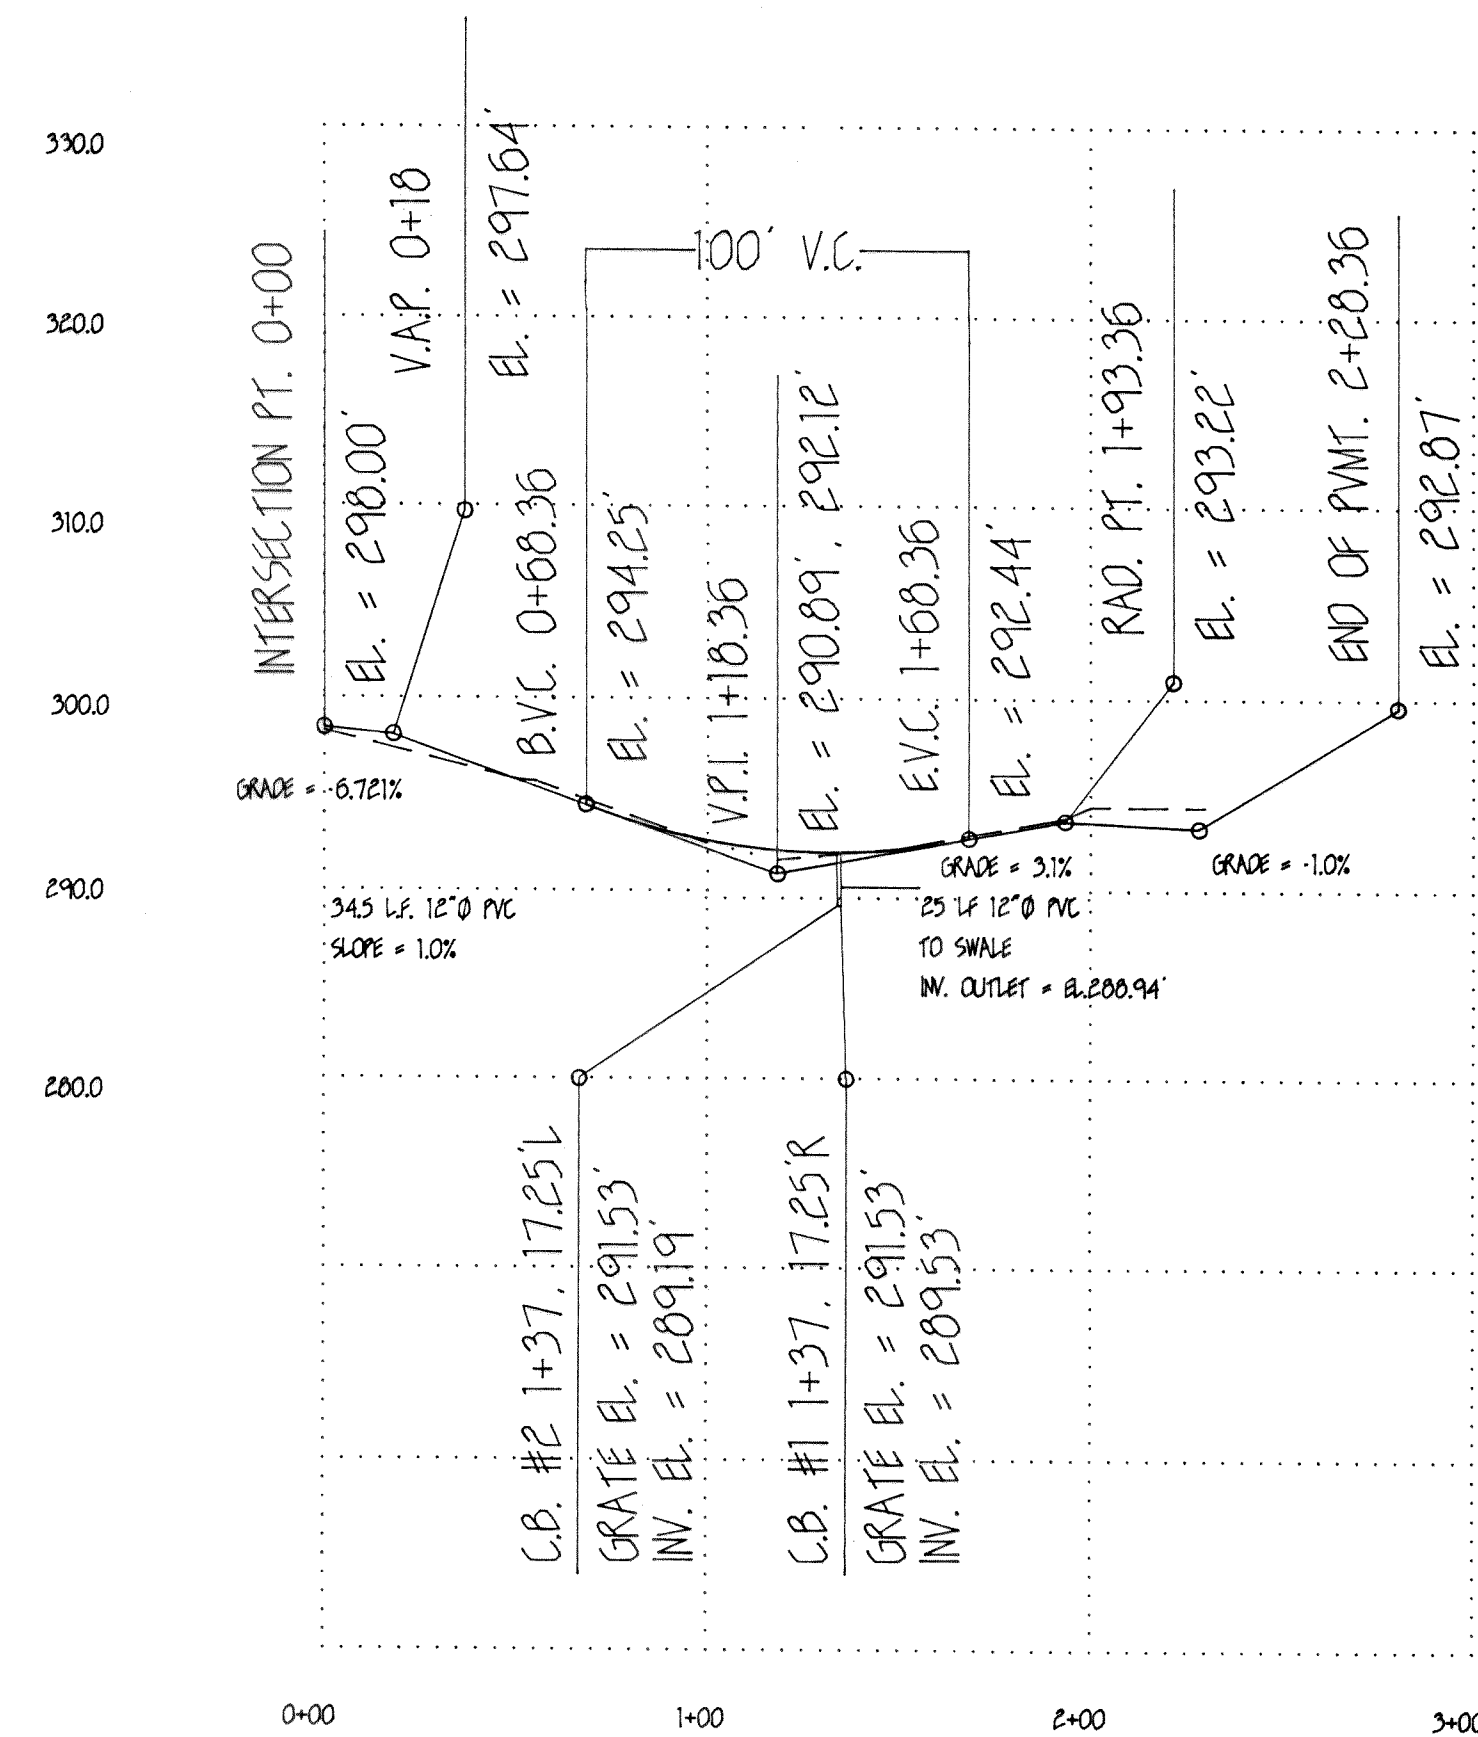

ROAD + STORM PROFILE - BRIAR CT.

SCALE = 1" = 50.0' HORIZ.
1" = 10.0' VERT.

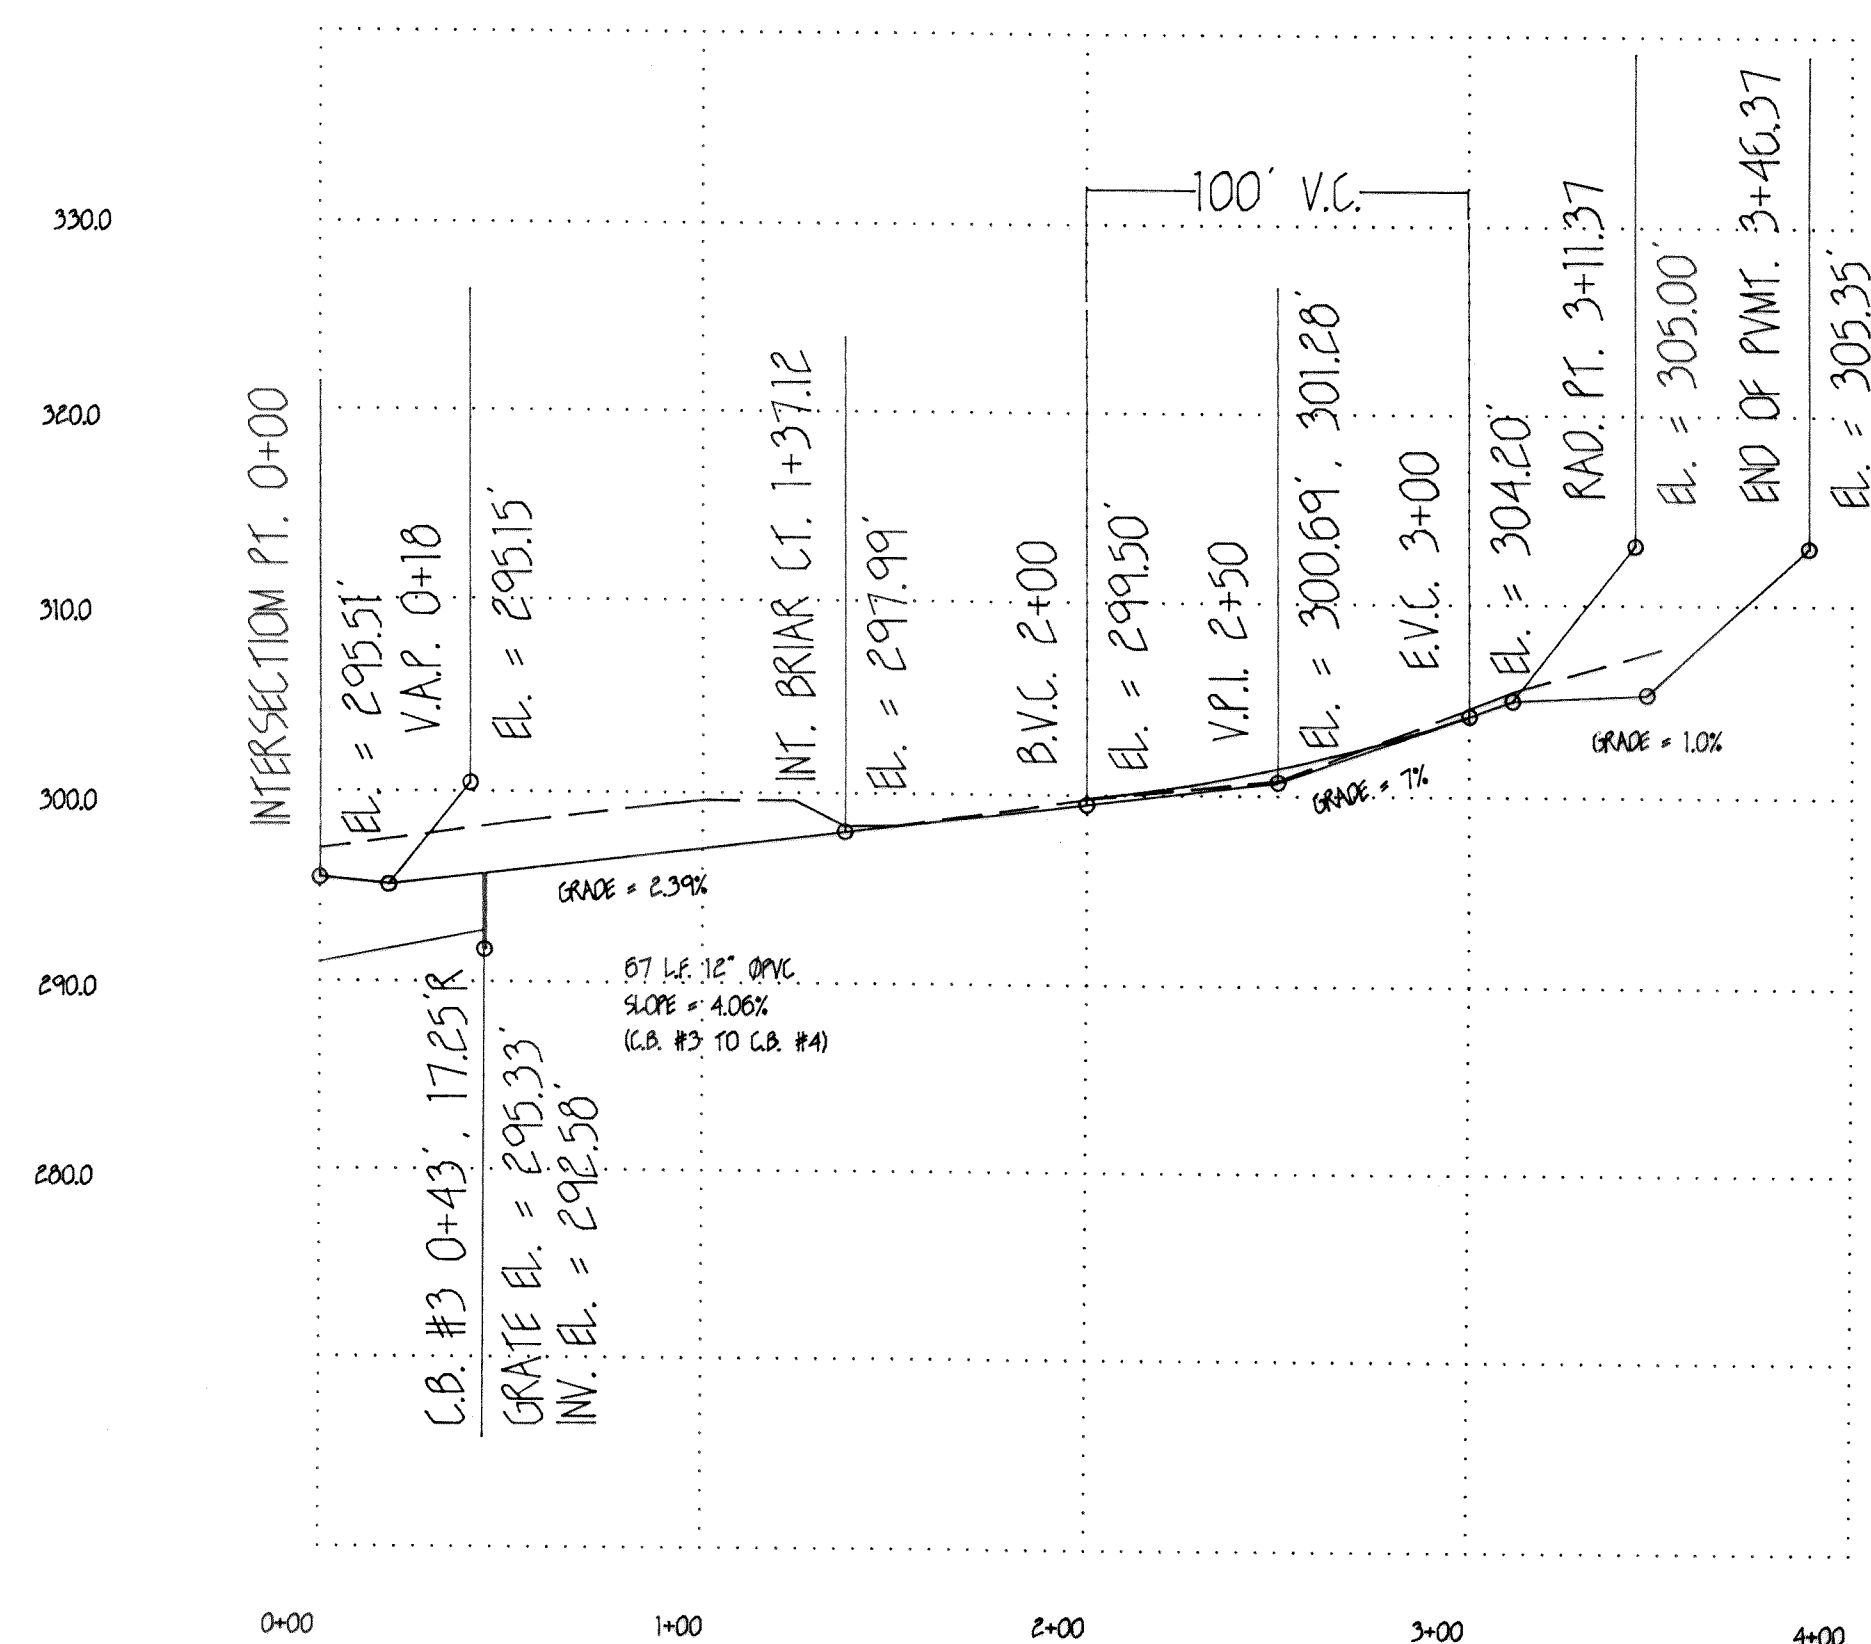


ROAD + STORM PROFILE - ORCHARD COURT


SCALE = 1" = 50.0' HORIZ.
1" = 10.0' VERT.

MARVEL CONSTRUCTION		
SCALE: 1"=50'	APPROVED BY:	DRAWN BY: T.P.D.
DATE: 8/10/90		REVISED:
ORCHARD CREST PLAT		
ROAD AND STORM		DRAWING NUMBER 43089-1

00189.001 8.14.00 K2

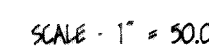

SCALE = 1" = 50.0'

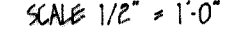

43089-2