

SECOND STREET
CITY OF FERNDALE
SEWER IMPROVEMENTS


LEGEND

	= EXIST GUY WIRE
	= EXIST POWER METER
	= EXIST SIGN
	= EXIST PHONE BOOTH
	= EXIST SIGNAL VAULT
	= EXIST TRAFFIC SIGNAL
	= EXIST STREET LIGHT
	= EXIST FIRE HYDRANT
	= EXIST WATER MAIN
	= EXIST UTILITY POLE
	= EXIST SEWER LINE
	= EXIST STORM DRAIN
	= EXIST SEWER MANHOLE
	= EXIST CATCH BASIN
	= EXIST STORM DRAIN MANHOLE
	= EXIST GAS METER
	= EXIST WATER METER
	= EXIST WATER VALVE
	= PROPOSED SEWER MAIN
	= PROPOSED SEWER MANHOLE
	= PROPOSED SS CLEAN OUT


SHEET INDEX

1.)	COVER SHEET
2.)	SECOND STREET STA 2+00 TO 7+00
3.)	SECOND STREET STA 7+00 TO 8+50
4.)	VISTA DRIVE STA 8+50 TO 11+90
5.)	DETAIL SHEET

VICINITY MAP

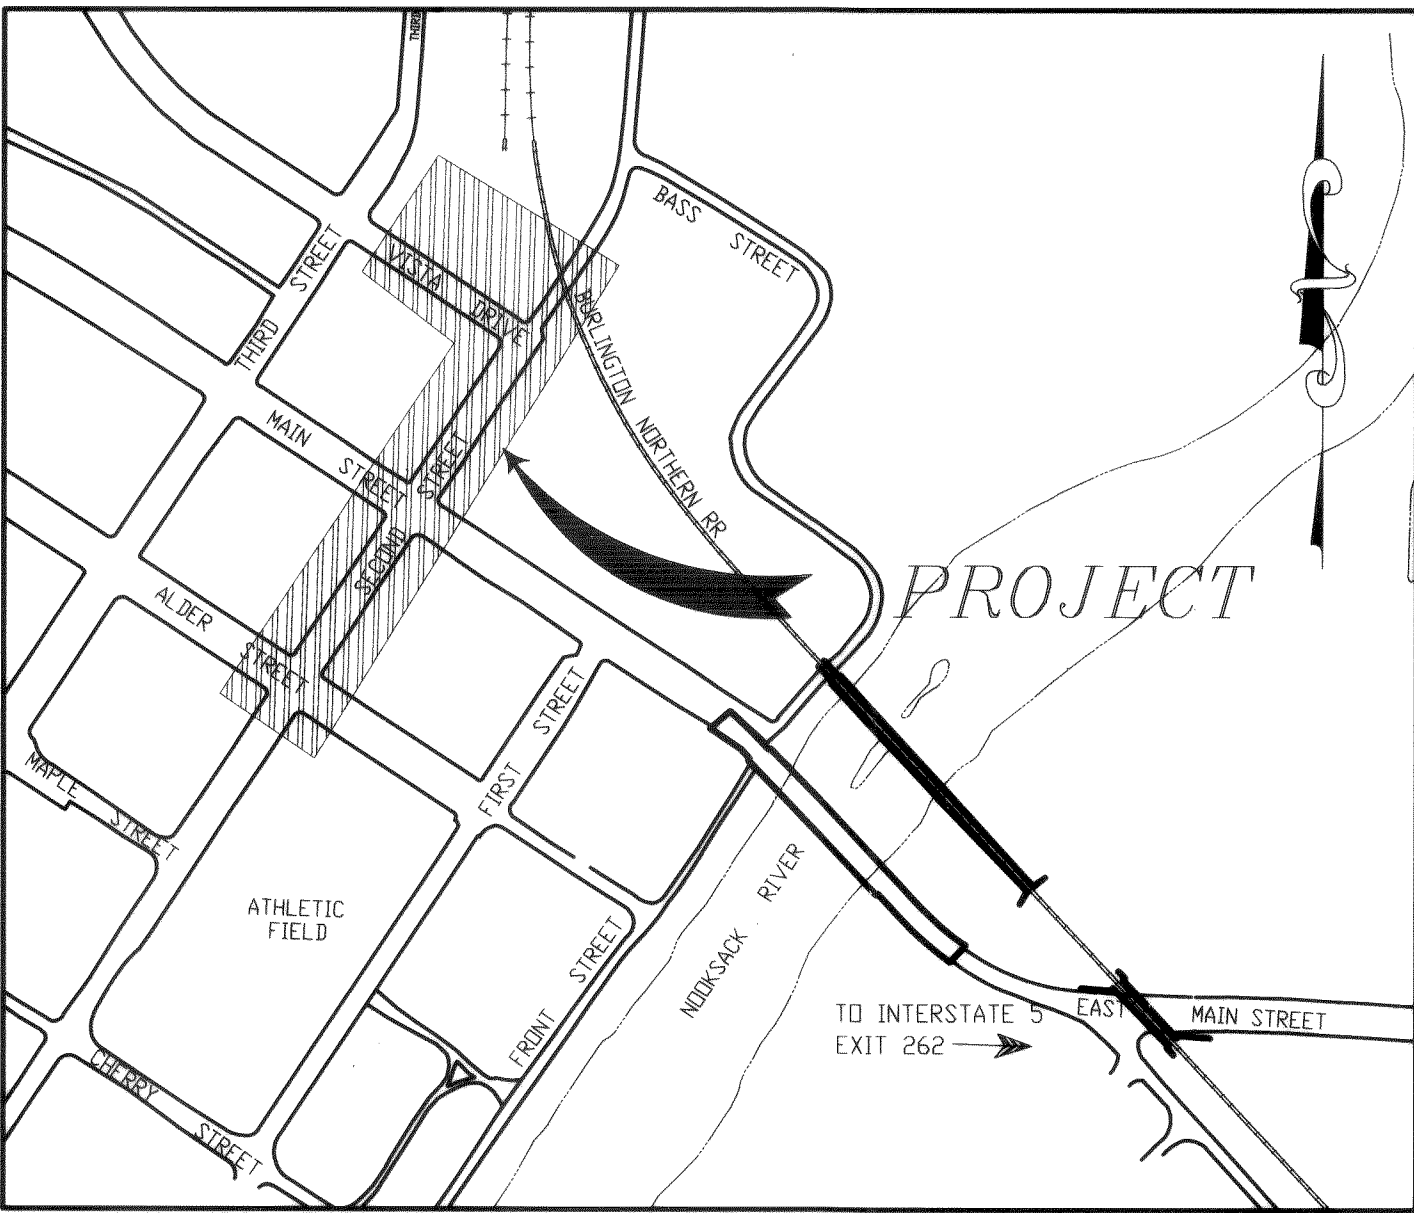


DATE: 2-5-01
AS-BUILT

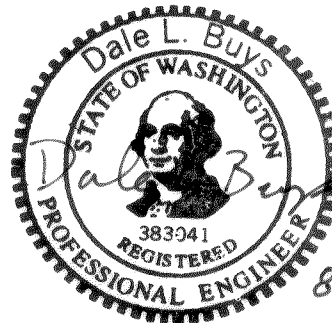





	DESIGNED BY GDE	 REICHHARDT & EBE <i>ENGINEERING, INC.</i> CONSULTING ENGINEERS PO Box 978 423 Front St., Ste 201 Ph (360) 354-3687 Lynden, Washington 98264 Fax (360) 354-0407					CITY OF FERNDAL 2085 MAIN STREET FERNDAL, WASHINGTON 98248	SECOND STREET COVER SHEET FERNDAL, WASHINGTON	JOB# / DWG 00064 064TP2	DATE 8-29-00
	DRAWN BY LMC								SCALE H: N/A v: N/A	SHEET 1
	CHECKED BY GDE		NO.	DATE	REVISION	BY				

00214.002 2-16-06 KR

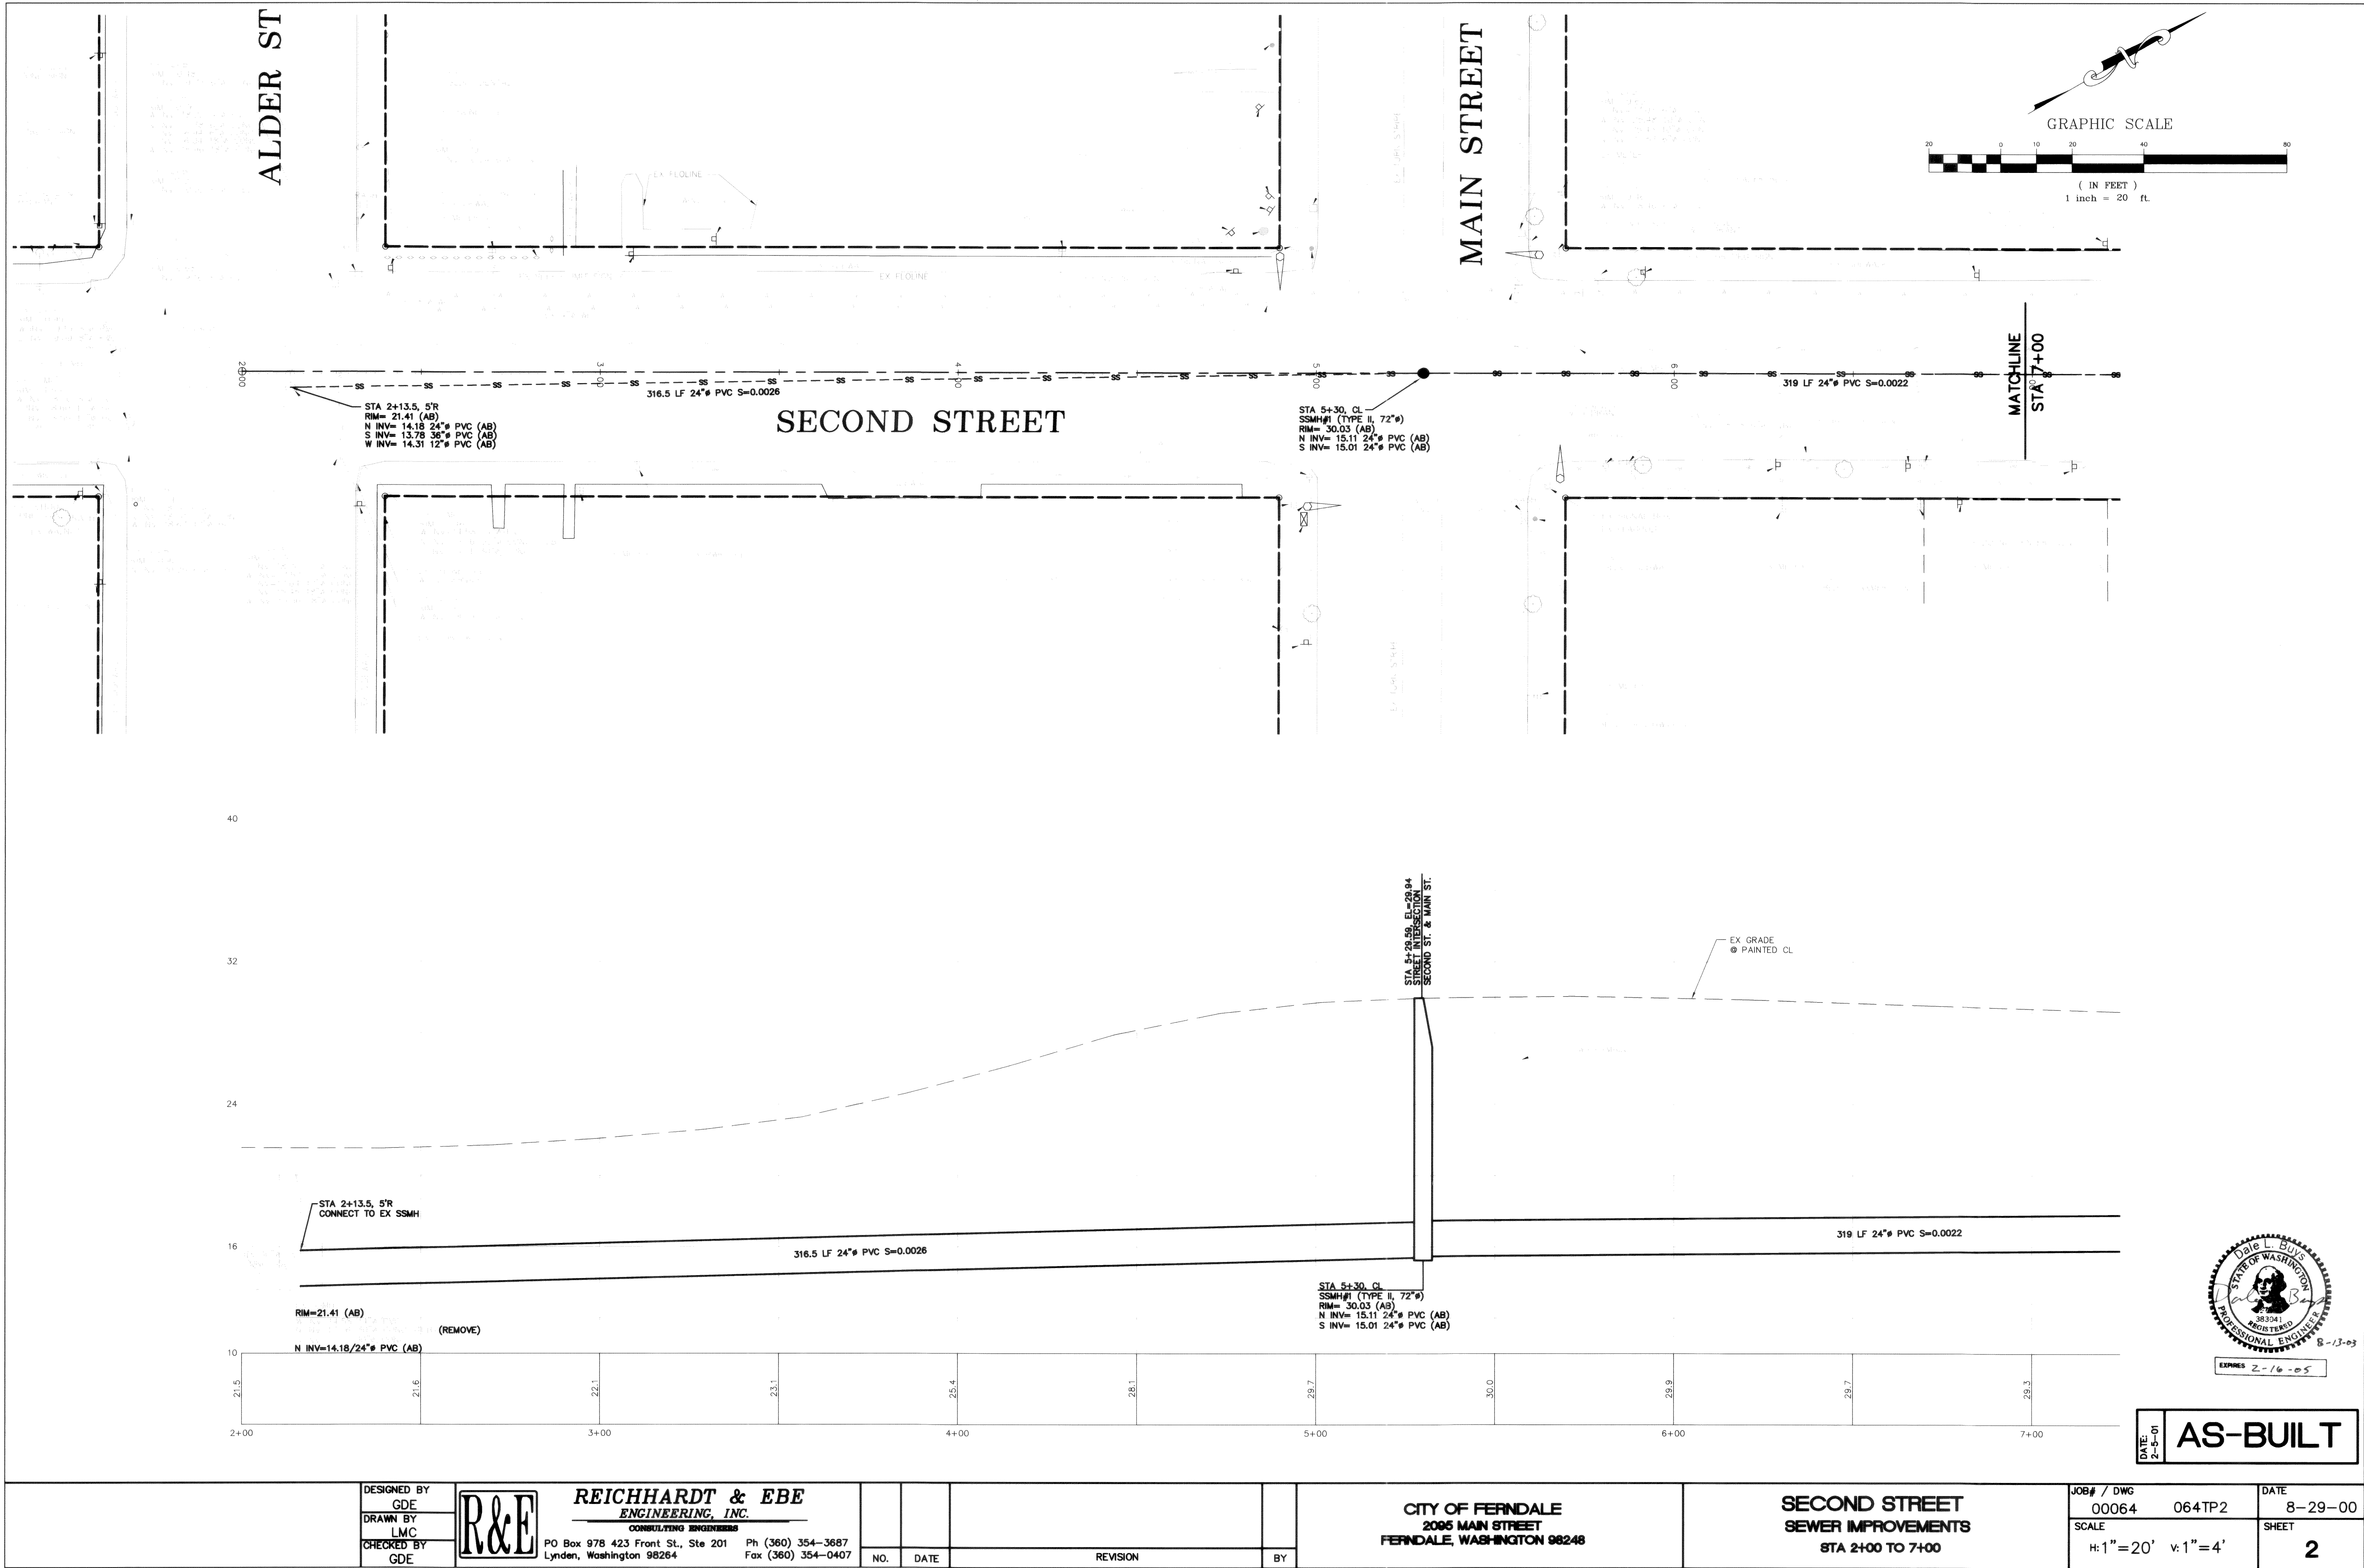

00064.DWG\GIS\064TP2_AB.dwg, 08/13/2003 01:17:58 PM, HP, DesignJet 500, 42"HPGL2 Card

00064DWG064TP2_AB.dwg, 08/13/2003 01:17:35 PM, HP Designer, 500.42+HPGL2 Card

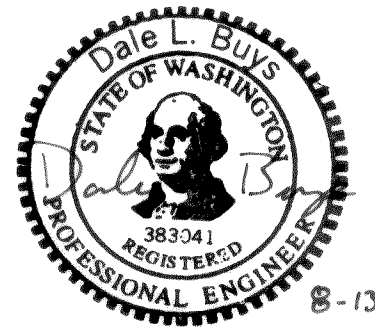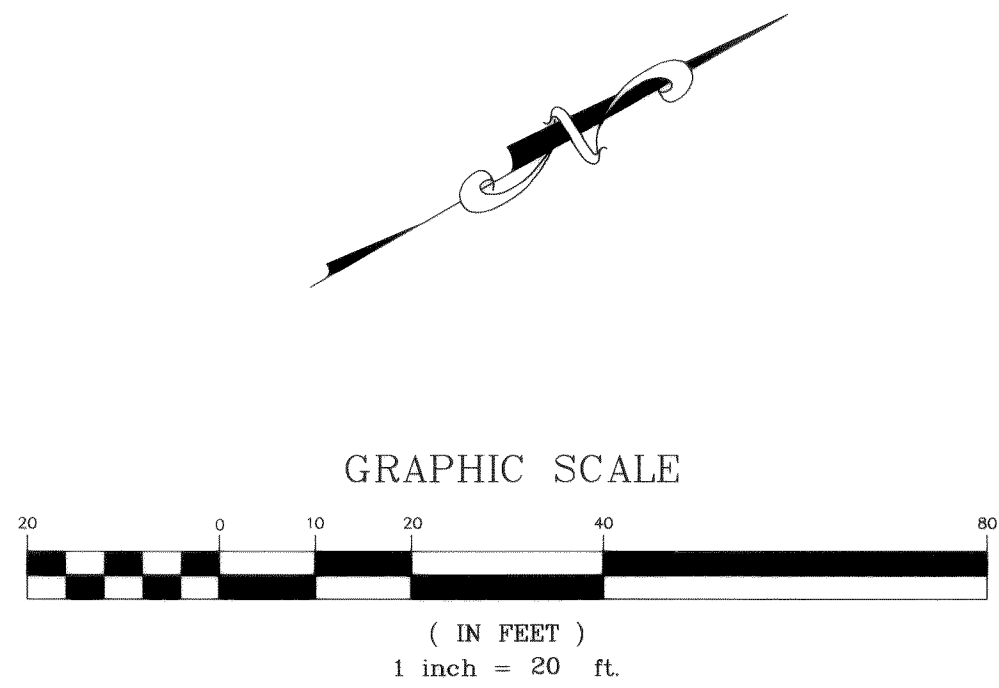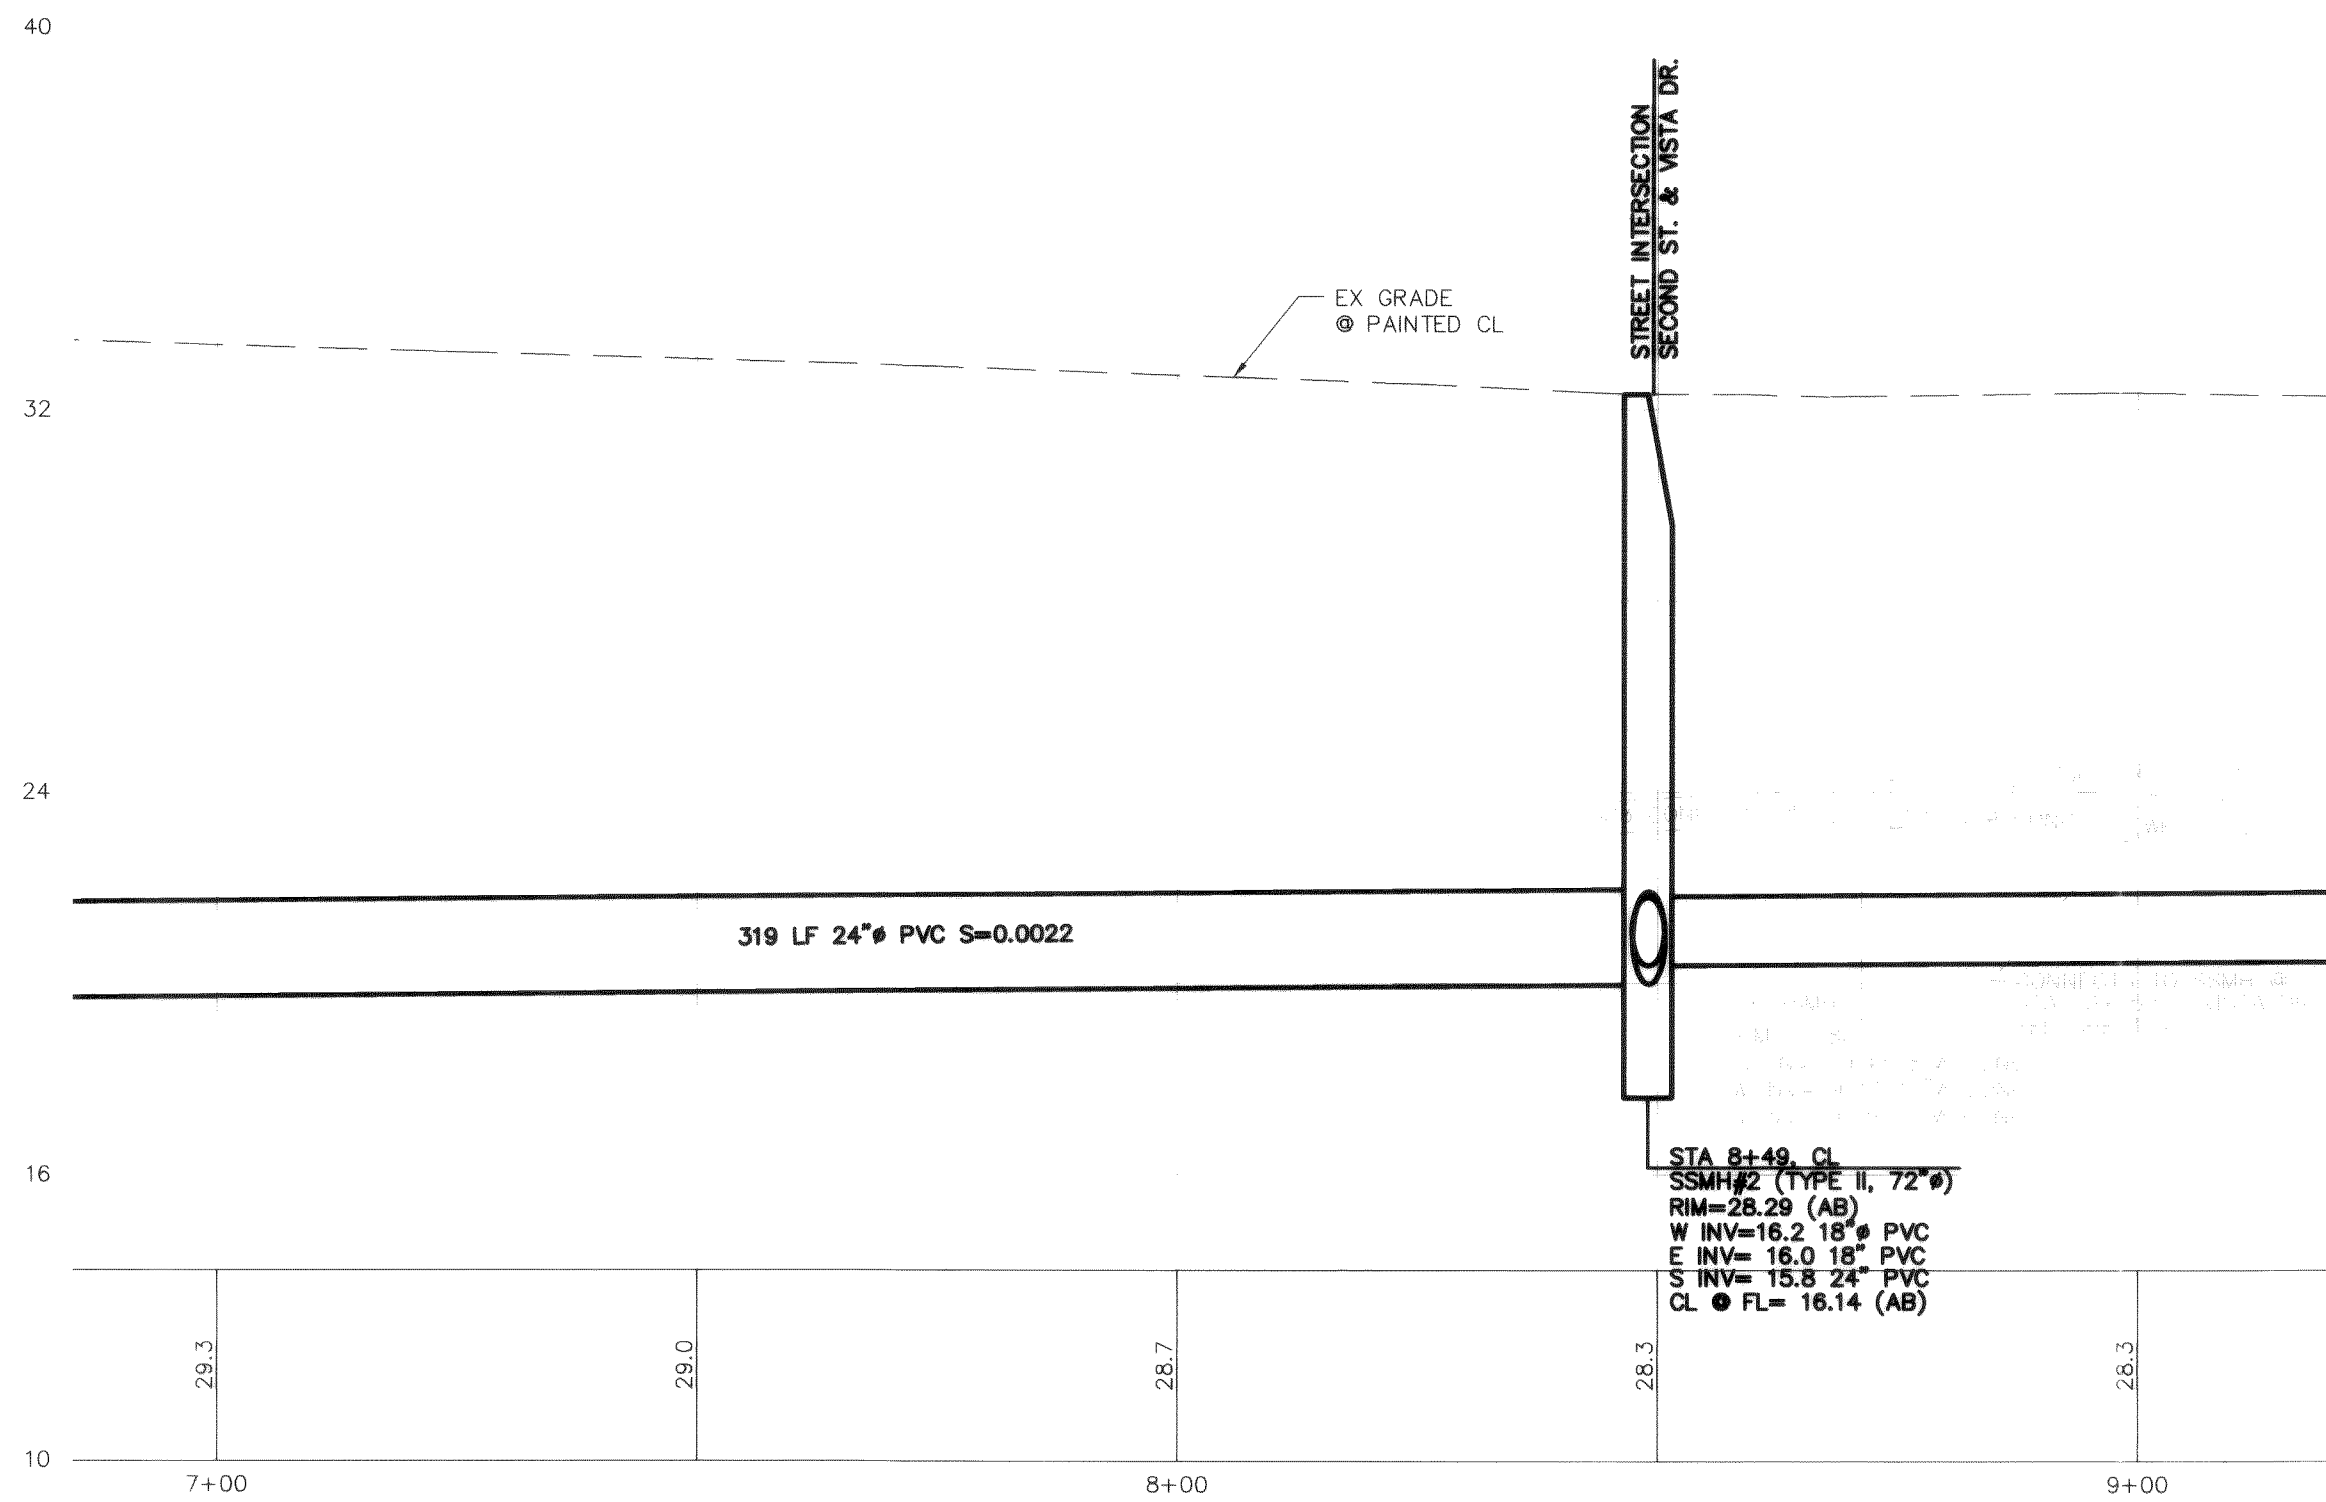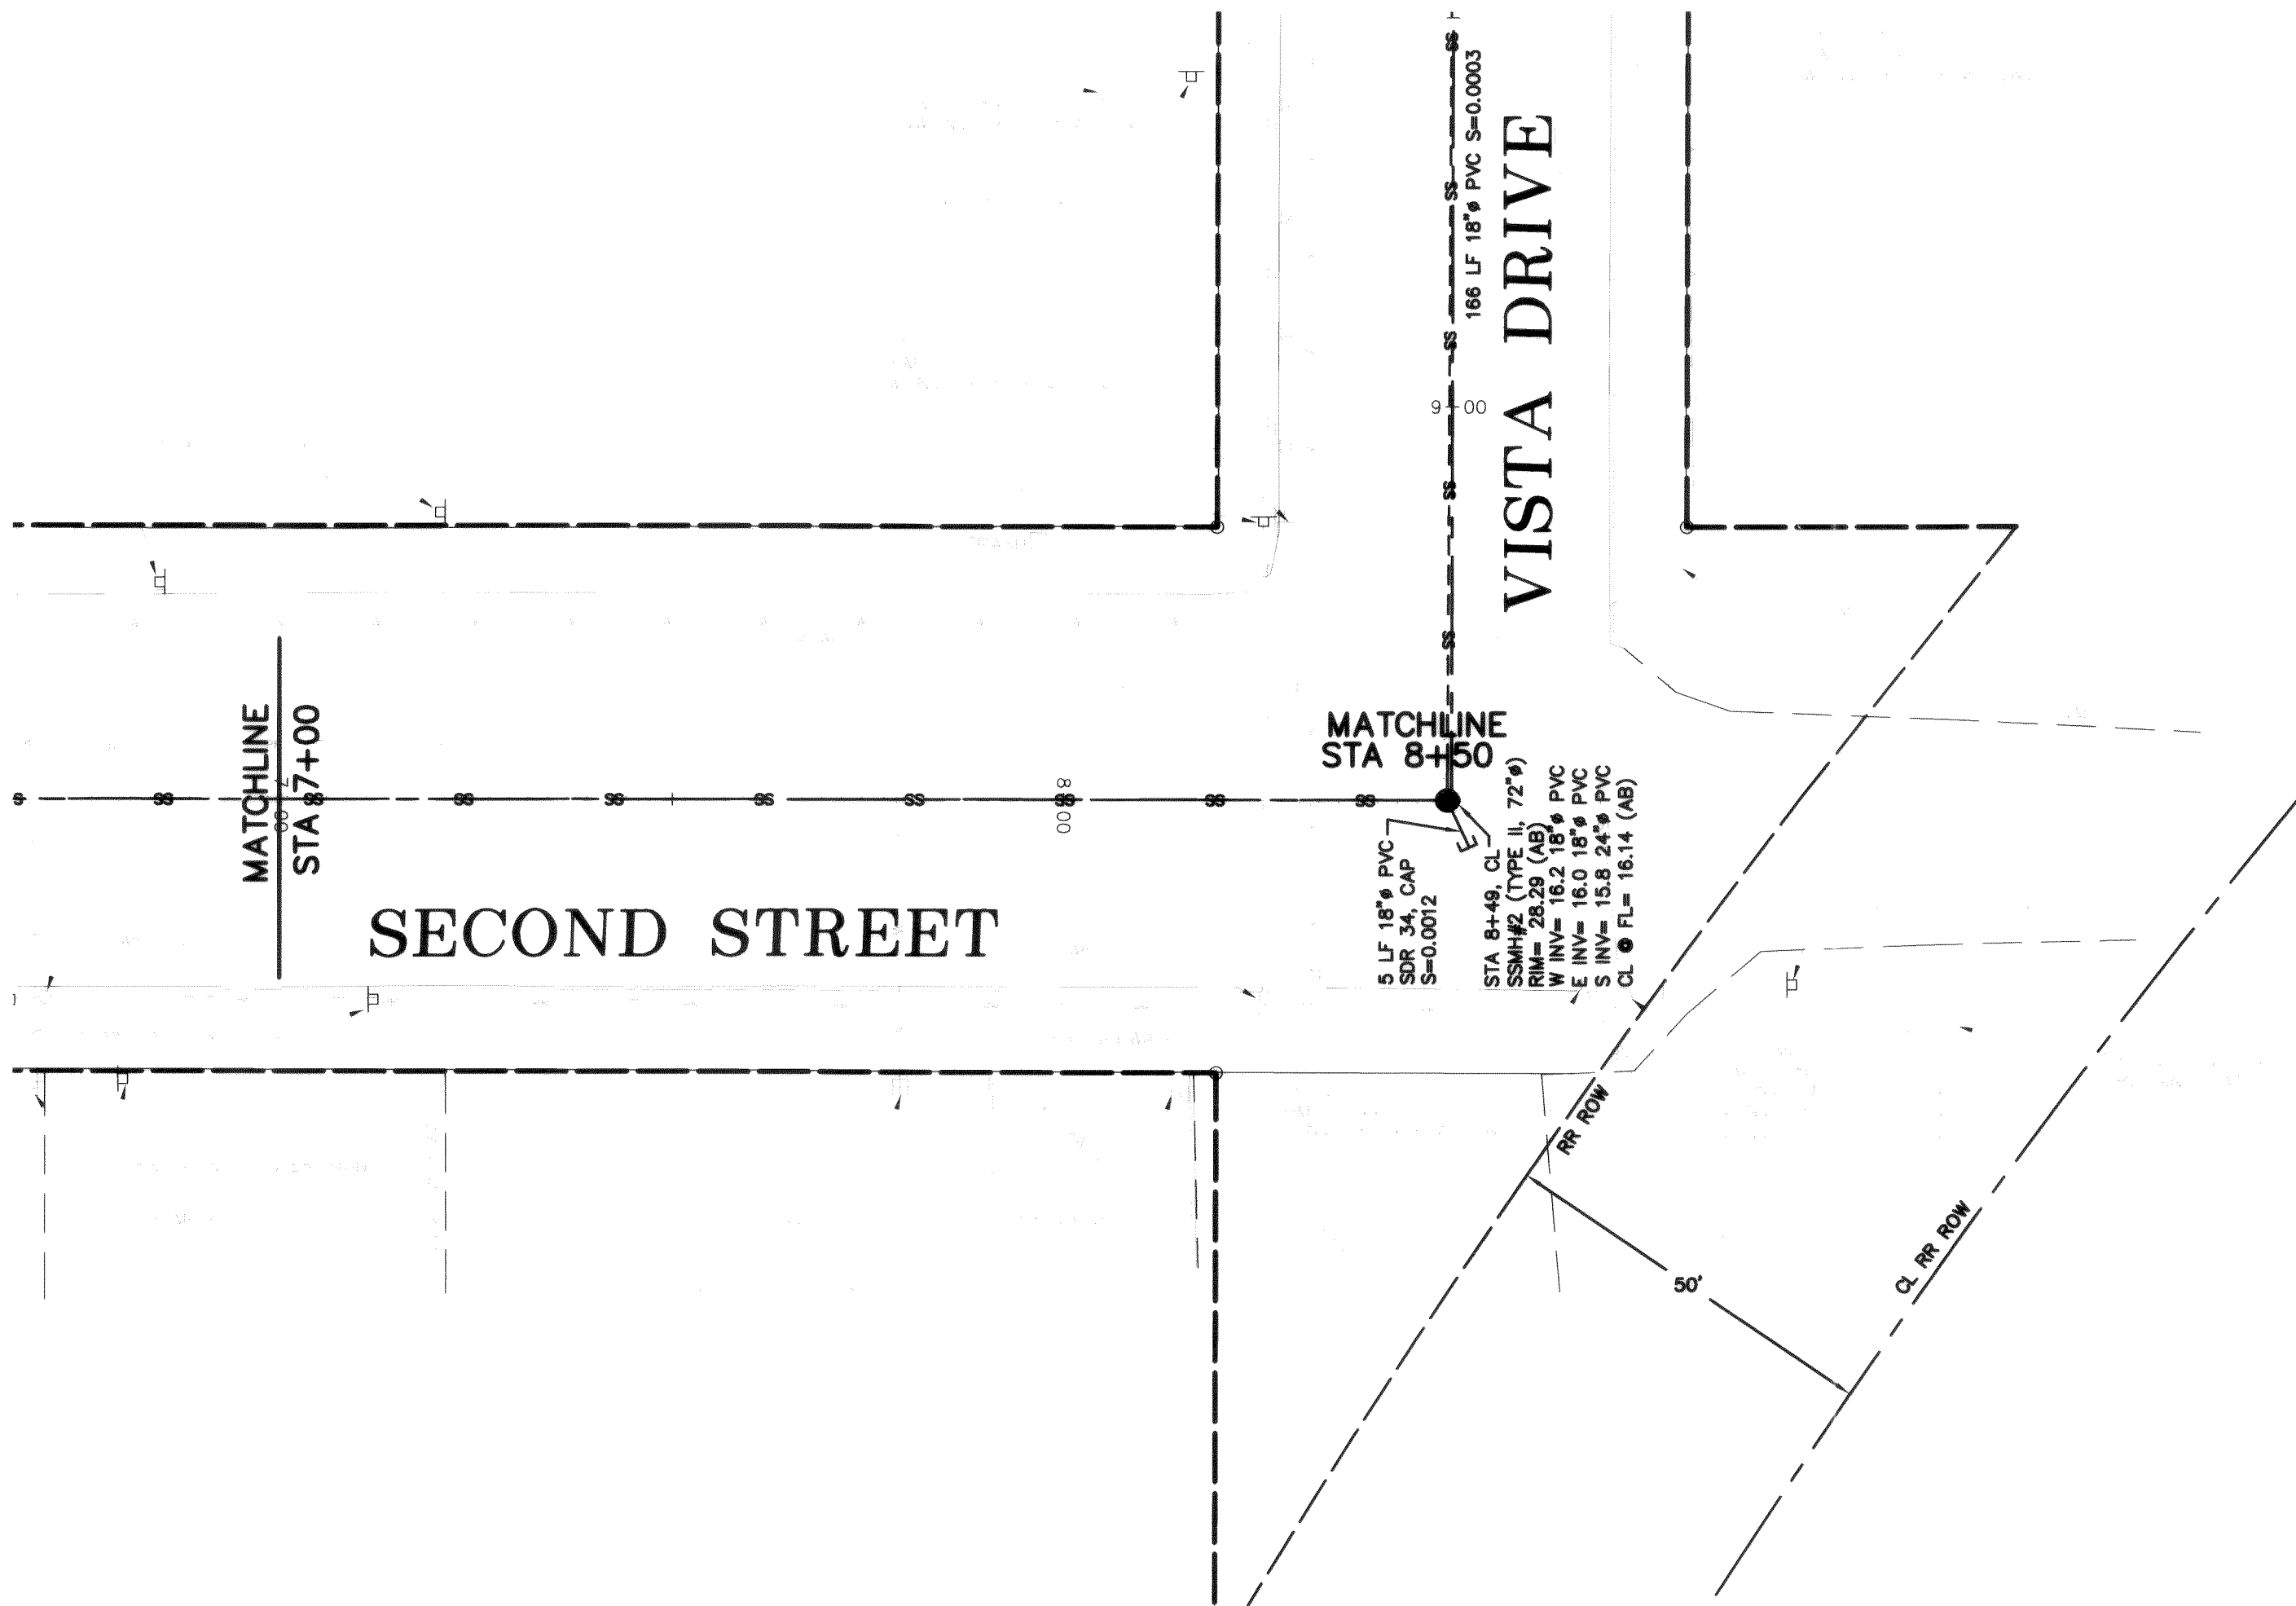


DATE: 2-9-01
AS-BUILT


DESIGNED BY GDE	R&E	REICHHARDT & EBE ENGINEERING, INC. CONSULTING ENGINEERS PO Box 978 423 Front St., Ste 201 Lynden, Washington 98264 Ph (360) 354-3687 Fax (360) 354-0407	NO.	DATE	REVISION	BY	CITY OF FERNDALE 2065 MAIN STREET FERNDALE, WASHINGTON 98248	SECOND STREET SEWER IMPROVEMENTS STA 7+00 TO 8+50	JOB# / DWG 00064 064TP2	DATE 8-29-00
									SCALE H: 1"=20' V: 1"=4'	SHEET 3

00214.003 2.16.06 KR


00064.DWG\SS064TP2_AB.dwg, 08/13/2003 01:17:08 PM, HP, DesignJet 500, 42-HFGLZ Card

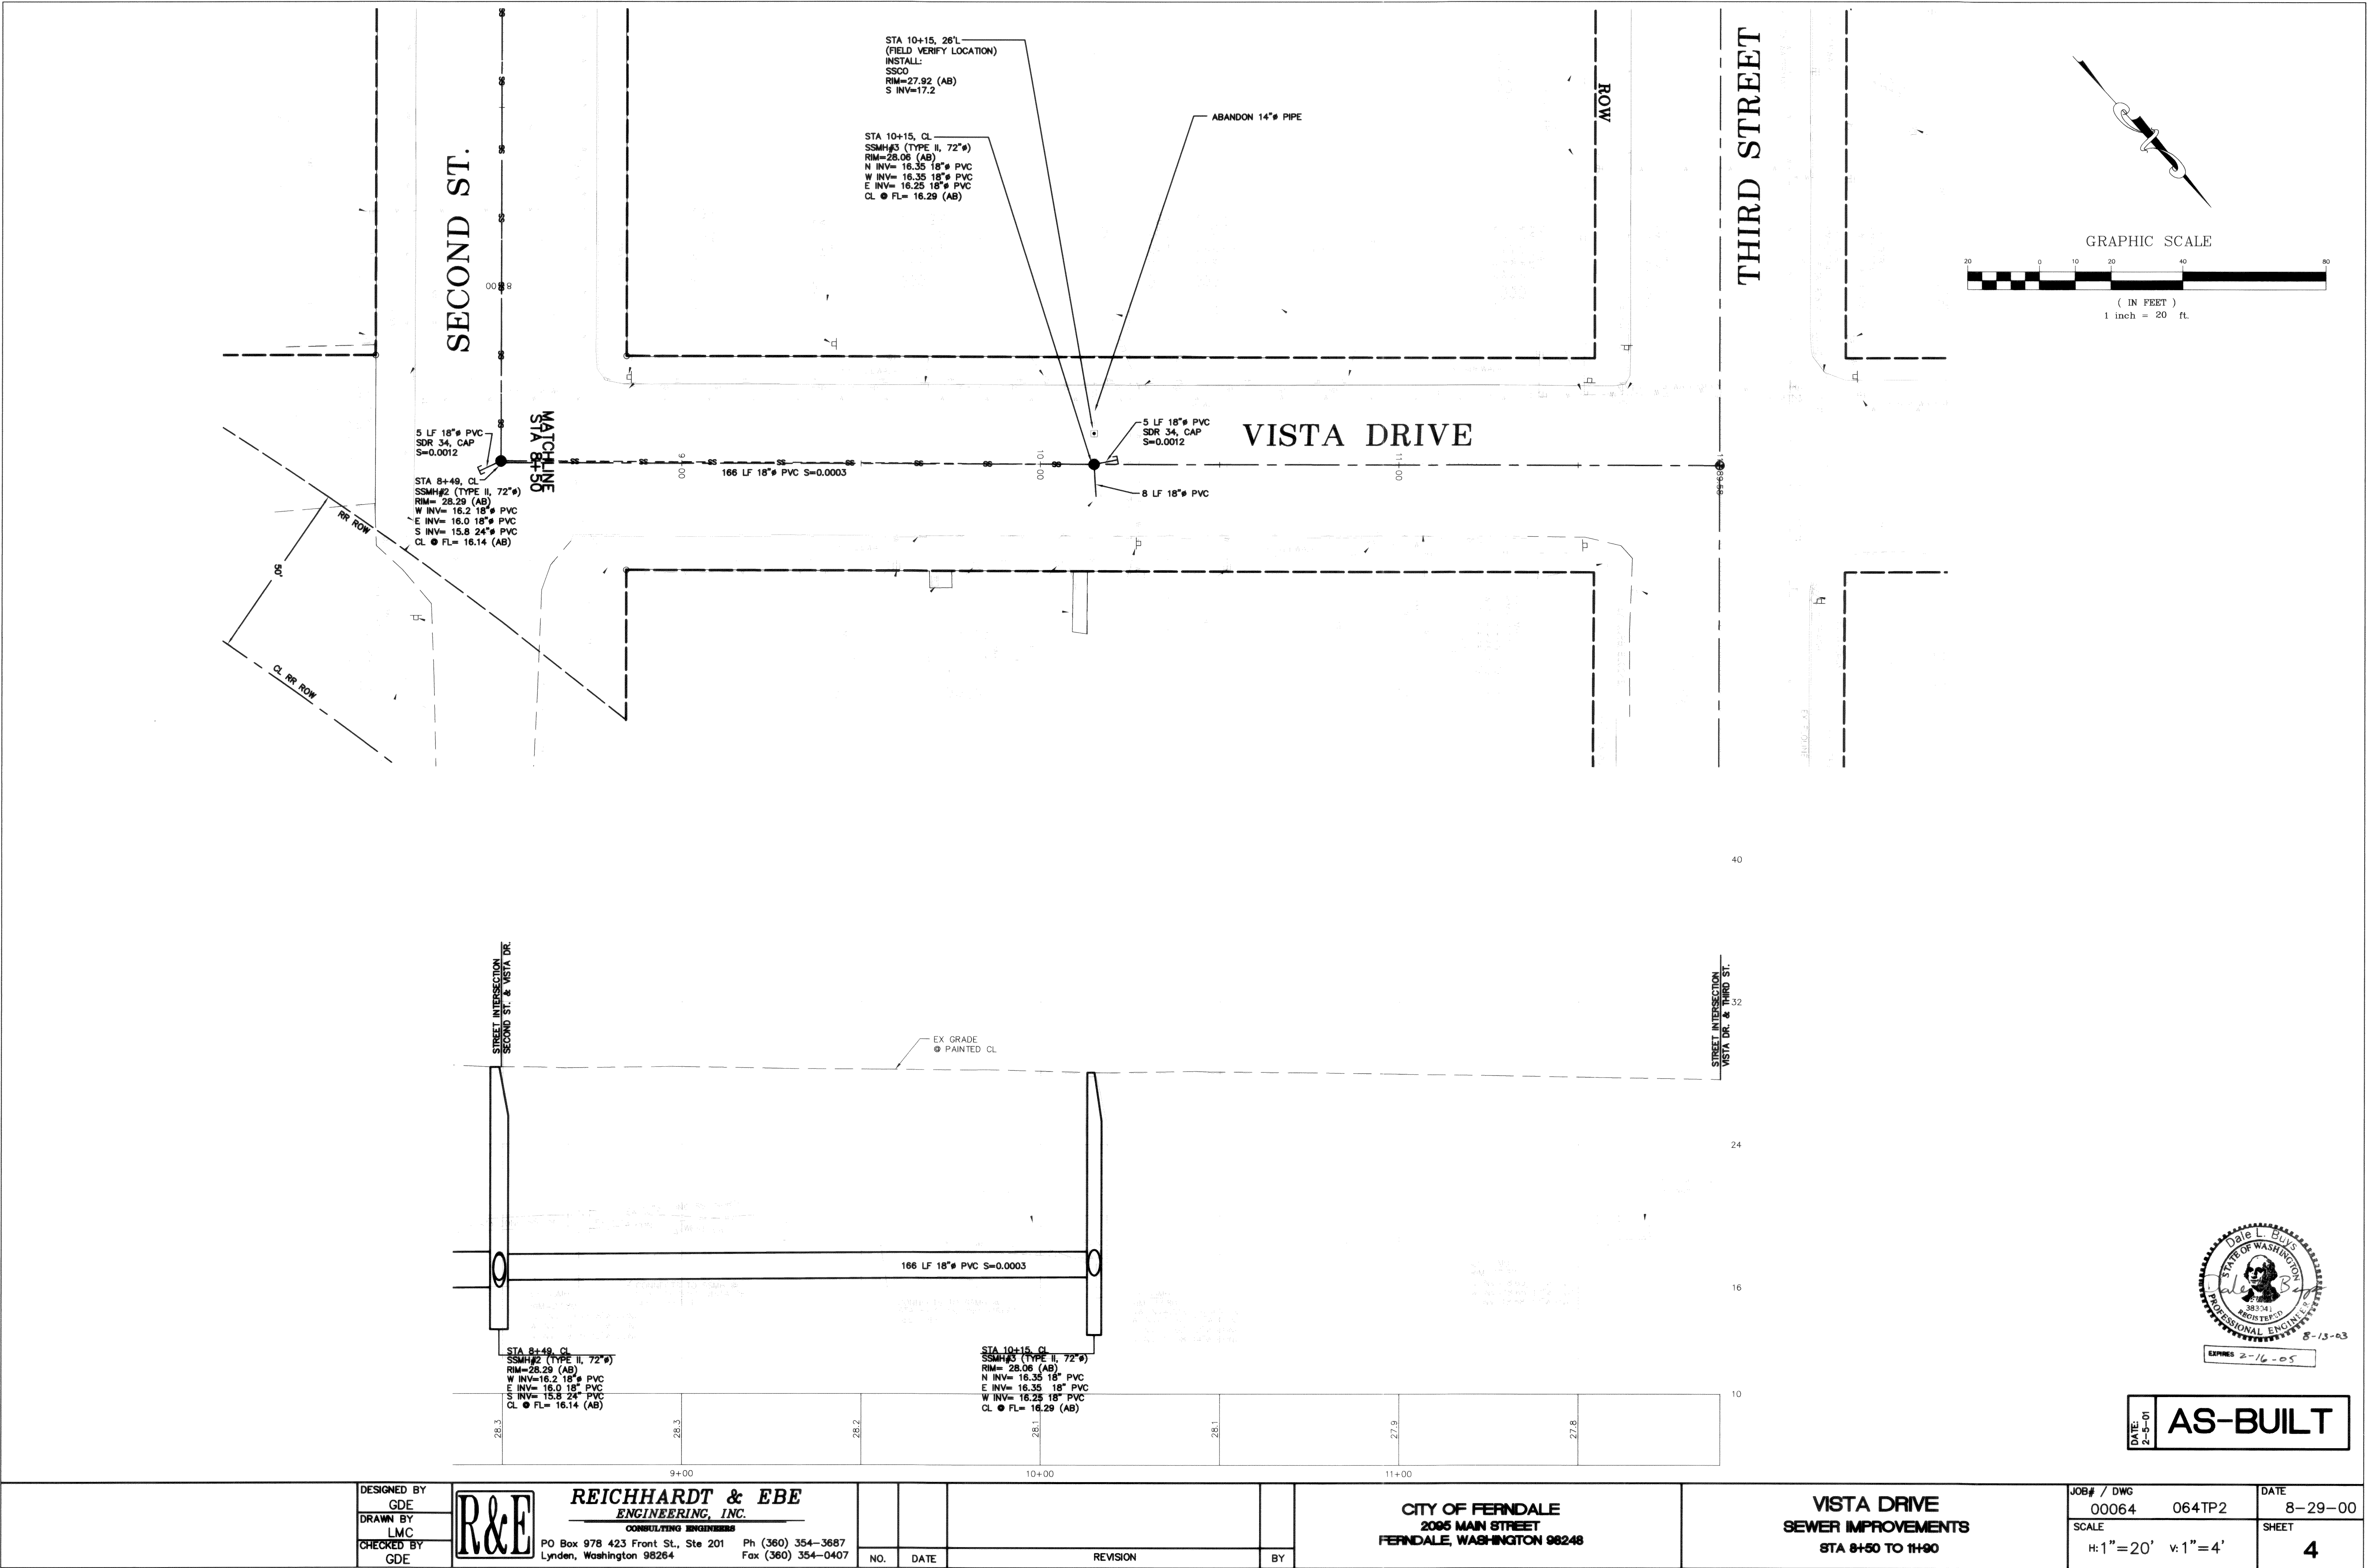


00214.004 2/16/06 KR.

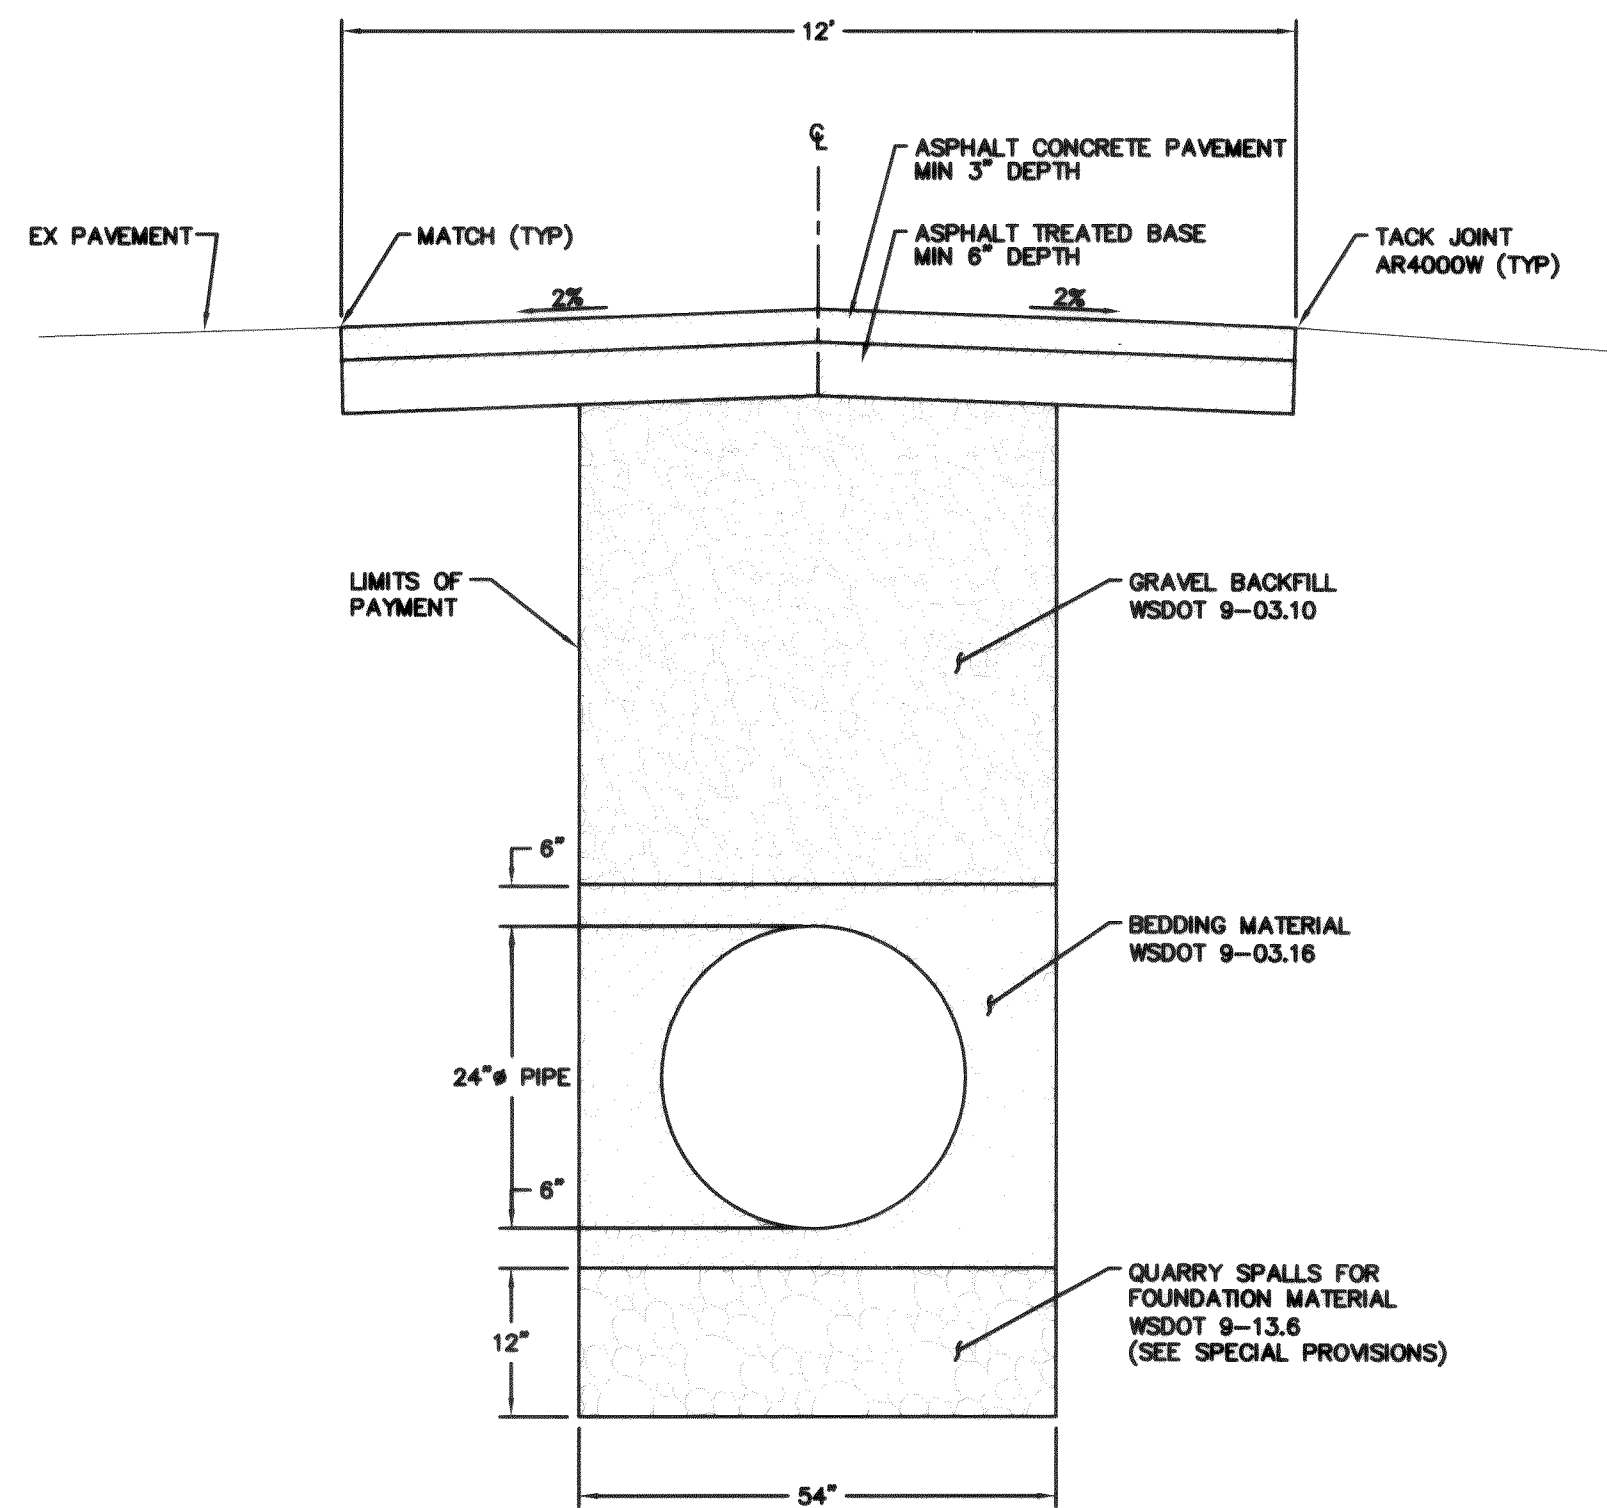


24" PIPE TRENCH
STA 2+13.5 TO 8+49
NTS

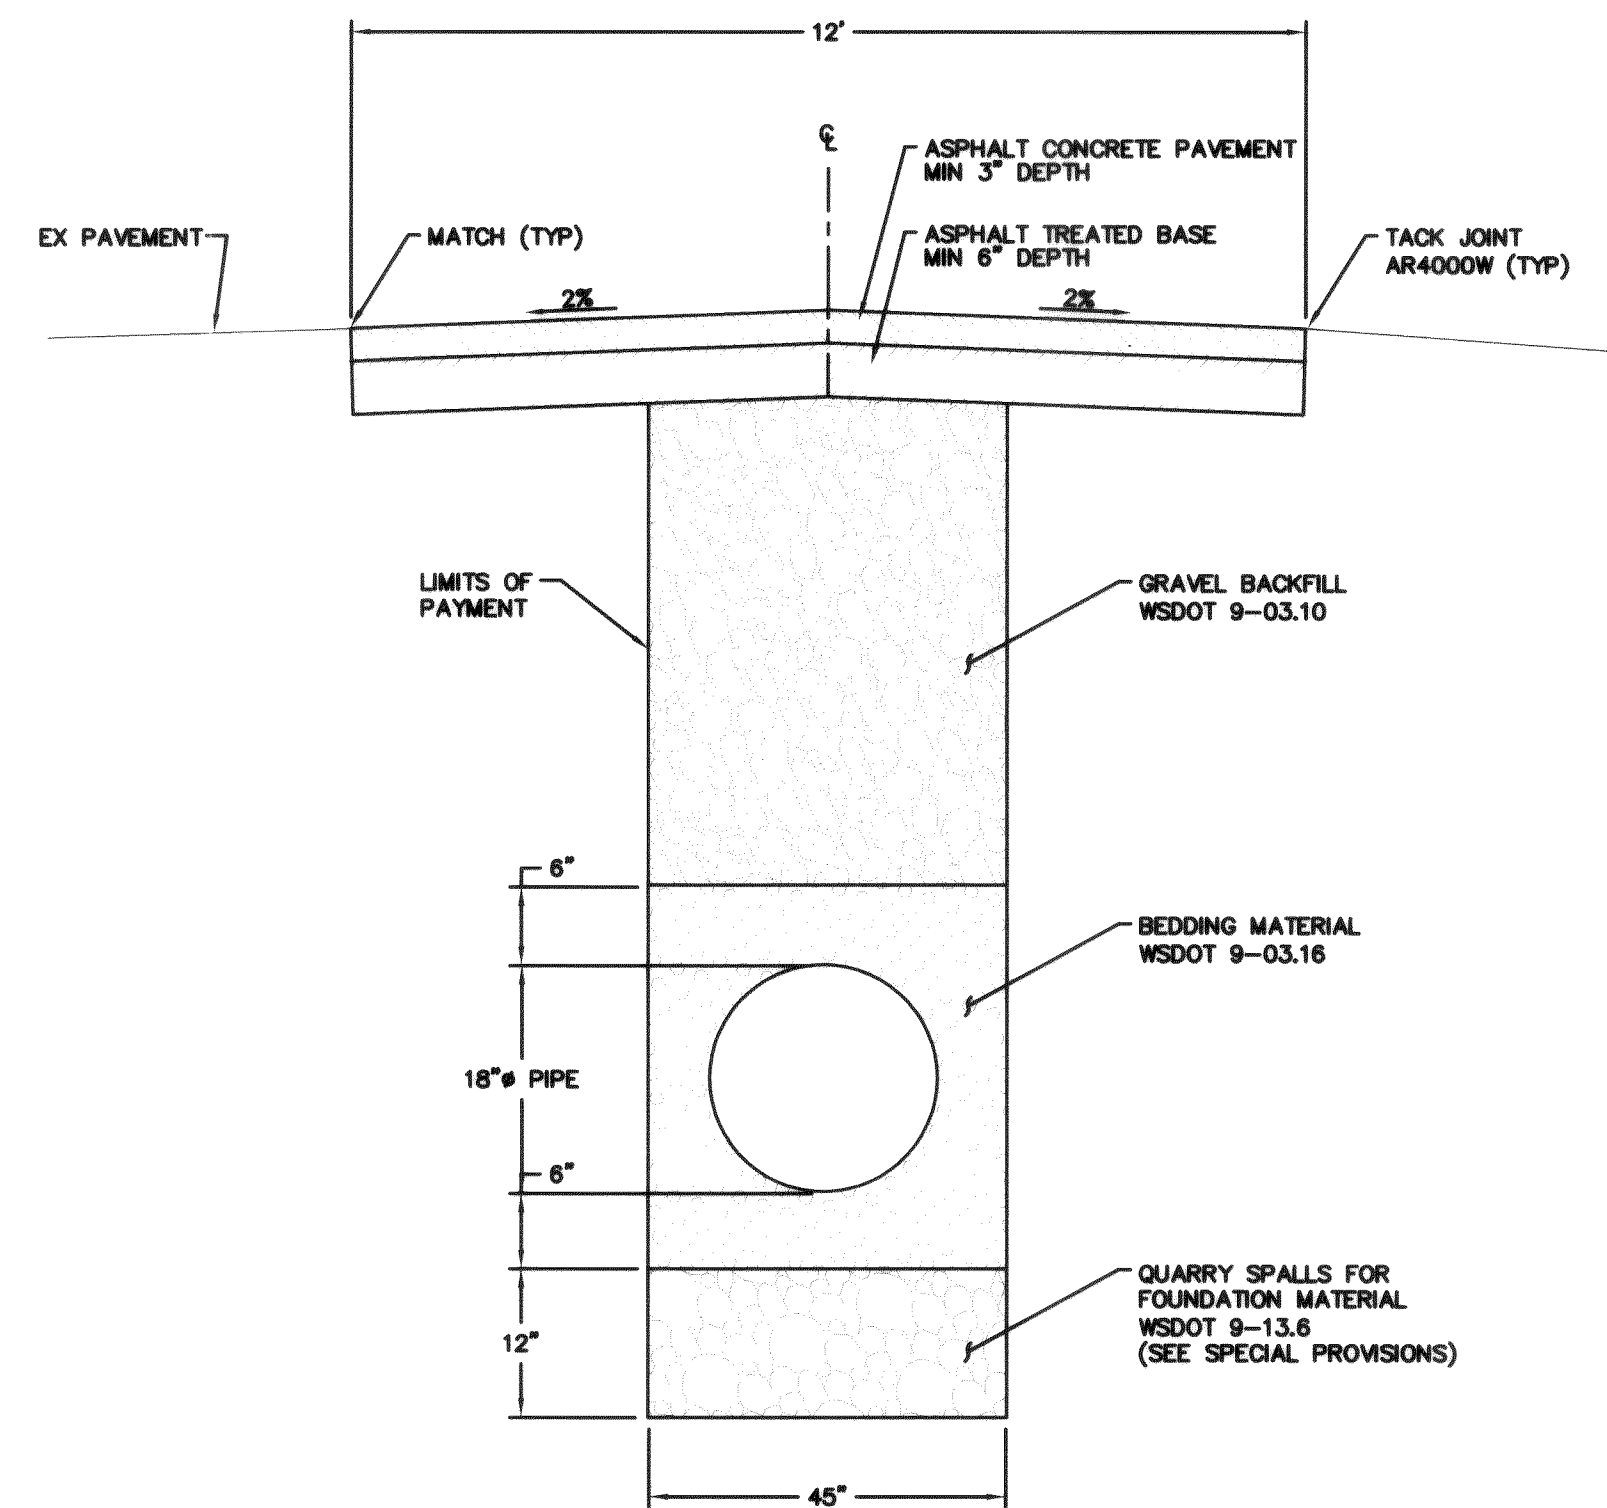

18" PIPE TRENCH
STA 8+49 TO 10+15
NTS

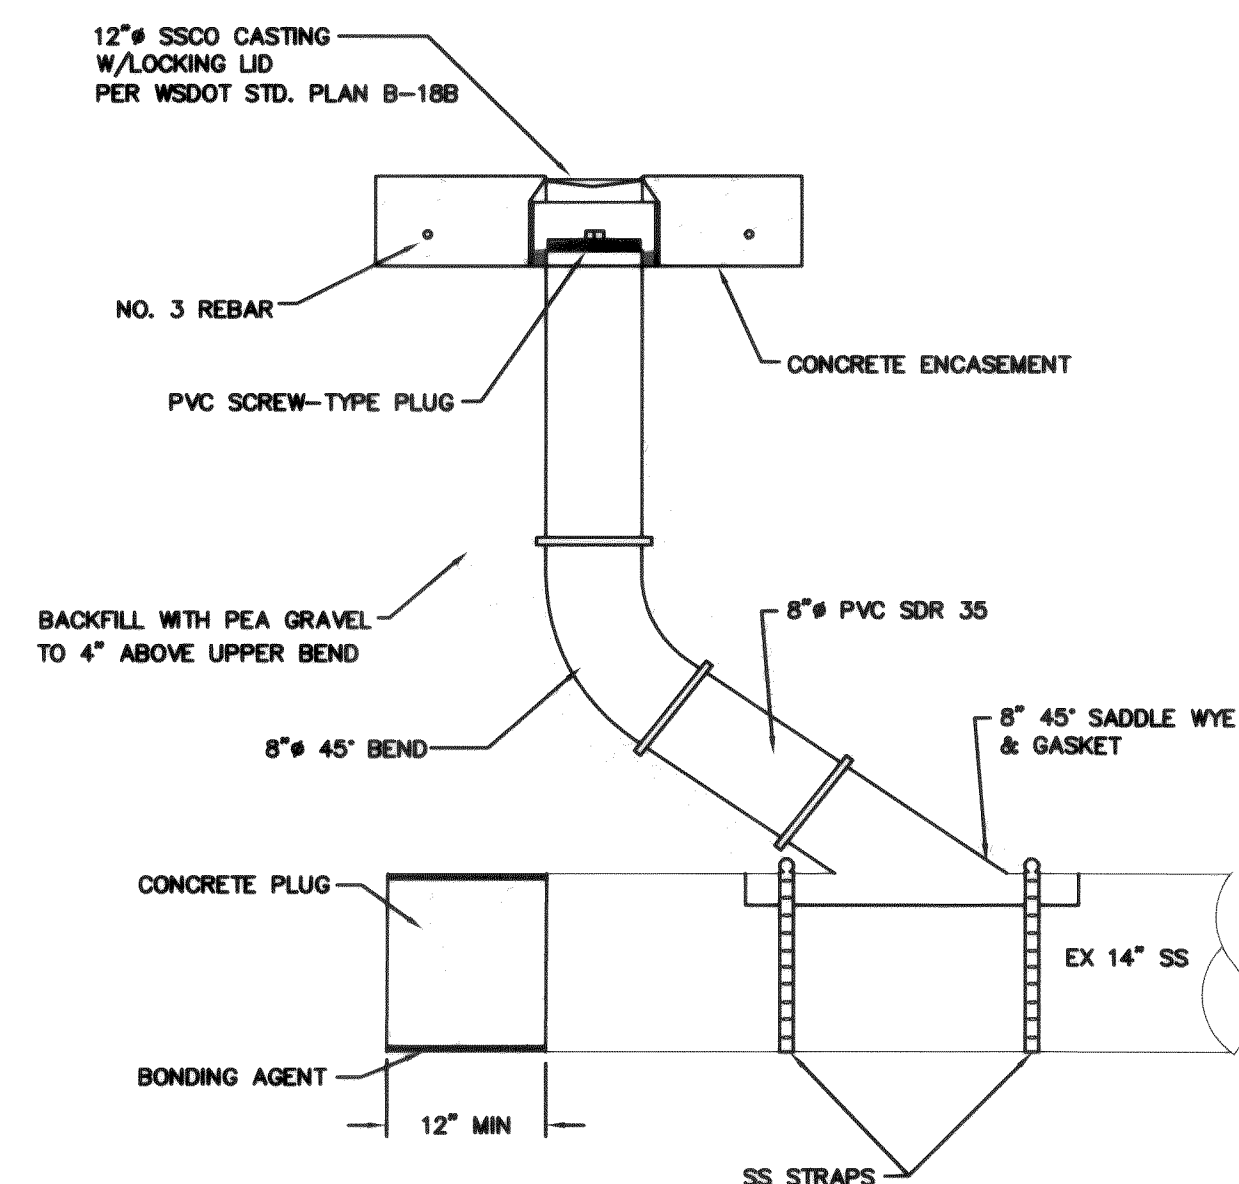

12" SANITARY SEWER CLEAN-OUT DETAIL
NTS

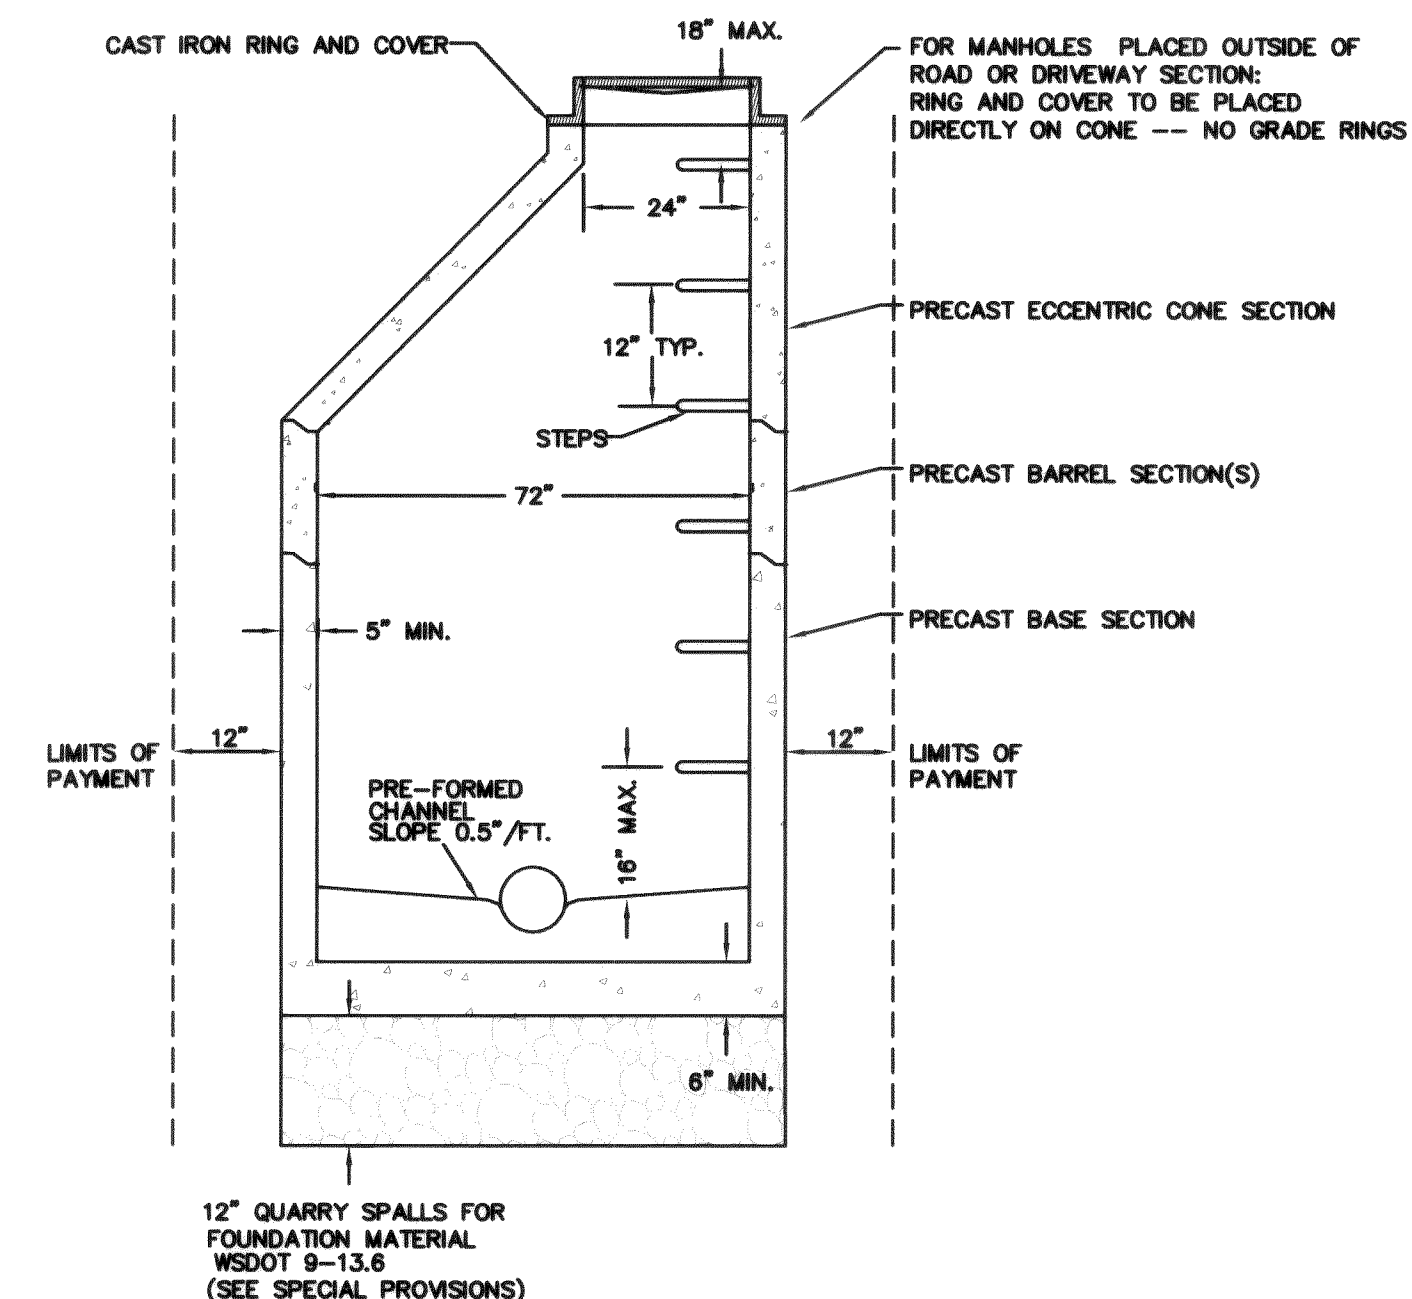

TYPE II SEWER MANHOLE DETAIL
72-INCH DIAMETER
NTS

DESIGNED BY
GDE
DRAWN BY
LMC
CHECKED BY
GDE



REICHHARDT & EBE
ENGINEERING, INC.
CONSULTING ENGINEERS

PO Box 978 423 Front St., Ste 201 Ph (360) 354-3687
Lynden, Washington 98264 Fax (360) 354-0407

NO.

DATE

REVISION

BY

CITY OF FERDALE
2095 MAIN STREET
FERDALE, WASHINGTON 98248

SECOND STREET
SEWER IMPROVEMENTS
DETAIL SHEET

JOB# / DWG
00064 064DET
SCALE
H: n/a V: n/a

DATE
8-30-00
SHEET
5

00214.005 2.16.06 KLR