

00565.001 6/27/14 SH

00565.001 6/27/14 SH



- OWNER/APPLICANT**
CITY OF FERNDALE
PUBLIC WORKS
- ENGINEER**
LDES, INC.
5160 INDUSTRIAL PL., SUITE 108
FERNDALDE, WA 98248
CONTACT: RAMON LLANOS, PE.
(360) 383-0620
- SURVEYOR**
LDES, INC.
5160 INDUSTRIAL PL., SUITE 108
FERNDALDE, WA 98248
CONTACT: KYLE HAGGITH, PLS
(360) 383-0620

APPROVED
JUN 9 6 2014
BY [Signature]
CITY OF ERNDALE

COVER SHEET
AS BUILT
BASS STREET, FERNDALE WA

REVISIONS		
SR	02-06-14	SUBMITTAL
SR	05/30/14	SUBMITTAL 2
YC	06/17/14	SUBMITTAL 3



SHEET

01

OF

03

150505 000 6/27/14



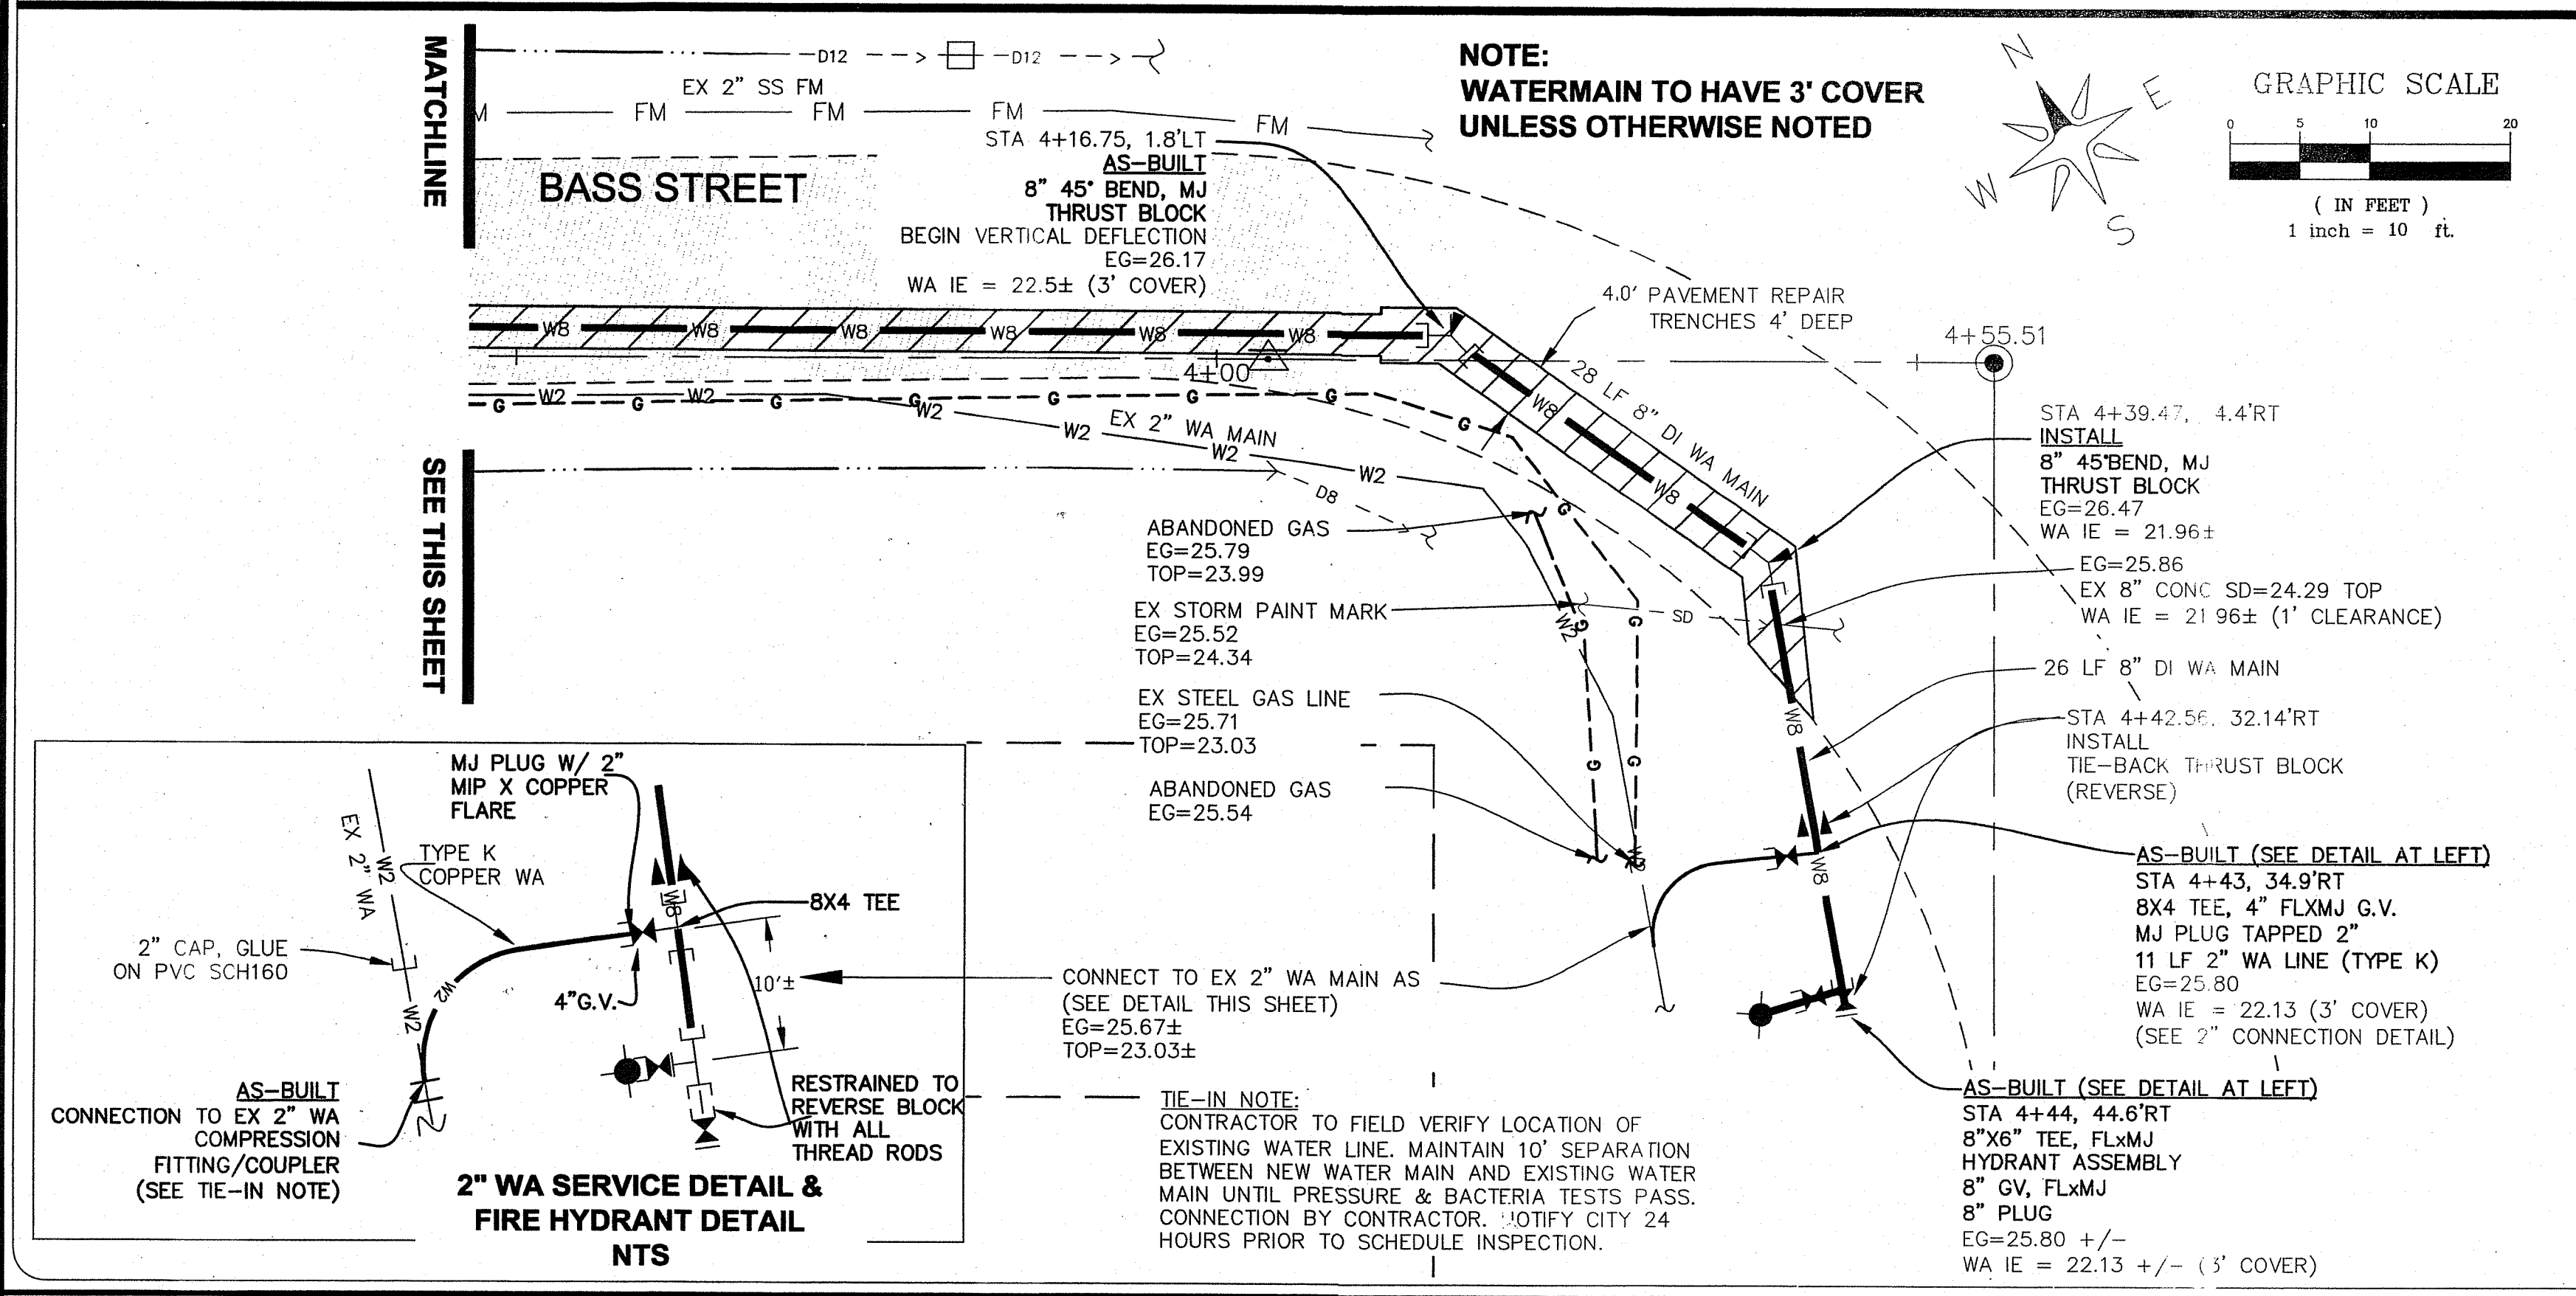
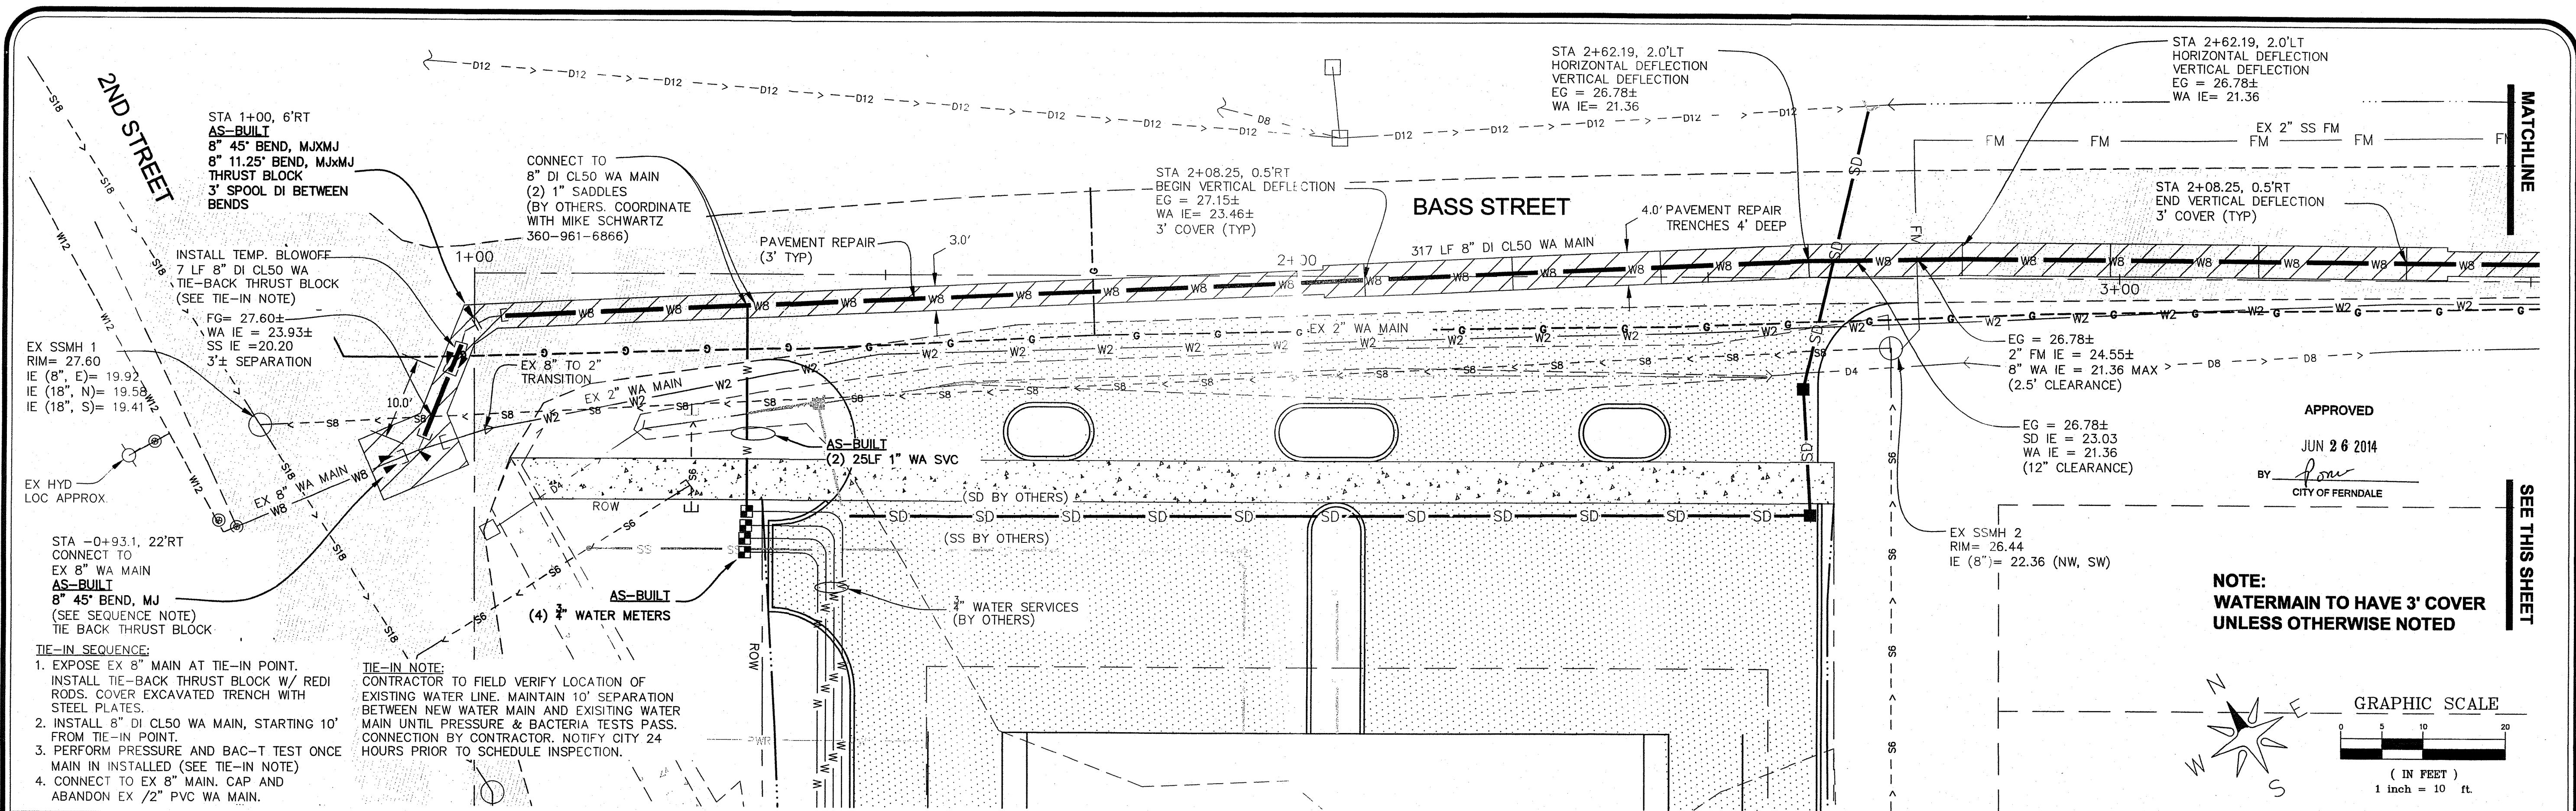


LEGEND



—	= EXST RIGHT-OF-WAY LINE	—	= SANITARY SEWER LINE
—	= EXST ROAD CENTER-LINE	—	= WATER LINE
—	= EXST CONTOUR (INDEX)	—	= WATER SERVICE LINE
—	= EXST CONTOUR (NORMAL)	—	= STORM DRAIN LINE
—	= EXST DITCH CENTER-LINE	—	= STORM DRAIN CULVERT
—	= EXIST GAS MAIN	—	= DITCHLINE
—	= EXIST WATER LINE	—	= UNDERGROUND POWER
—	= EXIST WATER SERVICE LINE	—	= WATER METER
—	= EXIST SANITARY SEWER LINE	—	= WATER VALVE
—	= EXIST 8\"/>		
—	= EXIST 6\"/>		
—	= EXIST STORM DRAIN LINE	—	= TEE CONNECTION (FL, MJ)
—	= EXIST STORM DRAIN CULVERT	—	= REDUCER
—	= EXIST WATER VALVE BOX	—	= THRUST BLOCK
—	= EXISTING WATER METER BOX	—	= TIE-BACK THRUST BLOCK
—	= EXISTING FIRE HYDRANT	—	= FIRE HYDRANT
—	= EXISTING COUPLING	—	= 11.25\"/>
—	= EXISTING REDUCER	—	= 45\"/>
—	= EXIST POWER AND/OR UTILITY POLE	—	= 90\"/>
—	= EXIST TELEPHONE POLE	—	= SANITARY SEWER CLEANOUT
—	= EXIST SANITARY SEWER MANHOLE	—	= STORM DRAIN CATCH BASIN
—	= EXIST CATCH BASIN	—	
—	= EXIST ASPHALT	—	
—	= EXIST CONC SIDEWALK	—	

2\"/>

0565-003 6/27/14 st

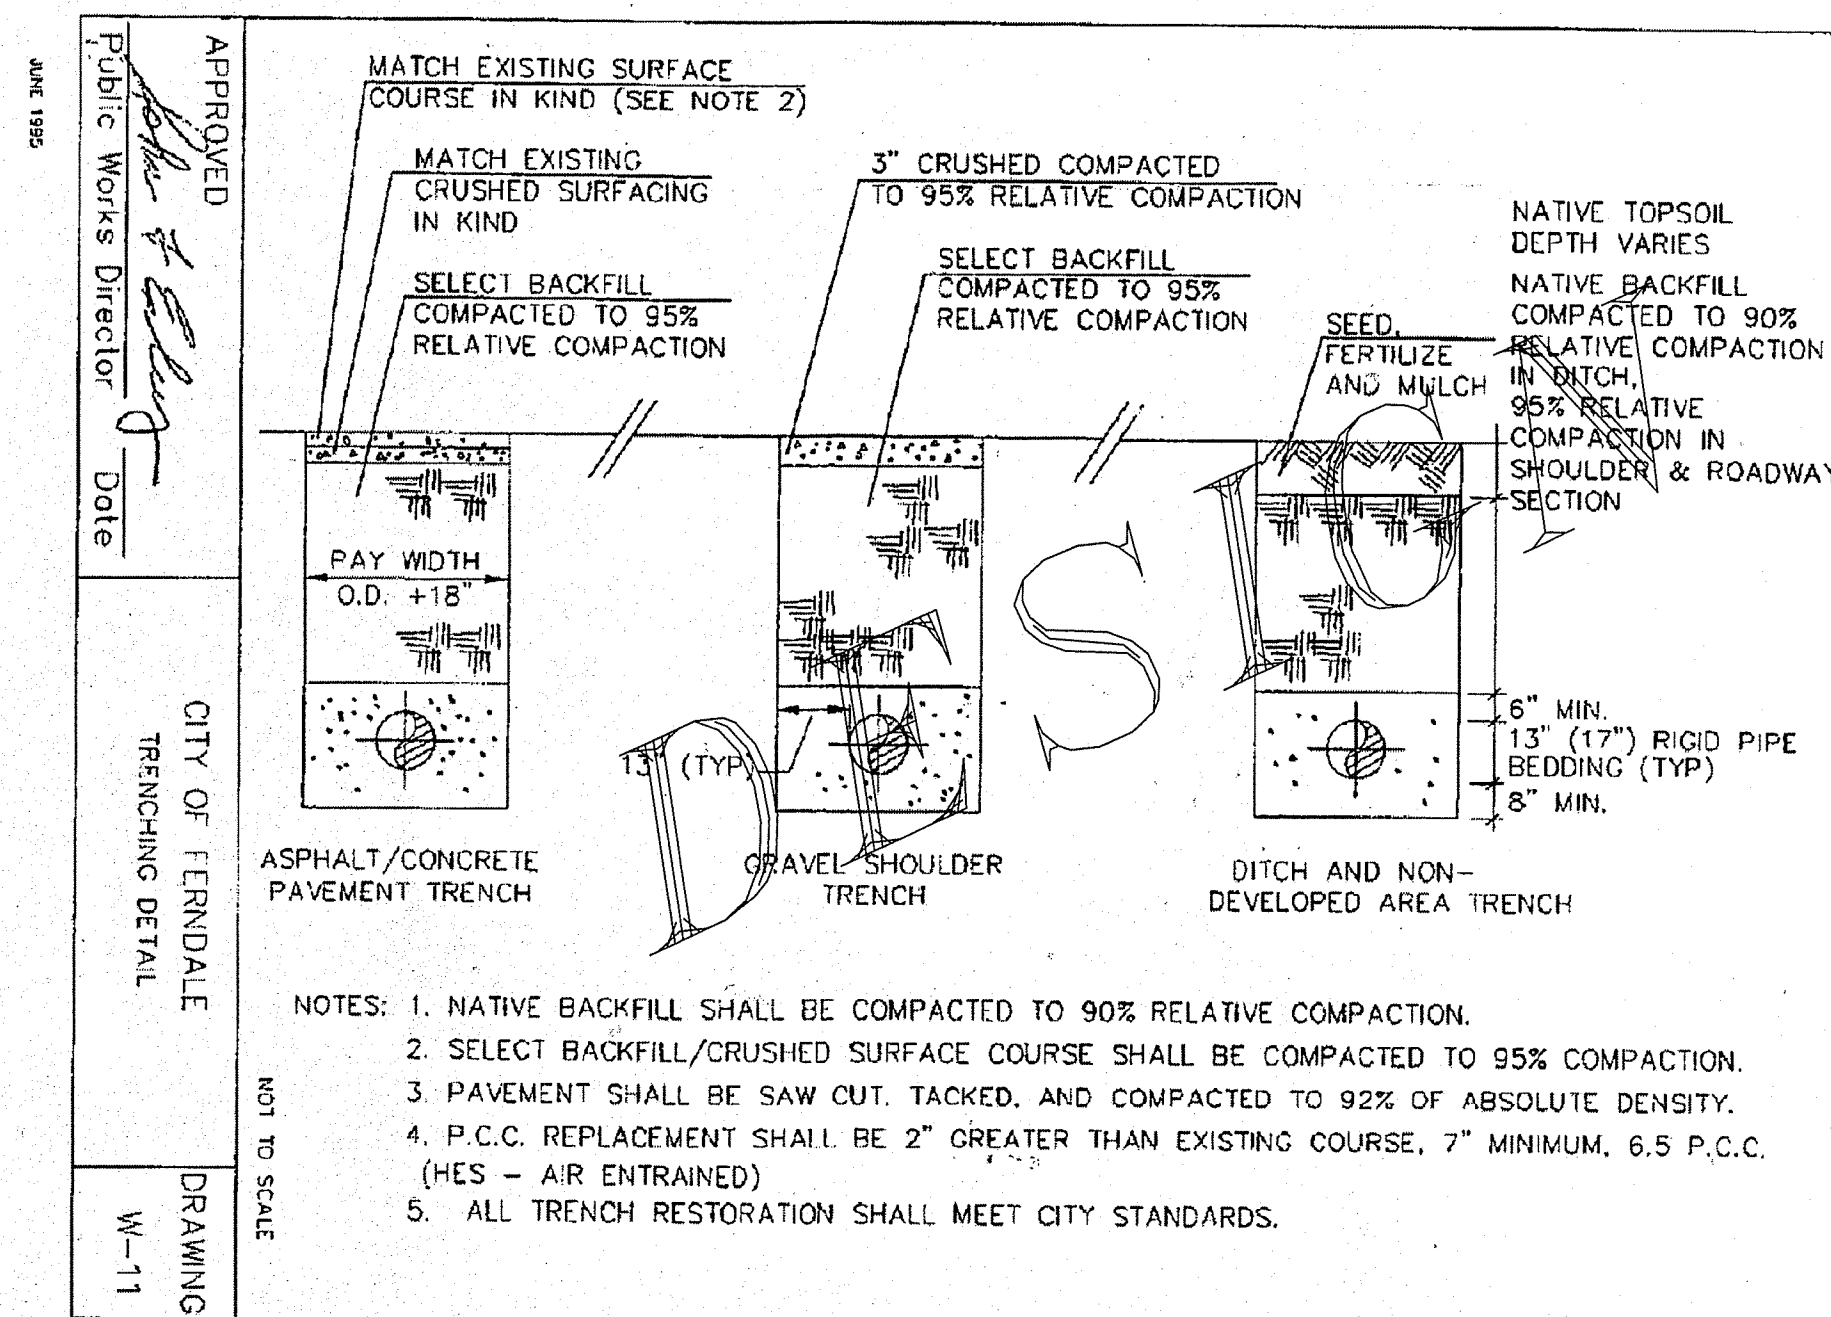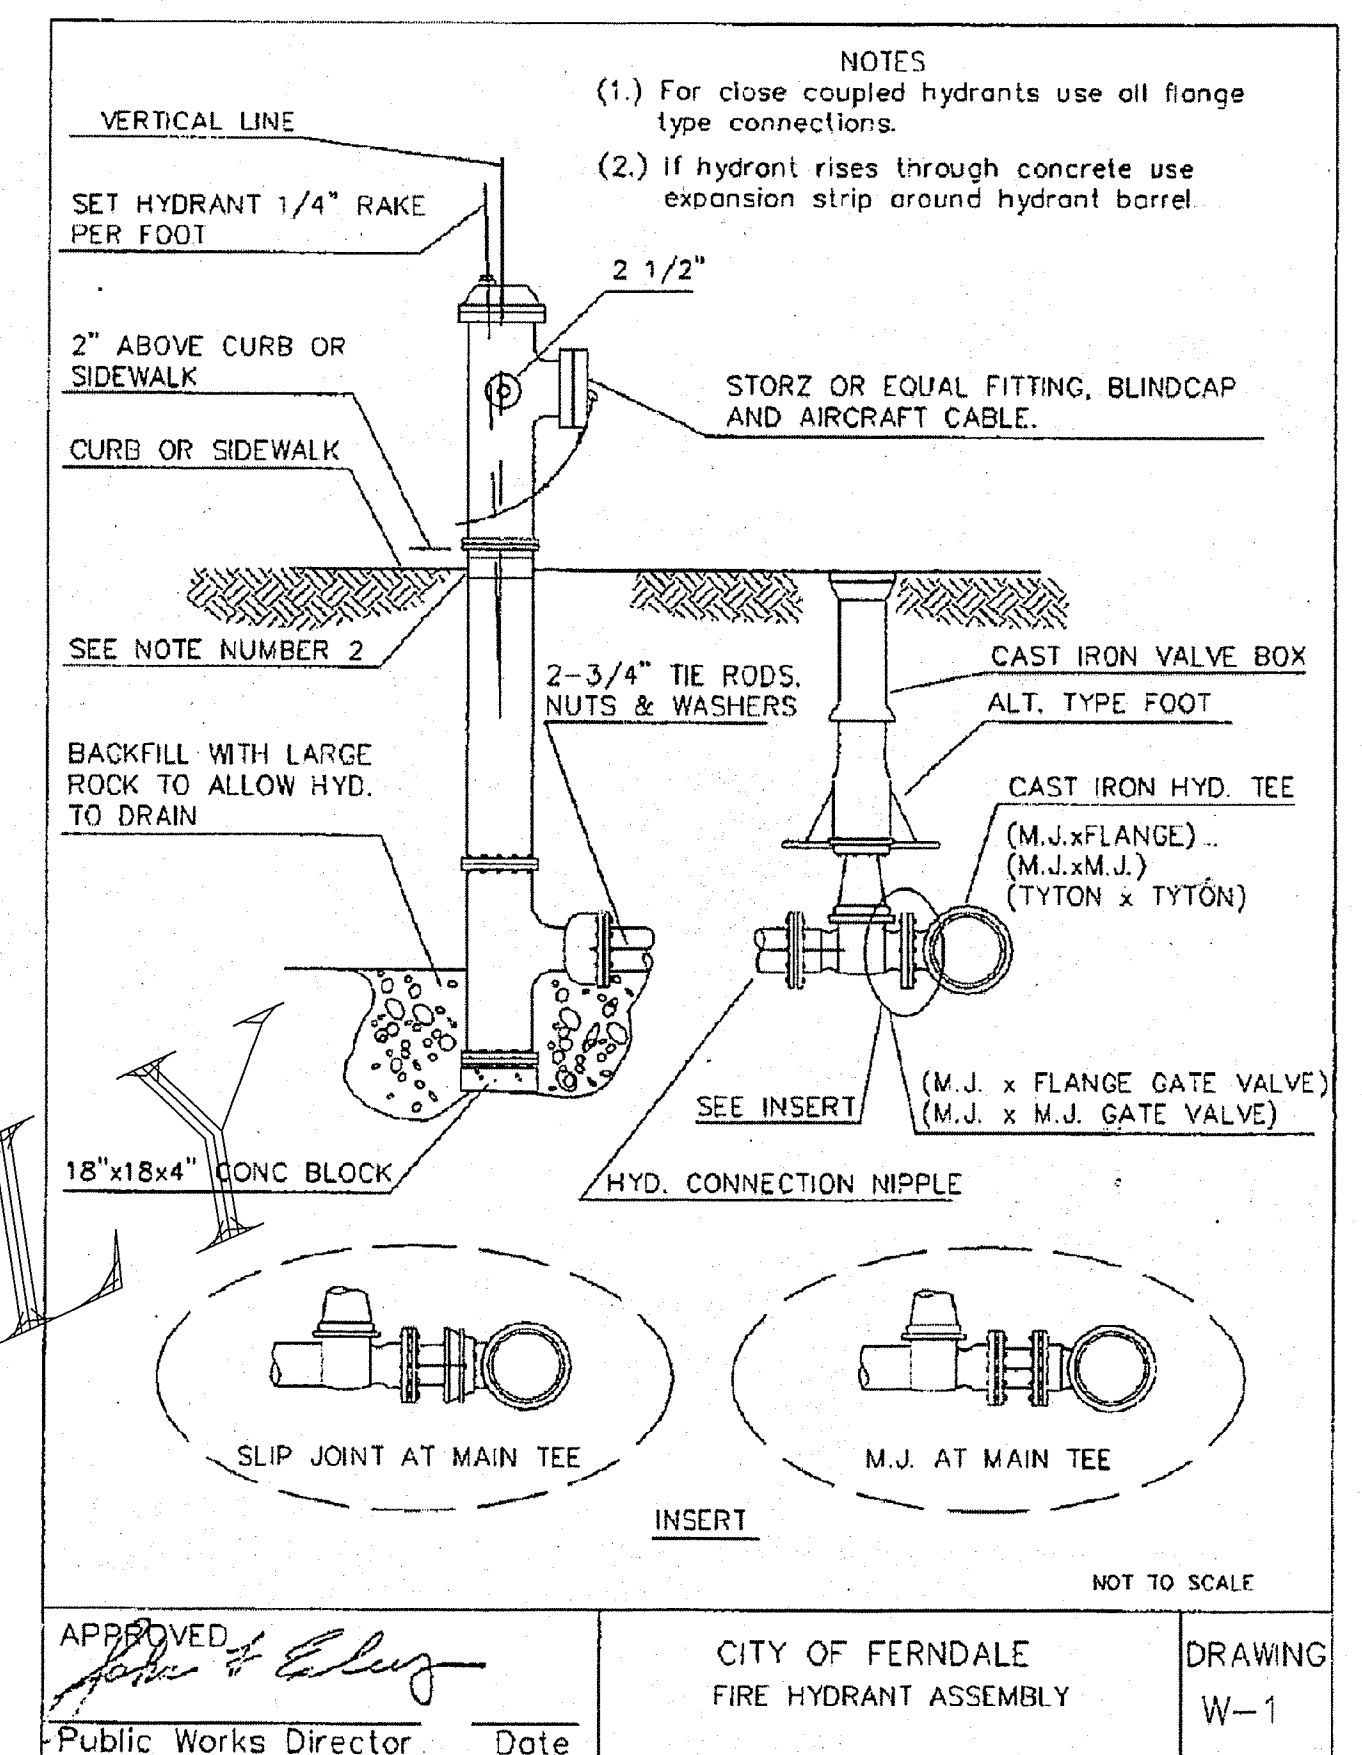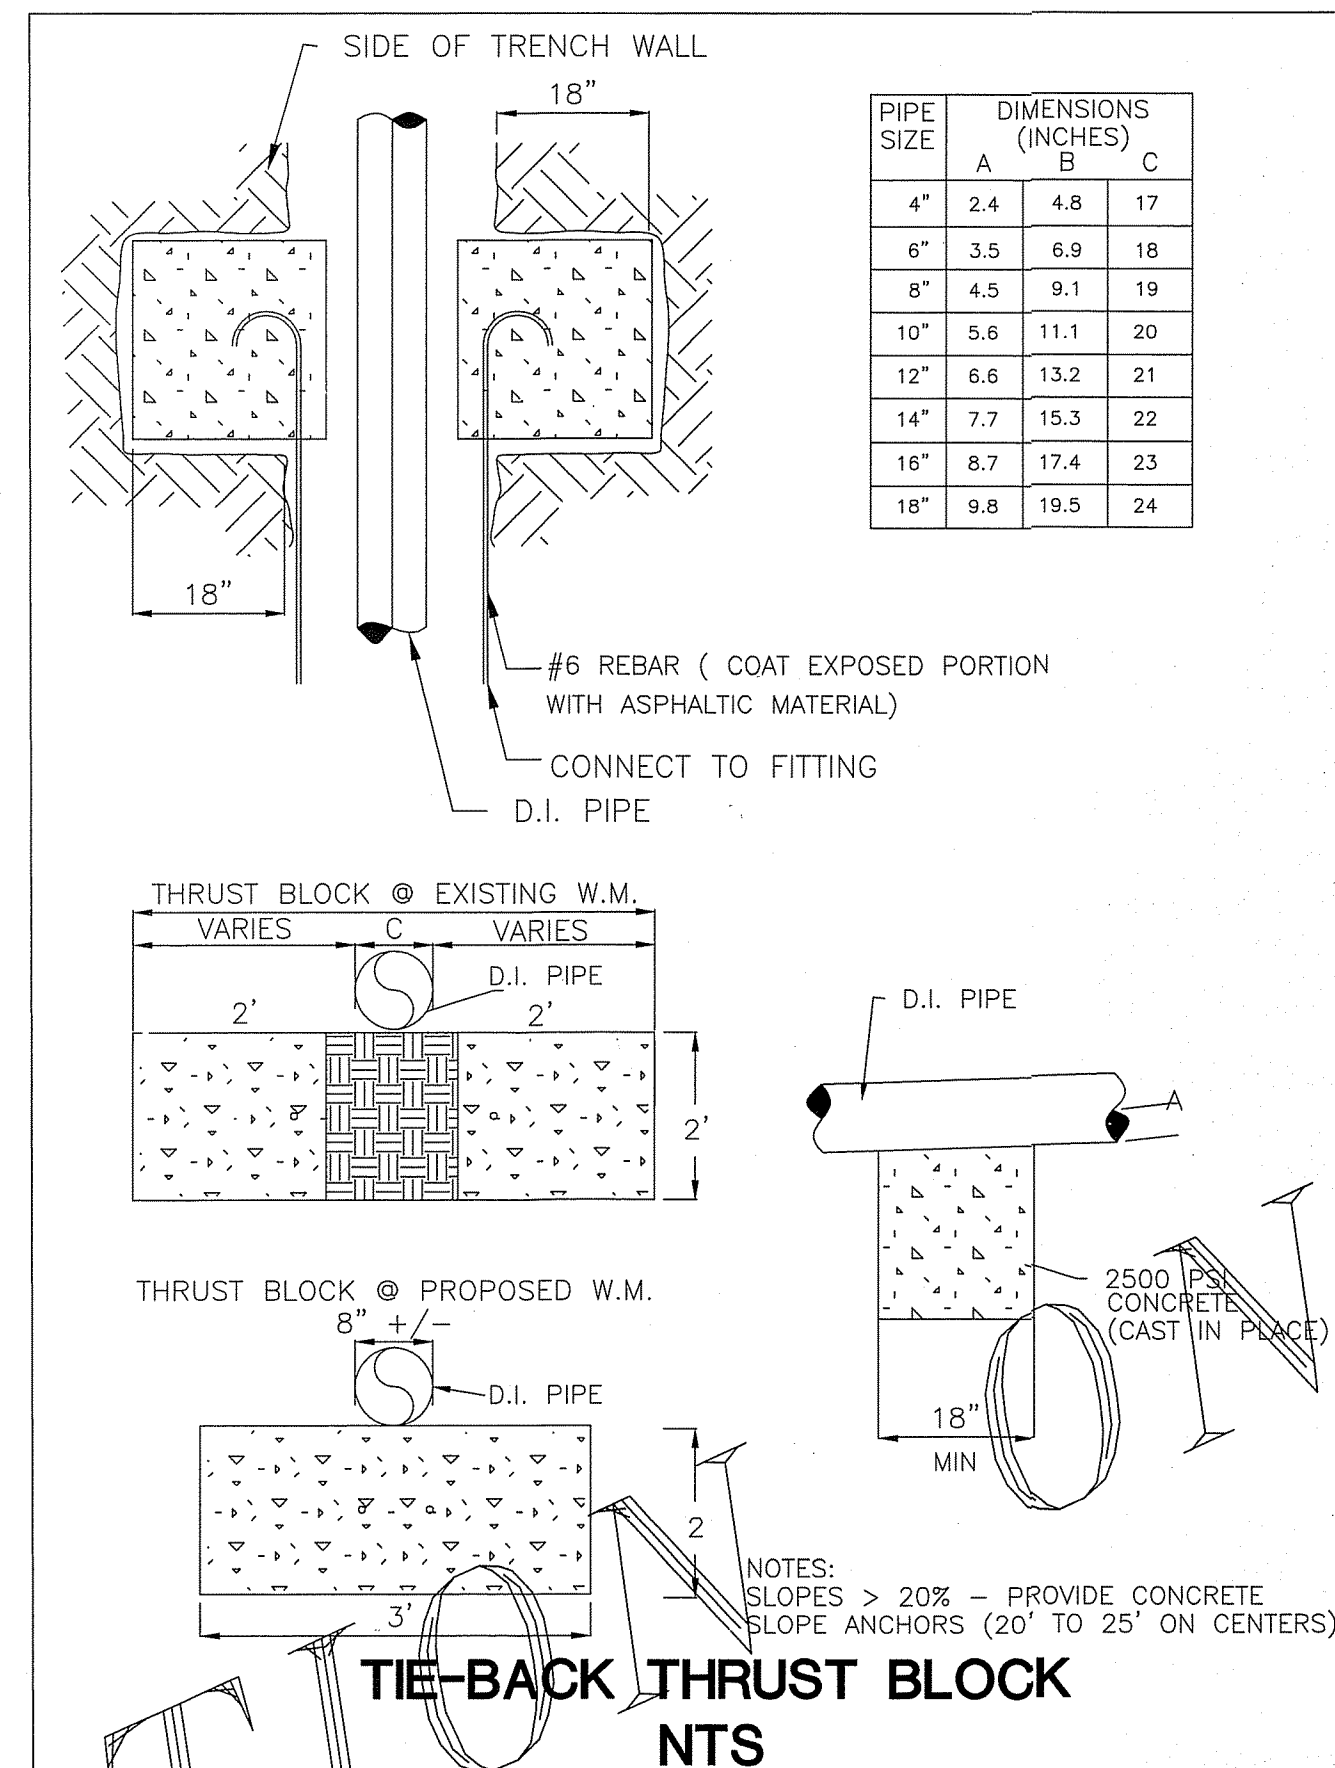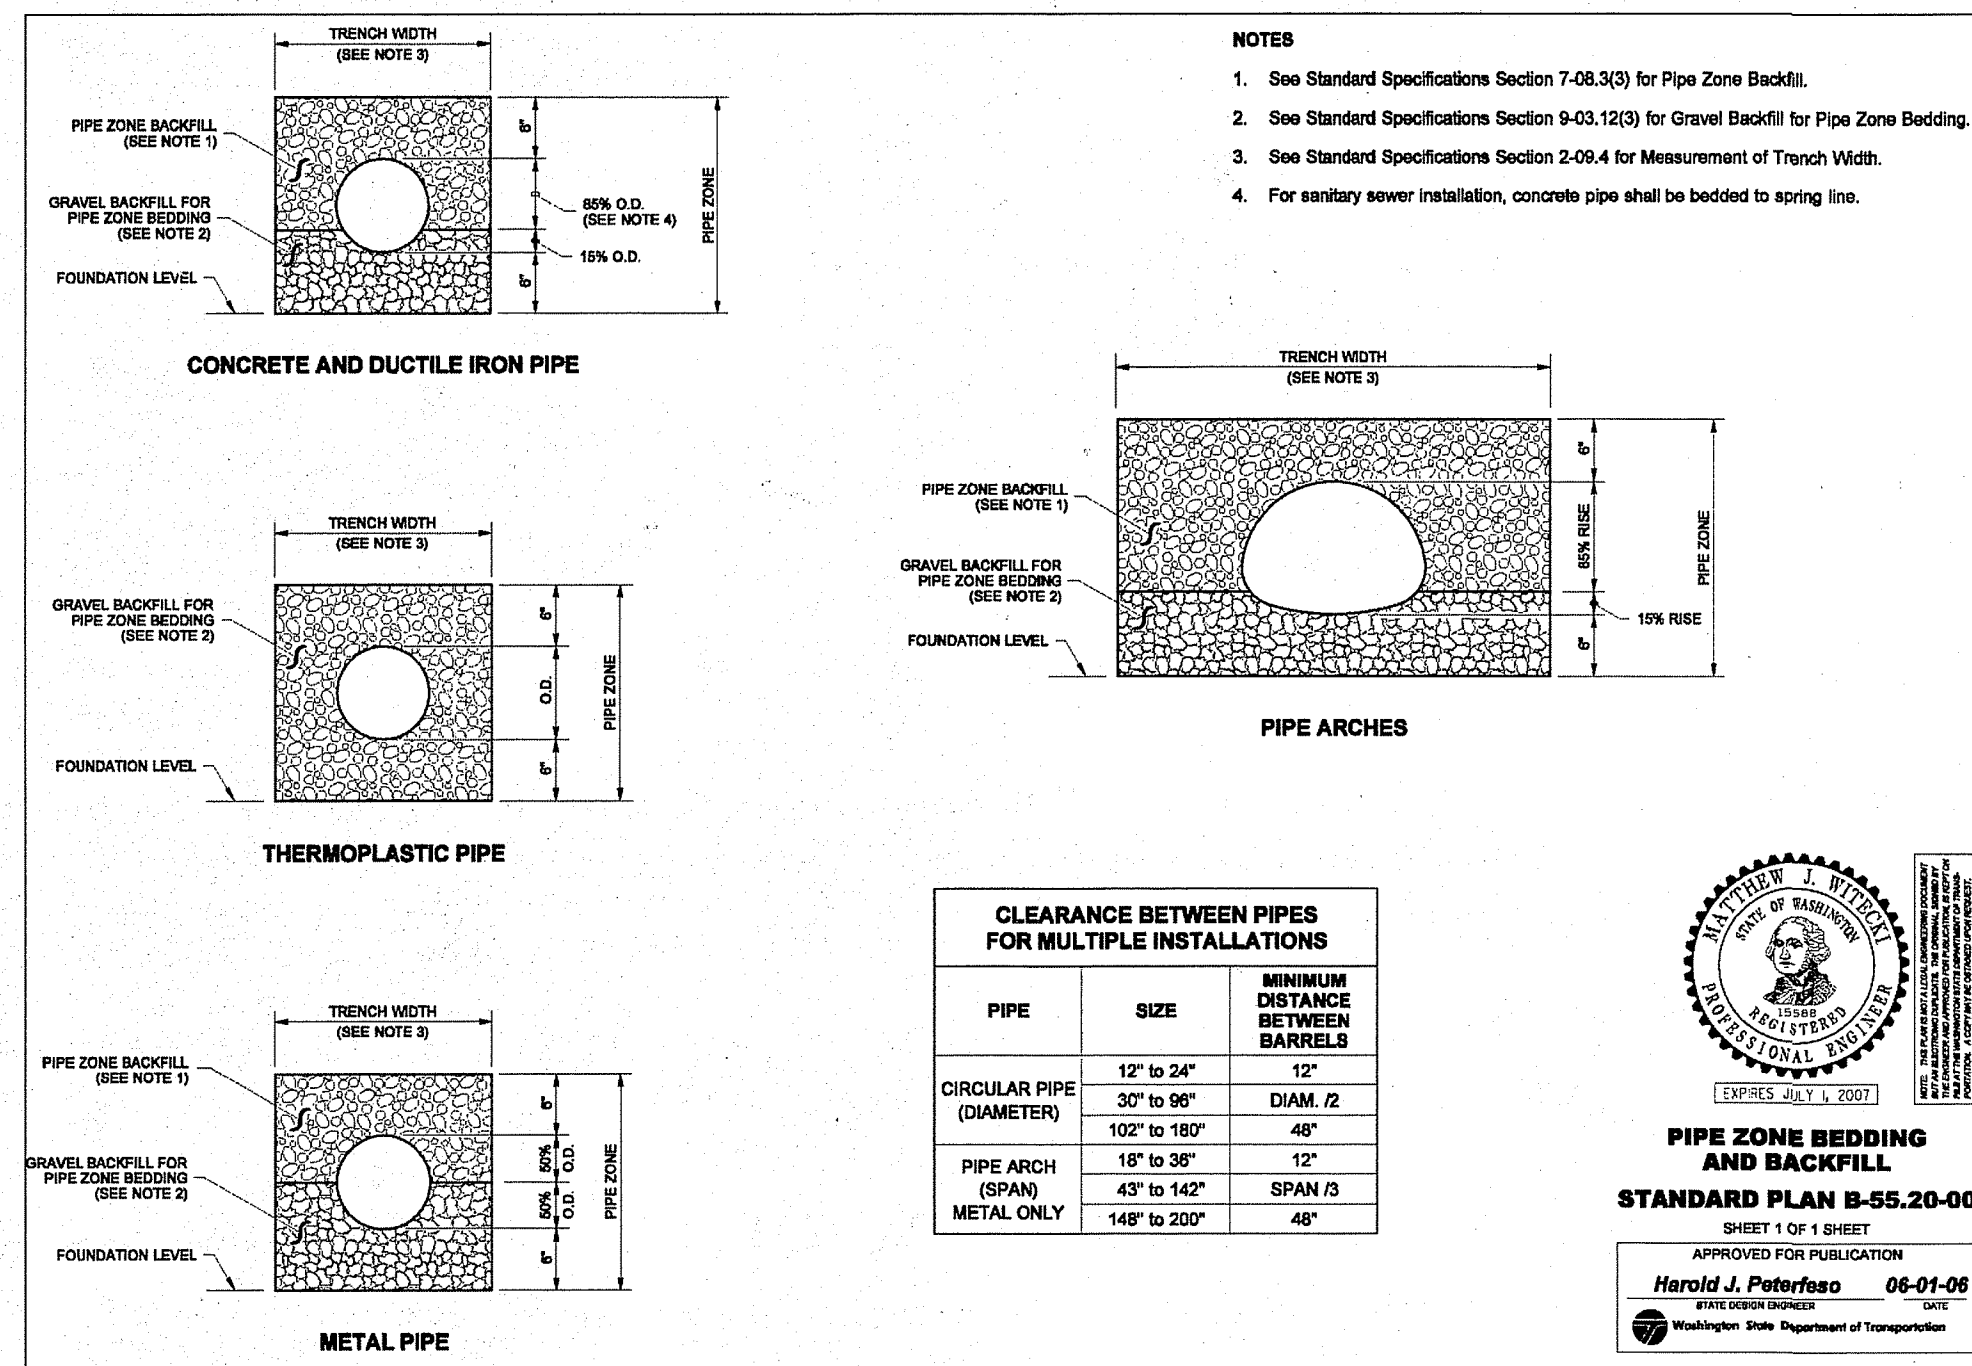



INFORMATION

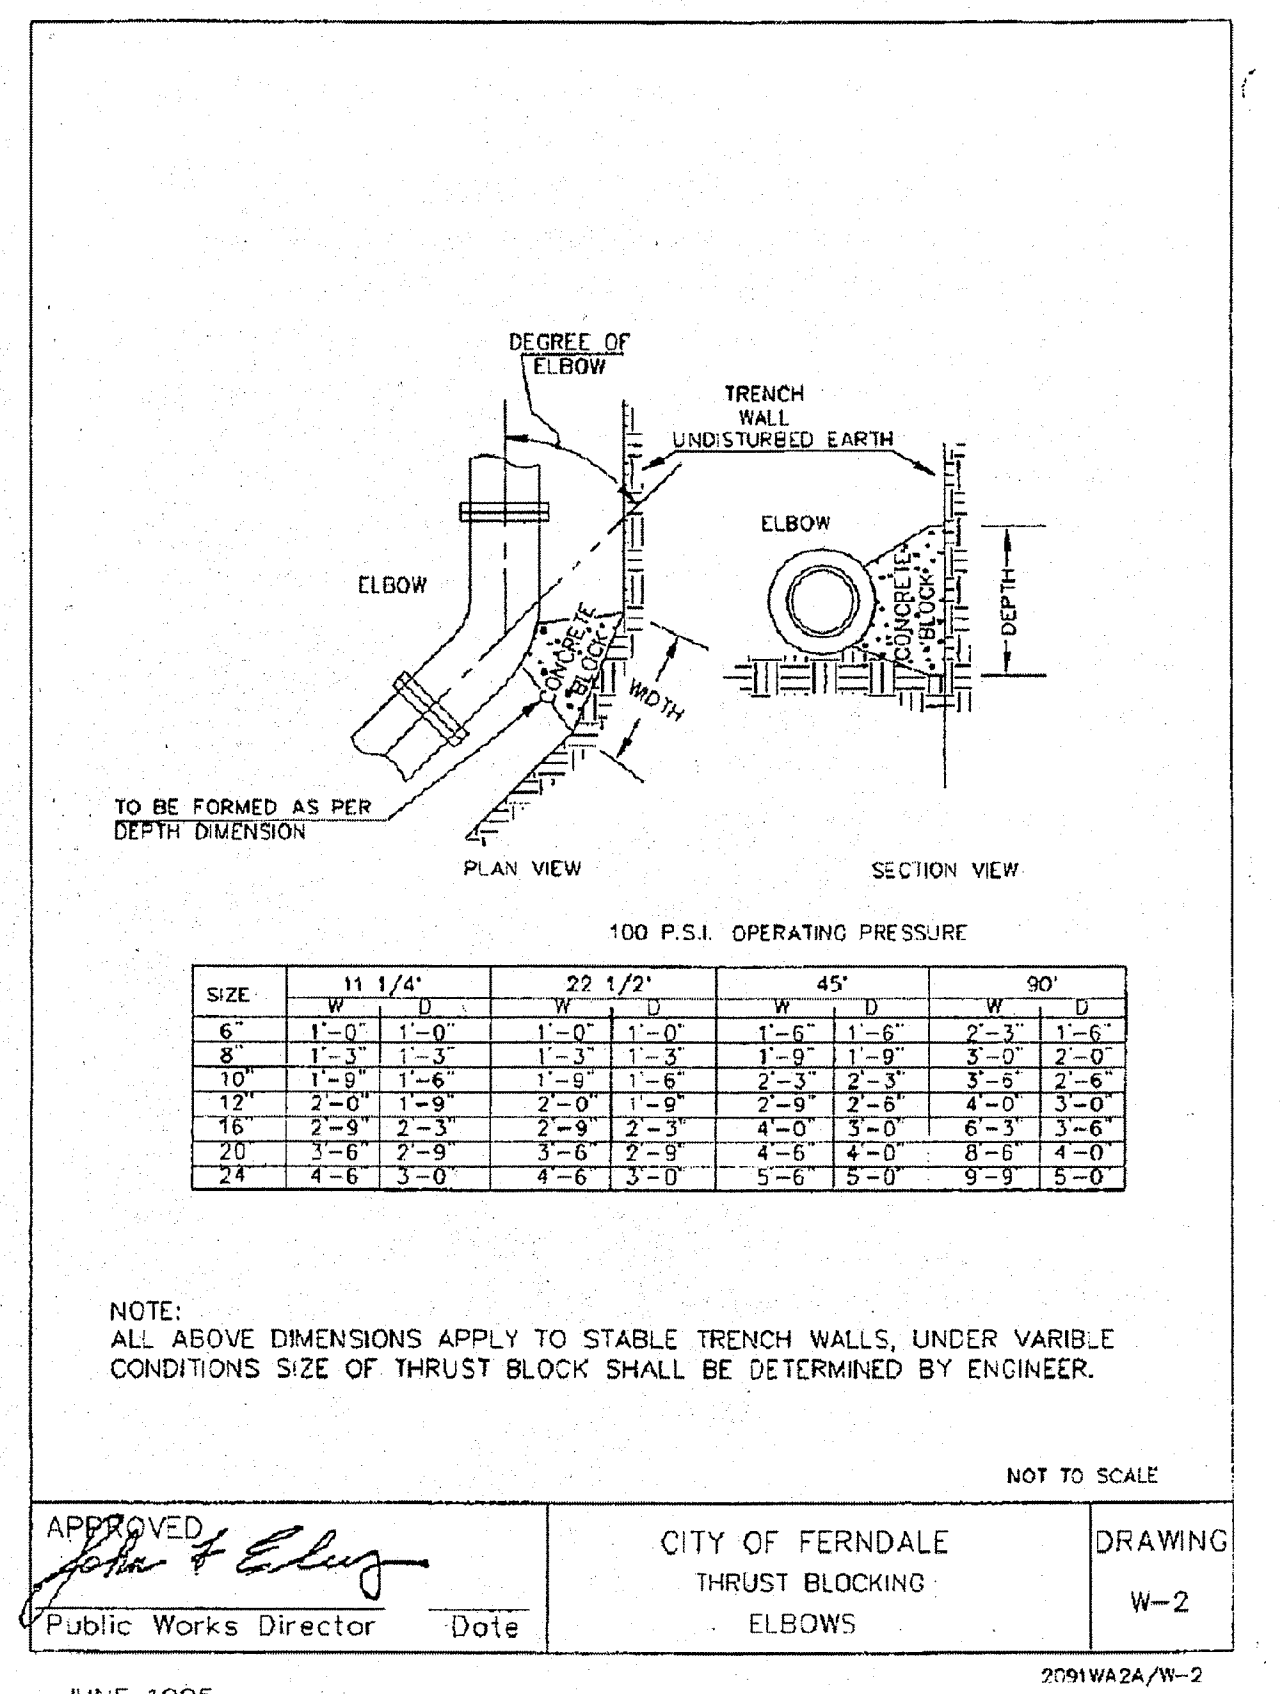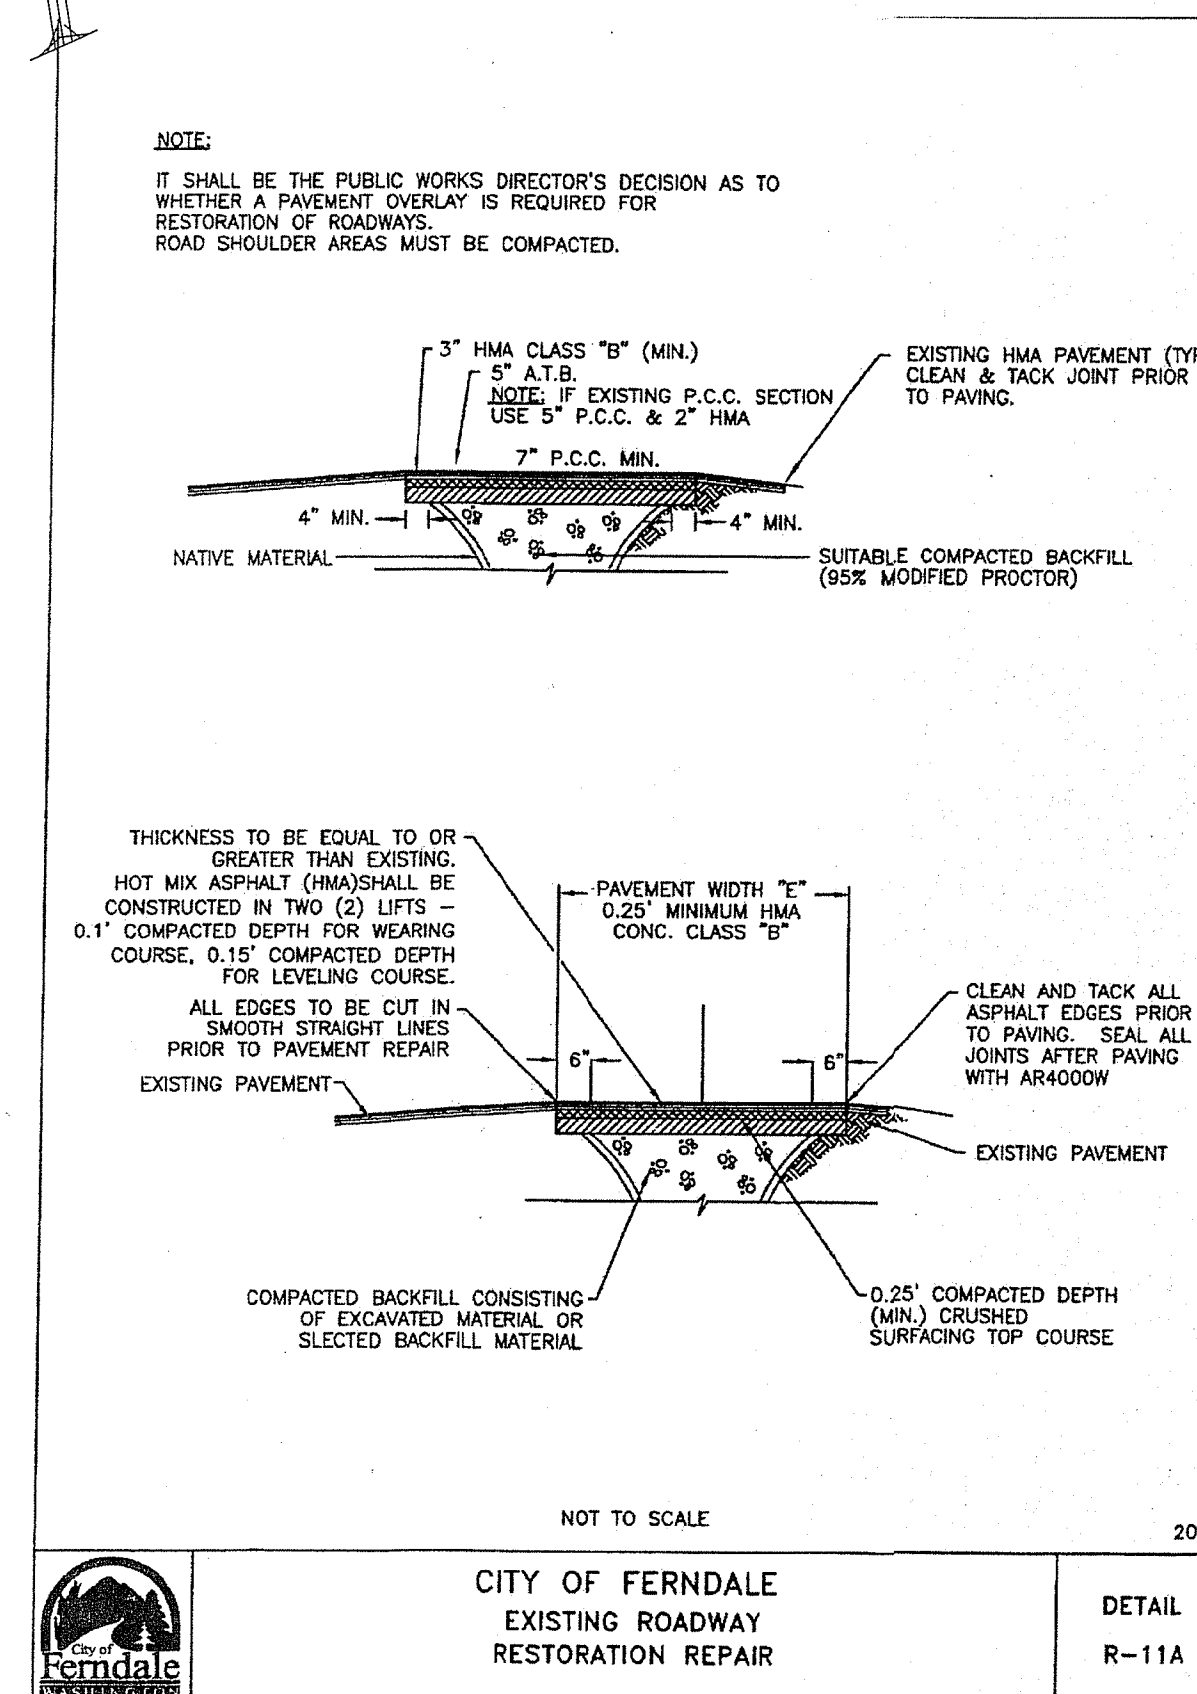

BASS STREET WATERLINE EXTENSION

JOB # 13027

FOR: CITY OF FERNDAL

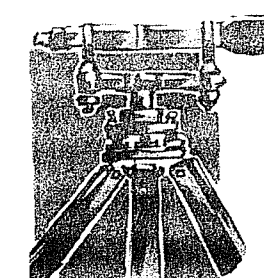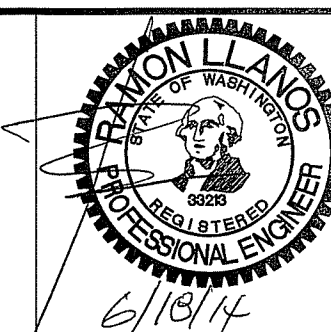

LDES, INC.
5160 INDUSTRIAL PL. #108
FERNDAL, WA 98248
PHONE 360-383-0620
FAX 360-383-0639

DETAILS
AS BUILT
BASS STREET, FERNDAL WA

REVISIONS

SR	DATE	DESCRIPTION
02-06-14	SUBMITTAL	
05/30/14	SUBMITTAL No. 2	

SHEET

3

OF

03