


ASSOCIATED PROJECT CONSULTANTS, INC.

NOOKSACK RIVER WATERLINE CROSSING

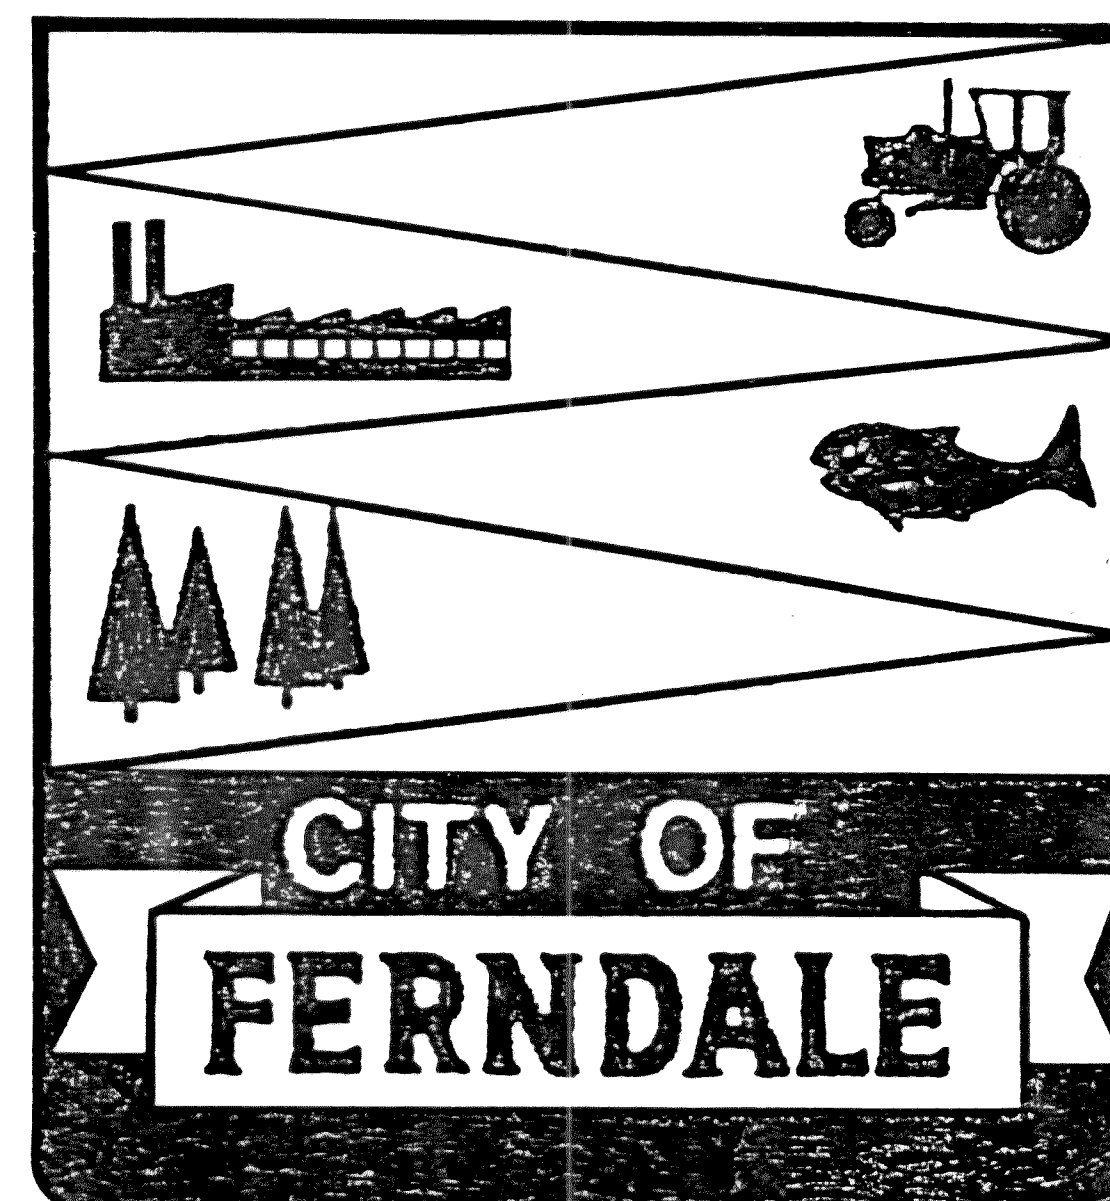

CITY MANAGER: RON PETERSON


PUBLIC WORKS DIRECTOR: JOHN ELEY

CONSULTING ENGINEER: DOUGLAS N. CAMPBELL, P.E.



RECORD DRAWING






117762

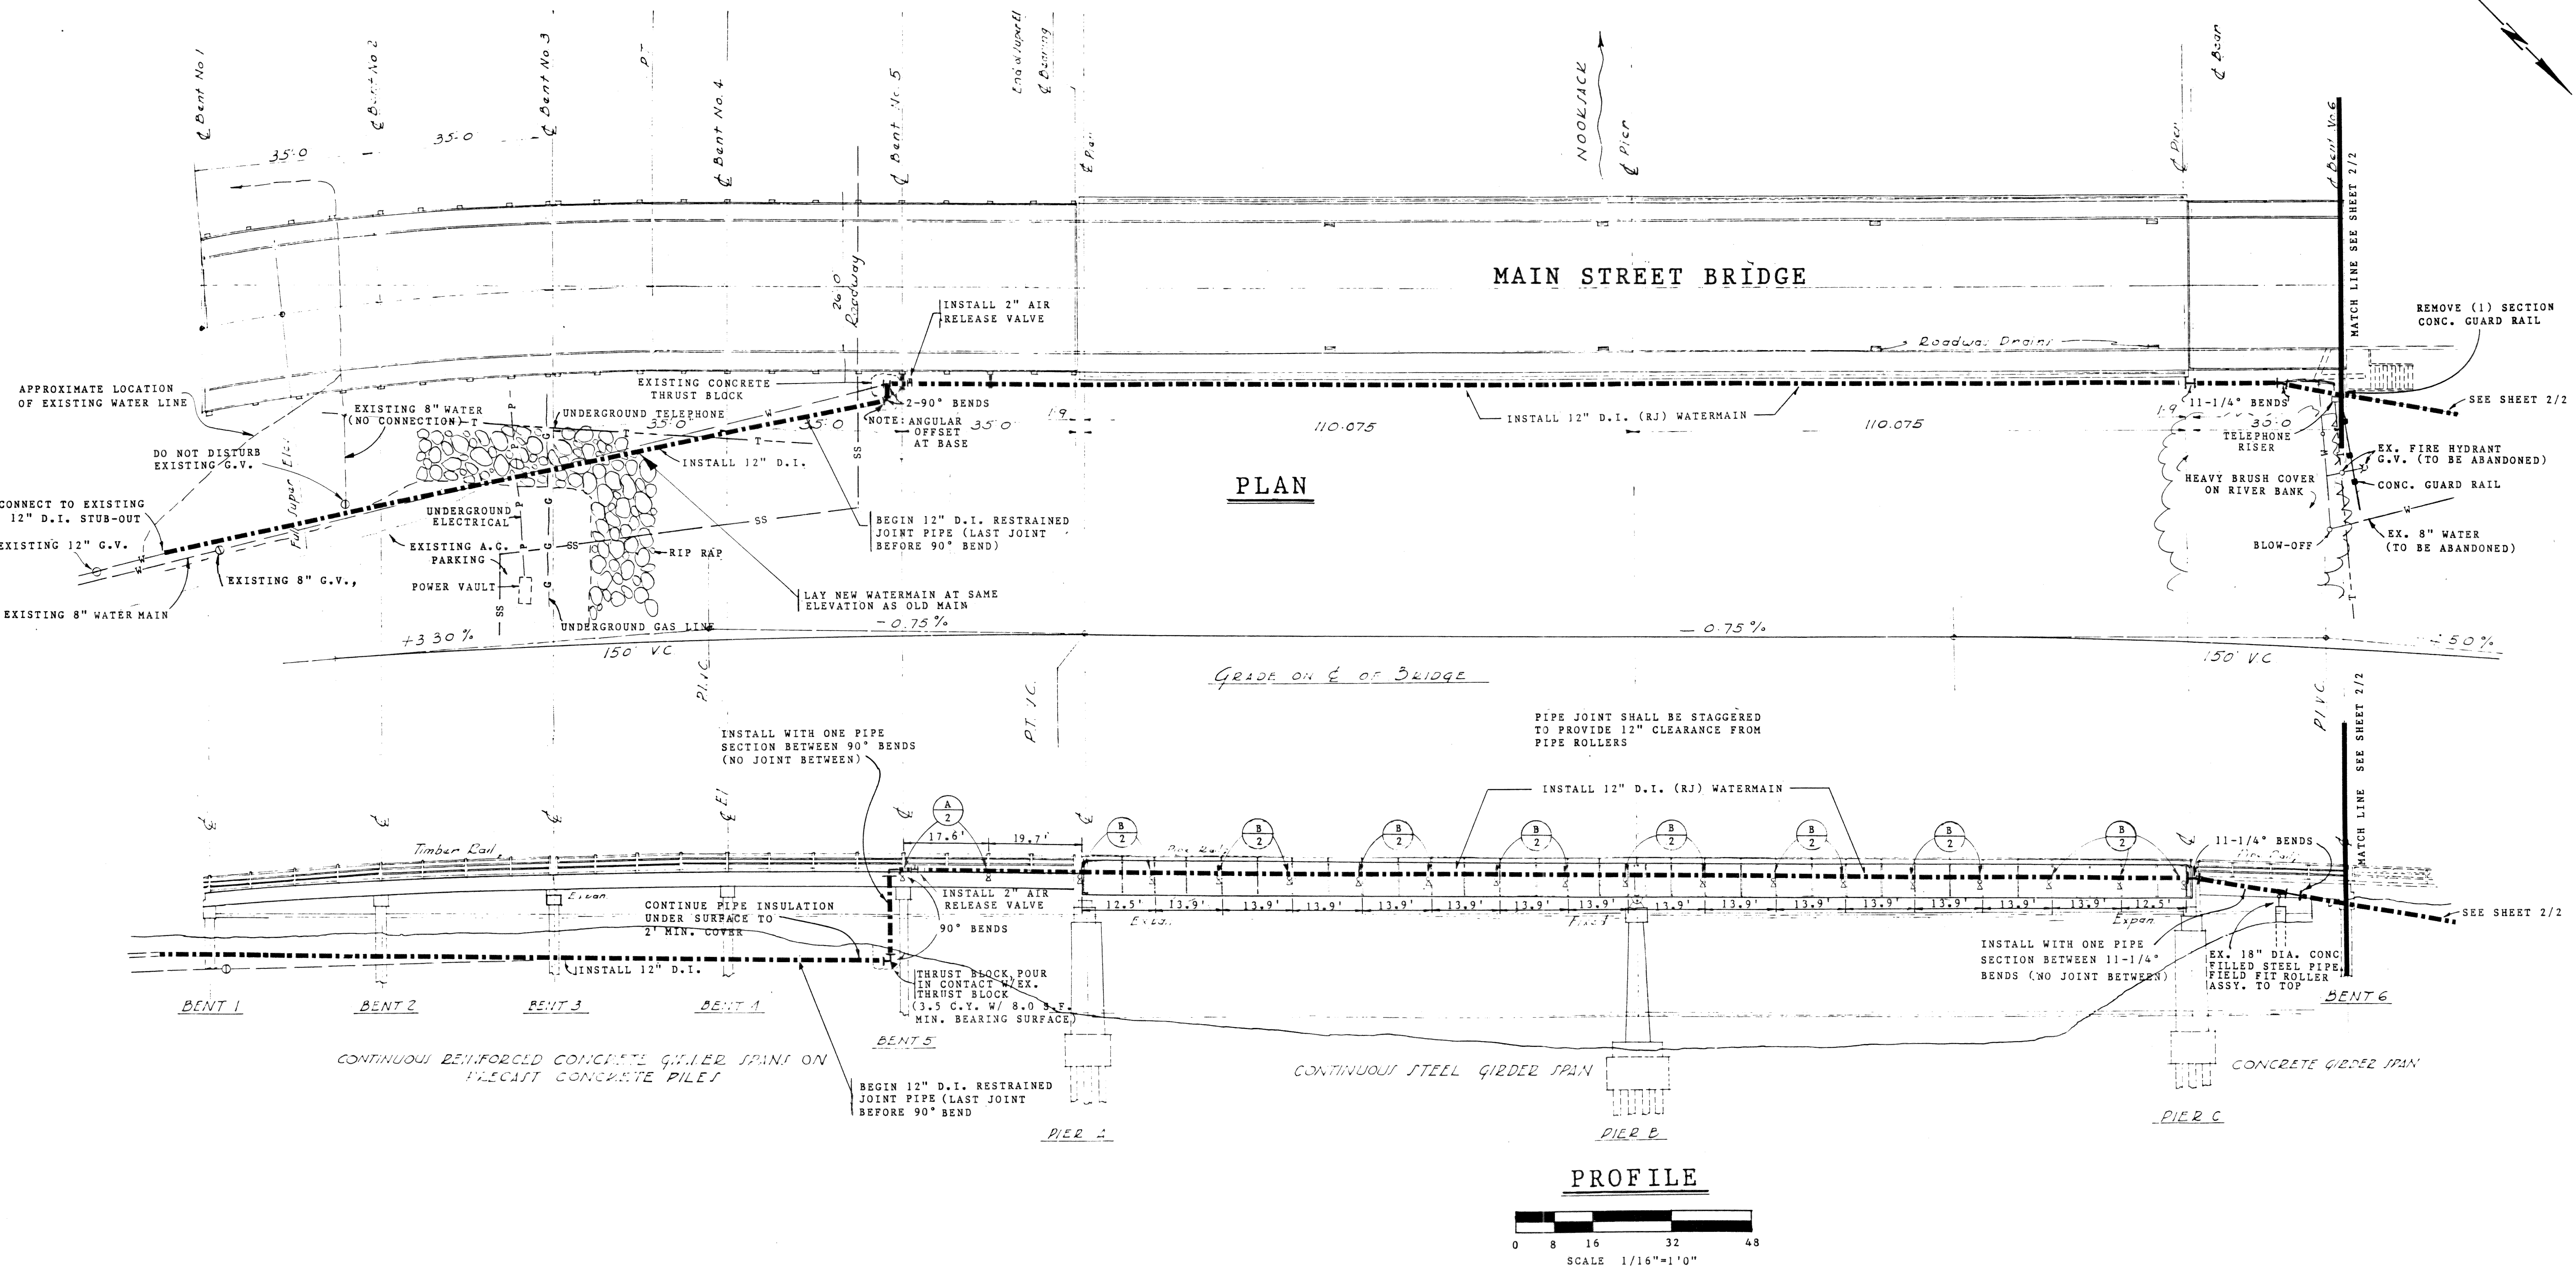

RECORD DRAWING

REVISIONS					Drwn. by	Date	Chkd. by	Date	APPROVED FOR CONSTRUCTION:		Seal	Seal	REFERENCES		Drawn by: CL/MB Date: JUNE, 1988		Client: CITY OF FERNDAL	JOB NO. 88-127
1									Title: J. F. Elling				Field Bk.	Page	Checked by: DNC Date: JUNE, 1988	Project: NOOKSACK RIVER WATERLINE CROSSING		
2									APPROVED FOR DESIGN:				J. F. Elling	Title: J. F. Elling			R. O. S.	
3											A. F.				ASSOCIATED PROJECT CONSULTANTS, INC.		Datum:	
4													1401 ASTOR STREET, BELLINGHAM, WA 98225 — 671-1146 366 MARTIN STREET, BOX 1697, BLAINE, WA 98230 — 332-5825					
5																		

002103.002 2.2.06 K2

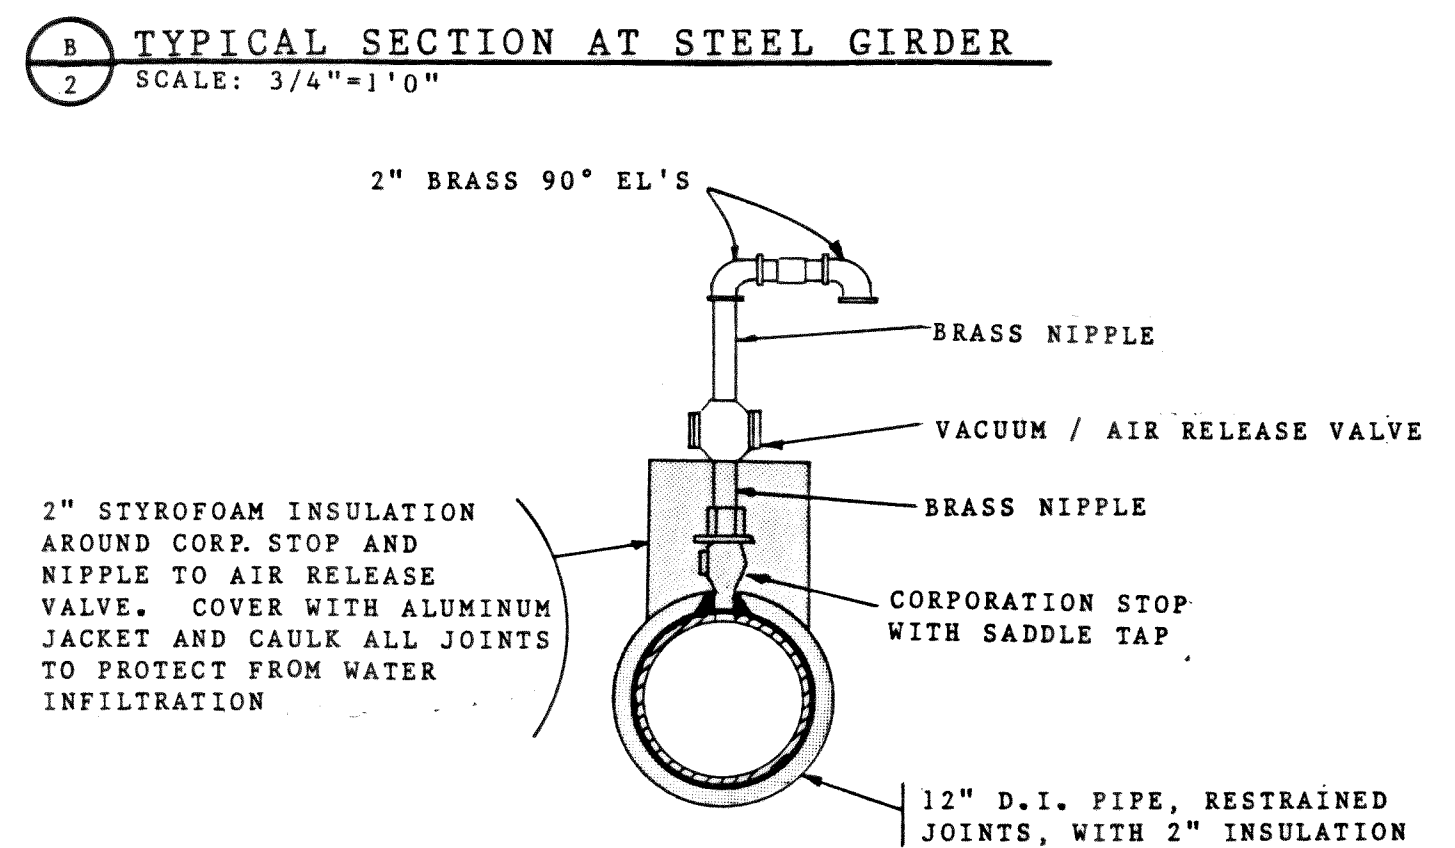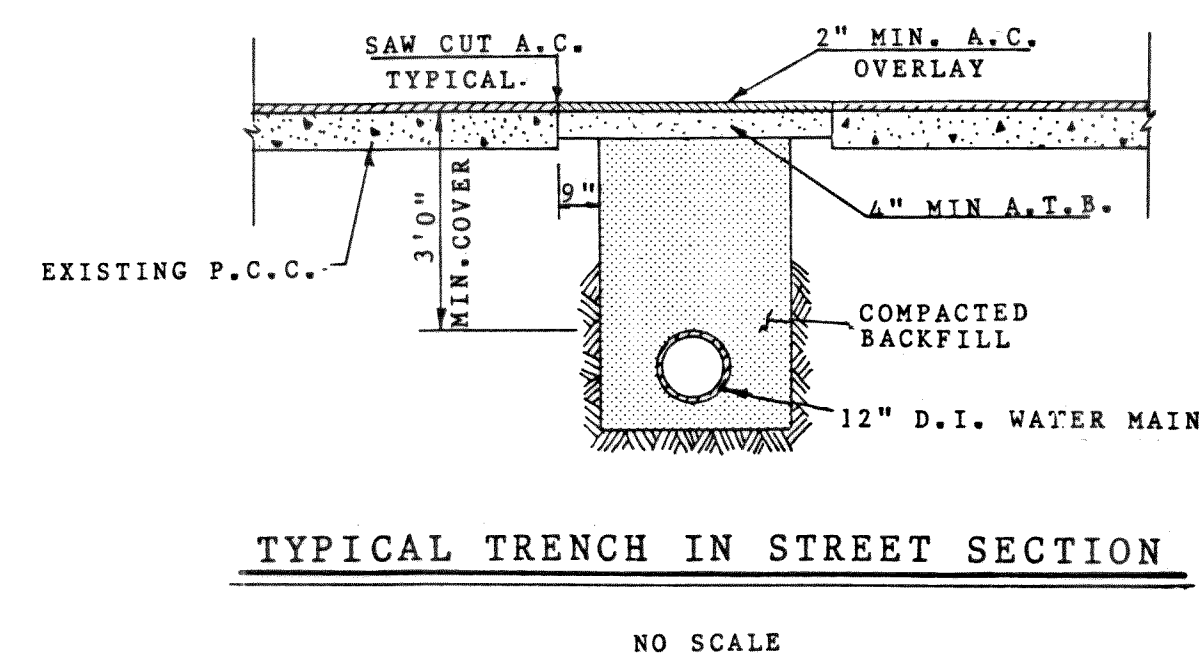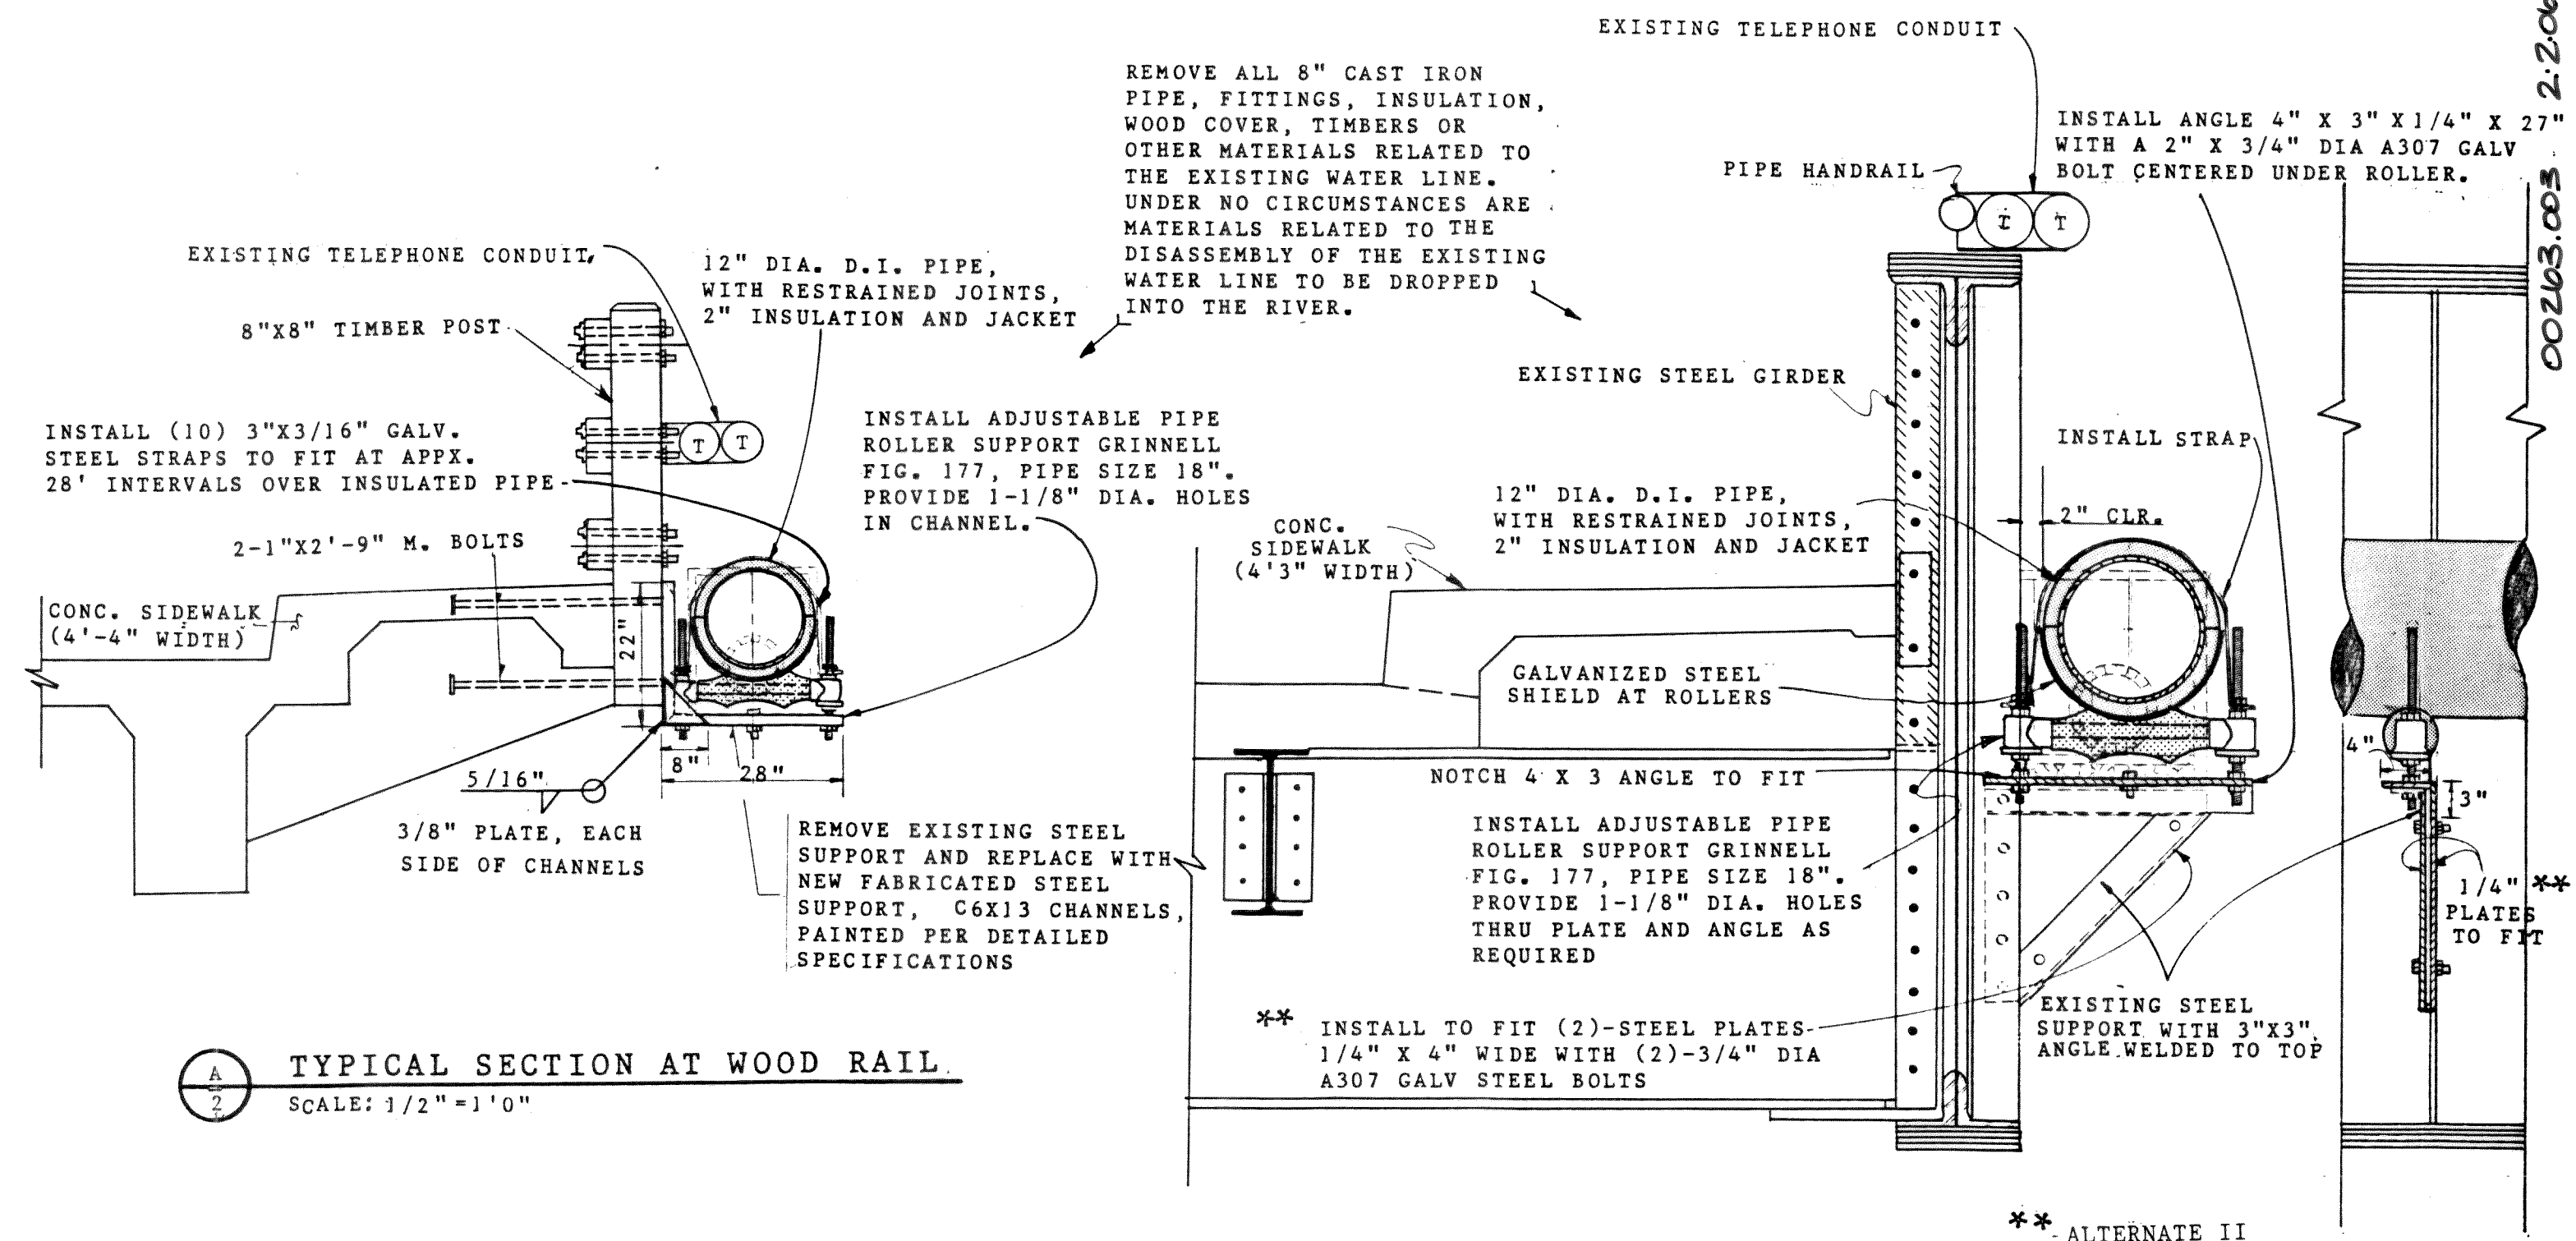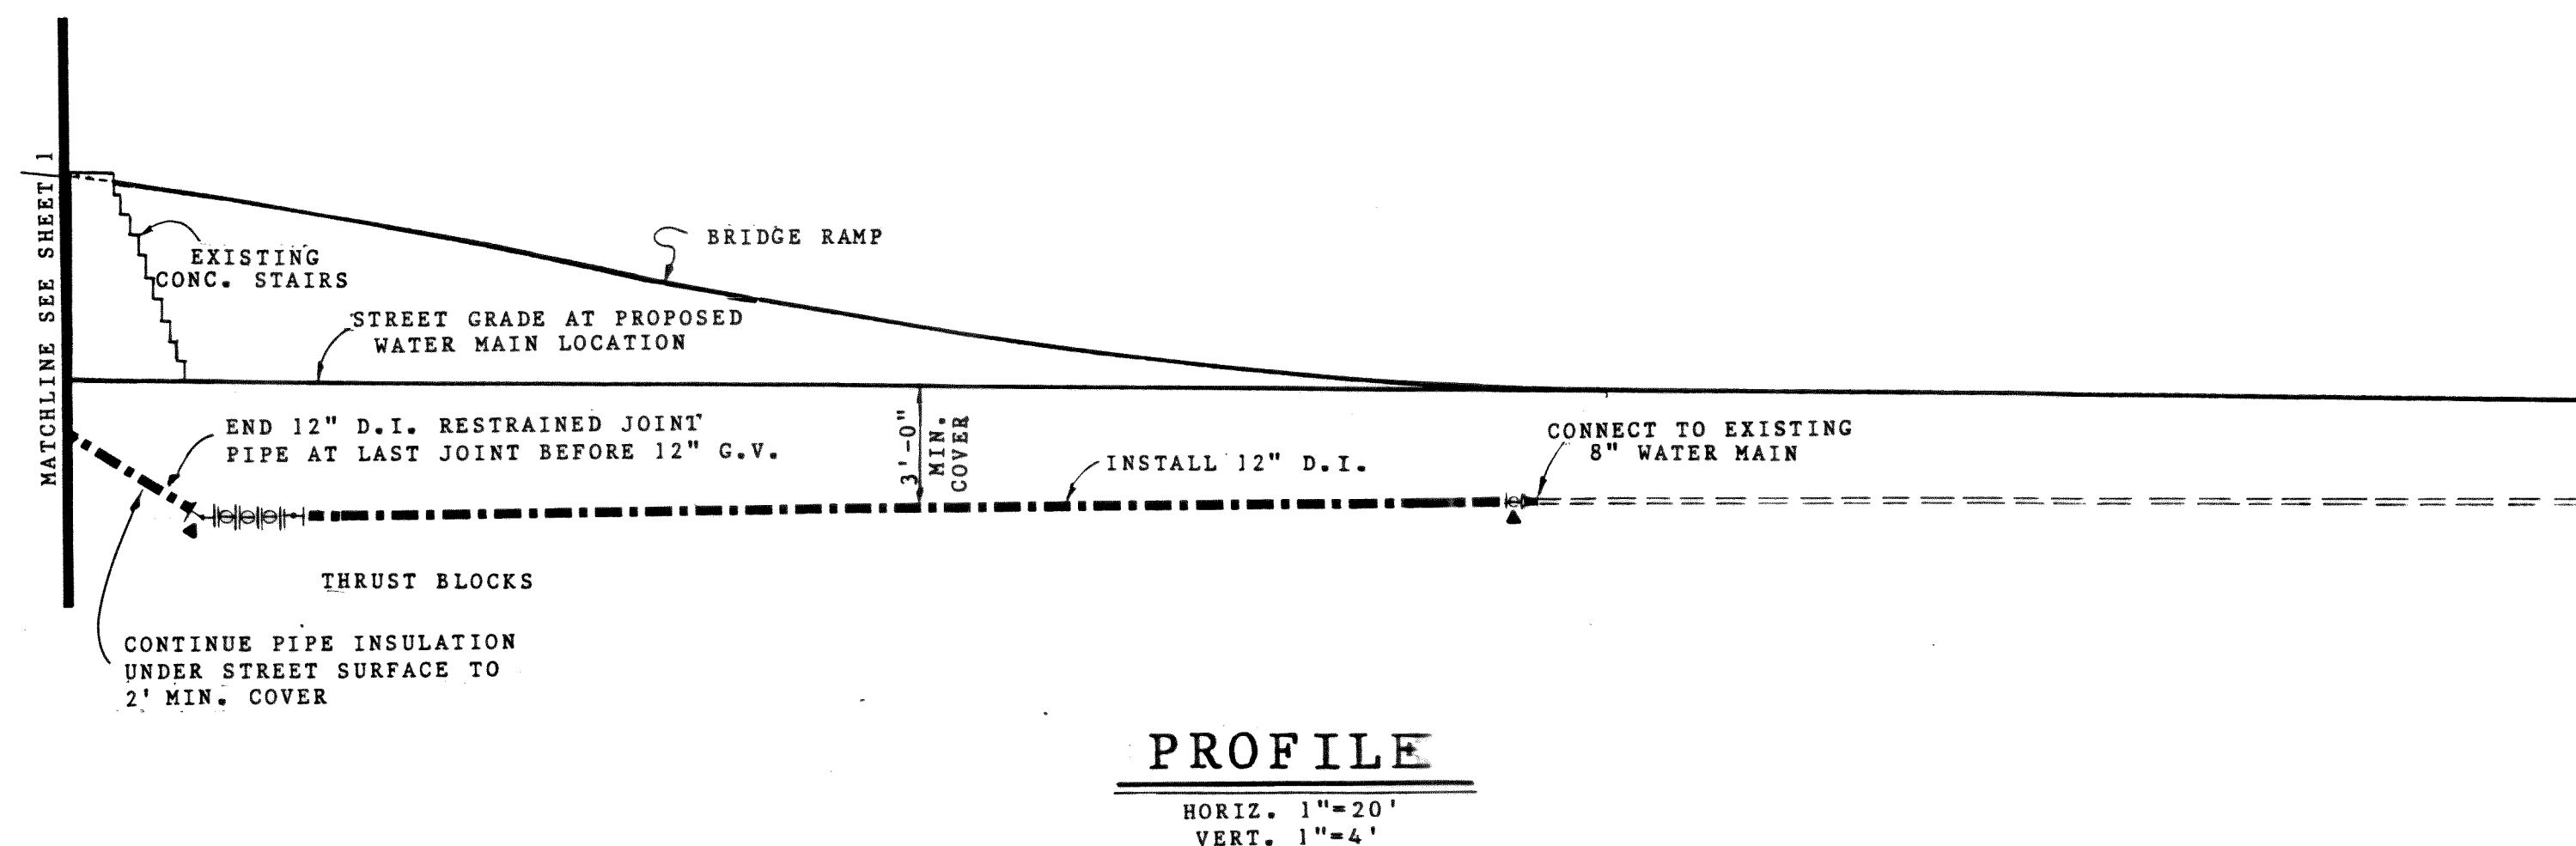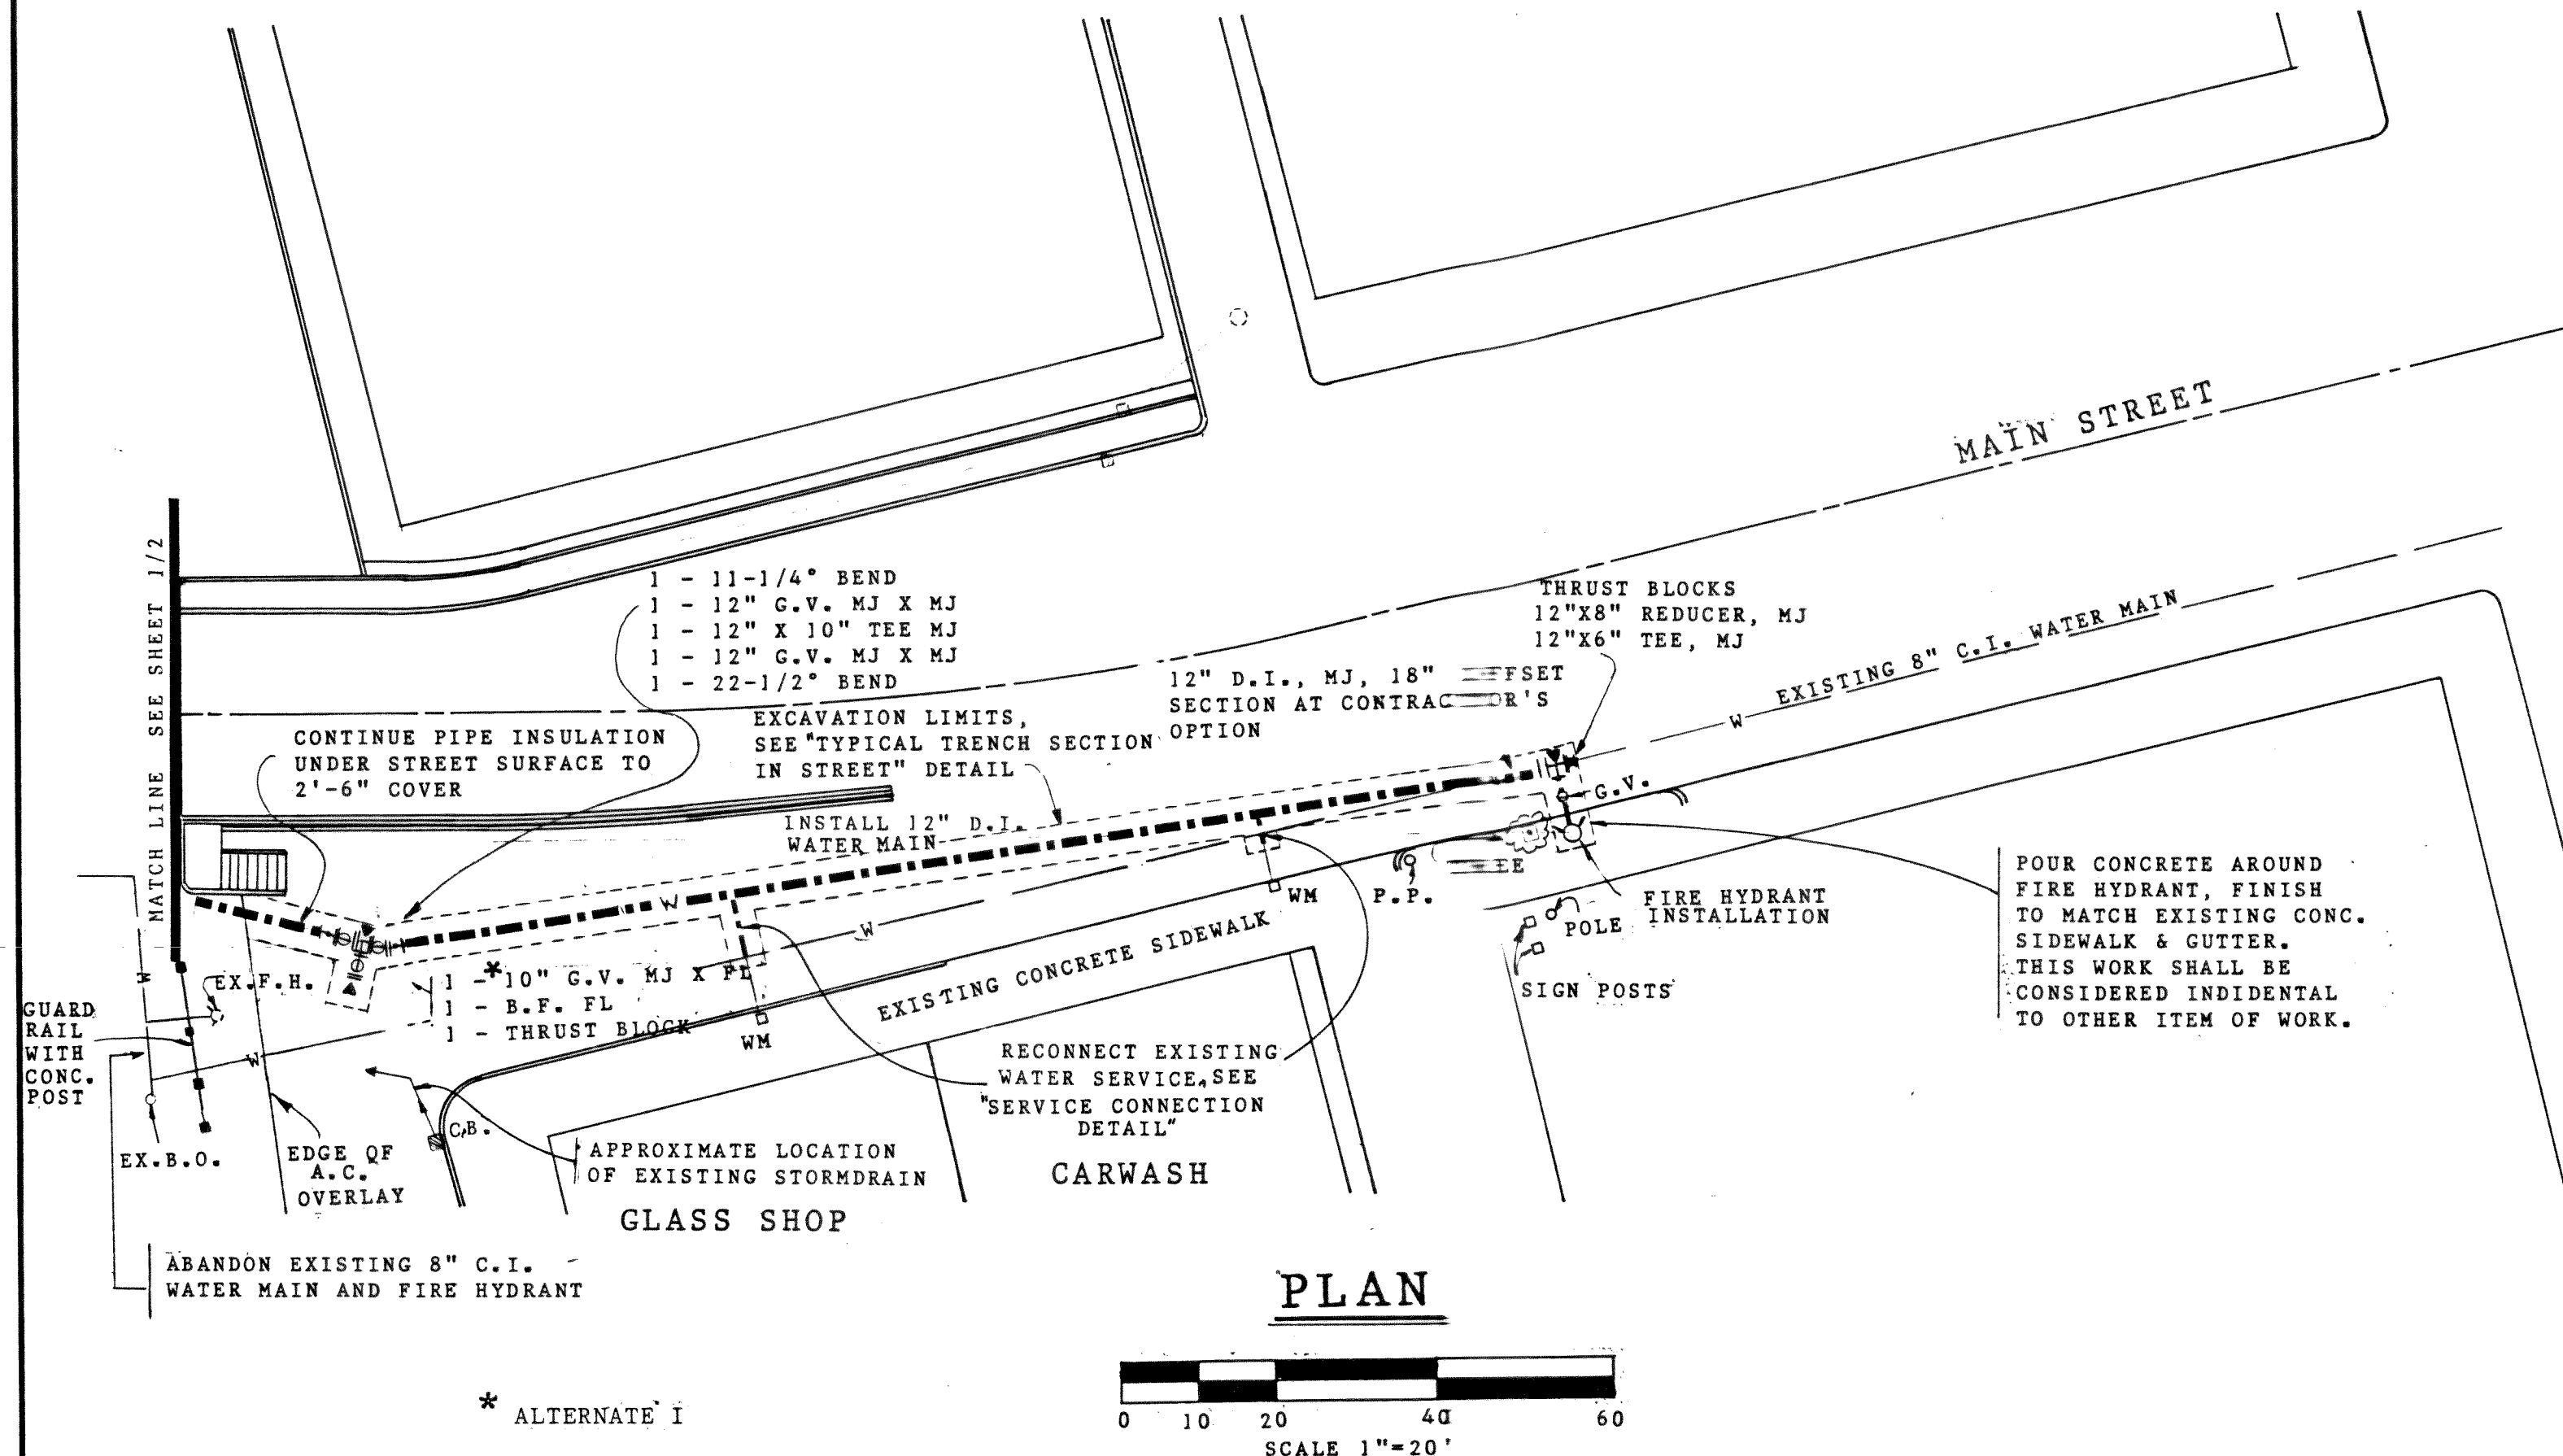


GENERAL NOTES

- All workmanship and materials shall conform to applicable provisions of the "1988 Standard Specifications for Road, Bridge, and Municipal Construction", DOT/APWA, and shall comply with the Detailed Specifications contained within the Contract Documents.
- The Contractor is cautioned that underground utilities do exist in the construction area which may interfere with excavation. The Contractor shall make every effort to locate the utilities ahead of the excavation and shall be responsible for their maintenance and protection during his operation.

Public and private utilities shall be moved by the owning companies. The Contractor shall conform to Section 1-07.17 of the Standard Specifications.

Any delay or rescheduling of the Contractor's work caused by the relocation of any utilities shall be considered as incidental to construction and no additional compensation shall be allowed therefor.
- Inspection by the City of Ferndale's consulting Engineer shall be required whenever any work other than maintenance of the Contractor's equipment is being done. Inspection shall be provided at no cost to the Contractor.

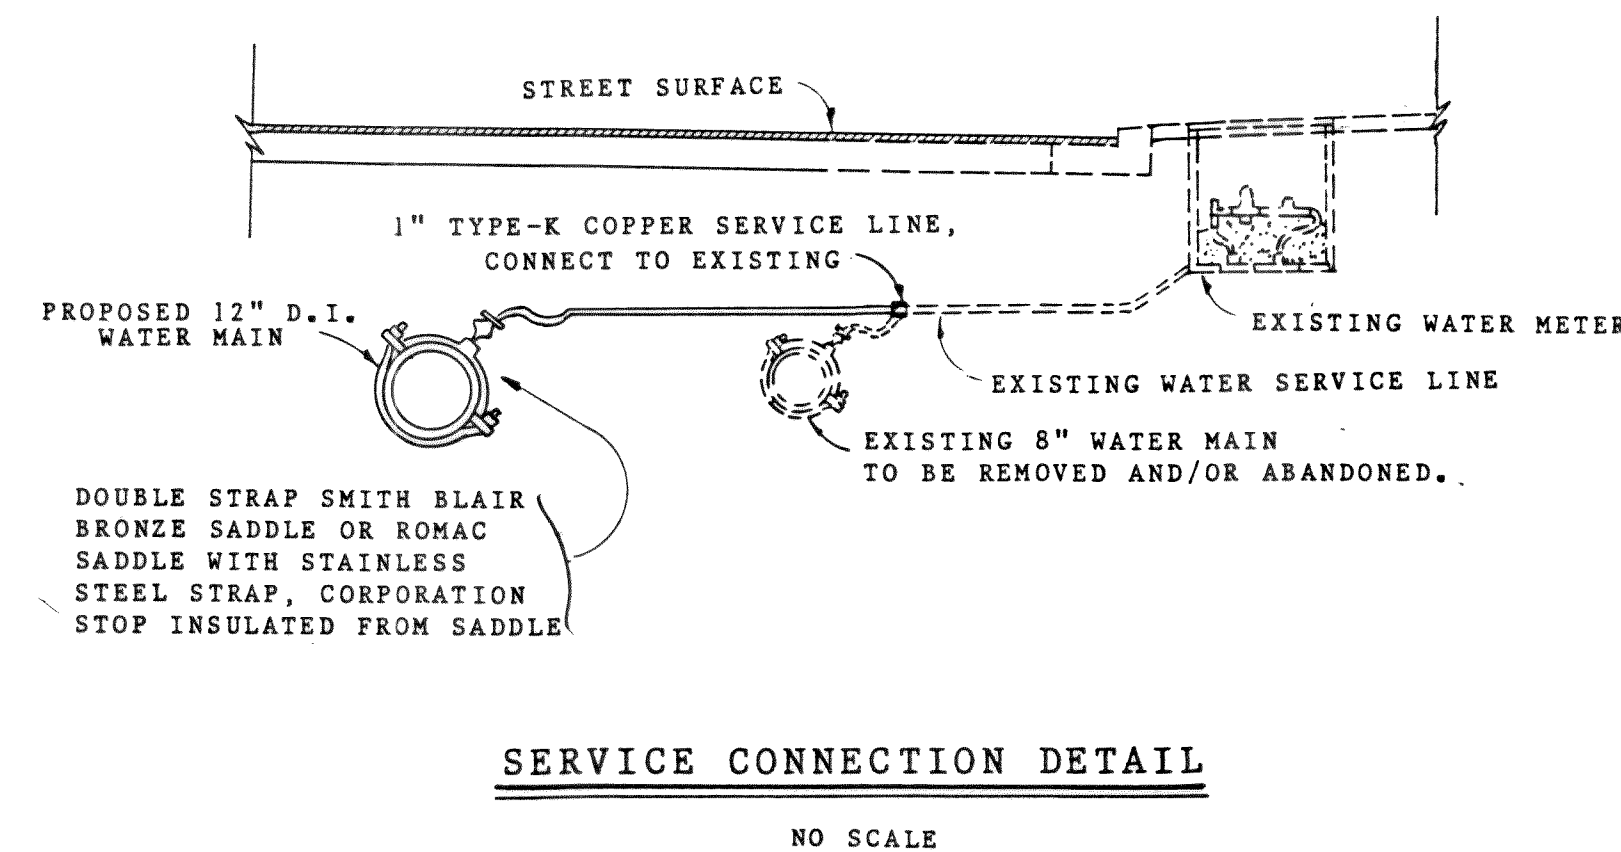

RECORD DRAWING

REVISIONS 1 2 3 4 5				Drwn. by Date Chkd. by Date	APPROVED FOR CONSTRUCTION: Title: APPROVED FOR DESIGN: Title:	Seal Seal	REFERENCES Field Bk. Page R.O.S. A.F.	ASSOCIATED PROJECT CONSULTANTS, INC. 1401 ASTOR STREET, BELLINGHAM, WA 98225 - 671-1146 366 MARTIN STREET, BOX 1697, BLAINE, WA 98230 - 332-5825		Drawn by: PT, MB Date: JUNE, 1988 Checked by: DNC Date: JUNE, 1988 H. Scale: 1"=1' ABOVE V. Scale: 1"=4' ABOVE Datum:	Client: CITY OF FERNDALE Project: NOOKSACK RIVER WATERLINE CROSSING Title: PLAN-PROFILE/DETAILS	JOB NO. 88-127 DRAWING NO. 2 OF 2
---	--	--	--	--------------------------------------	--	--------------	--	---	--	---	---	---