
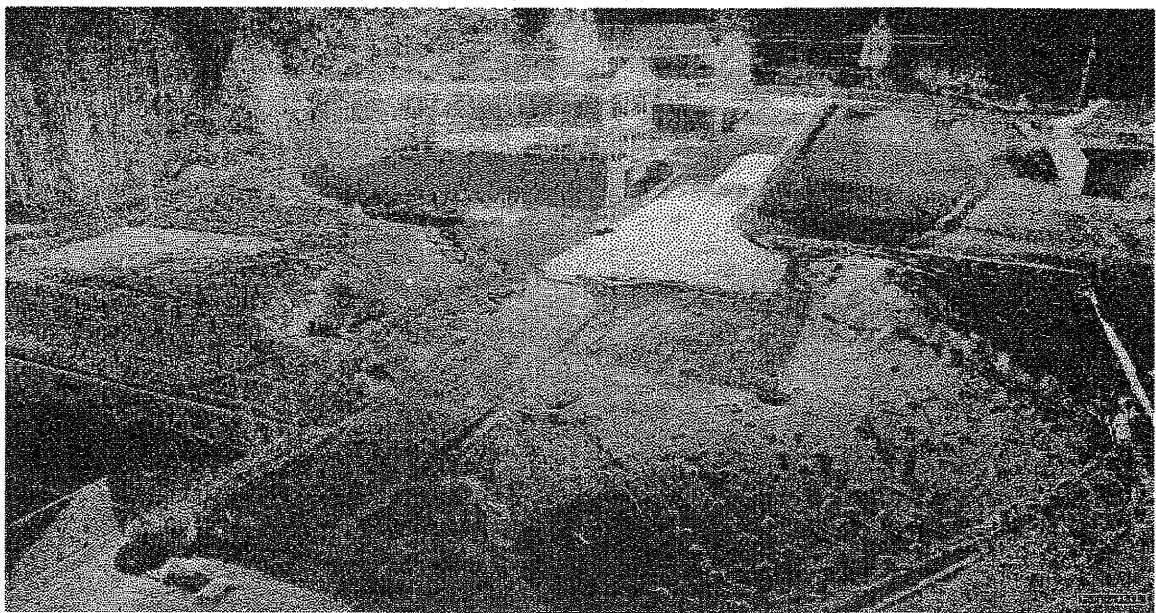


A PORTION OF THE NW 1/4 OF THE NW 1/4  
OF SECTION 30, TOWNSHIP 39 NORTH, RANGE 2 EAST OF W.M.  
CITY OF FERNDAL, WHATCOM COUNTY, WASHINGTON

# DRAKE RIDGE DEVELOPMENT: PHASE 2 AS-BUILT DRAWINGS

## INDEX SHEET

- COVER SHEET
- EXISTING CONDITIONS
- EROSION CONTROL PLAN
- GRADING PLAN
- STORM DRAINAGE PLAN & PROFILE
- STORM STANDARD DETAILS
- SANITARY SEWER & WATER DISTRIBUTION PLAN AND PROFILE
- SANITARY SEWER AND WATER STANDARD DETAILS
- COMPOSITE UTILITY PLAN
- CITY OF FERNDAL CONSTRUCTION NOTES

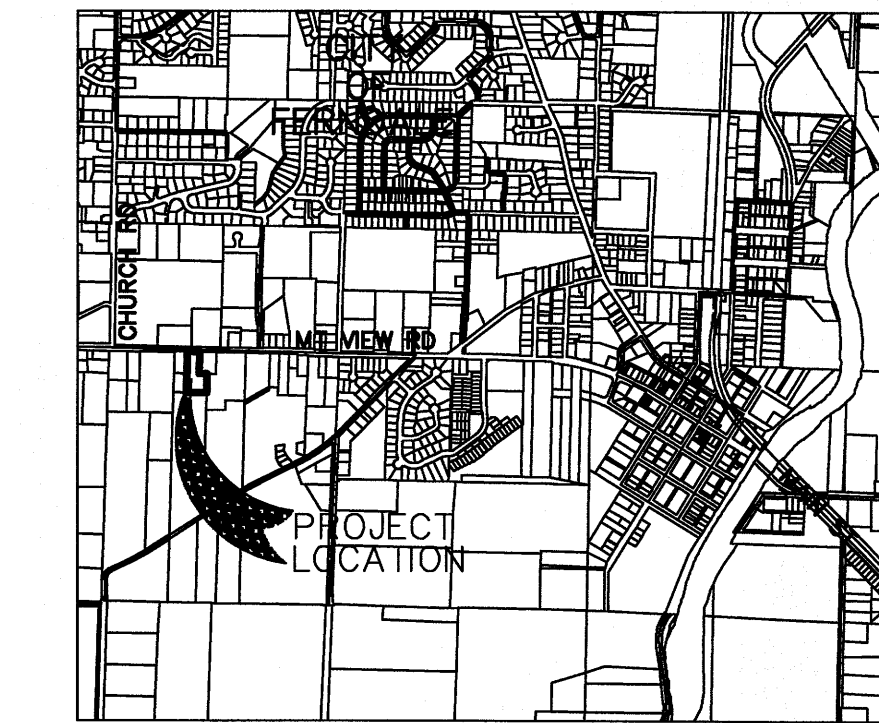

3D LASER SCANNING ISOMETRIC VIEW  
COURTESY OF SUMMIT ENGINEERING AND DESIGN, LLC

## EXISTING LEGEND:

●	= PROPERTY CORNER PER RECORD	—OP—OP—	= EXIST OVERHEAD POWER
□	= EXIST SD CATCH BASIN (TYPE I)	—P—P—	= EXIST UNDERGROUND POWER
△	= EXIST SANITARY SEWER SERVICE	—G—G—	= EXIST GAS MAIN
○	= EXISTING SEWER MANHOLE	—W—W—	= EXIST WATER LINE
○	= EXISTING WATER METER BOX	—S—S—	= EXIST WATER SERVICE
○	= EXISTING WATER VALVE	—SB—SB—	= EXIST SANITARY SEWER LINE
○	= EXISTING FIRE HYDRANT	—FK—FK—	= EXIST SANITARY SEWER FORCE MAIN
○	= EXIST POWER/AND OR UTILITY POLE	—D—D—	= EXIST STORM DRAIN LINE
○	= EXIST GUY POLE	—D12—D12—	= EXIST STORM DRAIN LINE
○	= EXIST GUY WIRE	—O—O—	= EXIST CHAIN LINK FENCE
○	= EXIST POWER METER/STRUCTURE	—X—X—	= EXIST BARBED WIRE FENCE
○	= EXIST POWER VAULT	—□—□—	= EXIST WOOD POST FENCE
○	= EXIST LIGHT POLE	—65—65—	= EXIST CONC. FENCE OR RET. WALL
○	= EXIST UTILITY POLE	—64—64—	= EXIST CONTOUR (INDEX)
○	= EXIST MAIL BOX	—	= EXIST CONTOUR (NORMAL)
○	= EXIST SIGN	—	= EXIST ROW CL
○	= EXIST BOLLARD	—	= EXIST ROW
○	= EXIST LANDSCAPING	—	= EXIST TOP OF DITCH
○	= EXIST ROAD PAVEMENT	—	= EXIST ROAD CL
○	= EXIST CONC. DRIVEWAY	—	= GUARD RAIL
		—	= EXISTING RET. WALL
		—	= EXISTING ON-SITE ROAD PAVEMENT
		—	= EXISTING ON-SITE SIDEWALK
		—	= EXISTING ON-SITE GRAVEL ACCESS RD

## PROPOSED LEGEND:

—O—O—	= SILT FENCE
—D6—D6—	= PROPOSED STORM DRAIN LINE, 6"
—D8—D8—	= PROPOSED STORM DRAIN LINE, 8"
—S6—S6—	= PROPOSED SANITARY SEWER, 6"
—FK—FK—	= PROPOSED SANITARY SEWER FORCEMAIN
—W—W—	= PROPOSED WATERLINE
—	= PROPOSED PAVEMENT
—	= PROPOSED GRAVEL ACCESS RD

[AB]	= AS-BUILT
BOW	= BACK OF WALK
BOW CO	= BACK OF WALK CLEAN OUT
BW	= BOTTOM OF WALL
COF	= CITY OF FERNDAL
C	= CENTERLINE
CONC	= CONCRETE
CPDP	= CORRUGATED PLASTIC DRAIN PIPE
DI	= DUCTILE IRON
DOE	= DEPARTMENT OF ECOLOGY
DTL	= DETAIL
EG	= EXISTING GROUND
EL	= ELEVATION
EXST	= EXISTING
FF	= FINISH FLOOR
FG	= FINISH GROUND
FM	= FORCE MAIN
FND	= FOUND
G.V.	= GATE VALVE
HYD	= FIRE HYDRANT
IE	= INVERT ELEVATION
LF	= LINEAR FEET
LT	= LEFT
OHWM	= ORDINARY HIGH WATER MARK
PERF	= PERFORATED PIPE
PERM.	= PERMANENT
PRP	= PROPOSED
PVC	= POLYVINYL CHLORIDE PIPE
RD	= ROAD
RT	= RIGHT
RY	= ROOF AND YARD
SD	= STORM DRAIN
SS	= SANITARY SEWER
SSCO	= SANITARY SEWER CLEAN OUT
SSQ	= SQUARE FEET
SSMH	= SANITARY SEWER MANHOLE
STA	= STATION
TA	= TOP OF ASPHALT
TC	= TOP OF CONCRETE
TEMP.	= TEMPORARY
TW	= TOP OF WALL
WA	= WATER

CALL 2 BUSINESS DAYS BEFORE YOU DIG  
1-800-424-5555  
UTILITIES UNDERGROUND LOCATION CENTER

OWNER APPLICANT  
LEWIS AND YORK, LLC  
1292 W. AXTON RD  
FERNDAL, WA 98248  
(360) 201-9675

ENGINEER  
LDES, INC.  
5160 INDUSTRIAL PL #108  
FERNDAL, WA 98248  
CONTACT: RAMON LLANOS, P.E.  
(360) 383-0620

SURVEYOR  
LDES, INC.  
5160 INDUSTRIAL PL #108  
FERNDAL, WA 98248  
CONTACT: KYLE HAGGITH, P.L.S.  
(360) 383-0620

## SURVEYOR'S NOTES

- DATA FOR THIS SURVEY WAS GATHERED BY FIELD TRAVERSE UTILIZING ELECTRONIC DATA COLLECTION ON OR ABOUT MARCH-APRIL, 2010
- EQUIPMENT USED: NIKON DTS22: 00'01.5" ± 2 PPM, ± 2 MM
- THE PURPOSE OF THIS SURVEY IS TO SHOW AS-BUILT CONDITIONS AND NOT INTENDED FOR BOUNDARY SURVEY.
- THIS SURVEY WAS PERFORMED WITHOUT BENEFIT OF A CURRENT TITLE REPORT AND LAND DEVELOPMENT ENGINEERING & SURVEYING IS NOT RESPONSIBLE FOR ANY EASEMENTS, COVENANTS, RESERVATIONS OR RESTRICTIONS THAT MAY EXIST.
- LAND DEVELOPMENT ENGINEERING & SURVEYING ASSUMES NO LIABILITY FOR SUBSURFACE UTILITY LOCATES.

HORIZONTAL AND VERTICAL DATUM  
BENCHMARK: CITY OF FERNDAL CONTROL POINT # 7  
DATUM: CITY OF FERNDAL SURVEY MONUMENT NETWORK JUNE, 2001  
VERTICAL: NAVD83  
HORIZONTAL: NAD-83/91  
ELEVATION: 147.15

## LEGAL DESCRIPTION

LOTS A, B, AND C, AS DELINEATED ON "AMENDED MT. VIEW LOT LINE ADJUSTMENT," ACCORDING TO THE PLAT THEREOF, RECORDED UNDER WHATCOM COUNTY AUDITOR'S FILE NO. 2090701331

WASHINGTON STATE

NOTE:  
BOUNDARY DERIVED FROM PACIFIC SURVEYING AND ENGINEERING, INC "MT. VIEW LOT LINE ADJUSTMENT" AF No. 2090701331.

## PROJECT SUMMARY

LEGAL DESCRIPTION	SEE LEGAL DESCRIPTION THIS SHEET
ASSESSOR'S PARCEL #	390230 089531
SITE ADDRESS	2407, 2409 MAIN ST, RESPECTIVELY
SITE AREA	38,916 SF
LOT COVERAGE	73% (DESIGN - INCLUDING EX POND)
IMPERMEABLE SURFACE AREA	28,406 SF (DESIGN - INCLUDING EX POND)
# OF BUILDINGS	2 BUILDINGS
GROSS FLOOR AREA	
BUILDING HEIGHT	
# OF PARKING	
CITY ZONING	RO

## ENGINEER'S CERTIFICATION

I HEREBY CERTIFY THAT THE IMPROVEMENTS IN "DRAKE RIDGE DEVELOPMENT: PHASE 2" HAVE BEEN INSPECTED BY LDES AND TO THE BEST OF MY KNOWLEDGE, HAVE BEEN CONSTRUCTED IN CONFORMANCE WITH THE CITY OF FERNDAL DEVELOPMENT STANDARDS, THE CITY OF FERNDAL MUNICIPAL CODE, AND SUBSEQUENT STANDARDS ADOPTED BY REFERENCE THEREIN AND STANDARD ENGINEERING PRACTICE.



1/9/18  
RAMON LLANOS, P.E.

SURVEYOR'S CERTIFICATION  
I CERTIFY THAT THE LOCATIONS, ELEVATIONS, DEPTHS, AND AS-BUILT COMMENTS REFLECTING MATERIALS ACTUALLY USED DURING CONSTRUCTION ACCURATELY REFLECT EXISTING FIELD CONDITIONS AS DETERMINED BY ME OR UNDER MY DIRECT SUPERVISION ON THIS DATE: 1/9/18

1/9/18  
KYLE HAGGITH, P.L.S.



AS-BUILT SUBMITTAL 1	HJ	9/29/17
AS-BUILT SUBMITTAL 2	HJ/EH	01/03/18
AS-BUILT SUBMITTAL 3	YC	01/09/18
NO.	REVISION	BY DATE

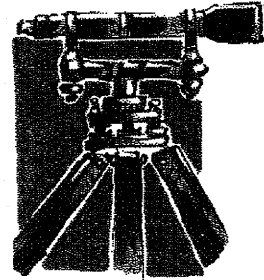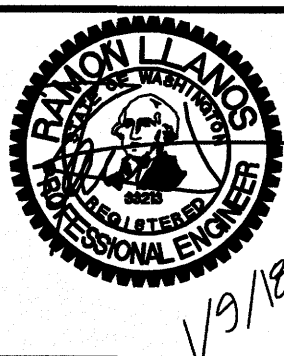

LDES, INC.  
5160 INDUSTRIAL PL. #108  
FERNDAL, WA 98248  
PHONE 360-383-0620  
FAX 360-383-0639

JOB NO.:	6022
DWG. NAME:	6022-CIVIL-ph2-2017-AB.dwg
DESIGNED BY:	RL
DRAWN BY:	EH
CHECKED BY:	RL

LEWIS AND YORK, LLC  
1292 W. AXTON RD  
FERNDAL, WA 98248

APPROVED

JAN 11 2018

CITY OF FERNDAL  
PUBLIC WORKS DEPARTMENT

## COVER SHEET

DRAKE RIDGE DEVELOPMENT: PHASE 2  
MAIN STREET, FERNDAL, WA

SHEET

01

OF

08

AS-BUILT DRAWING









B:\Common\Land Projects\2008\6022-Civil-ph2-2017-AB.dwg PLOT DATE: 1/9/2018 5:09 PM

CITY OF FERNDALE TESC NOTES:

1. STABILIZATION & SEDIMENT TRAPPING. ALL EXPOSED SOILS SHALL BE STABILIZED BY SUITABLE APPLICATION OF BMP'S. FROM OCTOBER 1 TO APRIL 30, NO SOILS SHALL REMAIN UNEXPOSED FOR MORE THAN 2 DAYS. FROM MAY 1 TO SEPTEMBER 30, NO SOILS SHALL REMAIN EXPOSED FOR MORE THAN 7 DAYS. PRIOR TO LEAVING THE SITE, STORMWATER RUNOFF SHALL PASS THROUGH A SEDIMENT POND, TRAP OR OTHER APPROPRIATE BMP.
2. DELINEATE CLEARING & EASEMENT LIMITS. IN THE FIELD, STAKE AND FLAG CLEARING LIMITS AND/OR ANY EASEMENTS, SETBACKS, SENSITIVE CRITICAL AREAS AND THEIR BUFFERS, TREES AND DRAINAGE COURSES.
3. PROTECTION OF ADJACENT PROPERTIES. PROPERTIES ADJACENT TO THE PROJECT SITE SHALL BE PROTECTED FROM SEDIMENT DEPOSITION.
4. TIMING & STABILIZATION OF SEDIMENT TRAPPING MEASURES. SEDIMENT PONDS AND TRAPS, PERIMETER DIKES, SEDIMENT BARRIERS, AND OTHER BMP'S INTENDED TO TRAP SEDIMENT ON-SITE SHALL BE CONSTRUCTED AS A FIRST STEP IN GRADING. THESE BMP'S SHALL BE FUNCTIONAL BEFORE LAND DISTURBING ACTIVITIES TAKE PLACE. EARTH STRUCTURES SUCH AS DAMS, DIKES AND DIVERSIONS SHALL BE SEEDED AND MULCHED ACCORDING TO THE TIMING INDICATED IN NO. 1 ABOVE.
5. CUT & FILL SLOPES. CUT AND FILL SLOPES SHALL BE DESIGNED AND CONSTRUCTED IN A MANNER THAT WILL MINIMIZE EROSION. IN ADDITION, SLOPES SHALL BE STABILIZED IN ACCORDANCE WITH NO. 1 ABOVE.
6. CONTROLLING OFF-SITE EROSION. PROPERTIES AND WATERWAYS DOWNSTREAM FROM THE DEVELOPMENT SITES SHALL BE PROTECTED FROM EROSION DUE TO INCREASES IN THE VOLUME, VELOCITY, AND PEAK FLOW RATE OF STORMWATER RUNOFF FROM THE PROJECT SITE.
7. STABILIZATION OF TEMPORARY CONVEYANCE CHANNELS & OUTLETS. ALL TEMPORARY ON-SITE CONVEYANCE CHANNELS SHALL BE DESIGNED, CONSTRUCTED AND STABILIZED TO PREVENT EROSION FROM THE EXPECTED VELOCITY OF FLOW FROM A 2-YEAR, 24-HOUR FREQUENCY STORM FOR THE DEVELOPED CONDITION. STABILIZATION ADEQUATE TO PREVENT EROSION OF OUTLETS, ADJACENT STREAM BANKS, SLOPES AND DOWNSTREAM REACHES SHALL BE PROVIDED AT THE OUTLETS OF ALL CONVEYANCE SYSTEMS.
8. STORM DRAIN INLET PROTECTION. ALL STORM DRAIN INLETS MADE OPERABLE DURING CONSTRUCTION SHALL BE PROTECTED SO THAT STORMWATER RUNOFF SHALL NOT ENTER THE CONVEYANCE SYSTEM WITHOUT FIRST BEING FILTERED OR OTHERWISE TREATED TO REMOVE SEDIMENT.
9. UNDERGROUND UTILITY CONSTRUCTION. THE CONSTRUCTION OF UNDERGROUND UTILITY LINES SHALL BE SUBJECT TO THE FOLLOWING CRITERIA: WHERE FEASIBLE, NO MORE THAN 500 FEET OF TRENCH SHALL BE OPENED AT ONE TIME; WHERE CONSISTENT WITH SAFETY AND SPACE CONSIDERATIONS, EXCAVATED MATERIAL SHALL BE PLACED ON THE UPHILL SIDE OF TRENCHES; AND TRENCH DEWATERING DEVICES SHALL DISCHARGE INTO A SEDIMENT TRAP OR SEDIMENT POND.
10. CONSTRUCTION ACCESS ROUTES. WHEREVER CONSTRUCTION VEHICLE ACCESS ROUTES INTERSECT PAVED ROADS, PROVISIONS MUST BE MADE TO MINIMIZE THE TRANSPORT OF SEDIMENT (MUD) ONTO THE PAVED ROAD. IF SEDIMENT IS TRANSPORTED ONTO A ROAD SURFACE, THE ROADS SHALL BE CLEANED THOROUGHLY AT THE END OF EACH DAY. SEDIMENT SHALL BE REMOVED FROM ROADS BY SHOVELING OR SWEEPING AND BE TRANSPORTED TO A CONTROLLED SEDIMENT DISPOSAL AREA. STREET WASHING SHALL BE ALLOWED ONLY AFTER SEDIMENT IS REMOVED IN THIS MANNER.
11. REMOVAL OF TEMPORARY BMP'S. ALL TEMPORARY EROSION AND SEDIMENT CONTROL BMP'S SHALL BE REMOVED WITHIN 30 DAYS AFTER FINAL SITE STABILIZATION IS ACHIEVED OR AFTER TEMPORARY BMP'S ARE NO LONGER NEEDED. TRAPPED SEDIMENT SHALL BE REMOVED OR STABILIZED ON SITE. DISTURBED SOIL AREAS RESULTING FROM REMOVAL SHALL BE PERMANENTLY STABILIZED.
12. DEWATERING CONSTRUCTION SITES. DEWATERING DEVICES SHALL DISCHARGE INTO A SEDIMENT TRAP OR SEDIMENT POND.
13. CONTROL OF POLLUTANTS OTHER THAN SEDIMENT ON CONSTRUCTION SITES. ALL POLLUTANTS OTHER THAN SEDIMENT THAT OCCUR ON-SITE DURING CONSTRUCTION SHALL BE HANDLED AND DISPOSED OF IN A MANNER THAT DOES NOT CAUSE CONTAMINATION OF STORMWATER.
14. MAINTENANCE. ALL TEMPORARY AND PERMANENT EROSION AND SEDIMENT CONTROL BMP'S SHALL BE MAINTAINED AND REPAIRED AS NEEDED TO ASSURE CONTINUED PERFORMANCE OF THEIR INTENDED FUNCTION.
15. FINANCIAL LIABILITY. PERFORMANCE BONDING, OR OTHER APPROPRIATE FINANCIAL INSTRUMENTS, SHALL BE REQUIRED FOR ALL PROJECTS TO ENSURE COMPLIANCE WITH THE APPROVED TESC PLAN.

AS-BUILT SUBMITTAL 1	HJ	9/29/17
AS-BUILT SUBMITTAL 2	HJ/EH	01/03/18
NO.	REVISION	BY DATE

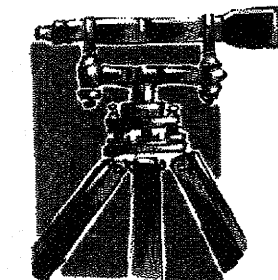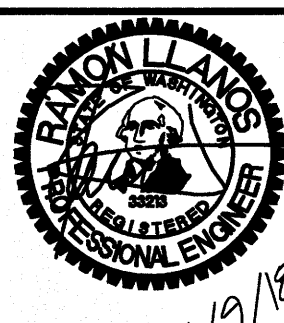

**LDES, INC.**  
5160 INDUSTRIAL PL. #108  
FERNDAL, WA 98248  
PHONE 360-383-0620  
FAX 360-383-0639

JOB NO.:	6022
DWG. NAME:	6022-Civil-ph2-2017-AB.dwg
DESIGNED BY:	RL
DRAWN BY:	EH
CHECKED BY:	RL

**LEWIS AND YORK, LLC**  
1292 W. AXTON RD  
FERNDAL, WA 98248

APPROVED

JAN 11 2018

BY RAYMOND L. LARSEN  
CITY OF FERNDAL  
PUBLIC WORKS DEPARTMENT

EROSION CONTROL

DRAKE RIDGE DEVELOPMENT: PHASE 2  
MAIN STREET, FERNDAL, WA



SHEET

03


OF

08

AS-BUILT DRAWING

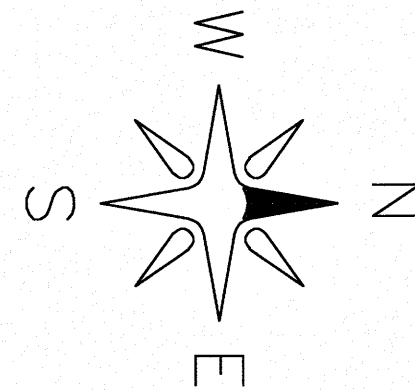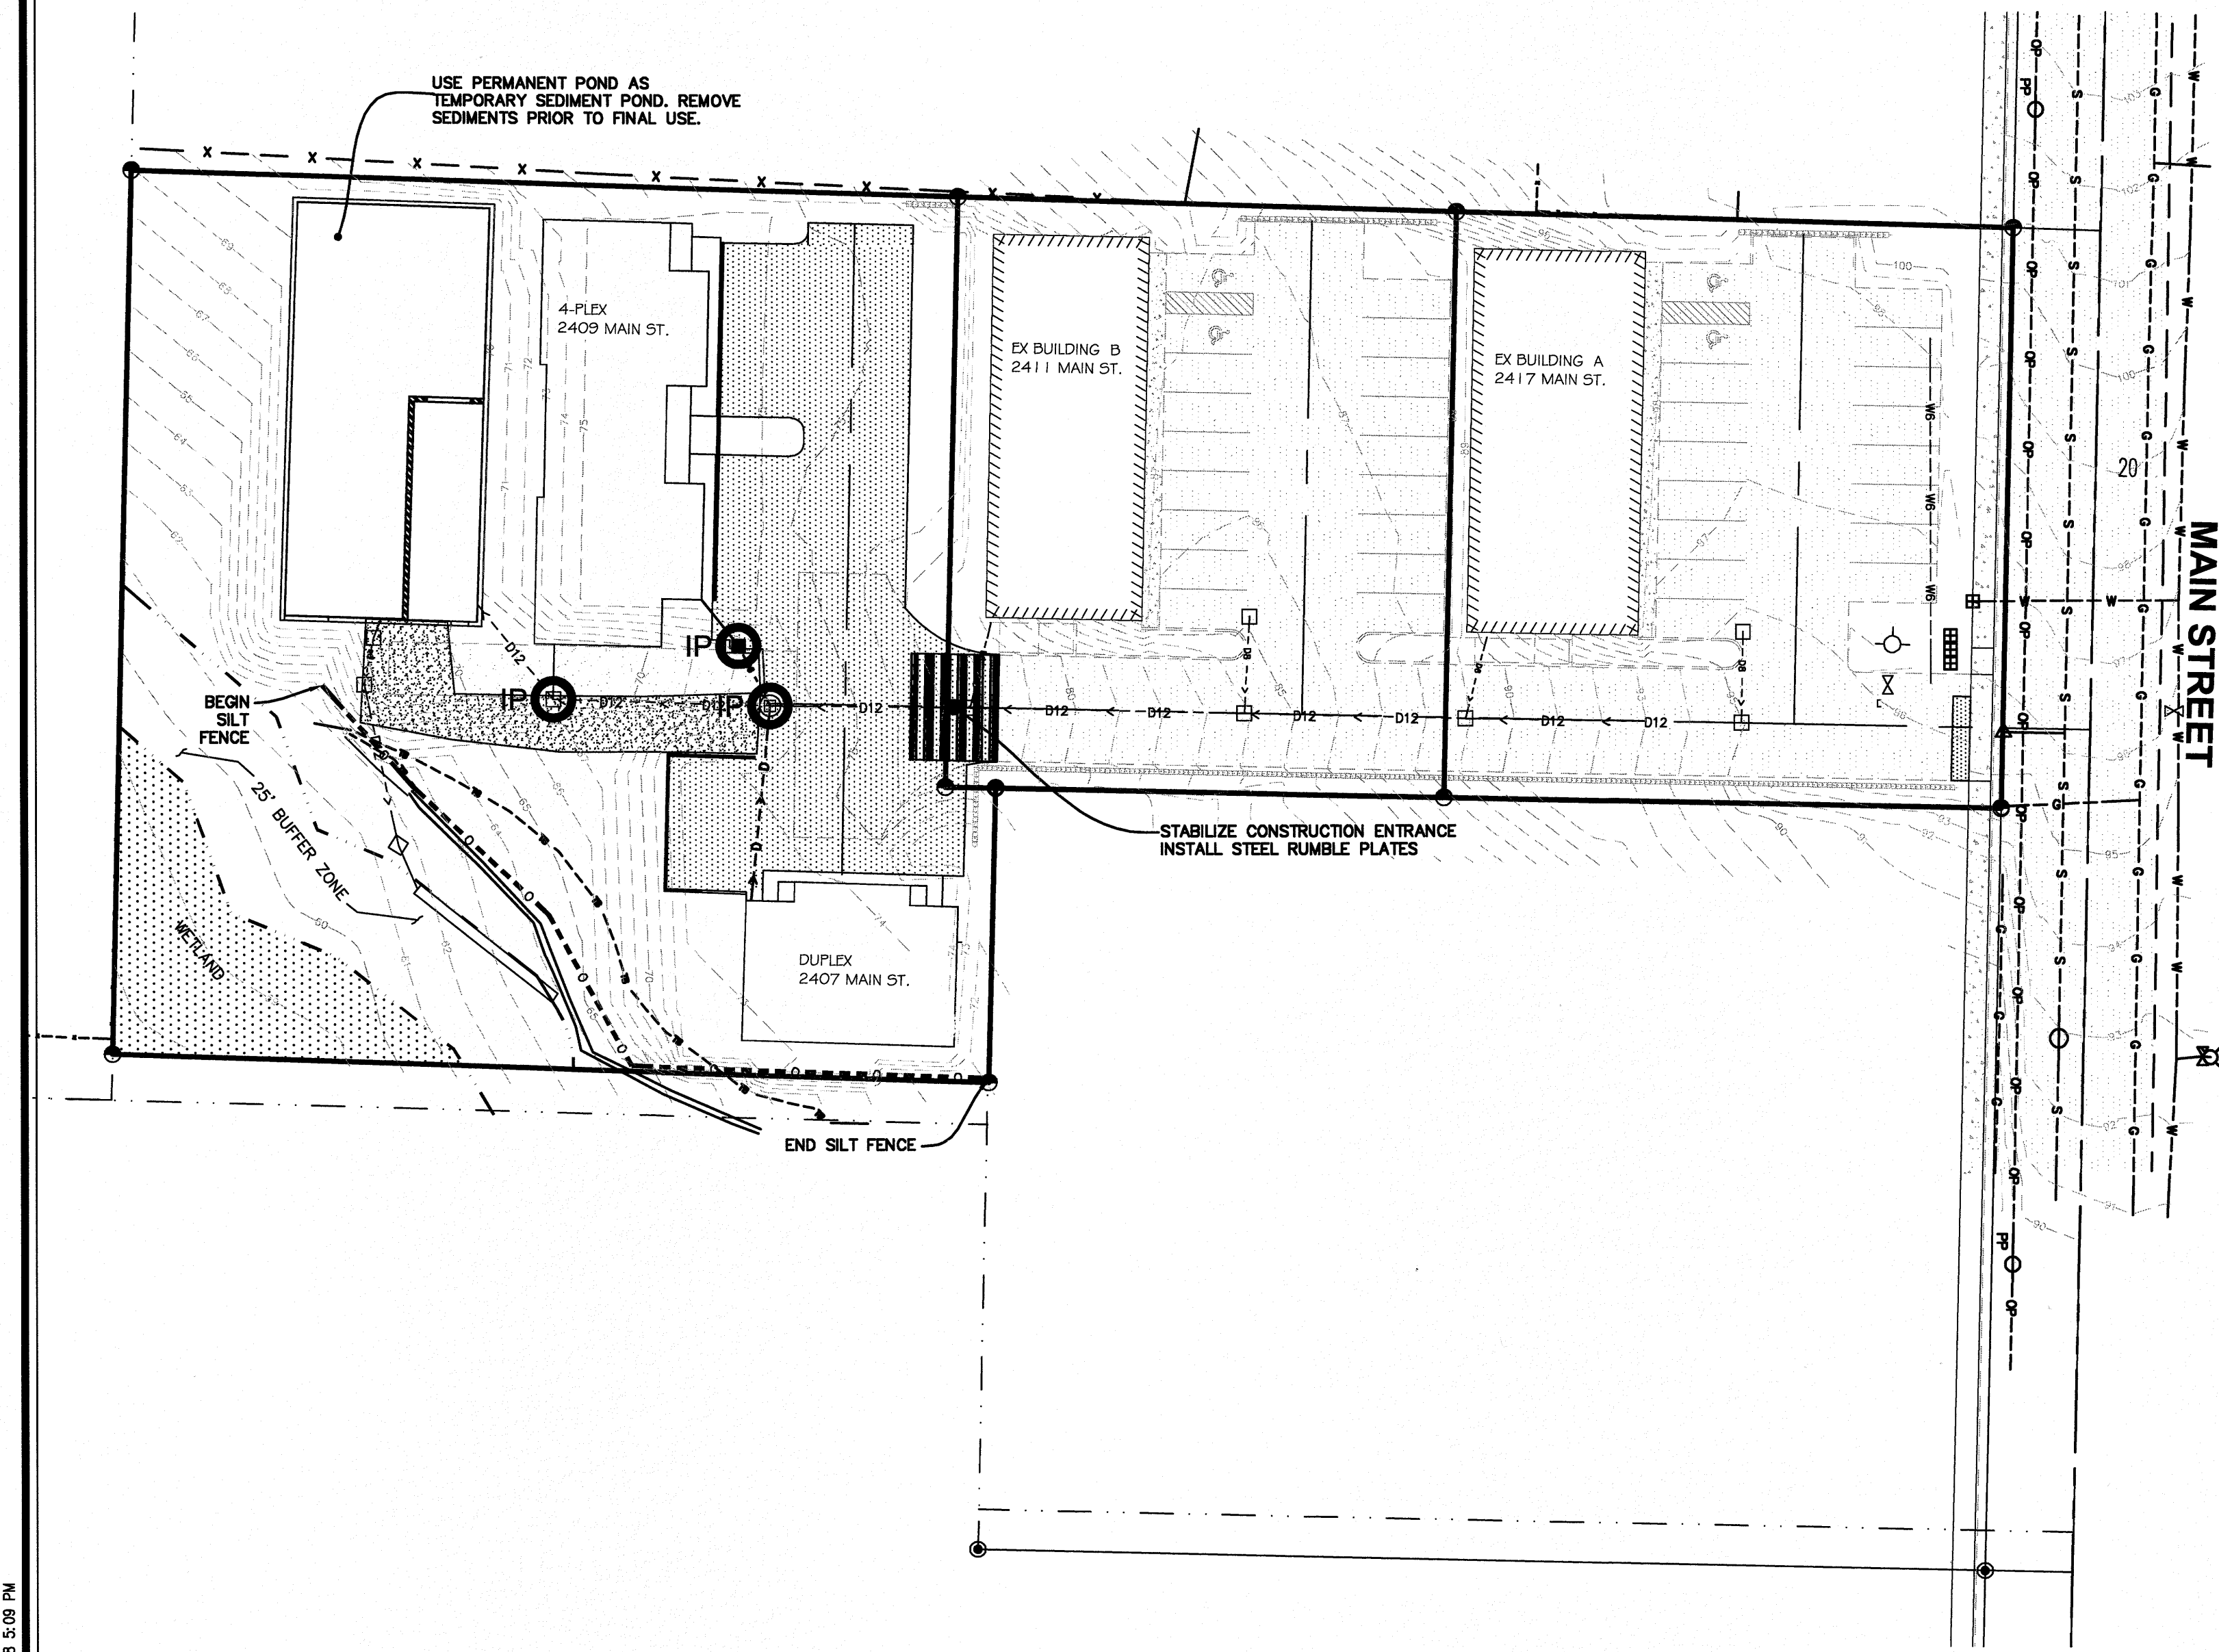

GRAPHIC SCALE

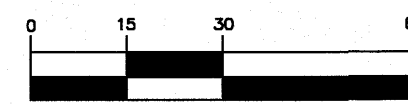


( IN FEET )  
1 inch = 30 ft.

CALL 2 BUSINESS DAYS BEFORE YOU DIG  
1-800-424-5555  
UTILITIES UNDERGROUND LOCATION CENTER

TESC LEGEND:


- INLET PROTECTION  
PROTECT NEW STRUCTURES  
AS THEY ARE INSTALLED
- SEDIMENT FENCE  
(DETAIL 1, THIS SHEET)
- CONSTRUCTION ENTRANCE  
STEEL RUMBLE PLATE

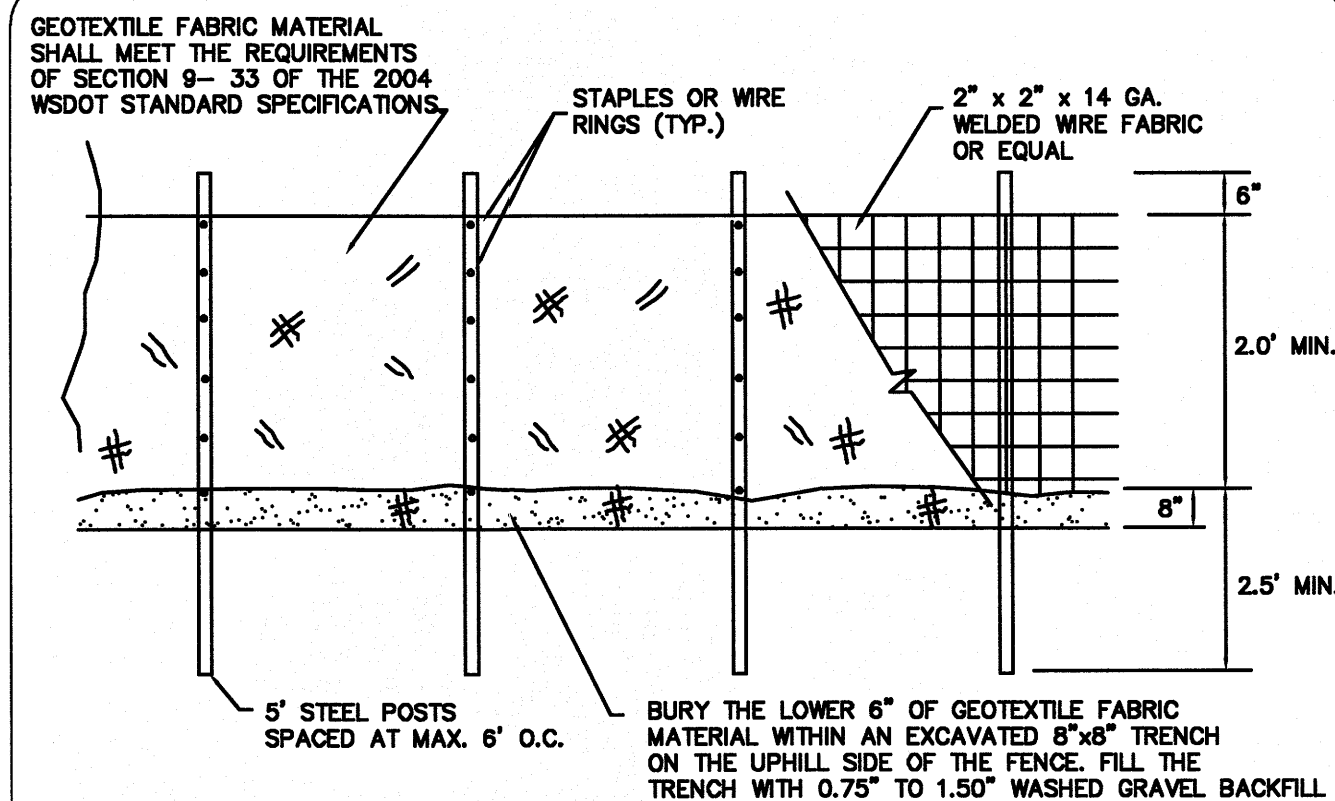

GENERAL NOTES:

1. ANY DAMAGE TO FENCING SHALL BE REPAIRED IMMEDIATELY.
2. IF CONCENTRATED FLOWS ARE EVIDENT UPHILL OF THE FENCE, THEN THE WATER MUST BE INTERCEPTED AND CONVEYED TO A FULLY-FUNCTIONING SEDIMENT TRAP, POND, OR CONVEYANCE SYSTEM.
3. IT IS IMPORTANT TO PERIODICALLY CHECK THE UPHILL SIDE OF FENCING FOR SIGNS OF CLOGGING. IF CLOGGING OCCURS, THE FENCE WILL ACT AS A BARRIER TO FLOW AND WILL CAUSE CHANNELIZATION PARALLEL TO THE FENCE. TO REMEDY THIS, THE CONTRACTOR SHALL REPLACE THE FENCE AND/OR REMOVE THE TRAPPED SEDIMENT.
4. SILT FENCING SHALL BE CONSTRUCTED DIRECTLY AFTER CLEARING AND GRUBBING IS COMPLETE. THE FENCE SHALL ONLY BE REMOVED WHEN CONSTRUCTION OR UTILITIES DEMANDS IT ABSOLUTELY NECESSARY. IMMEDIATELY AFTER UTILITIES ARE IN-PLACE, THE SILT FENCING SHALL BE RECONSTRUCTED.

① SILT FENCE DETAIL (BASED ON FERNDAL ST-10)  
not to scale

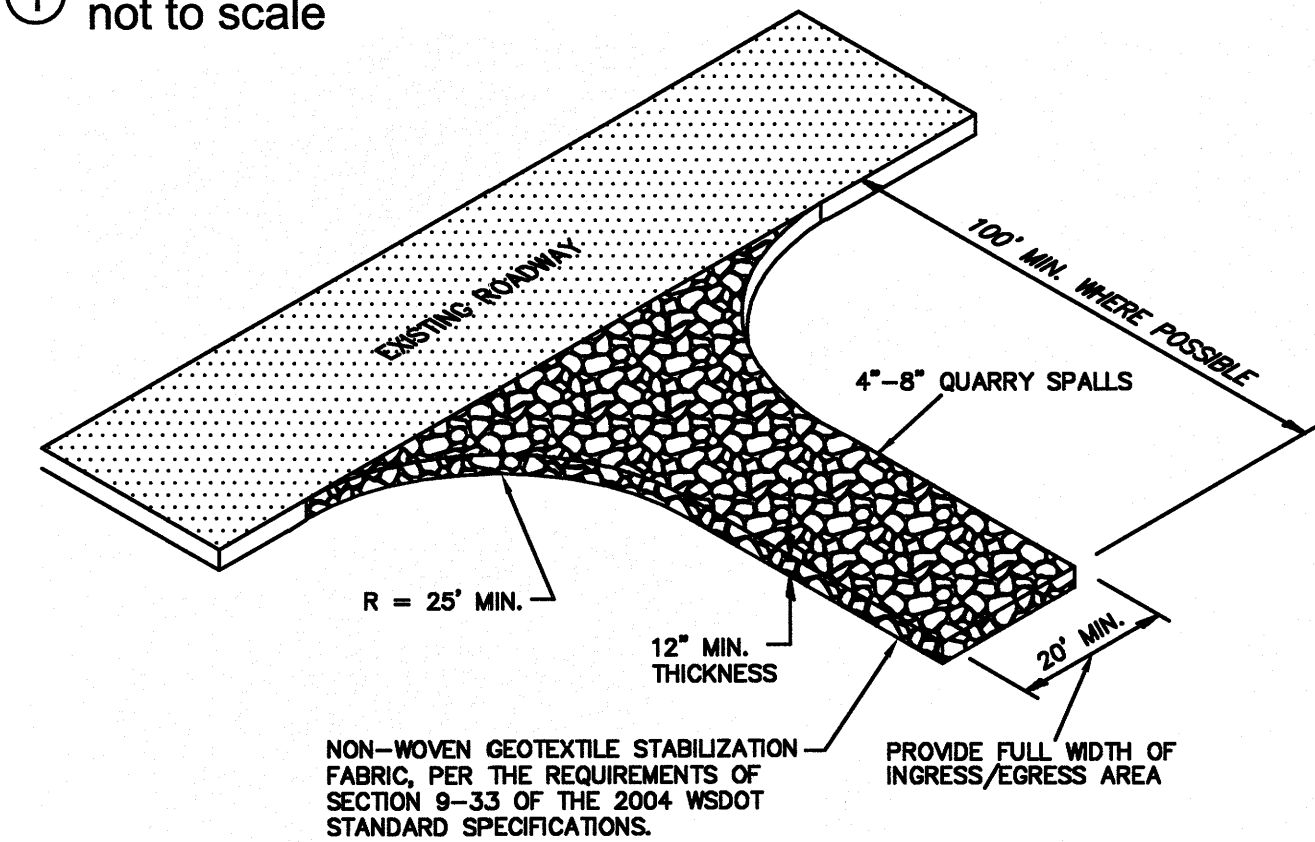

GENERAL NOTES:


1. IF THE ENTRANCE IS NOT PREVENTING SEDIMENT FROM BEING TRACKED ONTO SURROUNDING FACILITIES, THEN ALTERNATIVE MEASURES TO KEEP THE FACILITIES FREE OF SEDIMENT SHALL TO USED. THIS MAY INCLUDE STREET SWEEPING OR UPSIZING THE DIMENSIONS OF THE ENTRANCE.
2. ANY SEDIMENT THAT IS TRACKED ONTO PAVEMENT SHALL BE REMOVED IMMEDIATELY BY SWEEPING. THE SEDIMENT COLLECTED BY SWEEPING SHALL BE REMOVED OR STABILIZED ON-SITE. THE PAVEMENT SHALL NOT BE CLEANED BY WASHING, EXCEPT WHEN SWEEPING IS INEFFECTIVE AND THERE IS A THREAT TO PUBLIC SAFETY. IF IT IS NECESSARY TO WASH PAVEMENT, A SMALL SUMP OR POND SHALL BE CONSTRUCTED AND THE SEDIMENT SHALL BE CONVEYED INTO THE SUMP OR POND.

② QUARRY SPALL CONSTRUCTION ENTRANCE DETAIL  
not to scale

EROSION AND SEDIMENT CONTROL GENERAL NOTES:



1. EROSION CONTROL METHODS AND MATERIALS SHALL MEET THE REQUIREMENTS OF SECTION 8-01 OF THE 2008 WSDOT/APWA STANDARD SPECIFICATIONS, THE REQUIREMENTS SET FORTH IN VOLUME II OF THE "STORMWATER MANAGEMENT MANUAL FOR WESTERN WASHINGTON" BY THE WASHINGTON STATE DEPARTMENT OF ECOLOGY, CURRENT EDITION, THE CITY OF FERNDAL DEVELOPMENT STANDARDS, THE PROJECT SWPPP AND THIS PLAN, WITH THE MOST EFFECTIVE REQUIREMENTS TAKING PRECEDENCE. THE CONTRACTOR SHALL FOLLOW RECOMMENDATIONS MADE BY SUPPLIERS AND MANUFACTURERS FOR ALL MATERIALS AND EQUIPMENT USED.
2. THE CONTRACTOR SHALL TAKE ALL PRECAUTIONS TO PREVENT SILTY STORMWATER FROM EXITING THE SITE. IF SILT LOADED STORMWATER EXITS THE SITE, THE ENGINEER SHALL STOP WORK ON THE JOB. IT IS THE CONTRACTOR'S RESPONSIBILITY TO WORK WITH THE PROJECT ENGINEER OR LOCAL JURISDICTION TO COORDINATE FURTHER EROSION CONTROL MEASURES, NOT SHOWN ON THE EROSION AND SEDIMENT CONTROL PLAN, THAT MAY BE NECESSARY TO CONTROL SITE RUNOFF.
3. THE EXISTING AND PROPOSED STORM SYSTEMS SHALL BE CLEANED AND MAINTAINED THROUGHOUT CONSTRUCTION AND UNTIL ALL ON-SITE SOILS HAVE BEEN STABILIZED.
4. AT THE END OF ALL SITE CONSTRUCTION, THE CONTRACTOR SHALL FLUSH OUT ALL DEBRIS FROM THE STORM SYSTEM INSTALLED ON-SITE. MATERIAL FLUSHED FROM THE STORM SYSTEM SHALL BE DISPOSED OF BY THE CONTRACTOR AT AN APPROVED DISPOSAL SITE. FLUSHING OPERATION SHALL BE PERFORMED USING A VACTOR TRUCK.



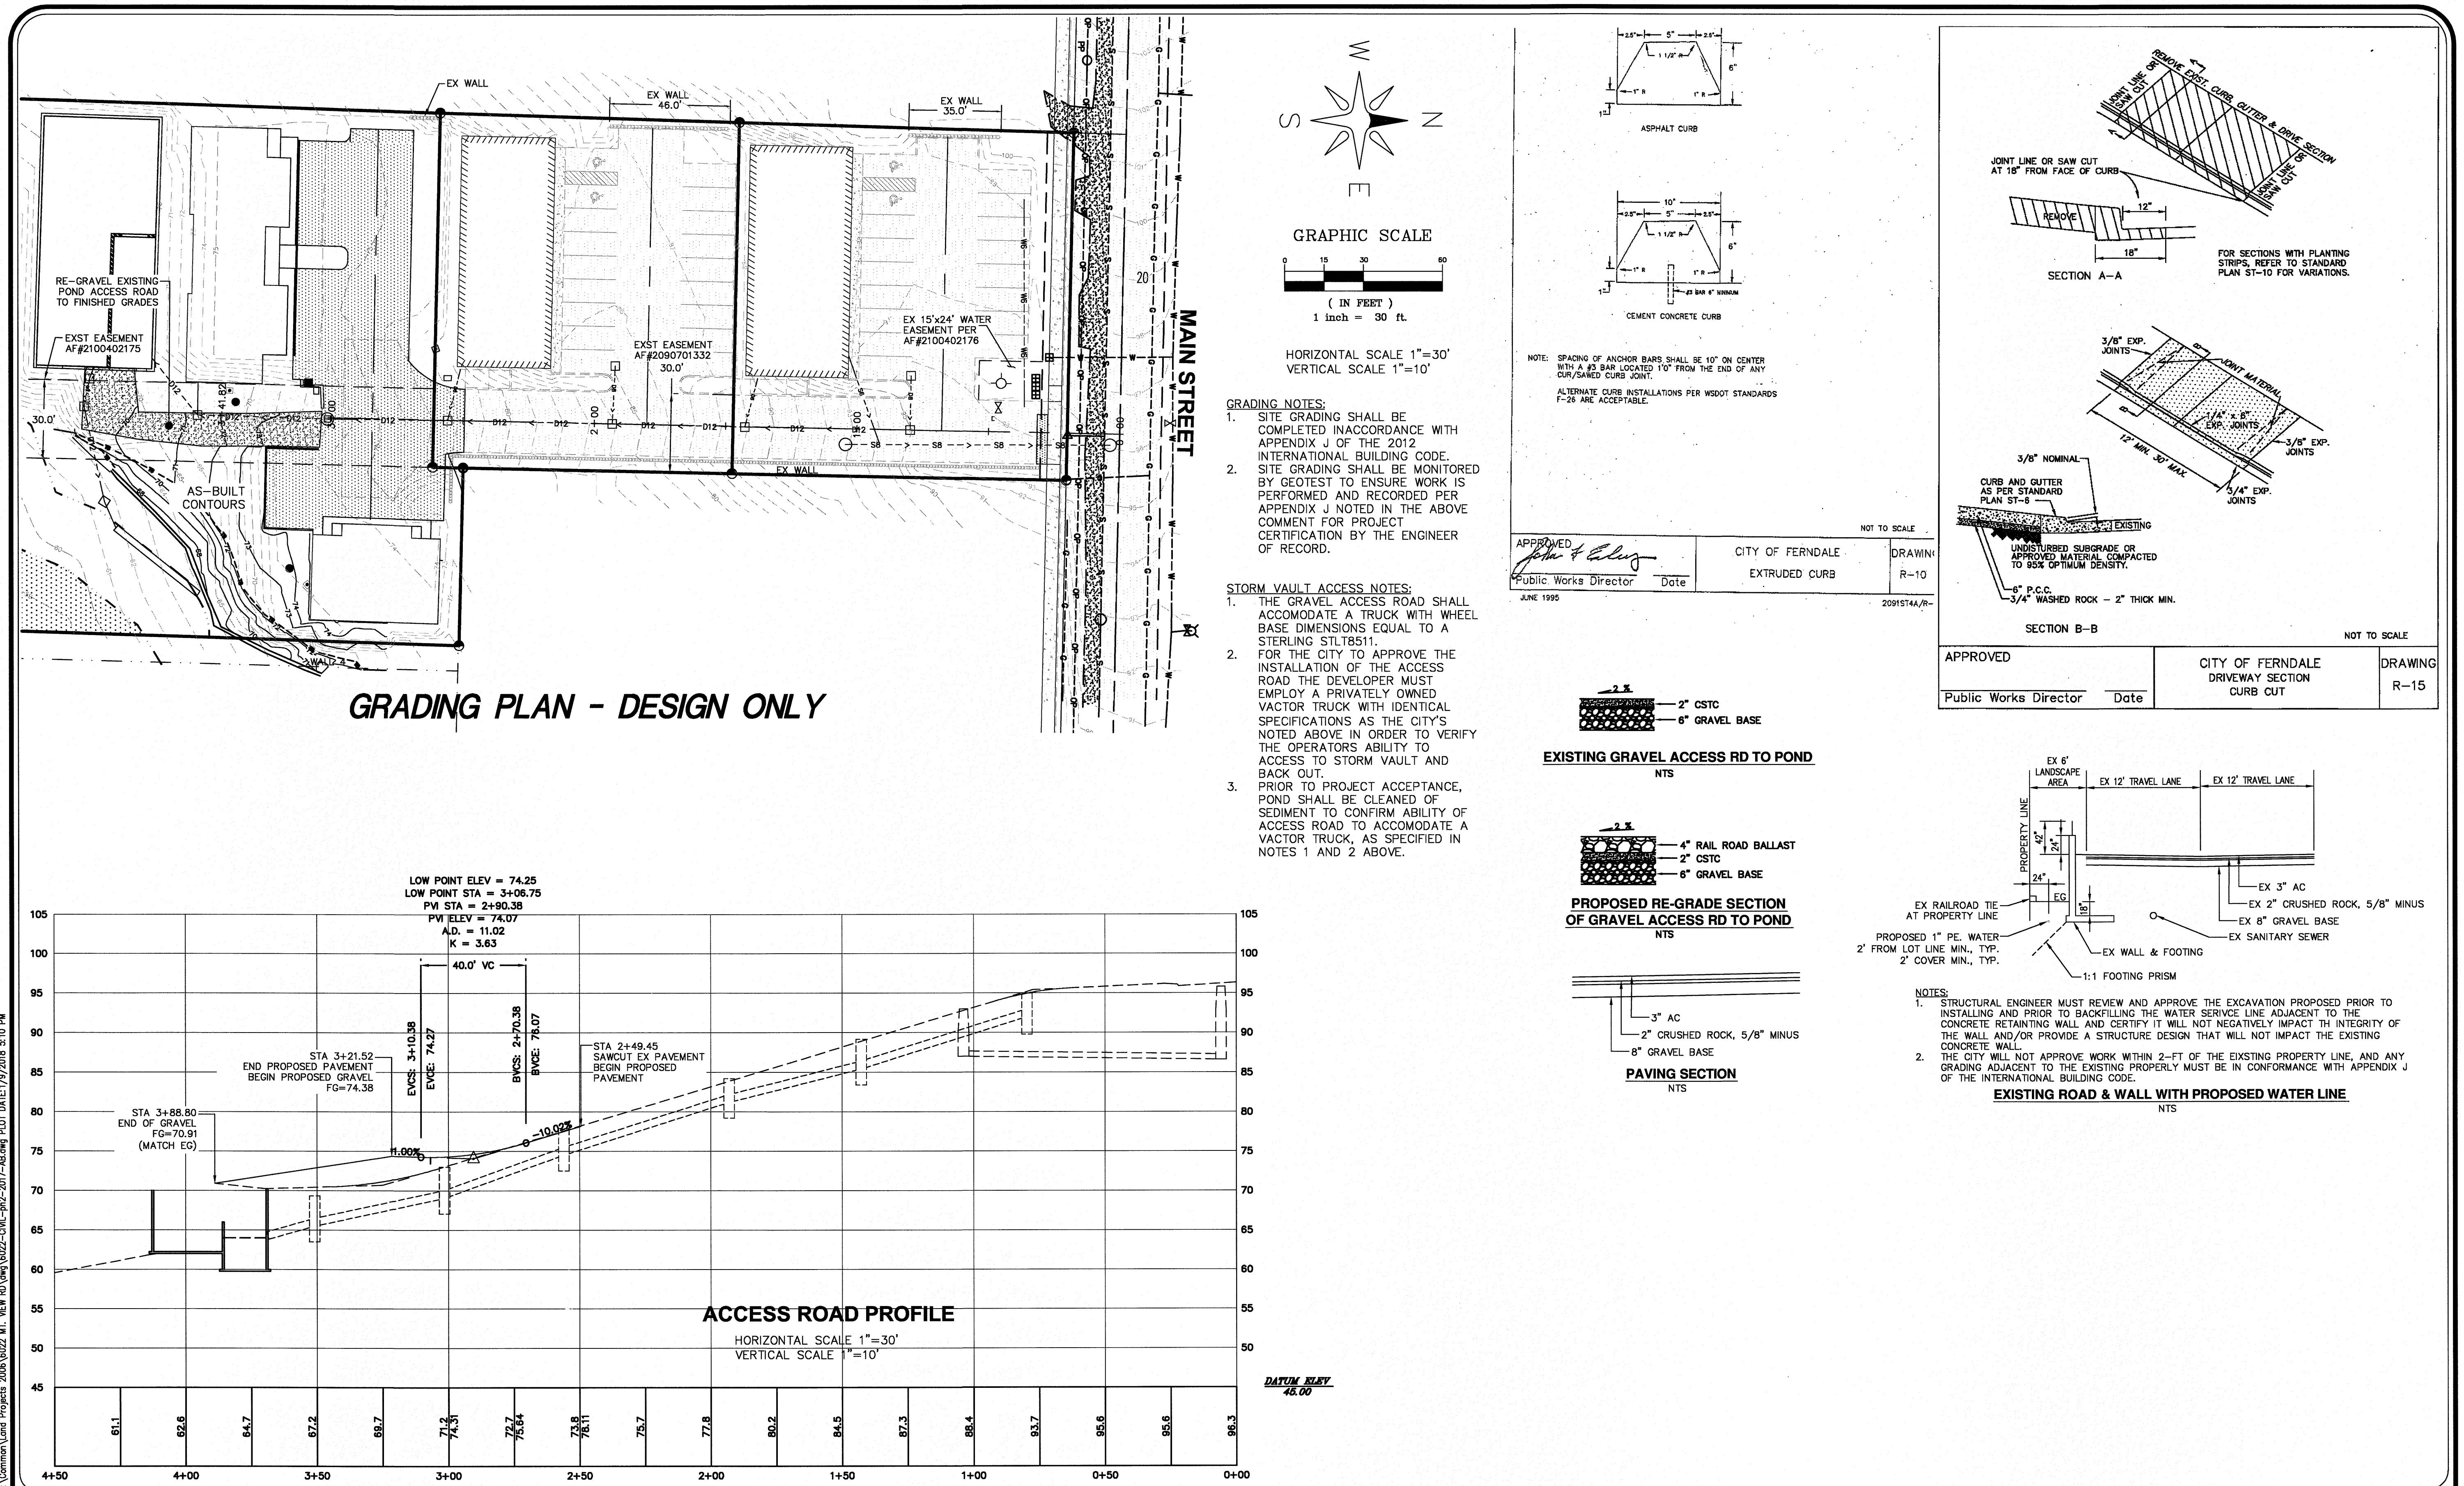

AS-BUILT DRAWING

AS-BUILT SUBMITTAL 1	HJ	9/28/17
AS-BUILT SUBMITTAL 2	HJ/EH	01/03/18
NO.	REVISION	BY DATE

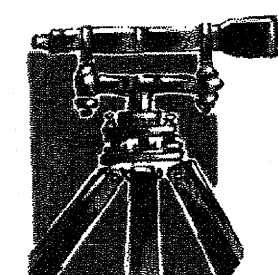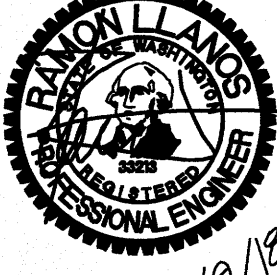

**LDES, INC.**  
5160 INDUSTRIAL PL. #108  
FERNDAL, WA 98248  
PHONE 360-383-0620  
FAX 360-383-0639

JOB NO.: 6022

DWG. NAME: 6022-CIVIL-ph2-2017-AB.dwg

DESIGNED BY: JW

DRAWN BY: JW


CHECKED BY: EH

**LEWIS AND YORK, LLC**

1292 W. AXTON RD  
FERNDAL, WA 98248

APPROVED

JAN 11 2018

BY:   
CITY OF FERNDAL  
PUBLIC WORKS DEPARTMENT

**GRADING PLAN**

DRAKE RIDGE DEVELOPMENT: PHASE 2  
MAIN STREET, FERNDAL, WA







SHEET

**04**

OF

**08**



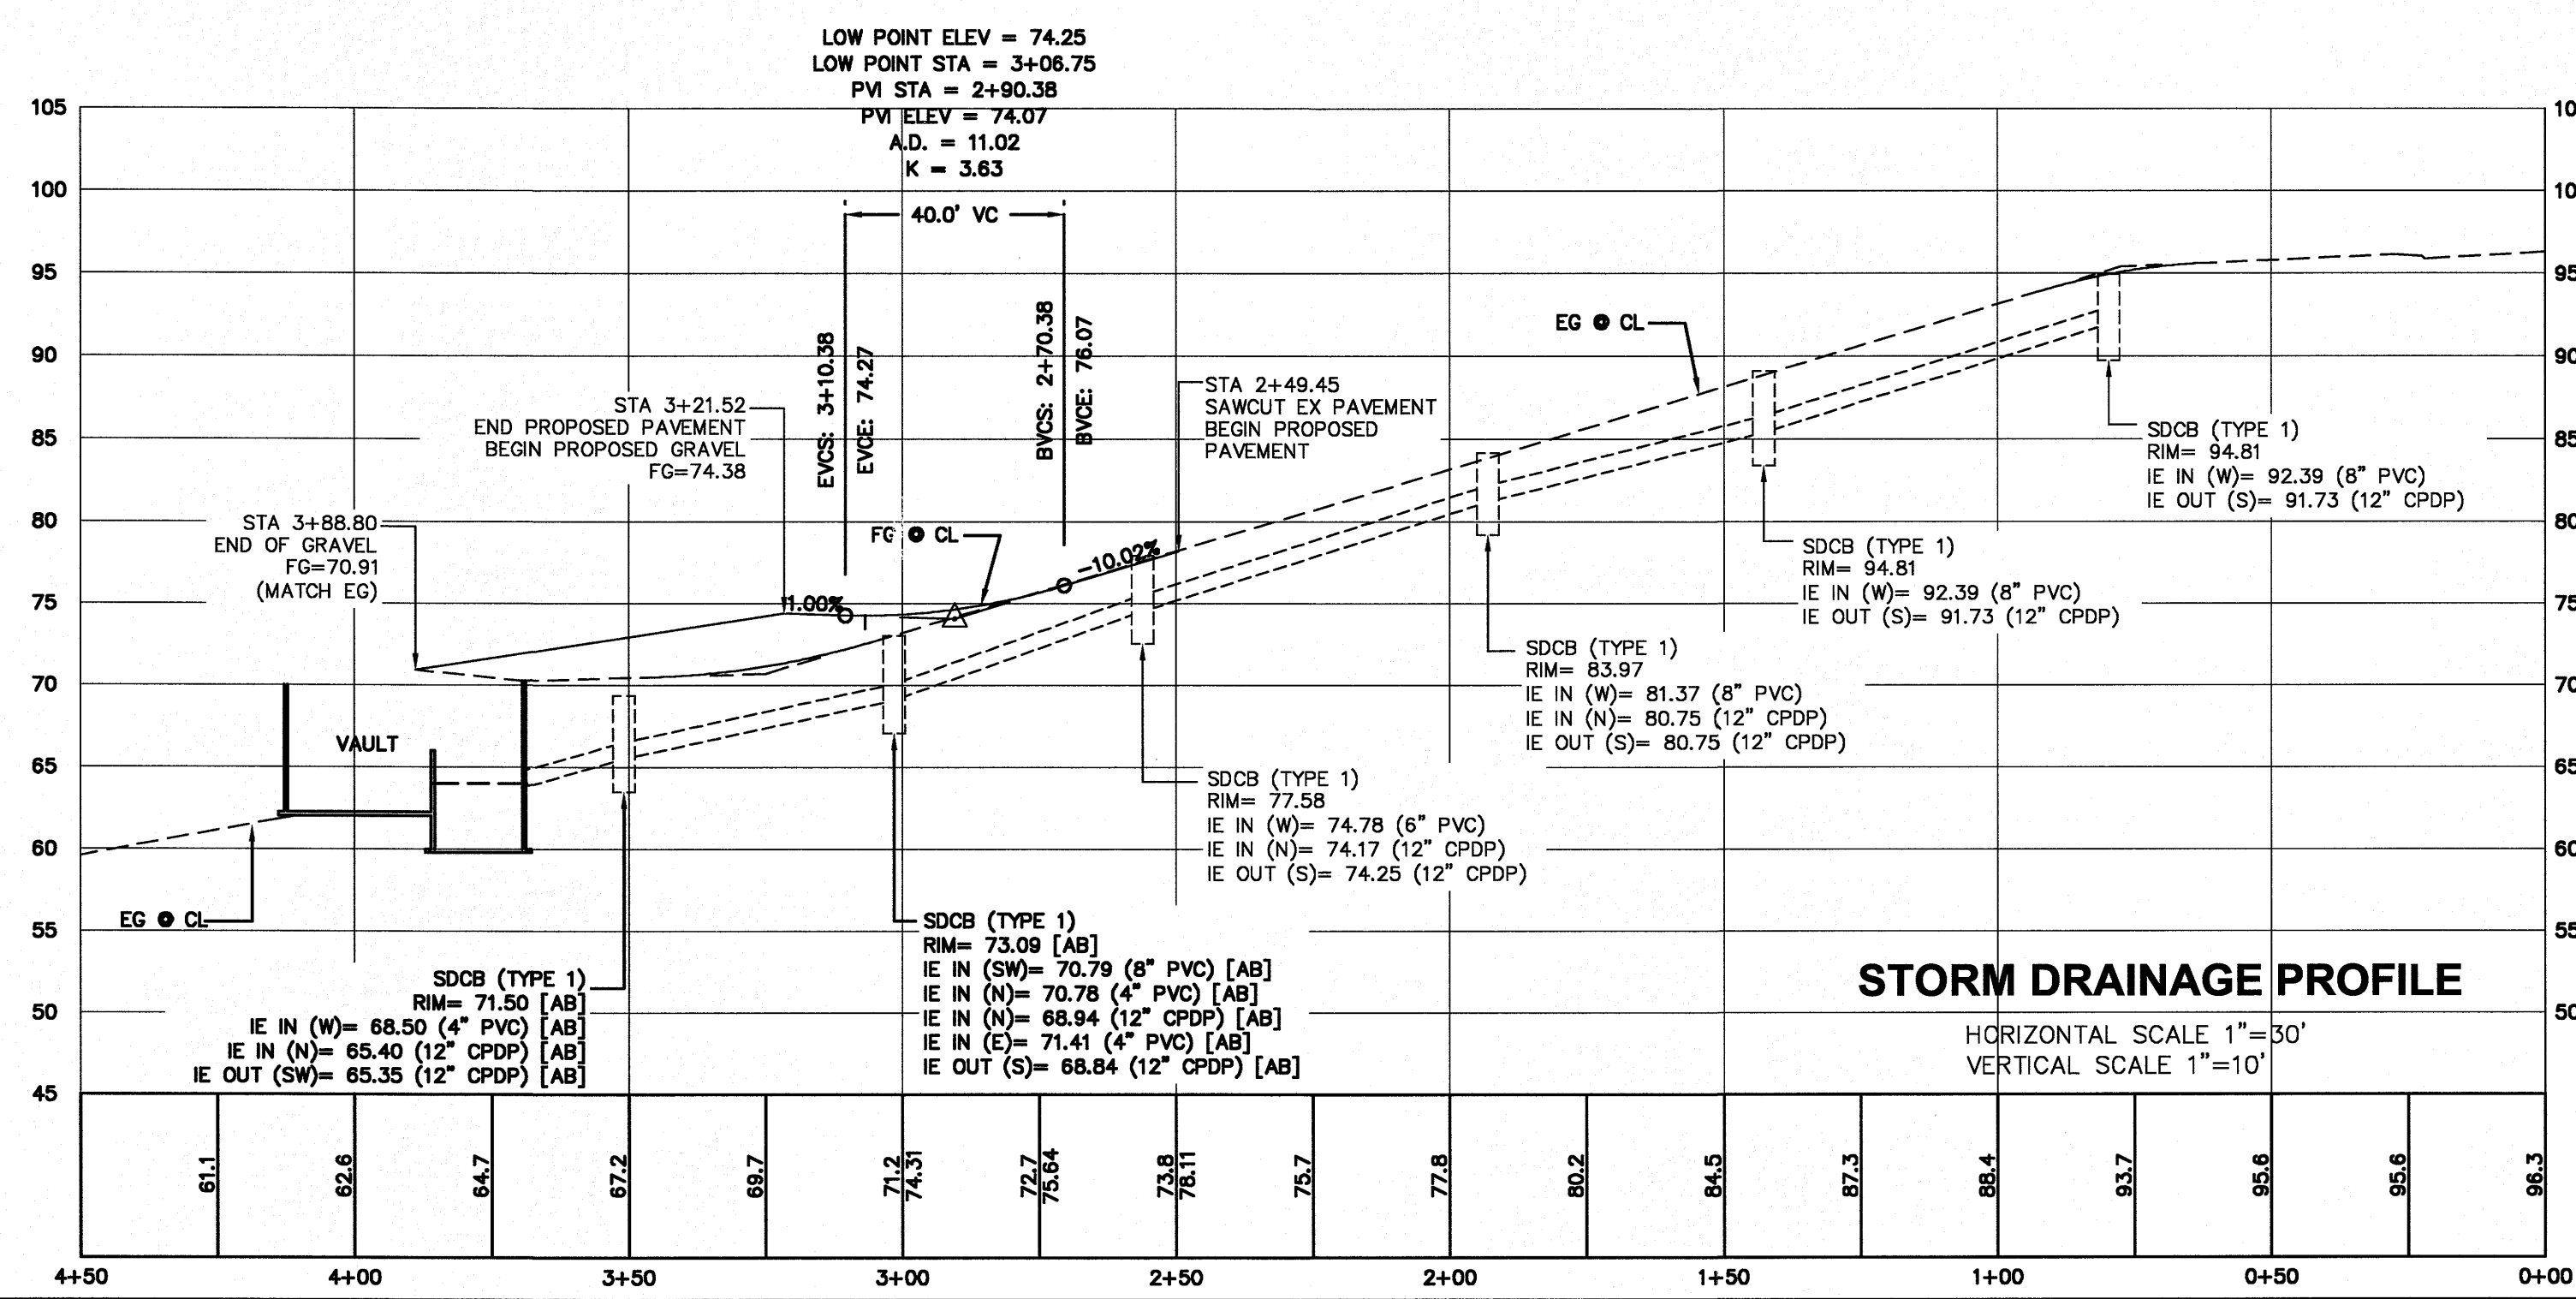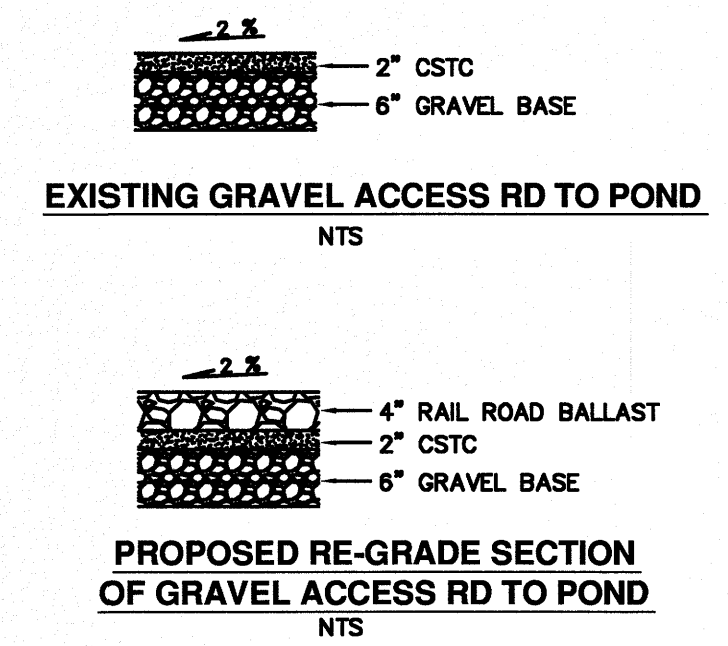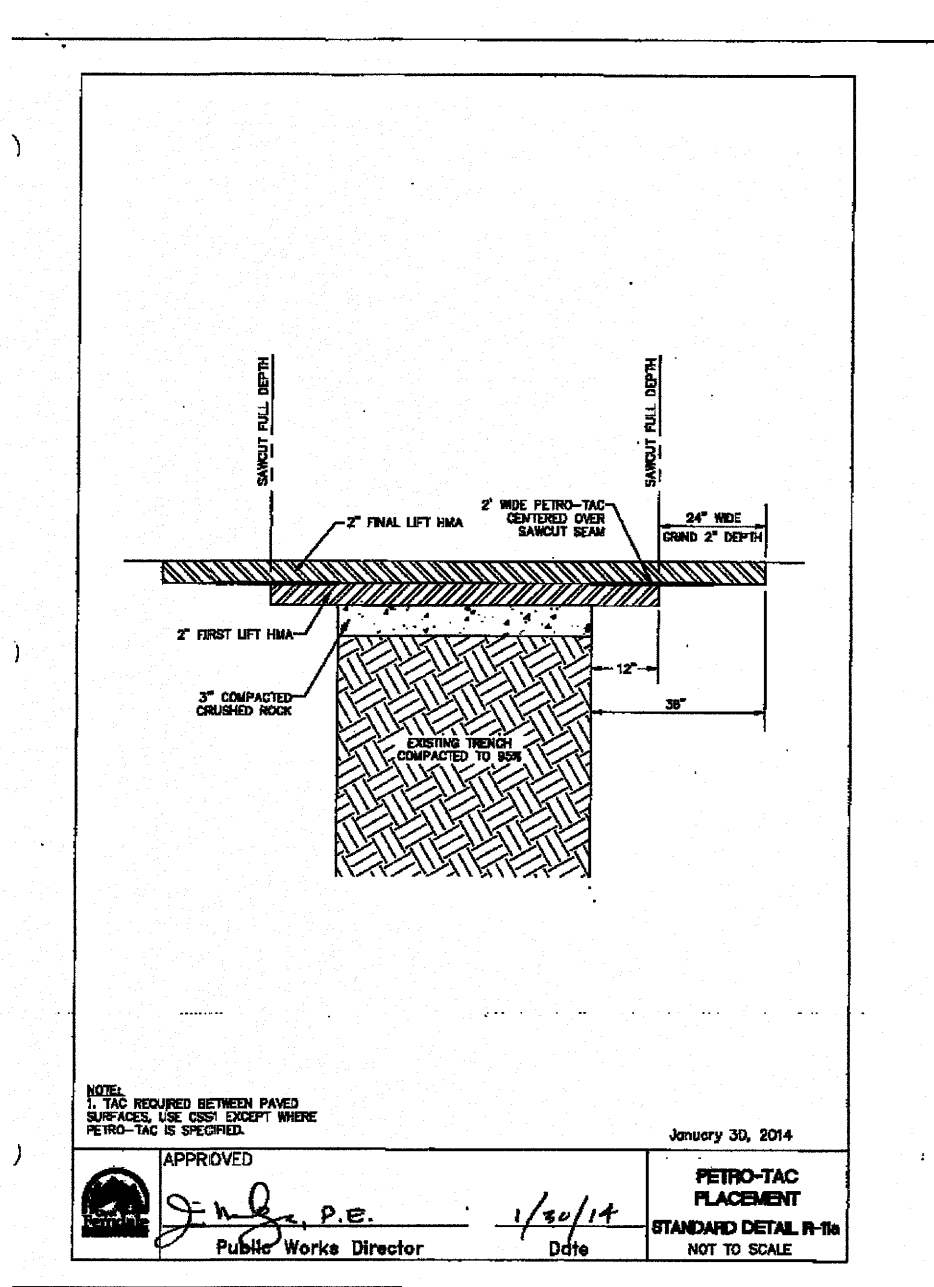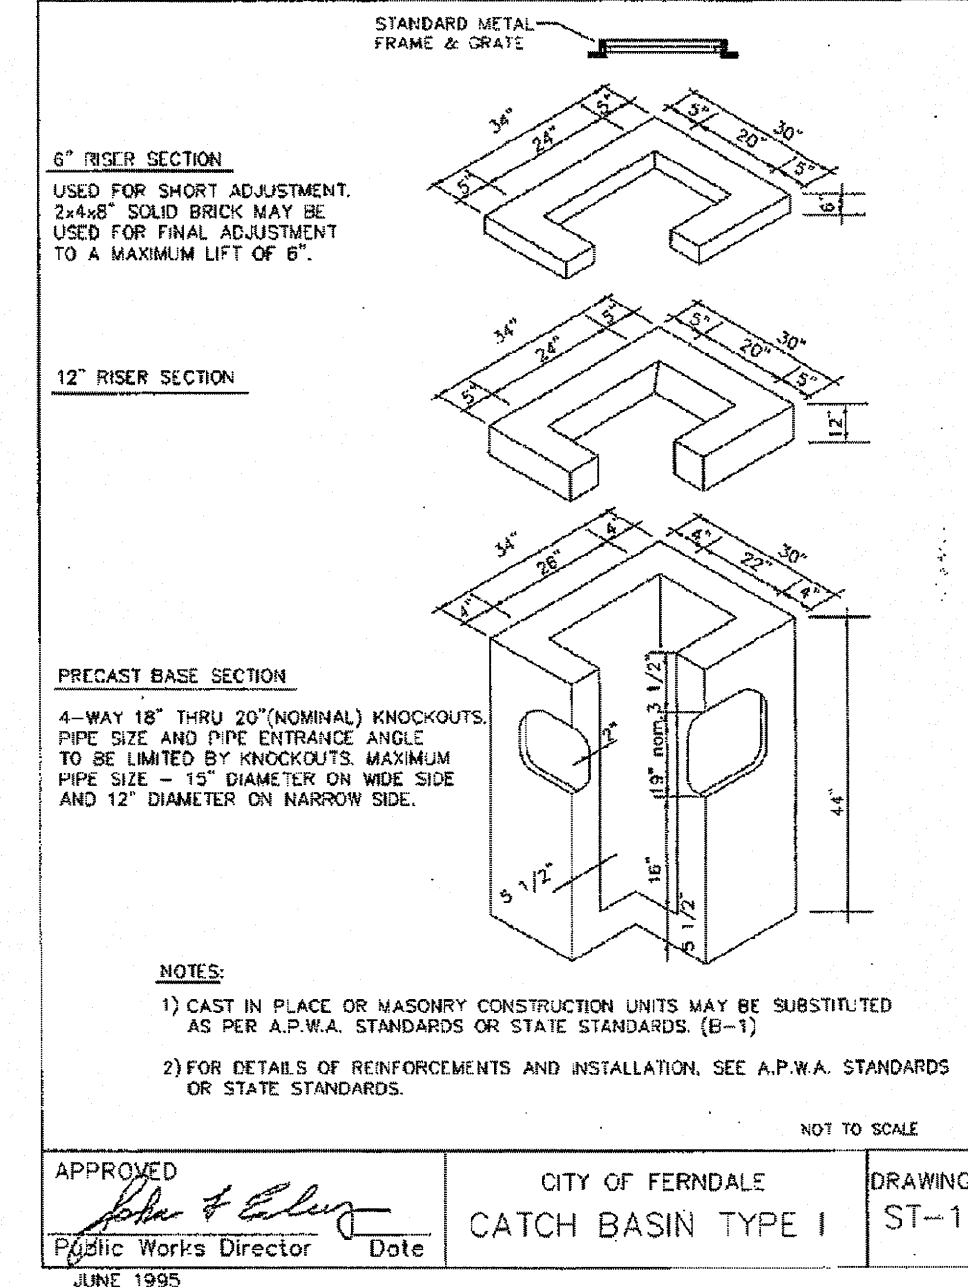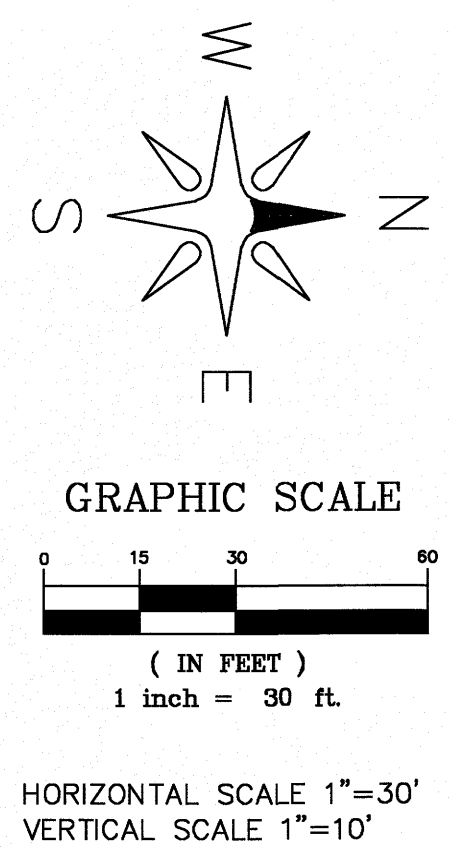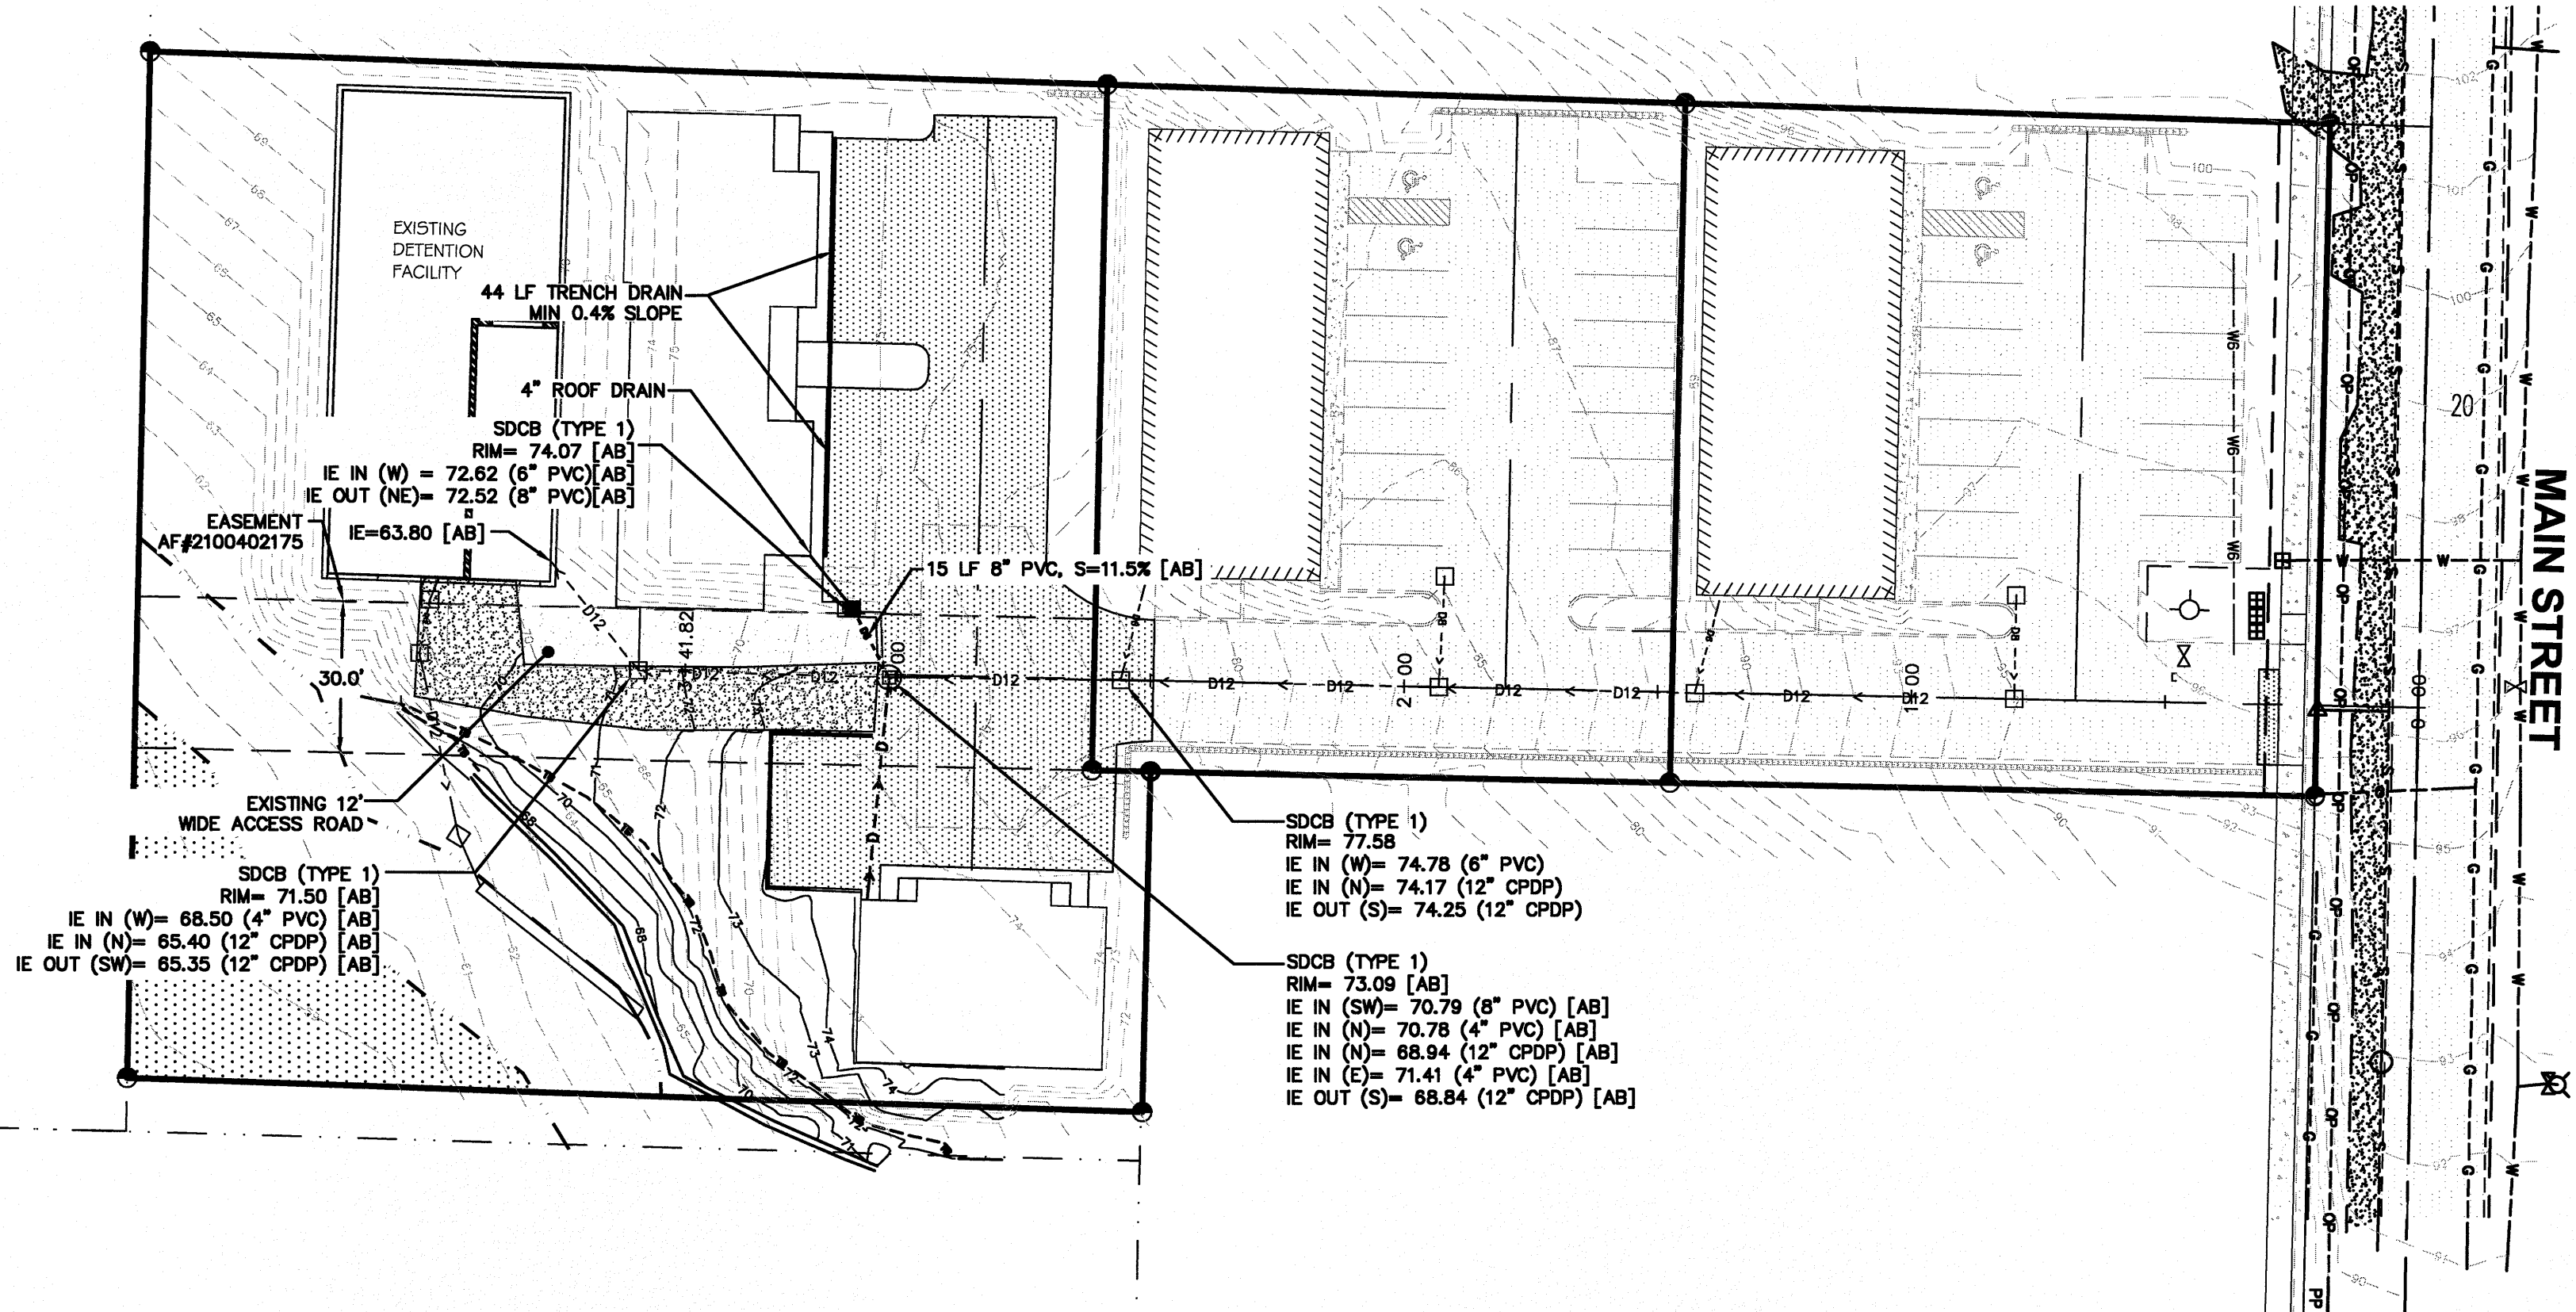

R:\Common\Land Projects 2008\6022.MT VIEW RD\DWG\6022-CIVL-ph2-2017-AB.dwg PLOT DATE: 1/9/2018 5:11 PM

AS-BUILT SUBMITTAL 1	HJ	9/29/17
AS-BUILT SUBMITTAL 2	HJ/EH	01/03/18
NO.	REVISION	BY DATE

**LDES, INC.**  
5160 INDUSTRIAL PL. #108  
FERDALE, WA 98248  
PHONE 360-383-0620  
FAX 360-383-0639

JOB NO.: 6022

DWG. NAME: 6022-CIVL-ph2-2017-AB.dwg

DESIGNED BY: RL

DRAWN BY: EH

CHECKED BY: RL

**LEWIS AND YORK, LLC**

1292 W. AXTON RD  
FERDALE, WA 98248

APPROVED

JAN 11 2018

CITY OF FERDALE  
PUBLIC WORKS DEPARTMENT

**STORM DRAINAGE PLAN**

DRAKE RIDGE DEVELOPMENT: PHASE 2  
MAIN STREET, FERDALE, WA

SHEET


**05**

OF

**08**






AS-BUILT DRAWING



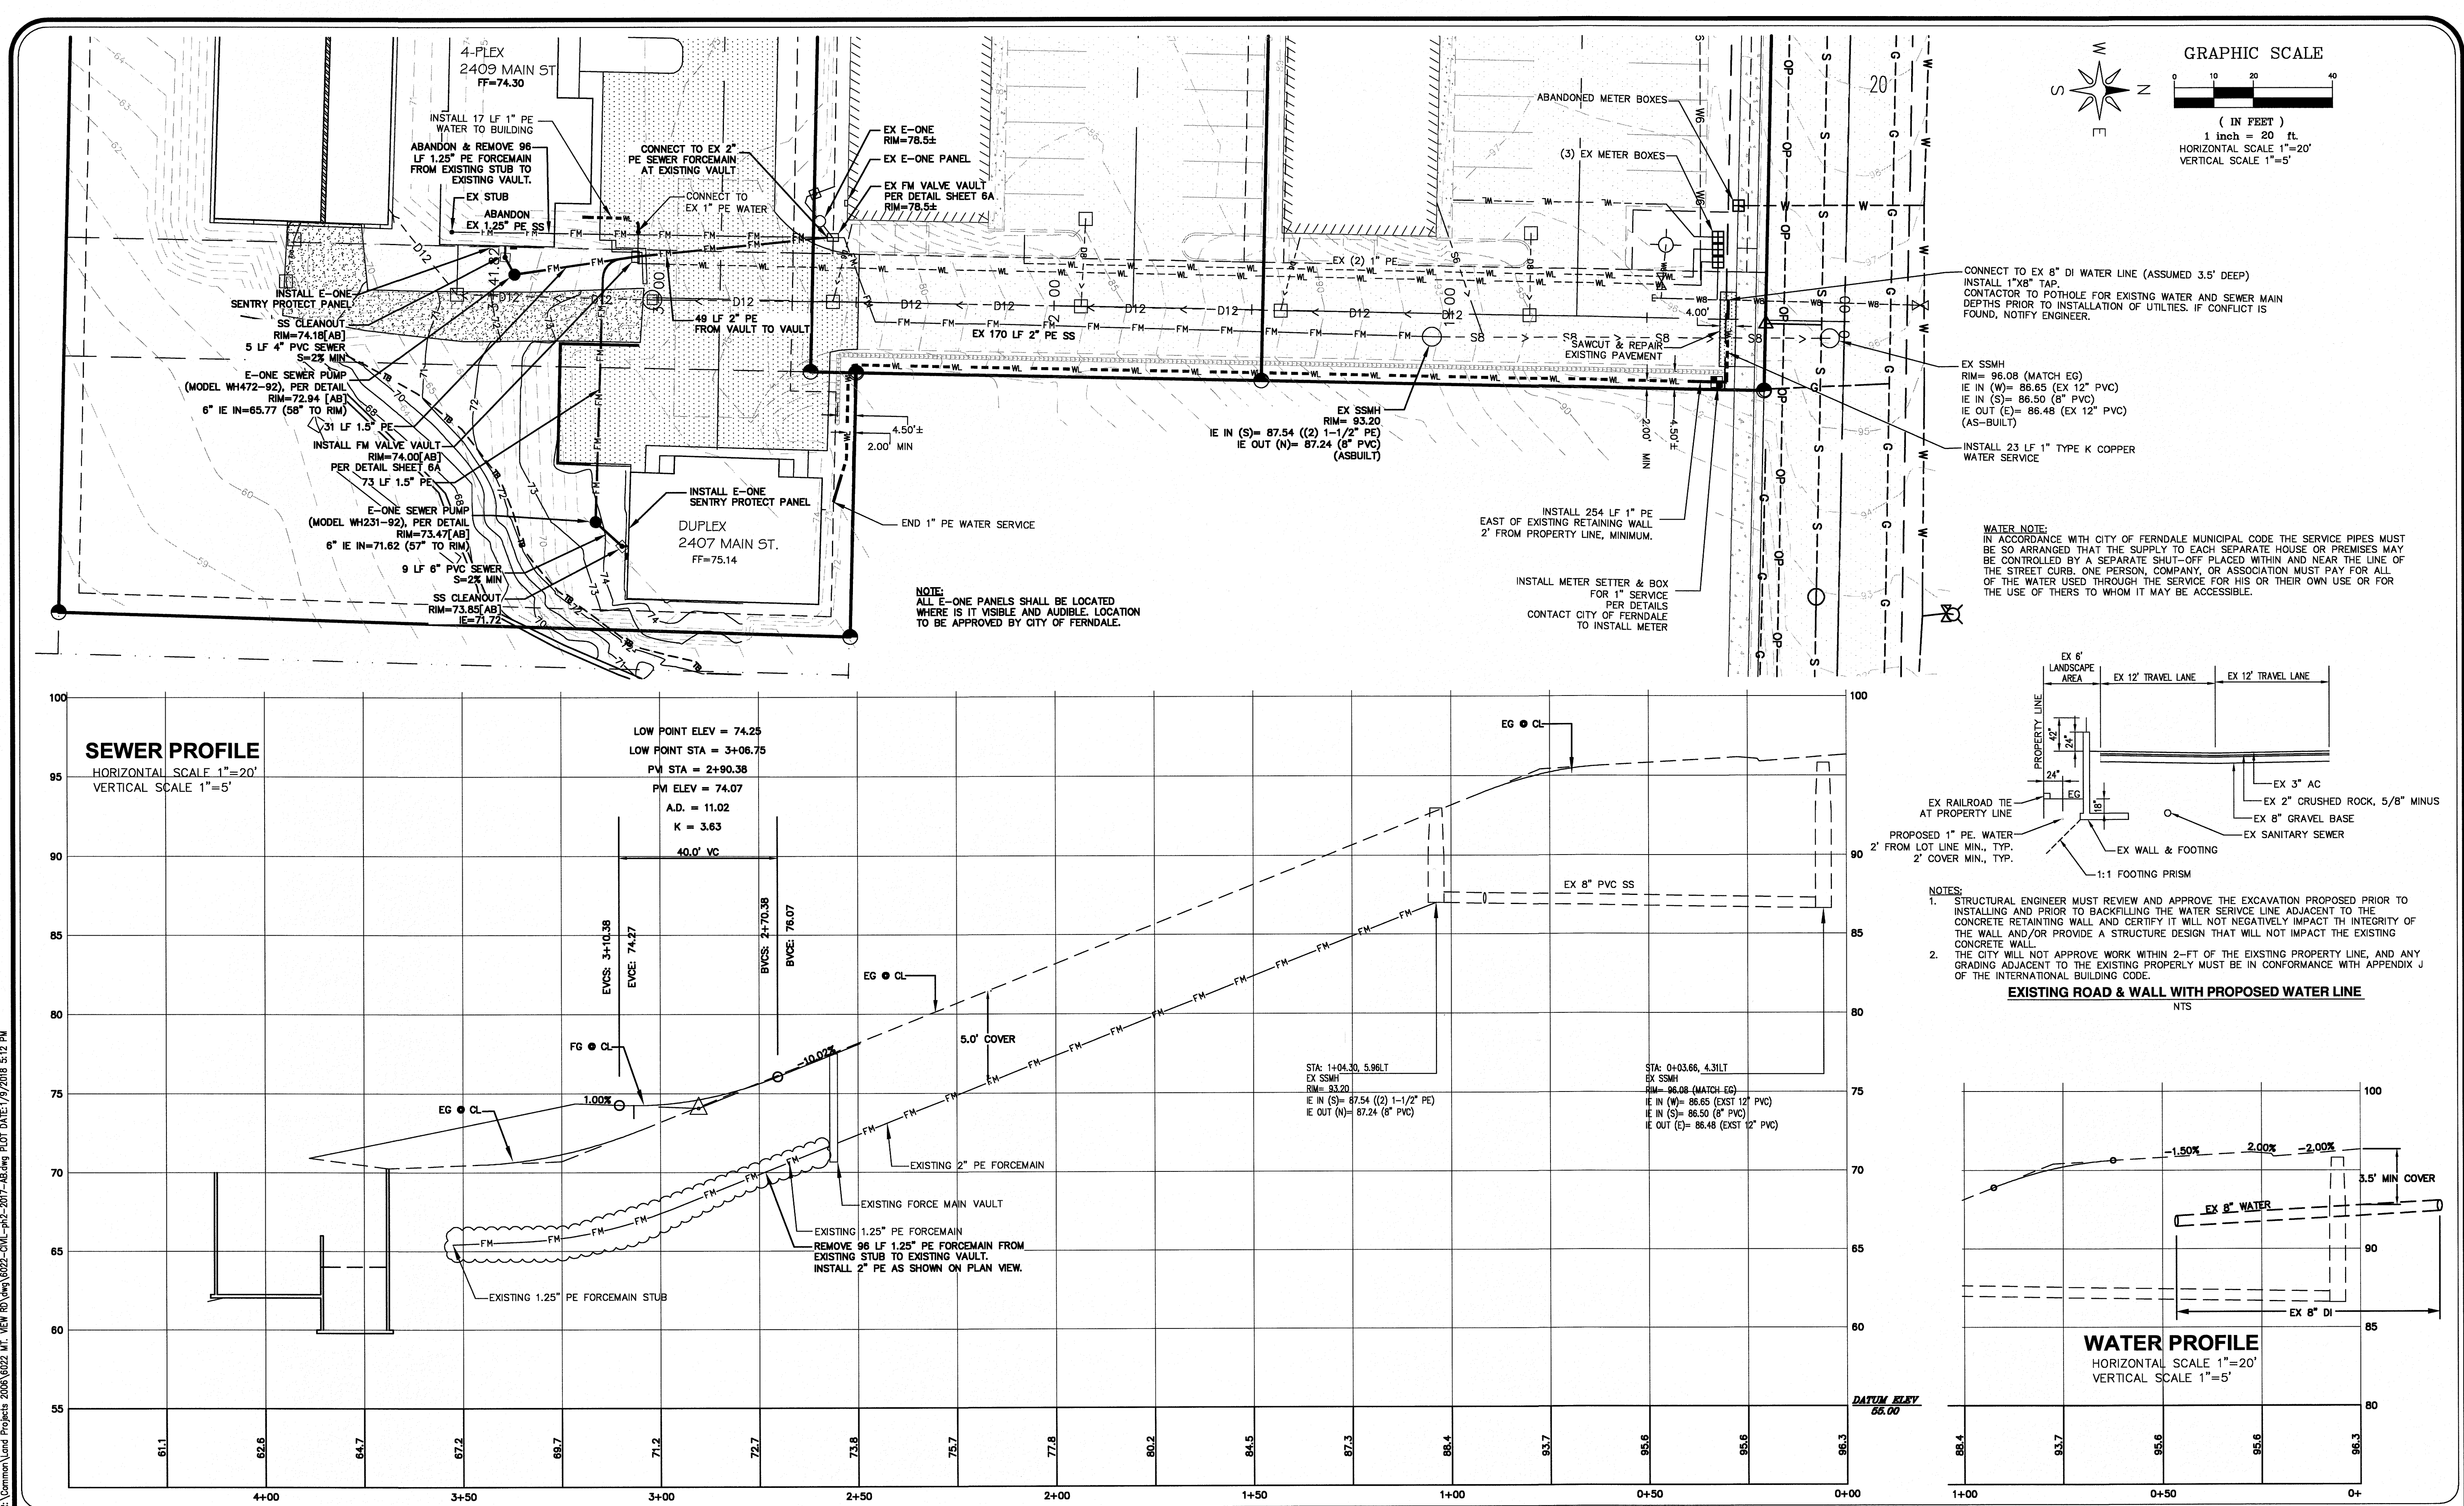

LDES, INC. 5160 INDUSTRIAL PL. #108 FERNDAL, WA 98248 PHONE 360-383-0620 FAX 360-383-0639		FERNDAL LANDS FERNDAL, WA 98248		FERNDAL LANDS FERNDAL, WA 98248	
JOB NO.: 6022		DWG. NAME: 6022-CIVIL-ph2-2017-AB.dwg		DESIGNED BY: RL	
DRAWN BY: EH		CHECKED BY: RL		APPROVED: JUN 11 2018	
BY: CITY OF FERNDAL		PUBLIC WORKS DEPARTMENT		SANITARY SEWER & WATER DISTRIBUTION PLAN & PROFILE	
DRAKE RIDGE DEVELOPMENT: PHASE 2 MAIN STREET, FERNDAL, WA		SHEET 06 OF 08		06	



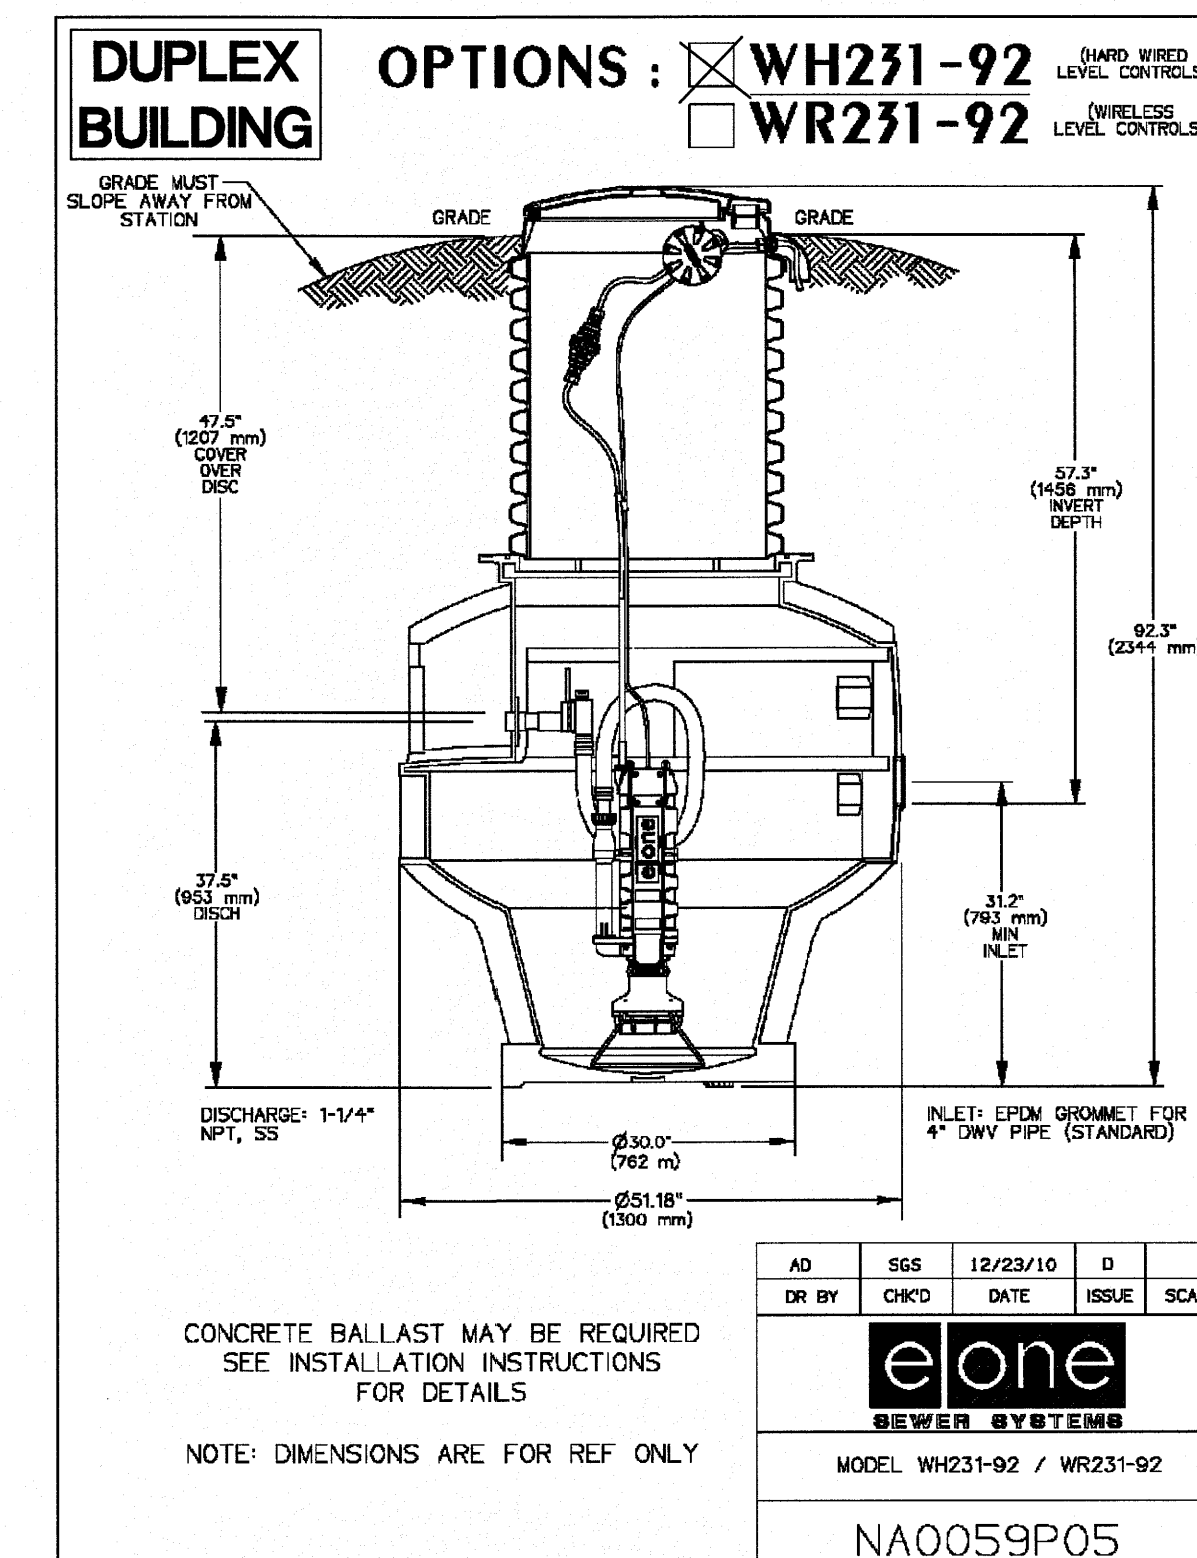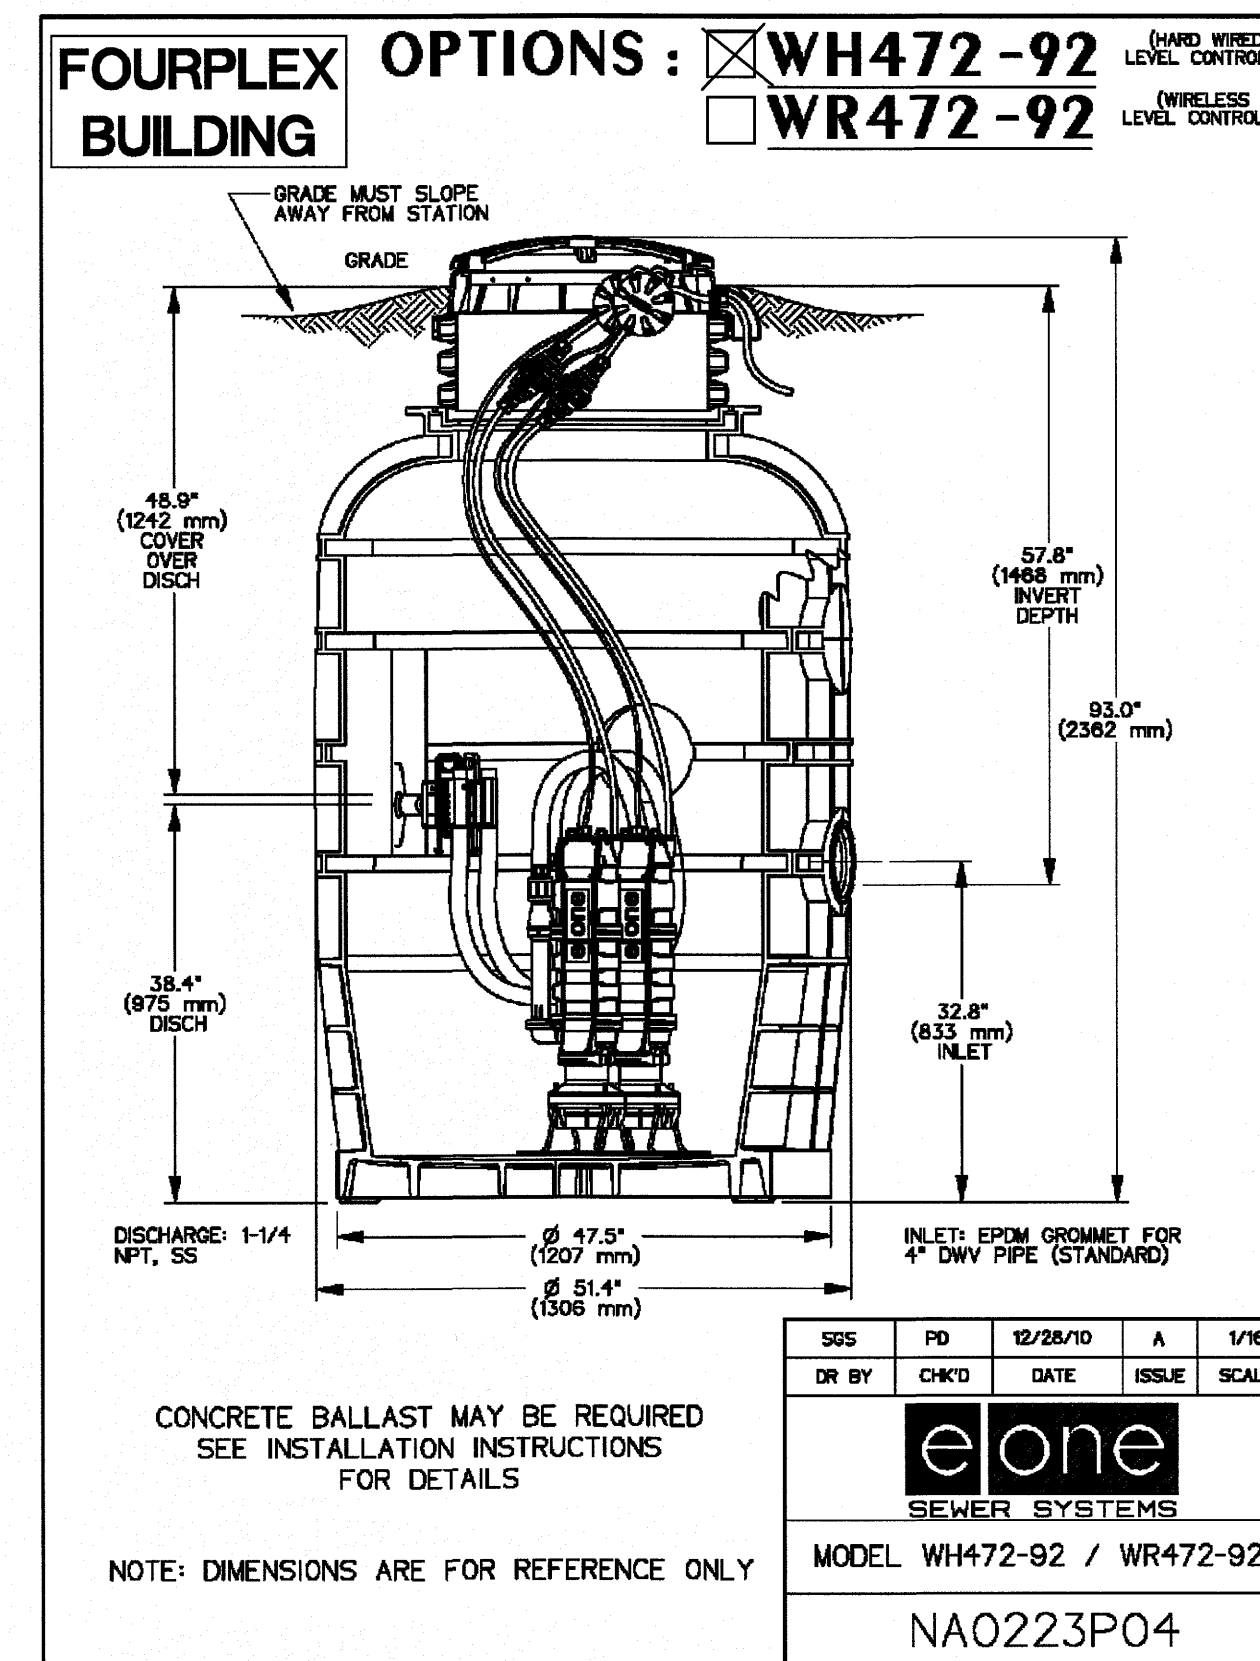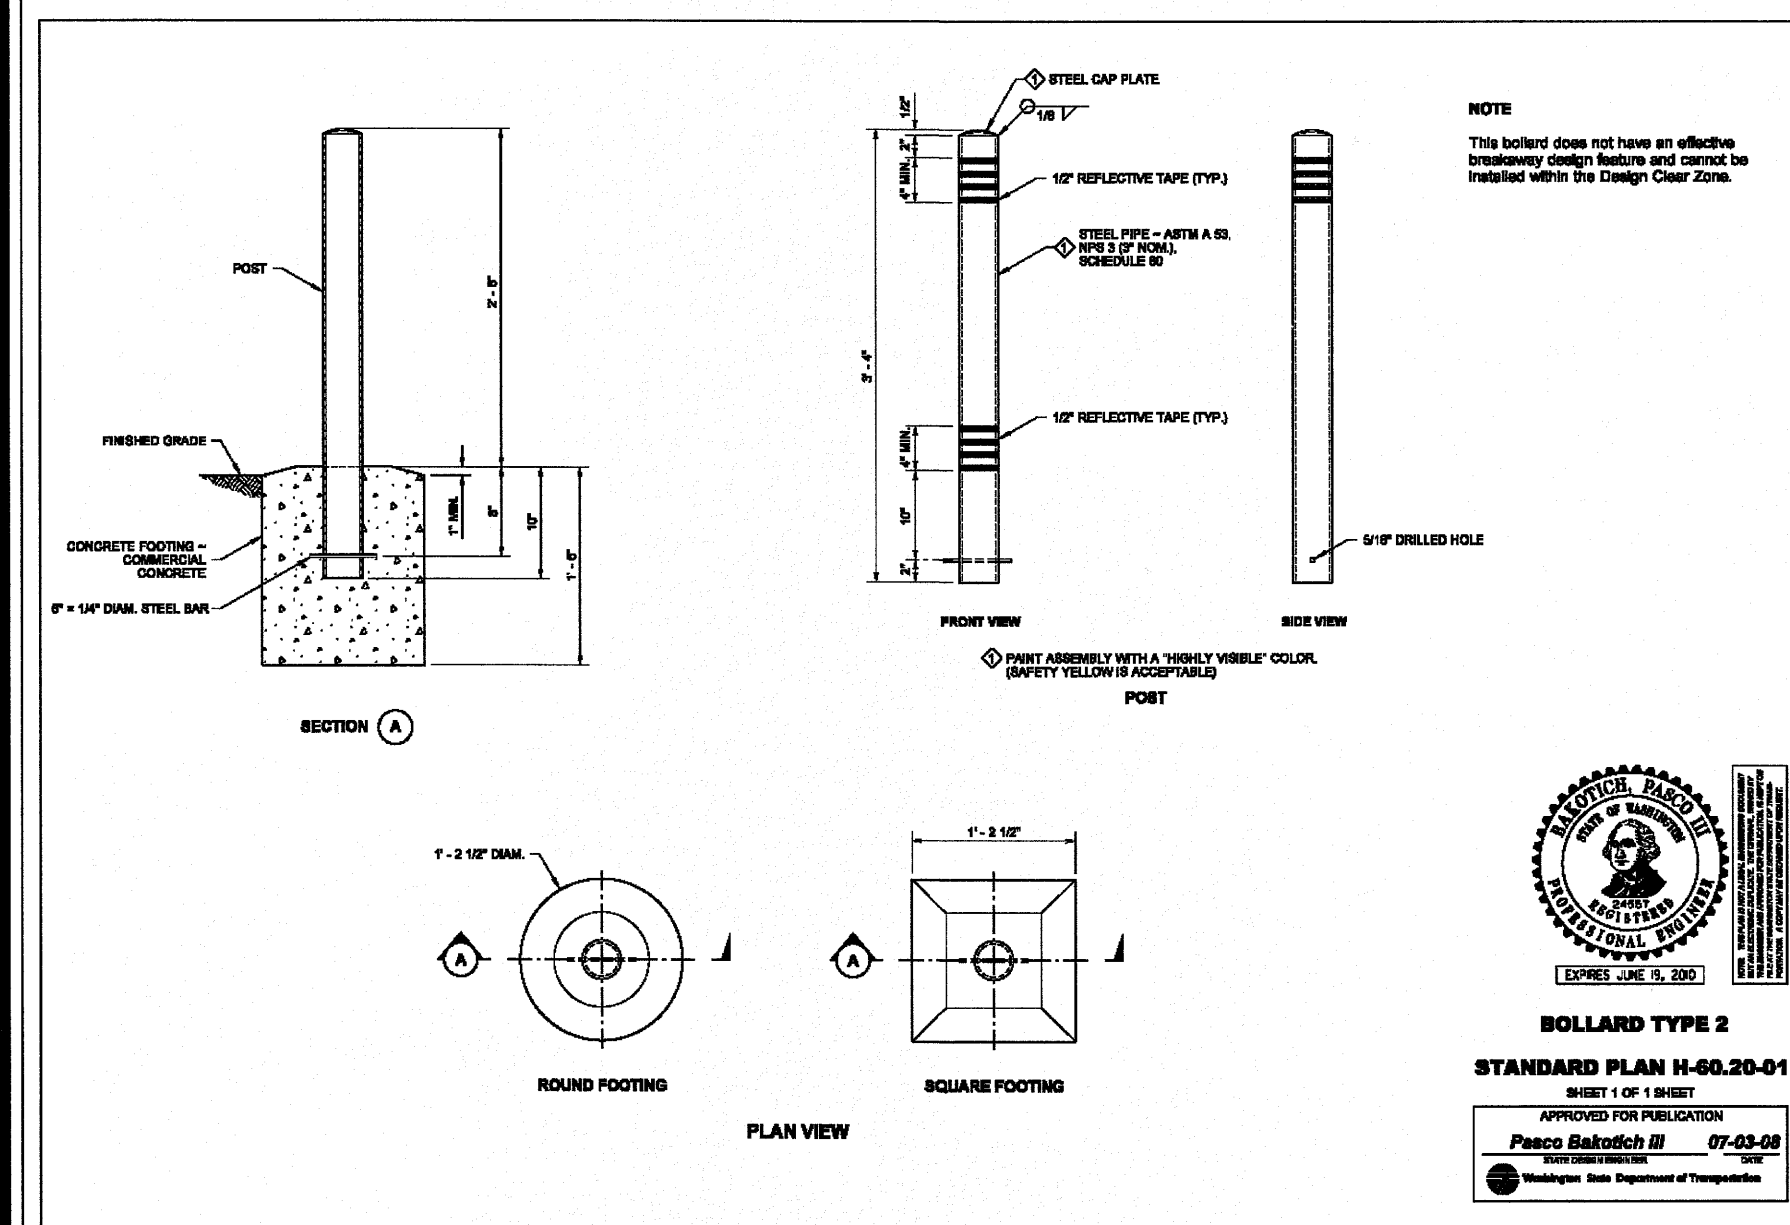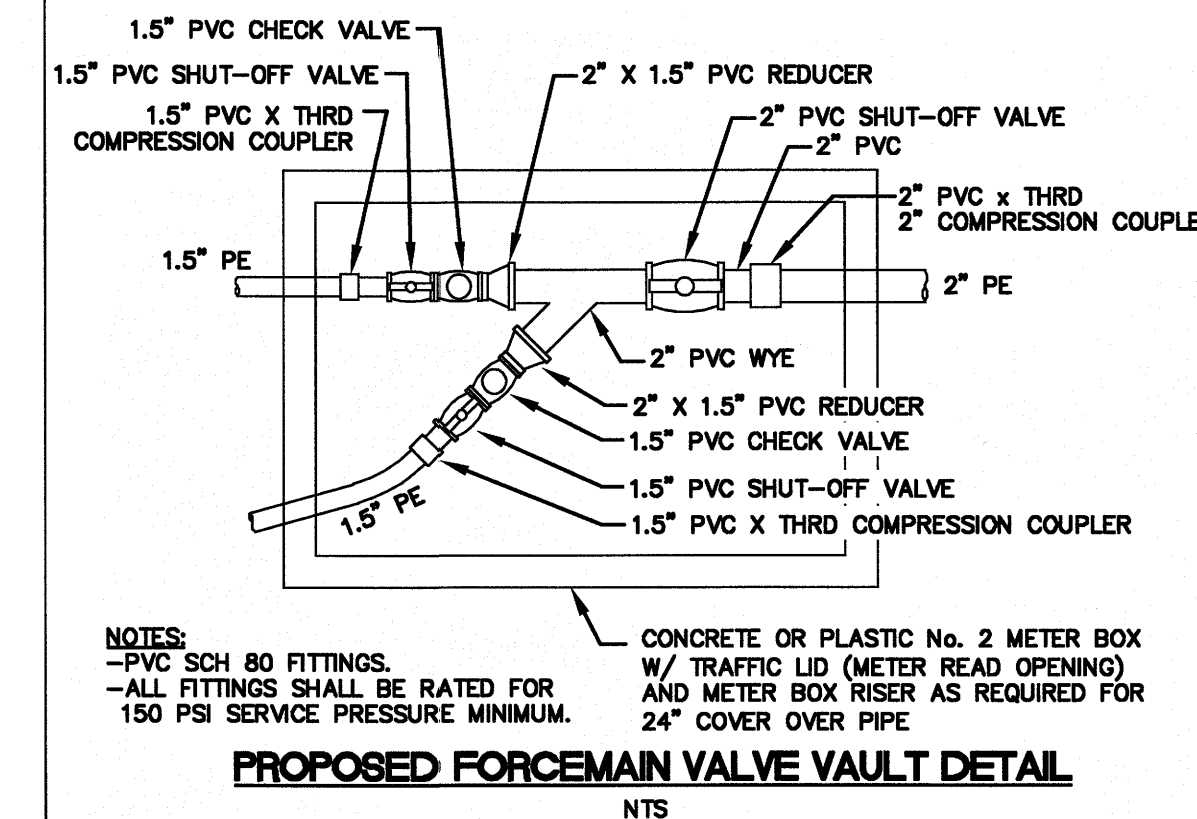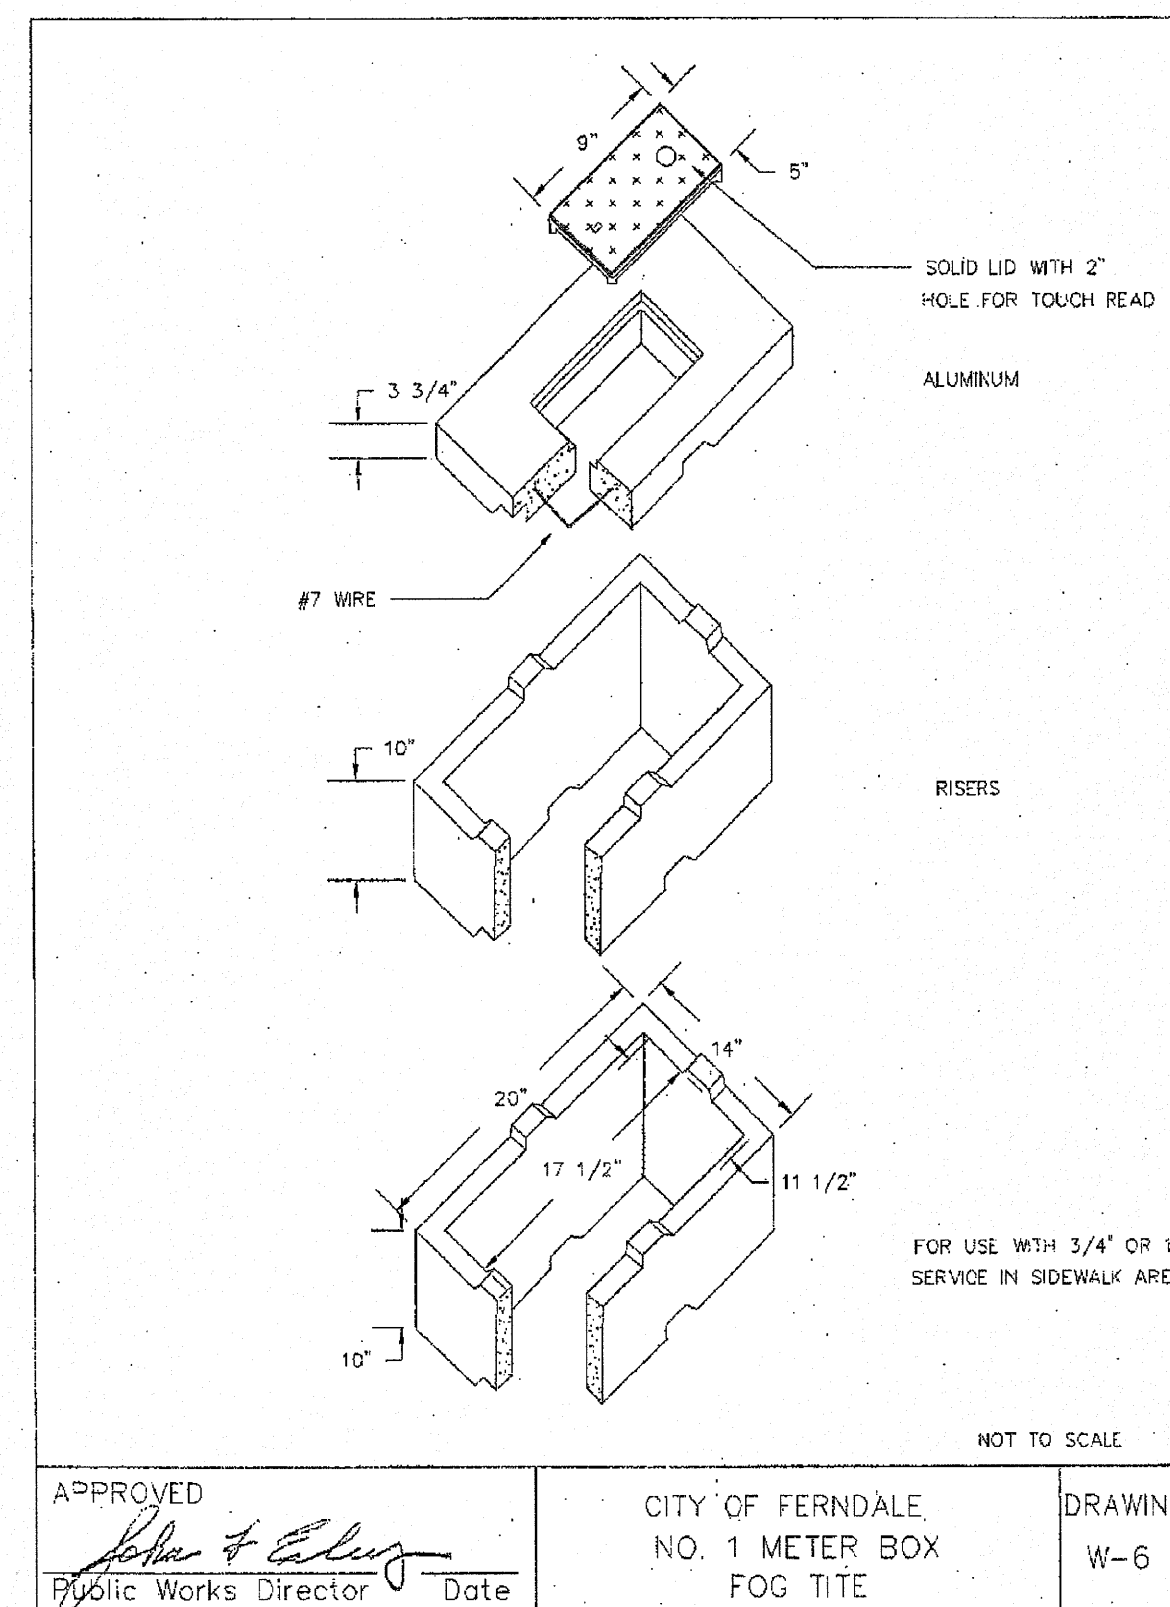

**LEWIS AND YORK, LLC**  
1292 W. AXTON RD  
FERNDALE, WA 98248

BY 3  
CITY OF FERNDALE  
PUBLIC WORKS DEPARTMENT

SHEET



OF

08





0	AS-BUILT SUBMITTAL 1	HJ	9/29/17
1	AS-BUILT SUBMITTAL 2	HJ/EH	01/03/18
2			
3			
4			
5			
NO.	REVISION	BY	DATE

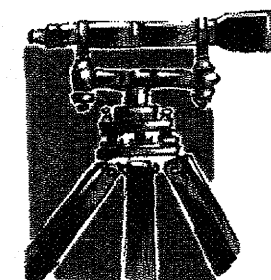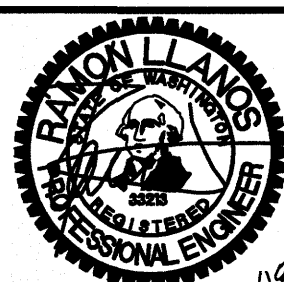

**LDES, INC.**  
**5160 INDUSTRIAL PL. #108**  
**FERNDALE, WA 98248**  
**PHONE 360-383-0620**  
**FAX 360-383-0639**

JOB NO.:	6022
DWG. NAME:	6022-CIVIL-ph2-2017-AB.dwg
DESIGNED BY:	RL
DRAWN BY:	EH
CHECKED BY:	RL

**LEWIS AND YORK, LLC**  
1292 W. AXTON RD  
FERNDALE, WA 98248

APPROVED

JAN 11 2018

BY 3  
CITY OF FERNDALE  
PUBLIC WORKS DEPARTMENT

## COMPOSITE UTILITY PLAN

**DRAKE RIDGE DEVELOPMENT: PHASE 2**  
**MAIN STREET, FERNDALE, WA**

SHEET

07

OF 08



