
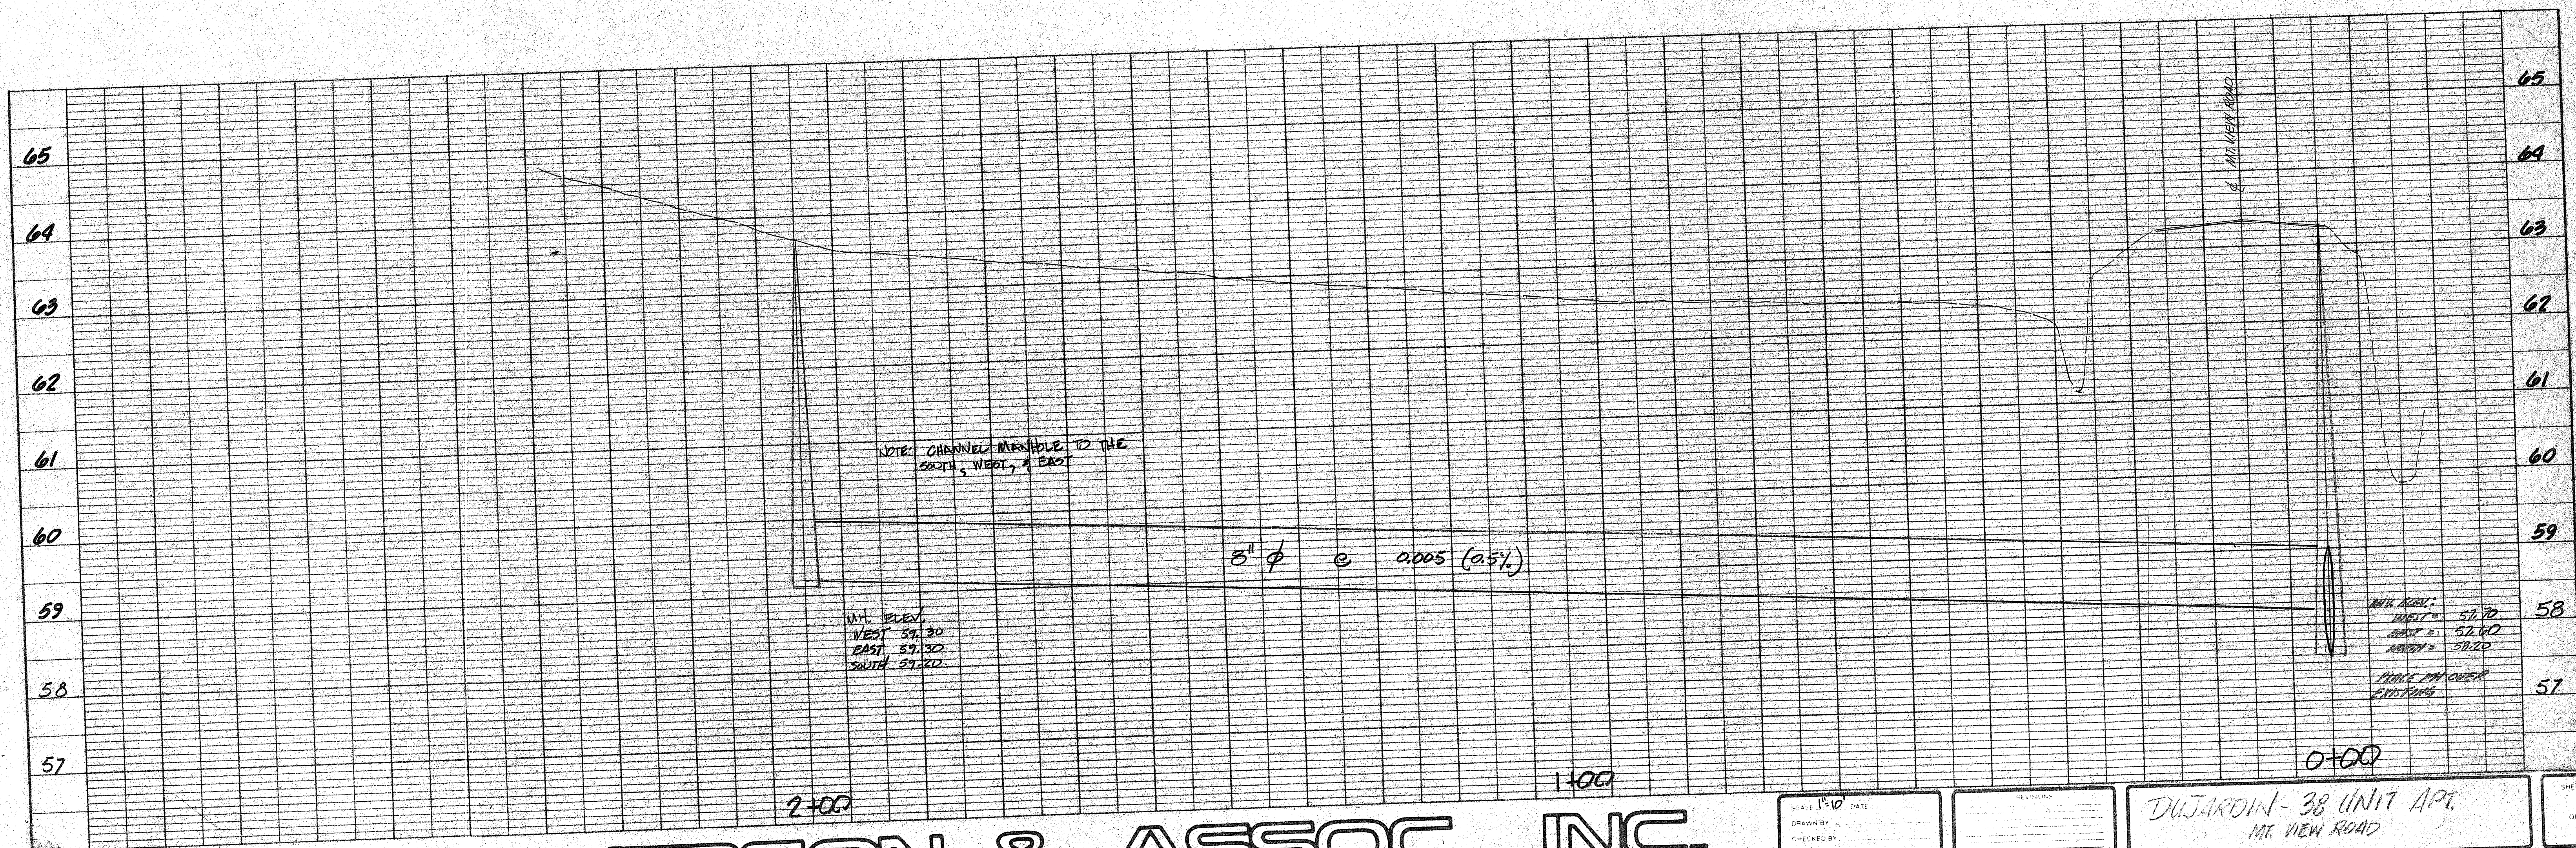
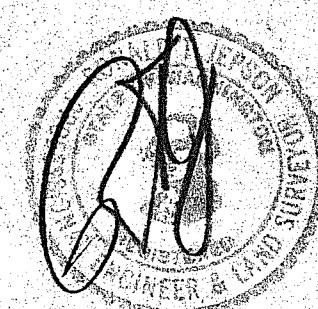


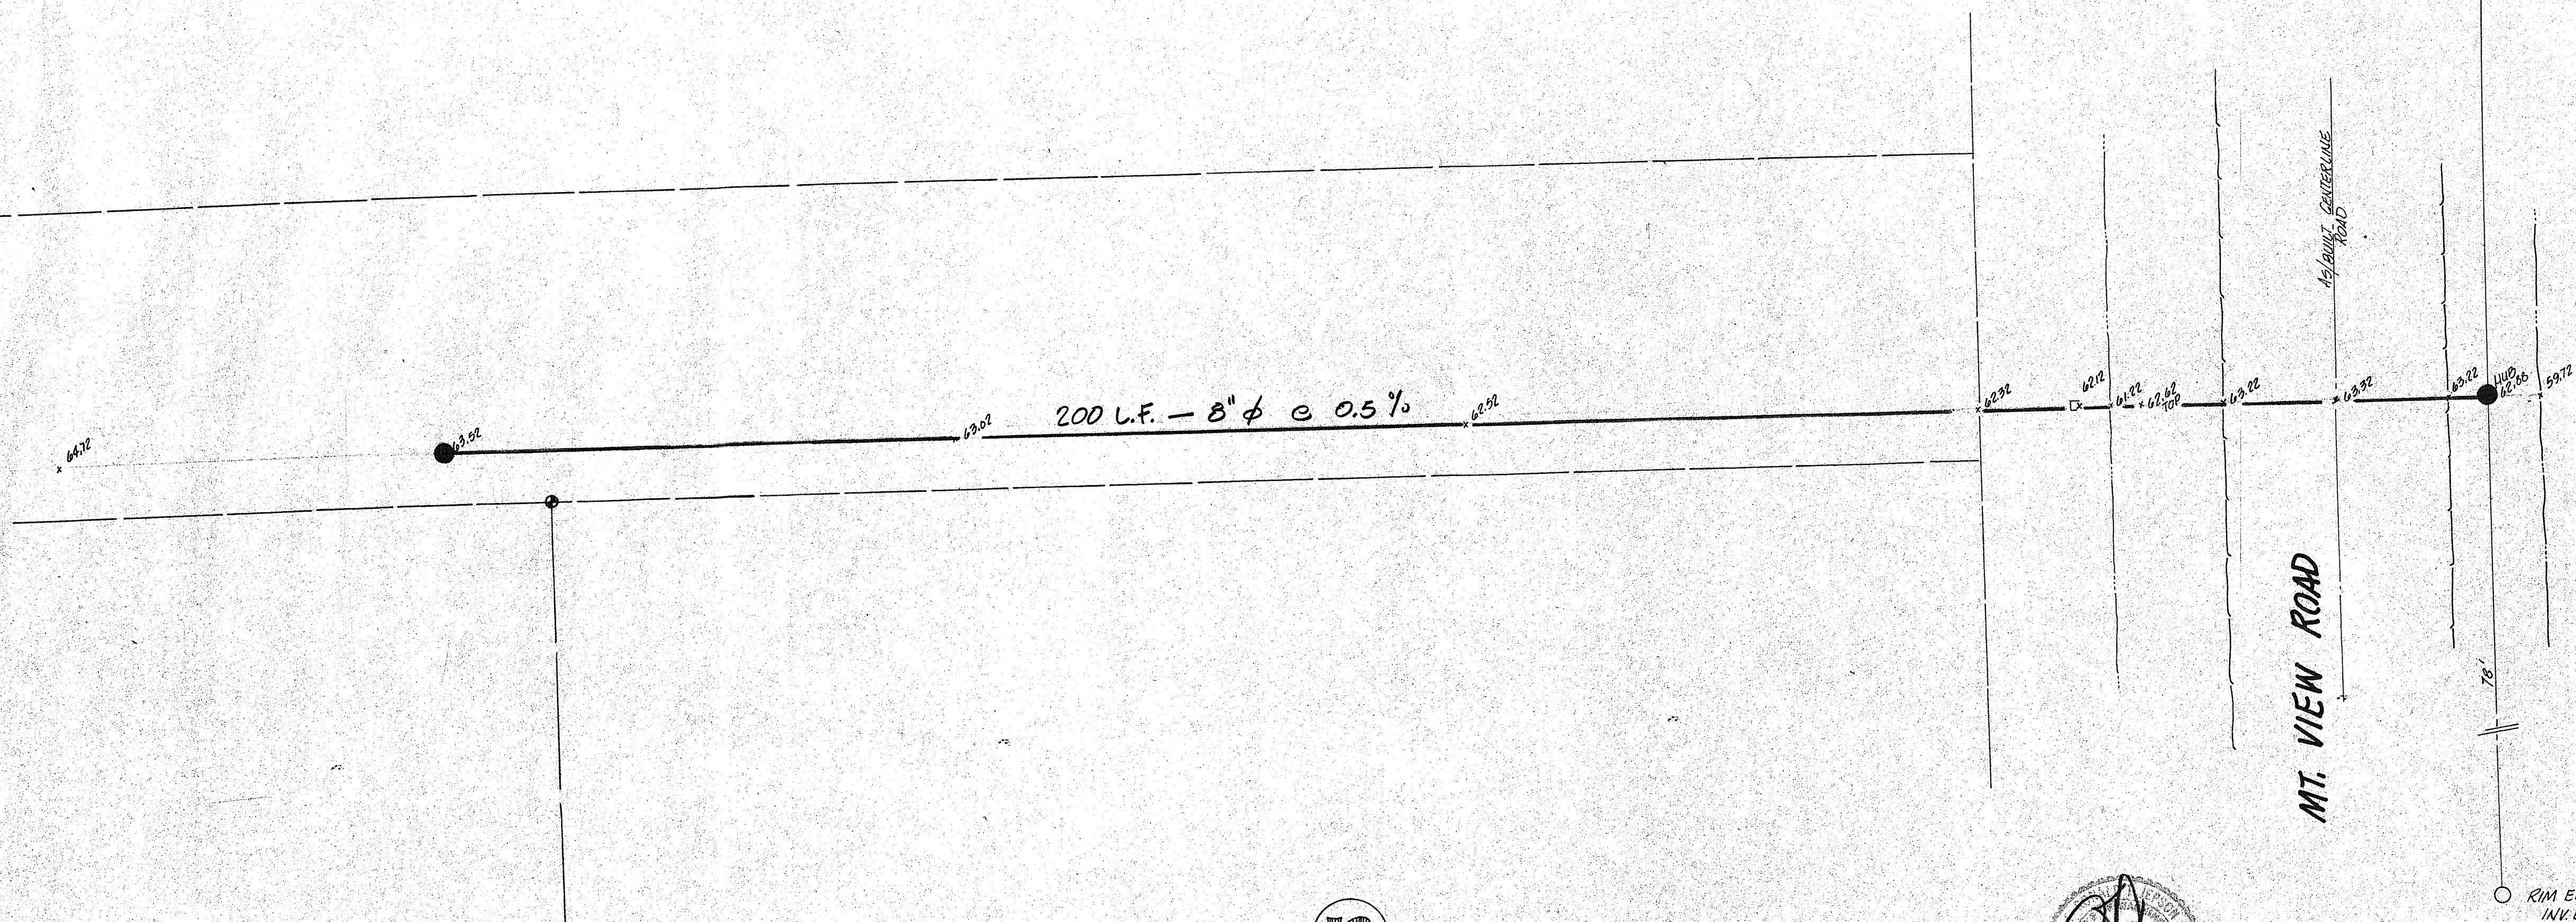

SHEET
OF



DUGARON-38 UNIT APR.
MT VIEW ROAD

REVISIONS


SCALE 1"=10'
DRAWN BY
CHECKED BY
APPROVED

1509 CORNWALL AVE
BELLINGHAM, WASHINGTON 98225
JEPSON & ASSOC., INC.

REGISTERED PROFESSIONAL ENGINEERS AND LAND SURVEYORS
RONALD T. JEPSON & ASSOC., INC.

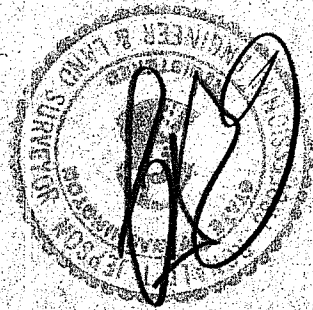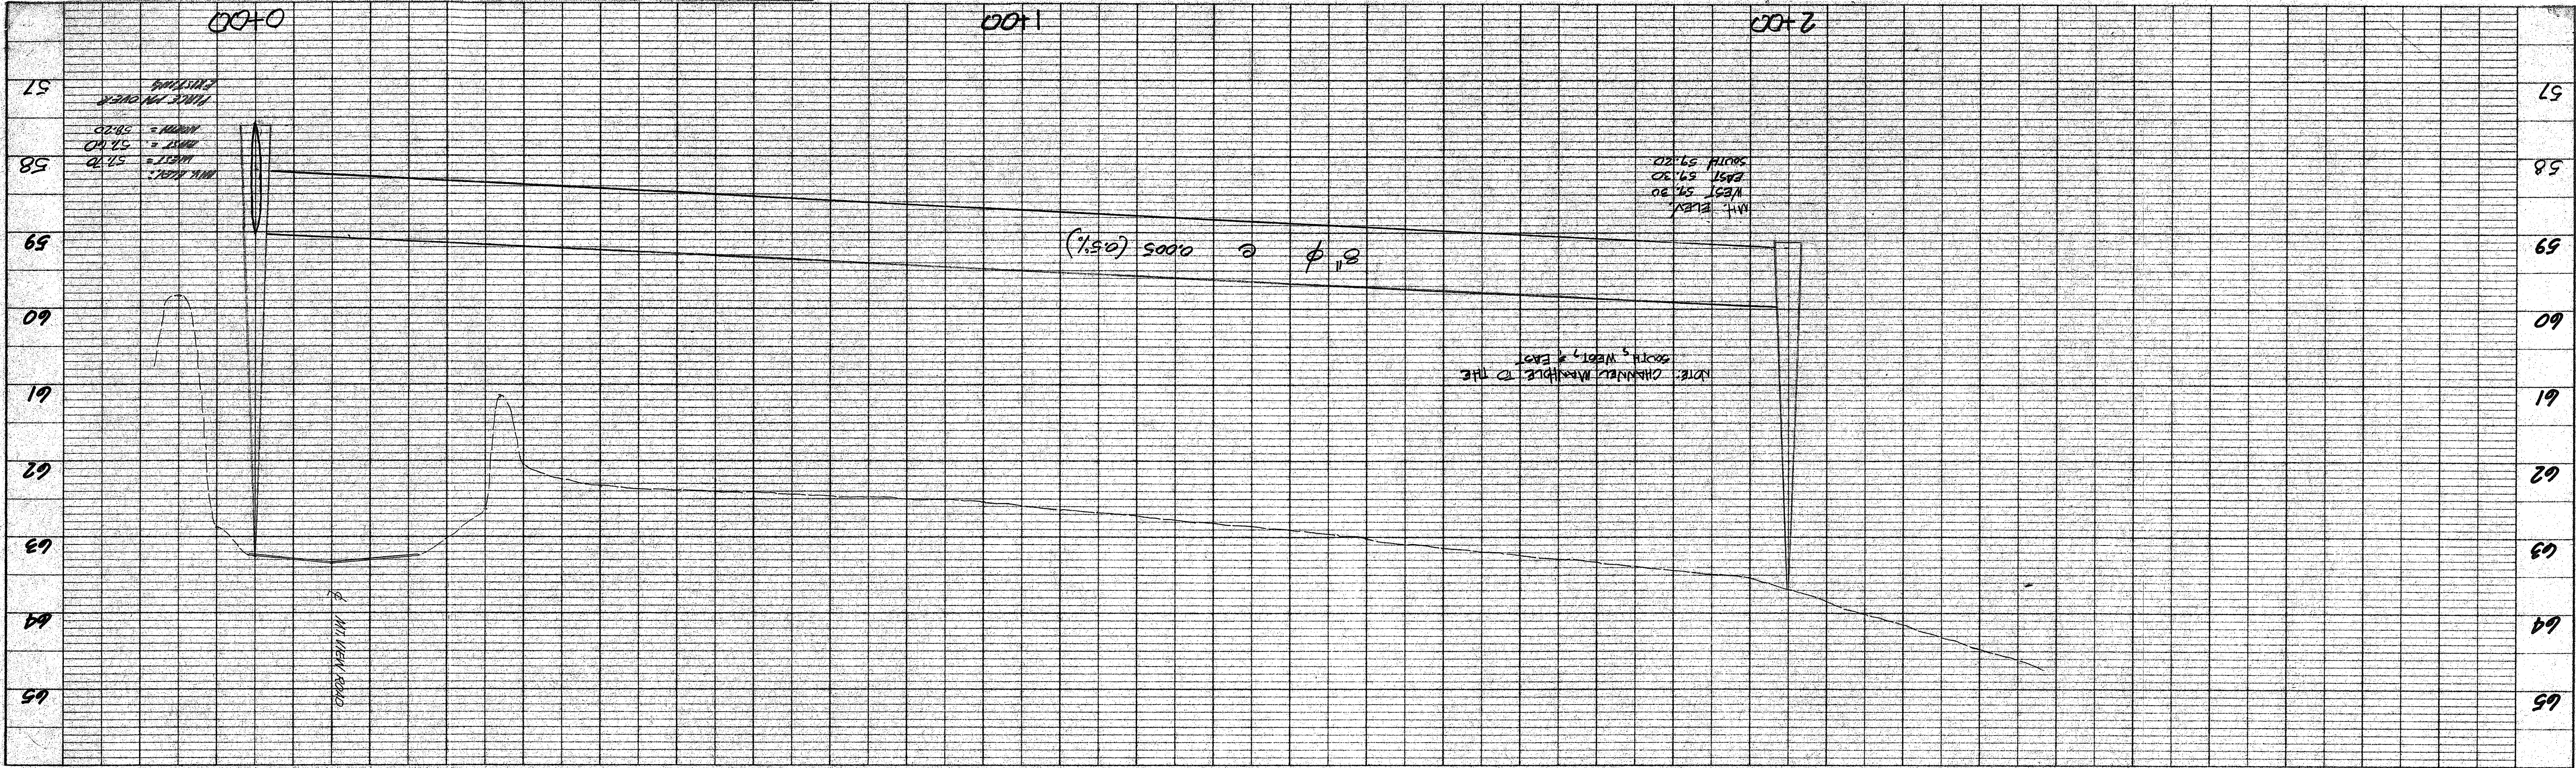

Scale 1"=10'

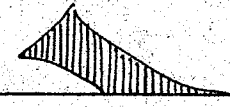

RIM EL. 58.07
INV EL. 58.02

MT. VIEW ROAD

WATER COLLECTION

RIM EL. 59.89
WEST INV. 59.04
EAST INV. 59.04

04441.00 2 S/21/12 06