


A PORTION OF THE NE 1/4 OF SECTION 30, TOWNSHIP 39 N., RANGE 2 E. OF THE W.M.
CITY OF FERNDAL, WHATCOM COUNTY, WASHINGTON

MAIN STREET VILLAGE

RECORD DRAWING

VICINITY MAP FERNDAL, WA

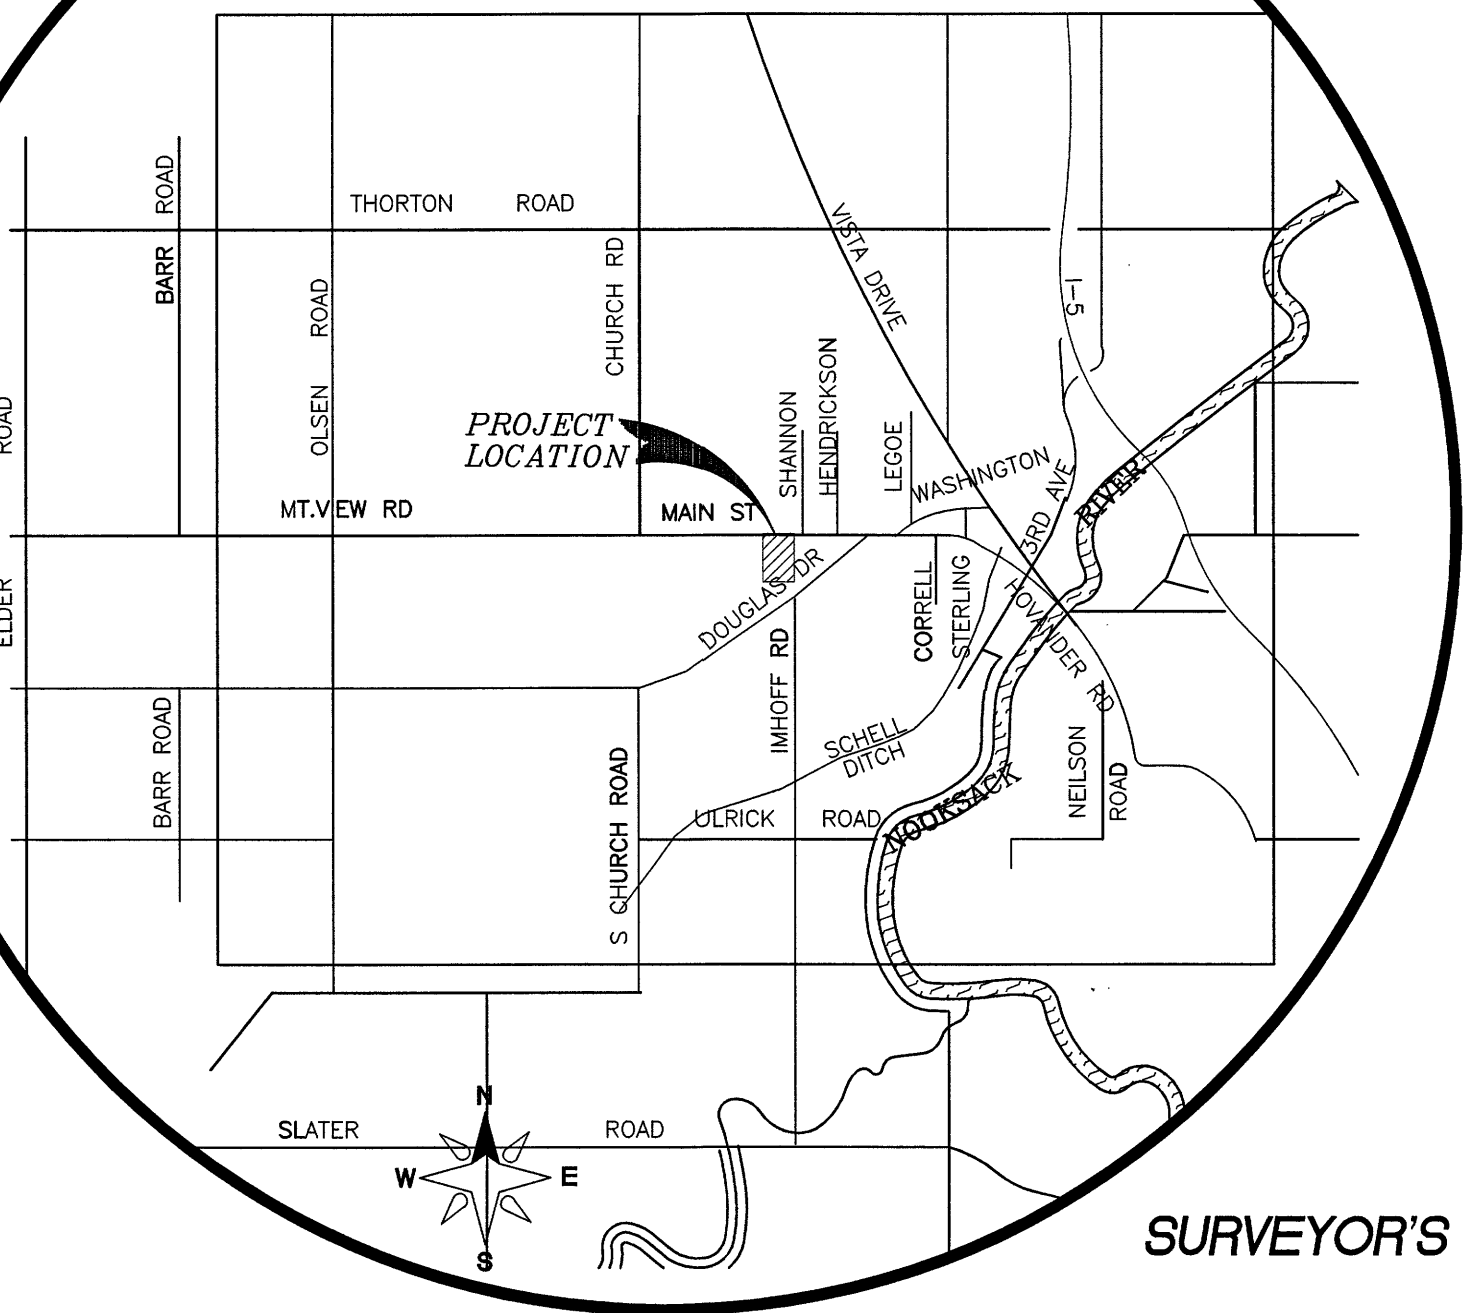


TOTAL PARCEL AREA: 167,046 SF
ROW AREA: 29,254 SF
LOT AREA: 137,792 SF
LOT TOTAL AS PROPOSED
11 LOTS

SURVEYOR'S NOTES:

- 1) DATA FOR THIS SURVEY WAS GATHERED BY FIELD TRAVERSE UTILIZING ELECTRONIC DATA COLLECTION ON FEBRUARY 2016.
 - 2) EQUIPMENT USED: LEICA TOR1203: 003" ± 2 PPM, ±2 MM
 - 3) HORIZONTAL DATUM: CGF NAD83/91
VERTICAL DATUM: NGVD29
 - 4) PURPOSE OF SURVEY: TOPOGRAPHIC SURVEY
 - 5) IN ACCORDANCE WITH THE REVISED CODE OF WASHINGTON: 58.09 AND WAC CHAPTER 332-130, THIS RECORD OF SURVEY DEPICTS OCCUPATIONAL INDICATORS, SUCH AS FENCES, THESE INDICATORS REPRESENT A POTENTIAL FOR CLAIMS OF UNWRITTEN TITLE. THIS SURVEY DOES NOT RESOLVE ANY OF THE LEGAL OWNERSHIP ISSUES THAT MAY ARISE FROM THESE UNWRITTEN TITLE CLAIMS.
 - 6) CONTOUR INTERVALS ARE 1 FOOT AND ARE COMPUTER GENERATED FROM GROUND FIELD TOPOGRAPHY GATHERED FOR THIS SURVEY UTILIZING ELECTRONIC DATA COLLECTION.
 - 7) UTILITY LOCATIONS SHOWN HEREON ARE BASED UPON FIELD LOCATION OF THE SURFACE EVIDENCE OF EXISTING STRUCTURES. UNDERGROUND UTILITY LOCATION SERVICES WERE NOT PROVIDED FOR THIS TOPOGRAPHIC SURVEY AND THE UNDERGROUND ROUTING OF REPORTED BURIED UTILITIES HAS NOT BEEN VERIFIED OR CONFIRMED WITH THE UTILITY PURVEYOR. ADDITIONAL UTILITY LOCATIONS AND UNDERGROUND UTILITY LOCATION PAINT MAPPING WILL BE REQUIRED PRIOR TO ANY CONSTRUCTION. THE CONTRACTOR SHALL VERIFY THE EXACT LOCATION, ELEVATION AND SIZE OF EXISTING UTILITIES PRIOR TO CONSTRUCTION.
- LEGAL DESCRIPTION
(PER WLT ORDER No. W-130884)
LOTS A AND B, LOT LINE ADJUSTMENT TO LOTS 1 AND 2, LA ROSE SHORT PLATS, ACCORDING TO THE PLAT THEREOF, RECORDED ON MARCH 28, 1991, IN VOLUME 23 OF SHORT PLAT, PAGE 62, UNDER AUDITOR'S FILE NUMBER 910328143, RECORDS OF WHATCOM COUNTY, WASHINGTON; EXCEPT THAT PORTION OF LOT B CONVEYED TO THE CITY OF FERNDAL BY DEED RECORDED UNDER AUDITOR'S FILE NUMBER 2120102782.
SITUATE IN WHATCOM COUNTY, WASHINGTON.

SHEET INDEX

1. COVER SHEET
2. CITY OF FERNDAL GENERAL NOTES
3. EXISTING CONDITIONS PLAN
4. TEMPORARY EROSION CONTROL - PLAN
5. PLAT
6. COMPOSITE UTILITY PLAN
7. ROAD & STORMWATER PLAN & PROFILE 1
8. ROAD & STORMWATER PLAN & PROFILE 2
9. ROAD & STORMWATER PLAN & PROFILE 3
- 9A. ROAD & STORMWATER PLAN & PROFILE 4 - EAST LOT
10. ROAD & STORMWATER PLAN & DETAILS - STORMWATER VAULT
11. ROAD & STORMWATER PLAN & PROFILE - MAIN STREET
12. GRADING PLAN
13. ROAD & STORM TYPICAL DETAILS 1
14. ROAD & STORM TYPICAL DETAILS 2
- 14A. ROAD & STORM TYPICAL DETAILS 3
15. CROSS SECTIONS
16. WATER PLAN & PROFILE - ONSITE CENTERLINE
17. WATER TYPICAL DETAILS
18. SEWER PLAN & PROFILE 1
19. SEWER PLAN & PROFILE 2 & SERVICE CROSS-SECTIONS
- 19A. SEWER SADDLE MANHOLE INSTALLATION DETAILS
20. SEWER TYPICAL DETAILS

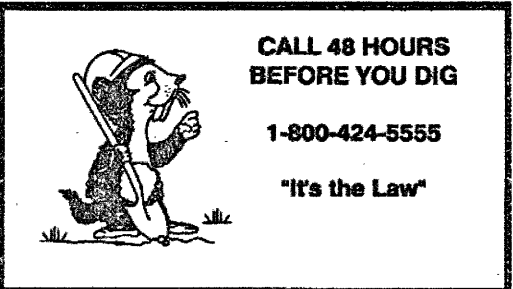

BURIED UTILITIES NOTE:
ALL UNDERGROUND UTILITIES SHOWN ON THIS PLAN ARE APPROXIMATE LOCATIONS ONLY AND THERE IS NO GUARANTEE THAT ALL UTILITIES ON THIS SITE ARE SHOWN. THE CONTRACTOR SHALL FIELD VERIFY THE LOCATIONS OF ALL UTILITIES PRIOR TO CONSTRUCTION. CONTACT THE WASHINGTON STATE UTILITY LOCATED CENTER AT LEAST 48 HOURS BEFORE CONSTRUCTION

LEGEND:

- = FND REBAR AND CAP
- ▲ = FND PK NAIL
- = FND BRASS MON
- * = CALCULATED POSITION
- = EXIST SANITARY SEWER MANHOLE
- = EXIST POWER/AND OR UTILITY POLE
- = EXIST GUY WIRE
- = EXIST TELEPHONE PEDESTAL
- = EXIST WATER VALVE
- = EXIST FIRE HYDRANT
- = EXIST WATER BLOW-OFF VALVE
- = EXIST SD CATCH BASIN (TYPE 1)
- = EXIST SD CATCH BASIN (TYPE 2)
- = EXIST GAS METER
- = EXIST LANDSCAPING
- = EXIST SIGN
- = EXIST STORM DRAIN LINE
- = EXIST SEWER DRAIN LINE
- = EXIST WATER LINE
- = EXIST GAS LINE
- = EXIST OVERHEAD POWER LINE
- = EXIST GUARDRAIL
- = EXIST WOOD FENCE
- = EXIST TOP OF BANK
- = EXIST BOTTOM OF BANK
- = EXIST DITCH
- = EXIST PATH
- = EXIST TREE LIN (BRUSH)
- = EXIST ORDINARY HIGH WATER MARK

PROPOSED LEGEND:



- = PROPOSED STORMDRAIN CATCHBASIN
- = PROPOSED STORMDRAIN FILTER
- = PROPOSED STORM DRAIN SERVICE
- = PROPOSED STORM DRAIN CLEANOUT
- = PROPOSED STORM DRAIN ROOF STUB
- = PROPOSED SANITARY SEWER MANHOLE
- = PROPOSED SANITARY SEWER SERVICE
- = PROPOSED WATER METER
- = PROPOSED FIRE HYDRANT
- = PROPOSED POST INDICATOR VALVE (PIV)
- = PROPOSED FIRE DEPARTMENT CONNECTION (FDC)
- = PROPOSED VALVE
- = PROPOSED BLOW-OFF
- = PROPOSED REDUCER
- = PROPOSED ADAPTER (FLXJM)
- = PROPOSED CAP
- = PROPOSED TEE
- = PROPOSED 45° BEND
- = PROPOSED 22.5° BEND
- = THRUST BLOCK
- = PROPOSED GAS METER
- = PROPOSED BOLLARD
- = PROPOSED STREET LIGHT
- = PROPOSED LANDSCAPE BUSH & TREE
- = PROPOSED GABION BASKET
- = PROPOSED STORMWATER PIPE, 8"
- = PROPOSED STORMWATER PIPE, 12"
- = PROPOSED CULVERT
- = PROPOSED DITCH
- = PROPOSED SEWER LINE, 8"
- = PROPOSED SEWER LINE, 6"
- = PROPOSED WATER LINE, 8"
- = PROPOSED WATER LINE, 6"
- = PROPOSED WATER LINE, 4"
- = PROPOSED CUT LINE
- = PROPOSED FILL LINE
- = PROPOSED TOP OF BANK
- = PROPOSED BOTTOM OF BANK
- = PROPOSED DITCH LINE
- = PROPOSED PERFORATED PIPE
- = PROPOSED ROOF & YARD DRAIN
- = PROPOSED COMMON UTILITIES
- = PROPOSED CONTOUR (INDEX)
- = PROPOSED CONTOUR (NORMAL)
- = EXIST CHAIN LINK FENCE
- = PROPOSED ASPHALT
- = PROPOSED CONCRETE
- = PROPOSED GRAVEL
- = PROPOSED STRIPING
- = WETLAND
- = PERMANENT BUFFER IMPACT 771 SF
- = TEMPORARY BUFFER IMPACT 2429 SF
- = NEW BUFFER AREA 4569 SF

CLIENT
PNRD, LLC.
PO BOX 3249
FERNDAL, WA 98248
CONTACT: SHAHGR SINGH GILL
(360) 296-2251

ENGINEER
LDES, INC.
5160 INDUSTRIAL PL., SUITE 108
FERNDAL, WA 98248
CONTACT: RAMON LLANOS, PE.
(360) 383-0620

SURVEYOR
LDES, INC.
5160 INDUSTRIAL PL., SUITE 108
FERNDAL, WA 98248
CONTACT: KYLE HAGGITH, PL.
(360) 383-0620

NO.	REVISION	BY	DATE	NO.	BY	DATE
1	SUBMITTAL 1	RL	04/23/19	1		
2				2		
3				3		
4				4		
5				5		

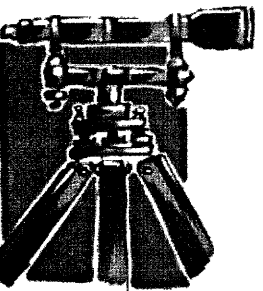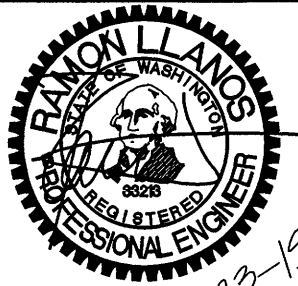

LDES, INC.
5160 INDUSTRIAL PL. #108
FERNDAL, WA 98248
PHONE 360-383-0620
FAX 360-383-0639

JOB NO.:	1602
DWG. NAME:	1602-CIVIL-ASB.dwg
DESIGNED BY:	RL
DRAWN BY:	EH
CHECKED BY:	RL

PNRD
PO BOX 3249
FERNDAL, WA 98248

APPROVED
JUN 13 2019
BY
CITY OF FERNDAL
PUBLIC WORKS DEPARTMENT

COVER

MAIN STREET VILLAGE
2312 MAIN STREET, FERNDAL, WA
A PORTION OF SECTION 30, TOWNSHIP 39N, RANGE 2E, W.M.

SHEET
01
OF
20

RECORD DRAWING

\\SERVER\Share\Common\Land Projects\2016\1602-CIVL-ASB.dwg PLOT DATE: 6/12/2019 4:50 PM

GENERAL REQUIREMENTS:

- ALL WORK AND MATERIALS SHALL CONFORM TO THESE PLANS AND TO THE REQUIREMENTS OF THE CURRENT EDITION OF THE "STATE OF WASHINGTON, DEPARTMENT OF TRANSPORTATION STANDARD SPECIFICATIONS FOR ROAD, BRIDGE AND MUNICIPAL CONSTRUCTION" (WSDOT SPECS.), THE CITY OF FERNDALE DEVELOPMENT STANDARDS (COFDS) AND THE 2005 VERSION OF THE DEPARTMENT OF ECOLOGY STORM WATER MANAGEMENT MANUAL FOR WESTERN WASHINGTON (DCE MANUAL). IN CASE OF A CONFLICT BETWEEN PLANS, REGULATORY STANDARDS OR SPECIFICATIONS, THE MORE STRINGENT REQUIREMENT WILL PREVAIL.
- PRIOR TO THE START OF CONSTRUCTION, THE CONTRACTOR SHALL VERIFY THAT ALL REQUIRED PERMITS AND APPROVALS HAVE BEEN OBTAINED. NO CONSTRUCTION OR FABRICATION SHALL BEGIN UNTIL THE CONTRACTOR HAS RECEIVED AND THOROUGHLY REVIEWED ALL PLANS AND OTHER CONSTRUCTION DOCUMENTS APPROVED BY ALL OF THE PERMITTING AUTHORITIES. THROUGHOUT THE PERIOD OF CONSTRUCTION, CONTRACTOR SHALL COMPLY WITH THE TERMS OF ALL PERMITS.
- THE CONTRACTOR MUST HAVE A FULL SET OF CITY CONTRACT DOCUMENTS ON THE SITE WHENEVER CONSTRUCTION IS IN PROGRESS.
- CONSTRUCTION NOISE SHALL BE LIMITED TO BETWEEN 7 a.m. TO 8 p.m., MONDAY THROUGH SATURDAY.
- THE CONTRACTOR SHALL CONTACT THE UTILITIES UNDERGROUND LOCATION CENTER AT LEAST 72 HOURS PRIOR TO STARTING CONSTRUCTION. PHONE: 1-800-424-5555. IT IS THE CONTRACTOR'S RESPONSIBILITY TO CONTACT ALL OF THE VARIOUS UTILITY COMPANIES TO ARRANGE FOR FIELD LOCATIONS OF ALL EXISTING UTILITY FACILITIES. NO EXTRA COMPENSATION WILL BE PAID TO THE CONTRACTOR FOR COSTS INCURRED BECAUSE OF DAMAGE DONE TO EXISTING FACILITIES BY THE CONTRACTOR'S WORK FORCE, INCLUDING COSTS FOR REPAIRS, WHICH WILL BE CONTRACTOR'S SOLE RESPONSIBILITY. THE CONTRACTOR SHALL BE RESPONSIBLE FOR MAINTAINING THE INTEGRITY OF ALL EXISTING UTILITIES AND TO NOTIFY THE ENGINEER PROMPTLY OF ANY CONFLICT BETWEEN THE APPROVED PLANS AND THE LOCATION OF ANY EXISTING UTILITIES. THE CONTRACTOR SHALL PROTECT ALL PRIVATE AND PUBLIC UTILITIES FROM DAMAGE RESULTING FROM THE WORK. CONTRACTOR SHALL RESTORE ALL PRIVATE AND PUBLIC PROPERTY DISRUPTED BY THE PROJECT IMMEDIATELY AFTER CONSTRUCTION.
- THE CONTRACTOR SHALL BE RESPONSIBLE FOR MAINTAINING EROSION CONTROL MEASURES THROUGHOUT THE DURATION OF THE PROJECT. EROSION CONTROL MEASURES SHALL BE INSTALLED PRIOR TO ANY CLEARING OR GRADING IN CONFORMANCE WITH THE EROSION & SEDIMENTATION CONTROL PLAN AND THE STORM WATER POLLUTION PREVENTION PLAN (SWPPP). THE SWPPP SHALL BE ON-SITE AT ALL TIMES DURING CONSTRUCTION ACTIVITIES.
- SITE CLEARING SHALL INCLUDE THE LOCATION AND REMOVAL OF ALL ABOVE GROUND AND BURIED DEBRIS AND WASTE THAT MAY BE PRESENT.
- THE CONTRACTOR SHALL OBTAIN REVOCABLE ENCROACHMENT PERMITS FROM THE CITY OF FERNDALE AND/OR WHATCOM COUNTY PRIOR TO COMMENCING WORK WITHIN THE PUBLIC RIGHT-OF-WAY.
- THE CONTRACTOR SHALL ATTEND A PRE-CONSTRUCTION MEETING WITH REPRESENTATIVES OF THE CITY OF FERNDALE PUBLIC WORKS DEPARTMENT AND THE PROJECT ENGINEER A MINIMUM OF THREE (3) WORKING DAYS PRIOR TO THE START OF CONSTRUCTION. THE CITY WILL SCHEDULE THE MEETING.
- ALL WORK AND MATERIALS SHALL BE SUBJECT TO APPROVAL BY THE CITY OF FERNDALE PUBLIC WORKS DEPARTMENT. REPRESENTATIVES FROM THE CITY OF FERNDALE PUBLIC WORKS DEPARTMENT MUST INSPECT ALL WORK IDENTIFIED ON THE PLANS, BOTH PUBLIC AND PRIVATE. THE CONTRACTOR SHALL CALL AT LEAST 24 HOURS IN ADVANCE TO SCHEDULE INSPECTIONS AS FOLLOW:
 - PLACEMENT OF TEMPORARY EROSION CONTROL MEASURES.
 - CONSTRUCTION OF STORMWATER MANAGEMENT FACILITIES.
 - PLACEMENT OF WATER MAIN AND BACKFILLING OF WATER MAIN TRENCH WITHIN ROAD RIGHTS OF WAY OR IN WATERLINE EASEMENT TO BE DEDICATED TO THE CITY OF FERNDALE.
 - PLACING OR BACKFILLING OF UNDERGROUND UTILITIES, STORM SEWER AND SANITARY SEWER WITHIN ROAD RIGHTS-OF-WAY, IN EASEMENTS TO BE DEDICATED TO THE CITY OF FERNDALE, OR OTHER PUBLICLY SHARED FACILITIES.
 - GRADING OF PUBLIC OR PRIVATE ROADWAY AT:
 - COMPLETION OF EXCAVATION TO SUBGRADE.
 - COMPLETION OF BALLAST COURSE PLACEMENT.
 - COMPLETION OF CRUSHED SURFACING COURSE PLACEMENT.
 - POURING OF CURB AND GUTTER AND SIDEWALK IN PUBLIC ROADWAY.
 - ASPHALT PAVING IN PROGRESS IN PUBLIC ROADWAY.
 - OVERALL INSPECTION FOR FINISHED SHOULDERS, DITCHES, PERMANENT SEEDING AND MONUMENT PLACEMENT.
 - END OF MAINTENANCE PERIOD.
- THE CONTRACTOR SHALL BE RESPONSIBLE FOR PROVIDING ADEQUATE SAFEGUARDS, SAFETY DEVICES, PROTECTIVE EQUIPMENT FLAGGERS, AND ANY OTHER NEEDED ACTIONS TO PROTECT THE LIFE, HEALTH AND SAFETY OF THE PUBLIC, AND TO PROTECT PRIVATE & PUBLIC PROPERTY IN CONNECTION WITH THE PERFORMANCE AND WORK BY THE CONTRACTOR. ANY WORK WITHIN THE TRAVELED RIGHT-OF-WAY THAT MAY INTERRUPT NORMAL TRAFFIC FLOW SHALL REQUIRE AT LEAST ONE FLAGGER FOR EACH LANE OF TRAFFIC AFFECTED. A TRAFFIC CONTROL PLAN SHALL BE SUBMITTED TO THE CITY FOR APPROVAL PRIOR TO PERFORMING THE WORK. ALL SECTIONS OF THE WSDOT STANDARD SPECIFICATIONS 1-07.23- TRAFFIC CONTROL, SHALL APPLY.
- THE CONTRACTOR SHALL INFORM THE ENGINEER AND OBTAIN APPROVAL FROM THE CITY OF FERNDALE PUBLIC WORKS DIRECTOR OF ANY PROPOSED DEVIATION FROM THE APPROVED PLANS PRIOR TO CONSTRUCTION OF THE REVISED IMPROVEMENTS. THE CONTRACTOR SHALL KEEP RECORDS OF ALL DEVIATIONS AND SHALL FORWARD THEM TO THE ENGINEER AND TO THE CITY OF FERNDALE PUBLIC WORKS DEPARTMENT.
- AS-BUILT DATA SHALL BE PROVIDED TO THE CITY OF FERNDALE UPON COMPLETION OF CONSTRUCTION AND PROVIDED IN CITY OF FERNDALE DATUM - VERTICAL (NSD 29) AND HORIZONTAL (NAD 83/91). CONTACT THE CITY FOR MORE INFORMATION ON SUBMITTAL REQUIREMENTS.

UNDERGROUND UTILITIES CONSTRUCTION:

- THE CONTRACTOR IS RESPONSIBLE FOR COORDINATING WITH THE ENGINEER TO ASSURE ACCURATE AND TIMELY COLLECTION OF ALL REQUIRED AS-BUILT DATA. THIS DATA MUST ACCURATELY REFLECT THE LOCATIONS OF ALL UNDERGROUND UTILITIES, BOTTOM OF PIPE ELEVATIONS, INVERT ELEVATIONS, MANHOLE LOCATIONS, WATER SERVICE TAPS, BLOW-OFF LOCATIONS AND INVERTS OF SERVICE CONNECTIONS (BOTH AT PIPE AND AT PROPERTY LINE), VERTICAL AND HORIZONTAL BENDS, SERVICE BOXES AND METERS, VALVES AND HYDRANTS. CALL THE PROJECT ENGINEER AT LEAST 48-HOURS BEFORE BURYING UNDERGROUND PIPE TO ASSURE AND FACILITATE REQUIRED AS-BUILT SURVEY.
- THE CONSTRUCTION OF UNDERGROUND UTILITY LINES SHALL BE SUBJECT TO THE FOLLOWING CRITERIA:
 - NO MORE THAN 500 FEET OF TRENCH SHALL BE OPENED AT ONE TIME.
 - WHERE CONSISTENT WITH SAFETY AND SPACE CONSIDERATIONS, EXCAVATED MATERIAL SHALL BE PLACED ON THE UPHILL SIDE OF DITCHES.
 - TRENCH Dewatering DEVICES SHALL DISCHARGE INTO SEDIMENT TRAPS OR SEDIMENT PONDS.
 - WHERE PRACTICAL, INSTALL GRAVITY PIPE UTILITIES PRIOR TO INSTALLATION OF OTHER UTILITIES.
 - UTILITY CONSTRUCTION SHALL BE DONE IN ACCORDANCE WITH THE REQUIREMENTS OF THE CITY OF FERNDALE DEVELOPMENT STANDARDS.
 - ALL UTILITY TRENCHES IN THE RIGHT OF WAY SHALL BE BACKFILLED WITH 9-INCH MINUS OR 5/8-INCH MINUS WELL GRADED CRUSHED ROCK.
 - TESTING OF NEW WATER LINES, STORM SEWER SYSTEMS SHALL NOT BE PERFORMED UNTIL ALL OTHER ADJACENT UTILITIES HAVE BEEN INSTALLED.
 - ALL UTILITY TRENCHES SHALL BE BACKFILLED AND COMPACTED TO 95% DENSITY IN LIFTS NOT TO EXCEED 24 INCHES WITH A "HOE PACK, OR 8 INCHES WITH HAND-OPERATED COMPACTION".
 - OPEN CUTTING OF EXISTING ROADWAYS IS ONLY ALLOWED AS APPROVED AND NOTED ON THESE APPROVED PLANS. ANY OPEN CUT SHALL BE RESTORED IN ACCORDANCE WITH THE FERNDALE STANDARD TRENCH DETAIL(S). ALL UTILITY TRENCHES UNDERNEATH AN EXISTING ROADWAY SHALL BE BACKFILLED WITH 150 PSF CONTROLLED DENSITY FILL.
 - NO PART OF THE DRAINAGE SYSTEM MAY BE COVERED, CONCEALED, OR PUT INTO USE UNTIL IT HAS BEEN INSPECTED, TESTED, AND ACCEPTED BY THE CITY INSPECTOR.
 - A MINIMUM OF 5-FOOT SEPARATION IS REQUIRED BETWEEN THE WET UTILITIES (WATER, SEWER, STORM) SHOWN ON THE PLANS AND THE DRY UTILITIES (GAS, POWER, CABLE AND POWER) THAT MAY OR MAY NOT BE SHOWN ON THE PLANS.

EARTHWORK:

- THE CONTRACTOR SHALL REMOVE AND REPLACE ALL EXISTING UN-COMPACTED OR POORLY COMPACTED FILL SOILS WITHIN THE ROAD FROM AT THE DIRECTION OF THE ENGINEER.
- THE CONTRACTOR SHALL EXCAVATE AND GRADE TO THE ALIGNMENT, GRADE AND CROSS-SECTIONS SHOWN IN THE PLANS OR ESTABLISHED BY THE ENGINEER.
- UNSATURABLE MATERIAL FOUND AND NOT FIT FOR USE AS A SUB-GRADE SHALL BE EXCAVATED TO THE BOUNDARIES SET BY THE ENGINEER AND REPLACED WITH A SUITABLE BACKFILL MATERIAL.
- THE ENGINEER IS REQUIRED TO CERTIFY SUBGRADE, IN WRITING, PRIOR TO PAVING.

BASE COURSES AND SURFACING:

- GRAVEL BASES AND BALLAST MATERIAL GRADATION SHALL MEET WSDOT STANDARD SPECIFICATIONS.
- BALLAST, GRAVEL BASE AND CRUSHED SURFACING SHALL BE COMPACTED TO AT LEAST 95% OF MAXIMUM DRY DENSITY.
- THE GRADED AND COMPACTED SURFACE OF THE CRUSHED SURFACING TOP COURSE SHALL BE WITHIN 1/8 INCH OF FINISHED GRADE.
- THE CONTRACTOR SHALL BE RESPONSIBLE FOR ALL MATERIAL AND COMPACTION TESTING. PRIOR TO IMPORTING OF MATERIAL FOR BASE AND CRUSHED SURFACING TOP COURSE THE CONTRACTOR SHALL PROVIDE EVIDENCE OF SATISFACTORY PASSING GRADING AND DEGRADATION TEST RESULTS TO THE ENGINEER.

STORM DRAINAGE:

- THE FOLLOWING STANDARD DETAILS SHALL BE USED FOR CONSTRUCTION OF STORM DRAIN IMPROVEMENTS:

CATCH BASINS TYPE 1, 1L OR 2	WSDOT STD. DETAILS B-5.20, B-5.40 OR B-10.20
"RESIDENTIAL SERVICE LINE"	COFSD ST-7 (CITY OF FERNDALE STD DETAIL)
CATCH BASINS	COFSD ST-16 (CITY OF FERNDALE STD DETAIL)
- STORM SEWER PIPE HAVING DIAMETERS GREATER THAN 8" SHALL BE CORRUGATED POLYETHYLENE PIPE (PEEP); ALL OTHER STORM SEWER PIPE SHALL BE PVC.
- ALL CATCH BASIN GRATES SHALL INCLUDE THE STAMPING "OUTFALL TO STREAM, DUMP NO POLLUTANTS".
- CONTROL DENSITY FILL SHALL BE USED IN AREAS WHERE LESS THAN 18" OF COVER IS MAINTAINED OVER THE PROPOSED STORM PIPES (PIPE IS IN ROAD BASE SECTION), AS SHOWN IN THE PLANS. DUCTILE IRON PIPE MAY BE USED FOR STORM PIPES WITH LESS THAN 18" OF COVER IF APPROVED BY THE CITY.
- COVER OVER PIPES SHALL BE MAINTAINED DURING CONSTRUCTION. DEPTH OF COVER REQUIRED SHALL CONFORM TO THE MANUFACTURER'S RECOMMENDATIONS AND WILL VARY WITH THE VEHICLE LOADS TRAVELING OVER THE PIPE. NO ADDITIONAL COMPENSATION SHALL BE PROVIDED FOR DAMAGE TO PIPE DURING CONSTRUCTION ACTIVITIES.
- AT THE END OF ALL SITE CONSTRUCTION, THE CONTRACTOR SHALL CLEAN ALL DEBRIS FROM CATCH BASINS AND STORMWATER CONVEYANCES. DEBRIS SHALL NOT BE ALLOWED TO ENTER STREAMS OR OFF-SITE STORMWATER SYSTEMS.
- POSTIVE LOT DRAINS PER STANDARD DETAIL ST-16.
- CONDITIONAL USE LEVEL DESIGNATION (CULD) TREATMENT TECHNOLOGY: THE FOLLOWING MUST BE SUBMITTED AND APPROVED BY THE CITY OF FERNDALE PRIOR TO INSTALLATION OF THE CULD TREATMENT TECHNOLOGY:
 - CONFORMATION LETTER FROM THE TREATMENT TECHNOLOGY MANUFACTURER IDENTIFYING THAT THE PROJECT ASSUMES AS YEA OF THE TREATMENT NUMBER OF INSTALLS.
 - CONTINGENCY MEMO FROM APPLICANT STATING:
 - UNTIL GENERAL USE LEVEL DESIGNATION (CULD) STATUS IS OBTAINED, OWNER SHALL CONDUCT ANNUAL SAMPLING RESULTS TO THE CITY (DUE BY DECEMBER 31 BEGINNING YEAR OF INSTALLATION) THAT PROVE THAT THE TREATMENT TECHNOLOGY IS MEETING EXISTING WATER QUALITY STANDARDS.
 - IF THE QUALITY STANDARDS ARE NOT BEING MET, OR IF THE TREATMENT TECHNOLOGY REPLACEMENT PARTS, FILTERS, ETC. ARE NO LONGER AVAILABLE, THE OWNER SHALL INSTALL AN EQUIVALENT TREATMENT TECHNOLOGY AT THEIR EXPENSE.
 - IF AT ANY TIME, THE TREATMENT TECHNOLOGY IS NOT MEETING WATER QUALITY STANDARDS, THE CITY HAS THE RIGHT TO IMPLEMENT A NOTICE OF VIOLATION, AS THE OPERATION AND MAINTENANCE OF THE TREATMENT TECHNOLOGY IS THE RESPONSIBILITY OF THE OWNER.
 - THIS MEMO SHALL ALSO BE INCLUDED IN THE STORMWATER MAINTENANCE MANUAL TO BE SUBMITTED AT THE COMPLETION OF THE PROJECT.

WATER:

- THE FOLLOWING STANDARD DETAILS SHALL BE USED IN CONSTRUCTING WATER SUPPLY SYSTEM IMPROVEMENTS:

PIPE BEDDING	COFSD W-11
TRENCH BACKFILL	COFSD W-11
FIRE HYDRANT ASSEMBLY	COFSD W-1
THRUST BLOCKING	COFSD W-2, W-3 & W-4
WATER SERVICE	COFSD W-5
- ALL WORK AND MATERIALS SHALL CONFORM TO THE REQUIREMENTS OF THE CITY OF FERNDALE DEVELOPMENT STANDARDS, SECTIONS 702 AND 705 AND THE MOST RECENT VERSION OF WSDOT STANDARD SPECIFICATIONS.
- ALL WATER MAIN PIPE SHALL BE DUCTILE IRON, MINIMUM THICKNESS CLASS 50, PER AWWA STANDARDS H3-71 AND C151-71, WITH CEMENT LINING PER AWWA STANDARD C104-71.
- MATERIAL FOR FITTINGS SUCH AS CROSSSES, TEES, BENDS, REDUCERS AND SLEEVES SHALL BE DUCTILE IRON. JOINTS SHALL BE M.J., FLANGED OR PUSH-ON JOINTS AND SHALL CONFORM TO AWWA SPECIFICATIONS C-110-71 AND C-104-71.
- CONCRETE BLOCKING SHALL BE AS SPECIFIED IN CITY OF FERNDALE STANDARD DETAILS W-2, W-3 AND W-4, OR AS DIRECTED BY THE PROJECT ENGINEER. BLOCKS SHALL BE INSTALLED AS SPECIFIED IN SECTION 7-09.3(21) OF THE WASHINGTON STATE DEPARTMENT OF TRANSPORTATION STANDARD SPECIFICATIONS FOR ROAD, BRIDGE OR MUNICIPAL CONSTRUCTION. NO PRE-CAST BLOCKS ARE ALLOWED. CONNECTIONS TO EXISTING WATER MAINS - THE CONTRACTOR MUST NOTIFY THE CITY OF FERNDALE PUBLIC WORKS DIRECTOR OF A PROPOSED CONNECTION AT LEAST FOUR WORKING DAYS IN ADVANCE.
- ALL HYDROSTATIC TESTING AND DISINFECTION OF WATER MAINS SHALL CONFORM TO SECTION 7-09.3(23) AND SECTION 7-09.3(24) OF THE WASHINGTON STATE DEPARTMENT OF TRANSPORTATION STANDARD SPECIFICATIONS FOR ROAD, BRIDGE OR MUNICIPAL CONSTRUCTION - CURRENT EDITION. HYDROSTATIC TEST PRESSURE FOR WATER MAIN ACCEPTANCE SHALL BE 250 PSI AND SHALL BE DONE ACCORDING TO CITY OF FERNDALE REQUIREMENTS. THE CITY OF FERNDALE LABORATORY SHALL CONDUCT ALL DISINFECTION TESTS AND BACTERIOLOGICAL TESTS. THE PIPE WILL NOT PASS TESTING UNLESS A ZERO BACTERIAL COUNT IS MEASURED ON TWO CONSECUTIVE TESTS, CONDUCTED 24 HOURS APART.
- BACKFILL SHALL BE GRAVEL BASE, CLASS B, IN ALL STREET RIGHTS-OF-WAY, COMPACTED TO MINIMUM 95% OPTIMUM DENSITY. IN UNIMPROVED AREAS, MINIMUM COMPACTION SHALL BE 90% OF OPTIMUM DENSITY.
- ALL PIPES SHALL HAVE A MINIMUM COVER OF 36".
- ALL VALVES SHALL BE EITHER GATE OR BUTTERFLY TYPE VALVES AND SHALL BE INSTALLED WITH SLP TYPE CAST IRON VALVE BOXES. GATE VALVES SHALL BE USED FOR LINES 2 INCHES THROUGH 10 INCHES IN DIAMETER. SHORT-BODY VALVES SUITABLE FOR A NON-SHOCK SHUT-OFF PRESSURE OF 130 PSI AND SUITABLE FOR DIRECT BURIAL ARE SPECIFIED. GATE VALVES SHALL BE RESILIENT SEATED IRON-BODY, FULL-BRONZE MOUNTED VALVES CONFORMING TO AWWA C509 AND SUITABLE FOR SERVICE WITH THE TRENCH AND CLASS OF PIPE USED. ALL VALVES SHALL HAVE NON-RISING STEMS AND SHALL OPEN COUNTERCLOCKWISE AND SHALL BE EXPOSED WITH A 2 INCH SQUARE OPERATING NUT. VALVES WILL BE FLANGE OR M.J. JOINTS. VALVE MARKERS SHALL BE LOCATED OUTSIDE PAVEMENT SECTIONS.
- WATER SERVICE TAP INSTALLATIONS SHALL MEET THE REQUIREMENTS OF THE COFDS W-5.
- FIRE HYDRANTS SHALL HAVE TWO INDIVIDUALLY VALVED 2-1/2" PORTS AND ONE 5-1/4" MAIN VALVE OPENING. A 1/2" TEST PUMPER NOZZLE AND A 5" STORZ PORT WITH CAP AND AIRCRAFT CABLE SHALL BE SUPPLIED. HYDRANTS SHALL BE 10' MIN. ABOVE GROUND.
- FIRE HYDRANTS SHALL HAVE THE STORZ PORT FACING THE REQUIRED ACCESS AND THE BASE FLANGE OF THE HYDRANT MUST NOT VARY MORE THAN 1 FOOT IN ELEVATION FROM THE GRADE LEVEL OF THE REQUIRED ACCESS. THE LOWEST STEM SHALL BE A MINIMUM OF 14" ABOVE THE GROUND.
- IF THE PUBLIC WORKS DIRECTOR DETERMINES THAT FIRE HYDRANTS ARE VULNERABLE TO VEHICULAR DAMAGE, AN APPROPRIATE CRASH POSTS SHALL BE PROVIDED. NO OBSTRUCTIONS SHALL EXIST WITHIN A 5-FOOT PARKING AREA OF EACH REQUIRED ACCESS. CRASH POSTS SHALL BE 4" CEMENT-FILLED PIPE A MIN. OF 3' IN HEIGHT AND A MIN. OF 6" OF PIPE BELOW GRADE. HYDRANT SHUTOFF VALVES SHALL BE LOCATED BETWEEN 5' AND 20' FROM THE HYDRANT.
- UNDERGROUND SUPPLIES TO FIRE HYDRANTS MUST BE TESTED TO A MINIMUM OF 250 PSI AND A TEST RECORD REQUIRED WHEN INSTALLATION IS COMPLETE.
- FIRE HYDRANTS MUST BE MAINTAINED IN AN OPERABLE CONDITION AT ALL TIMES AND MUST BE REPAIRED OR REPLACED WHEN DEFECTIVE. HYDRANTS SHALL BE REPAIRED BEFORE CONSTRUCTION COMMENCES ABOVE GRADE LEVEL.

ROAD:



- THE FOLLOWING STANDARD DETAILS SHALL BE USED FOR CONSTRUCTION OF THE STANDARD STREET SECTION:

TYPICAL STREET SECTION	PER THESE PLANS
PCC CURB AND GUTTER	COFSD R-9
PCC SIDEWALKS	COFSD R-12 (SEE CONSTRUCTION DOCUMENTS TYPICAL SECTION)
PCC CURB RAMPS	WSDOT STD. DETAIL F-40
- ROADWAY EXCAVATION WITHIN THE ROADWAY PRISM SHALL BE CUT TO A UNIFORM GRADE. THE COMPLETED SUBGRADE SURFACE SHALL NOT VARY MORE THAN 0.10-FOOT FROM THE LOWER EDGE OF A 15-FOOT STRAIGHTEDGE PLACED ON THE SUBGRADE PARALLEL TO THE CENTERLINE UNLESS APPROVED BY THE ENGINEER.
- THE OWNER SHALL PROVIDE TO THE ENGINEER A REPORT FROM A QUALIFIED GEOTECHNICAL FIRM CERTIFYING THE COMPACTION OF THE GRAVEL BASE UNDER ALL PAVING AREAS.
- ASPHALT CONCRETE PAVEMENT SHALL BE CLASS "B" MATERIALS AND CONSTRUCTION METHODS SHALL BE IN ACCORDANCE WITH THE STANDARD SPECIFICATIONS, SECTION 5-04, EXCEPT AS MODIFIED HEREIN. CONNECTION TO EXISTING PAVEMENT SHALL BE TO A STRAIGHT NEATLY-TRIMMED LINE.
- CRUSHED ROCK SURFACING FOR PAVEMENT SHALL BE IN ACCORDANCE WITH WSDOT STANDARD SPECIFICATION, SECTION 9-03.9(3); BALLAST PER SECTION 9-03.9(1).
- CEMENT CONCRETE SHALL BE CLASS 3000 (WITH AIR ENTRAINMENT) IN ACCORDANCE WITH WSDOT STANDARD SPECIFICATION, SECTION 6-02.3(2).
- CEMENT CONCRETE SIDEWALKS SHALL BE CONSTRUCTED AS SHOWN ON THE PLANS OR AS DESIGNATED BY THE ENGINEER IN ACCORDANCE WITH CITY STANDARDS, DRAWING NO. R-12.
- CEMENT CONCRETE DRIVEWAYS SHALL BE 6 INCHES THICK AND CONSTRUCTED WHERE SHOWN ON THE PLANS OR DESIGNATED BY THE ENGINEER IN ACCORDANCE WITH THE CITY STANDARDS, DRAWING NO. R-15. A 2- INCH LATER OF 3/4 INCH DRAIN ROCK SHALL BE USED FOR DRIVEWAYS.
- CEMENT CONCRETE CURB AND GUTTER SHALL BE CONSTRUCTED WHERE SHOWN ON THE PLANS OR AS DESIGNATED BY THE ENGINEER, IN ACCORDANCE WITH CITY STANDARDS SPECIFICATIONS, SECTION 8-04 AND CITY OF FERNDALE STANDARDS, DRAWING R-8 AND R-9. HANDICAP RAMPS SHALL BE CONSTRUCTED PER WSDOT STANDARD PLANS F-40. WHERE NEW CEMENT CONCRETE CURB AND GUTTER IS CONNECTED TO EXISTING CURB AND GUTTER, ASSURE THAT NO ABRUPT OFFSETS IN LINE OR GRADE SHALL BE CONSTRUCTED WHICH WILL BE UNLIKELY TO IMPED DRIVEWAY IN THE GUTTER LINE.
- SOIL RESIDUALS AND BRIDGE SHALL BE PLACED WITHIN 24 HOURS OF PAVING.
 - A TACK COAT OF ASPHALT SHALL BE APPLIED BETWEEN ALL COURSES OF ASPHALT.
 - PAVEMENT REPAIR SHALL BE SAW-OUT BEFORE REMOVAL. AR-4000W SHALL BE APPLIED TO ALL EDGES OF EXISTING PAVEMENT. WHERE NEWLY CONSTRUCTED PAVING MEETS EXISTING PAVING, THE APPLICANT SHALL PROVIDE A SMOOTH TRANSITION FROM EXISTING TO PROPOSED PAVING. CONTRACTOR SHALL COLD PLANE PER DIMENSIONS SPECIFIED ON THE PLANS, AND INSTALL A MINIMUM 2-FOOT WIDE PETROTAC PAVING FABRIC, OR EQUIVALENT, OVER JOINT BETWEEN PAVING LIFTS.
- THRU-CURB BASINS AND THRU-CURB INLETS CONFORMING TO THE WSDOT STANDARD SPECIFICATIONS, SECTION 7-05 SHALL BE CONSTRUCTED AT THE LOW POINT OF THE CURB FLOW LINES AND TO THE LOCATIONS, DIMENSIONS, AND DETAILS AS SHOWN ON THE PLANS OR DESIGNATED BY THE ENGINEER AND CITY STANDARDS, DRAWING NO. R-8.
- TRENCH EXCAVATIONS, BEDDING AND PIPE FOR STORMWATER PIPE LAYING SHALL BE IN ACCORDANCE WITH THE WSDOT STANDARD SPECIFICATIONS, SECTION 7-08.
- STORM SEWER PIPE CONSTRUCTION REQUIREMENTS SHALL BE IN ACCORDANCE WITH WSDOT STANDARD SPECIFICATION, SECTION 7-04. MATERIAL SHALL BE HANCOX SURE-LOK F477 PIPE OR CITY APPROVED EQUAL. LOTS' STORM DRAIN SERVICE LINE SHALL BE 6" PVC PER WSDOT STANDARD SPECIFICATION, SECTION 9-05.1(5).
- PERFORATED UNDERDRAIN PIPE SHALL MEET THE WSDOT STANDARD SPECIFICATION 7-01.3(2).

SANITARY SEWER SYSTEMS:

- ALL WORK AND MATERIALS SHALL BE IN ACCORDANCE WITH CITY OF FERNDALE STANDARD SPECIFICATIONS AND DETAILS, A.P.W.A. STANDARD SPECIFICATIONS, AND WSDOT STANDARD SPECIFICATIONS, MOST RECENT EDITIONS. SANITARY SEWER SYSTEM INSTALLATION, BOTH PUBLIC AND PRIVATE, IS SUBJECT TO CITY REVIEW AND APPROVAL.
- ALL WORK MUST BE INSPECTED TO THE SATISFACTION OF THE CITY OF FERNDALE. 24 HOUR NOTICE MUST BE GIVEN PRIOR TO STARTING WORK. TESTING OF THE SEWER SYSTEM AND ALL CONNECTIONS TO EXISTING MAINS SHALL BE PERFORMED IN THE PRESENCE AND UNDER THE SUPERVISION OF A CITY OF FERNDALE REPRESENTATIVE.
- SANITARY SEWER MAINS SHALL BE A MINIMUM 8 INCH DIAMETER PVC PIPE (SDR-35) CONFORMING TO THE PROVISIONS OF ASTM D 3034 AND INSTALLED TO CITY SPECIFICATIONS.
- SANITARY SEWER PIPE BEDDING SHALL BE PEA GRAVEL PER COFSD SS-1. ALL TRENCHES SHALL BE BACKFILLED WITH CLASS B BANK RUN GRAVEL WITHIN CITY RIGHT OF WAY AND TRAVELED WAYS OUTSIDE OF RIGHT OF WAY (ACCESS EASEMENTS) AND SHALL BE COMPACTED TO A MINIMUM DENSITY OF 95% MODIFIED PROCTOR. USE OF SUITABLE NATIVE BACKFILL OUTSIDE OF TRAVELED WAY SHALL BE SUBJECT TO APPROVAL BY THE CITY.
- ALL MANHOLES SHALL BE INSTALLED PER CITY OF FERNDALE STANDARD DETAILS AND SHALL BE PRE-CHANNELLED. MANHOLE CONES ARE TO BE OFFSET SUCH THAT LADDER RUNGS ARE PARALLEL TO THE FLOW.
- ALL SIDE SEWERS SHALL BE INSTALLED PER CITY OF FERNDALE STANDARD DETAILS SS-6, SS-8 OR SS-13, EXCEPT THAT SINGLE SIDE SEWERS SHALL HAVE A MINIMUM DIAMETER OF 4".
- CONTRACTOR SHALL EXTEND SEWER STUBS 5 FT BEYOND UTILITY CORRIDOR OR 15 FEET BEYOND RIGHT-OF-WAY LINE.
- EACH SIDE SEWER STUB SHALL BE CAPPED WITH A WATERTIGHT PLUG. EACH STUB SHALL BE MARKED FOR LOCATION WITH A 2" DIA. PVC PIPE (MIN. SCHEDULE 40) WITH THE TOP 18" PAINTED GREEN AND STENCILED WITH THE WORD "SEWER" AND THE PIPE INVERT INDICATED. THE LOCATION MARKER SHALL BE CONNECTED TO THE SERVICE STUB BY A #12 COPPER WIRE.

△	SUBMITTAL 1	RL	04/23/19	△					
△				△					
△				△					
△				△					
△				△					
NO.	REVISION	BY	DATE	NO.				BY	DATE

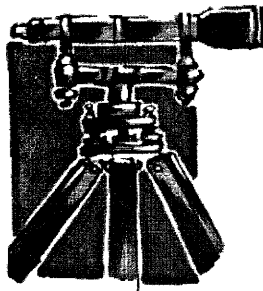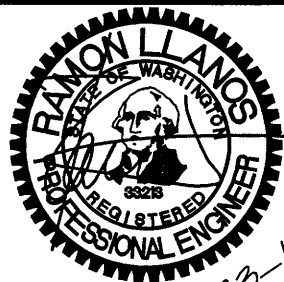

LDES, INC.
5160 INDUSTRIAL PL. #108
FERNDALE, WA 98248
PHONE 360-383-0620
FAX 360-383-0639

JOB NO.:	1602
DWG. NAME:	1602-CIVL-ASB.dwg
DESIGNED BY:	RL
DRAWN BY:	EH
CHECKED BY:	RL

PNRD
PO BOX 3249
FERNDALE, WA 98248

APPROVED

JUN 13 2019

BY 
CITY OF FERNDALE
PUBLIC WORKS DEPARTMENT

CITY OF FERNDALE GENERAL NOTES

MAIN STREET VILLAGE
2912 MAIN STREET, FERNDALE, WA
A PORTION OF SECTION 30, TOWNSHIP 39N, RANGE 2E, W.M.

SHEET


02

OF

20

RECORD DRAWING

00670.002 6/24/19 KB

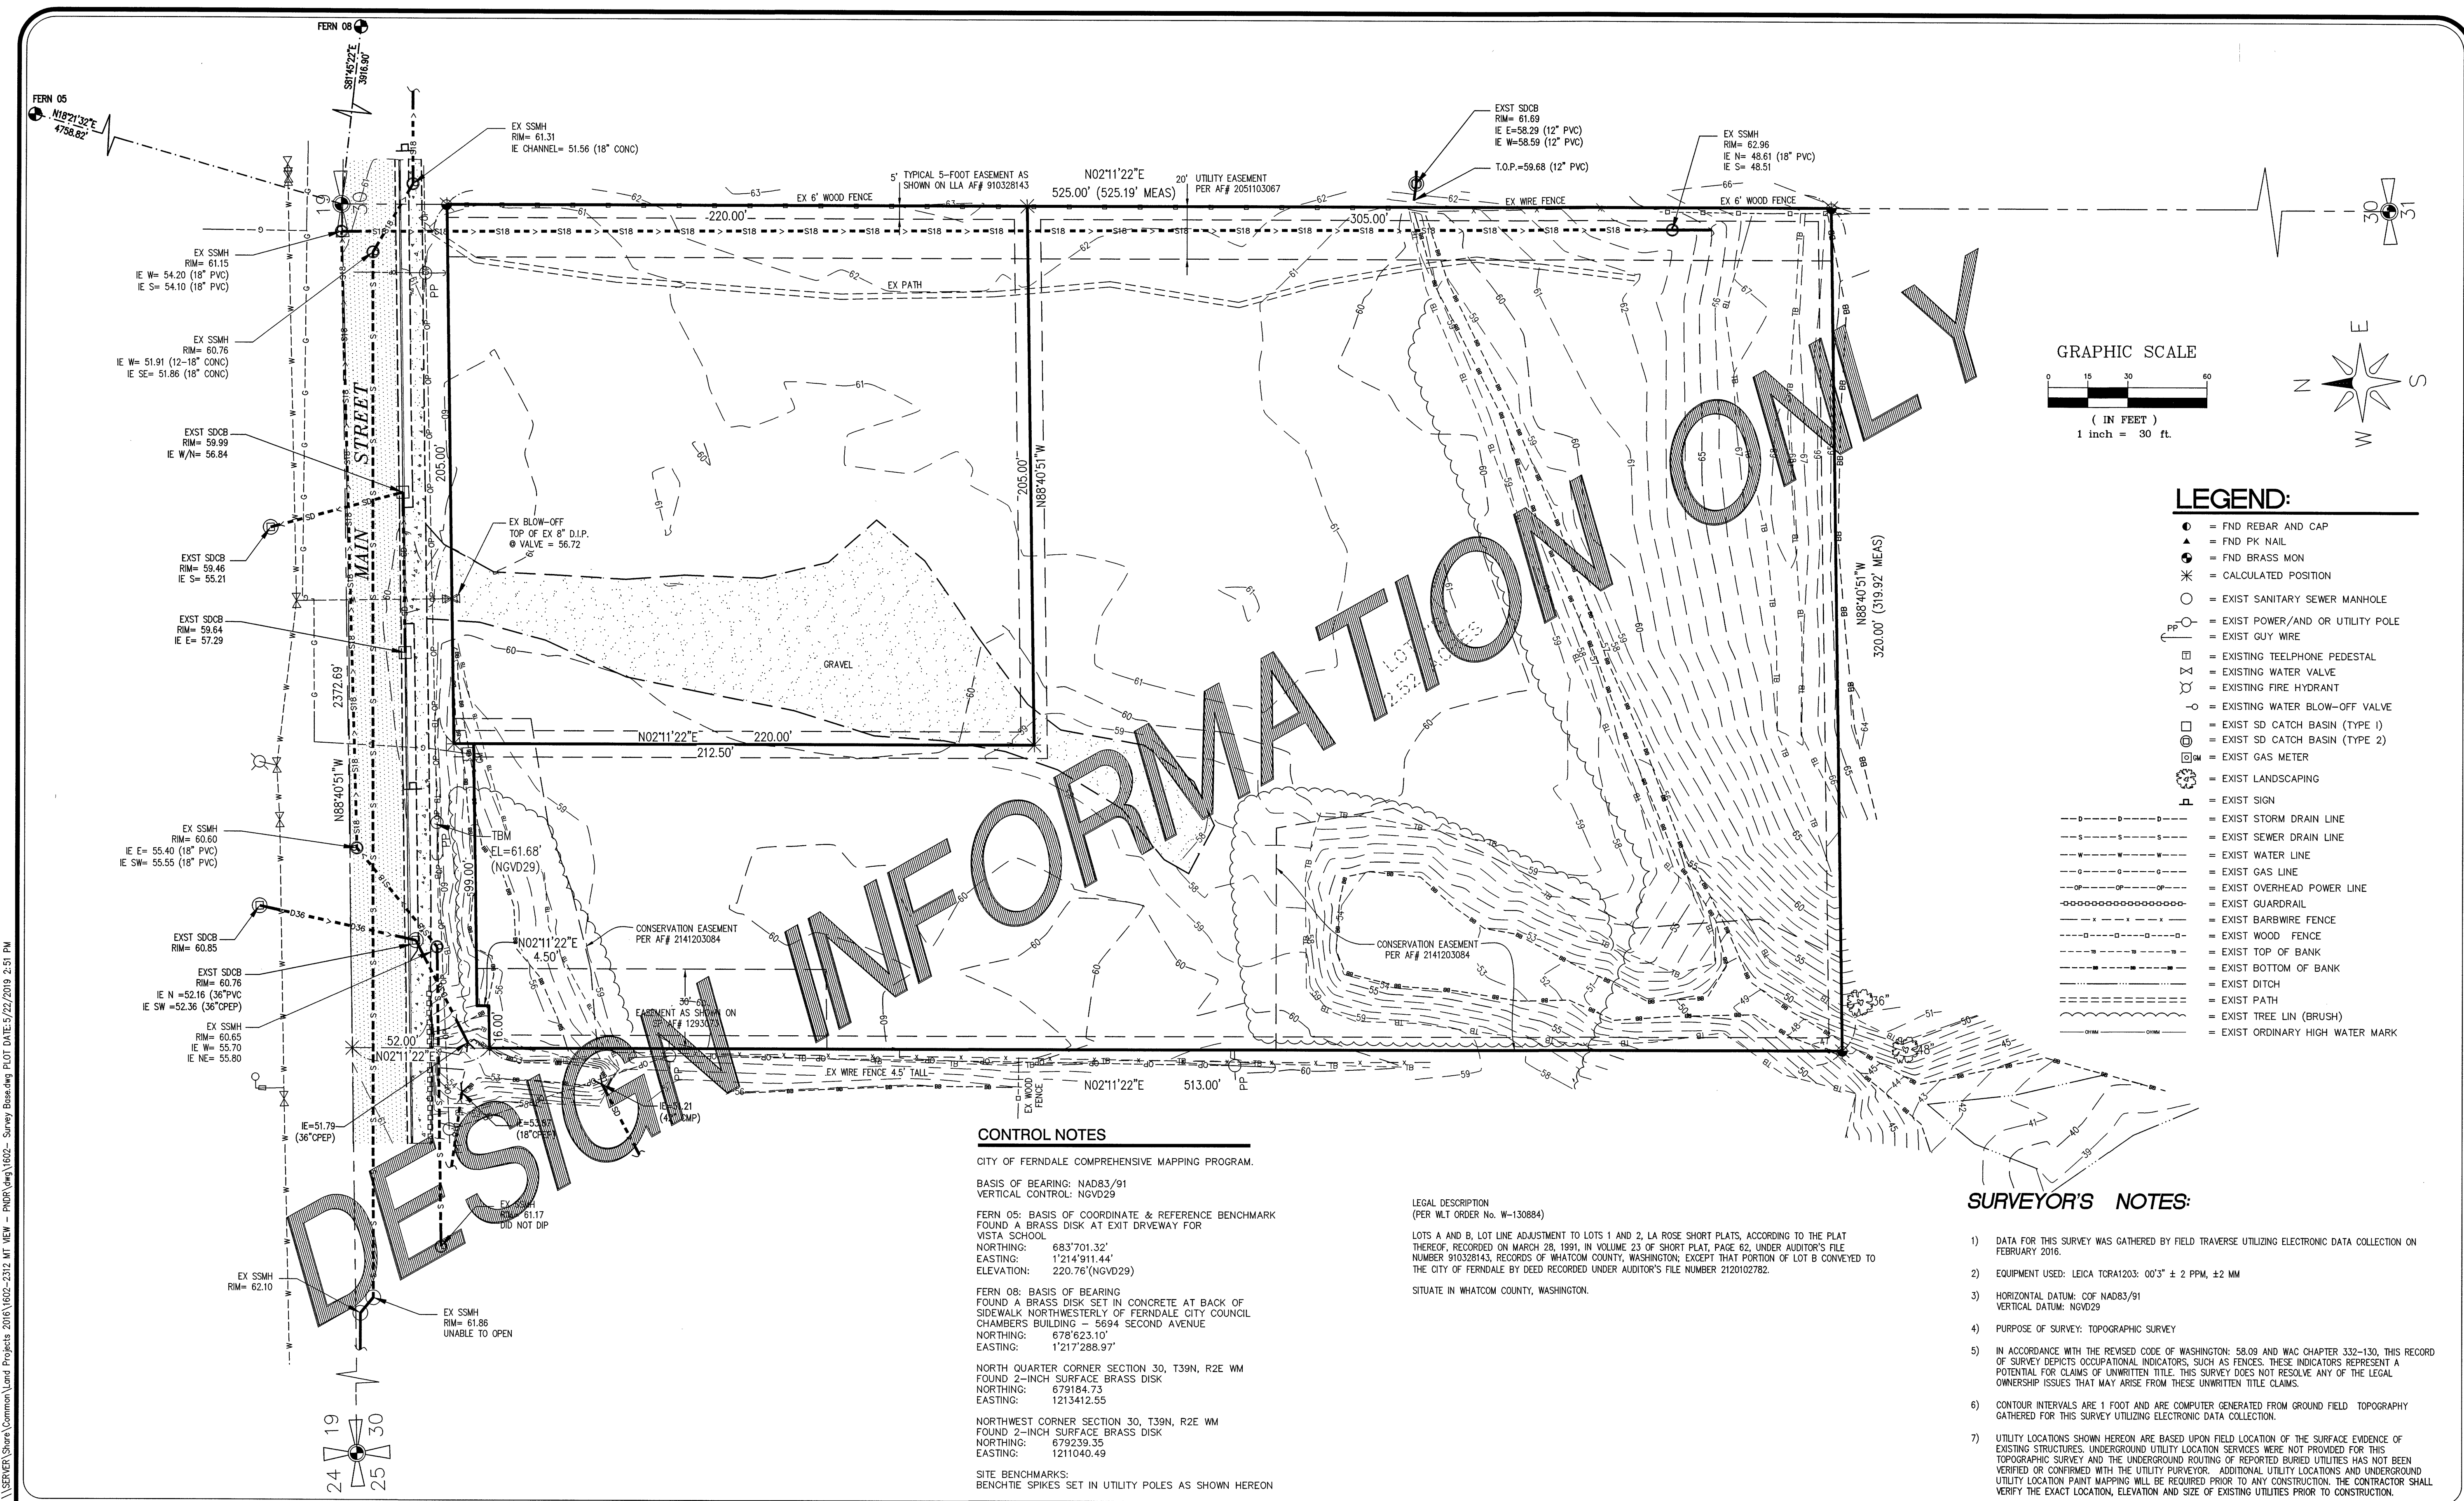

CONTROL NOTES

CITY OF FERNDAL COMPREHENSIVE MAPPING PROGRAM.

BASIS OF BEARING: NAD83/91
VERTICAL CONTROL: NGVD29

FERN 05: BASIS OF COORDINATE & REFERENCE BENCHMARK
FOUND A BRASS DISK AT EXIT DRIVEWAY FOR
VISTA SCHOOL
NORTHING: 683'701.32'
EASTING: 1'214'911.44'
ELEVATION: 220.76'(NGVD29)

FERN 08: BASIS OF BEARING
FOUND A BRASS DISK SET IN CONCRETE AT BACK OF
SIDEWALK NORTHWESTERLY OF FERNDAL CITY COUNCIL
CHAMBERS BUILDING - 5694 SECOND AVENUE
NORTHING: 678'623.10'
EASTING: 1'217'288.97'

NORTH QUARTER CORNER SECTION 30, T39N, R2E WM
FOUND 2-INCH SURFACE BRASS DISK
NORTHING: 679184.73
EASTING: 1213412.55

NORTHWEST CORNER SECTION 30, T39N, R2E WM
FOUND 2-INCH SURFACE BRASS DISK
NORTHING: 679239.35
EASTING: 1211040.49

SITE BENCHMARKS:
BENCHMARK SPIKE SET IN UTILITY POLES AS SHOWN HEREON

LEGAL DESCRIPTION
(PER WLT ORDER No. W-130884)


LOTS A AND B, LOT LINE ADJUSTMENT TO LOTS 1 AND 2, LA ROSE SHORT PLATS, ACCORDING TO THE PLAT THEREOF, RECORDED ON MARCH 28, 1991, IN VOLUME 23 OF SHORT PLAT, PAGE 62, UNDER AUDITOR'S FILE NUMBER 910328143, RECORDS OF WHATCOM COUNTY, WASHINGTON; EXCEPT THAT PORTION OF LOT B CONVEYED TO THE CITY OF FERNDAL BY DEED RECORDED UNDER AUDITOR'S FILE NUMBER 212102782.

SITUATE IN WHATCOM COUNTY, WASHINGTON.


- SURVEYOR'S NOTES:**
- 1) DATA FOR THIS SURVEY WAS GATHERED BY FIELD TRAVERSE UTILIZING ELECTRONIC DATA COLLECTION ON FEBRUARY 2016.
 - 2) EQUIPMENT USED: LEICA TORAL203: 003" ± 2 PPM, ± 2 MM
 - 3) HORIZONTAL DATUM: COF NAD83/91
VERTICAL DATUM: NGVD29
 - 4) PURPOSE OF SURVEY: TOPOGRAPHIC SURVEY
 - 5) IN ACCORDANCE WITH THE REVISED CODE OF WASHINGTON: 58.09 AND WAC CHAPTER 332-130, THIS RECORD OF SURVEY DEPICTS OCCUPATIONAL INDICATORS, SUCH AS FENCES. THESE INDICATORS REPRESENT A POTENTIAL FOR CLAIMS OF UNWRITTEN TITLE. THIS SURVEY DOES NOT RESOLVE ANY OF THE LEGAL OWNERSHIP ISSUES THAT MAY ARISE FROM THESE UNWRITTEN TITLE CLAIMS.
 - 6) CONTOUR INTERVALS ARE 1 FOOT AND ARE COMPUTER GENERATED FROM GROUND FIELD TOPOGRAPHY GATHERED FOR THIS SURVEY UTILIZING ELECTRONIC DATA COLLECTION.
 - 7) UTILITY LOCATIONS SHOWN HEREON ARE BASED UPON FIELD LOCATION OF THE SURFACE EVIDENCE OF EXISTING STRUCTURES. UNDERGROUND UTILITY LOCATION SERVICES WERE NOT PROVIDED FOR THIS TOPOGRAPHIC SURVEY AND THE UNDERGROUND ROUTING OF REPORTED BURIED UTILITIES HAS NOT BEEN VERIFIED OR CONFIRMED WITH THE UTILITY PURVEYOR. ADDITIONAL UTILITY LOCATIONS AND UNDERGROUND UTILITY LOCATION PAINT MAPPING WILL BE REQUIRED PRIOR TO ANY CONSTRUCTION. THE CONTRACTOR SHALL VERIFY THE EXACT LOCATION, ELEVATION AND SIZE OF EXISTING UTILITIES PRIOR TO CONSTRUCTION.

SUBMITTAL 1		RL	04/23/19			LDES, INC. 5160 INDUSTRIAL PL. #108 FERNDAL, WA 98248 PHONE 360-383-0620 FAX 360-383-0639	JOB NO.: 1602 DWG. NAME: 1602 - Survey Base.dwg DESIGNED BY: RL DRAWN BY: EH CHECKED BY: RL	PNRD PO BOX 3249 FERNDAL, WA 98248	APPROVED JUN 13 2019 BY: [Signature] CITY OF FERNDAL PUBLIC WORKS DEPARTMENT	EXISTING CONDITIONS MAIN STREET VILLAGE 2312 MAIN STREET, FERNDAL, WA A PORTION OF SECTION 30, TOWNSHIP 39N, RANGE 2E, WM.	SHEET 03 OF 20
REVISION		BY	DATE								

RECORD DRAWING

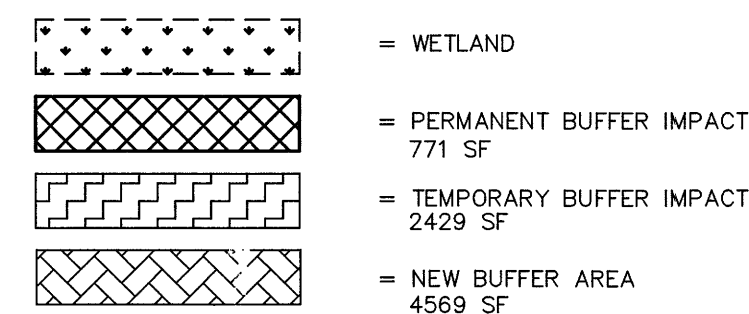20

\\SERVER\Share\Common\Land Projects\2016\1602-2312.MT.MEW - PNRD\1602-CIVIL-ASB.dwg PLOT DATE: 5/22/2019 2:24 PM

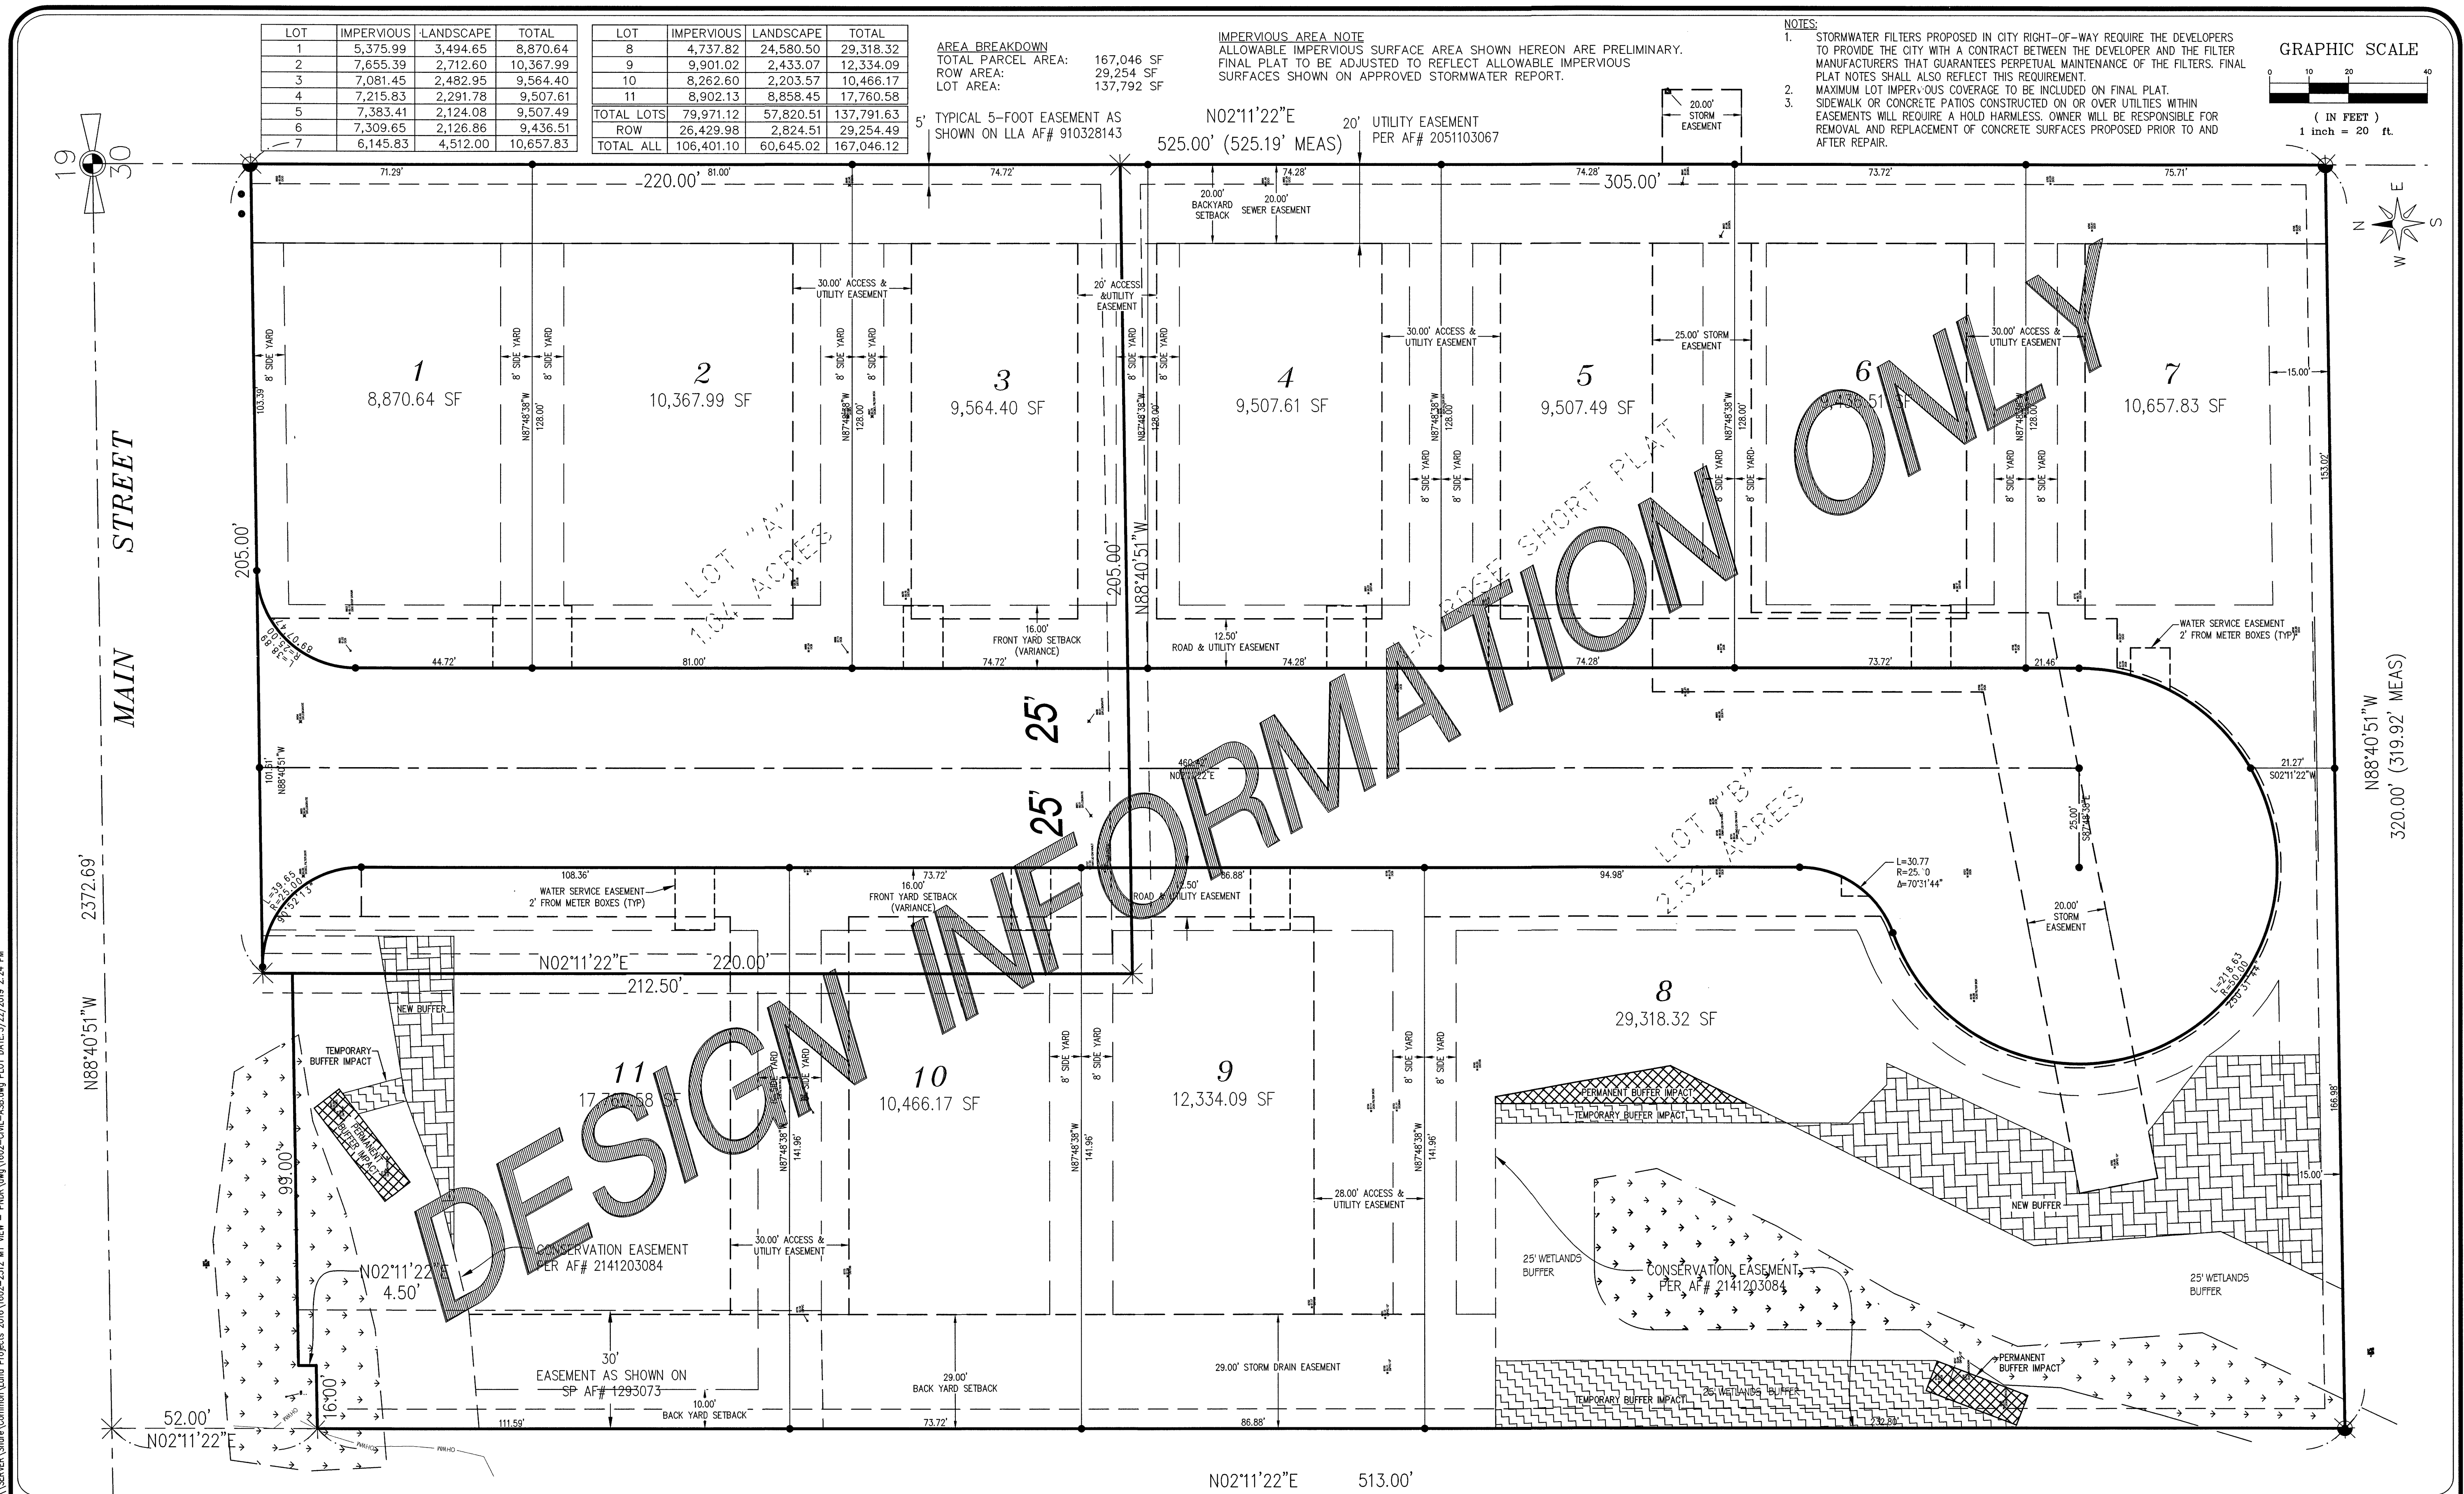

NO.	REVISION	BY	DATE	NO.	BY	DATE
1	SUBMITTAL 1	RL	04/23/19	6		
2				7		
3				8		
4				9		
5				10		
6				11		

PNRD
PO BOX 3249
FERDALE, WA 98248

APPROVED
JUN 13 2019
BY: [Signature]
CITY OF FERDALE
PUBLIC WORKS DEPARTMENT

PROPOSED PLAT

MAIN STREET VILLAGE
2312 MAIN STREET, FERDALE, WA
A PORTION OF SECTION 30, TOWNSHIP 39N, RANGE 2E, WM.

05
OF
20



	SUBMITAL 1		RL	04/23/19					
NO.	REVISION	BY	DATE	NO.	BY	DATE			



A-23-19



LDES, INC.
5160 INDUSTRIAL PL. #108
FERNDALE, WA 98248
PHONE 360-383-0620
FAX 360-383-0639

JOB NO.: 1602
 DWG. NAME: 1602-CIVIL-ASB.dwg
 DESIGNED BY: RL
 DRAWN BY: EH
 CHECKED BY: RL

PNRD
 PO BOX 3249
 FERNDALE, WA 98248

APPROVED

JUN 13 2019

BY 
 CITY OF FERNDALE
 PUBLIC WORKS DEPARTMENT

COMPOSITE PLAN

MAIN STREET VILLAGE
 2312 MAIN STREET, FERNDALE, WA
 A PORTION OF SECTION 30, TOWNSHIP 39N, RANGE 2E, W.M.


SHEET

06



OF

20

\\SERVER\Share\Common\Land Projects\2016\1602-2032, MT VIEW - PNRD.dwg 1602-CIVIL-ASB.dwg PLOT DATE: 5/22/2019 2:26 PM

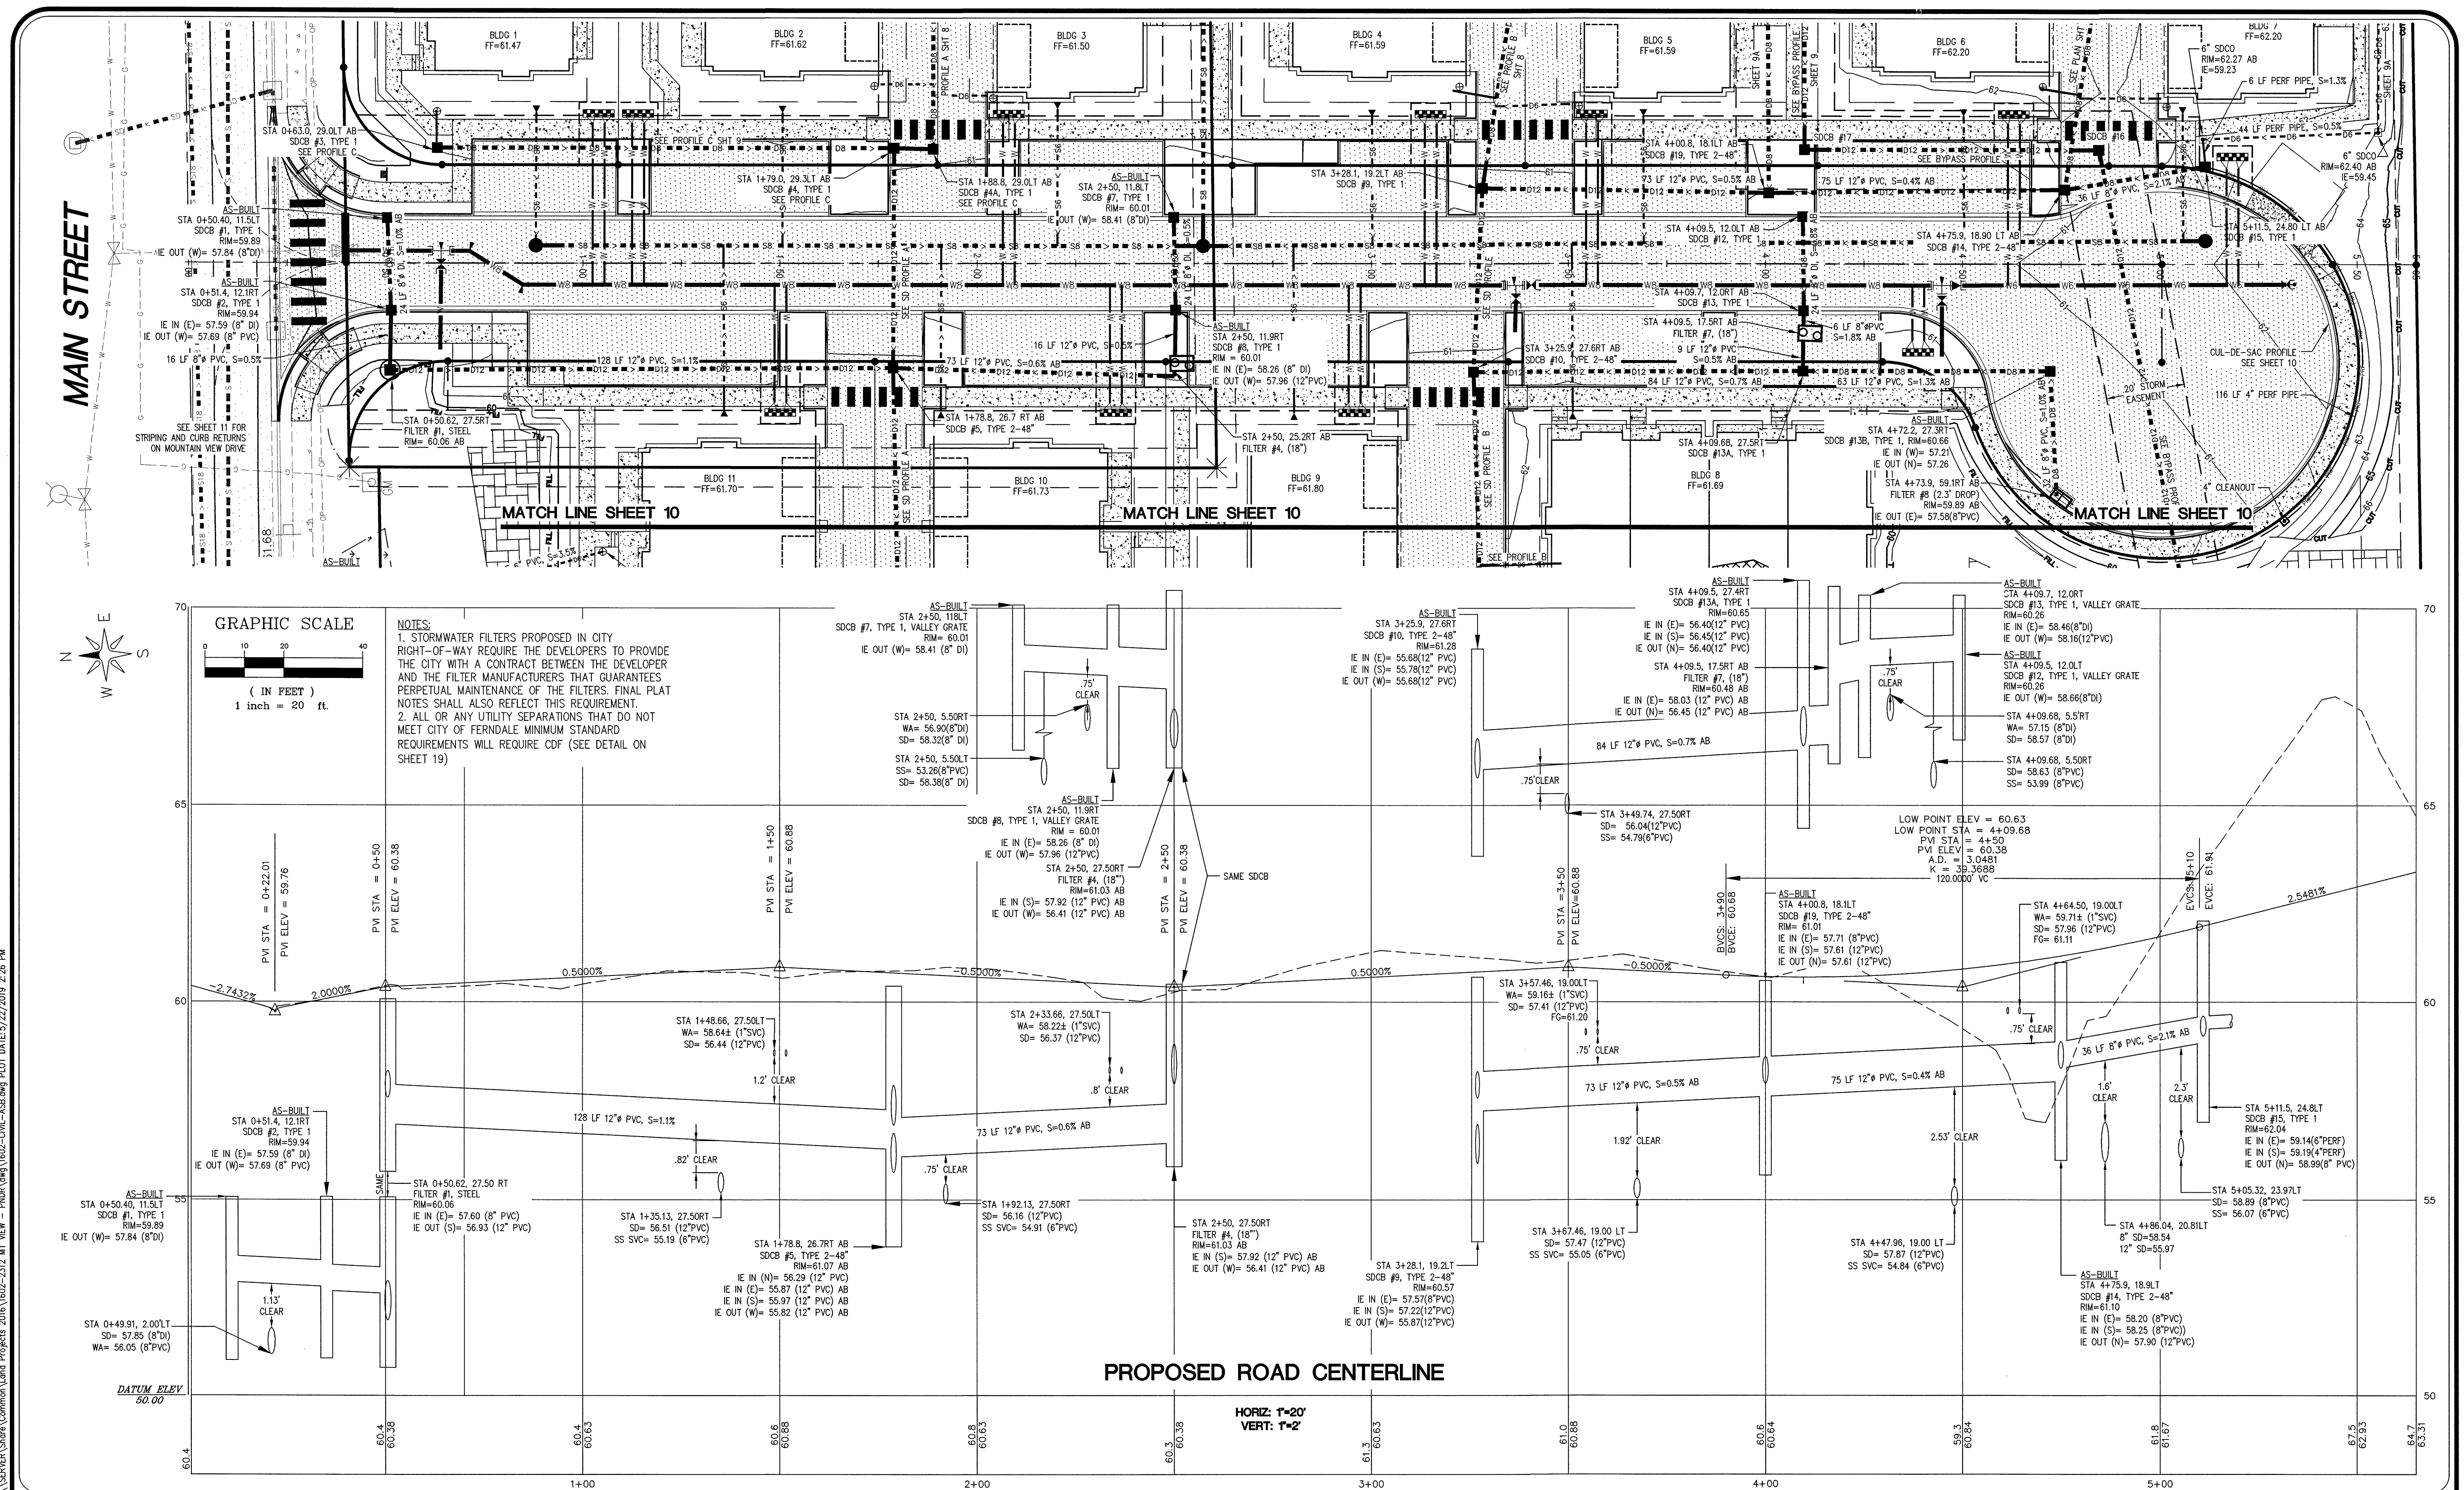

NO.	REVISION	BY	DATE	NO.	BY	DATE
1				1		
2				2		
3				3		
4				4		
5				5		
6				6		
7				7		
8				8		
9				9		
10				10		

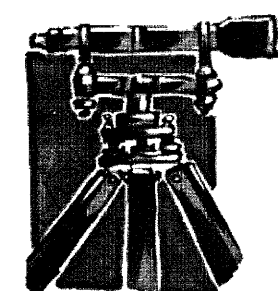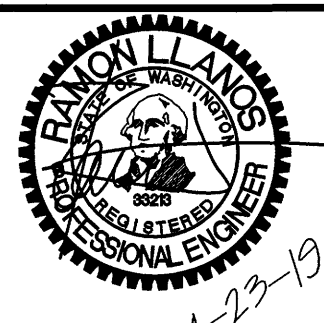

LDES, INC.
5160 INDUSTRIAL PL. #108
FERNDAL, WA 98248
PHONE 360-383-0620
FAX 360-383-0639

JOB NO.: 1602
DWG. NAME: 1602-CIVIL-ASB.dwg
DESIGNED BY: RL
DRAWN BY: EH
CHECKED BY: RL

PNRD
PO BOX 3249
FERNDAL, WA 98248


APPROVED
JUN 13 2019
BY: [Signature]
CITY OF FERNDAL
PUBLIC WORKS DEPARTMENT

**ROAD & STORMWATER
PLAN & PROFILE 1**
MAIN STREET VILLAGE
2312 MAIN STREET, FERNDAL, WA
A PORTION OF SECTION 30, TOWNSHIP 39N, RANGE 2E, W.M.

SHEET
07
OF
20

RECORD DRAWING


00670.007 6/24/19 KB

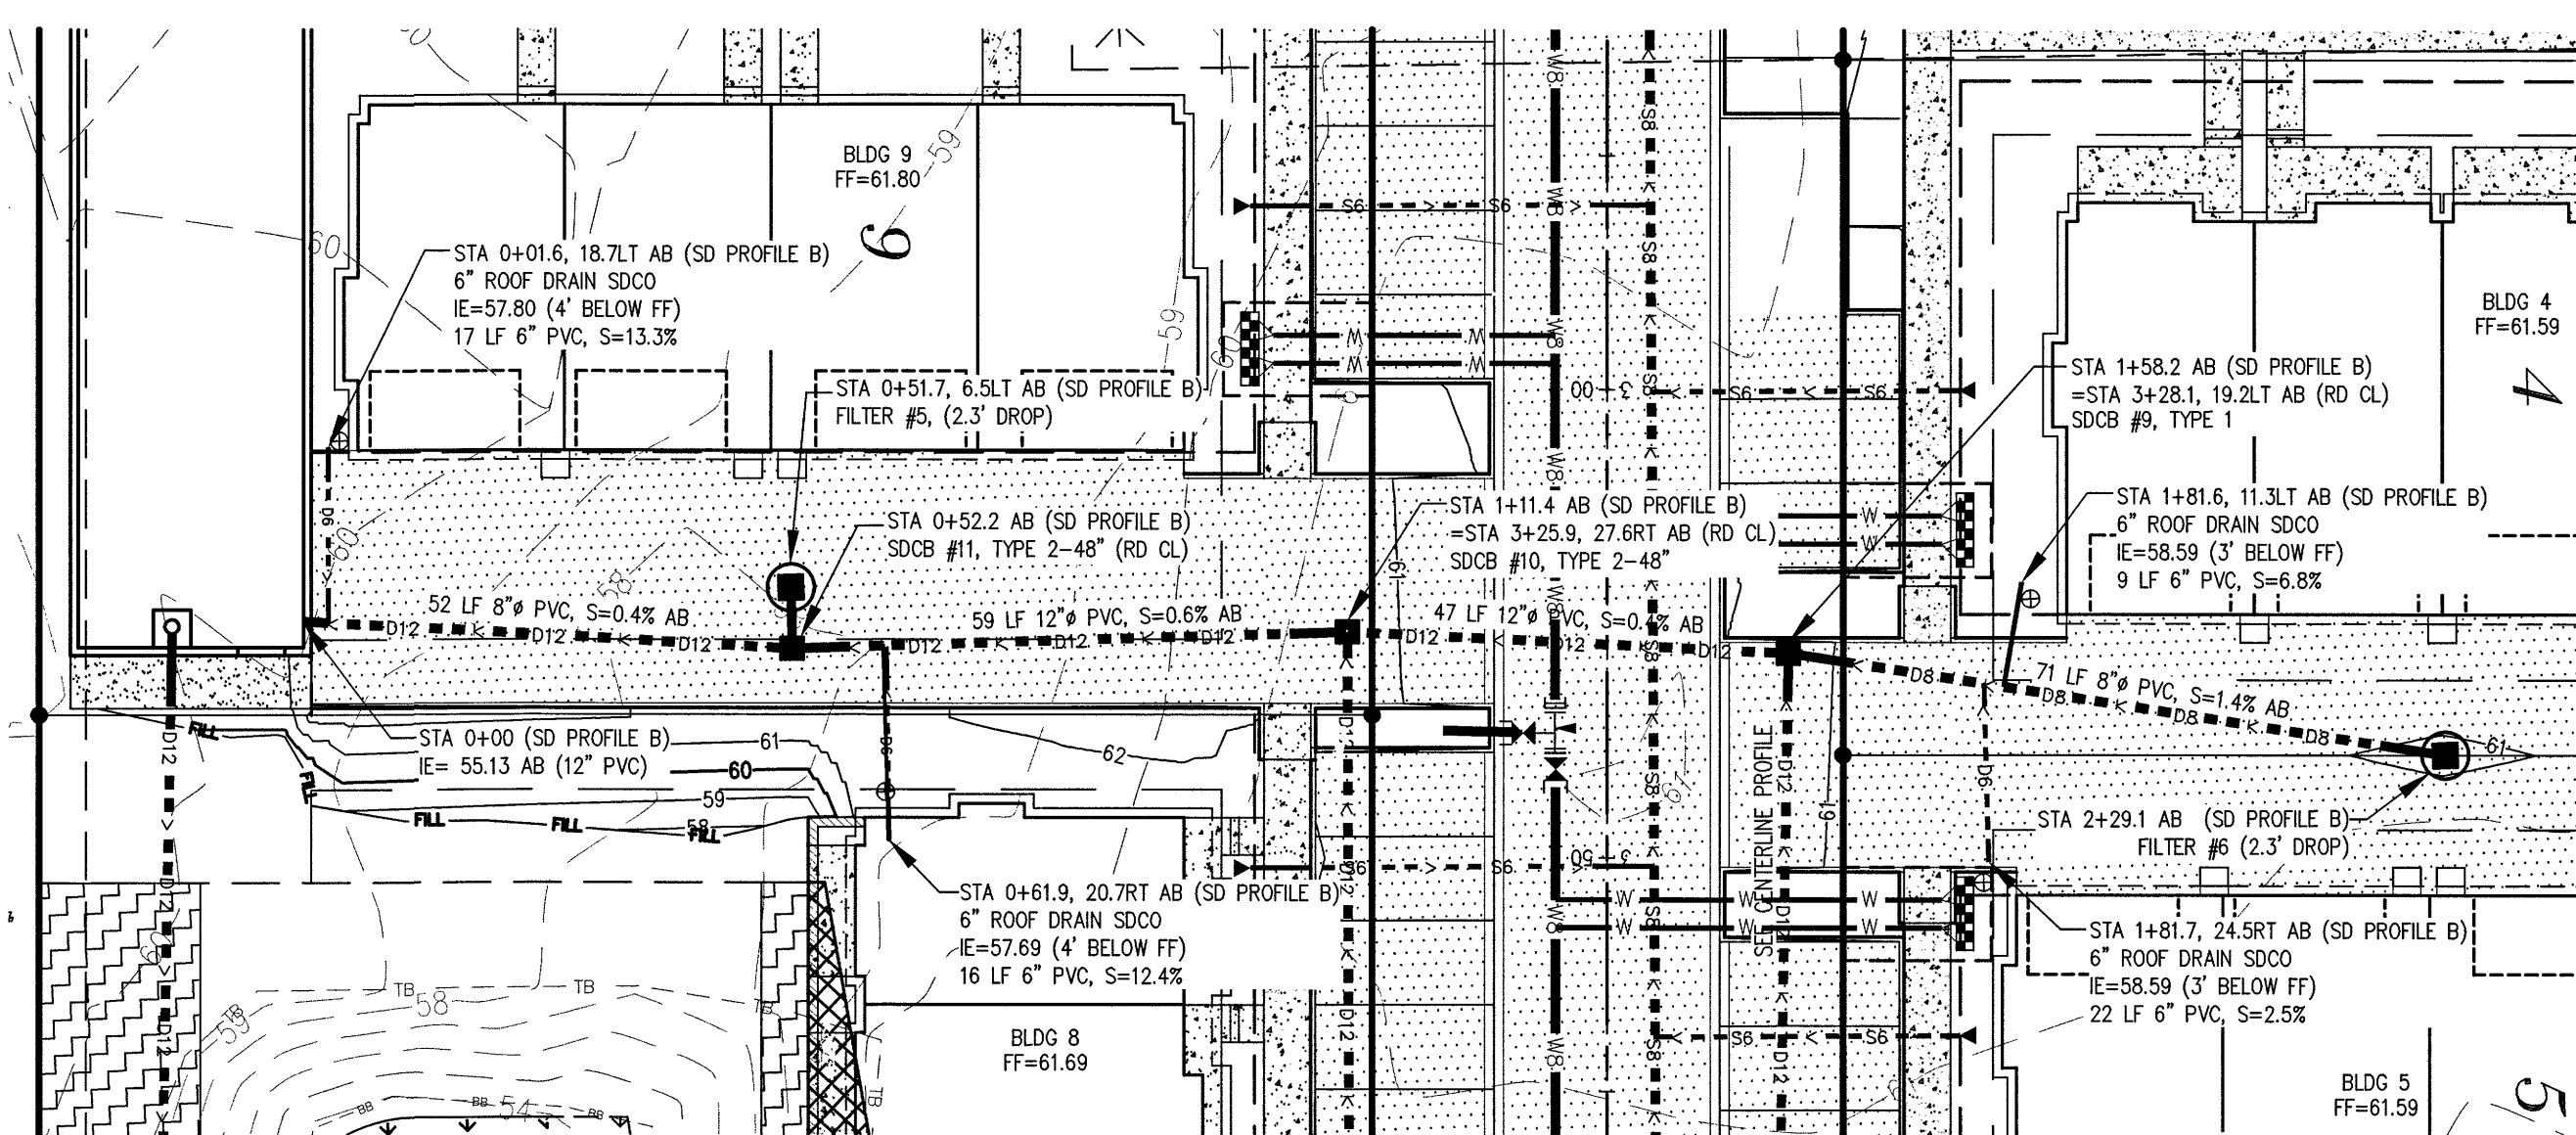







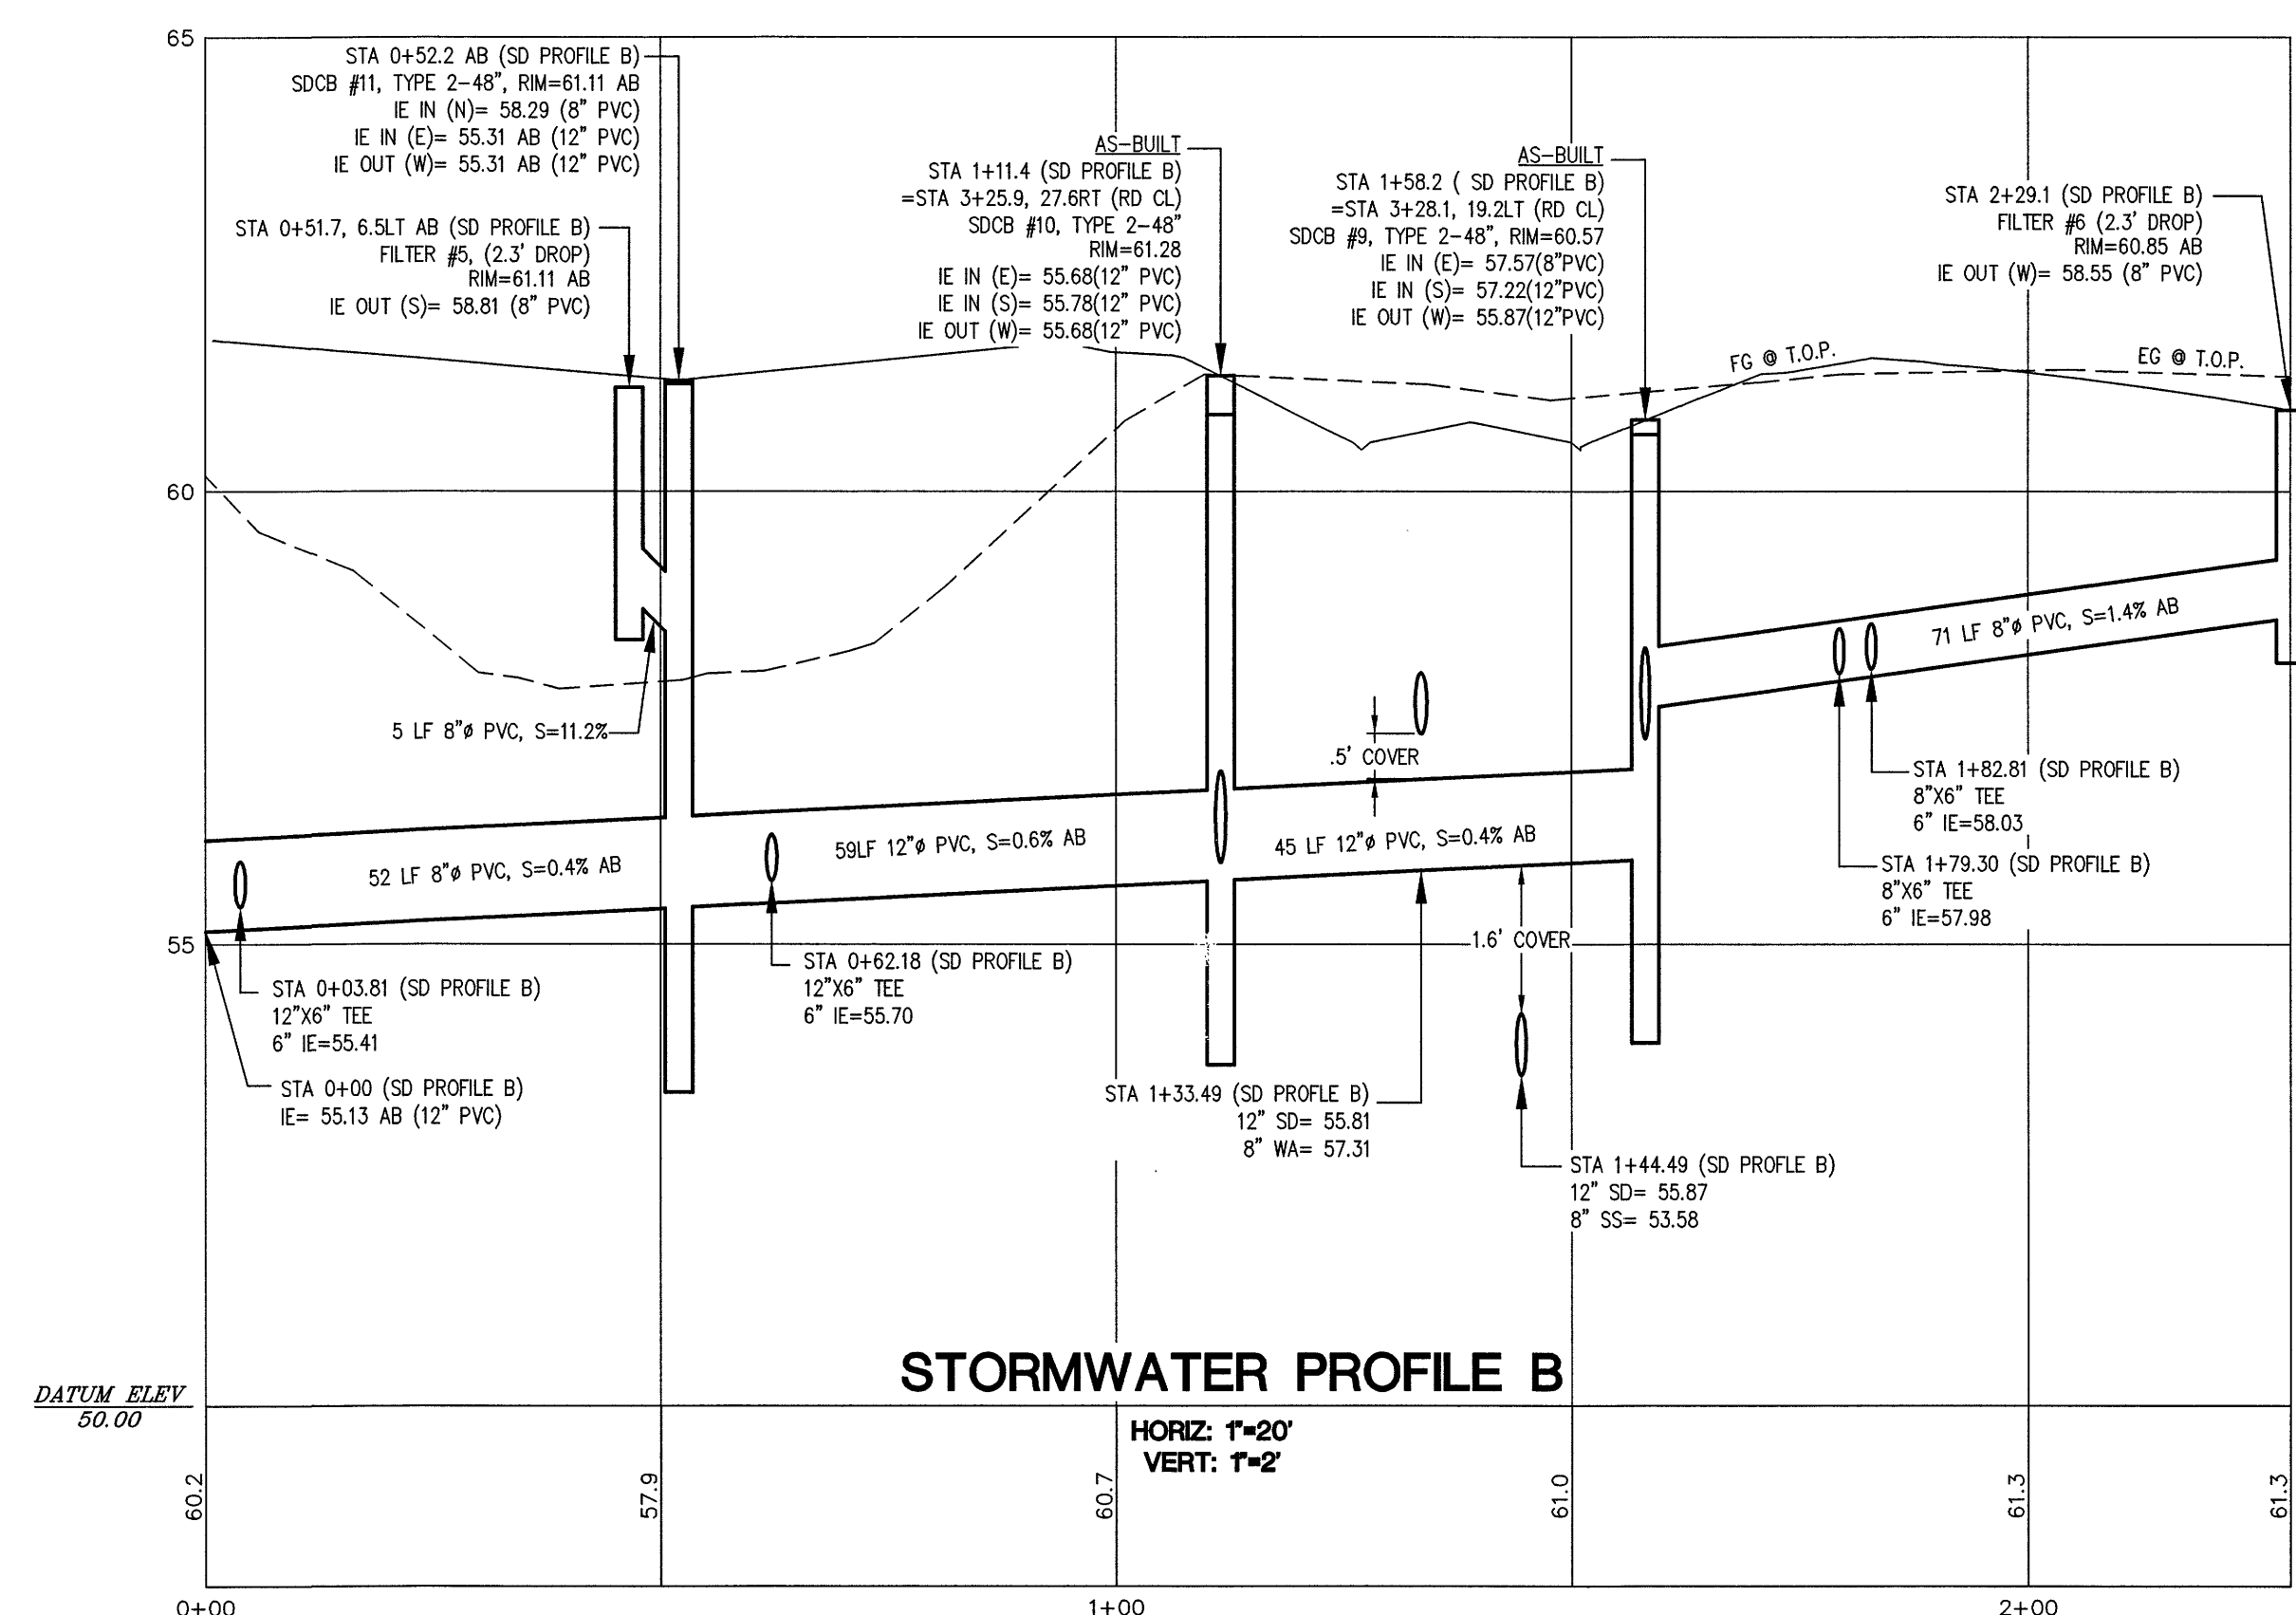

STORMWATER PROFILE B

HORIZ: 1"=20'
VERT: 1"=2'

LDES, INC.
5160 INDUSTRIAL PL. #108
FERNDALE, WA 98248
PHONE 360-383-0620
FAX 360-383-0639




PNRD
PO BOX 3249
FERNDALE, WA 98248

BY 3
CITY OF FERRDALE
PUBLIC WORKS DEPARTMENT

2312 MAIN STREET, FERNDALE, WA
A PORTION OF SECTION 30, TOWNSHIP 39N, RANGE 2E, W.M.

OF **20**

RECORD DRAWING

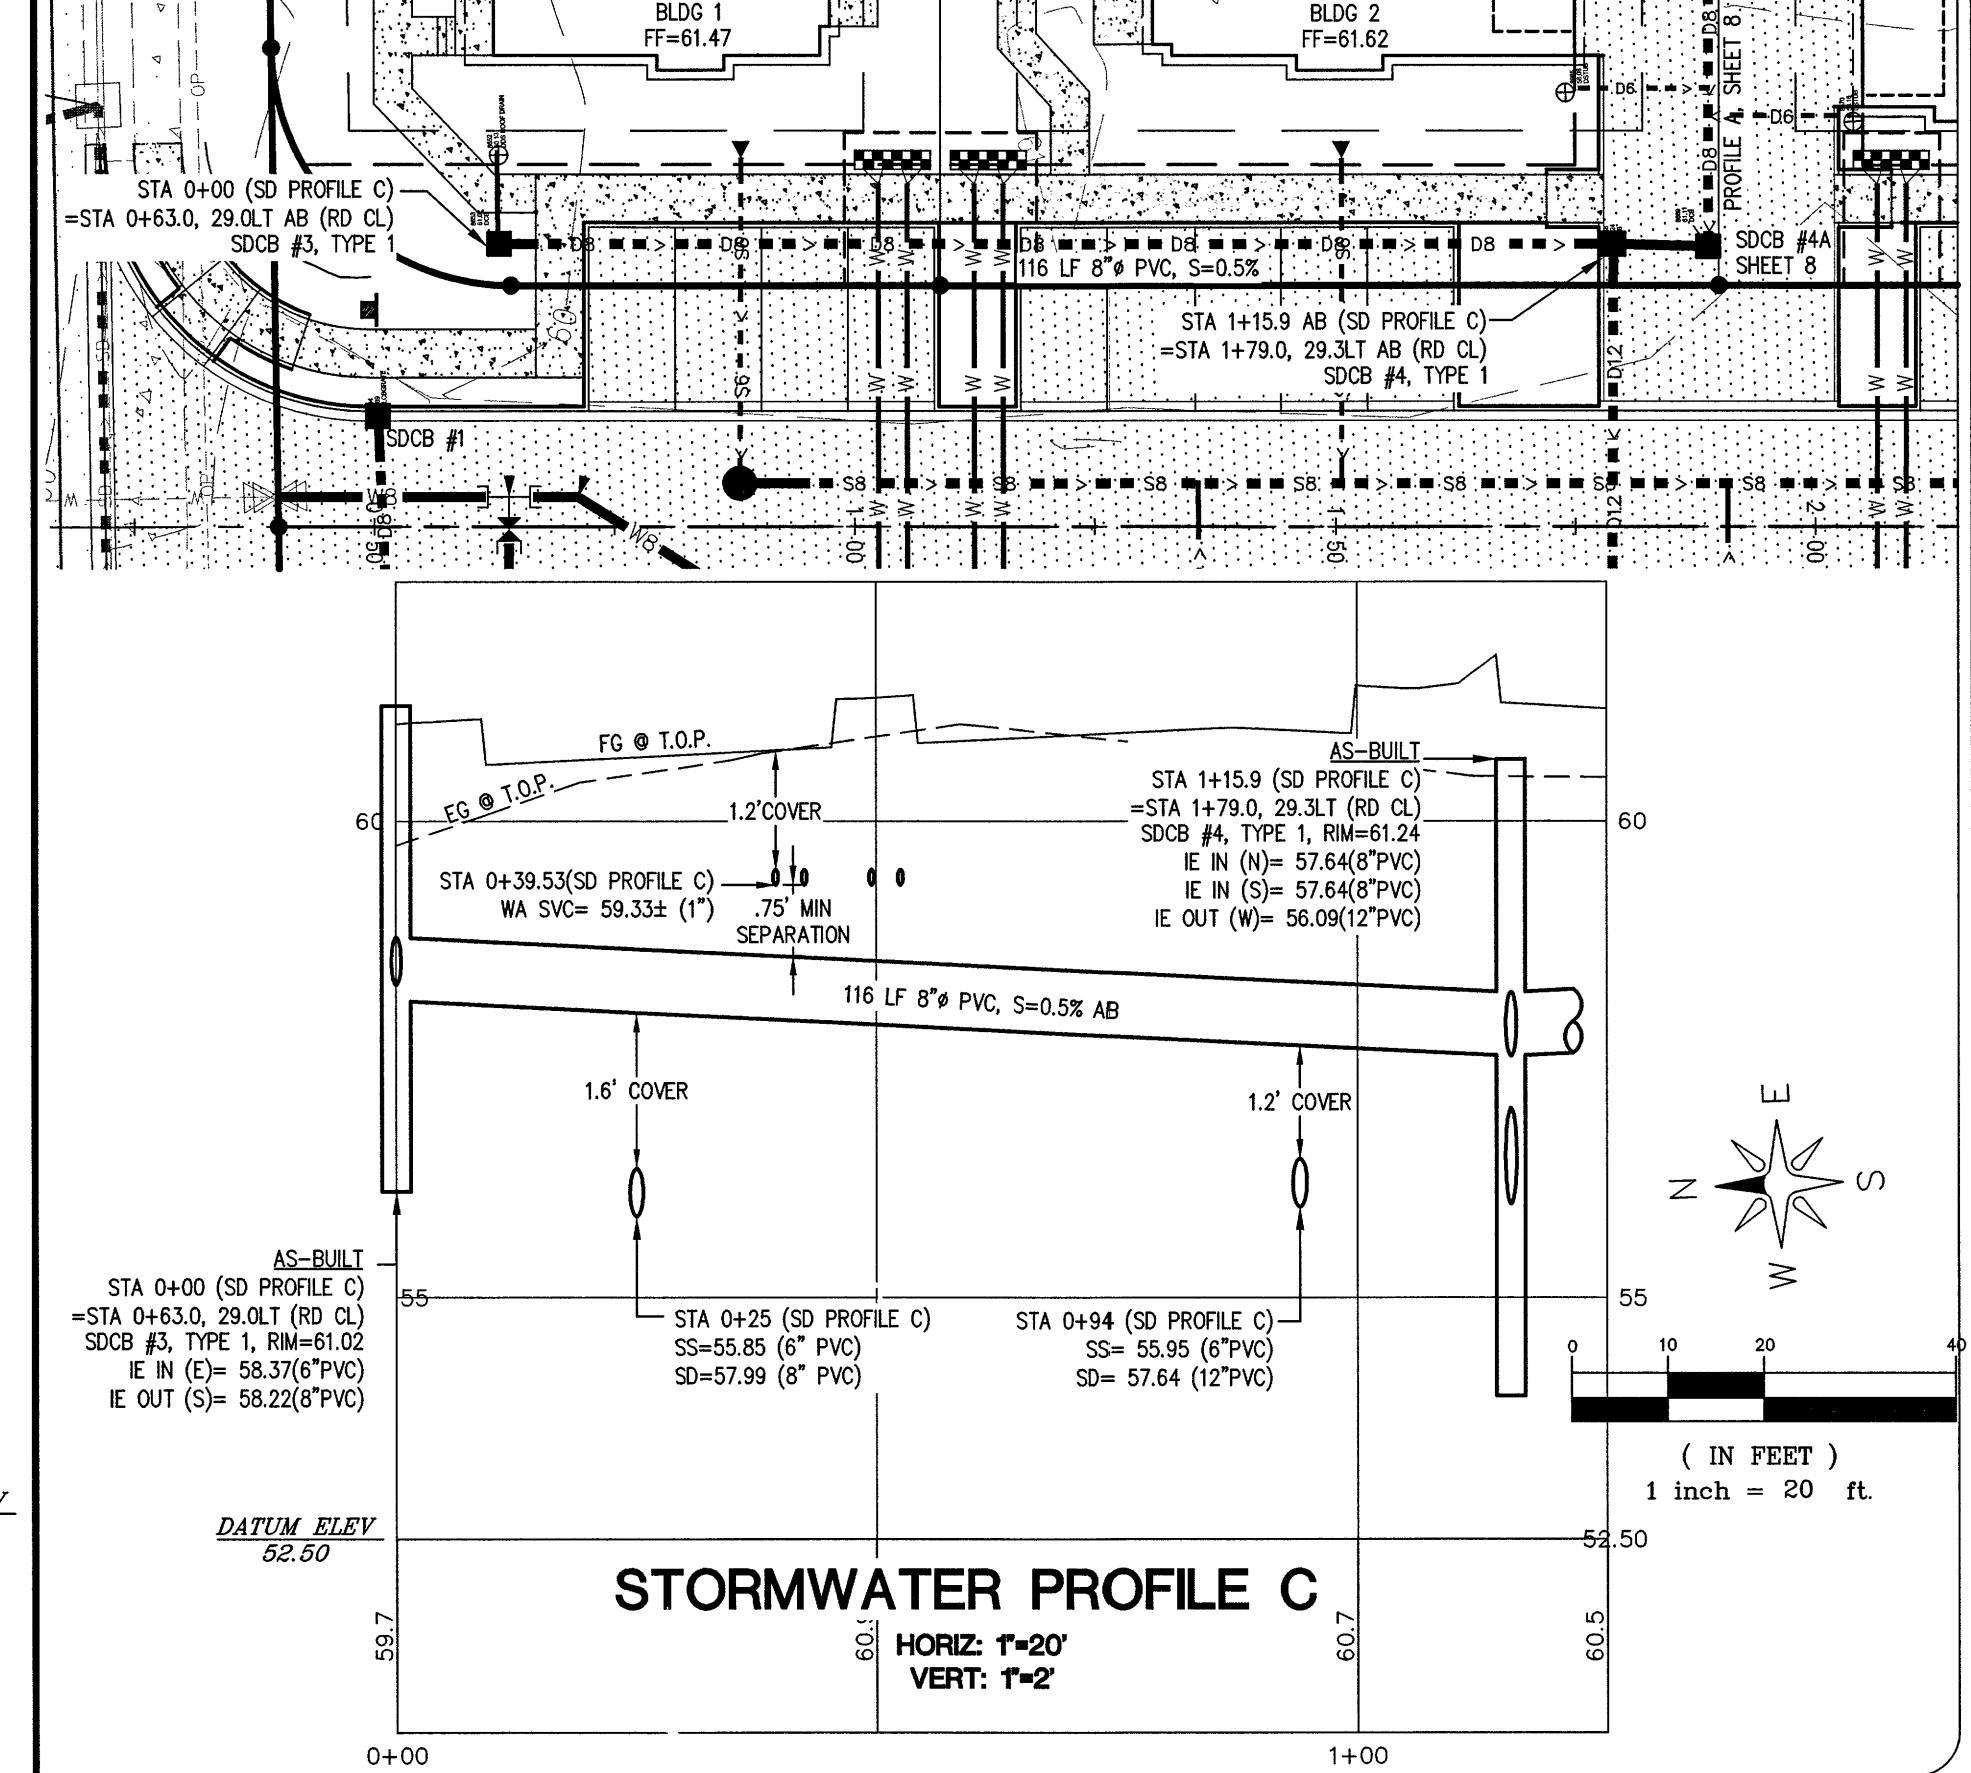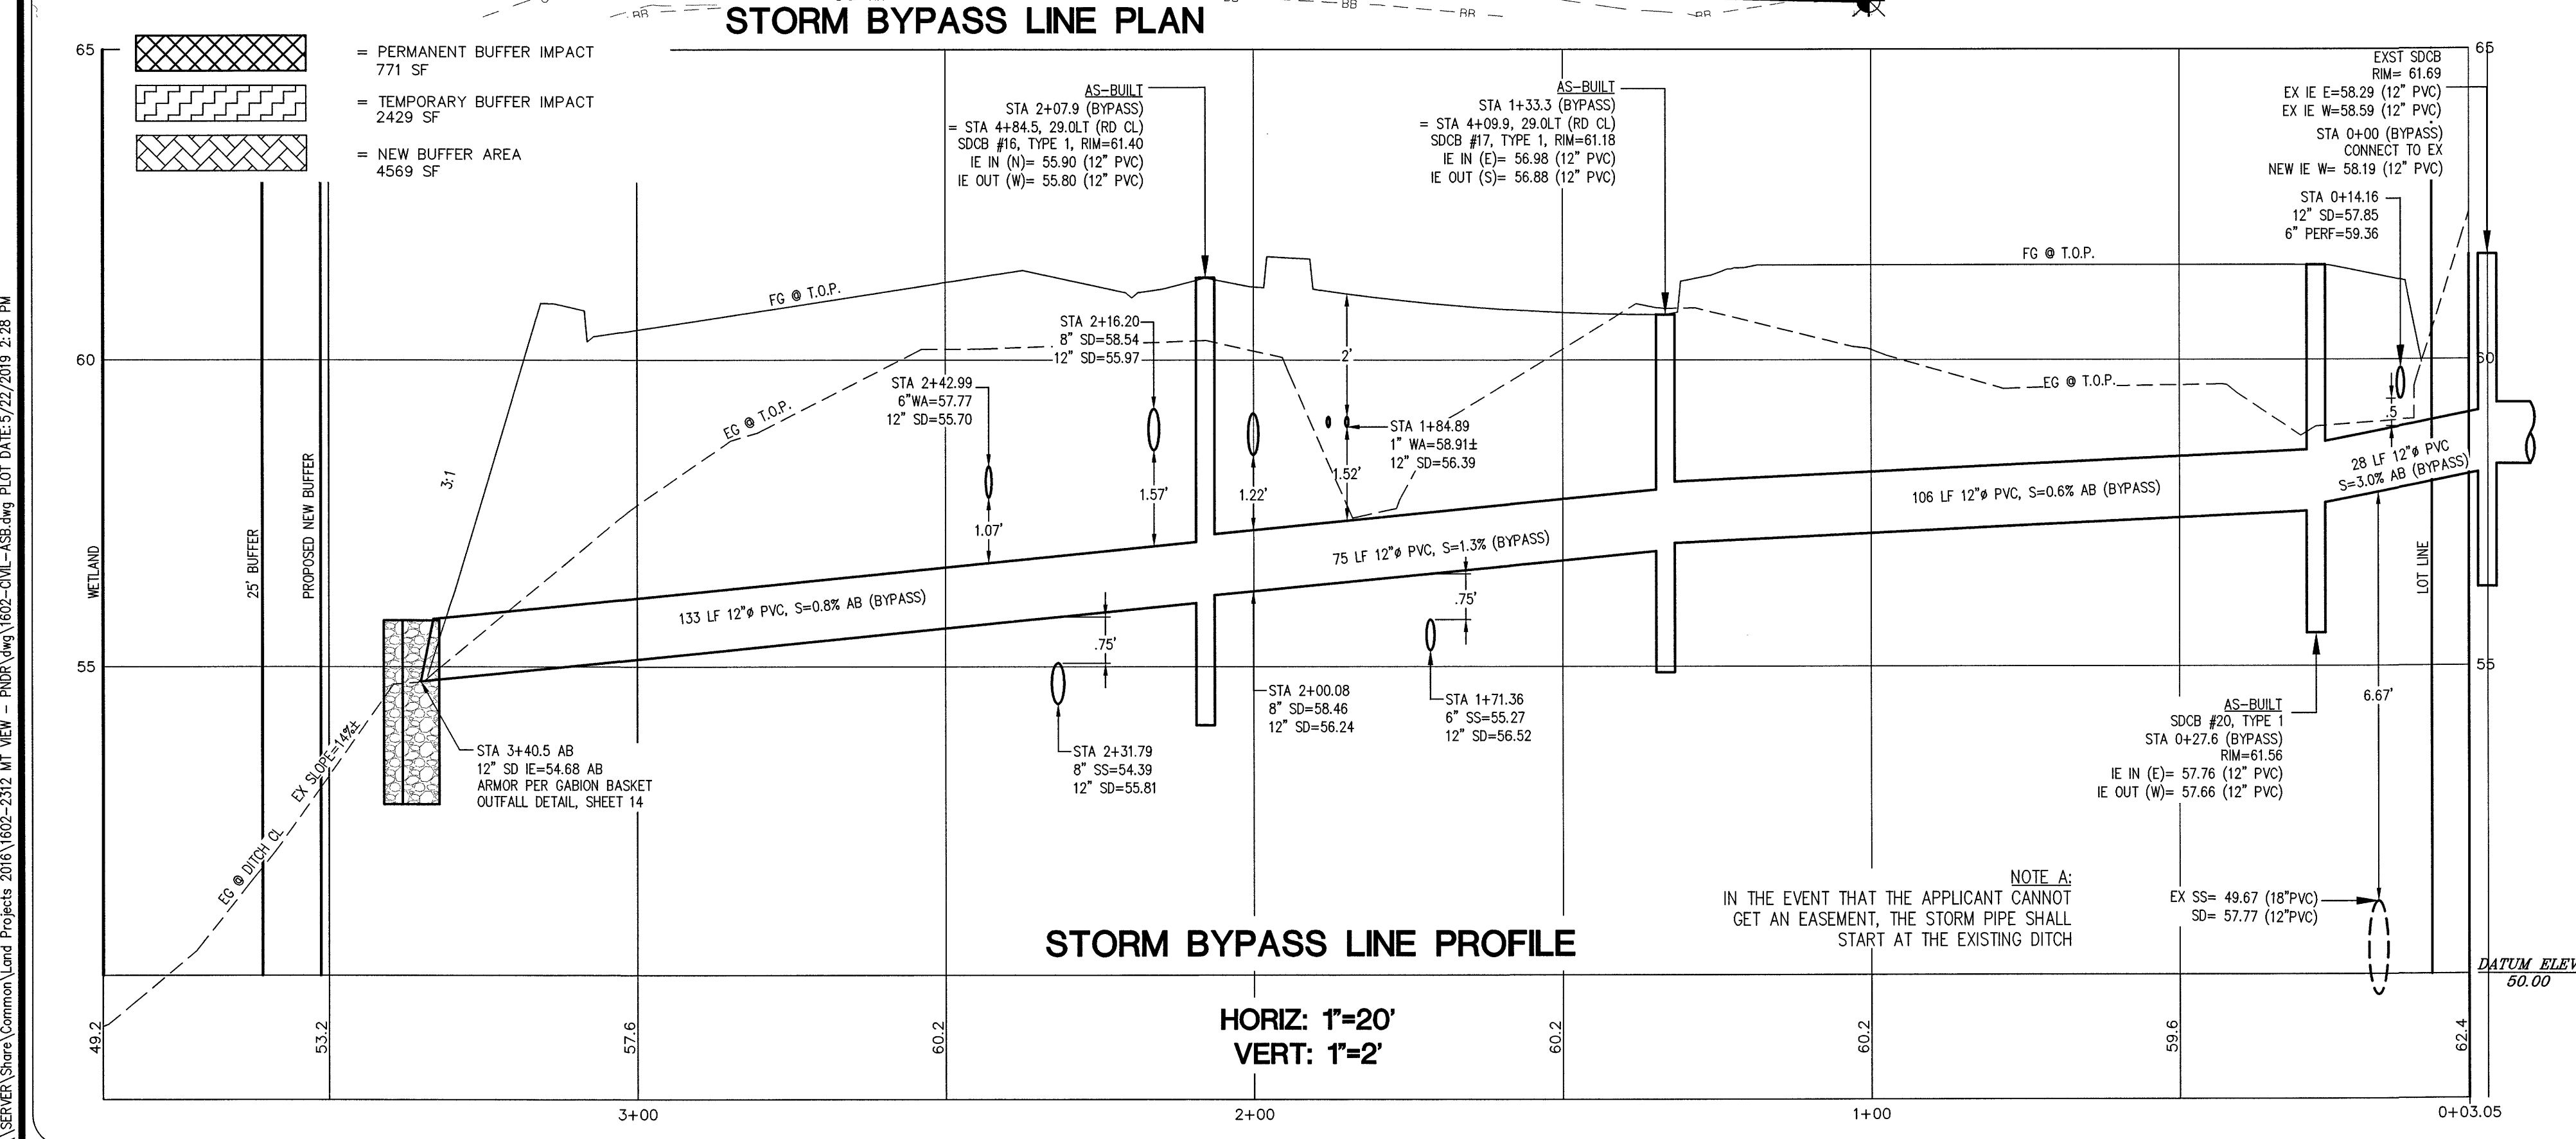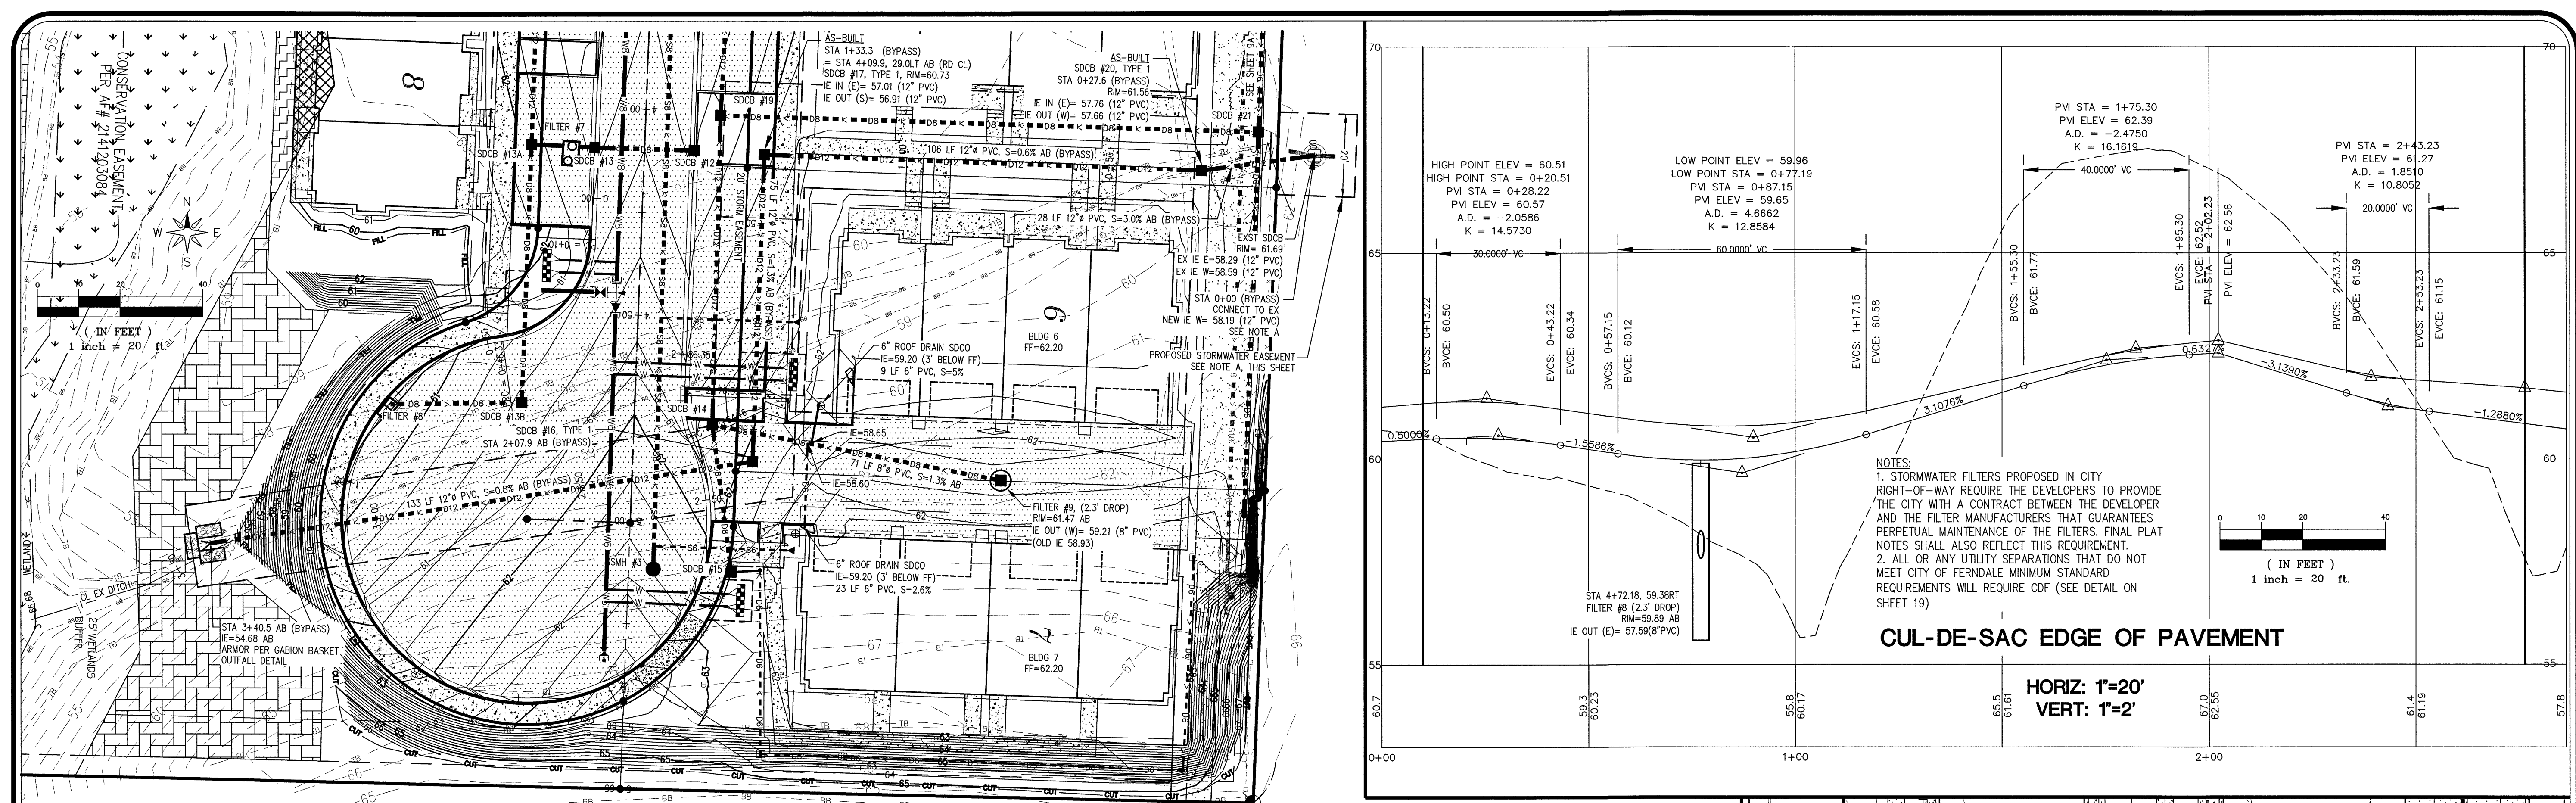

NO.	REVISION	BY	DATE	NO.	BY	DATE
1				1		
2				2		
3				3		
4				4		
5				5		
6				6		
7				7		
8				8		
9				9		
10				10		


PNRD
PO BOX 3249
FERNDAL, WA 98248

LDES, INC.
5160 INDUSTRIAL PL. #108
FERNDAL, WA 98248
PHONE 360-383-0620
FAX 360-383-0639



APPROVED
JUN 13 2019
CITY OF FERNDAL
PUBLIC WORKS DEPARTMENT

**ROAD & STORMWATER
PLAN & PROFILE 3**
MAIN STREET VILLAGE
2312 MAIN STREET, FERNDAL, WA
A PORTION OF SECTION 30, TOWNSHIP 39N, RANGE 2E, W.M.

09
OF
20

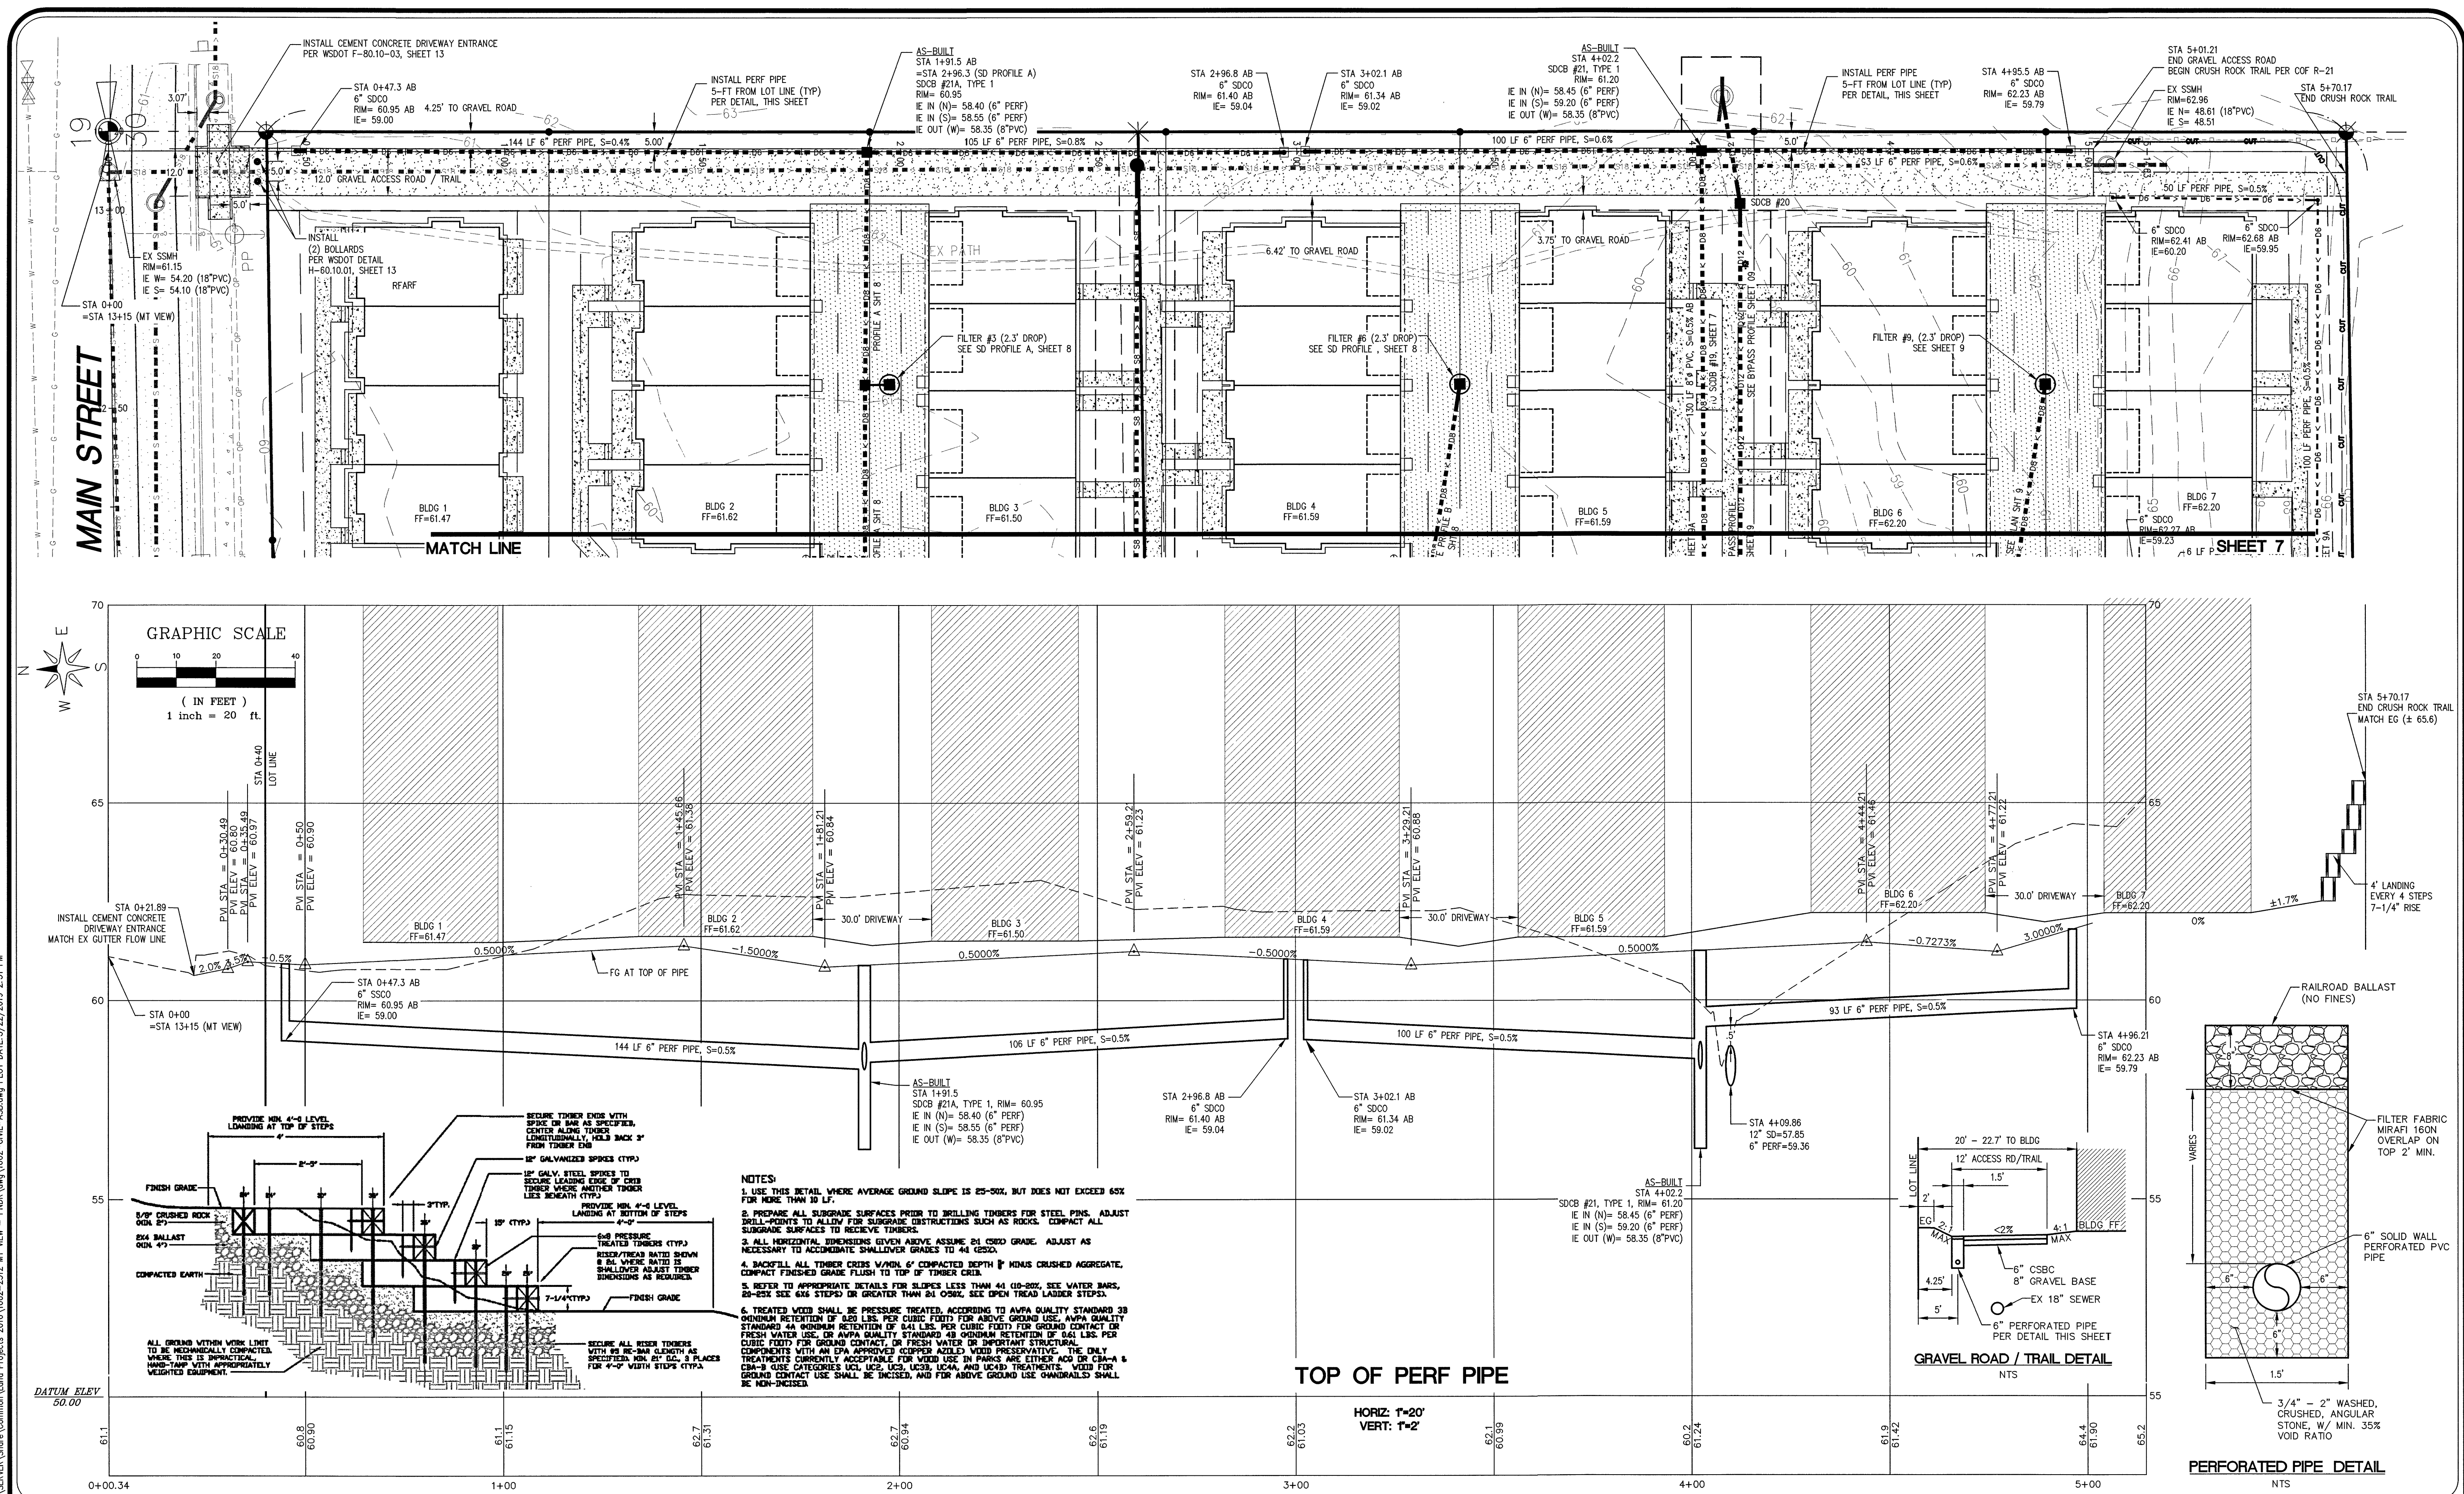

NO.	REVISION	BY	DATE
1	SUBMITTAL 1	RL	04/23/19
2			
3			
4			
5			
6			
7			
8			
9			
10			

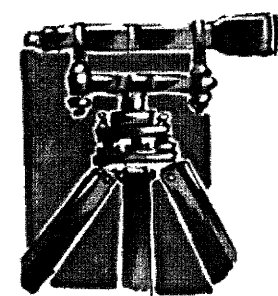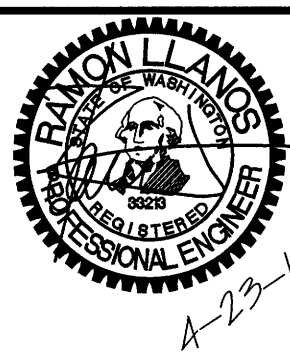

LDES, INC.
5160 INDUSTRIAL PL. #108
FERNDAL, WA 98248
PHONE 360-383-0620
FAX 360-383-0639

JOB NO.:	1602
DWG. NAME:	1602-CIVIL-ASB.dwg
DESIGNED BY:	RL
DRAWN BY:	EH
CHECKED BY:	RL

PNRD
PO BOX 3249
FERNDAL, WA 98248


APPROVED
JUN 13 2019
BY
CITY OF FERNDAL
PUBLIC WORKS DEPARTMENT

STORMWATER AT EAST LOT
PLAN & PROFILE 4
MAIN STREET VILLAGE
2312 MAIN STREET, FERNDAL, WA
A PORTION OF SECTION 30, TOWNSHIP 39N, RANGE 2E, W.M.



SHEET
09A
OF
20

RECORD DRAWING

\\SERVER.ShoreCommon\Land Projects\2016\1602-2312 MT VIEW - PNRD.dwg (1602-CIVIL-ASB.dwg) PLOT DATE: 5/22/2019 2:32 PM

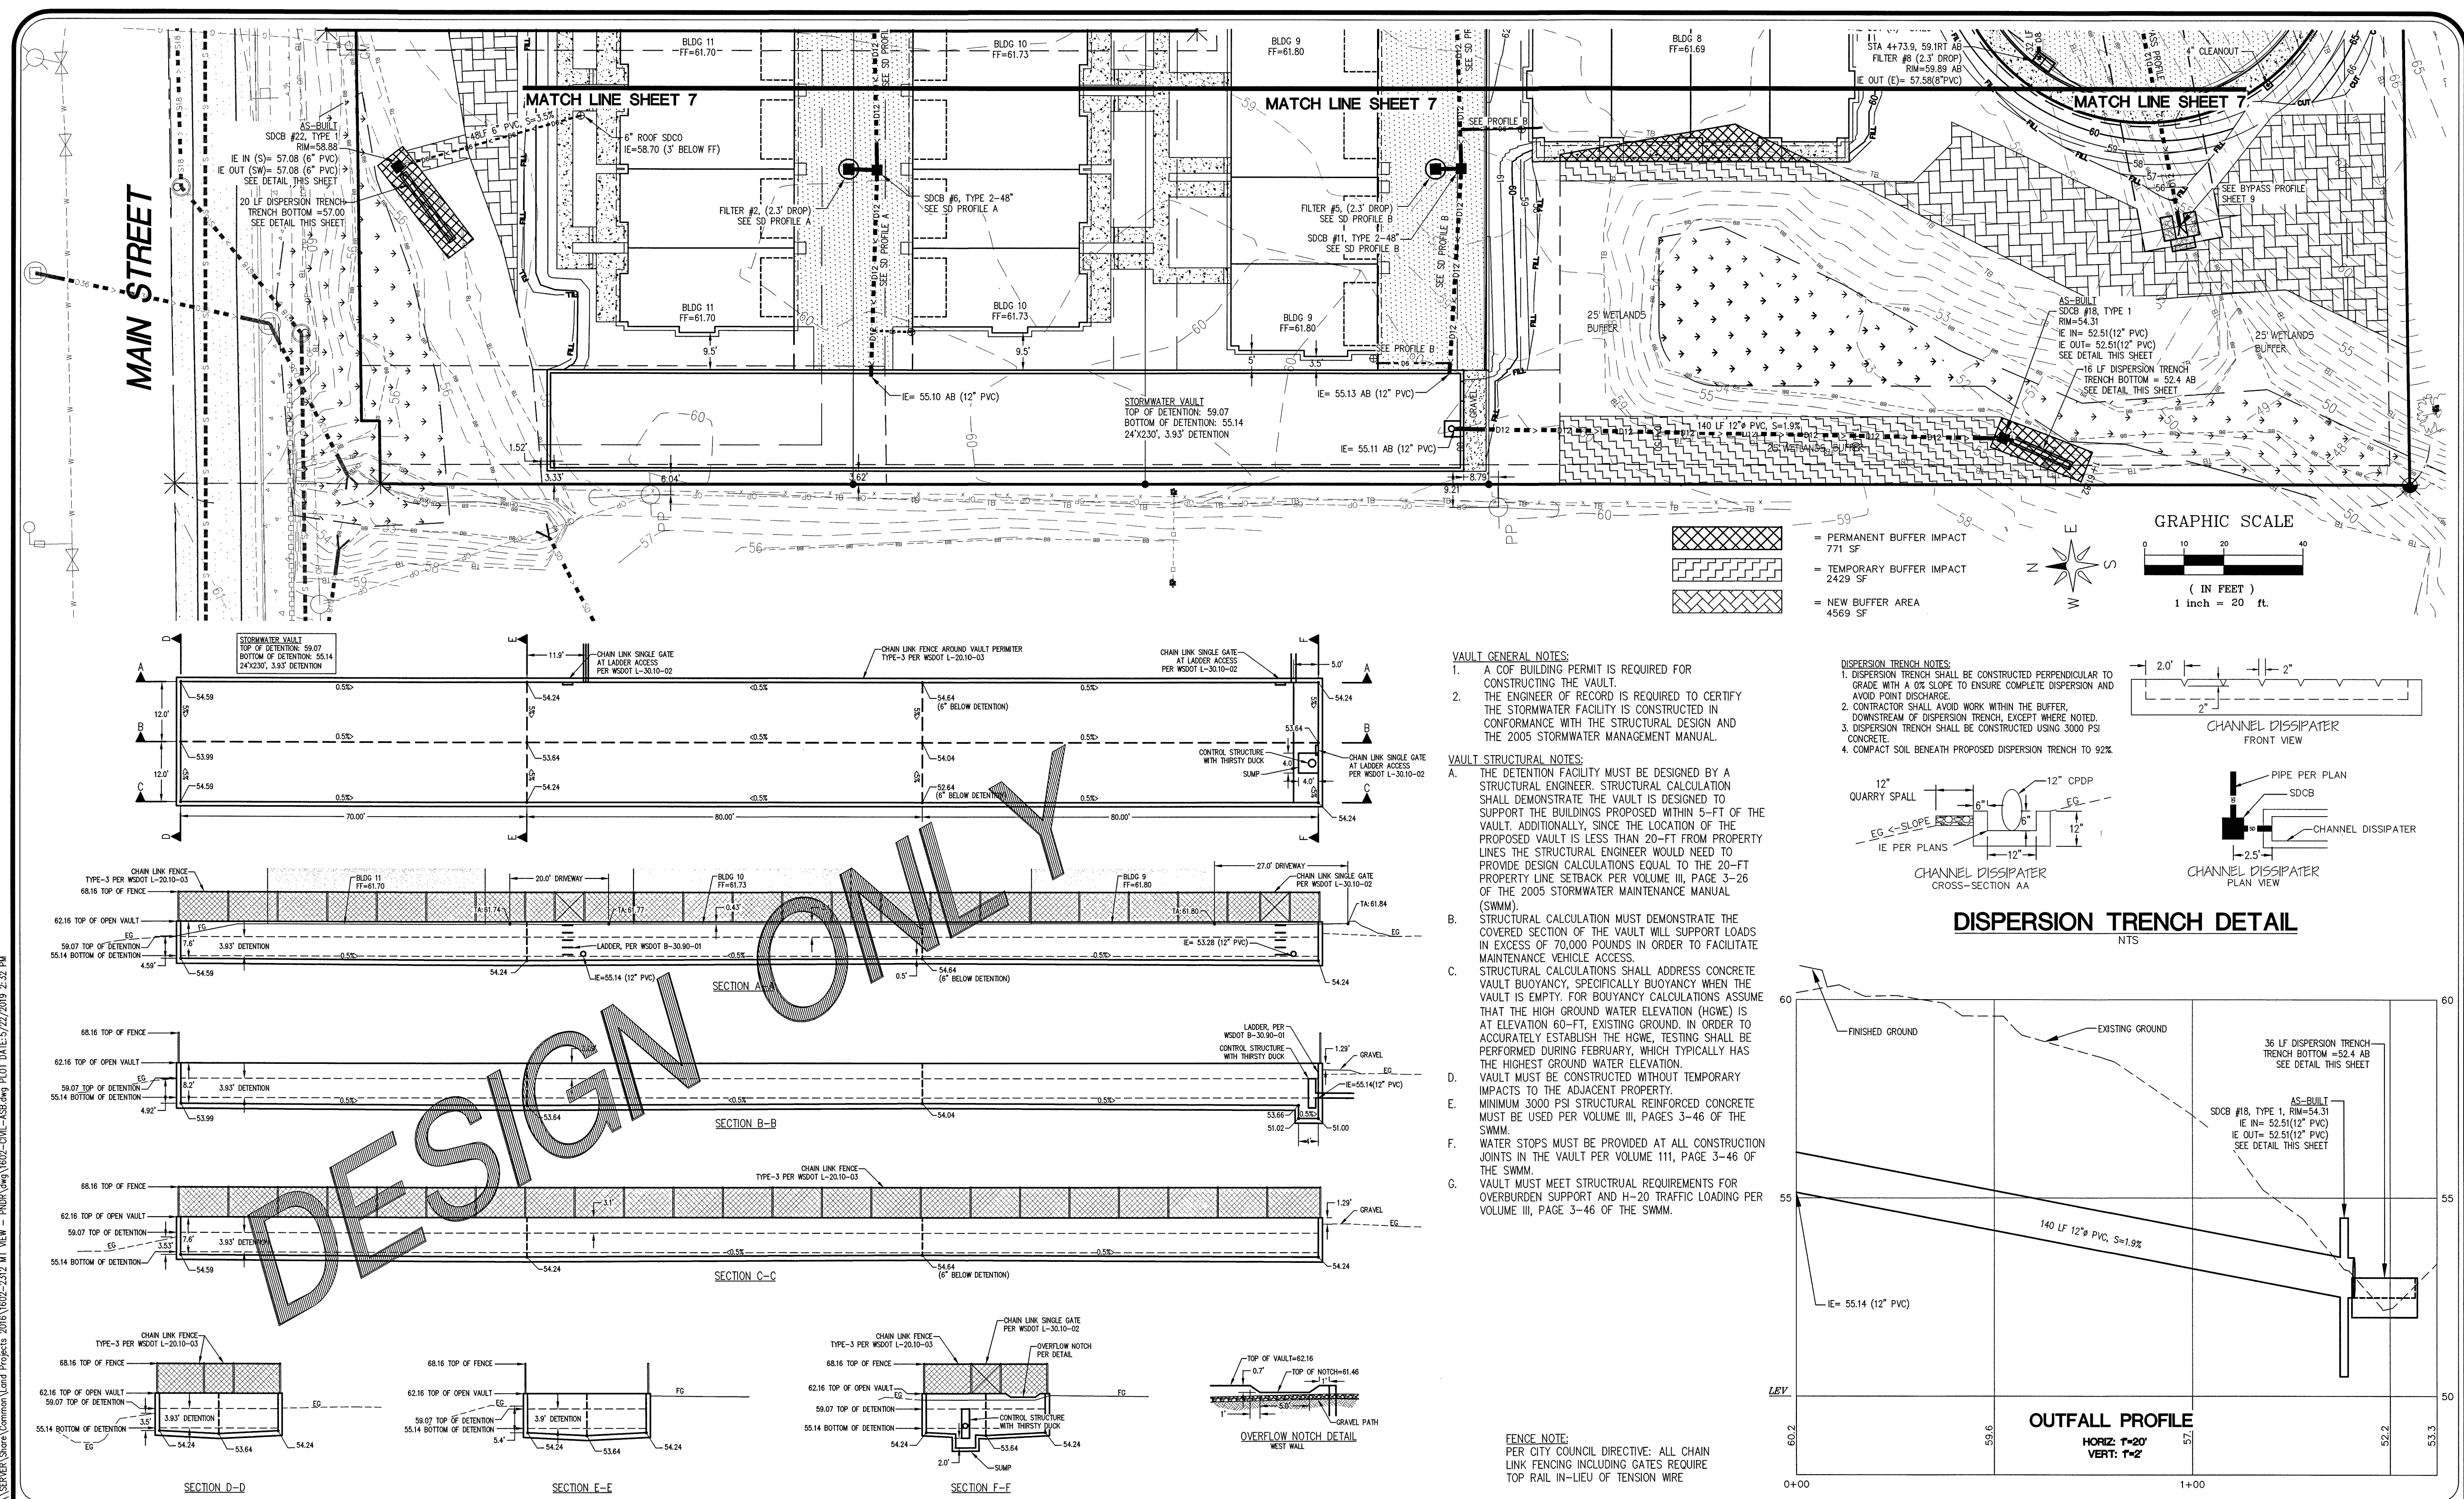

NO.	REVISION	BY	DATE	NO.	BY	DATE
1	SUBMITTAL 1	RL	04/23/19			
2						
3						
4						
5						

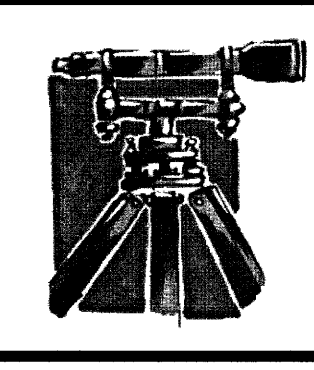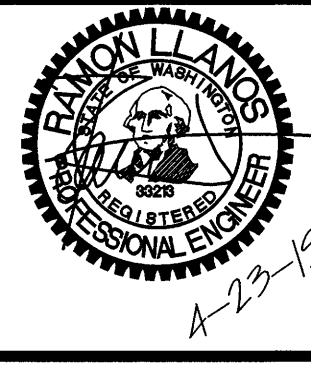

LDES, INC.
5160 INDUSTRIAL PL. #108
FERNDAL, WA 98248
PHONE 360-383-0620
FAX 360-383-0639

JOB NO.: 1602
DWG. NAME: 1602-CIVIL-ASB.dwg
DESIGNED BY: RL
DRAWN BY: EH
CHECKED BY: RL

PNRD
PO BOX 3249
FERNDAL, WA 98248




APPROVED
JUN 13 2019
BY: CITY OF FERNDAL
PUBLIC WORKS DEPARTMENT

ROAD & STORMWATER PLAN & DETAIL
STORMWATER VAULT

MAIN STREET VILLAGE
2312 MAIN STREET, FERNDAL, WA
A PORTION OF SECTION 30, TOWNSHIP 39N, RANGE 2E, WM.

SHEET
10
OF
20


RECORD DRAWING

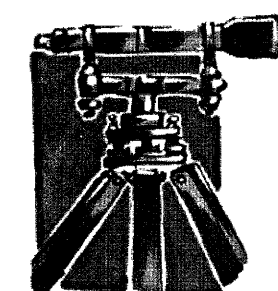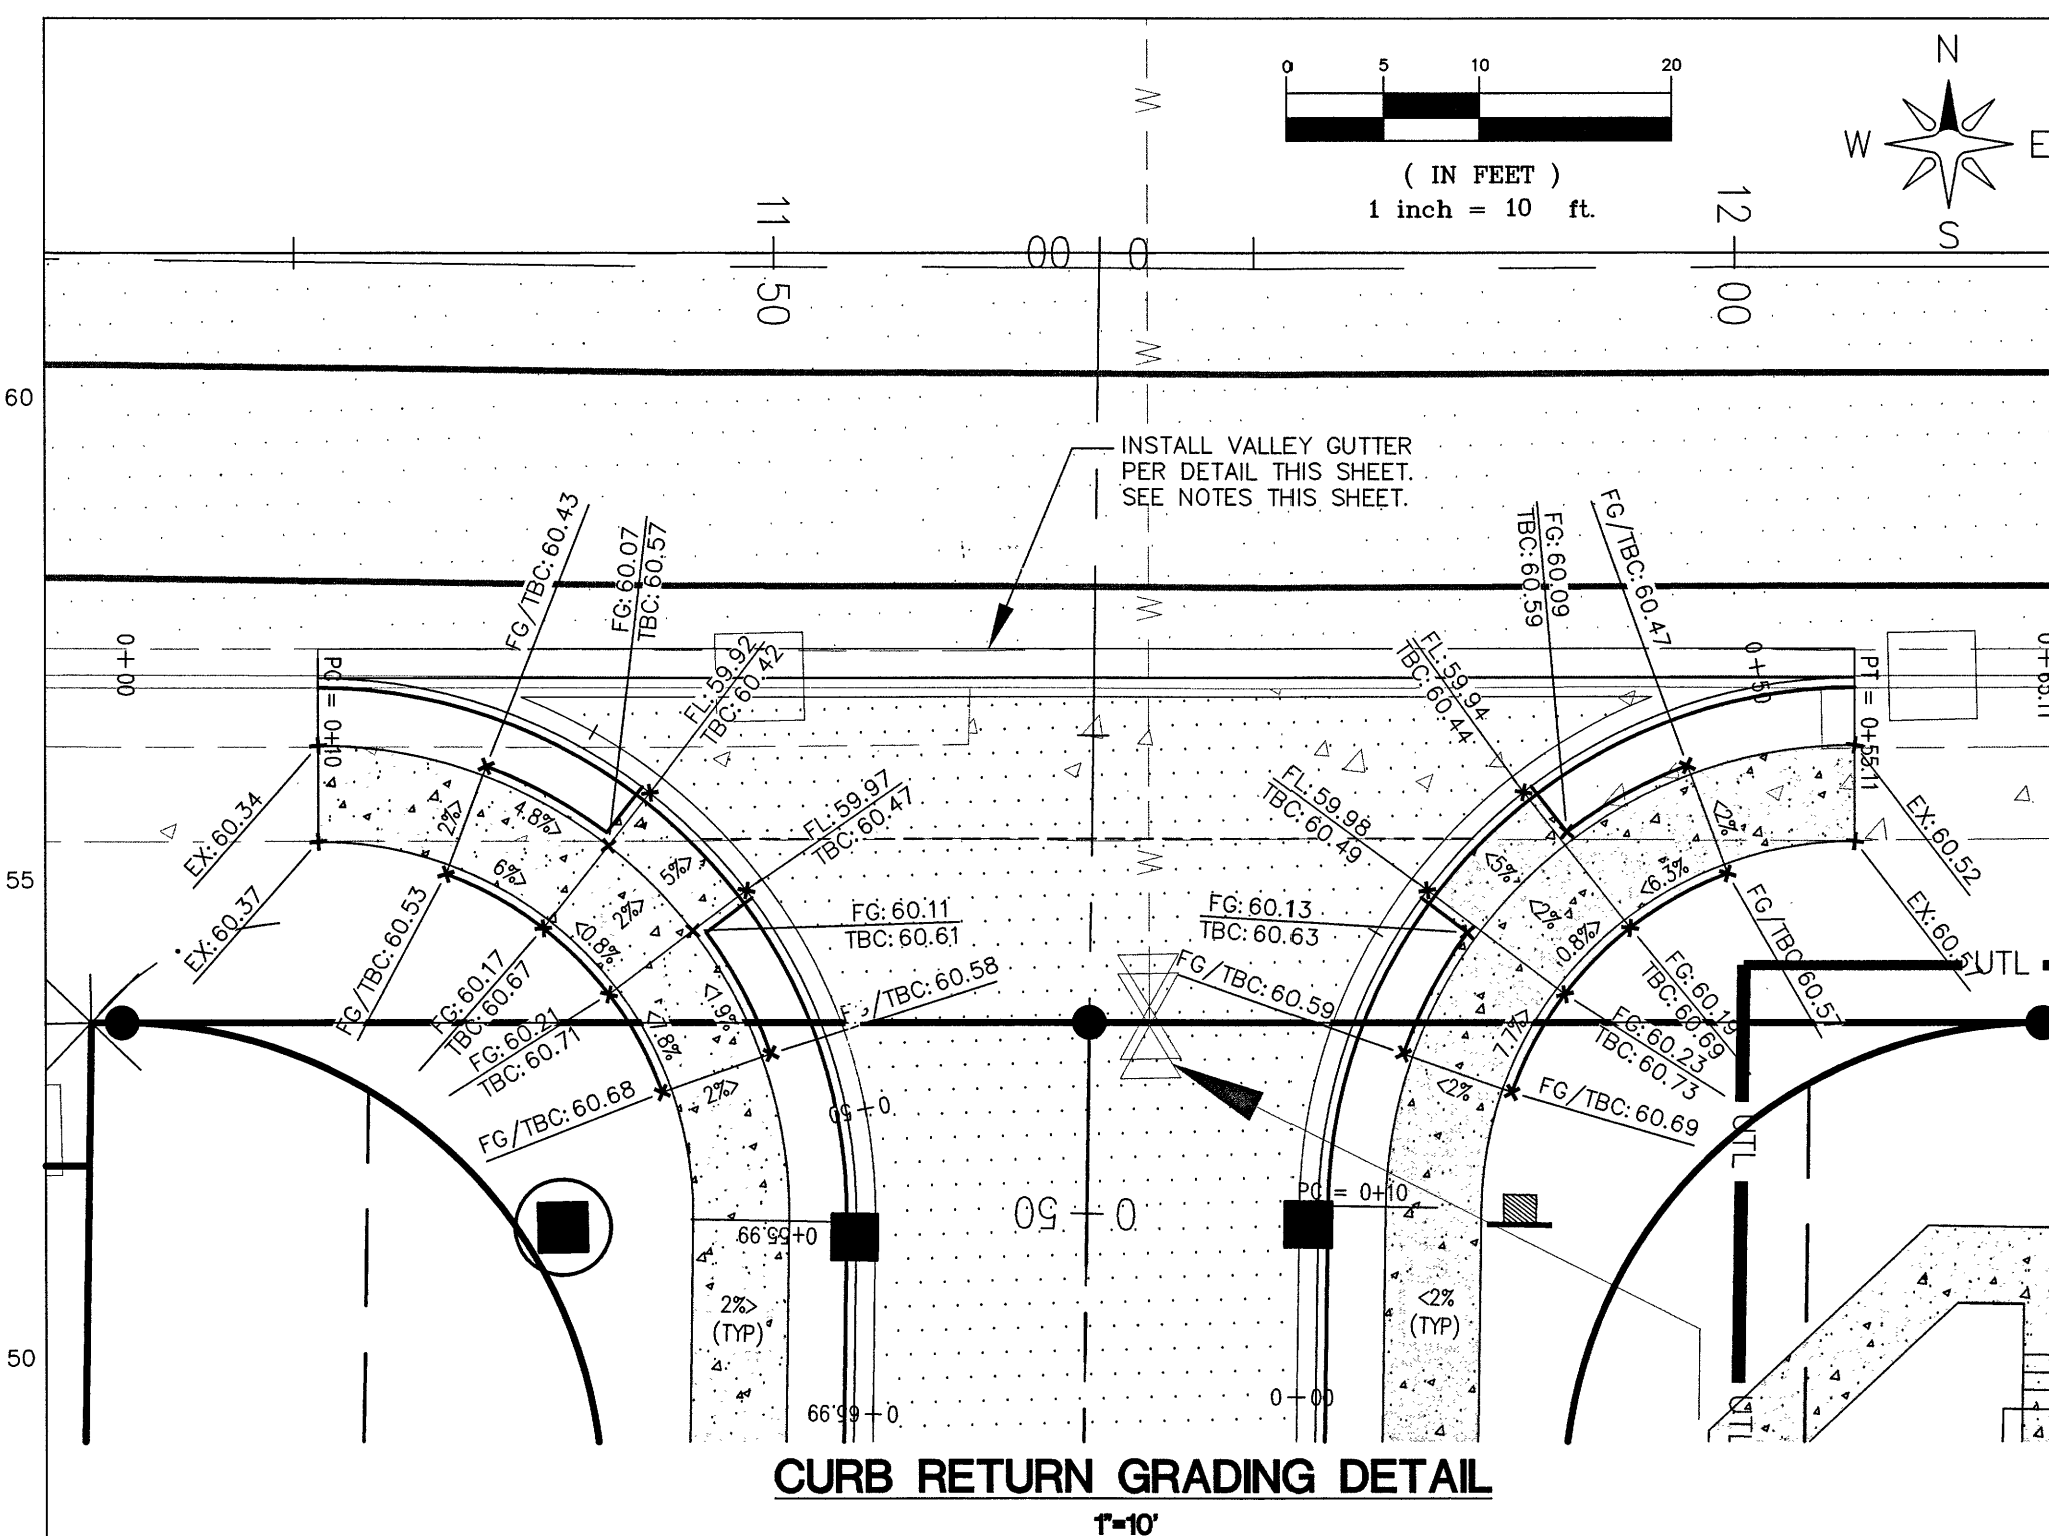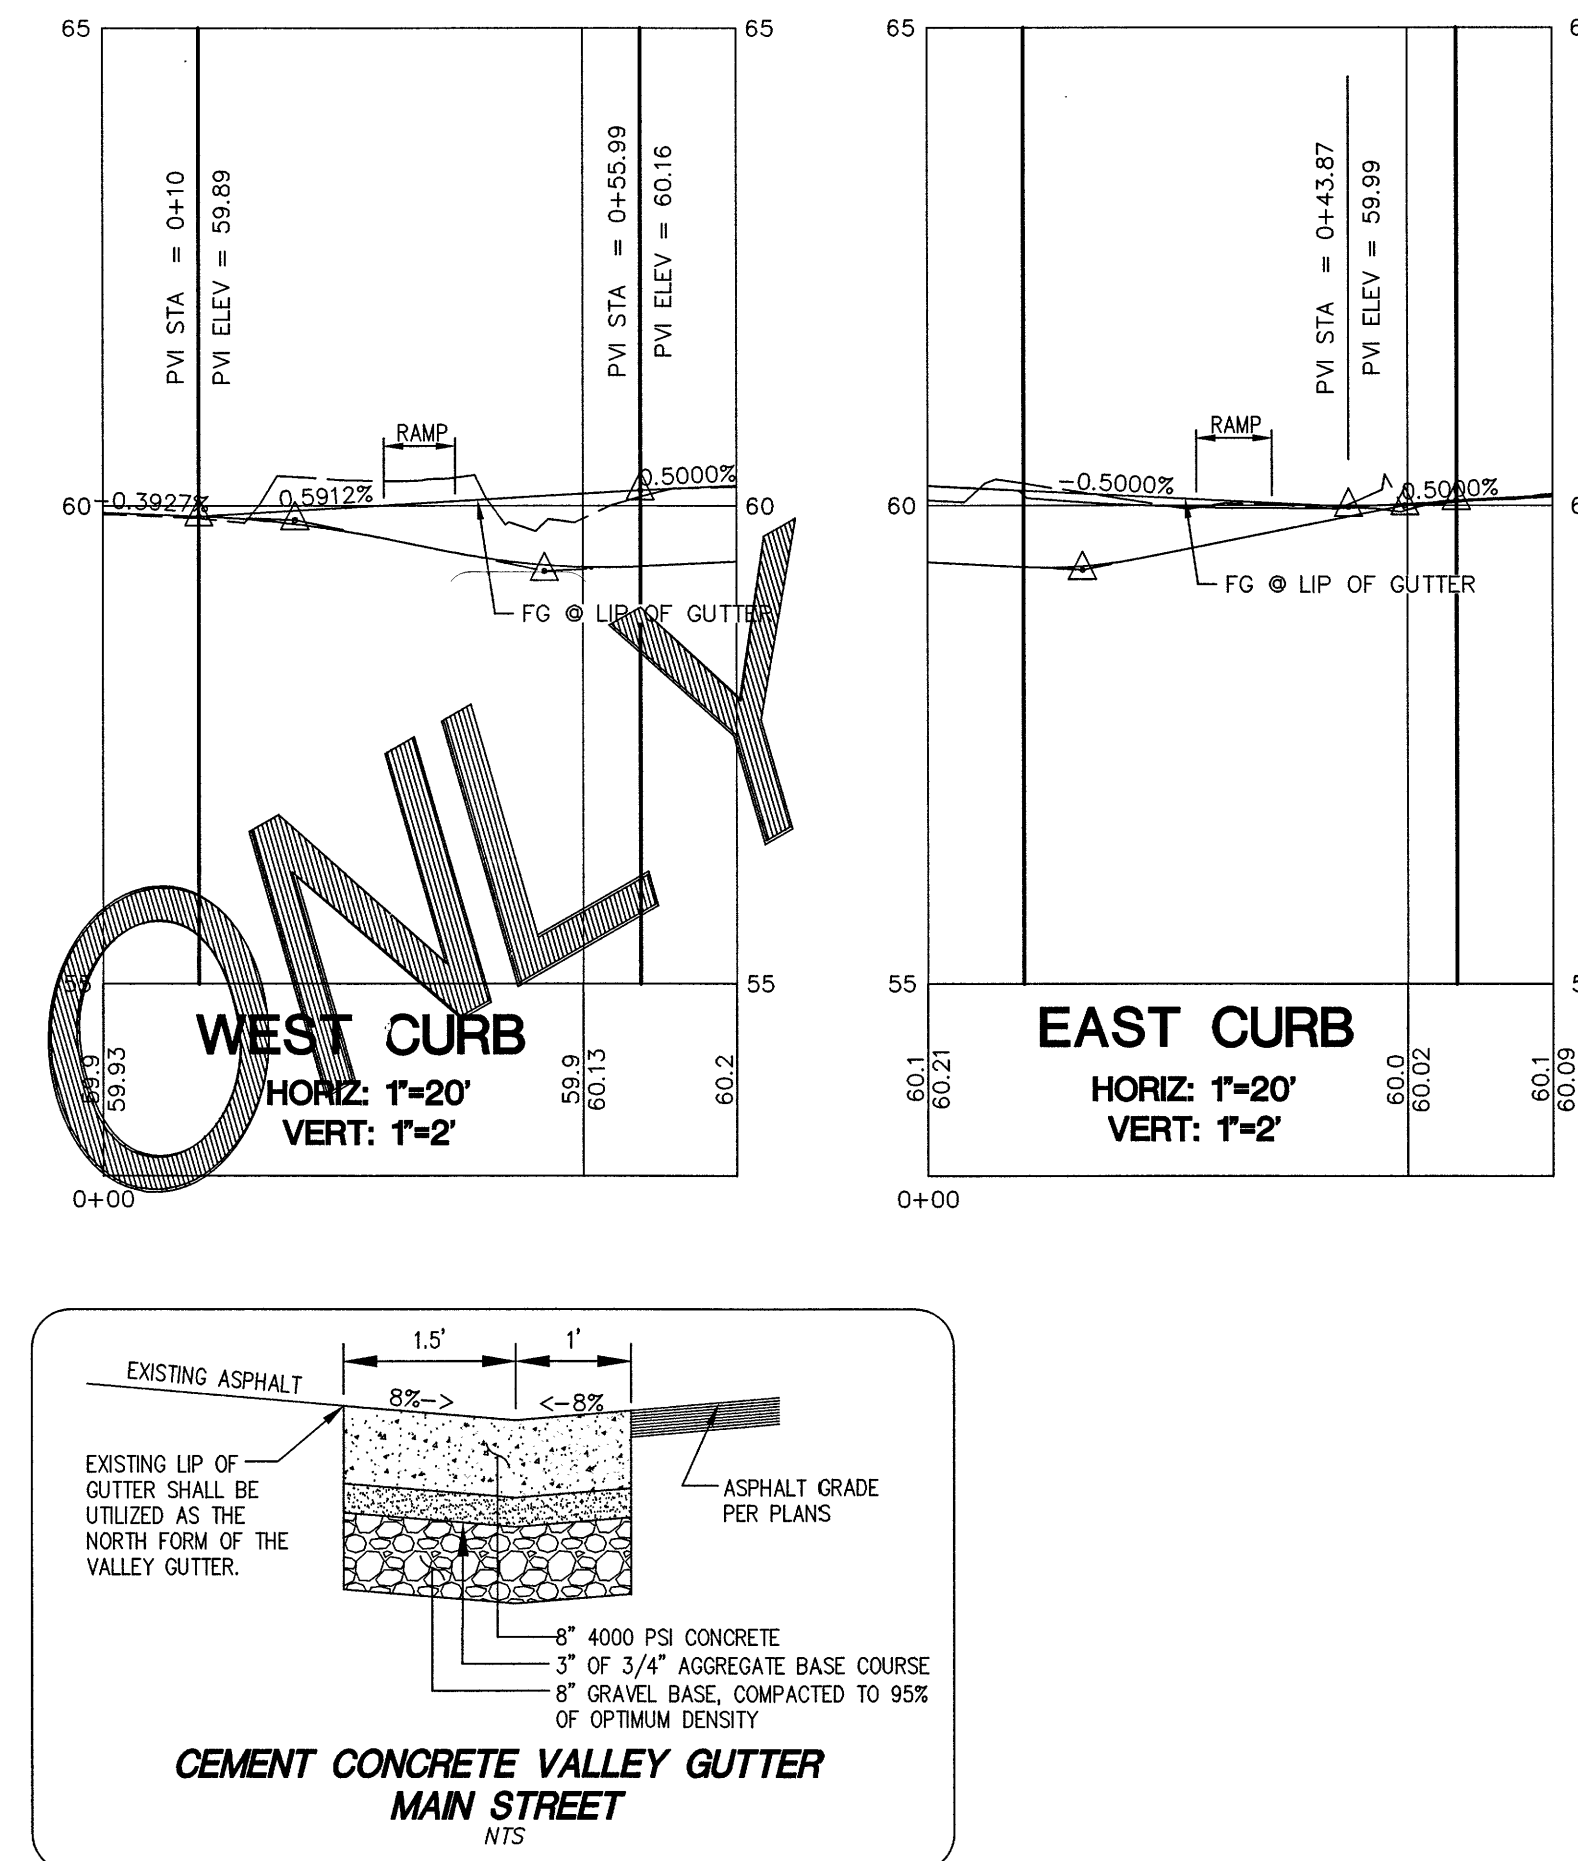

APPROVED
JUN 13 2019
BY [Signature]
CITY OF FERRISDALE
PUBLIC WORKS DEPARTMENT


SHEET
11
OF
20

RECORD DRAWING

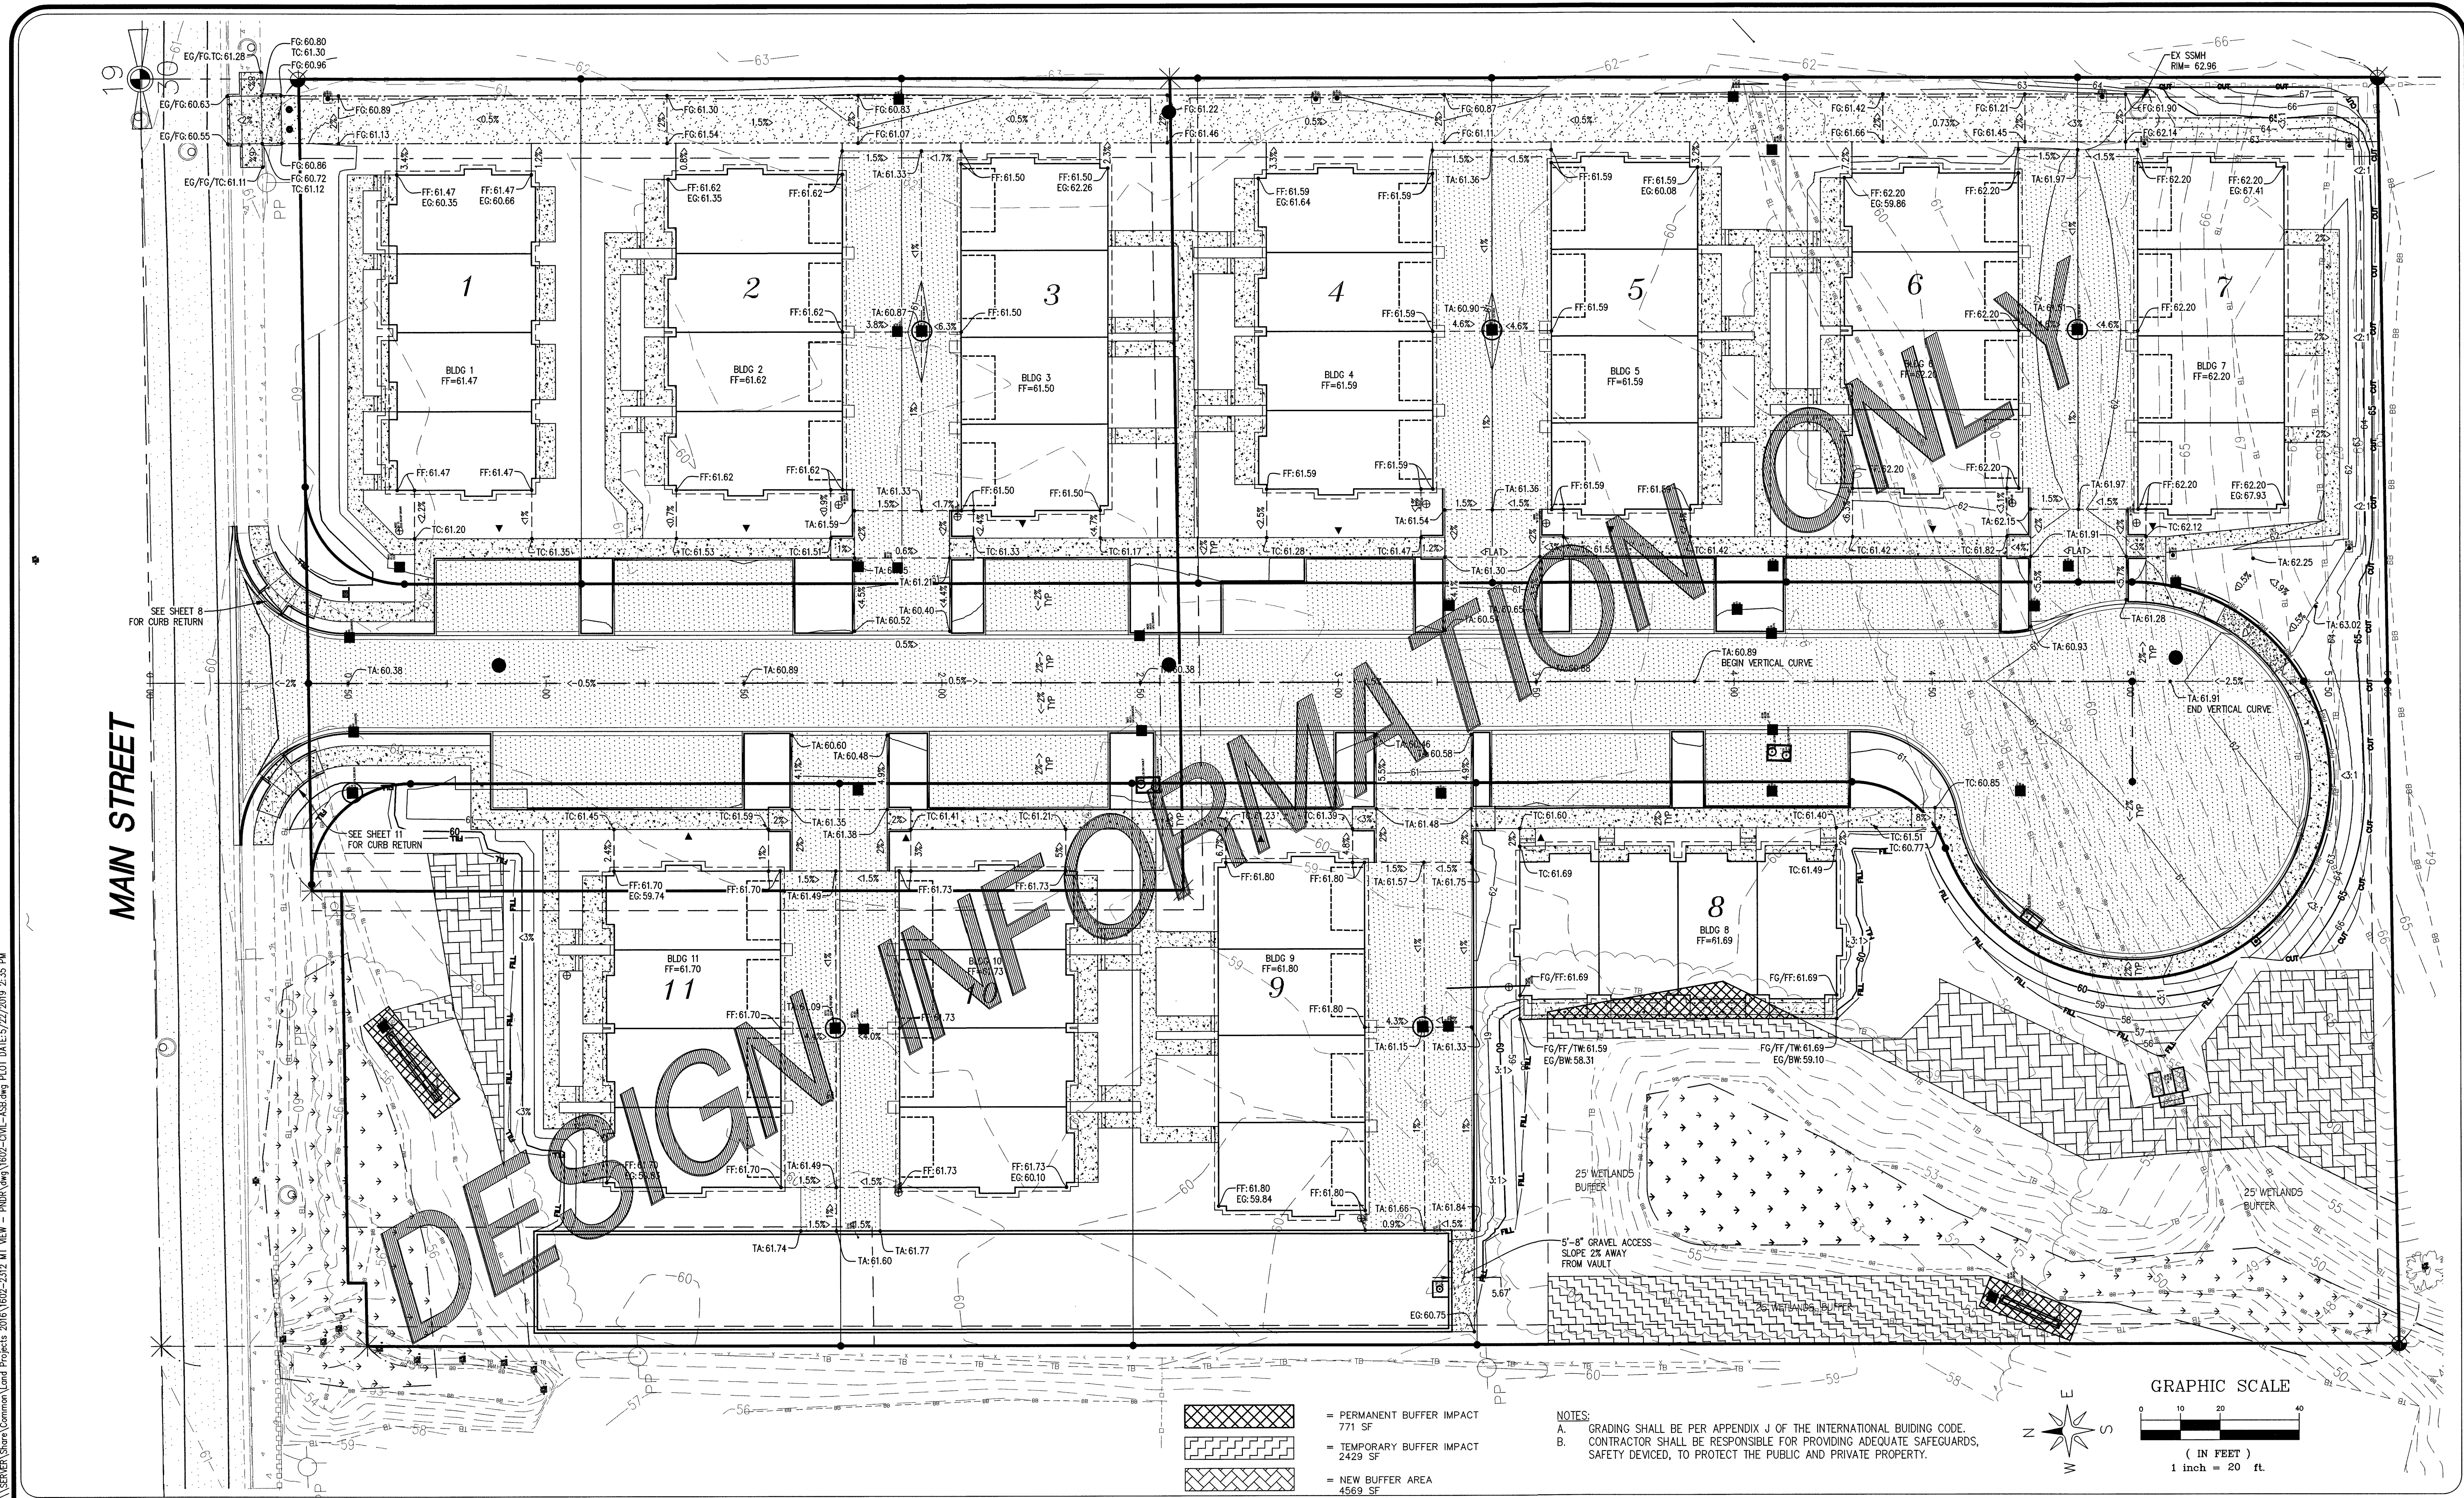

\\SERVER\Share\Common\Land Projects 2016\1602-2312 MT NEW - PNRD\1602-CIVIL-ASB.dwg PLOT DATE: 5/22/2019 2:35 PM

NO.	REVISION	BY	DATE	NO.	BY	DATE
1	SUBMITTAL 1	RL	04/23/19	1		
2				2		
3				3		
4				4		
5				5		
6				6		
7				7		
8				8		
9				9		
10				10		
11				11		

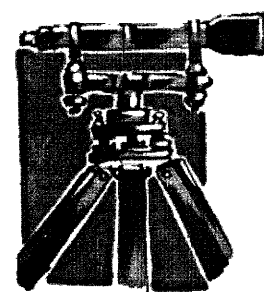

LDES, INC.
5160 INDUSTRIAL PL. #108
FERNDAL, WA 98248
PHONE 360-383-0620
FAX 360-383-0639

JOB NO.:	1602
DWG. NAME:	1602-CIVIL-ASB.dwg
DESIGNED BY:	RL
DRAWN BY:	EH
CHECKED BY:	RL

PNRD
PO BOX 3249
FERNDAL, WA 98248


APPROVED
JUN 13 2019

BY
CITY OF FERNDAL
PUBLIC WORKS DEPARTMENT

GRADING PLAN





MAIN STREET VILLAGE
2312 MAIN STREET, FERNDAL, WA
A PORTION OF SECTION 30, TOWNSHIP 39N, RANGE 2E, WM.

SHEET
12
OF
20


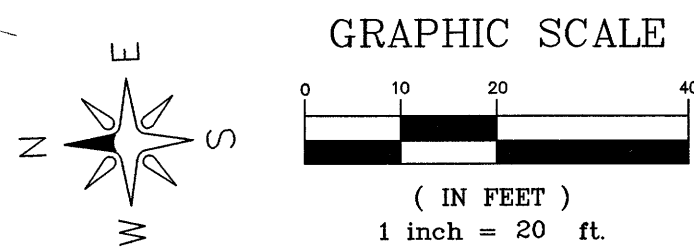


NOTES:
A. GRADING SHALL BE PER APPENDIX J OF THE INTERNATIONAL BUILDING CODE.
B. CONTRACTOR SHALL BE RESPONSIBLE FOR PROVIDING ADEQUATE SAFEGUARDS, SAFETY DEVICES, TO PROTECT THE PUBLIC AND PRIVATE PROPERTY.

- = PERMANENT BUFFER IMPACT
771 SF
- = TEMPORARY BUFFER IMPACT
2429 SF
- = NEW BUFFER AREA
4569 SF

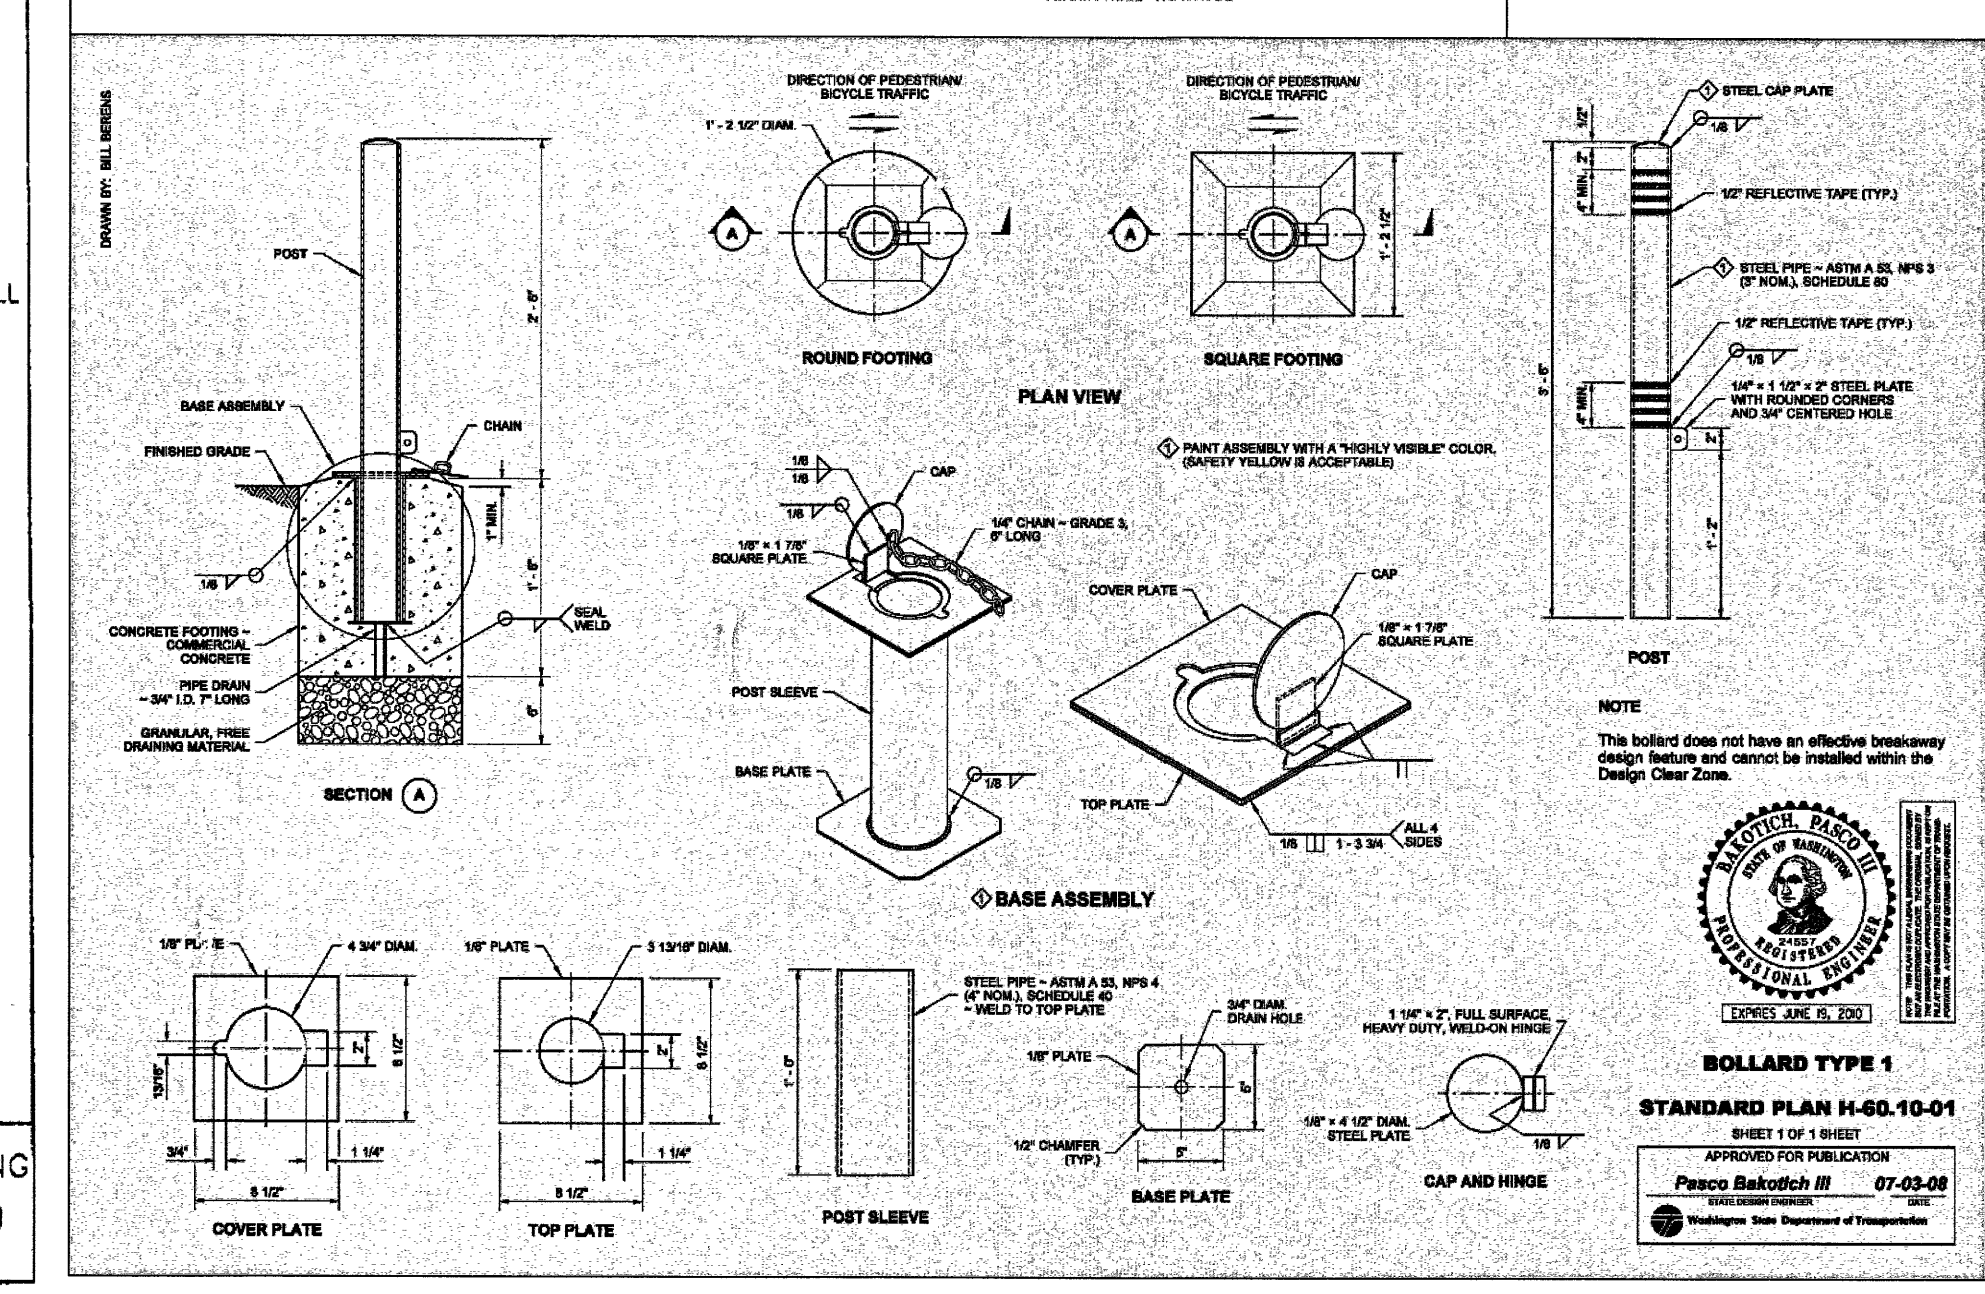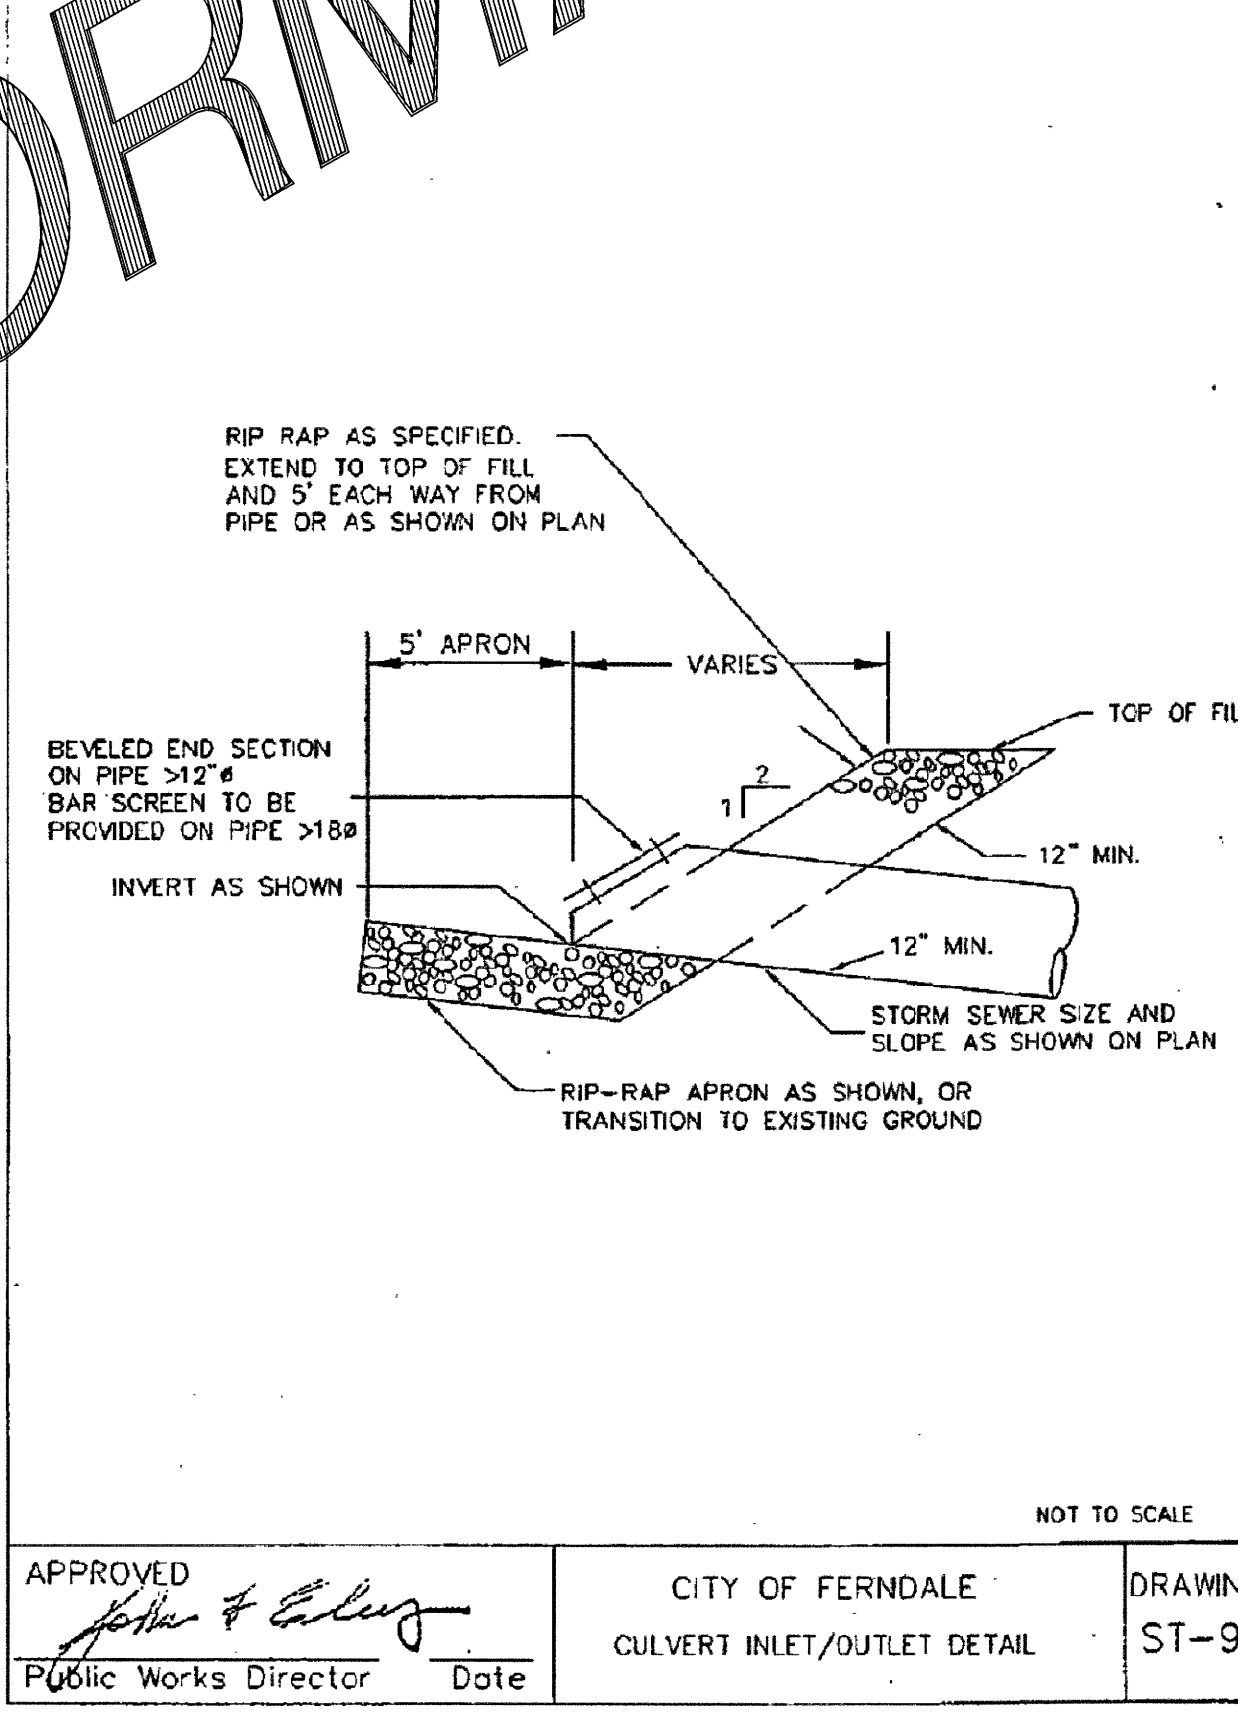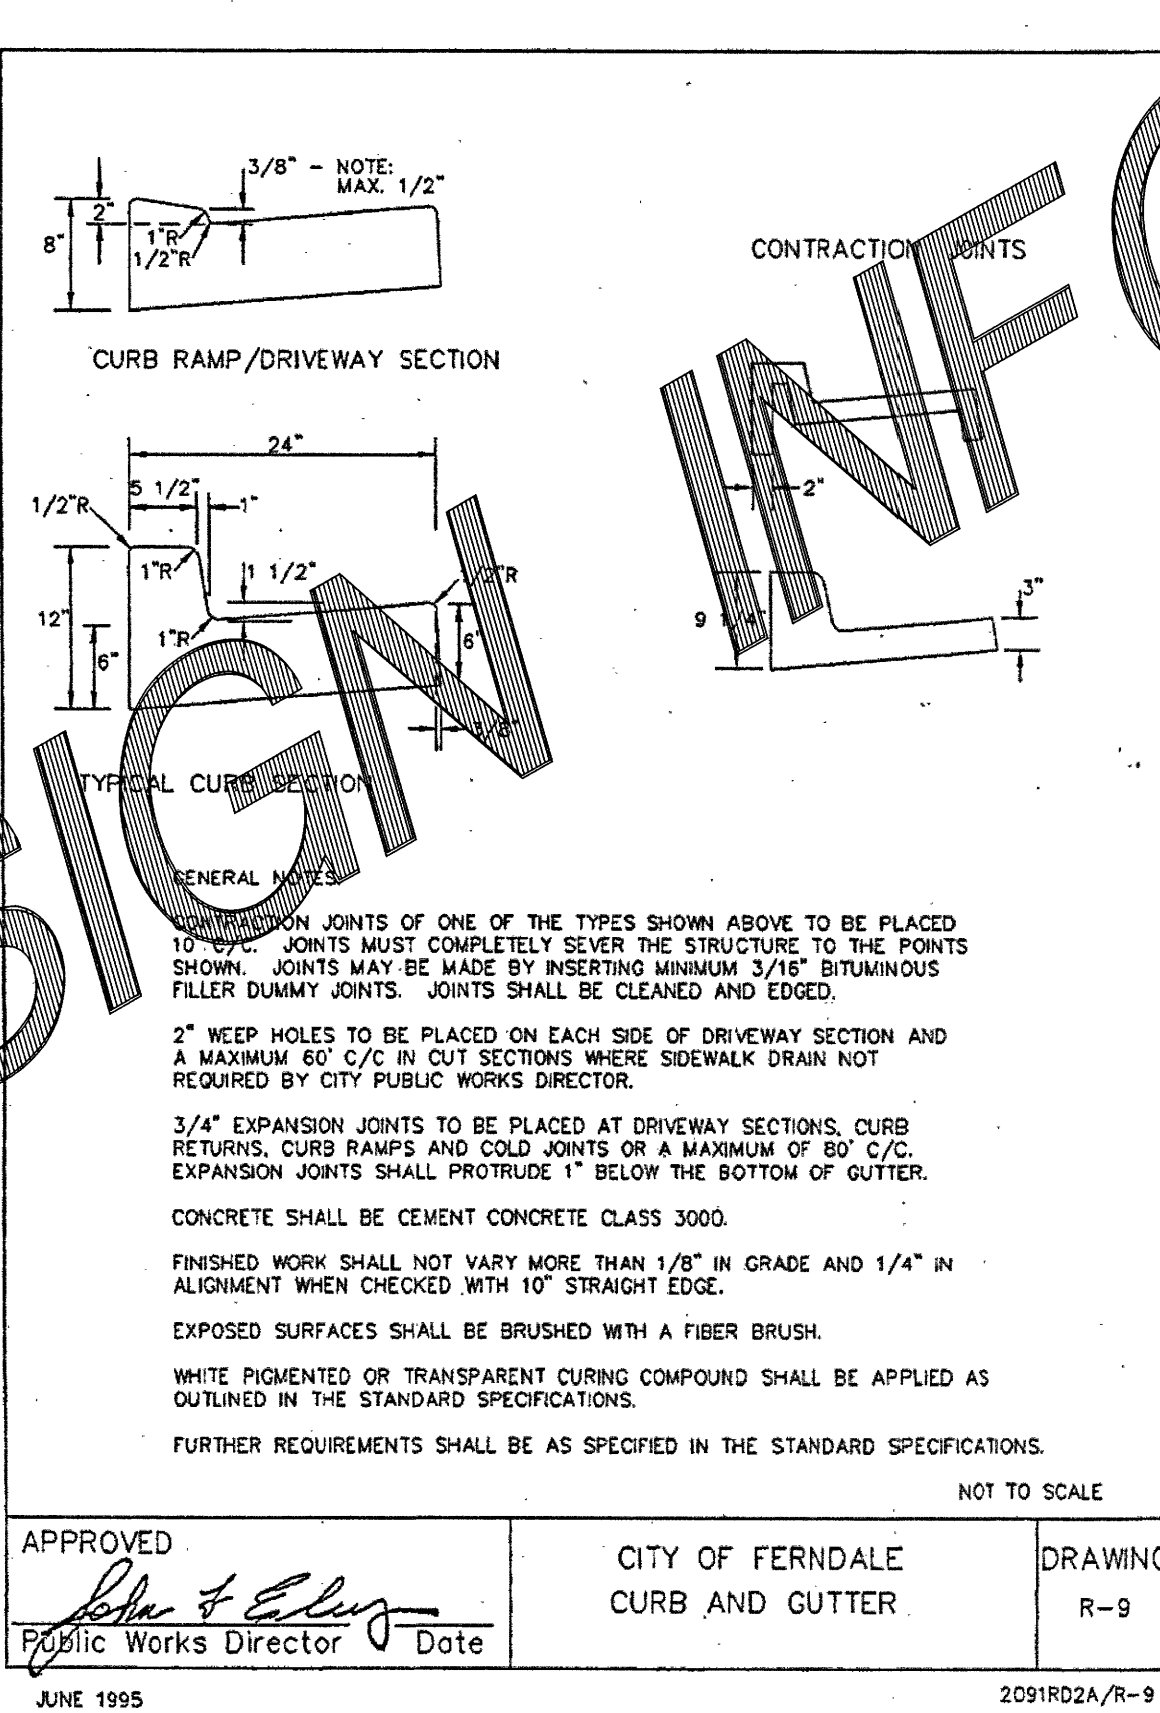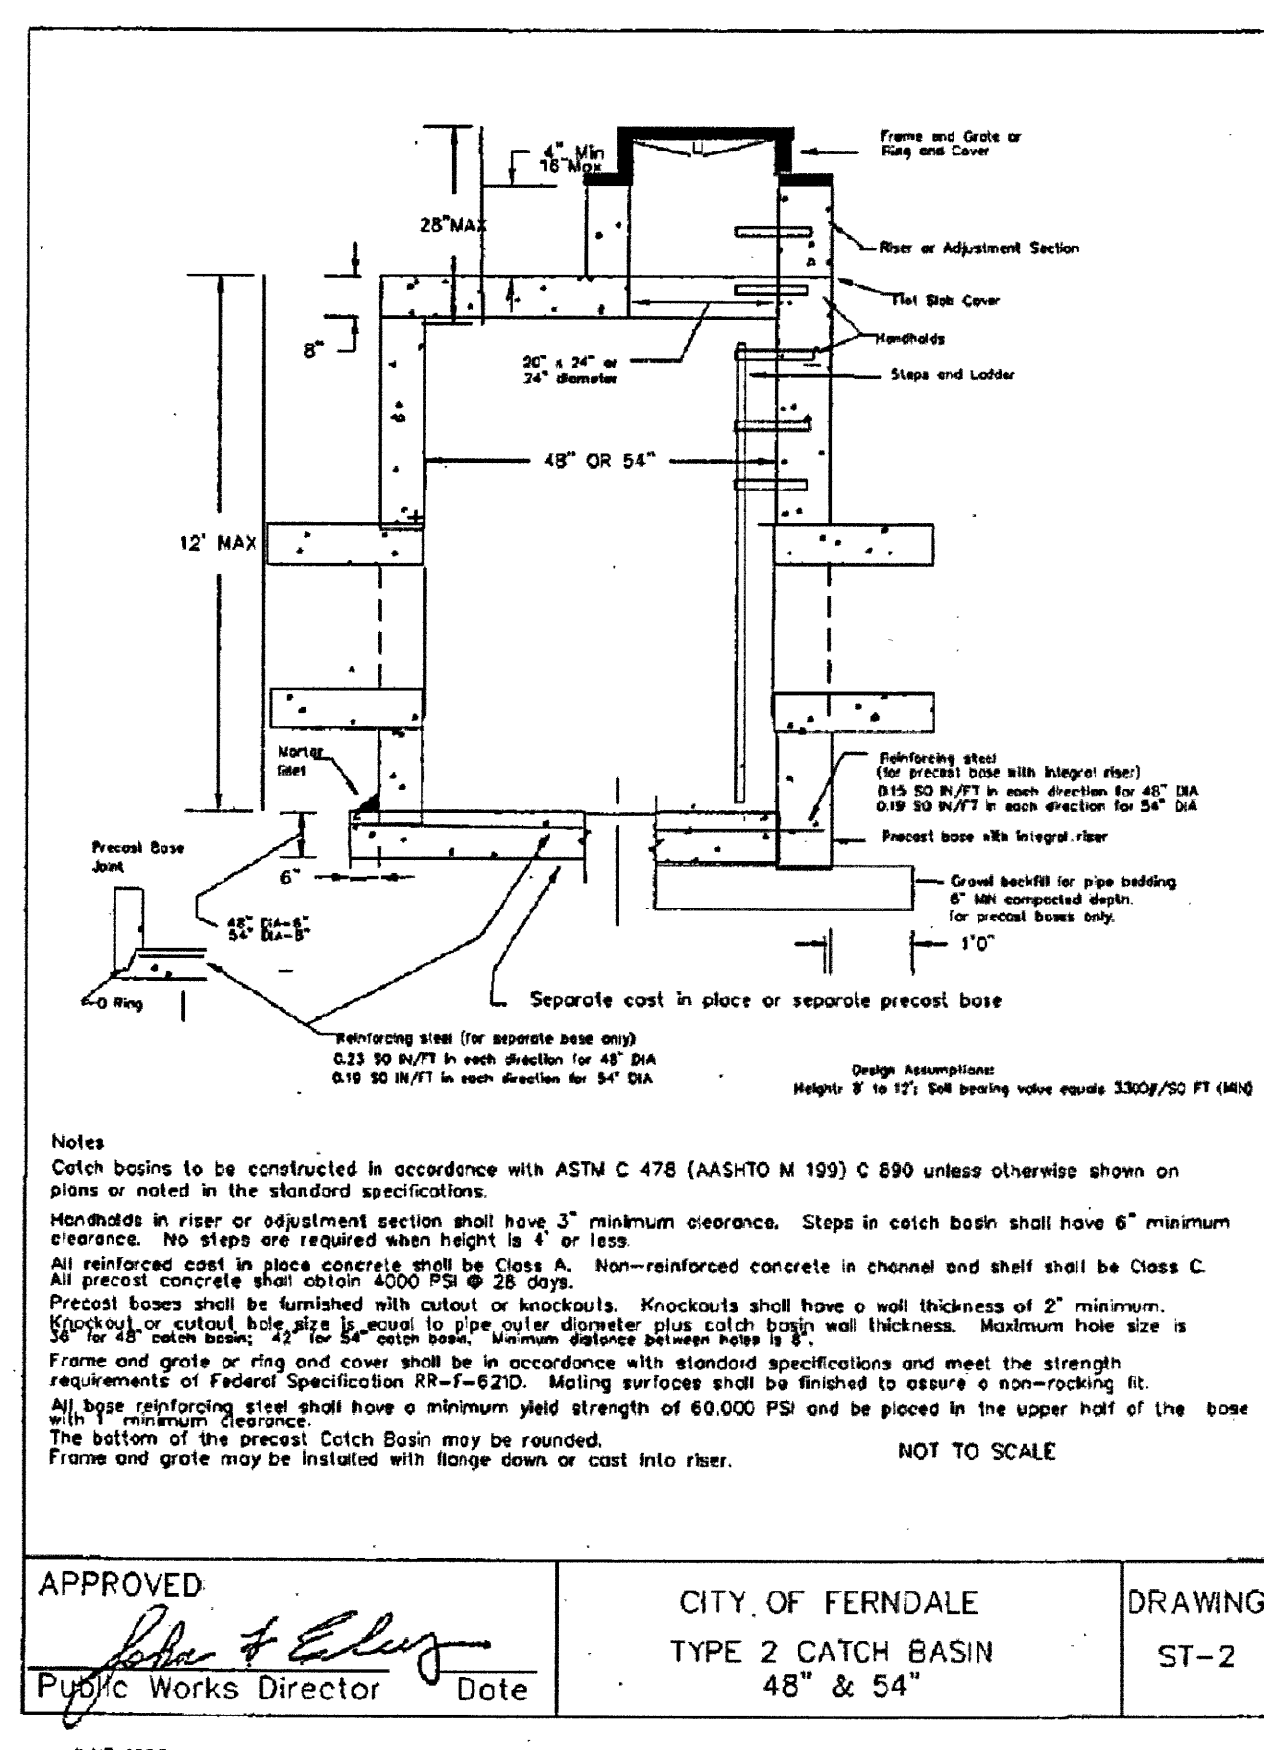












SHEET
13
OF
20

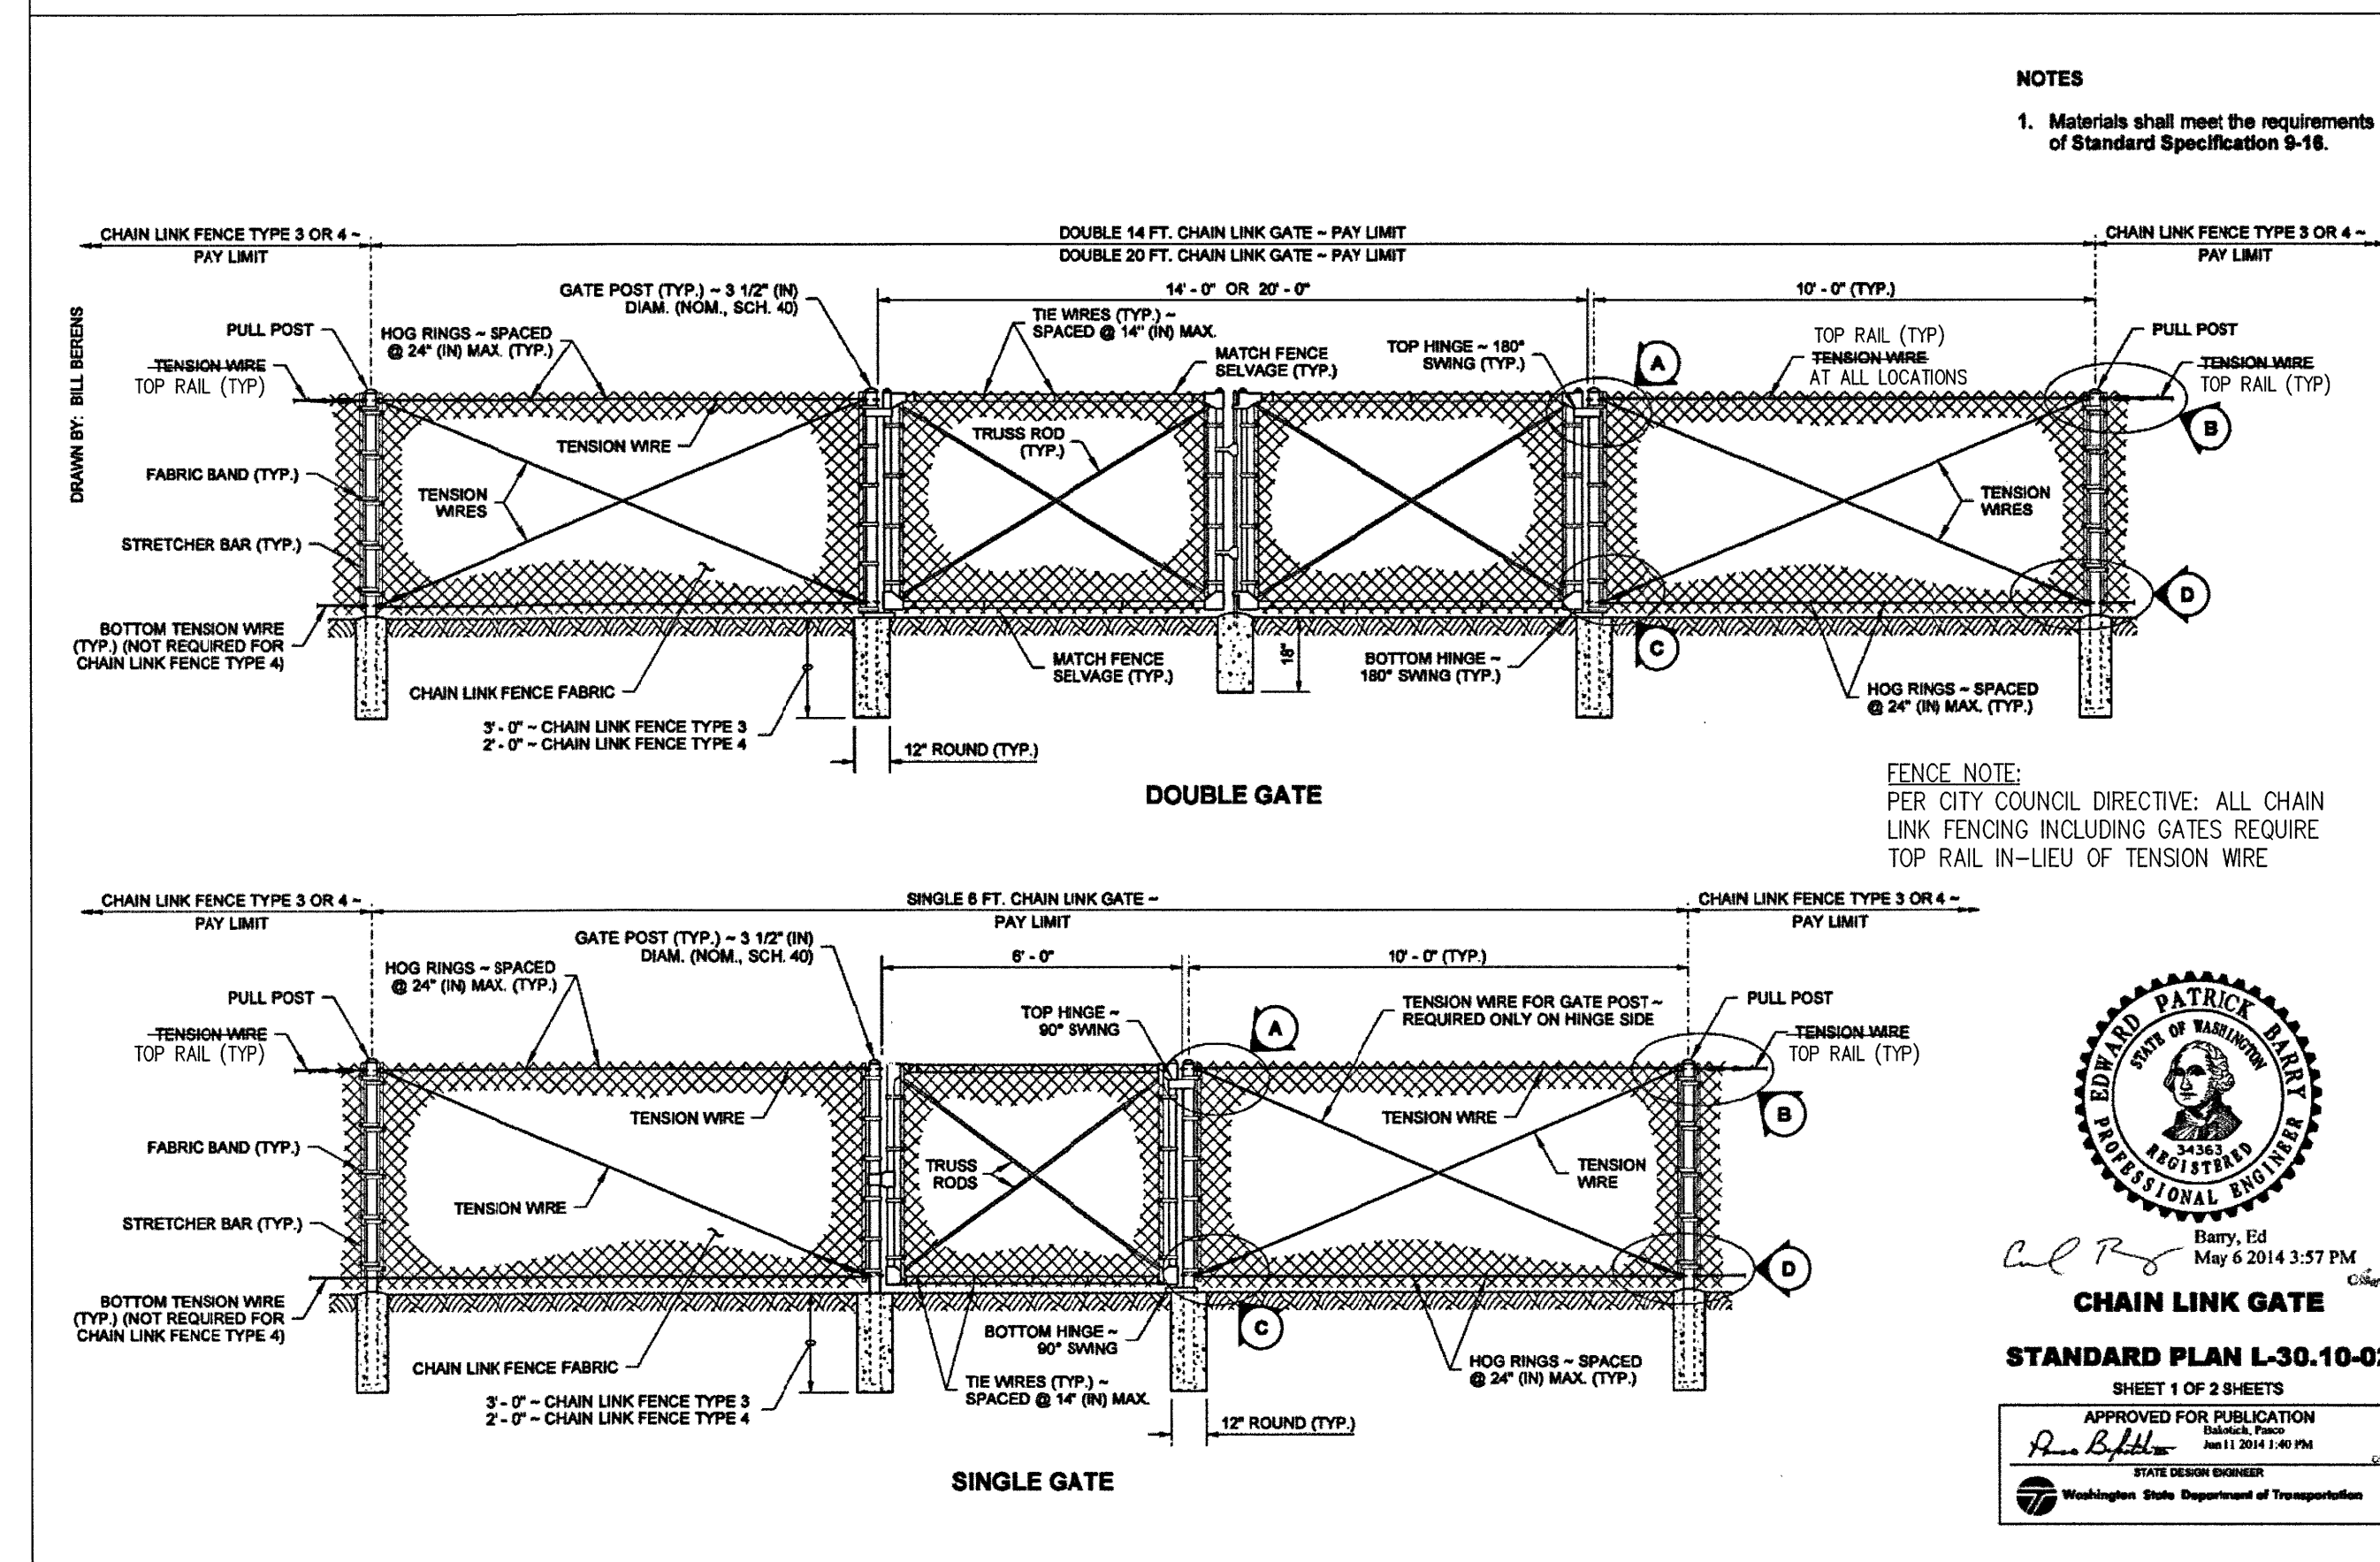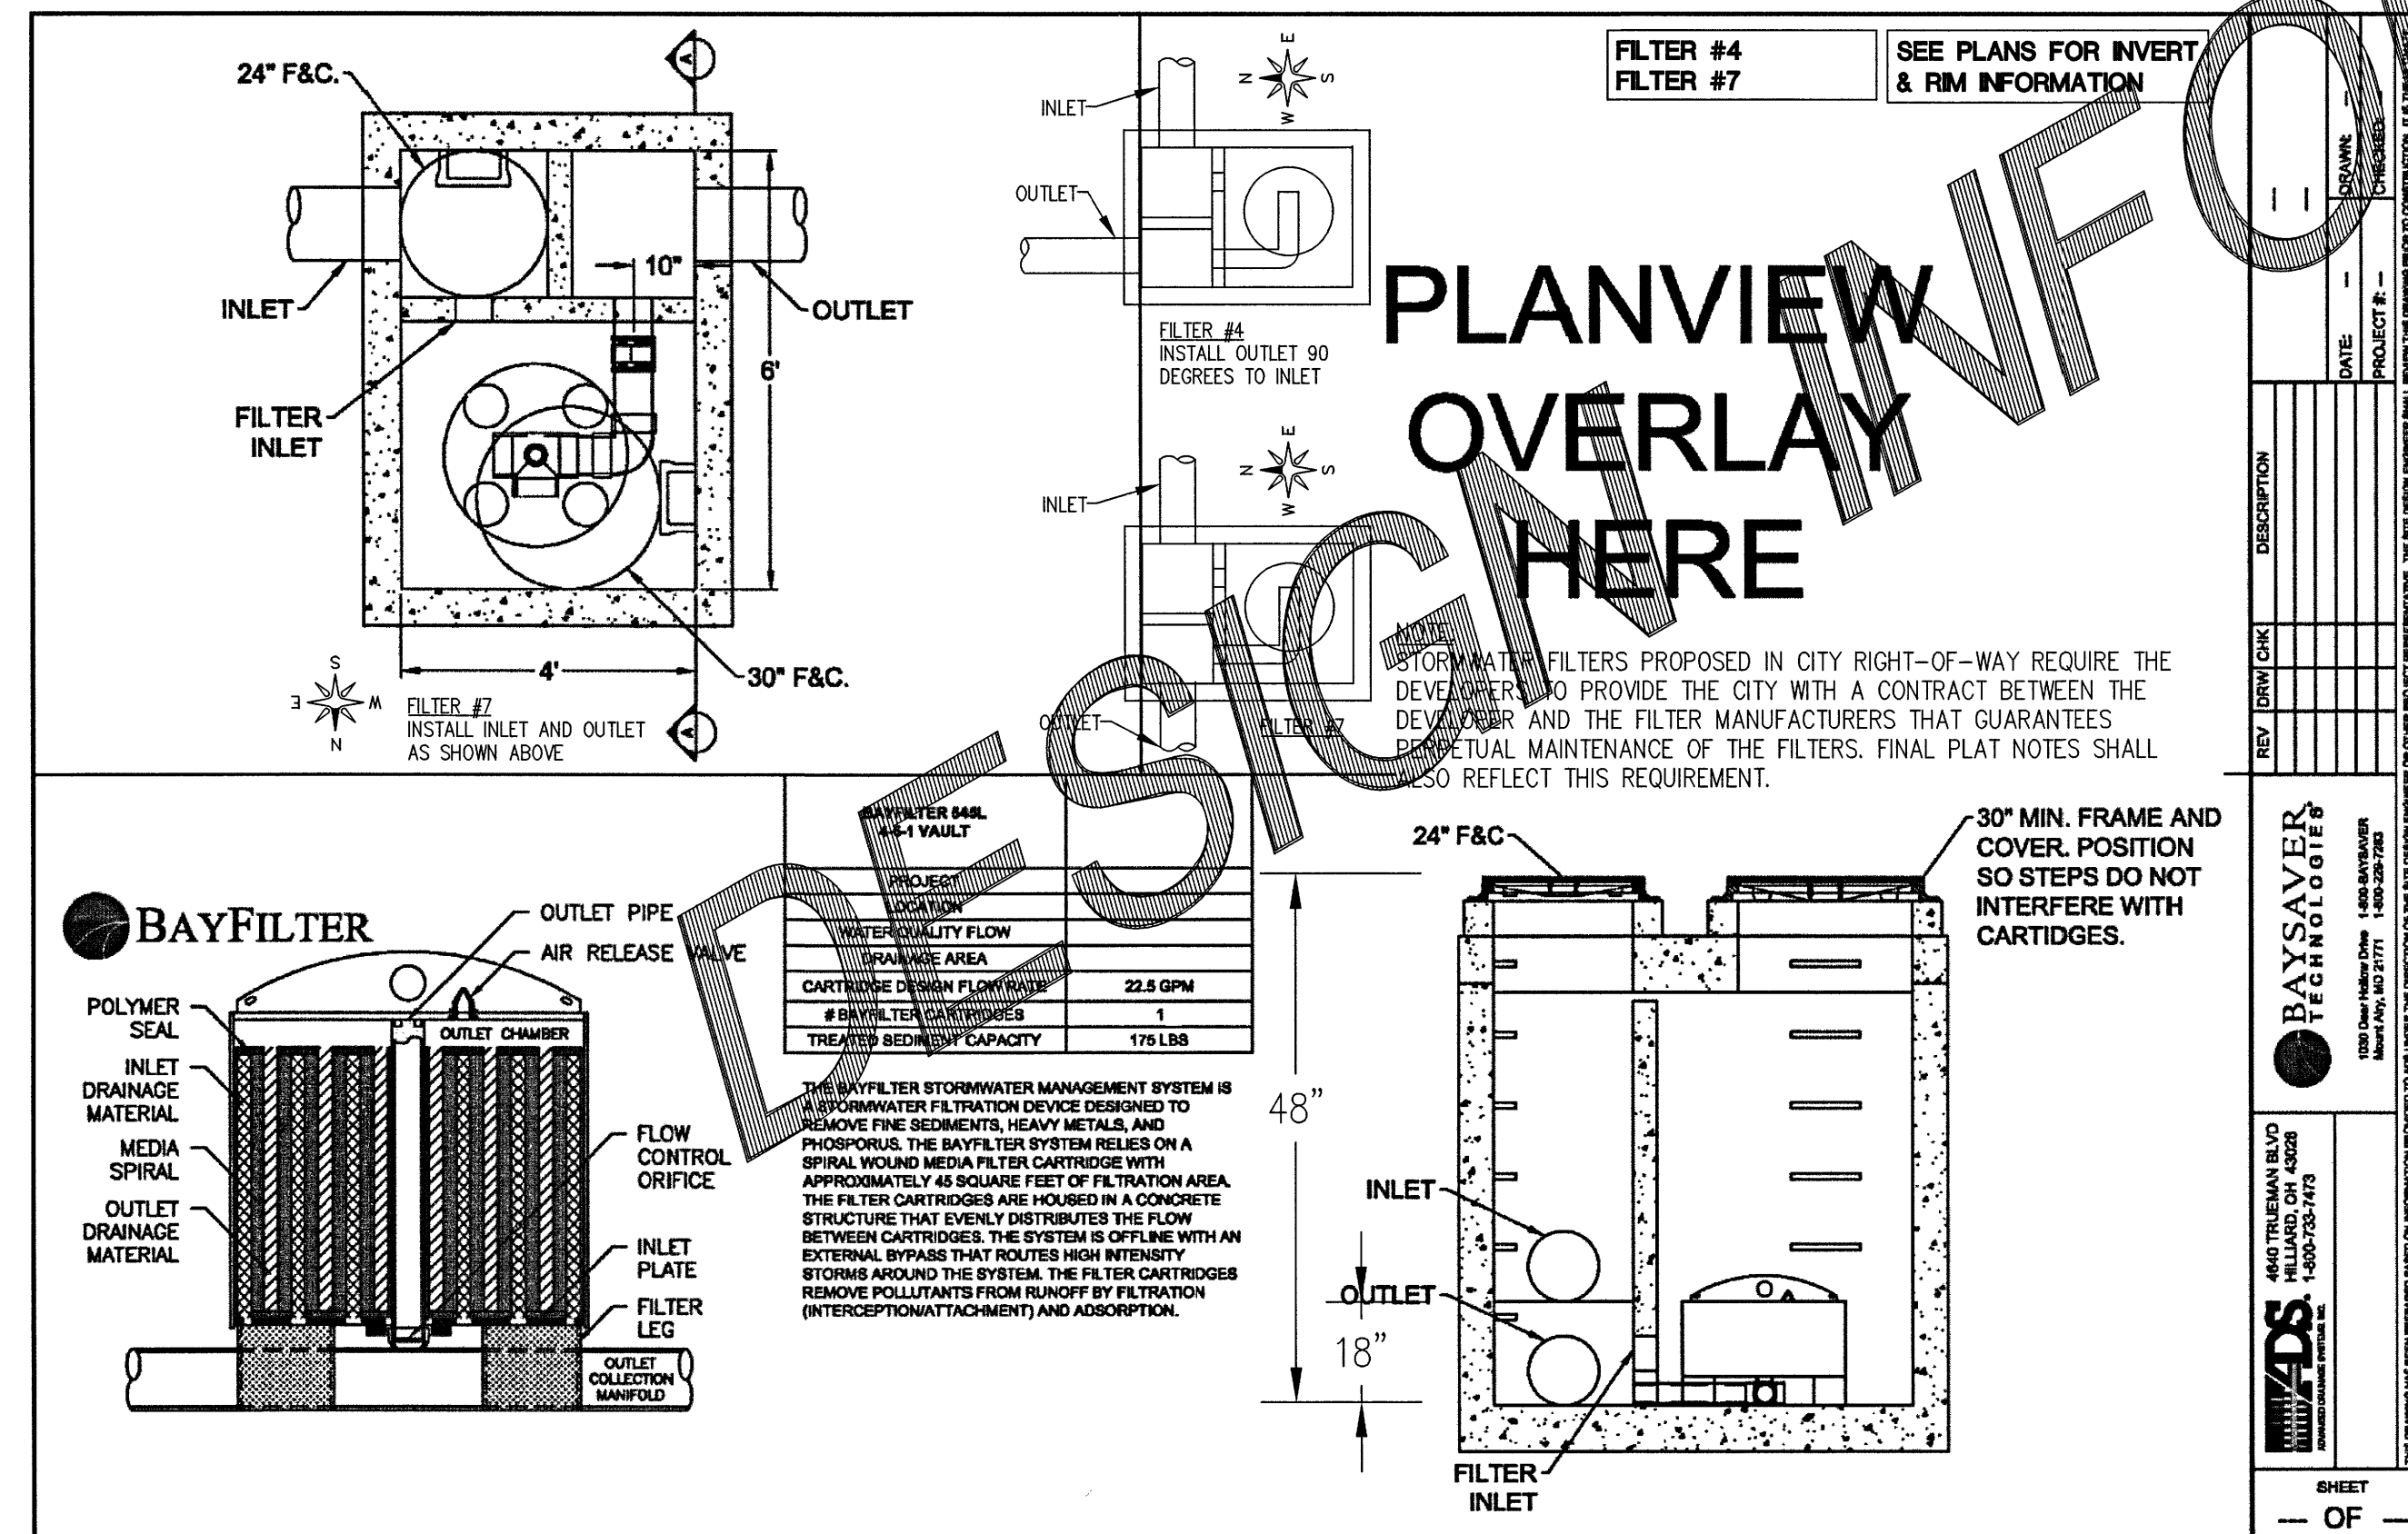








SHEET
14A
OF
20

\\SERVER\Share\Common\Land Projects\2016\1602-2312 MT VIEW - PNRD.dwg (1602-CIVIL-ASB.dwg PLOT DATE: 5/22/2019 2:40 PM


ONSITE ENTERLINE

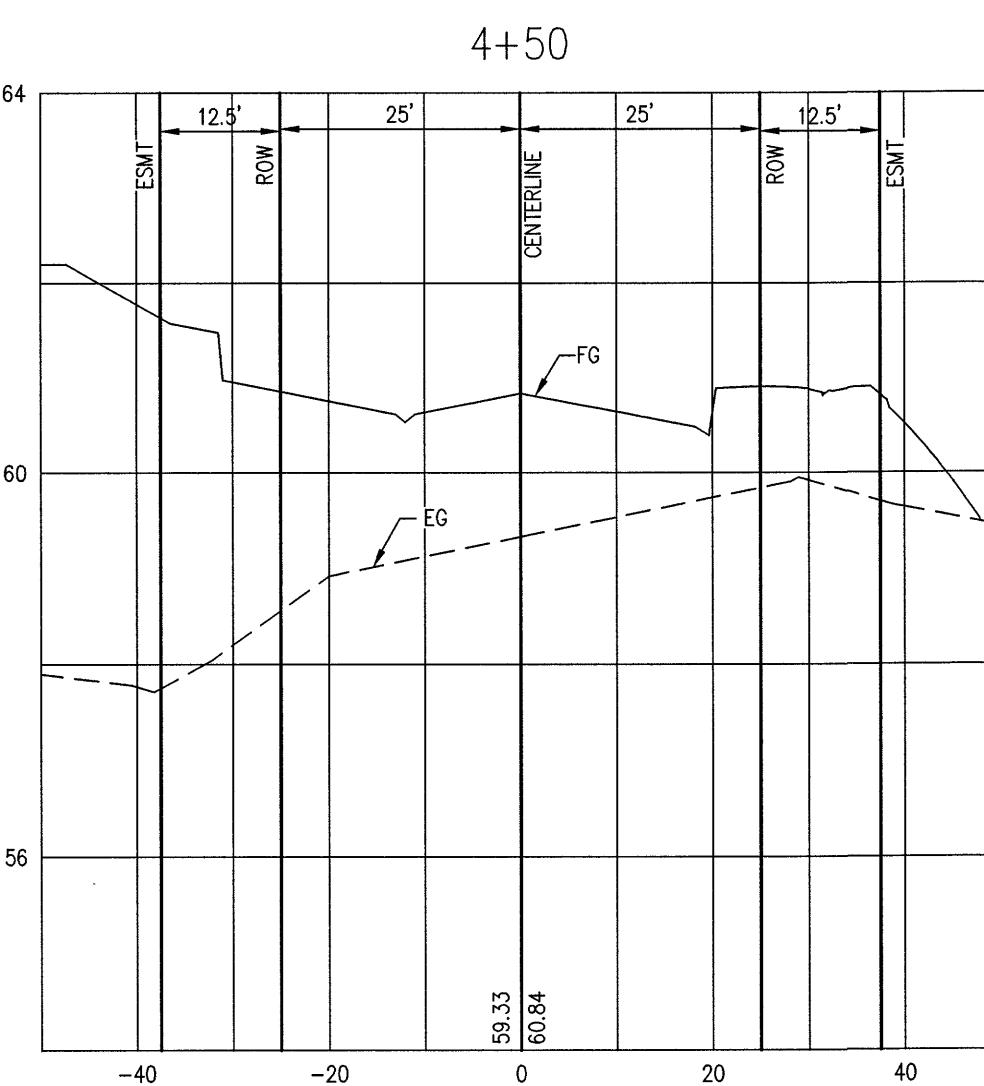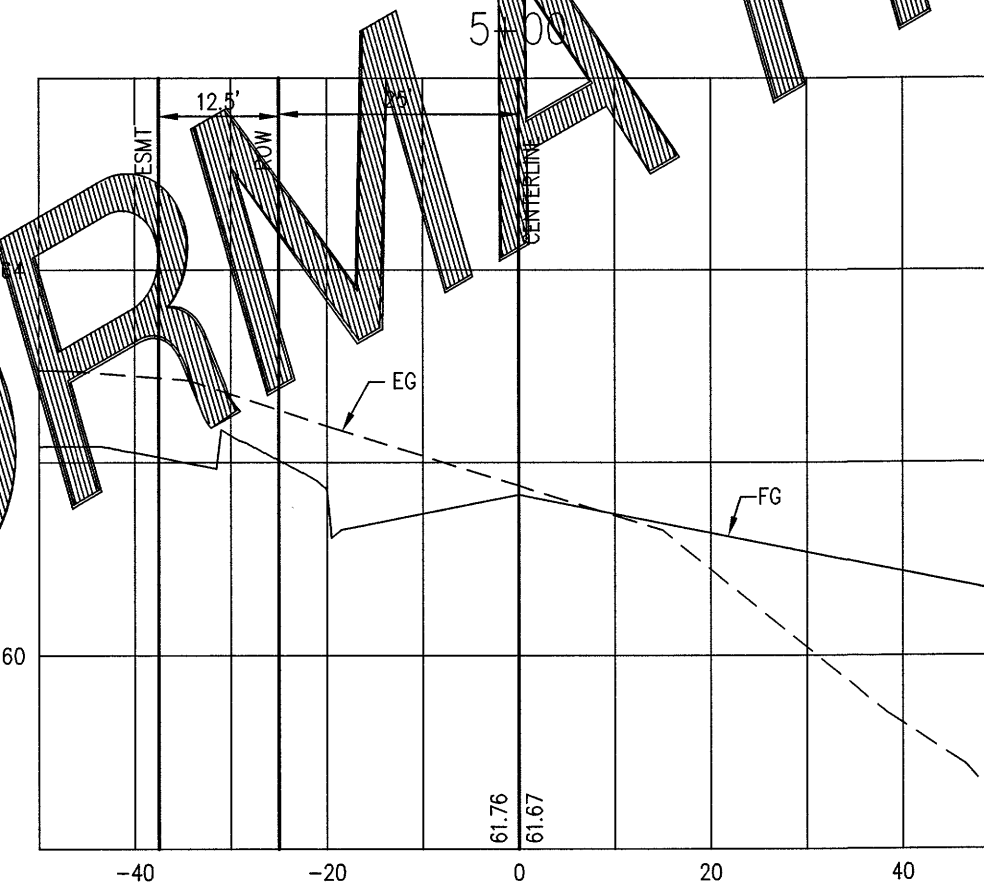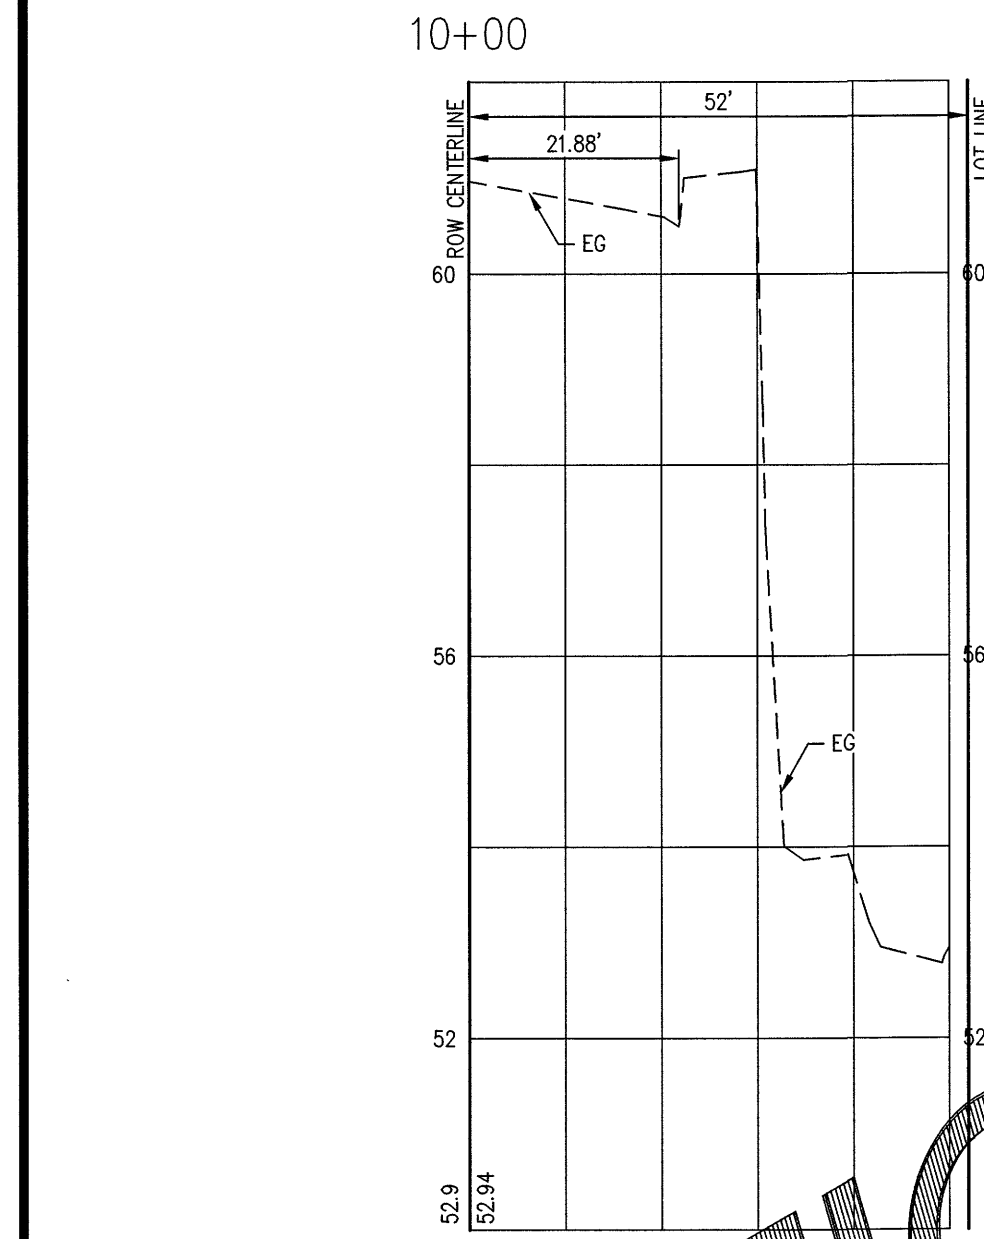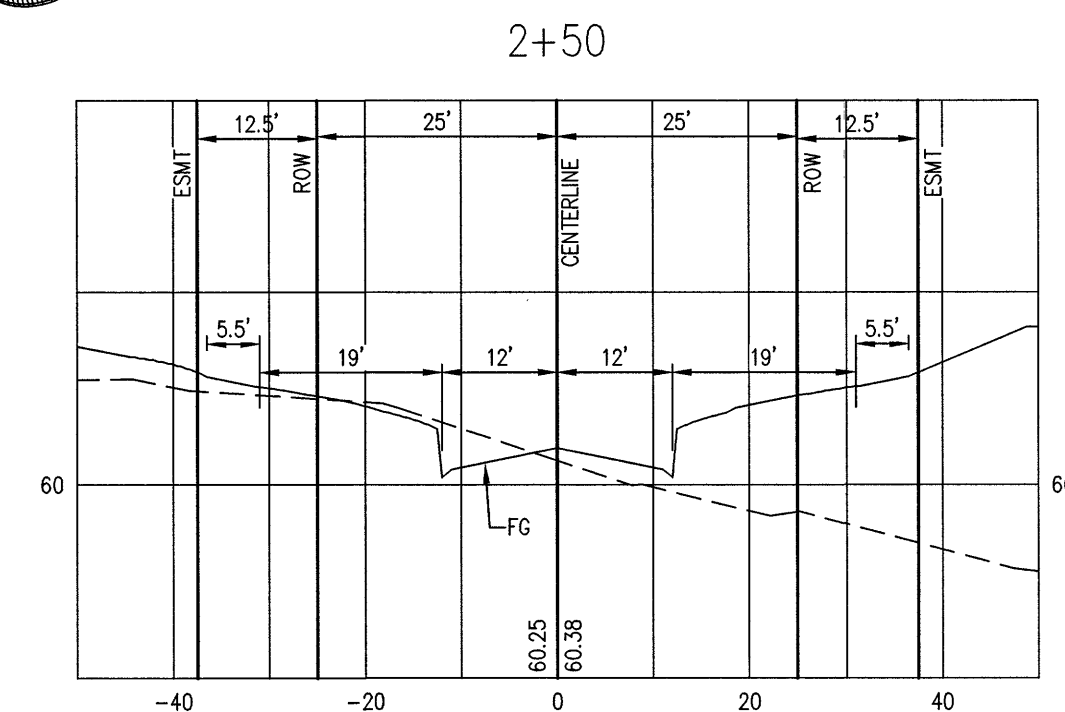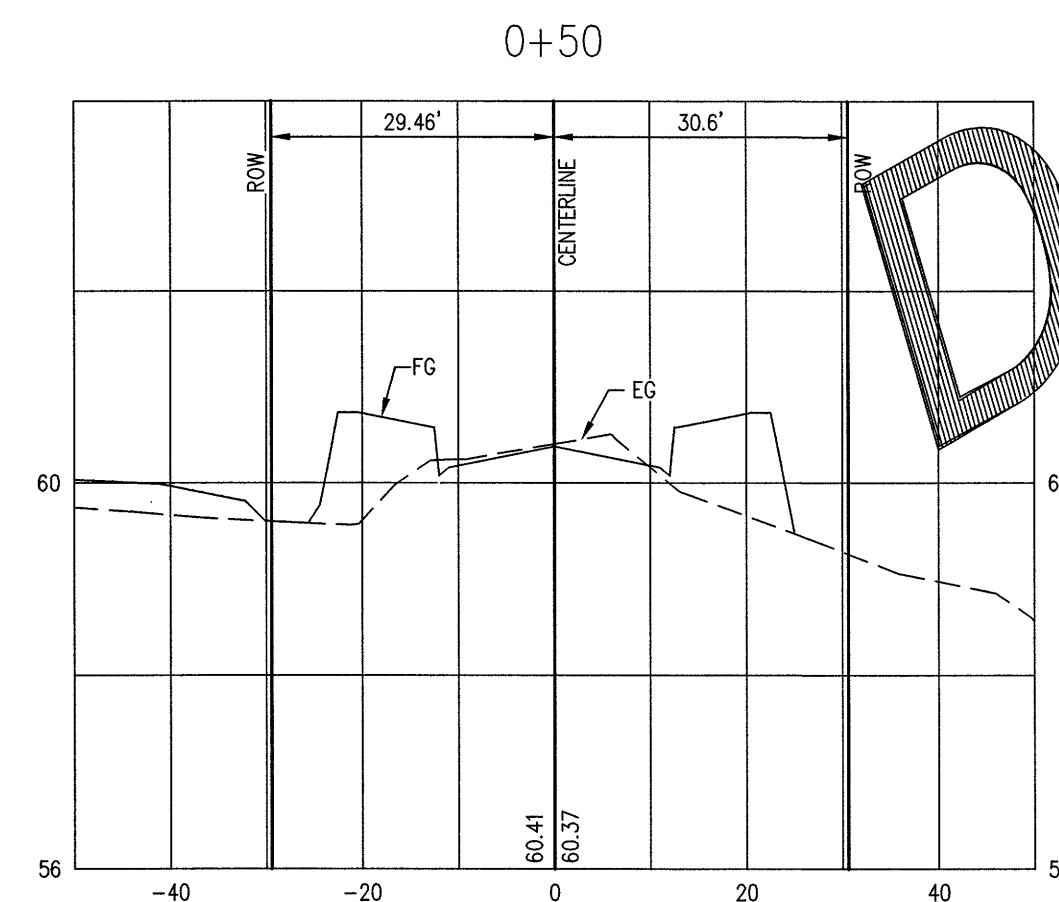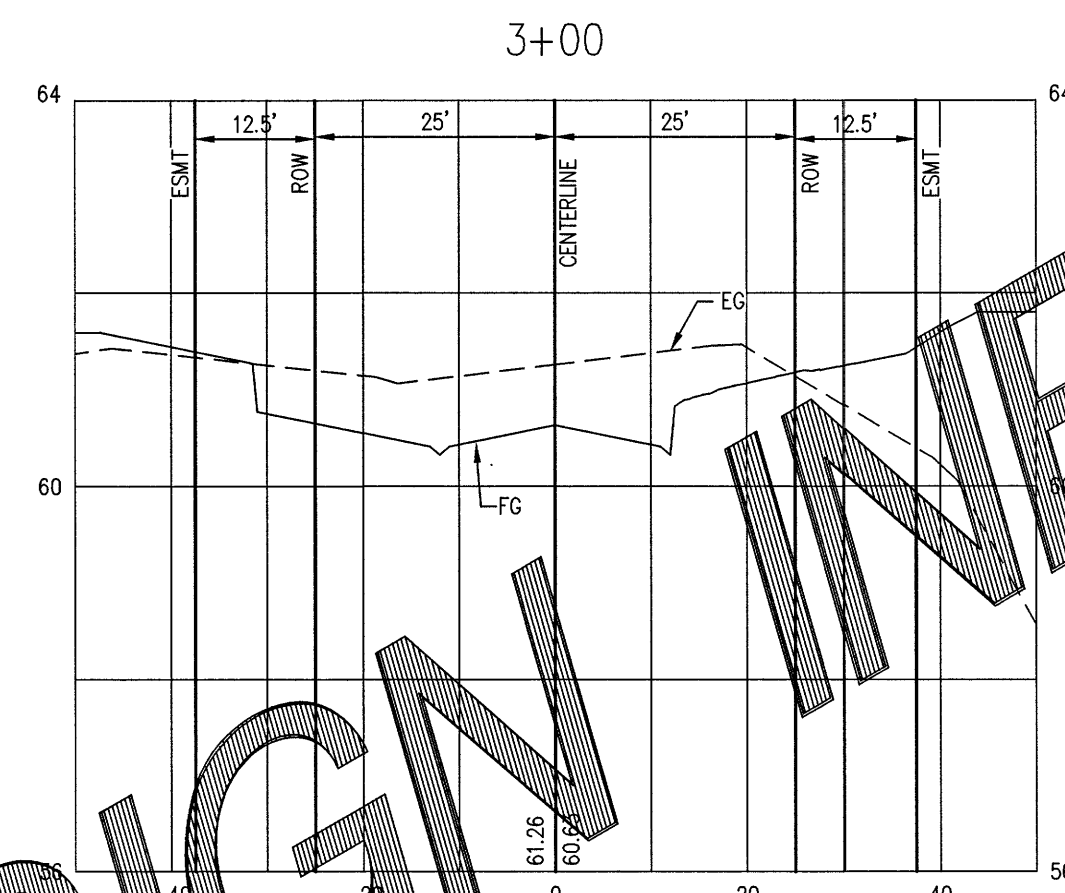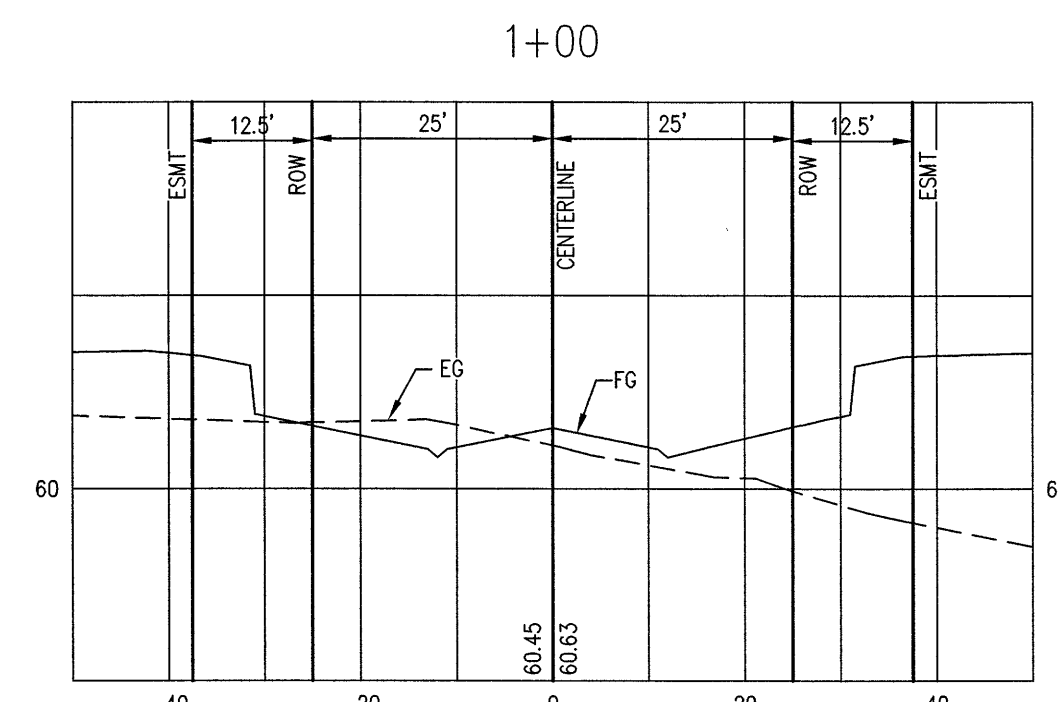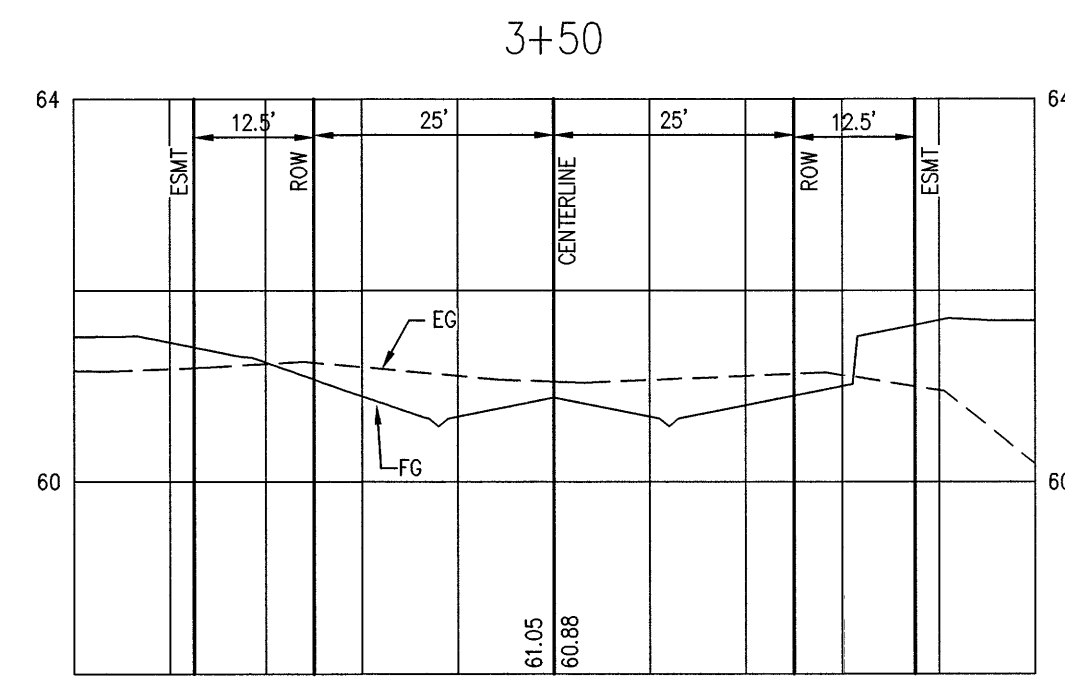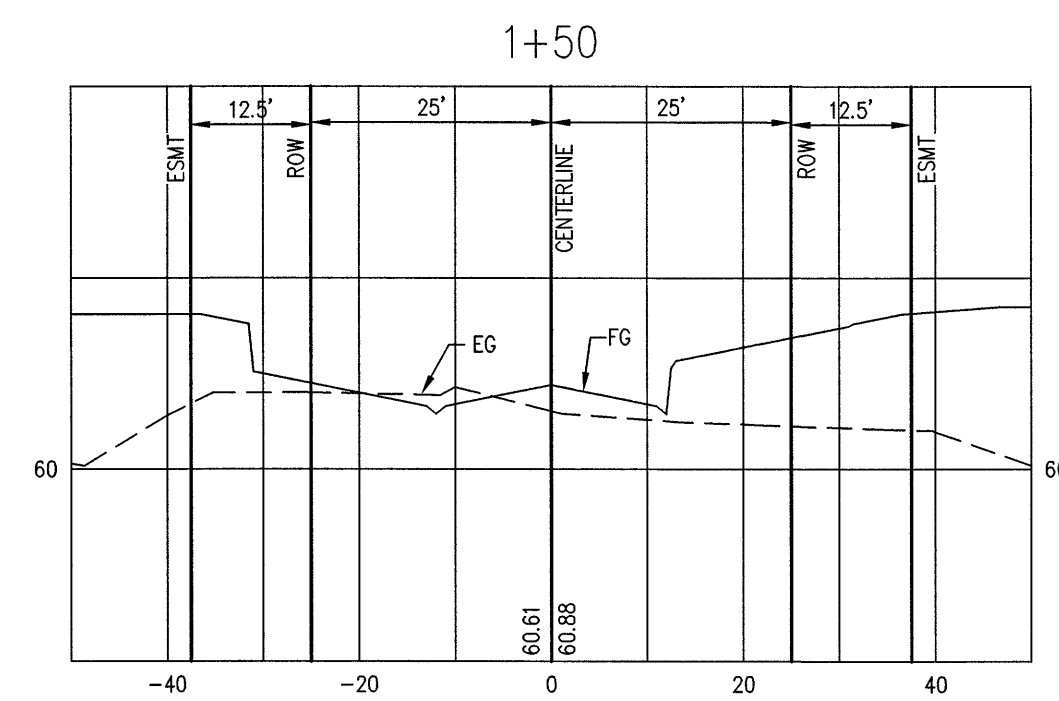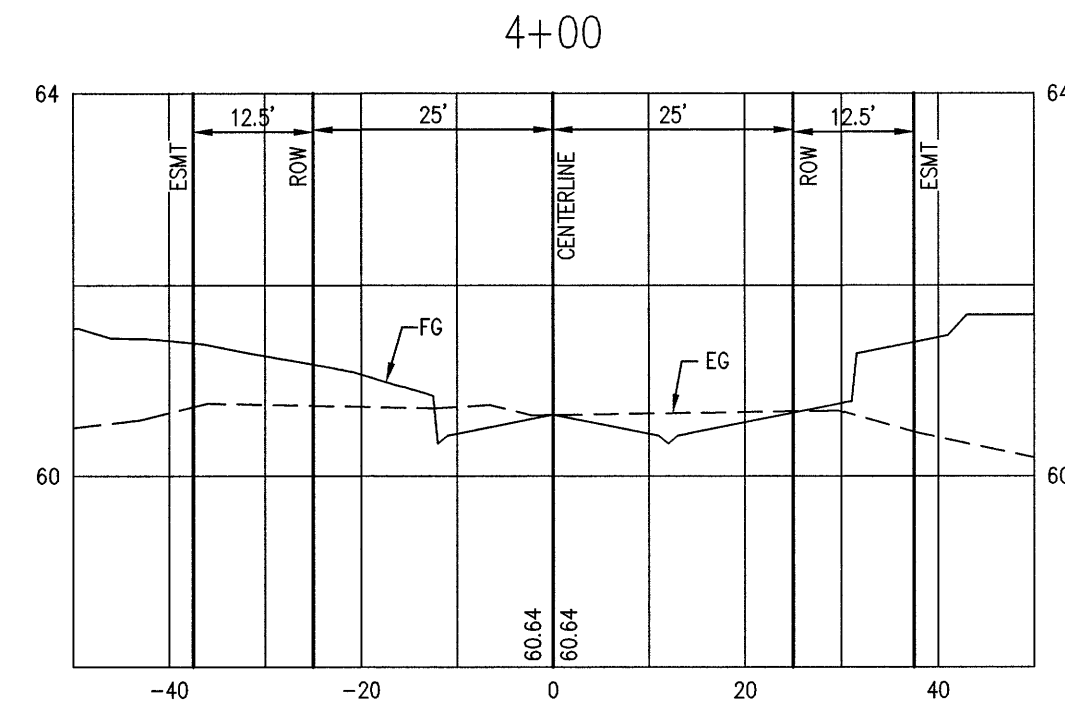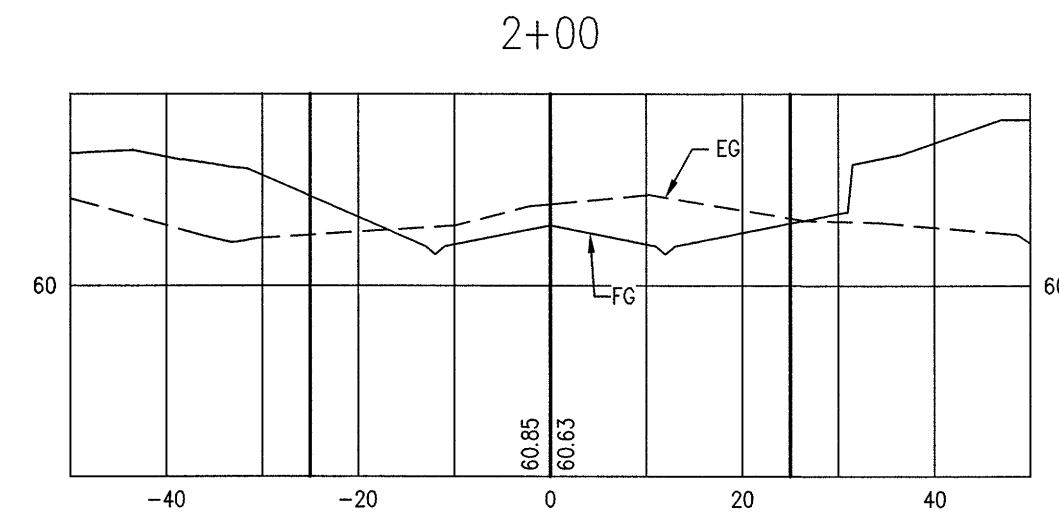

MAIN STREET

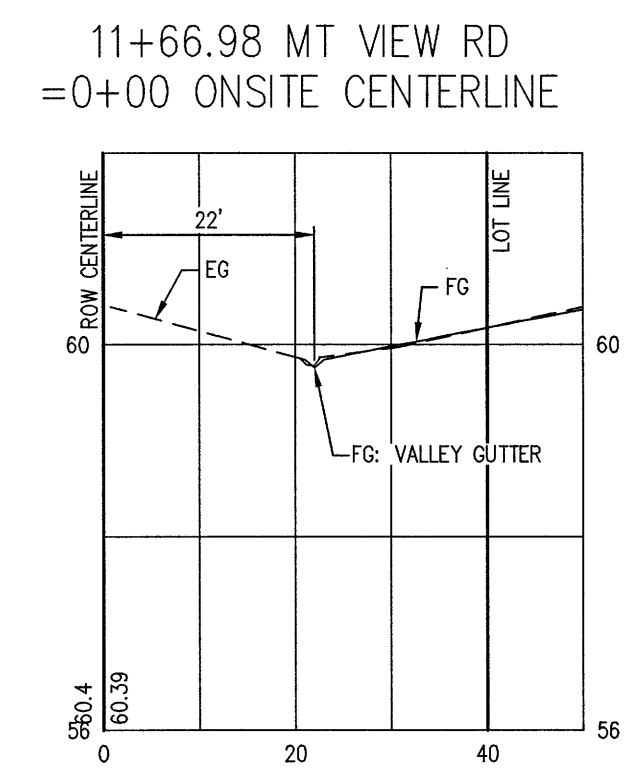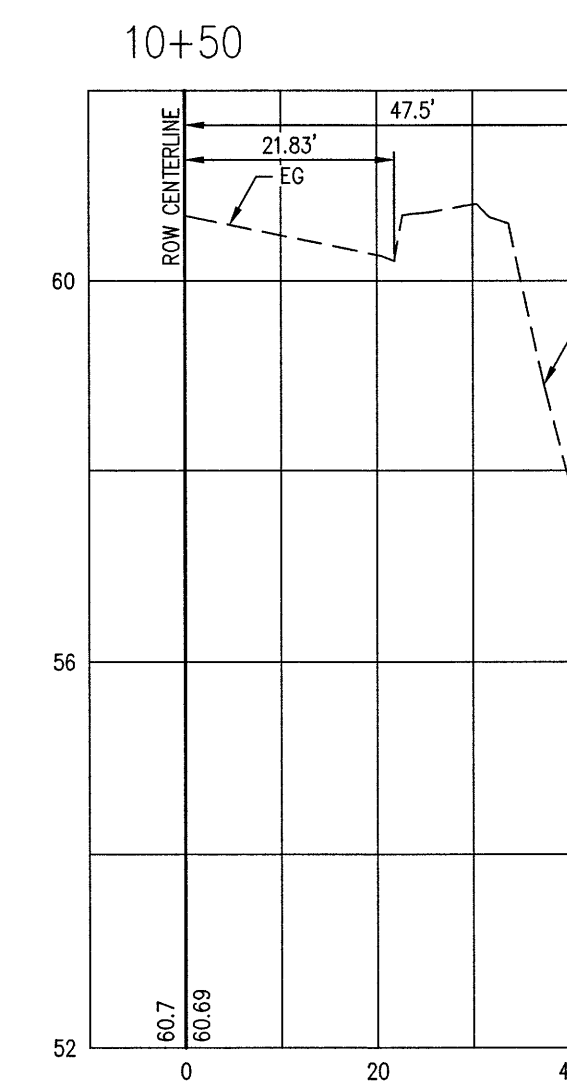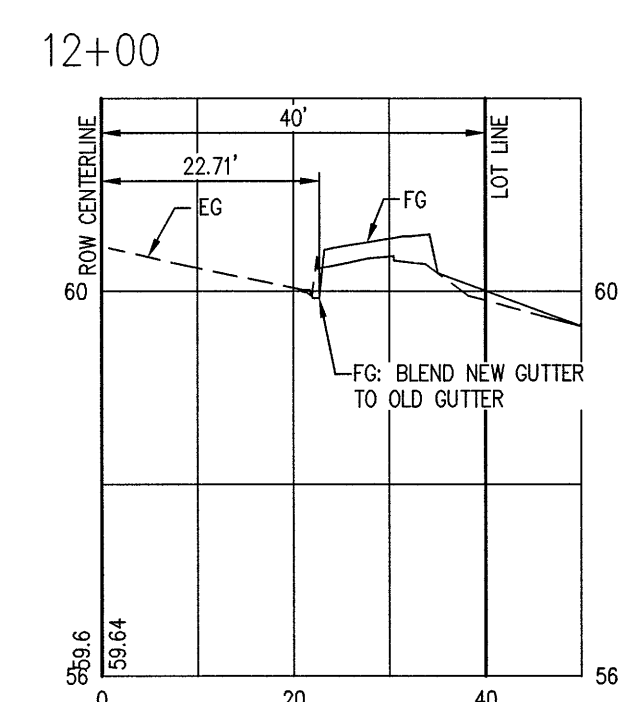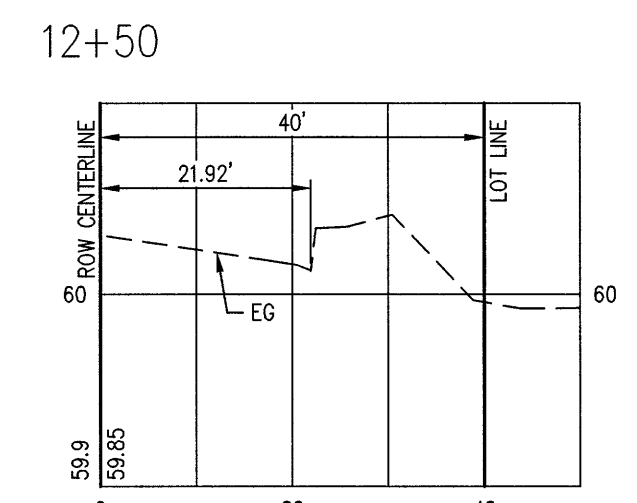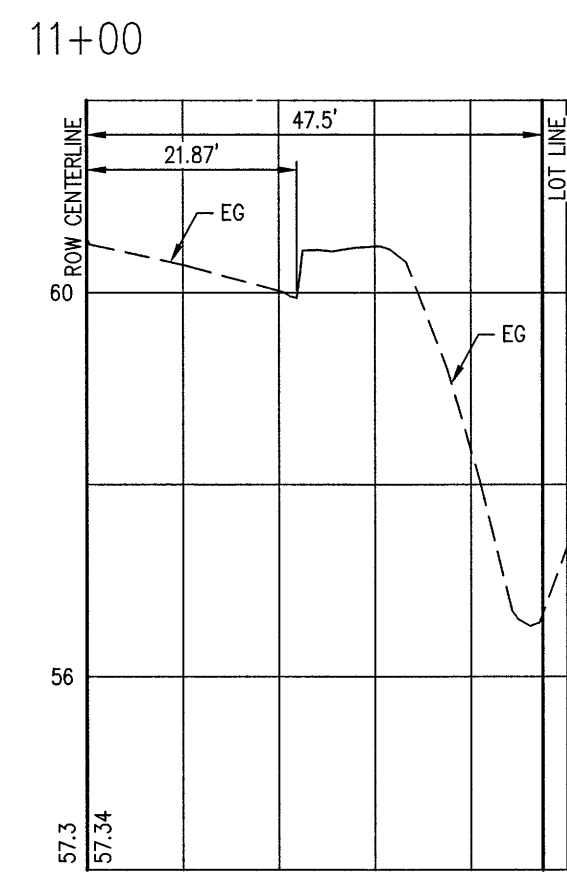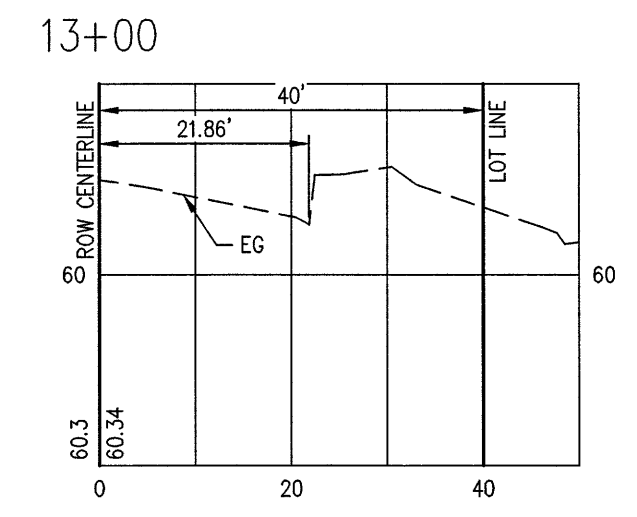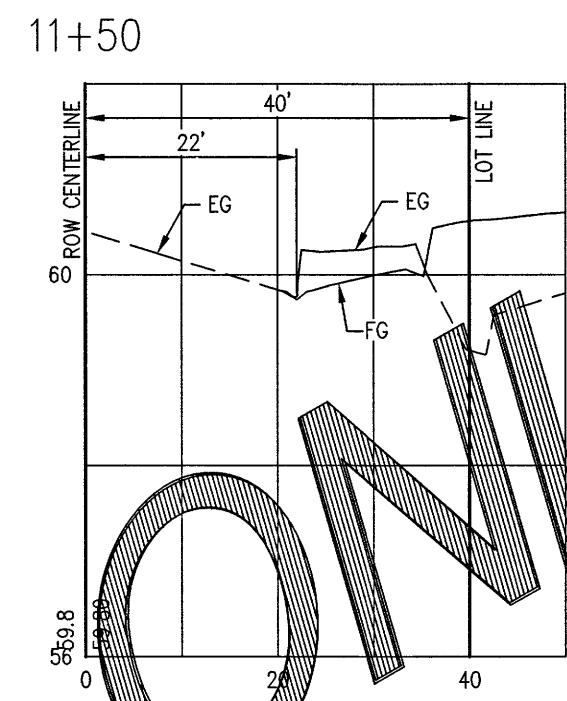

NO.	REVISION	BY	DATE	NO.	BY	DATE
1	SUBMITTAL 1	RL	04/23/19	1		
2				2		
3				3		
4				4		
5				5		

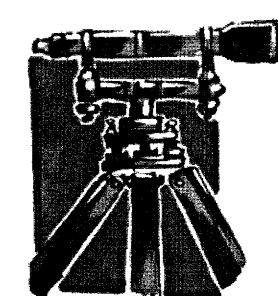

LDES, INC.
5160 INDUSTRIAL PL. #108
FERNDAL, WA 98248
PHONE 360-383-0620
FAX 360-383-0639

JOB NO.:	1602
DWG. NAME:	1602-CIVIL-ASB.dwg
DESIGNED BY:	RL
DRAWN BY:	EH
CHECKED BY:	RL

PNRD
PO BOX 3249
FERNDAL, WA 98248

APPROVED
JUN 13 2019









BY
CITY OF FERNDAL
PUBLIC WORKS DEPARTMENT

CROSS-SECTIONS

MAIN STREET VILLAGE
2312 MAIN STREET, FERNDAL, WA
A PORTION OF SECTION 30, TOWNSHIP 39N, RANGE 2E, WM.


SHEET
15
OF
20

RECORD DRAWING

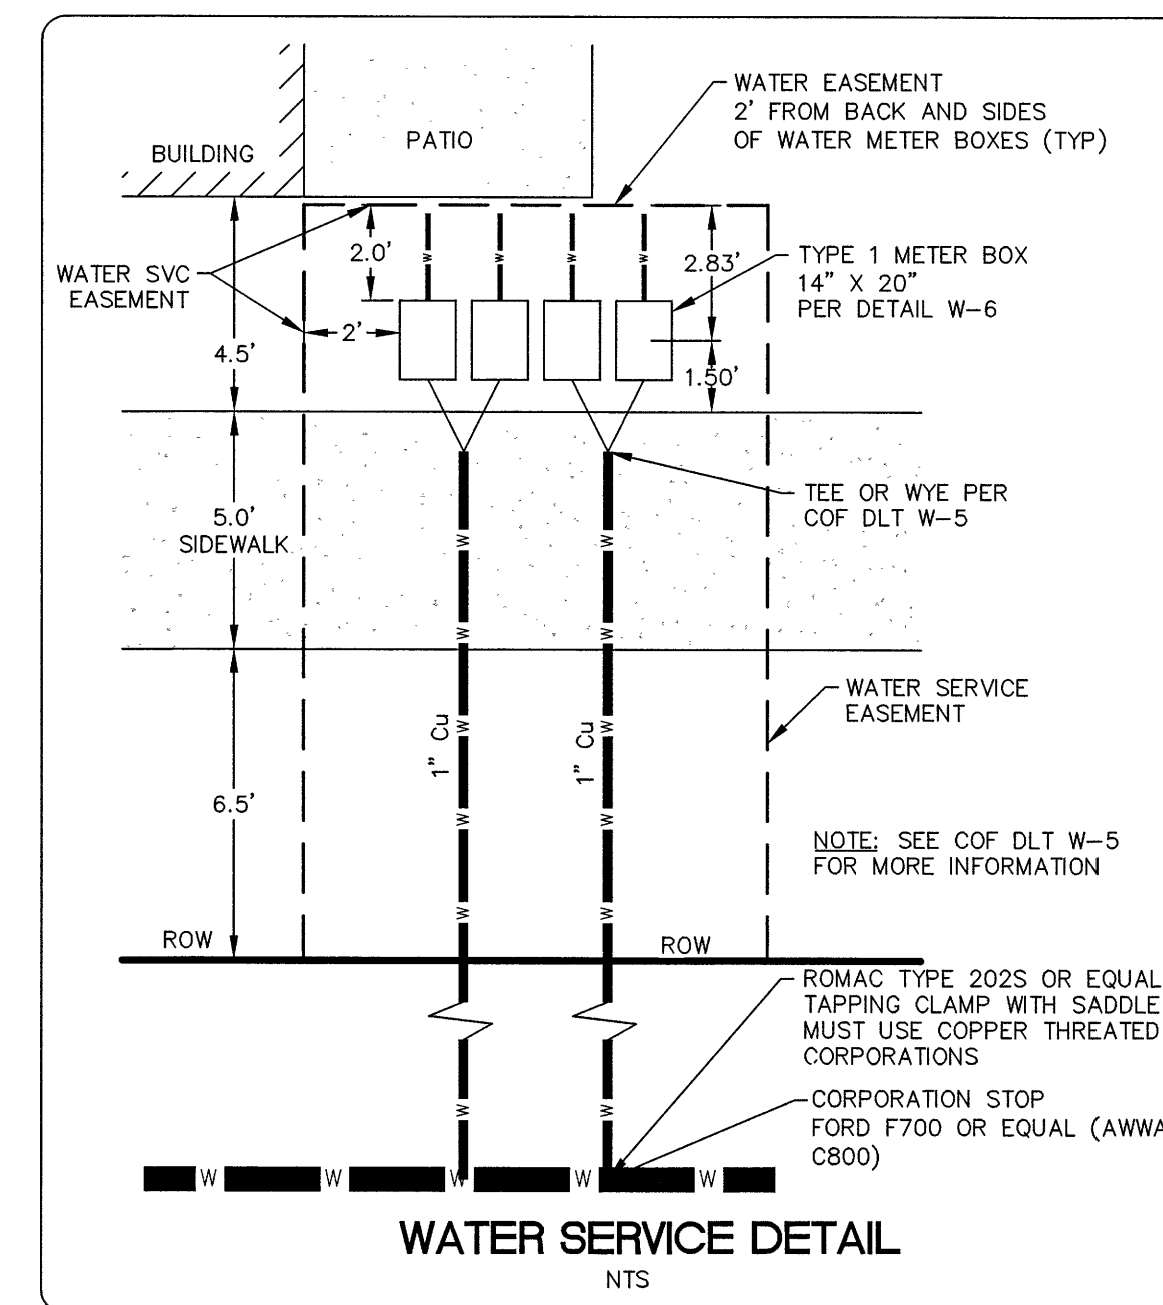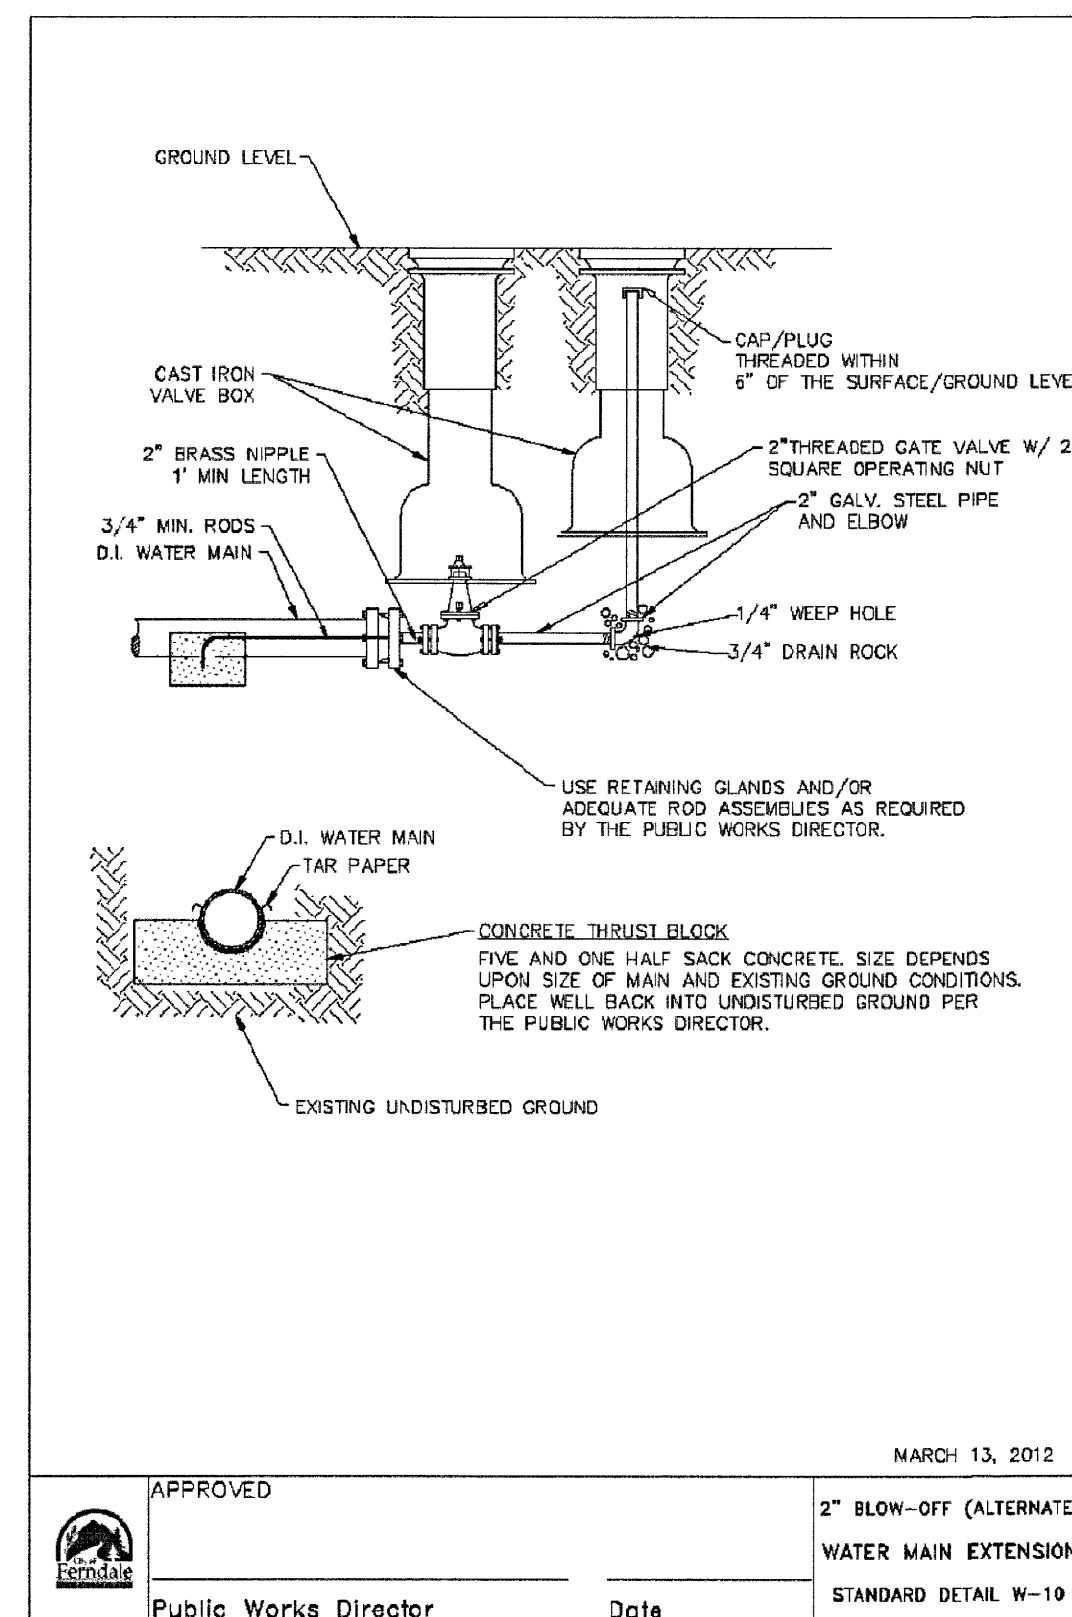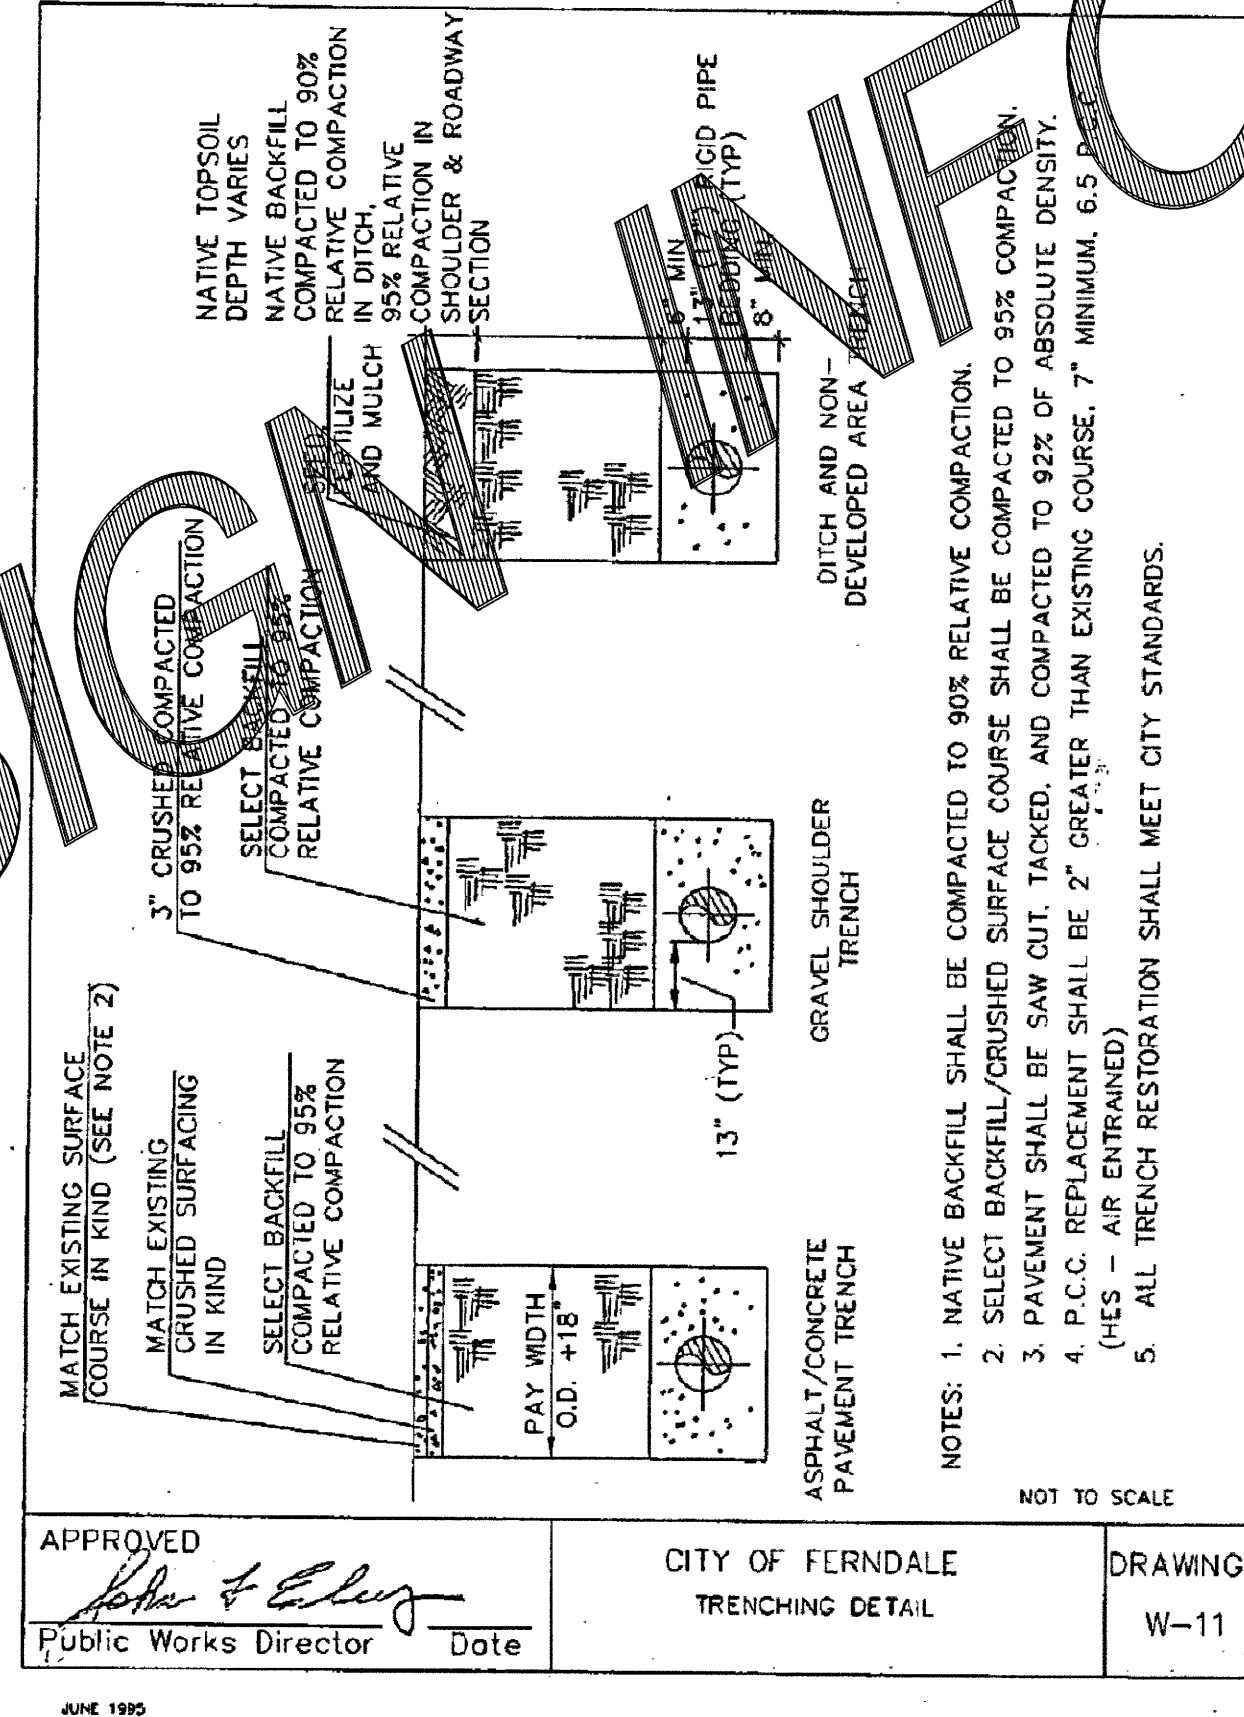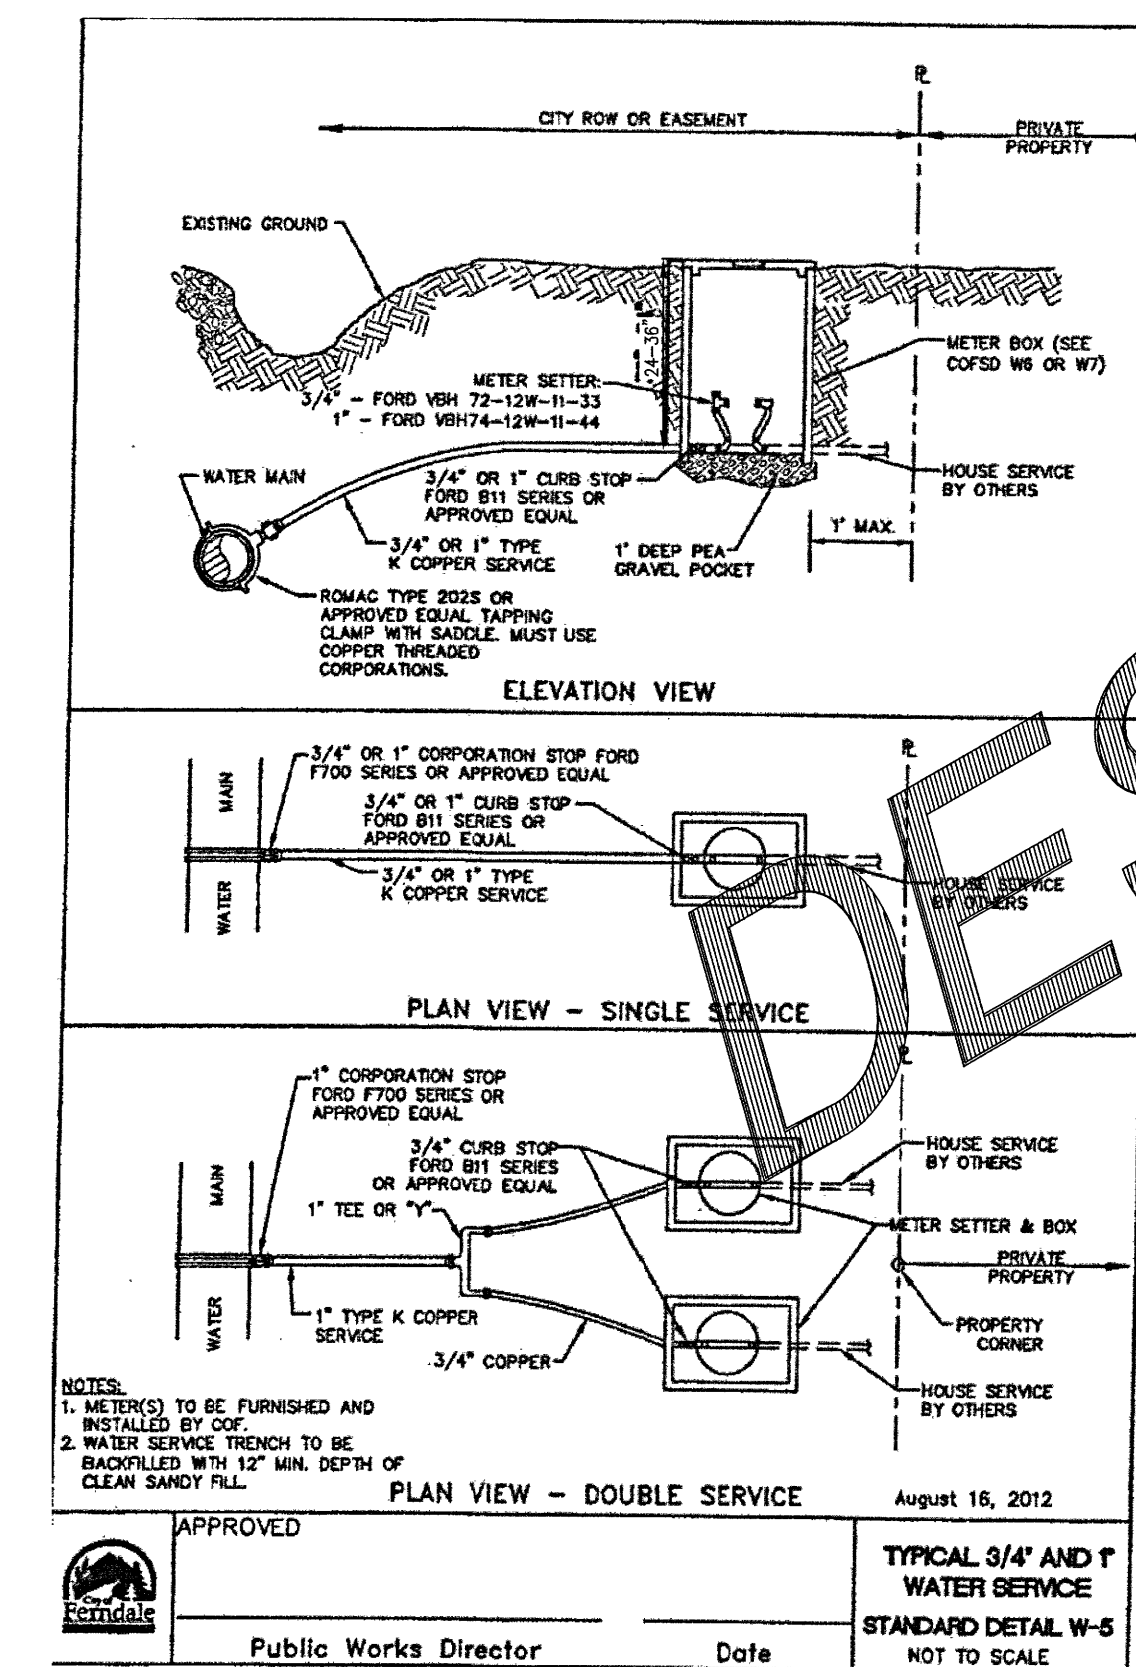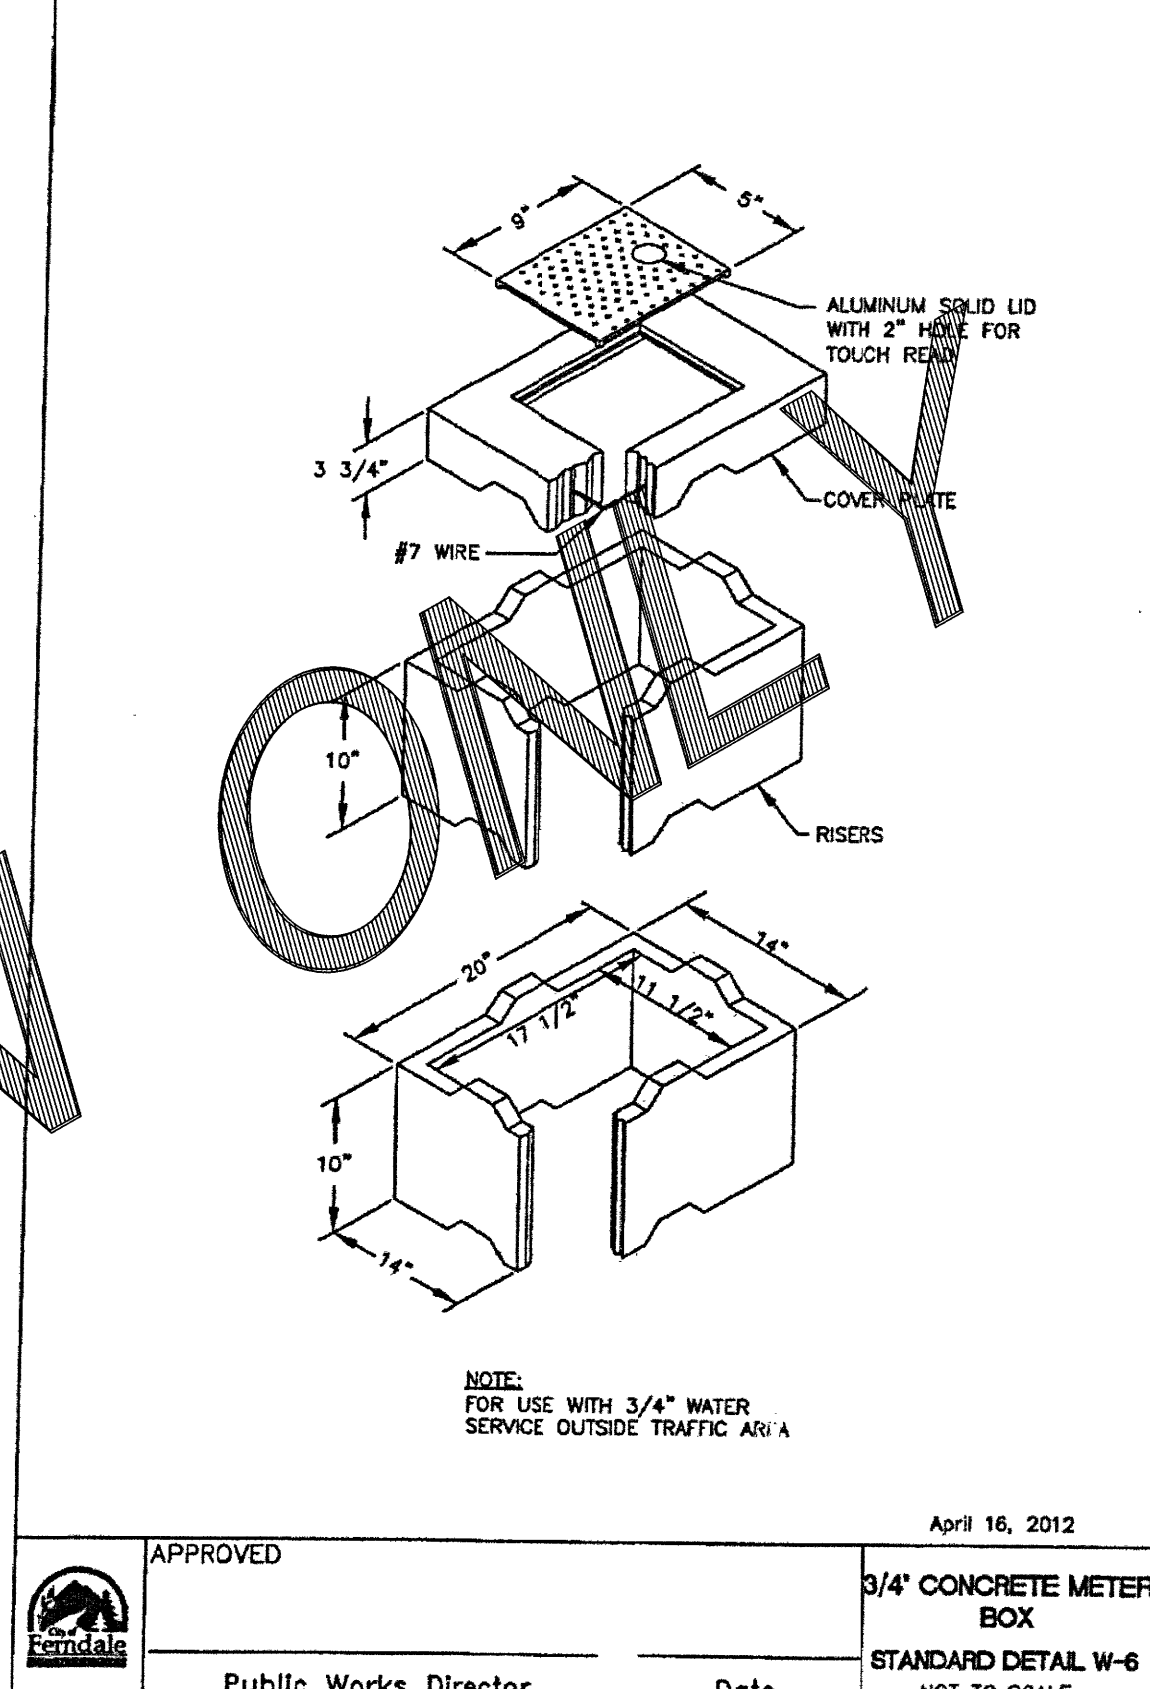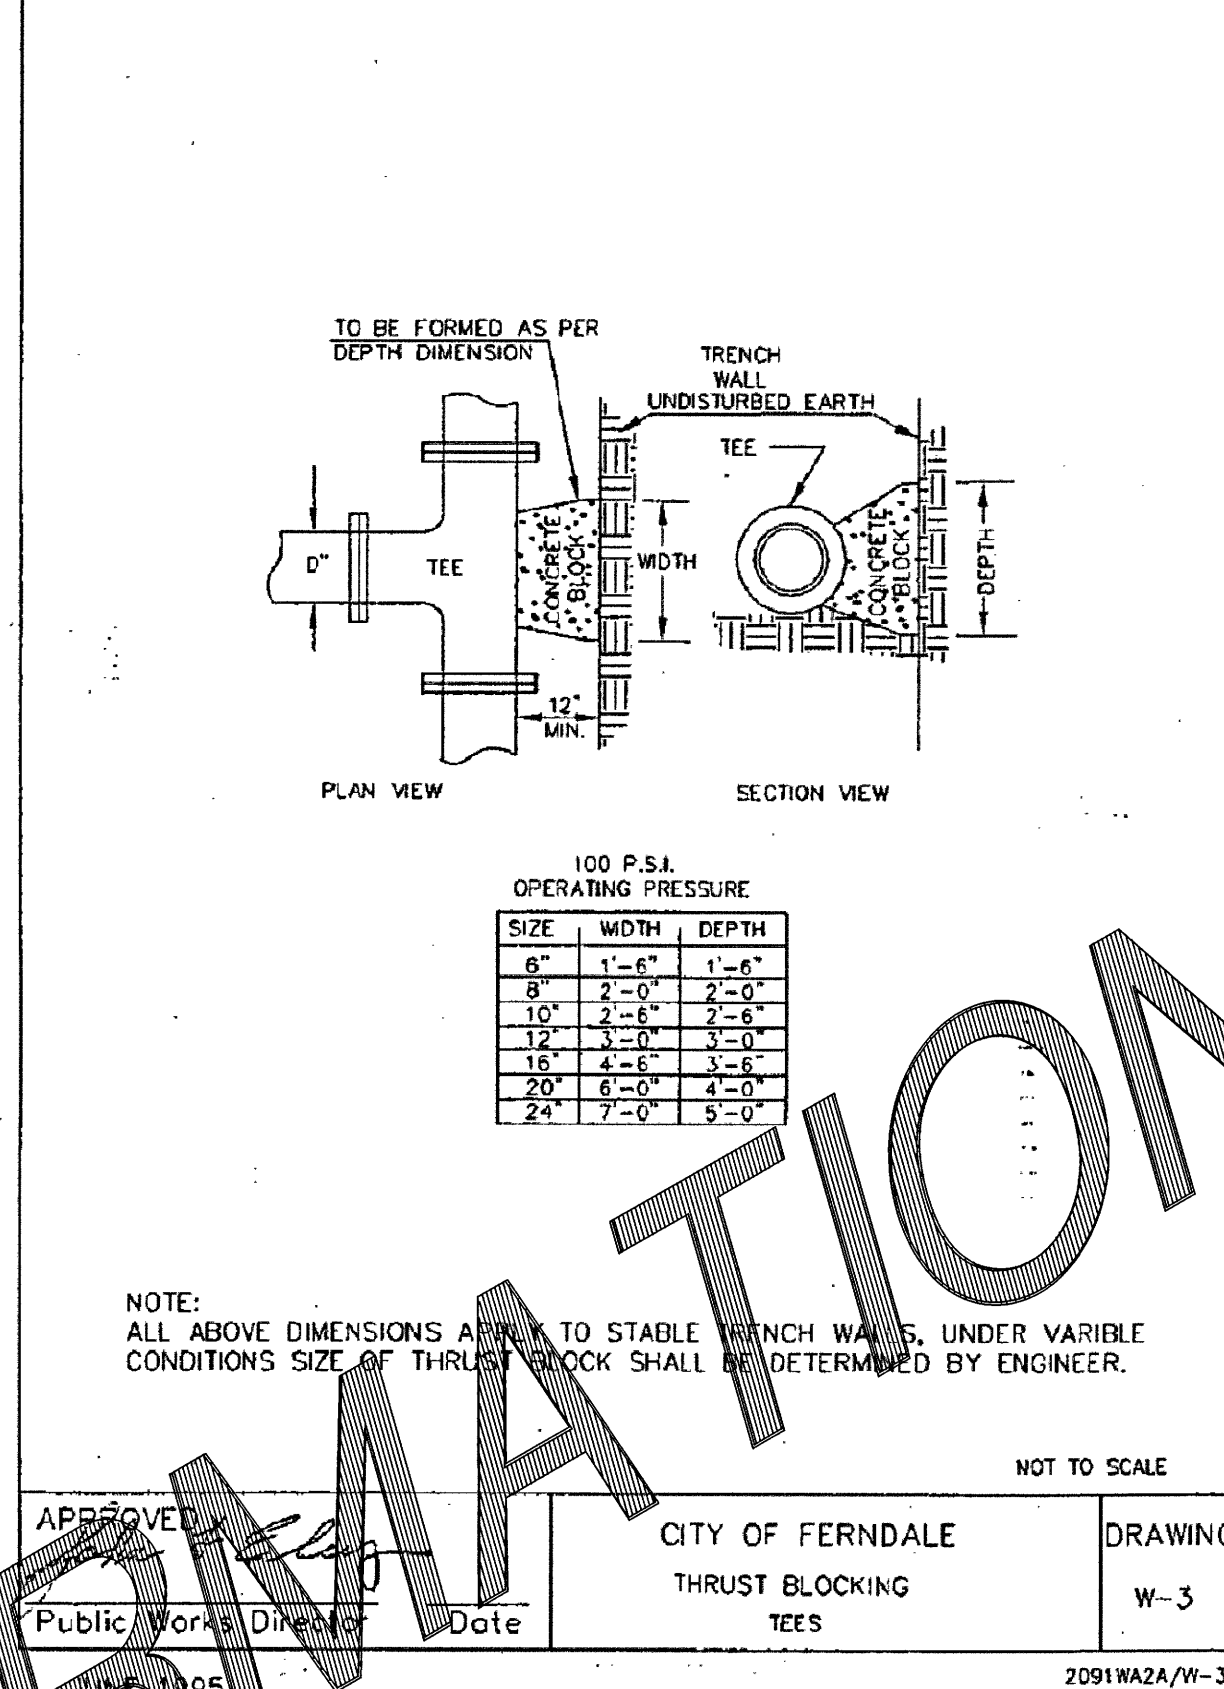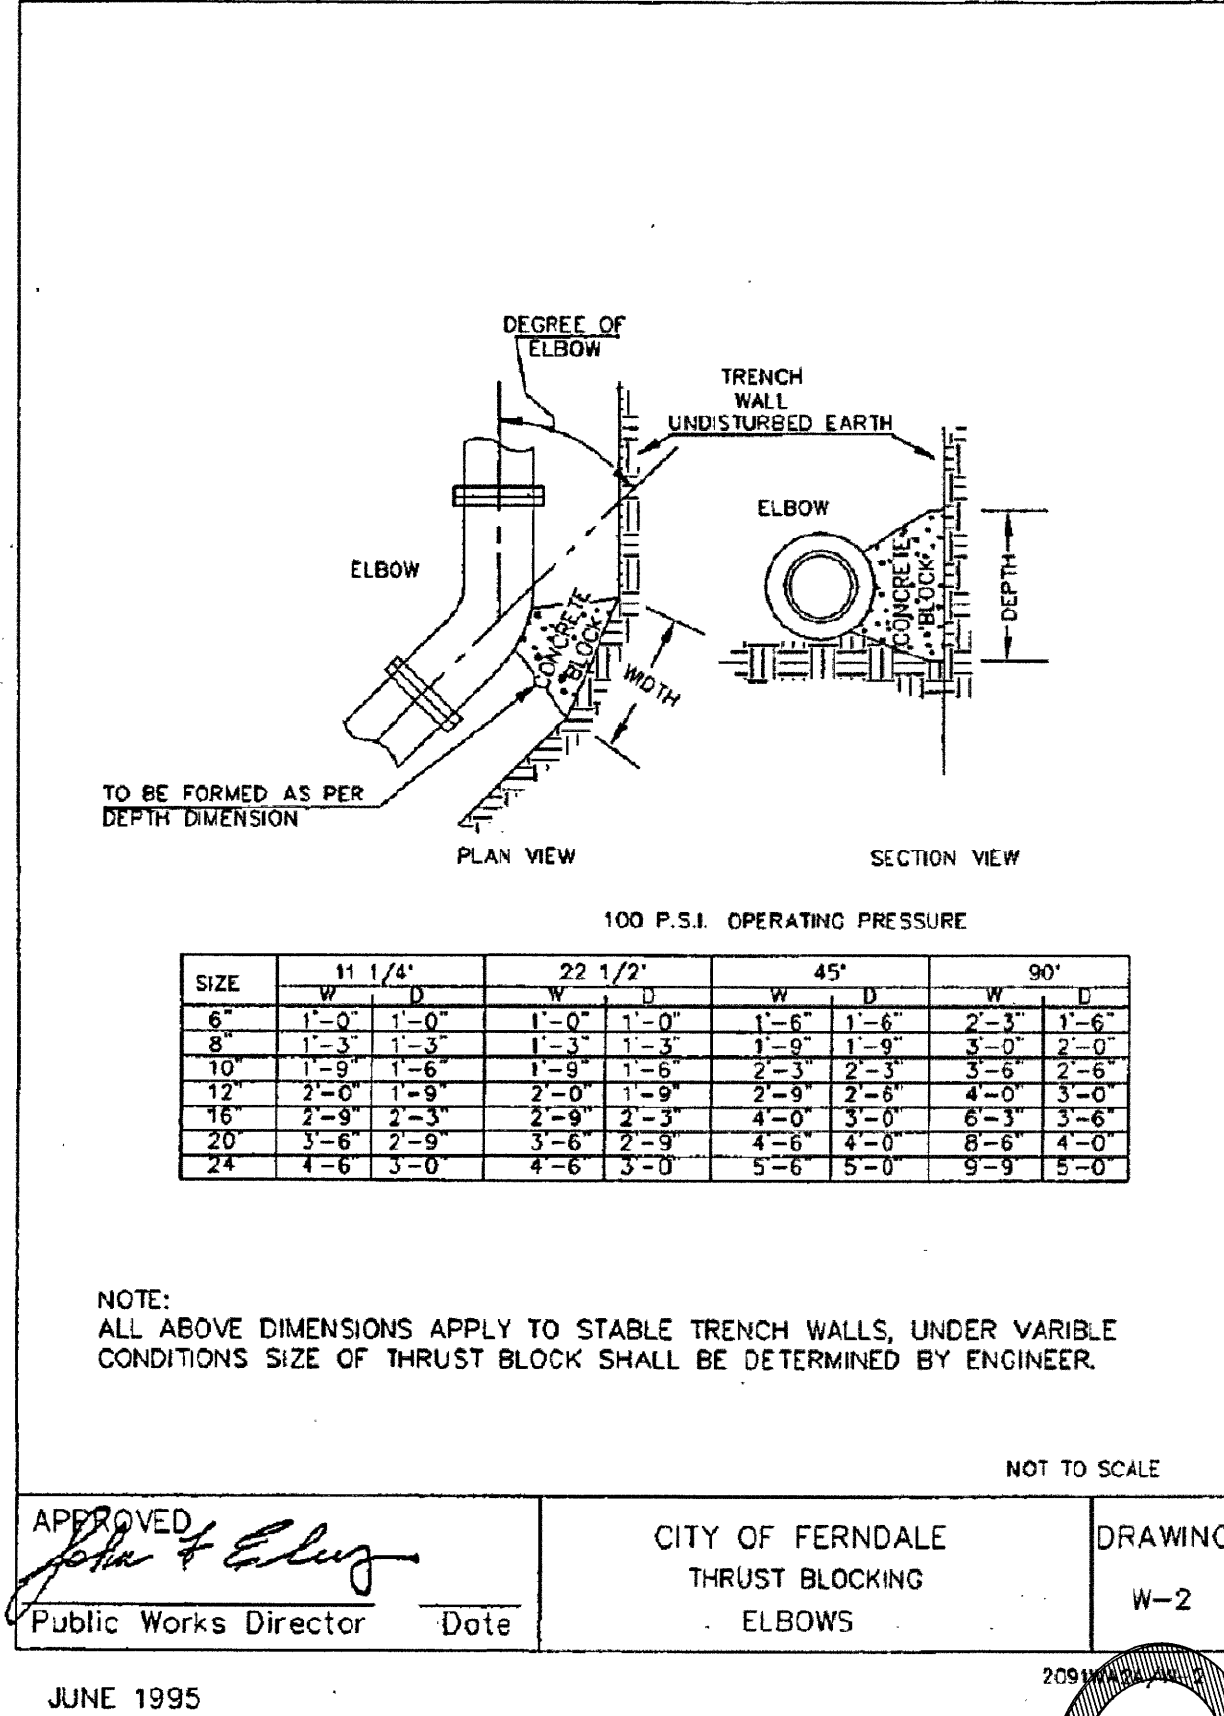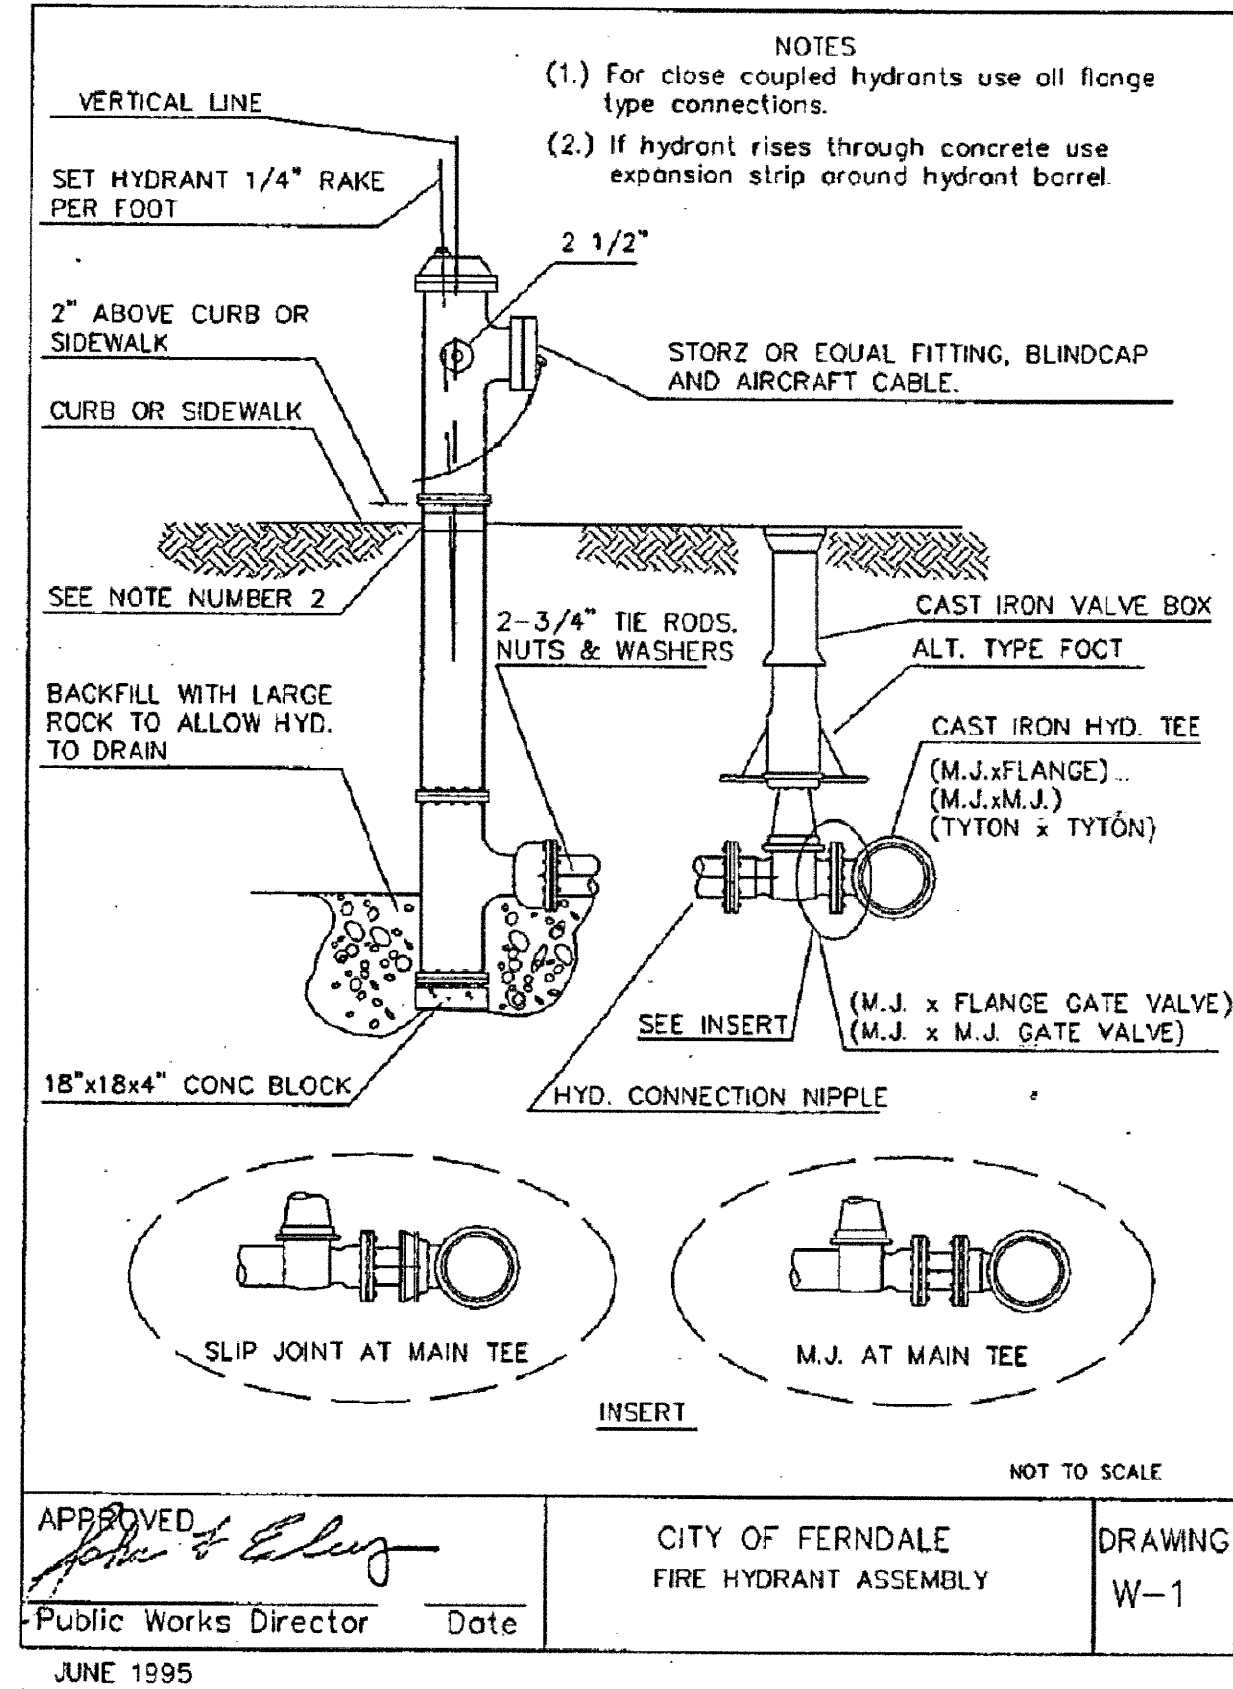

\\SERVER\Share\Common\Land Projects\2016\1602-2312-MT-VIEW - PNRD.dwg (1602-CIVIL-ASB.dwg) PLOT DATE: 5/22/2019 2:42 PM

NO.	REVISION	BY	DATE	NO.	BY	DATE
1	SUBMITTAL 1	RL	04/23/19	1		
2				2		
3				3		
4				4		
5				5		

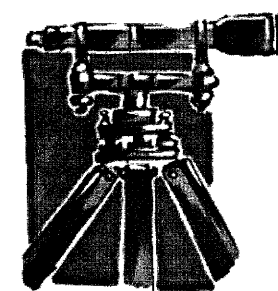

LDES, INC.
5160 INDUSTRIAL PL. #108
FERNDAL, WA 98248
PHONE 360-383-0620
FAX 360-383-0639

JOB NO.: 1602
DWG. NAME: 1602-CIVIL-ASB.dwg
DESIGNED BY: RL
DRAWN BY: EH
CHECKED BY: RL

PNRD
PO BOX 3249
FERNDAL, WA 98248


APPROVED
JUN 13 2019
BY: *John & Elly*
CITY OF FERNDAL
PUBLIC WORKS DEPARTMENT

**WATER
TYPICAL DETAILS**
MAIN STREET VILLAGE
2312 MOUNTAIN VIEW ROAD, FERNDAL, WA
A PORTION OF SECTION 30, TOWNSHIP 39N, RANGE 2E, WM.



SHEET
17
OF
20

RECORD DRAWING

\\SERVER\Share\Common\Land Projects\1602-2312-MT VIEW - PNRD\dwg\1602-CIVIL-ASB.dwg PLOT DATE: 5/22/2019 2:42 PM

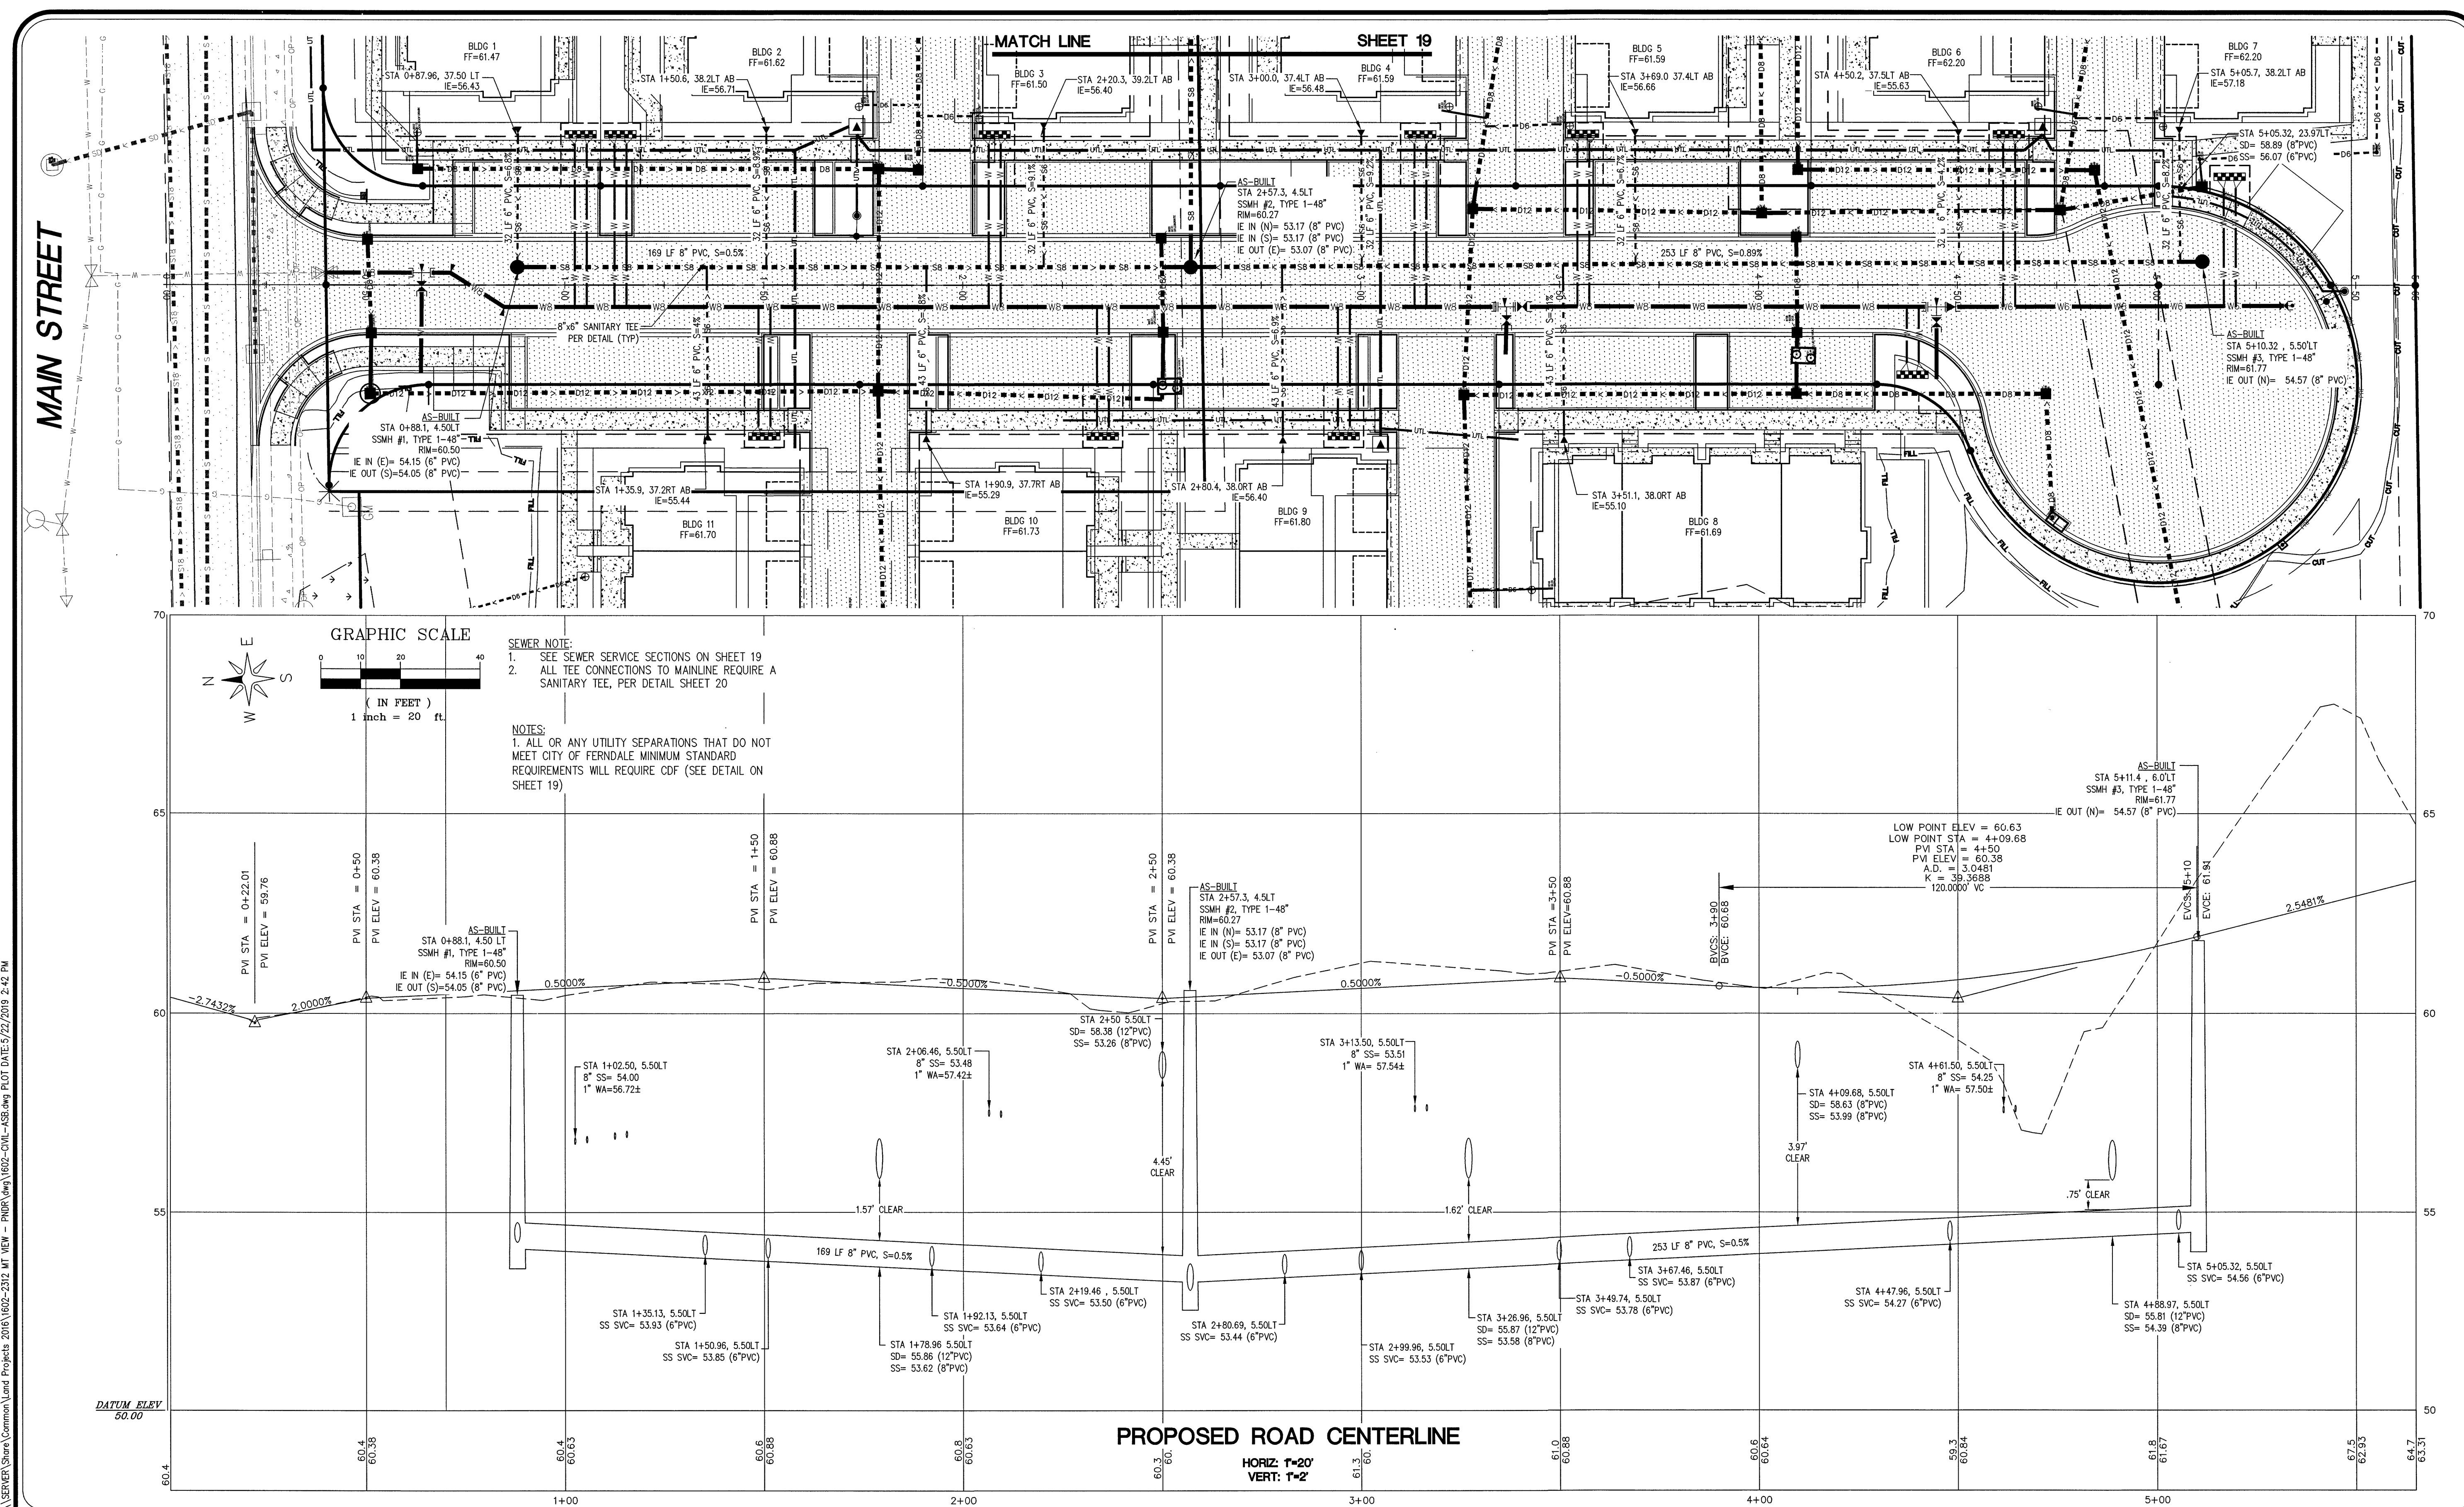

NO.	REVISION	BY	DATE	NO.	BY	DATE
1	SUBMITTAL 1	RL	04/23/19	6		
2				7		
3				8		
4				9		
5				10		

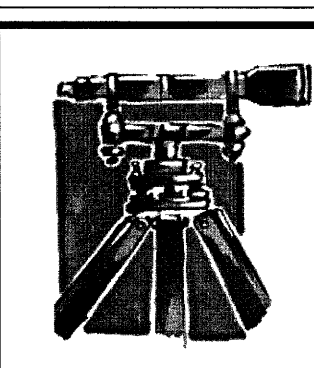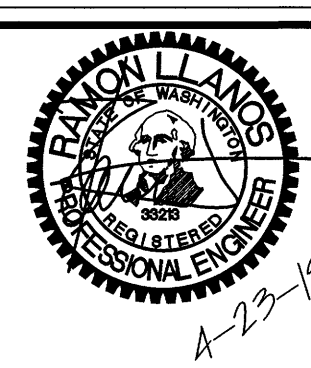

LDES, INC.
5160 INDUSTRIAL PL. #108
FERNDALE, WA 98248
PHONE 360-383-0620
FAX 360-383-0639

JOB NO.: 1602
DWG. NAME: 1602-CIVIL-ASB.dwg
DESIGNED BY: RL
DRAWN BY: EH
CHECKED BY: RL

PNRD
PO BOX 3249
FERNDALE, WA 98248

APPROVED
JUN 13 2019
BY: [Signature]
CITY OF FERNDALE
PUBLIC WORKS DEPARTMENT



SEWER PLAN & PROFILE 1

MAIN STREET VILLAGE
2312 MOUNTAIN VIEW ROAD, FERNDALE, WA
A PORTION OF SECTION 30, TOWNSHIP 39N, RANGE 2E, WM.


SHEET
18
OF
20

RECORD DRAWING


\\SERVER\Share\Common\Land Projects\2016\1602-2312 MT VIEW - PNRD\Civil\1602-Civil-ASB.dwg PLOT DATE: 5/22/2019 2:43 PM

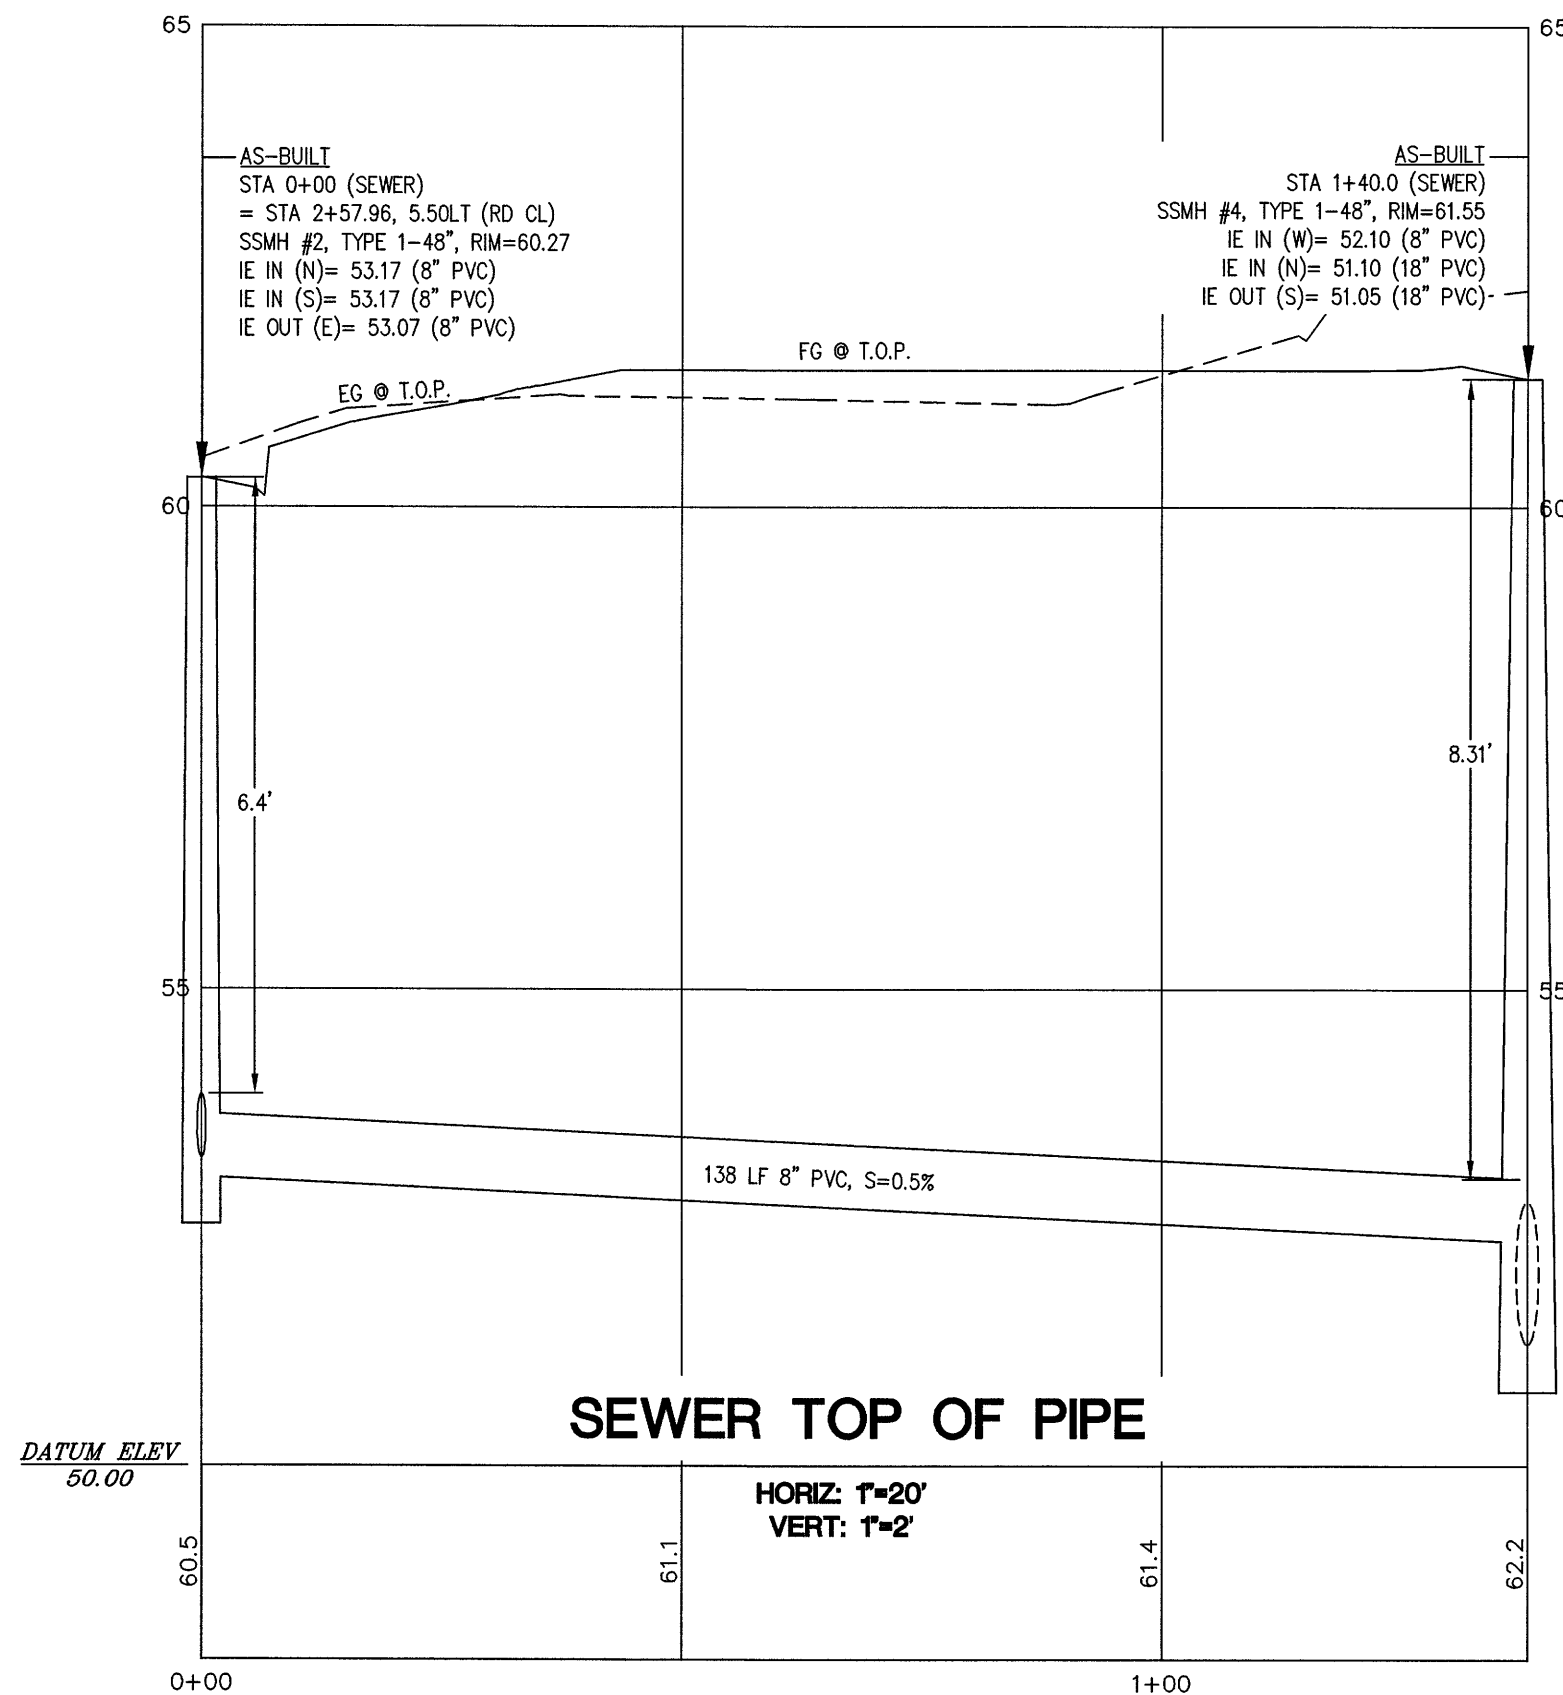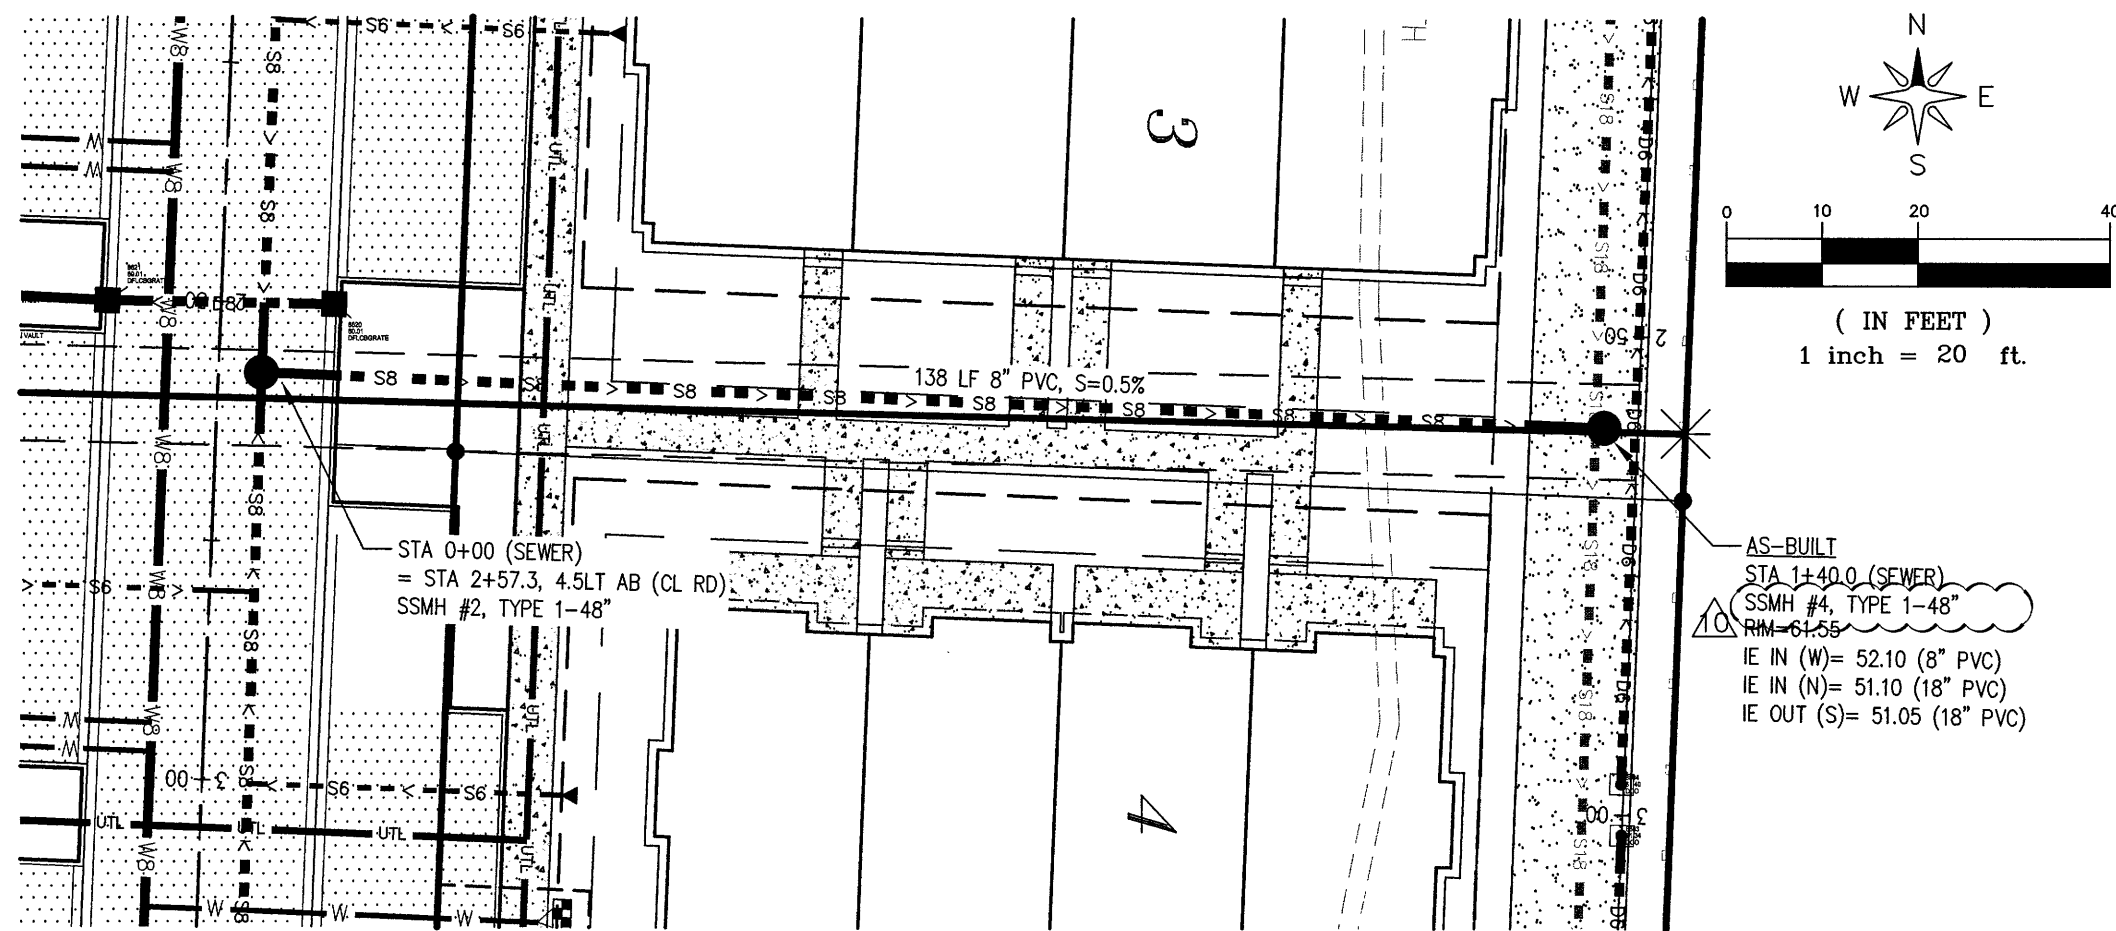

- NOTES:
- SSMH #4 MUST BE PRE-STUBBED, CUT-IN MANHOLE WITH DOUBLE BELL COUPLER CONNECTIONS TO THE EXISTING 18-INCH PVC SEWER MAINLINE.
 - CONTRACTOR MUST SUBMIT A SEWER BYPASS PLAN BEFORE INSTALLING SSMH #4 FOR CITY REVIEW AND APPROVAL.
 - THE ENGINEER OF RECORD SHOULD VERIFY THE FLOW ELEVATION IN THE EXISTING 18-INCH SEWER MAINLINE TO DETERMINE WHETHER THE 0.20-FT ELEVATION DIFFERENCE DESIGN ACROSS SSMH #4 IS ADEQUATE TO ALLOW CONSTRUCTION OF THE PROPOSED 6-INCH SEWER ONCE THE EXISTING SEWER IS BACK-IN-SERVICE AFTER SSMH #4 IS INSTALLED. CONTRACTOR WILL NEED TO SET UP LASER TO INSTALL NEW 6-INCH SEWER AND IF FLOW IS HIGH IN THE 18-INCH LINE THAT MAY BE DIFFICULT.
 - THE CITY OF FERNDAL DOES NOT HAVE A STANDARD OR APPROVED METHOD TO INSTALL A DOG HOUSE STYLE SSMH OVER AN EXISTING PVC SEWER MAIN. DUE TO THE DIFFICULTY ASSOCIATED WITH THIS SITE TO INSTALL A CONVENTIONAL CUT IN SSMH THE CITY HAS AGREED TO ENTERTAIN A PROPOSAL FROM DAHLGREN CONSTRUCTION TO USE ALTERNATIVE METHODS FOR ACHIEVING A WATER TIGHT SEAL AT THE PVC PIPE AND STRUCTURE CONNECTION POINT TO PREVENT OUTSIDE WATER INFILTRATION INTO THE SEWER SYSTEM. DAHLGREN CONSTRUCTION HAS AGREED TO ATTEMPT THESE ALTERNATIVE METHODS AT THEIR OWN RISK. IF INFILTRATION IS OBSERVED WITHIN THE CONSTRUCTION PROCESS OR DURING THE TWO-YEAR BOND PERIOD DAHLGREN CONSTRUCTION WILL BE HELD FULLY RESPONSIBLE AND AGREES TO DO WHATEVER IS NECESSARY TO SEAL THE SSMH TO THE SATISFACTION OF THE CITY OF FERNDAL.

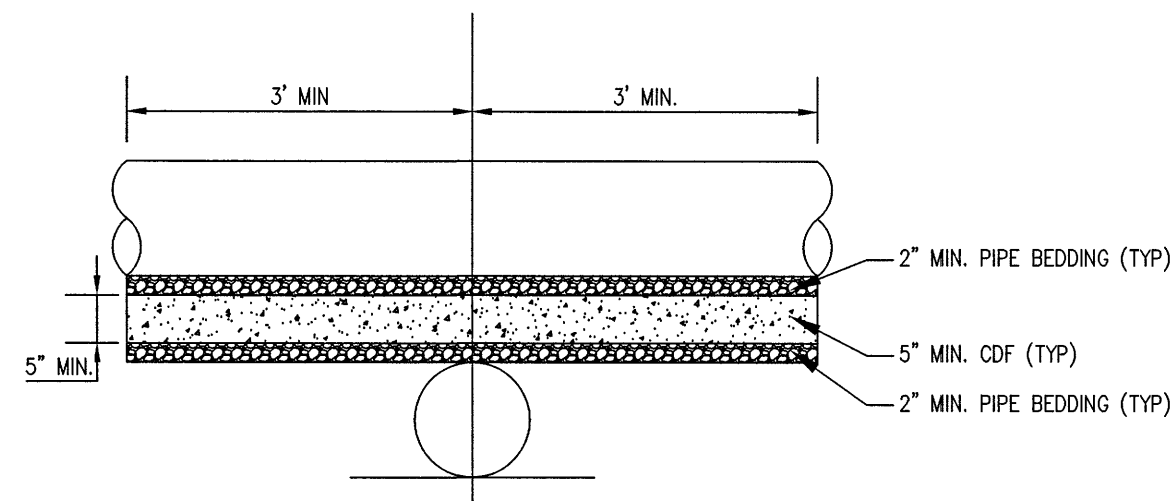

CDF DETAIL
TO BE USED WHEN CLEARANCE BETWEEN PIPES IS LESS THAN 12"

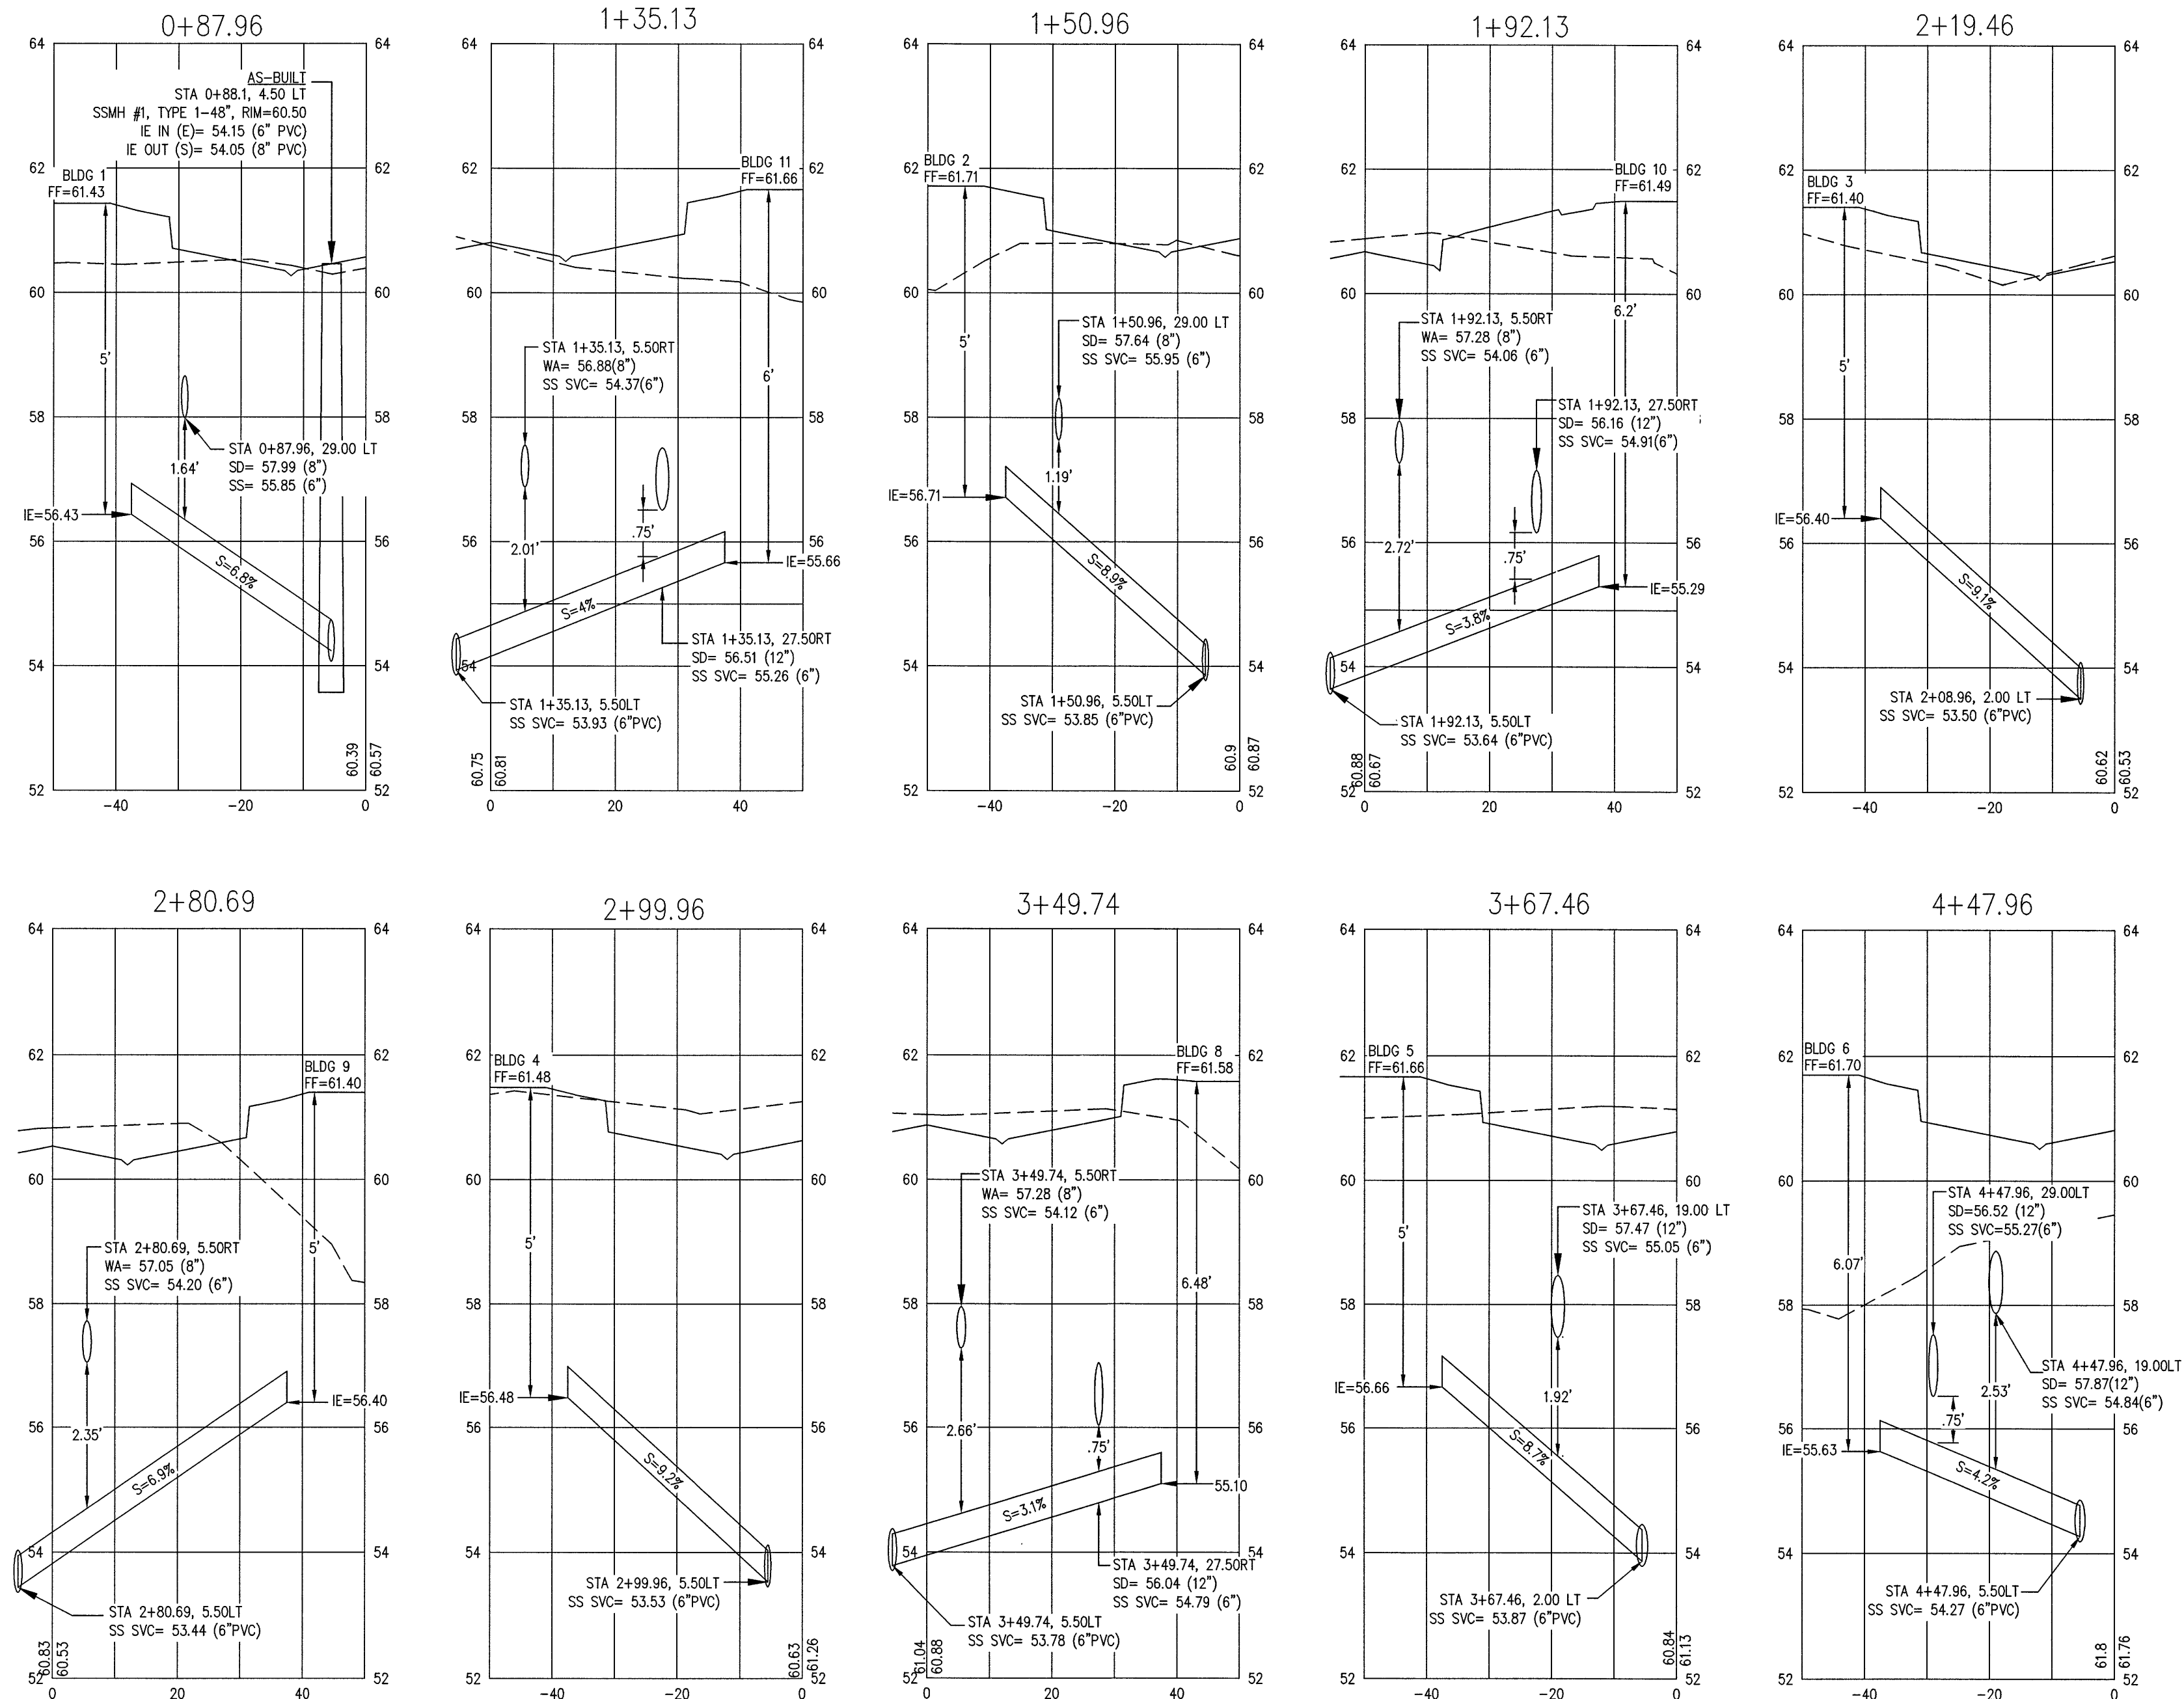


SEWER NOTE:
ALL TEE CONNECTIONS TO MAINLINE REQUIRE A
SANITARY TEE, PER DETAIL SHEET 20

SEWER SERVICE SECTIONS

HORIZ: 1"=20'
VERT: 1"=2'

NO.	REVISION	BY	DATE	NO.	BY	DATE
1	SUBMITTAL 1	RL	04/23/19			
2						
3						
4						
5						

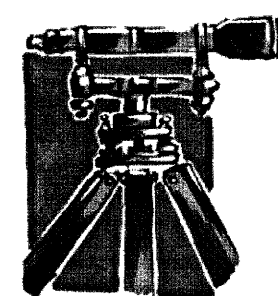

LDES, INC.
5160 INDUSTRIAL PL. #108
FERNDAL, WA 98248
PHONE 360-383-0620
FAX 360-383-0639

JOB NO.:	1602
DWG. NAME:	1602-CIVIL-ASB.dwg
DESIGNED BY:	RL
DRAWN BY:	EH
CHECKED BY:	RL

PNRD
PO BOX 3249
FERNDAL, WA 98248

APPROVED

JUN 13 2019

BY
CITY OF FERNDAL
PUBLIC WORKS DEPARTMENT

**SEWER PLAN & PROFILE 2
& SERVICE CROSS-SECTIONS**
MAIN STREET VILLAGE
2312 MOUNTAIN VIEW ROAD, FERNDAL, WA
A PORTION OF SECTION 30, TOWNSHIP 39N, RANGE 2E, WM.

SHEET
19
OF
20

RECORD DRAWING

IDS

HYDRO-SWELLING WATERPROOFING SEALANT

SPETEC® WT400

ADVANTAGES


- Single component
- MBI based
- Strong adhesion to concrete and steel even in humid conditions
- High elongation
- Remains elastic after curing
- Solvent free
- High expansion 450%
- Can be applied under water
- Non sagging

FIELD OF APPLICATION

- Waterstop
- Tunnel Segment joints
- Pipe penetrations
- Poured wall joints
- Cold joints
- Sheet pile joints
- Manhole joints
- Precast segments

DESCRIPTION

SPETEC® WT400 is a single component hydrophilic caulk designed to swell and/or expand in the presence of water creating a water tight seal around pipe penetrations, cold joints and other waterstop locations. SPETEC® WT400 should be applied onto a dust free, oil free surface to maximize bond strength. SPETEC® WT400 should be applied at a minimum bead of 10mm with a minimum concrete cover of 7cm. SPETEC® WT400 must be fully confined to properly expand and seal the surface. This material can be applied underwater on clean surfaces.

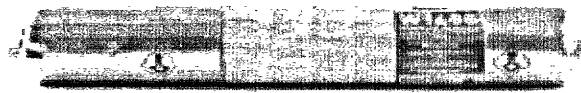


APPLICATION

- The SPETEC® WT400 must be applied on a dust-free concrete or metal surface.
- Use at temperatures between -5°C and 35°C
- Surface can be rough, smooth, wet or dry
- Should cure for 24 hours before concrete pouring
- Do not pour concrete directly on applied product


- For the cartridges of 310ml:
- Break the caulk at the nozzle
 - Remove the cap of the bottom
 - Cut the nozzle diagonally at the appropriate position
 - Place the cartridge in the gun and press the lever
- For the 600ml sausages:
- Put the sausage in the empty tube of the caulking gun
 - Cut 10mm off the top of the sausage
 - Close the tube and install the nozzle
 - Cut the nozzle diagonally at the appropriate position

SPETEC® WT400 is applied with a caulking gun in an interrupted bead (minimum 10mm wide and high) in the middle of the joint or profile element. Concrete cover should be at least 7cm on both sides in order to avoid cracks from the expansion pressure. If swelling SPETEC® WT400.

PIPE PENETRATION

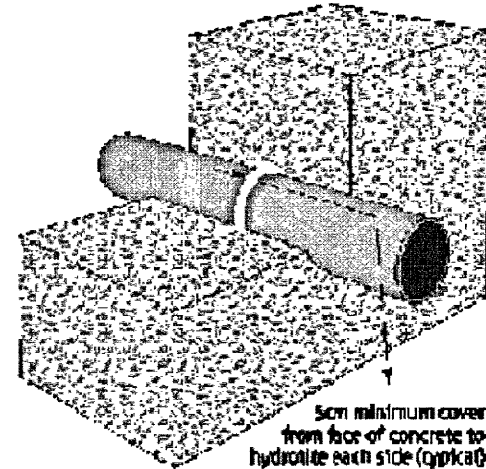

COLD JOINT APPLICATION

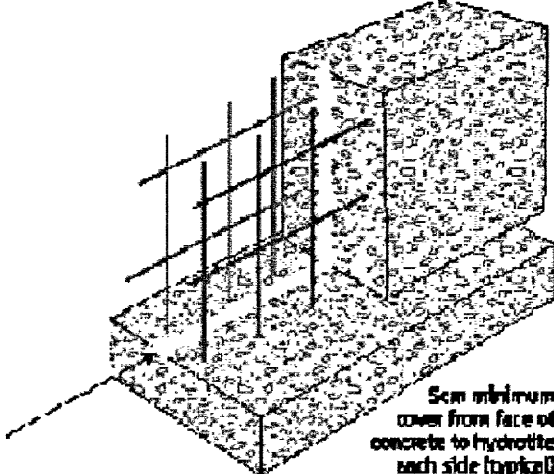

NOCKLE JOINTS BETWEEN SHEETPILE ELEMENTS



CHEMICAL RESISTANCE

Good overall chemical resistance.

COMPOSITION

One component MBI polyurethane based, solvent free, hydro swelling mastick.


TECHNICAL DATA

Property	Value	Norm
Base Polyurethane Consistency	Stable Paste	
Caulking Syringe	Moldure	
Cure Skin formation %	120 minutes	
Hydrostatic Pressure	5 bar	
Curing Rate %	1.8mm/24h	
Moisture	15-18% A	
Shrinkage	Max. 4%	
Specific Gravity	1.37kg/cm³	
Temperature Resistance	-30°C to +90°C	
Elasticity Modulus in Flex	0.54 MPa	(DIN 53504)
Stamp Hardness Strength in Flex	Ca. 0.60 MPa	(DIN 53504)
Elongation at Break in Flex	>800%	(DIN 53504)
Elasticity Modulus in Joint	Ca. 0.12 MPa	(ISO 839)
Tear Strength in joint	Ca. 0.20 MPa	(ISO 839)
Elongation at Break in joint	>450%	(ISO 839)
Settling	450%	
Final Cure %	34 Hours	
Solids	100%	

(*) These values may vary depending on environmental factors such as temperature, moisture, and type of substrate.

CONSUMPTION

Nozzle diameter	Length (mm)	Length (m)
5mm	23-25m	43-50m
6mm	8-10m	16-20m
8mm	4-5m	8-10m
10mm	3m	6m

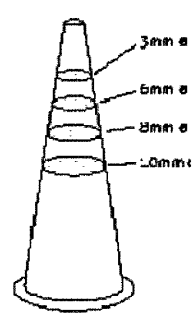

ACCESSORIES

- Skeleton caulking gun for cartridges
- Caulking gun for sausages (close tube)
- Nozzle for caulking gun sausages (close tube)

PACKAGING

- 310ml cartridges
 - 12 per cardboard box
 - 1 pallet = 75 cardboard boxes
 - Weight per cartridge: 0.5kg net
- 600ml sausages
 - 12 per cardboard box
 - 1 pallet = 40 cardboard boxes
 - Weight per sausage: 0.9kg net

STORAGE & CONSERVATION


In unopened packaging, in a dry place, between +5°C and +20°C, 12 months. Data of Production: see packaging.

HEALTH & SAFETY

Low toxicity, non-flammable, non-toxic.

NOTES:

1. FLOW SHALL BE MAINTAINED DURING CONSTRUCTION.
2. THIS DETAIL TO BE USED WHEN A 6" OR LARGER LATERAL NECESSITATES CONSTRUCTION OF A NEW MANHOLE.
3. FOR ADDITIONAL STANDARDS NOT SHOWN, SEE "STANDARD MANHOLE" SHEET 20.
4. CONTRACTOR SHALL BE RESPONSIBLE FOR SUPPORT OF EXISTING SEWER DURING INSTALLATION OF MANHOLE.
5. DOGHOUSE OPENING MAY ONLY BE USED WHEN PLACING A NEW MANHOLE OVER AN EXISTING LINE; OTHERWISE, THE OPENING MUST BE CAST. SIZE, LOCATION, AND ANGLE OF ENTRY SHALL BE AS REQUIRED BY THE PLANS.
6. EXCAVATE TRENCH TO MIN. 13" BELOW BOTTOM OF EXISTING PIPE. COMPACT SUBGRADE. PLACE AND COMPACT 8" OF GRANULAR BEDDING. MONOLITHIC POUR OF MIN. 7" DEPTH 8" SANK TOPPING MIX TO BE PLACED INSIDE, UNDER, AND OUTSIDE MANHOLE BARREL. FROM SURFACE OF BEDDING, AROUND CONCRETE BLOCK RISERS, TO A POINT APPROXIMATELY AT THE SPRING LINE OF THE EXIST. PIPE.
7. DURING THE SAME POUR, THE FINISH MANHOLE SHELF SHALL BE FORMED AND FINISHED AROUND THE BARREL AND EXISTING PIPE AS SHOWN.
8. AFTER CONCRETE SHELF HAS CURED, THE EXISTING PIPE SHALL BE SAW-CUT ON BOTH SIDES TO THE FINISHED SHELF GRADE AND REMOVED. THE EXISTING PIPE SHALL FORM THE TROUGH OF THE MANHOLE AS SHOWN. FILE CUT PIPE TO GIVE SMOOTH EDGES.

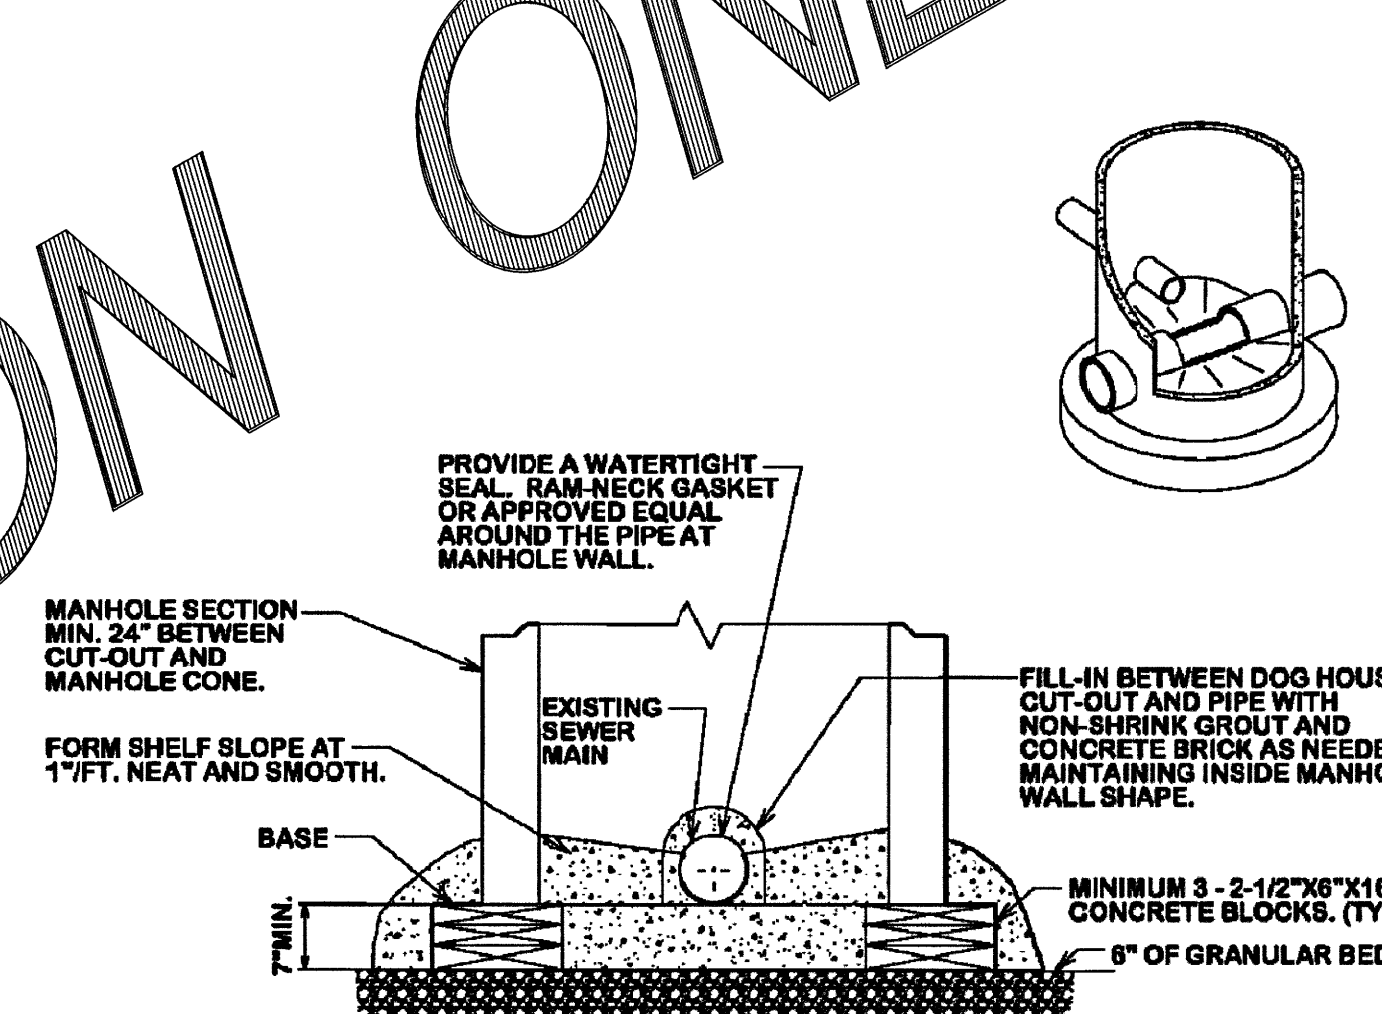


USE CONCRETE BLOCKS IF SADDLE MANHOLE DOES NOT PROVIDE ROOM FOR 7" BASE

SEWER SADDLE MANHOLE INSTLLATION SEQUENCING

1. EXPOSE THE EXISTING 18" SANITARY SEWER PIPE AND BUILD A ROCK BASE UNDERNEATH THE PIPE AND FUTURE MANHOLE LEAVING ROOM TO POUR A CONCRETE BASE.
2. ABRASE THE EXISTING PVC SEWER PIPE WITH A WIREWHEEL AT THE LOCATION WHERE THE FUTURE SADDLE MANHOLE WILL SIT.
3. CLEAN NEWLY PREPARED PIPE SURFACE WITH A SOLVENT.
4. HAND GUN WT400 OR APPROVED EQUAL AT THE MIDWAY POINT WHERE THE PROPOSED CONCRETE MANHOLE WILL SIT.
5. SET THE MANHOLE AND POUR A CONCRETE BASE HALF WAY UP THE EXISTING SEWER PIPE.
6. GROUT THE VOIDS BETWEEN THE MANHOLE, BASE AND PIPE.
7. LET THE CONCRETE SET FOR 24 HOURS. CUT THE TOP HALF OF THE PIPE WITHIN THE INSIDE OF THE MANHOLE.
8. ALLOW A MINIMUM OF 14 DAYS PRIOR TO APPLYING A COAT OF POLYUREA OVER THE GROUT AND PIPE OUTSIDE THE MANHOLE. THE APPLICATION SHOULD COVER AT LEAST 18" PAST THE PIPE AND GROUT CONNECTING TO THE MANHOLE.
9. THE CONTRATOR SHALL HAVE A BY-PASS PLAN IN CASE OF A SPILL OR NEED OF REPAIR. THE PLAN SHALL BE APPROVED BY THE ITY OF FERNDALE PRIOR TO THE MANHOLE INSTALLATION. ALL MATERIALS NEEDED FOR THE PLAN SHALL REMAIN ON SITE DURING THE INSTALLATION OF THE MANHOLE.





Resident: N/USA • Call center: 360-383-0620 • info@spetec.com • www.spetec.com
Tel: +1 360 383 0620 • Fax: +1 360 383 0639

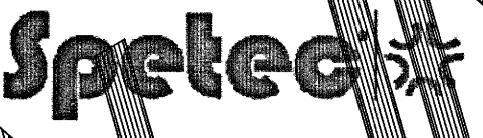

Resident: N/USA • Call center: 360-383-0620 • info@spetec.com • www.spetec.com
Tel: +1 360 383 0620 • Fax: +1 360 383 0639

\\SERVER\Share\Common\Land Projects 2016\1602-2312-MT-NEW - PNRD\Eng\1602-CIVIL-ASB.dwg PLOT DATE: 5/22/2019 2:44 PM

NO.	REVISION	BY	DATE	NO.	BY	DATE
1	SUBMITTAL 1	RL	04/23/19			
2						
3						
4						
5						

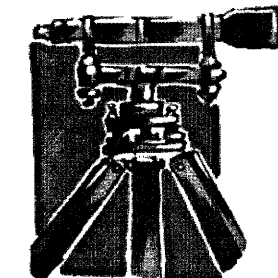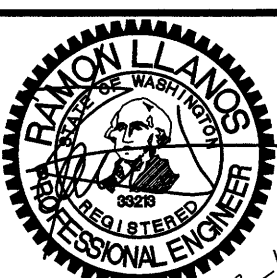

LDES, INC.
5160 INDUSTRIAL PL. #108
FERNDALE, WA 98248
PHONE 360-383-0620
FAX 360-383-0639

JOB NO.:	1602
DWG. NAME:	1602-CIVIL-ASB.dwg
DESIGNED BY:	RL
DRAWN BY:	EH
CHECKED BY:	RL

PNRD
PO BOX 3249
FERNDALE, WA 98248


APPROVED
JUN 13 2019
CITY OF FERNDALE
PUBLIC WORKS DEPARTMENT

SEWER SADDLE MANHOLE
INSTALLATION DETAILS
MAIN STREET VILLAGE
2312 MOUNTAIN VIEW ROAD, FERNDALE, WA
A PORTION OF SECTION 30, TOWNSHIP 39N, RANGE 2E, WM.


SHEET
19A
OF
20

RECORD DRAWING

\\SERVER.Shore\Common\Land Projects\2016\1602-2012 MT VIEW - PNRD.dwg\1602-CIVIL-ASB.dwg PLOT DATE:5/22/2019 2:45 PM

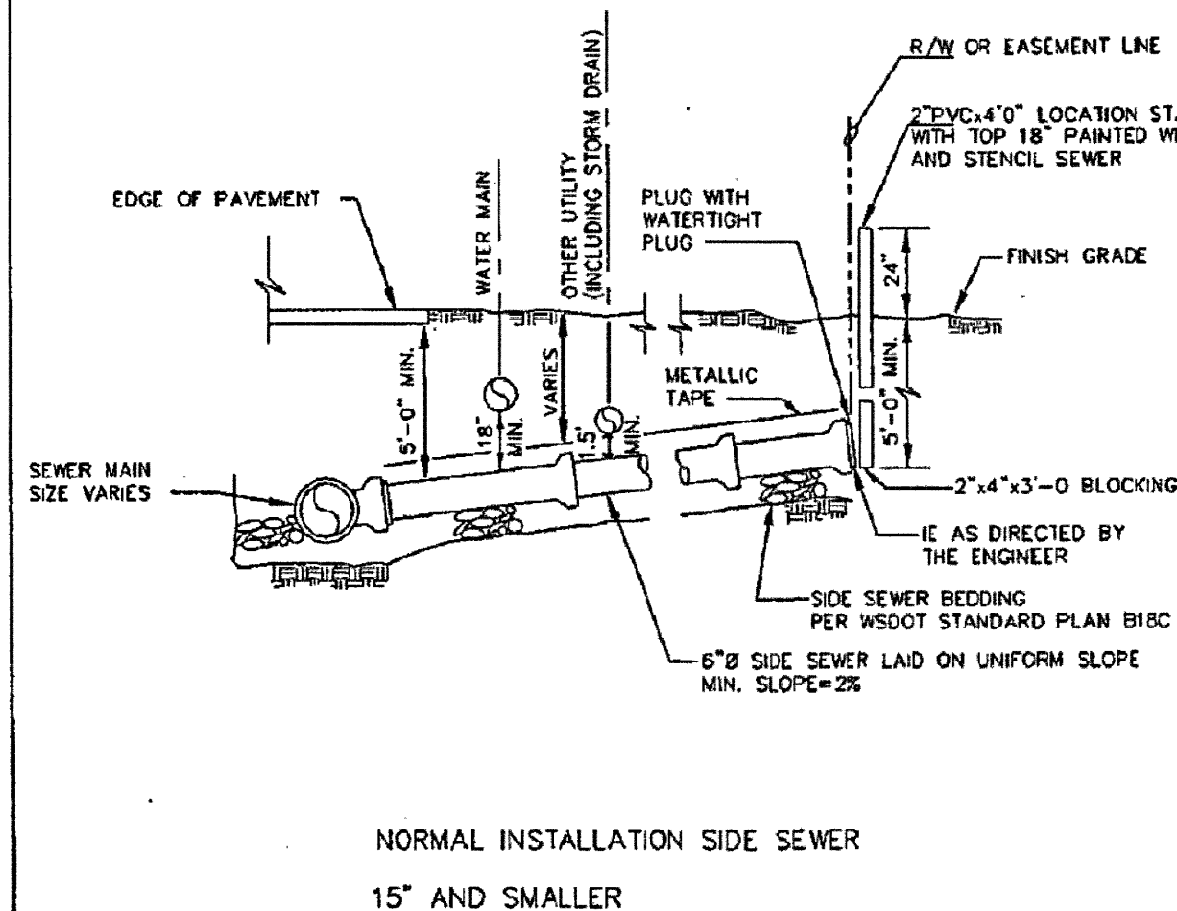

APPROVED *John & Elery* CITY OF FERDALE DRAWING
Public Works Director Date 15" AND SMALLER SEWER MAINS SS-6
JUNE 1995 20915E34/SS-6

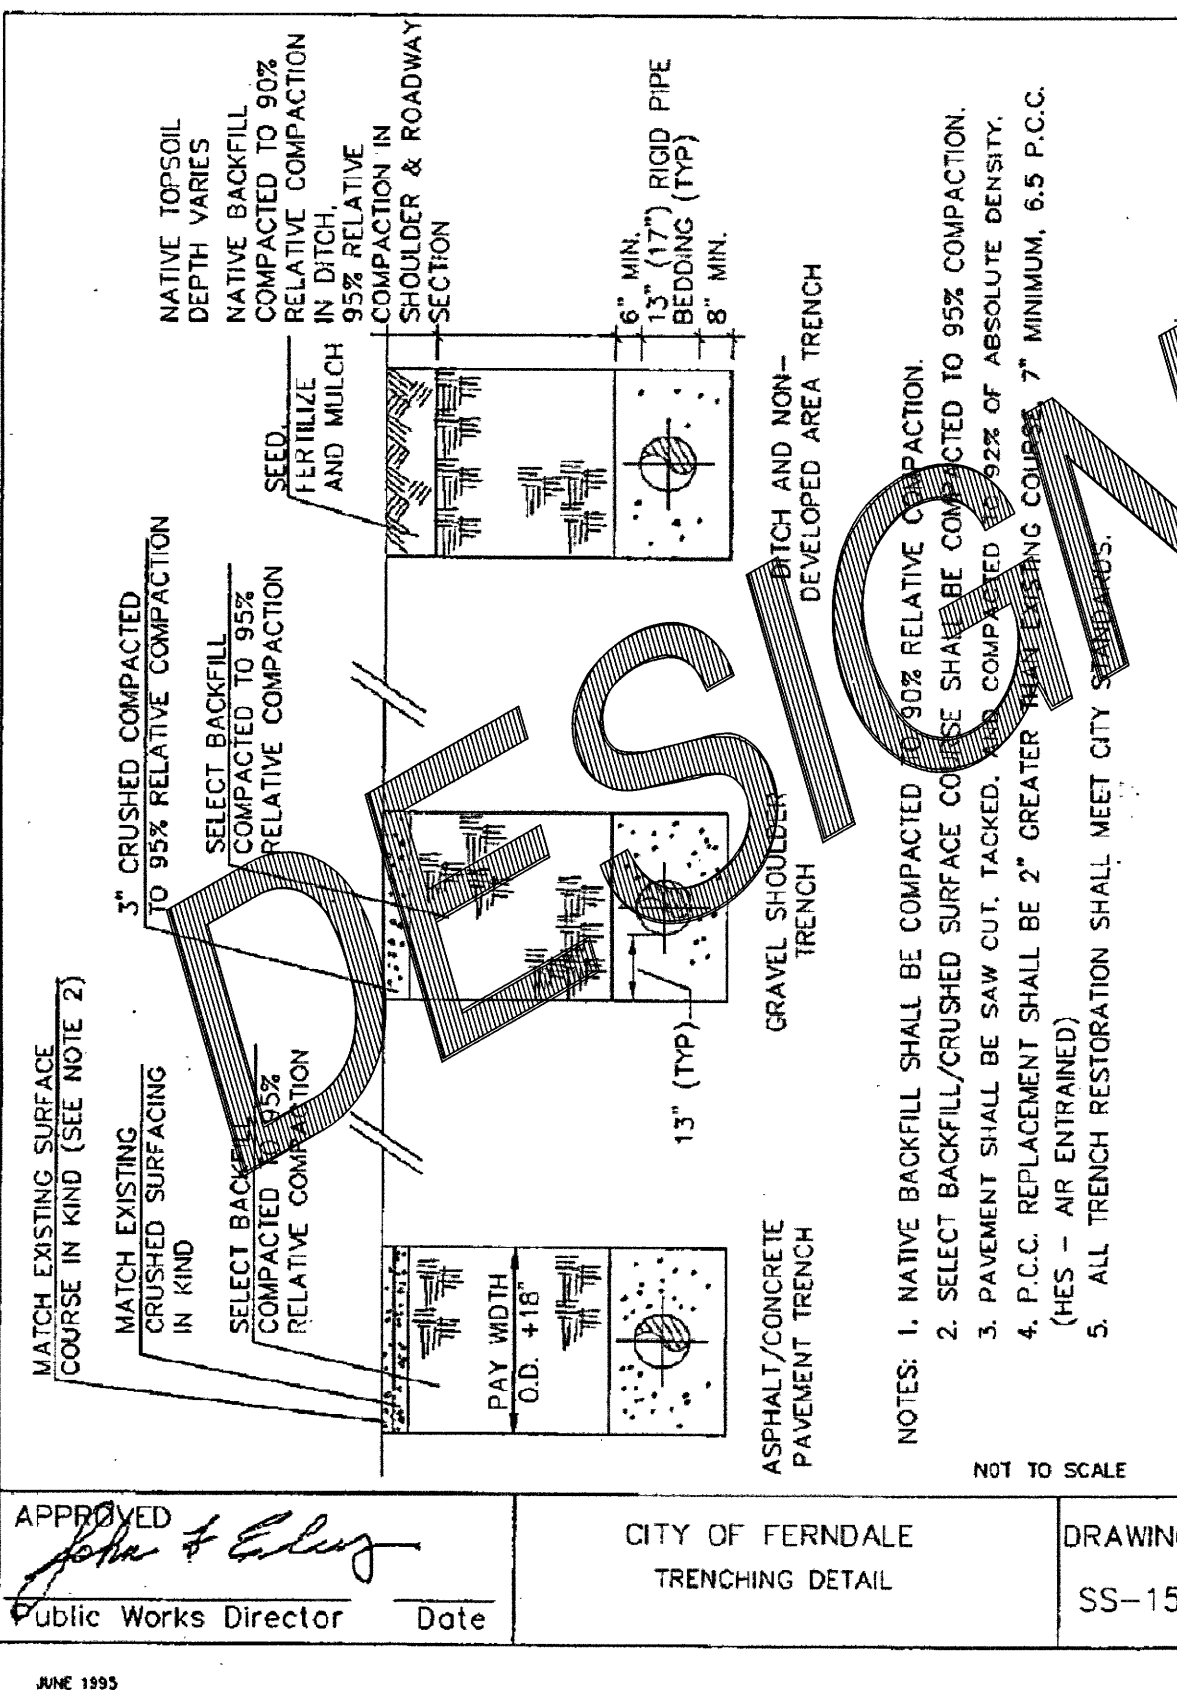

APPROVED *John & Elery* CITY OF FERDALE DRAWING
Public Works Director Date TRENCHING DETAIL SS-15
JUNE 1995

THE FOLLOWING SUPPLEMENTAL SPECIFICATIONS ARE TO BE USED IN CONJUNCTION WITH THE STANDARD SPECIFICATIONS FOR ROAD, BRIDGE AND MUNICIPAL CONSTRUCTION, CURRENT EDITION.


BEDDING FOR SEWERS, DRAINS AND CULVERTS FOR PVC PIPE—

BEDDING MATERIAL FOR PVC PIPE SHALL BE PEA GRAVEL CONFORMING THE FOLLOWING SPECIFICATIONS:


PEA GRAVEL — PEA GRAVEL BEDDING SHALL BE A CLEAN MIXTURE FREE FROM ORGANIC MATTER AND CONFORMING TO THE FOLLOWING GRADATION WHEN TESTED IN ACCORDANCE WITH ASTM D422:

U.S. STANDARD SIEVE SIZE	PERCENTAGE PASSING, BY WT.
3/4"	100
3/8"	95-100
1/8"	0-10
#200	0-3

BACKFILL — WHENEVER A TRENCH IS EXCAVATED IN THE EXISTING OR PROPOSED ROADWAY, SIDEWALK OR OTHER AREAS WHERE SETTLEMENT WOULD BE DETRIMENTAL, THE ENTIRE TRENCH SHALL BE BACKFILLED WITH IMPORTED GRAVEL AND COMPACTED TO 95% OF MAXIMUM DENSITY.

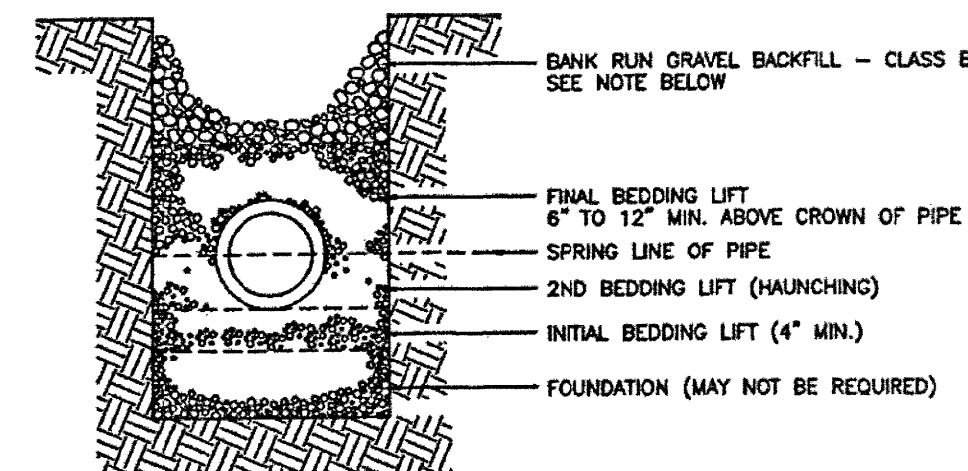



APPROVED *John & Elery* CITY OF FERDALE DRAWING
Public Works Director Date BEDDING SPECIFICATIONS FOR PVC PIPE SS-1
JUNE 1995 20915E34/SS-6

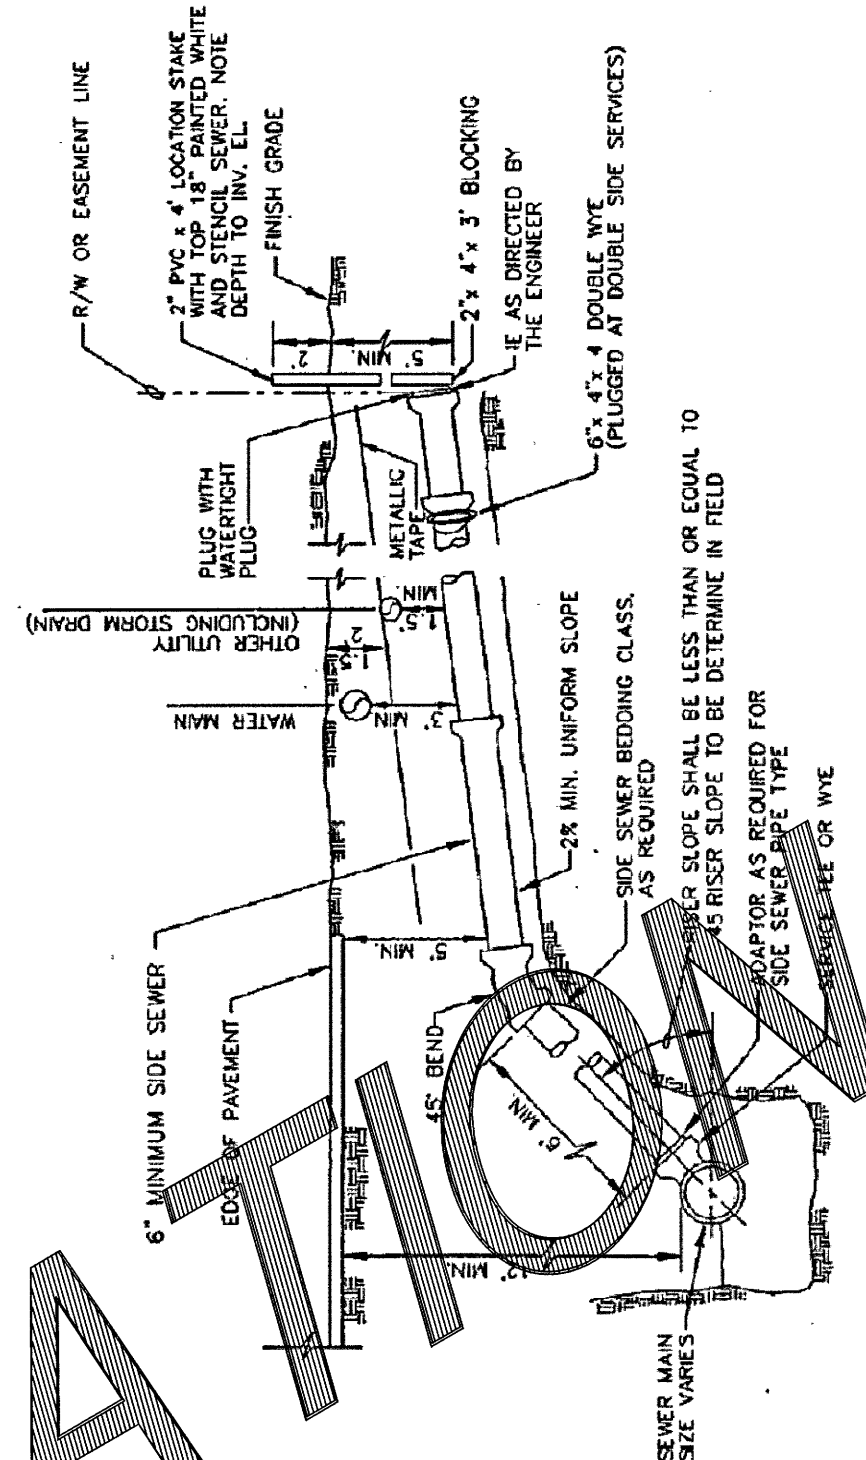


APPROVED *John & Elery* CITY OF FERDALE DRAWING
Public Works Director Date SANITARY SEWER SIDE SERVICE INSTALLATION DEEP MAINS SS-8
JUNE 1995 20915E44/SS-8

- NOTES
- Knockouts shall have a wall thickness of 2" minimum to 2.5" maximum.
 - For pipe allowances, see Standard Plan B-10.20.

MANHOLE DIMENSION TABLE				
DIAM.	MIN. WALL THICKNESS	MIN. BASE THICKNESS	MAXIMUM KNOCKOUT SIZE	MINIMUM DISTANCE BETWEEN KNOCKOUTS
48"	4"	6"	36"	8"
54"	4.5"	8"	42"	8"
60"	5"	8"	48"	8"

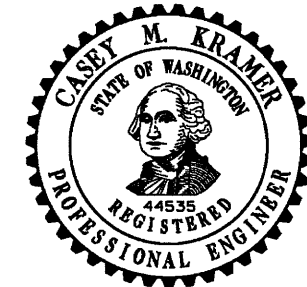
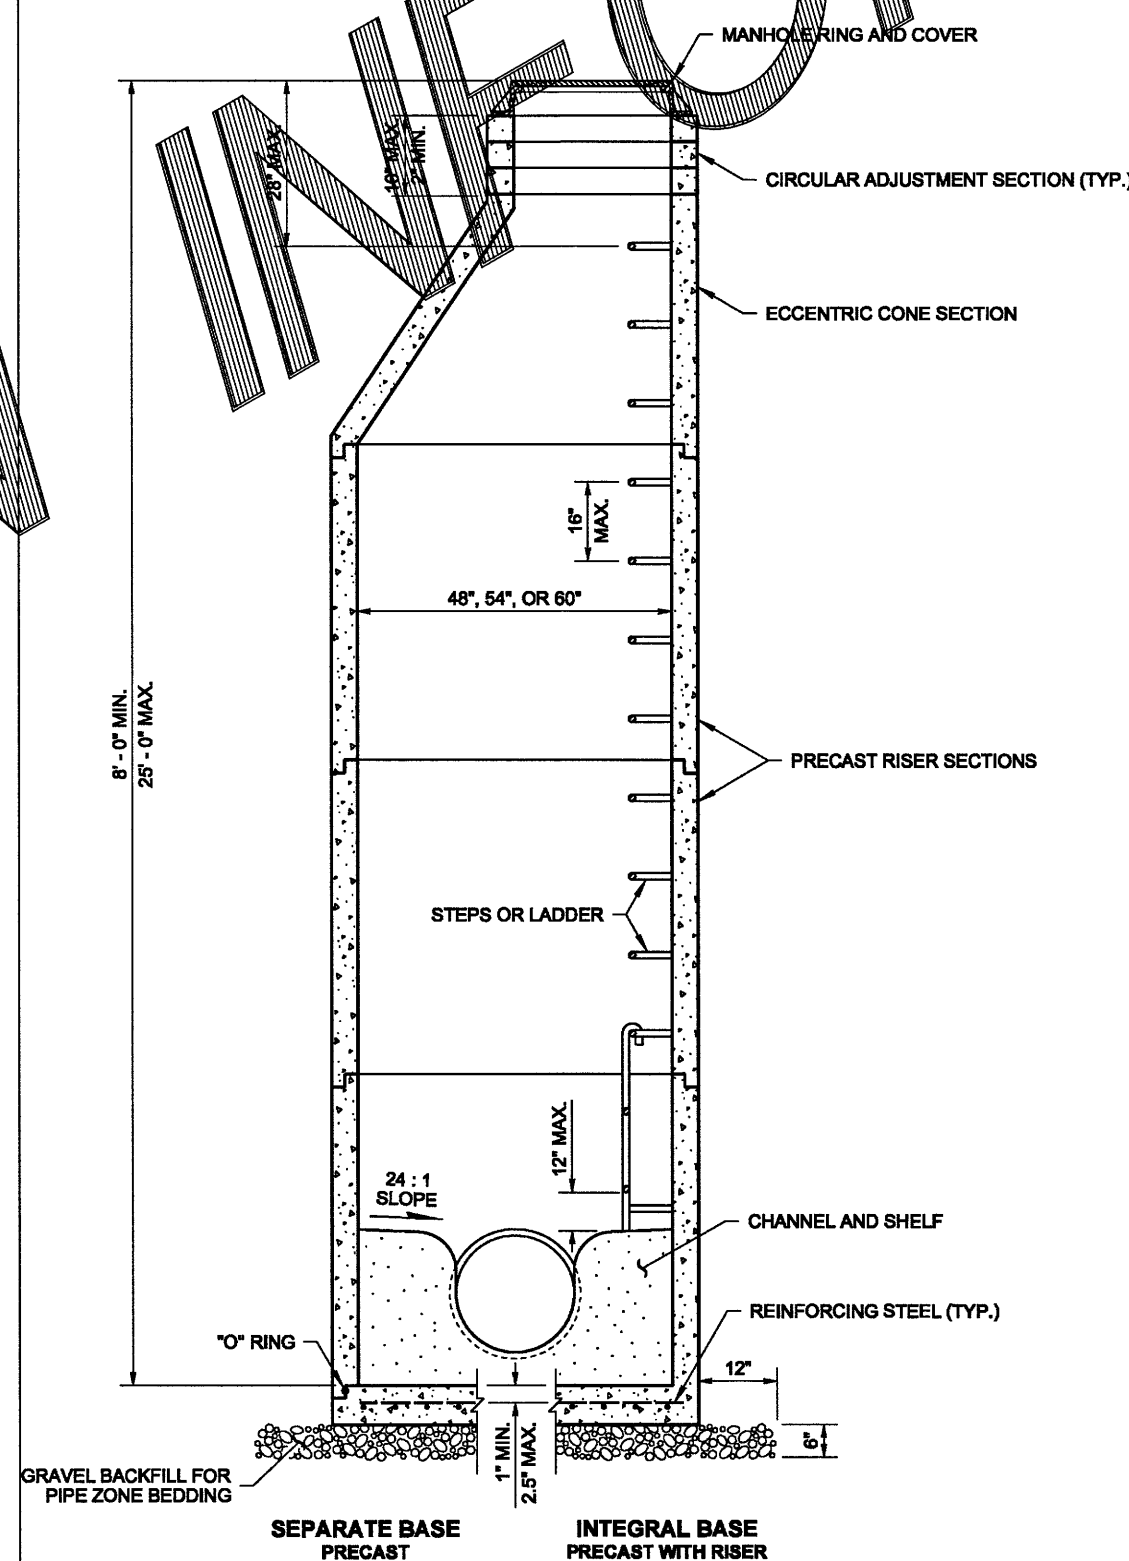


MANHOLE TYPE 1
STANDARD PLAN B-15.20-01
SHEET 1 OF 1 SHEET
APPROVED FOR PUBLICATION
Pasco Bakotich III 02-07-12
STATE DESIGN ENGINEER
Washington State Department of Transportation

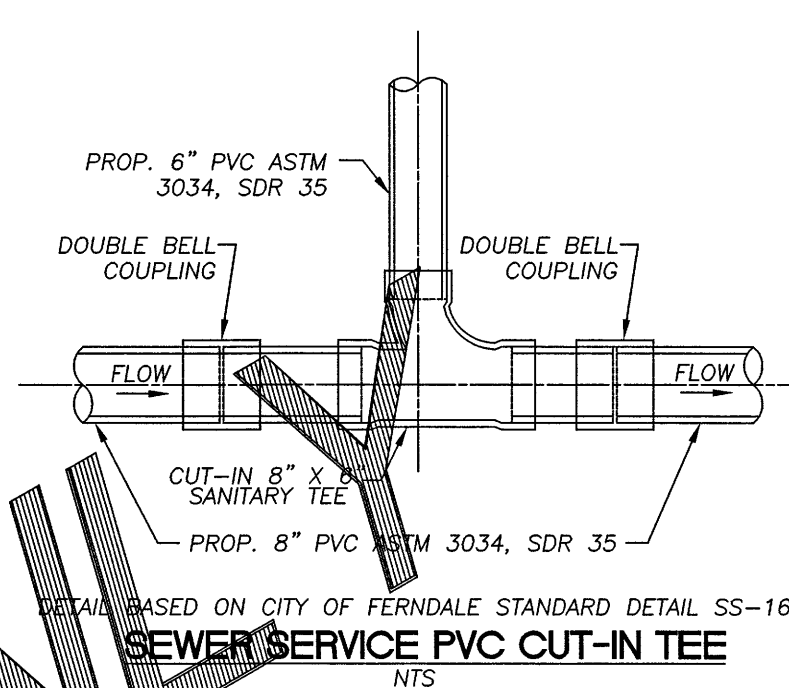

DETAIL BASED ON CITY OF FERDALE STANDARD DETAIL SS-16
SEWER SERVICE PVC CUT-IN TEE
NTS

NO.	REVISION	BY	DATE	NO.	BY	DATE
1	SUBMITTAL 1	RL	04/23/19	1		
2				2		
3				3		
4				4		
5				5		

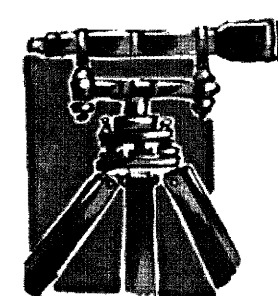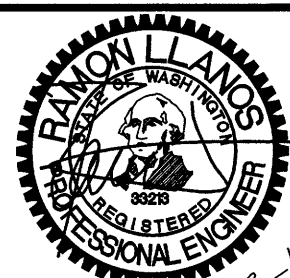

LDES, INC.
5160 INDUSTRIAL PL. #108
FERDALE, WA 98248
PHONE 360-383-0620
FAX 360-383-0639

JOB NO.:	1602
DWG. NAME:	1602-CIVIL-ASB.dwg
DESIGNED BY:	RL
DRAWN BY:	EH
CHECKED BY:	RL

PNRD
PO BOX 3249
FERDALE, WA 98248

APPROVED
JUN 13 2019
CITY OF FERDALE
PUBLIC WORKS DEPARTMENT

SEWER
TYPICAL DETAILS
MAIN STREET VILLAGE
2312 MOUNTAIN VIEW ROAD, FERDALE, WA
A PORTION OF SECTION 30, TOWNSHIP 39N, RANGE 2E, WM.

SHEET
20
OF
20

RECORD DRAWING