




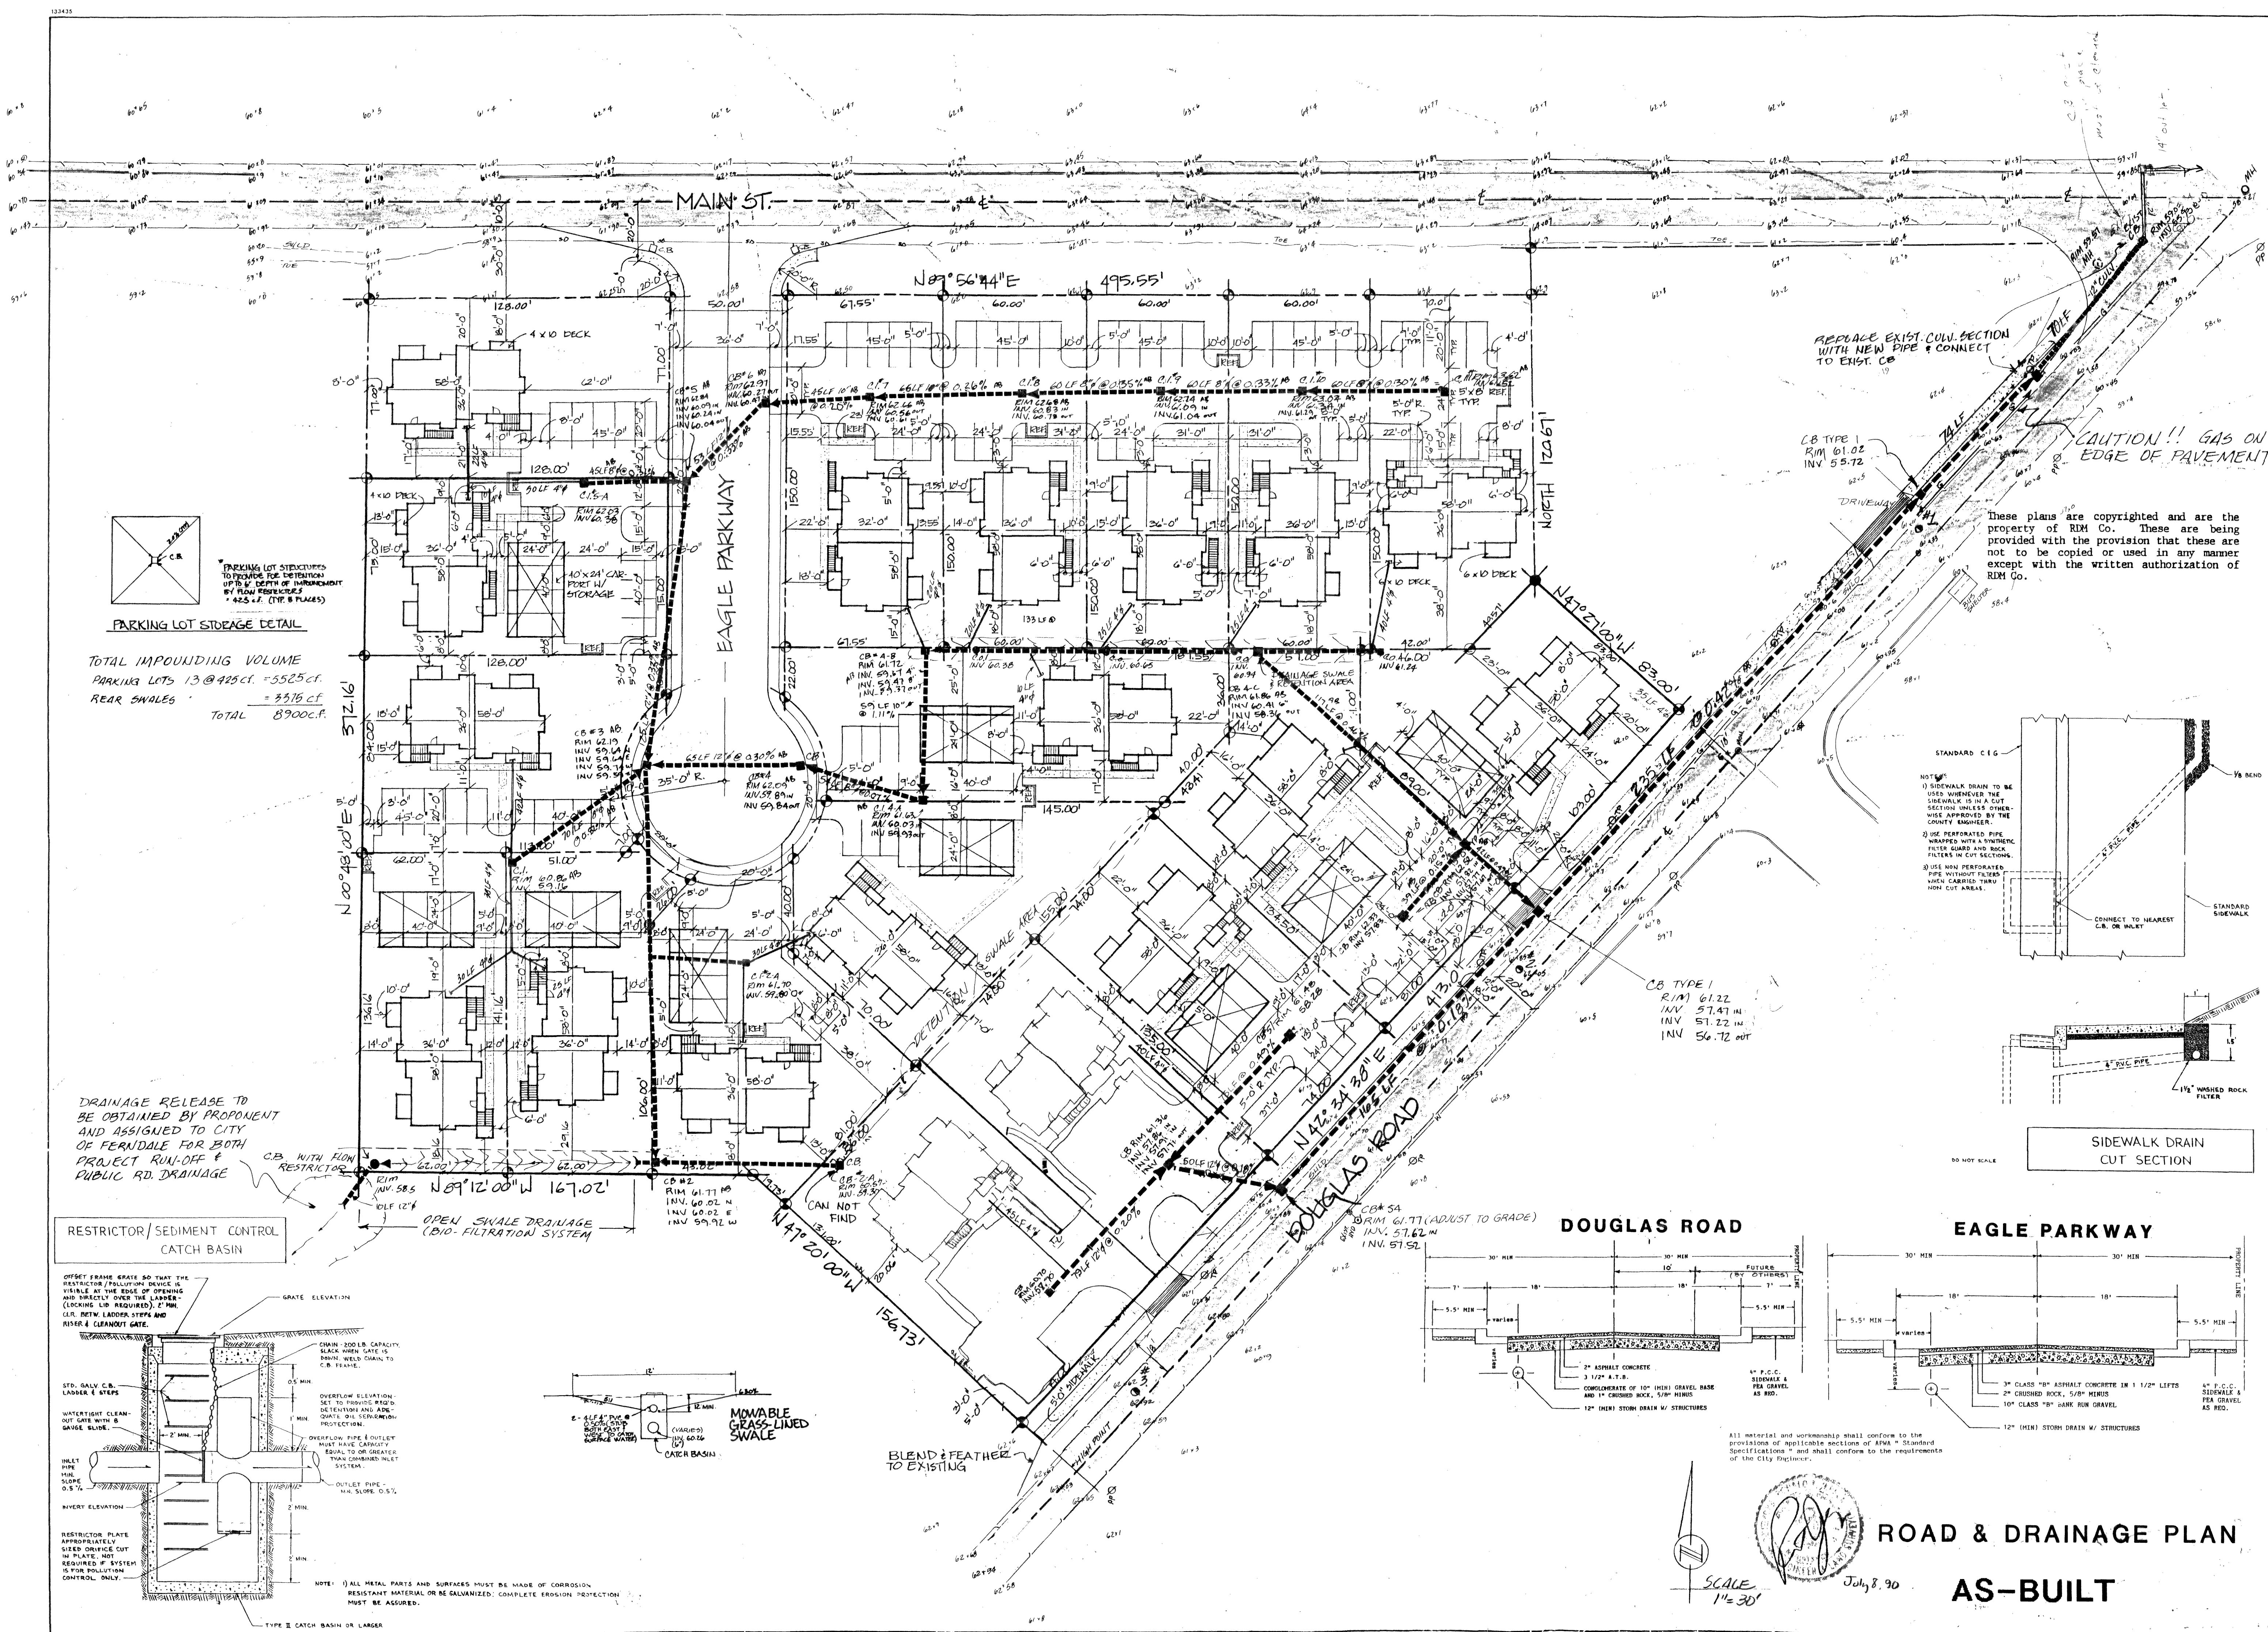

Job No.:	Sheet No.:	Project Title:	Writer:
	1/3	EAGLE PARK APARTMENTS	
Drawn: MUC	Traced:	Approved:	Checked:
Date: 10/22/2010			

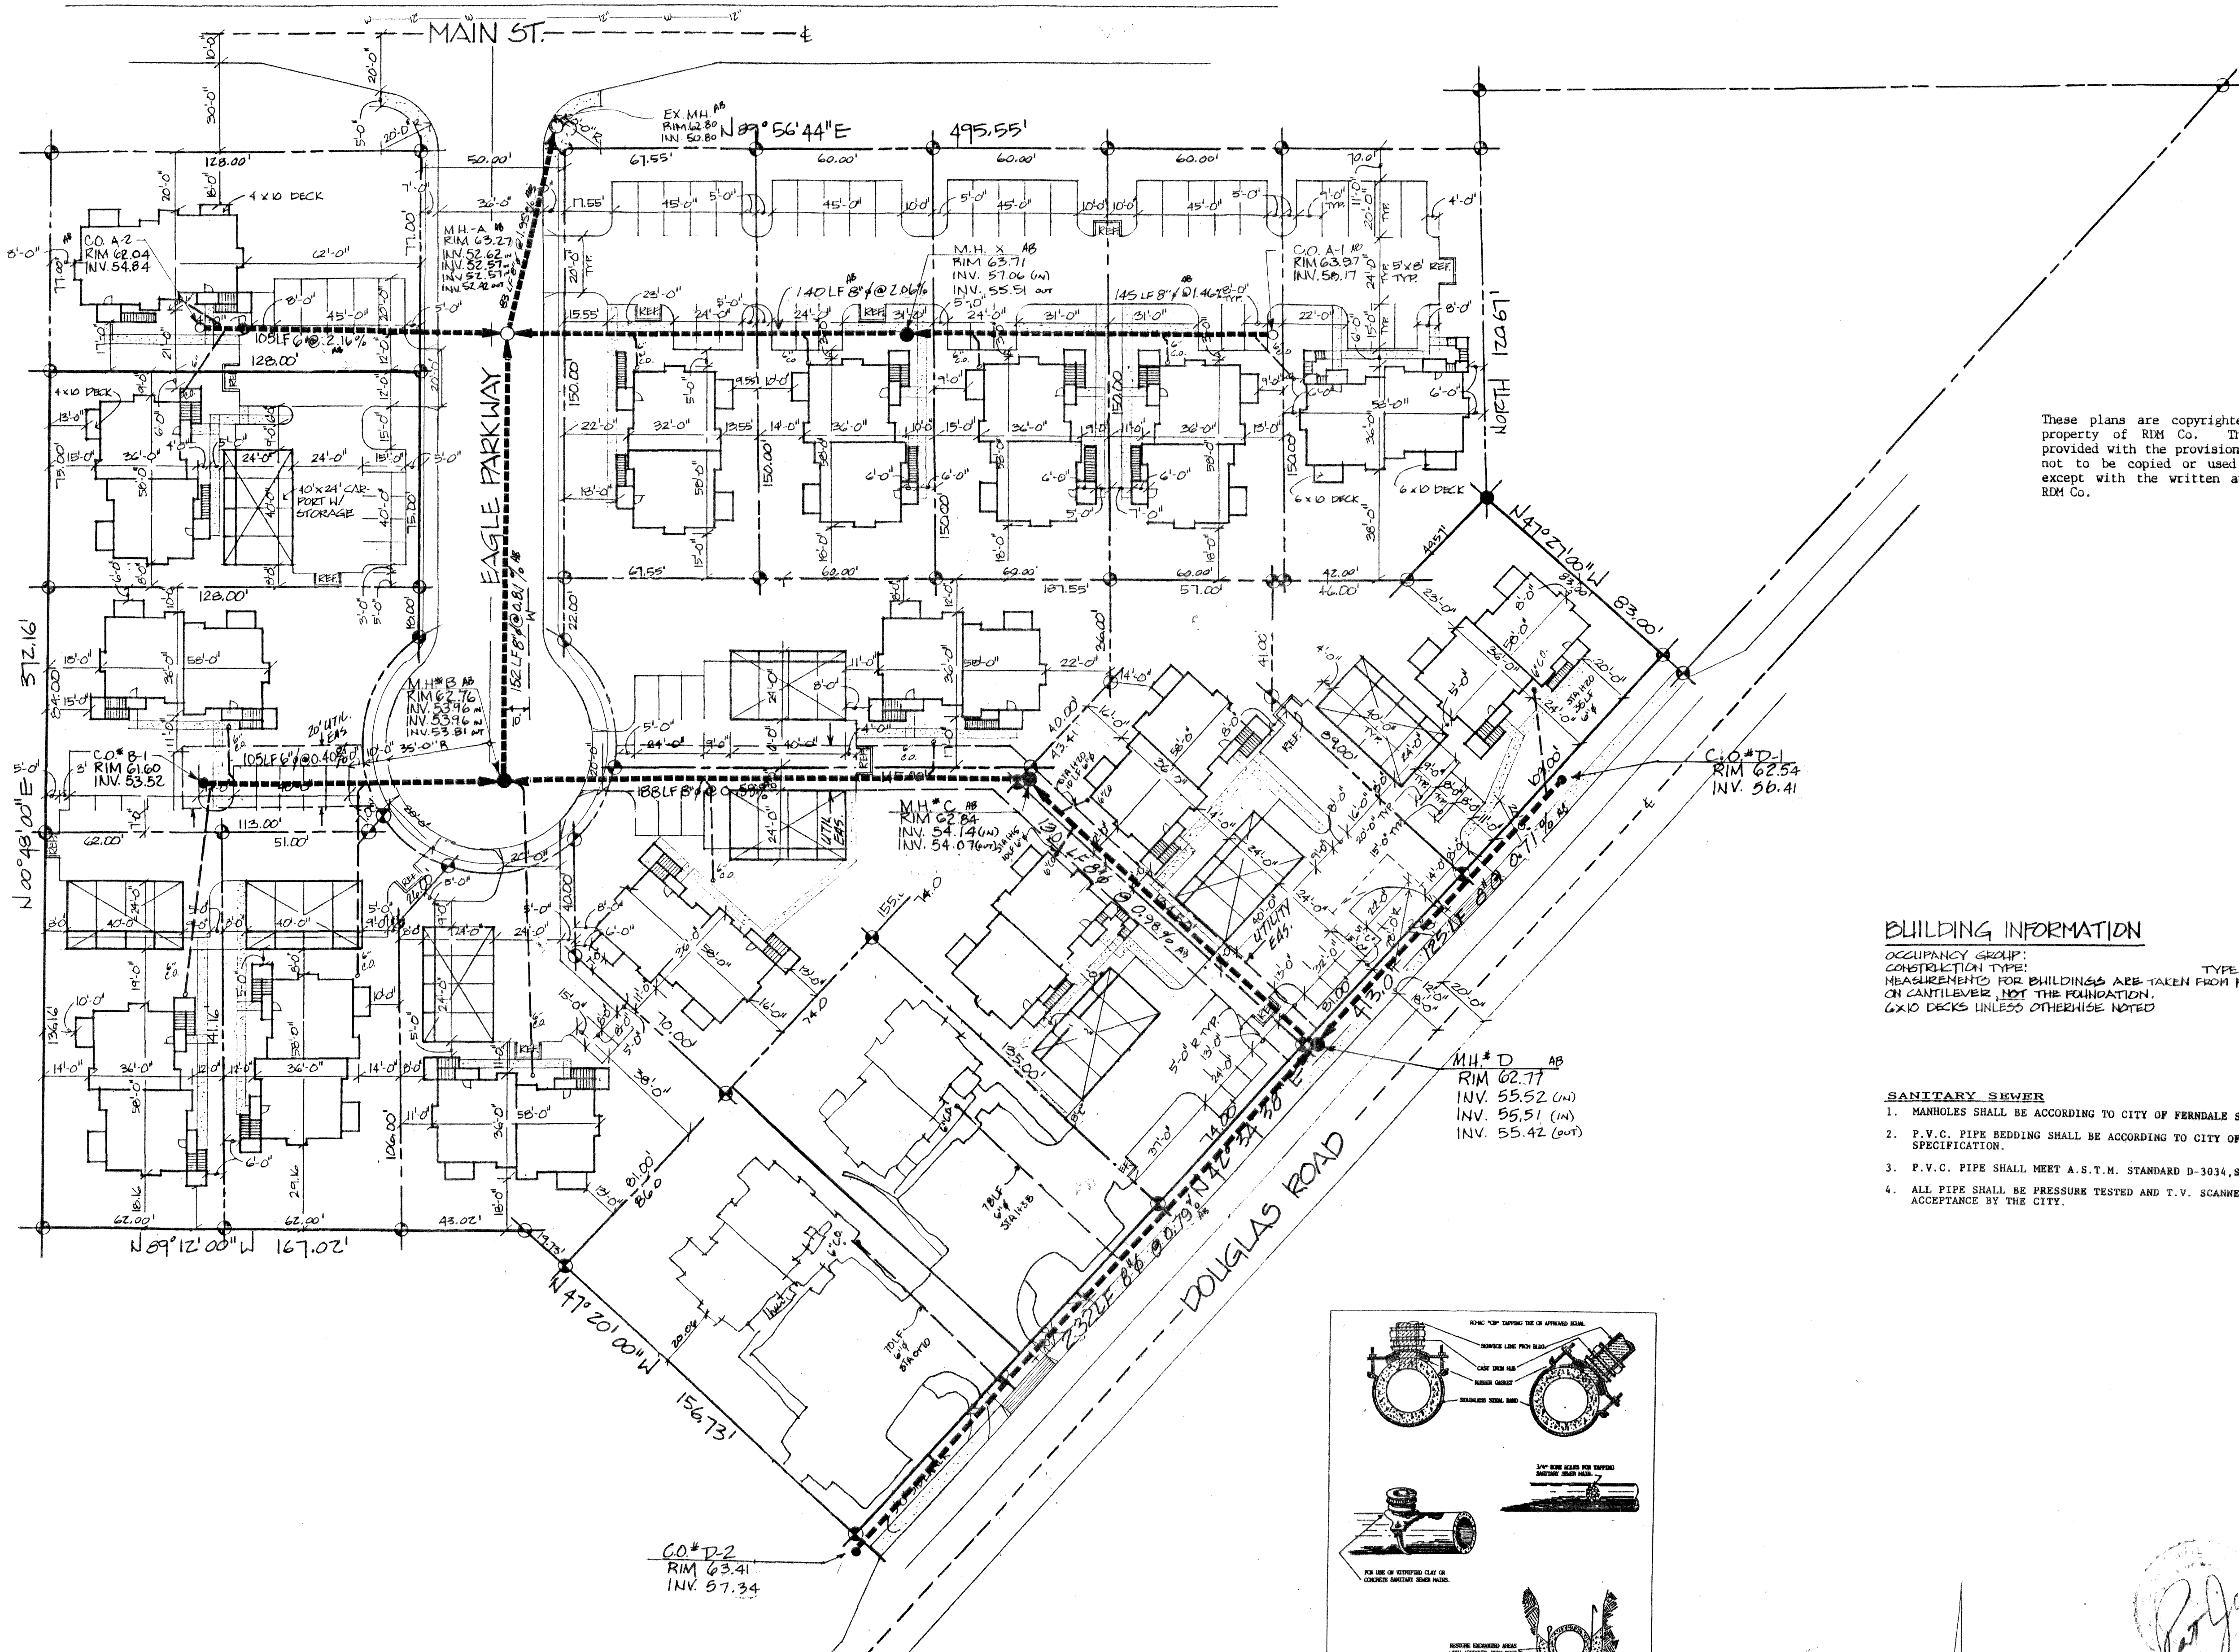

SITE PLAN
SCALE: 1"=30'-0"

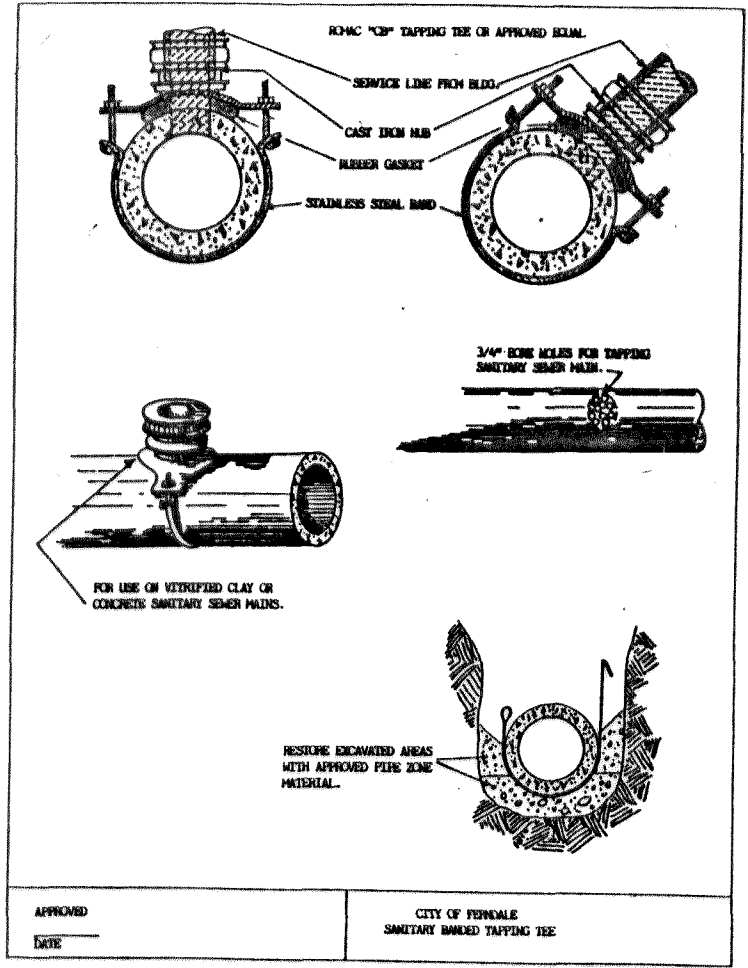


BUILDING INFORMATION

OCCUPANCY GROUP: TYPE II NON-RATED
CONSTRUCTION TYPE: TYPE II NON-RATED
MEASUREMENTS FOR BUILDINGS ARE TAKEN FROM FACE OF WALL
ON CANTILEVER, NOT THE FOUNDATION.
6X10 DECKS UNLESS OTHERWISE NOTED

SANITARY SEWER


1. MANHOLES SHALL BE ACCORDING TO CITY OF FERDALE SPECIFICATION.
2. P.V.C. PIPE BEDDING SHALL BE ACCORDING TO CITY OF FERDALE SPECIFICATION.
3. P.V.C. PIPE SHALL MEET A.S.T.M. STANDARD D-3034, SDR-35 OR EQUAL.
4. ALL PIPE SHALL BE PRESSURE TESTED AND T.V. SCANNED PRIOR TO ACCEPTANCE BY THE CITY.

These plans are copyrighted and are the property of RDM Co. These are being provided with the provision that these are not to be copied or used in any manner except with the written authorization of RDM Co.

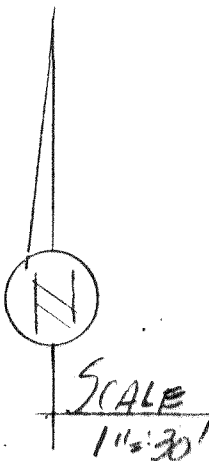

SEWER PLAN
AS-BUILT

Project Title: EAGLE PARK APARTMENTS		Job No.:	
RDM CO. design/build · 322 N. COMMERCIAL SUITE 300 BELLINGHAM, WA. 98225 [206] 733-5109		Sheet No.:	
Owner:		2/3	
Sheet Contents:		Drawn: MUG	
Approvals:		Traced:	
		Checked:	
		Date: MARCH 22, 2000	

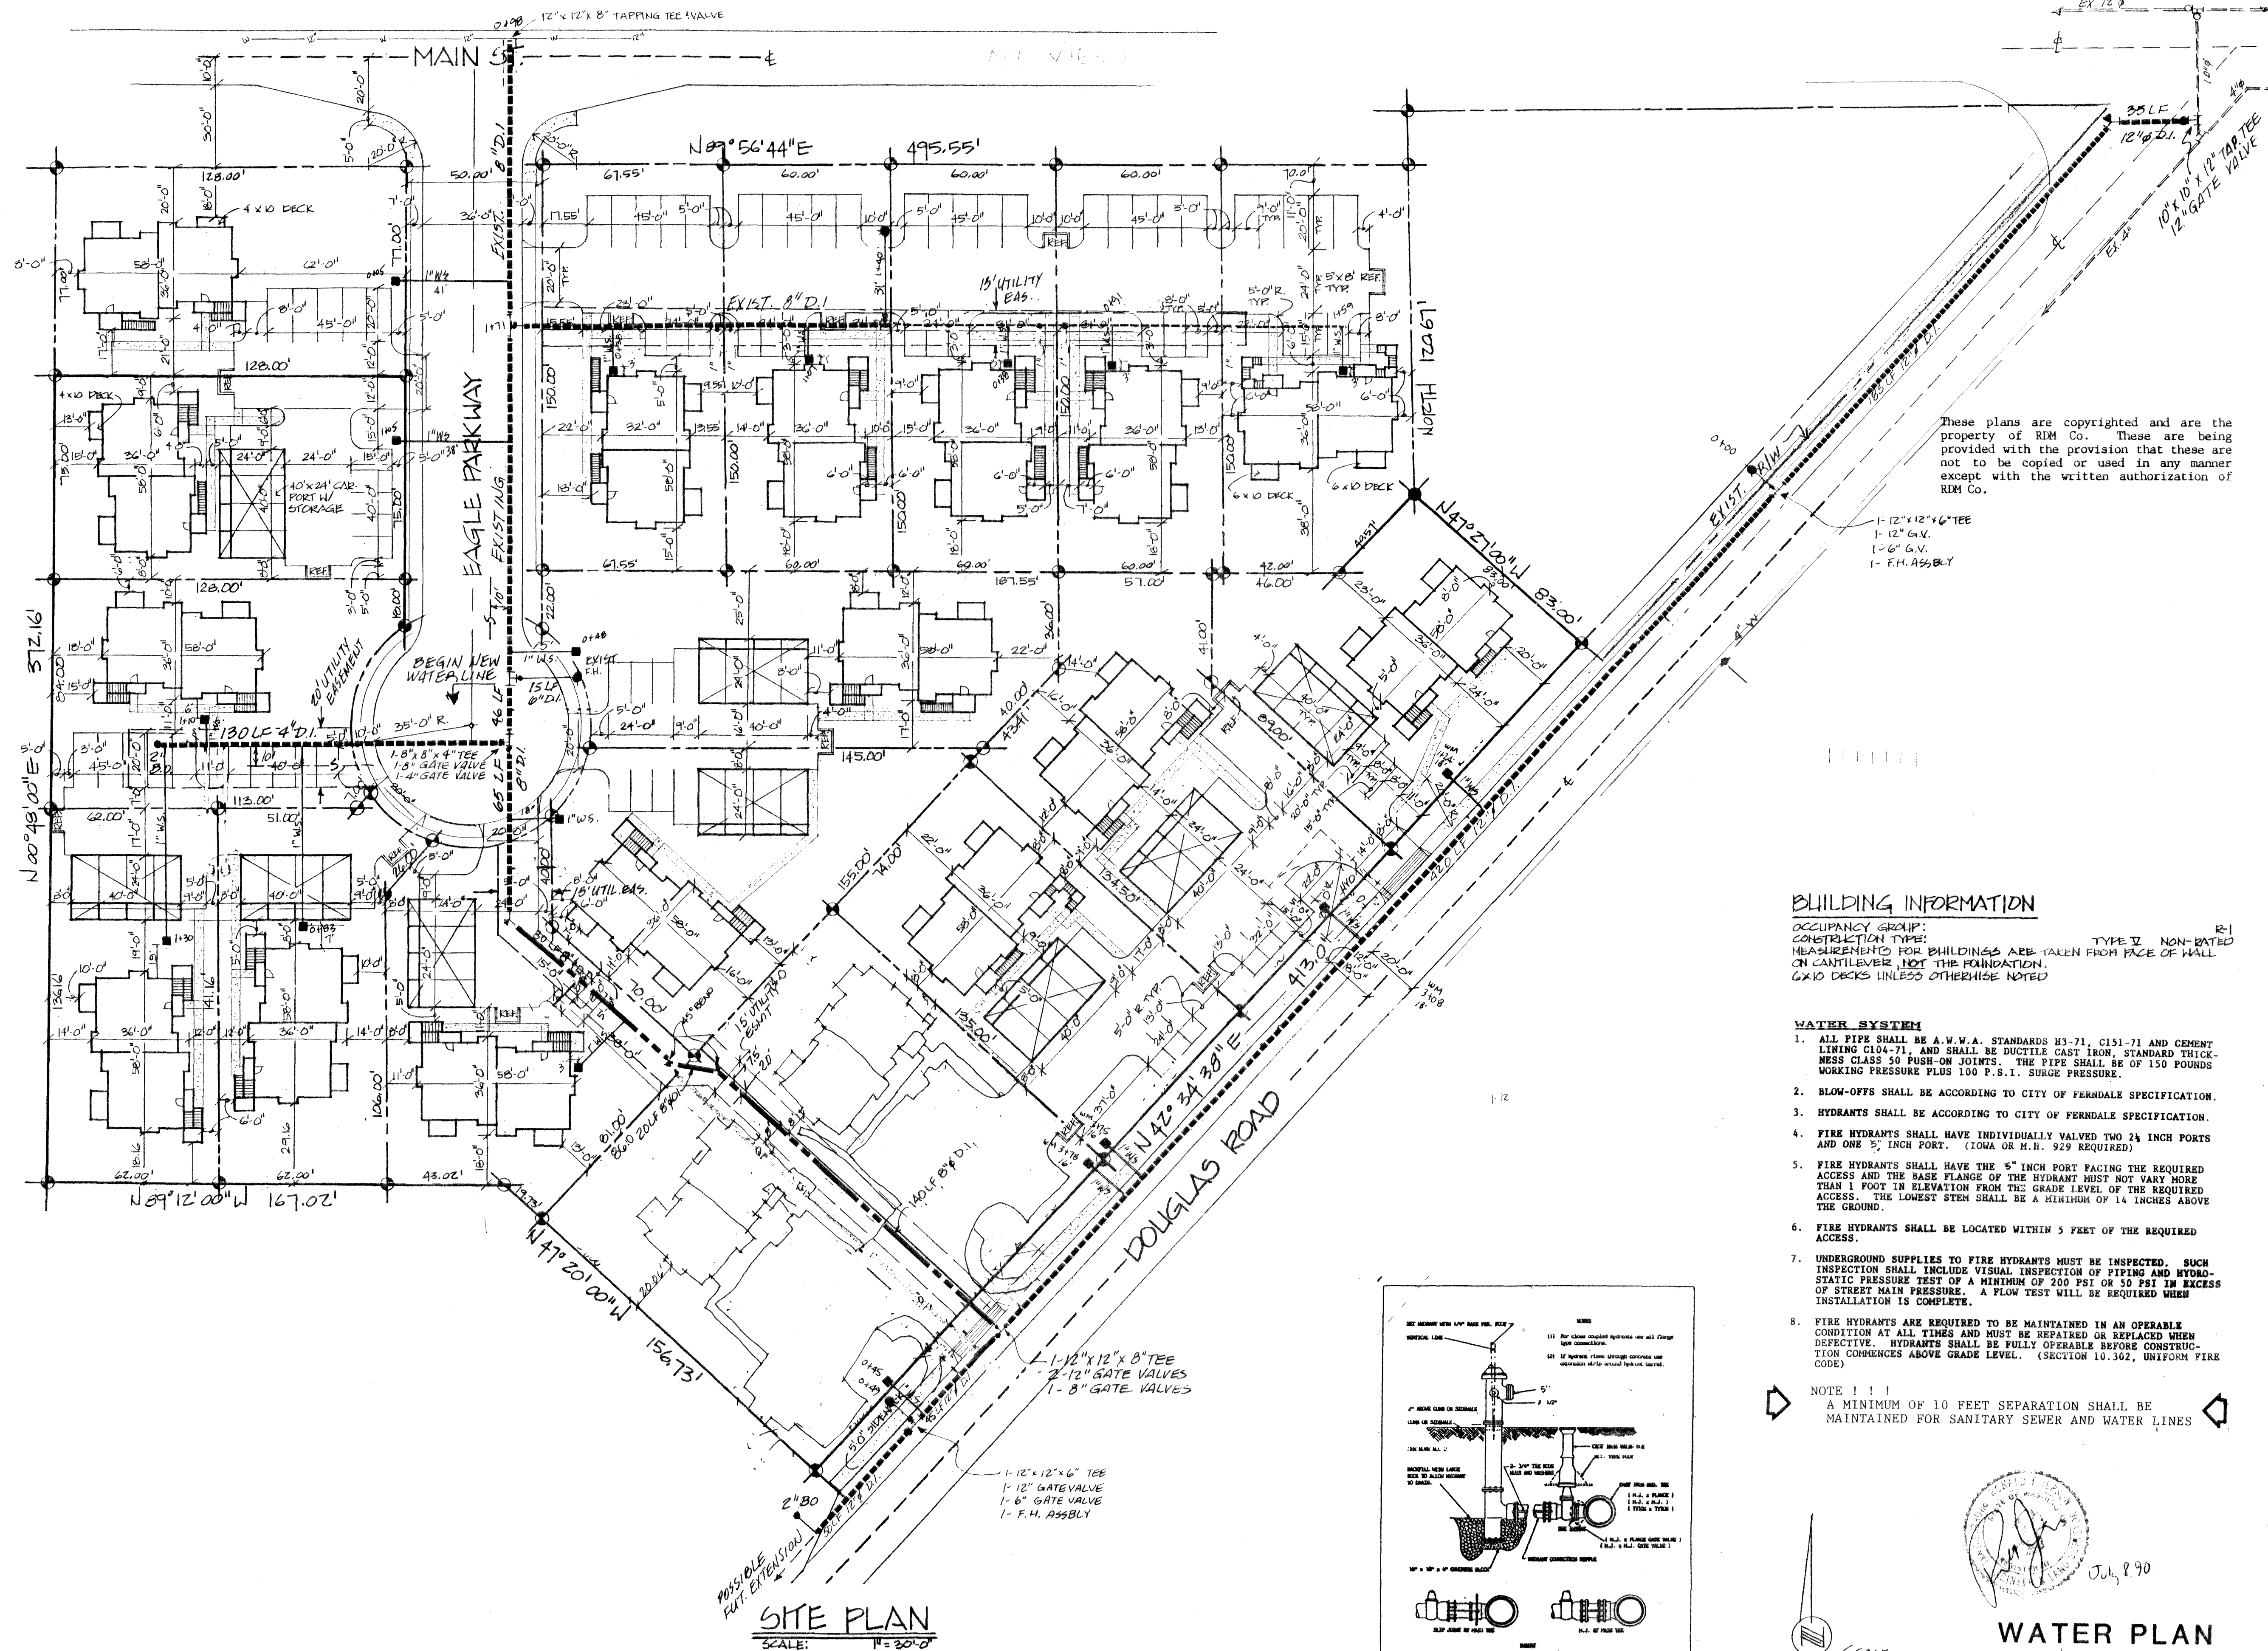

Sheet Contents:

Drawn: HUG	Traced:	Checked:	Date: MARCH 22nd, 90
Approvals:			

Owner:

Project Title: EAGLE PARK APARTMENTS

Job No.:

Sheet No.:

3/3

RDM CO. design/build · 322 N. COMMERCIAL SUITE 300 BELLINGHAM, WA. 98225 (206) 733-5109

00304.003 2-10-90 KR