

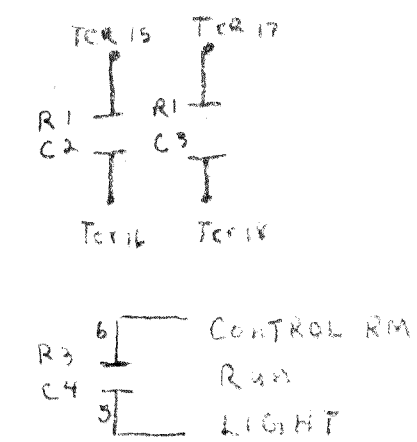


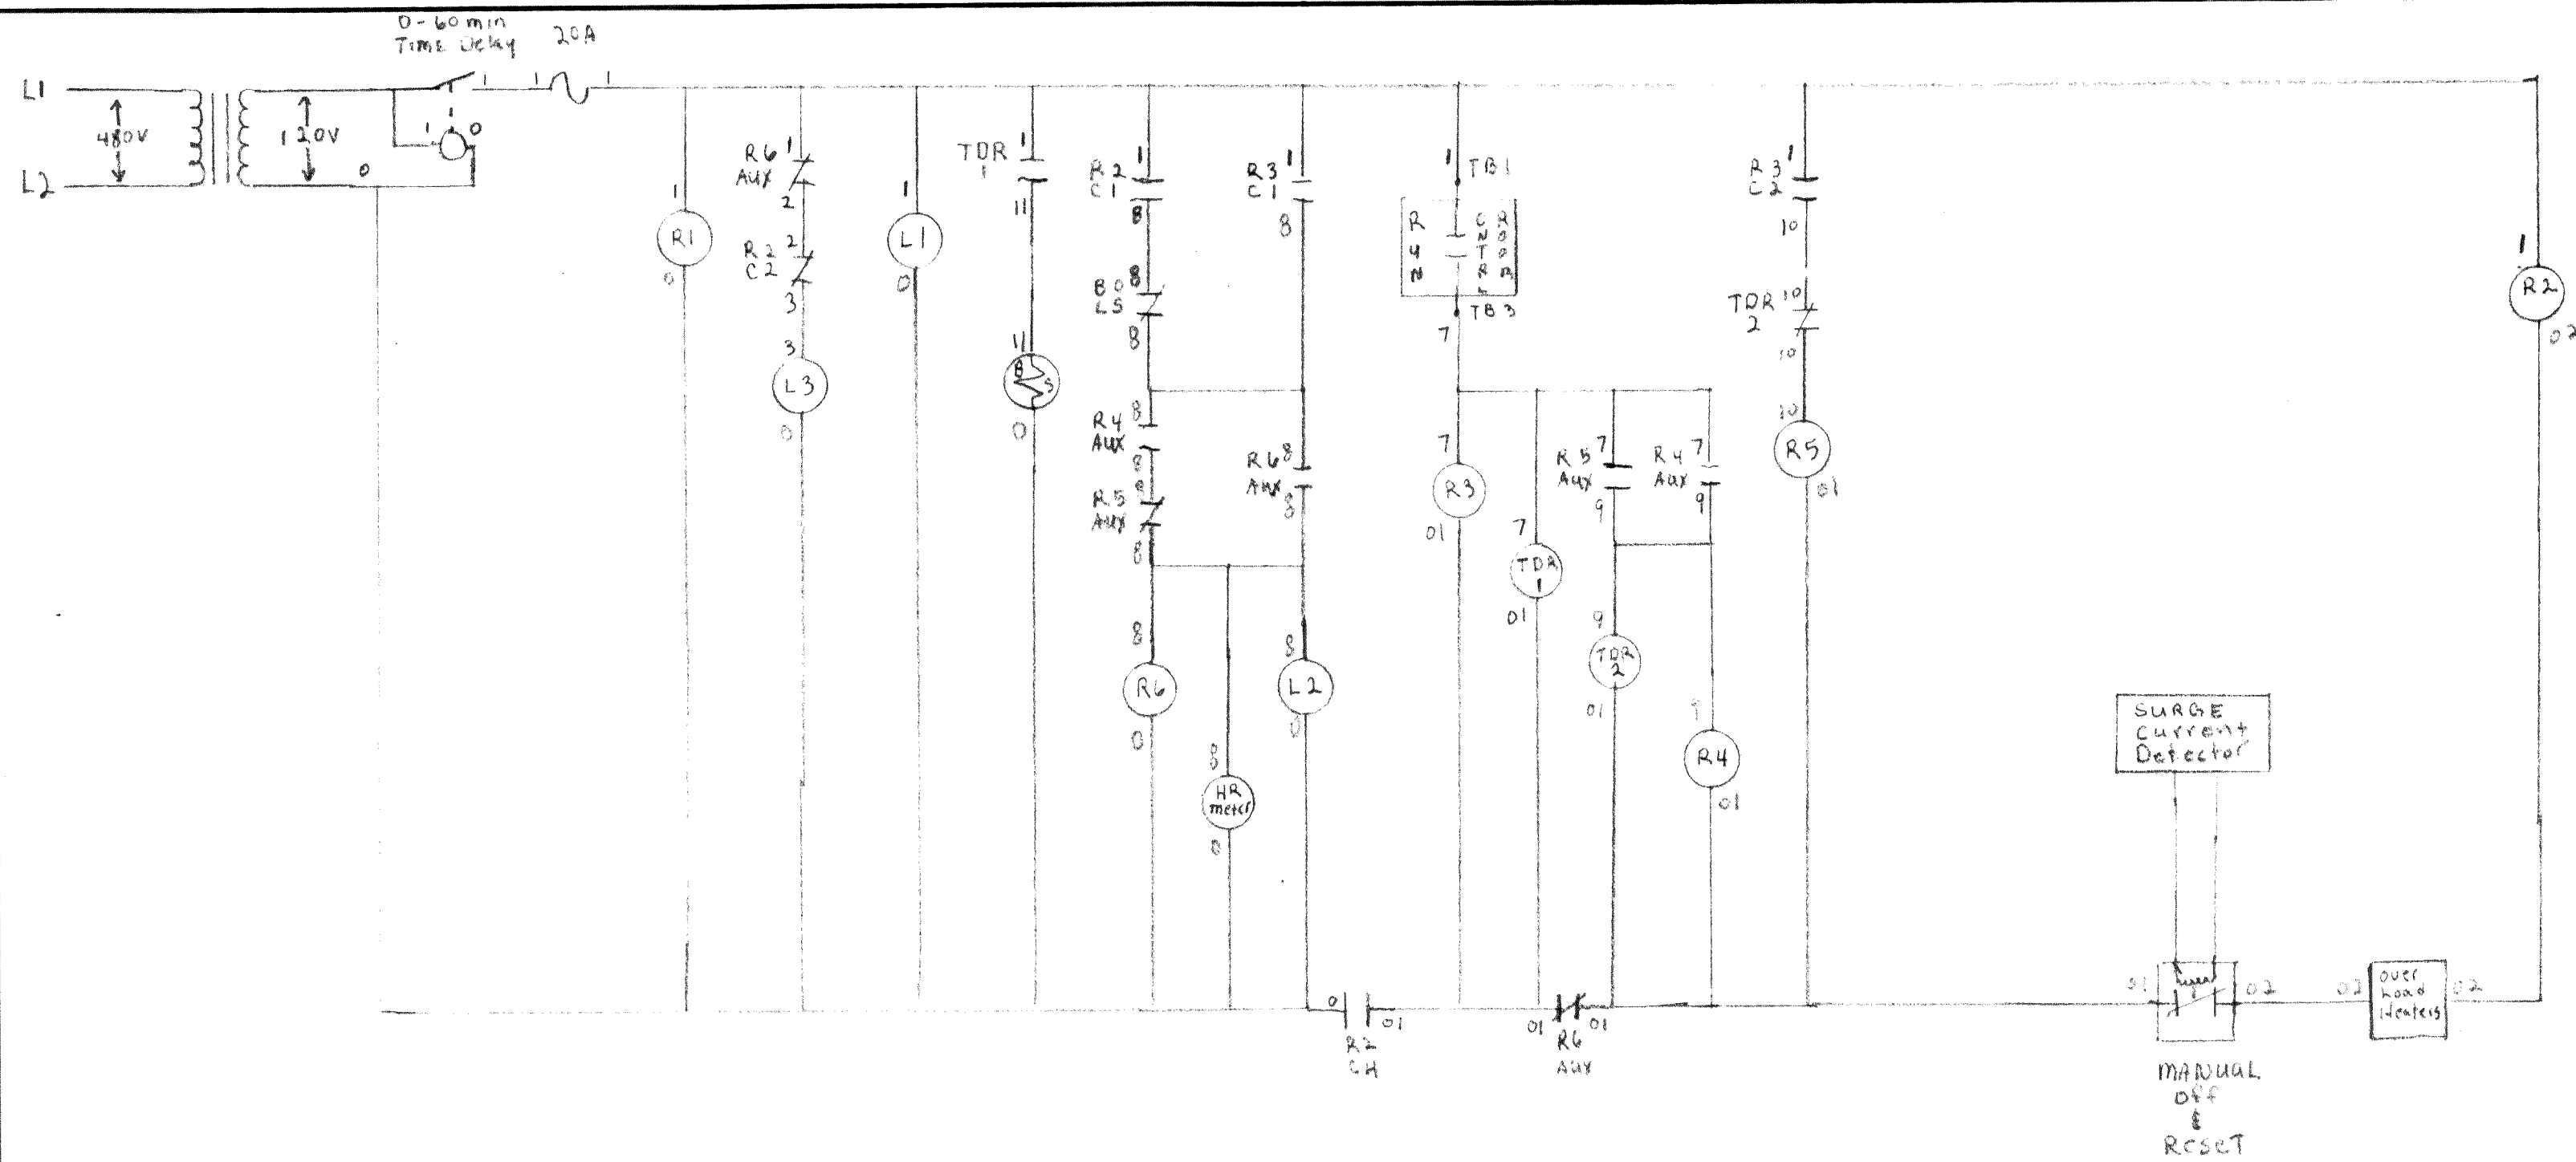

- (R1) COIL Relay 1
- (R2) COIL Relay 2
- (R3) COIL Relay 3
- (R4) COIL Relay 4
- (R5) COIL Relay 5
- (R6) COIL Relay 6
- (L1) AC Available LAMP
- (L2) RUN LAMP
- (L3) FAILURE LAMP
- (HR meter) Hour meter
- (S) Bleed off Solenoid
- (TDR 1) Coil Time Delay Relay 1
- (TDR 2) Coil Time Delay Relay 2
- R1 (Relay 1 C1 (contact 1))
- R6 (Auxiliary Contact Relay 6)
- TB1 (Terminal 1 on Terminal Board)

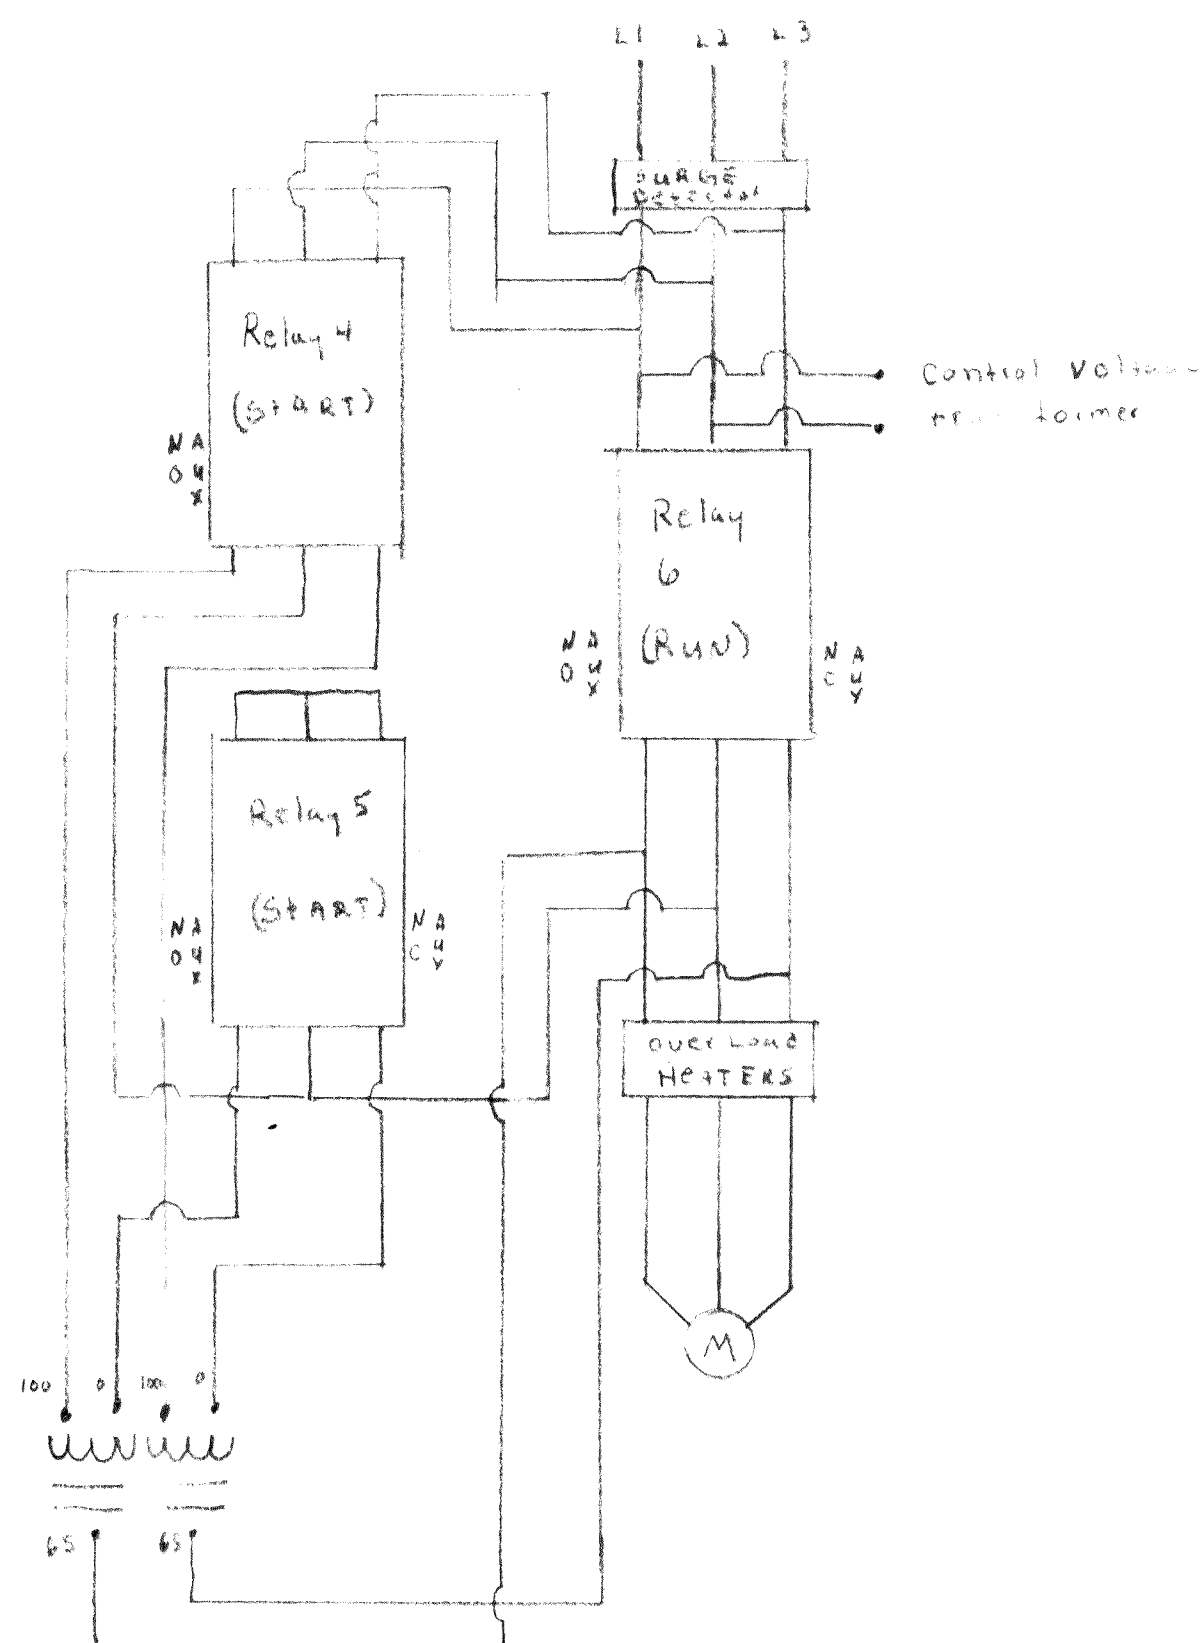

FERNDAL WATER TREATMENT PLANT		
HIGH SERVICE PUMP Control Panels		
SCALE: N/A	APPROVED BY:	DRAWN BY: DRS
DATE: 11 SEPT 86		REVISED:
VALLEY ELECTRIC CO. INC. (206) 424-6602		
1699 BEAVER MARSH RD		
MT. VERNON WA 98273		
AS-BUILTS		DRAWING NUMBER:

00294.001 2-2-06 R2