


RIGHT OF WAY PLAT


CITY OF FERNDALE

SEC. 29, T. 39N., R. 2E. W.M.
WHATCOM COUNTY, WASHINGTON

SCALE: 1" = 400'

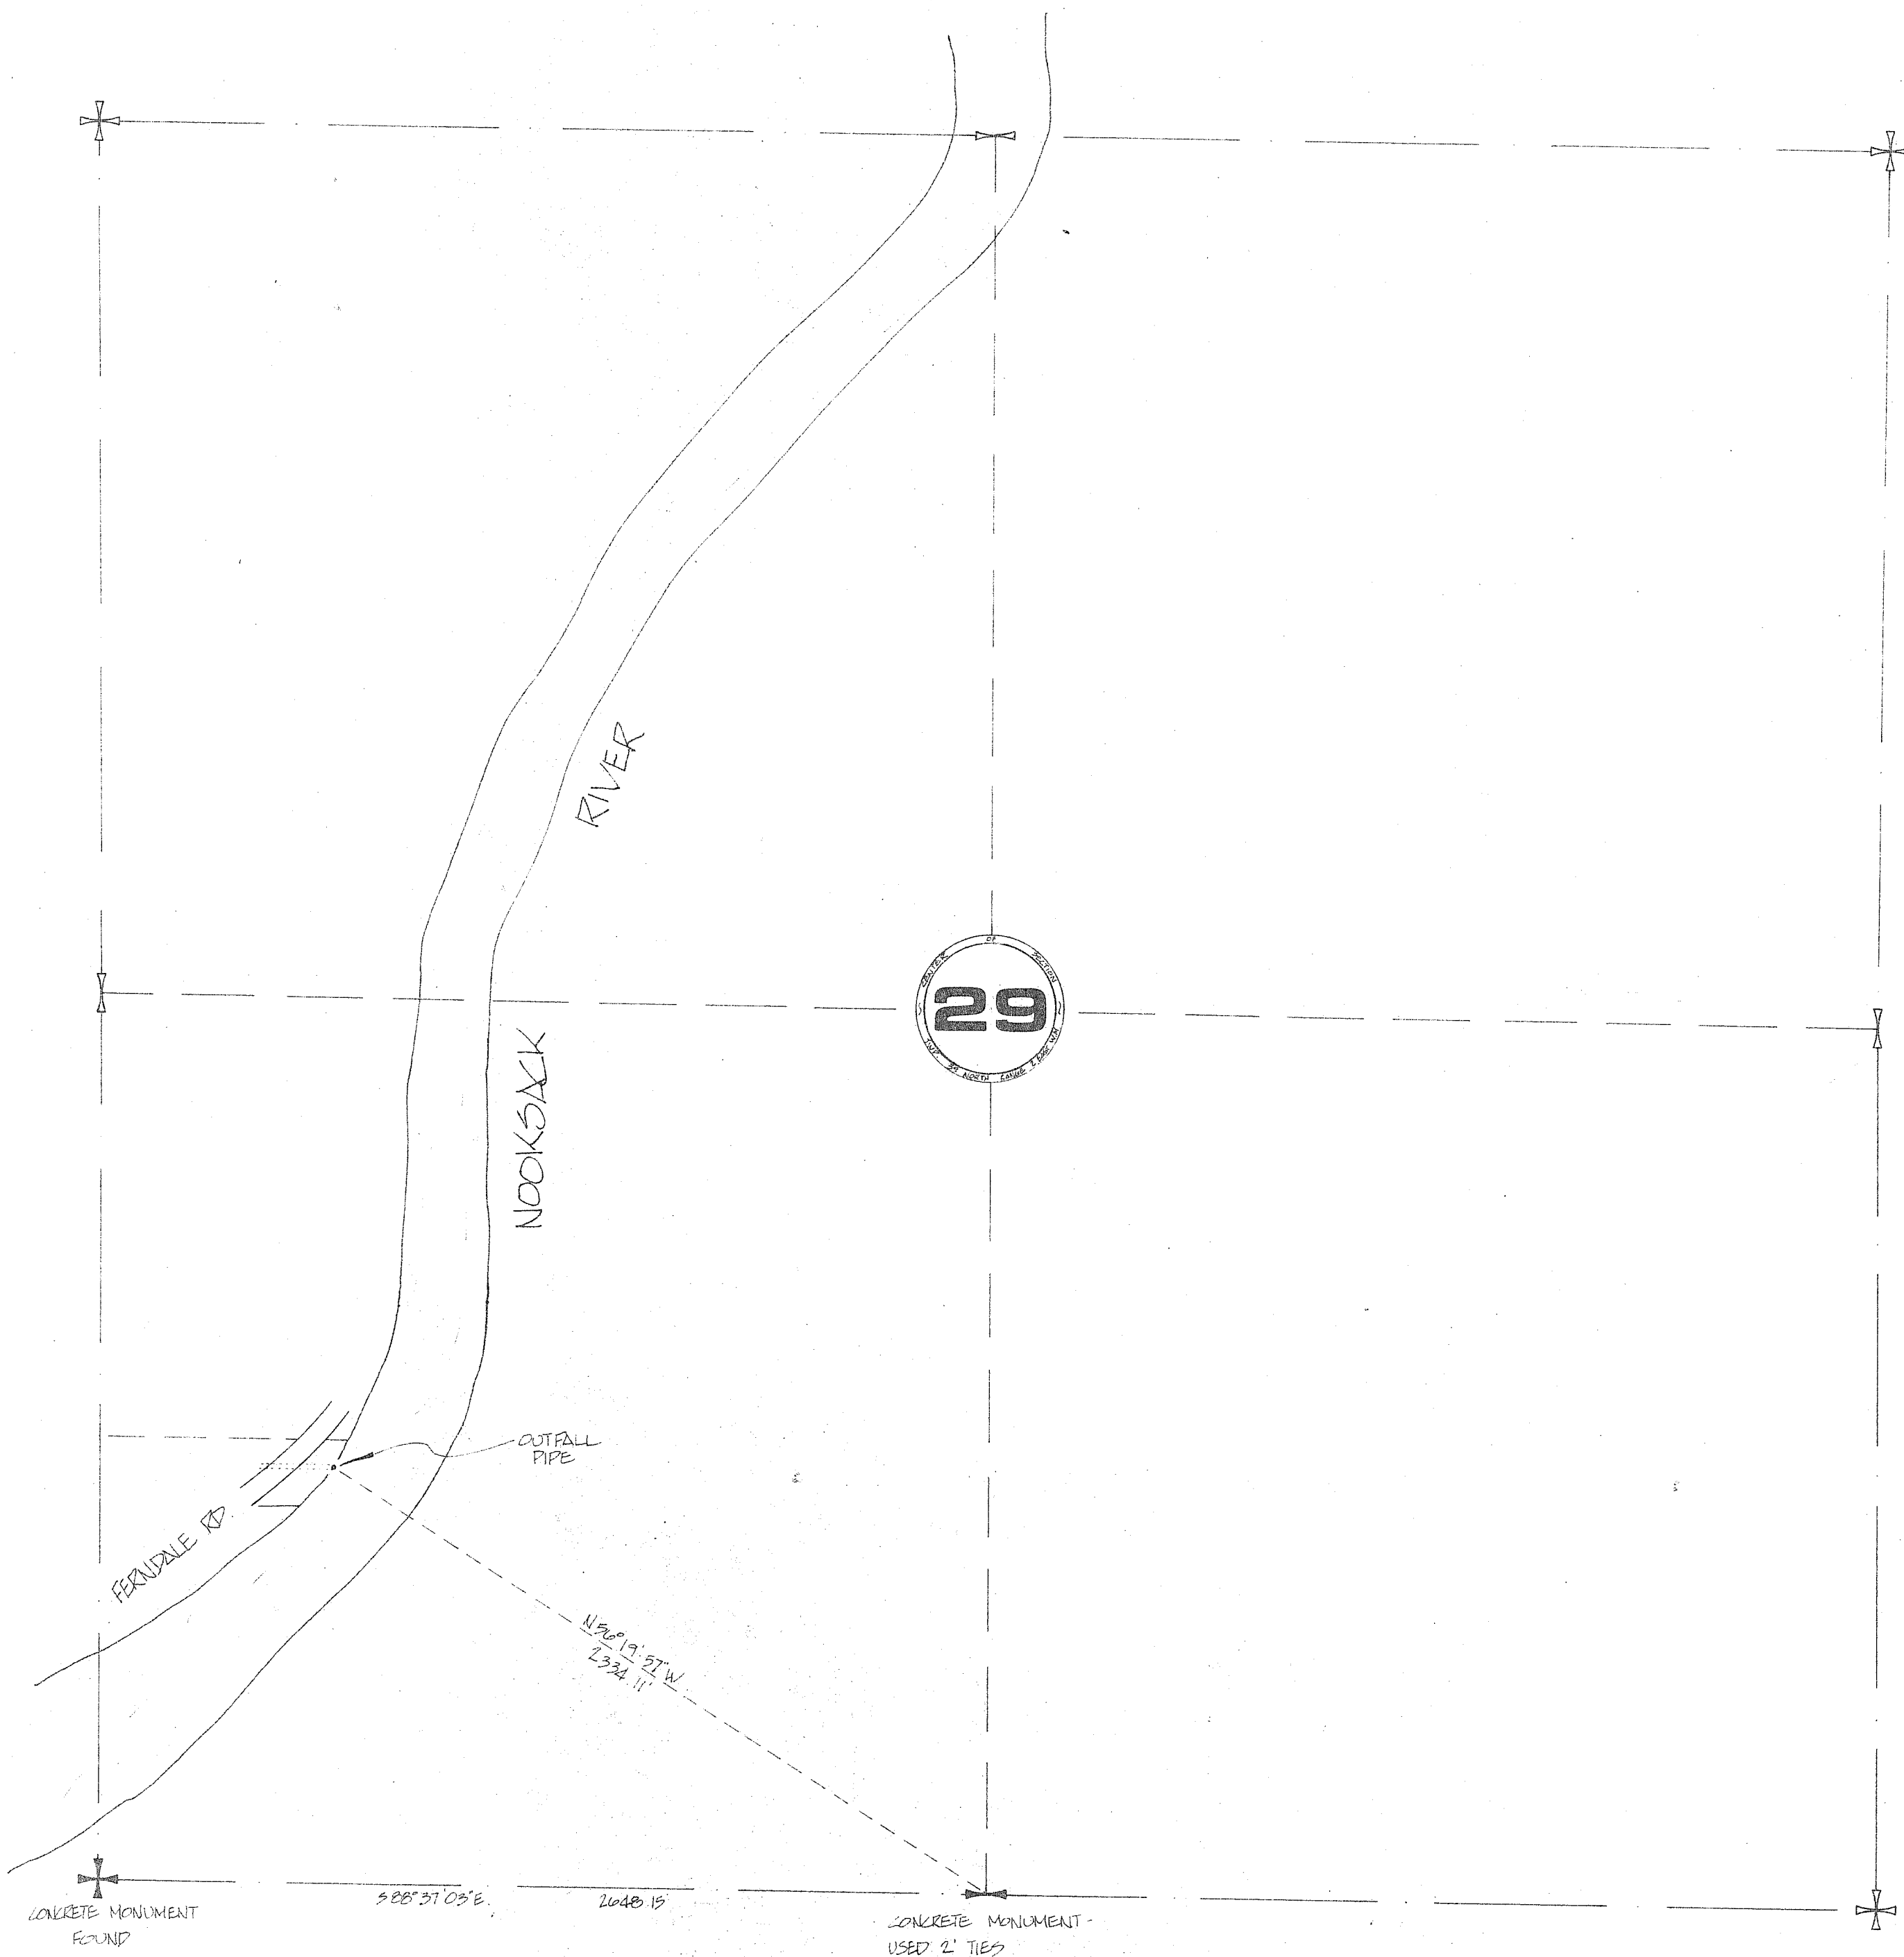

NOTE: LOCATION OF RIVER AND ROAD IS APPROXIMATE

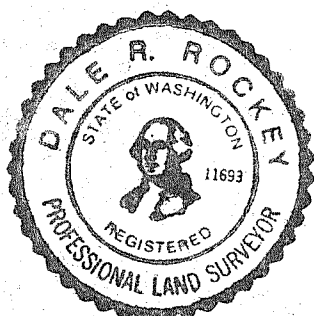

I, DALE R. ROCKY, PLS, DO HEREBY CERTIFY THAT THIS MAP
CORRECTLY REPRESENTS THE LOCATION OF SAID RIGHT OF WAY
IN SECTION 29, TOWNSHIP 39 NORTH, RANGE 2 EAST
OF W.M.

Dale R. Rocky
DALE R. ROCKY, PLS