


CENTENNIAL RIVERWALK

CITY OF FERNDALE

00377.001 1.5.09 KR

VICINITY MAP NTS

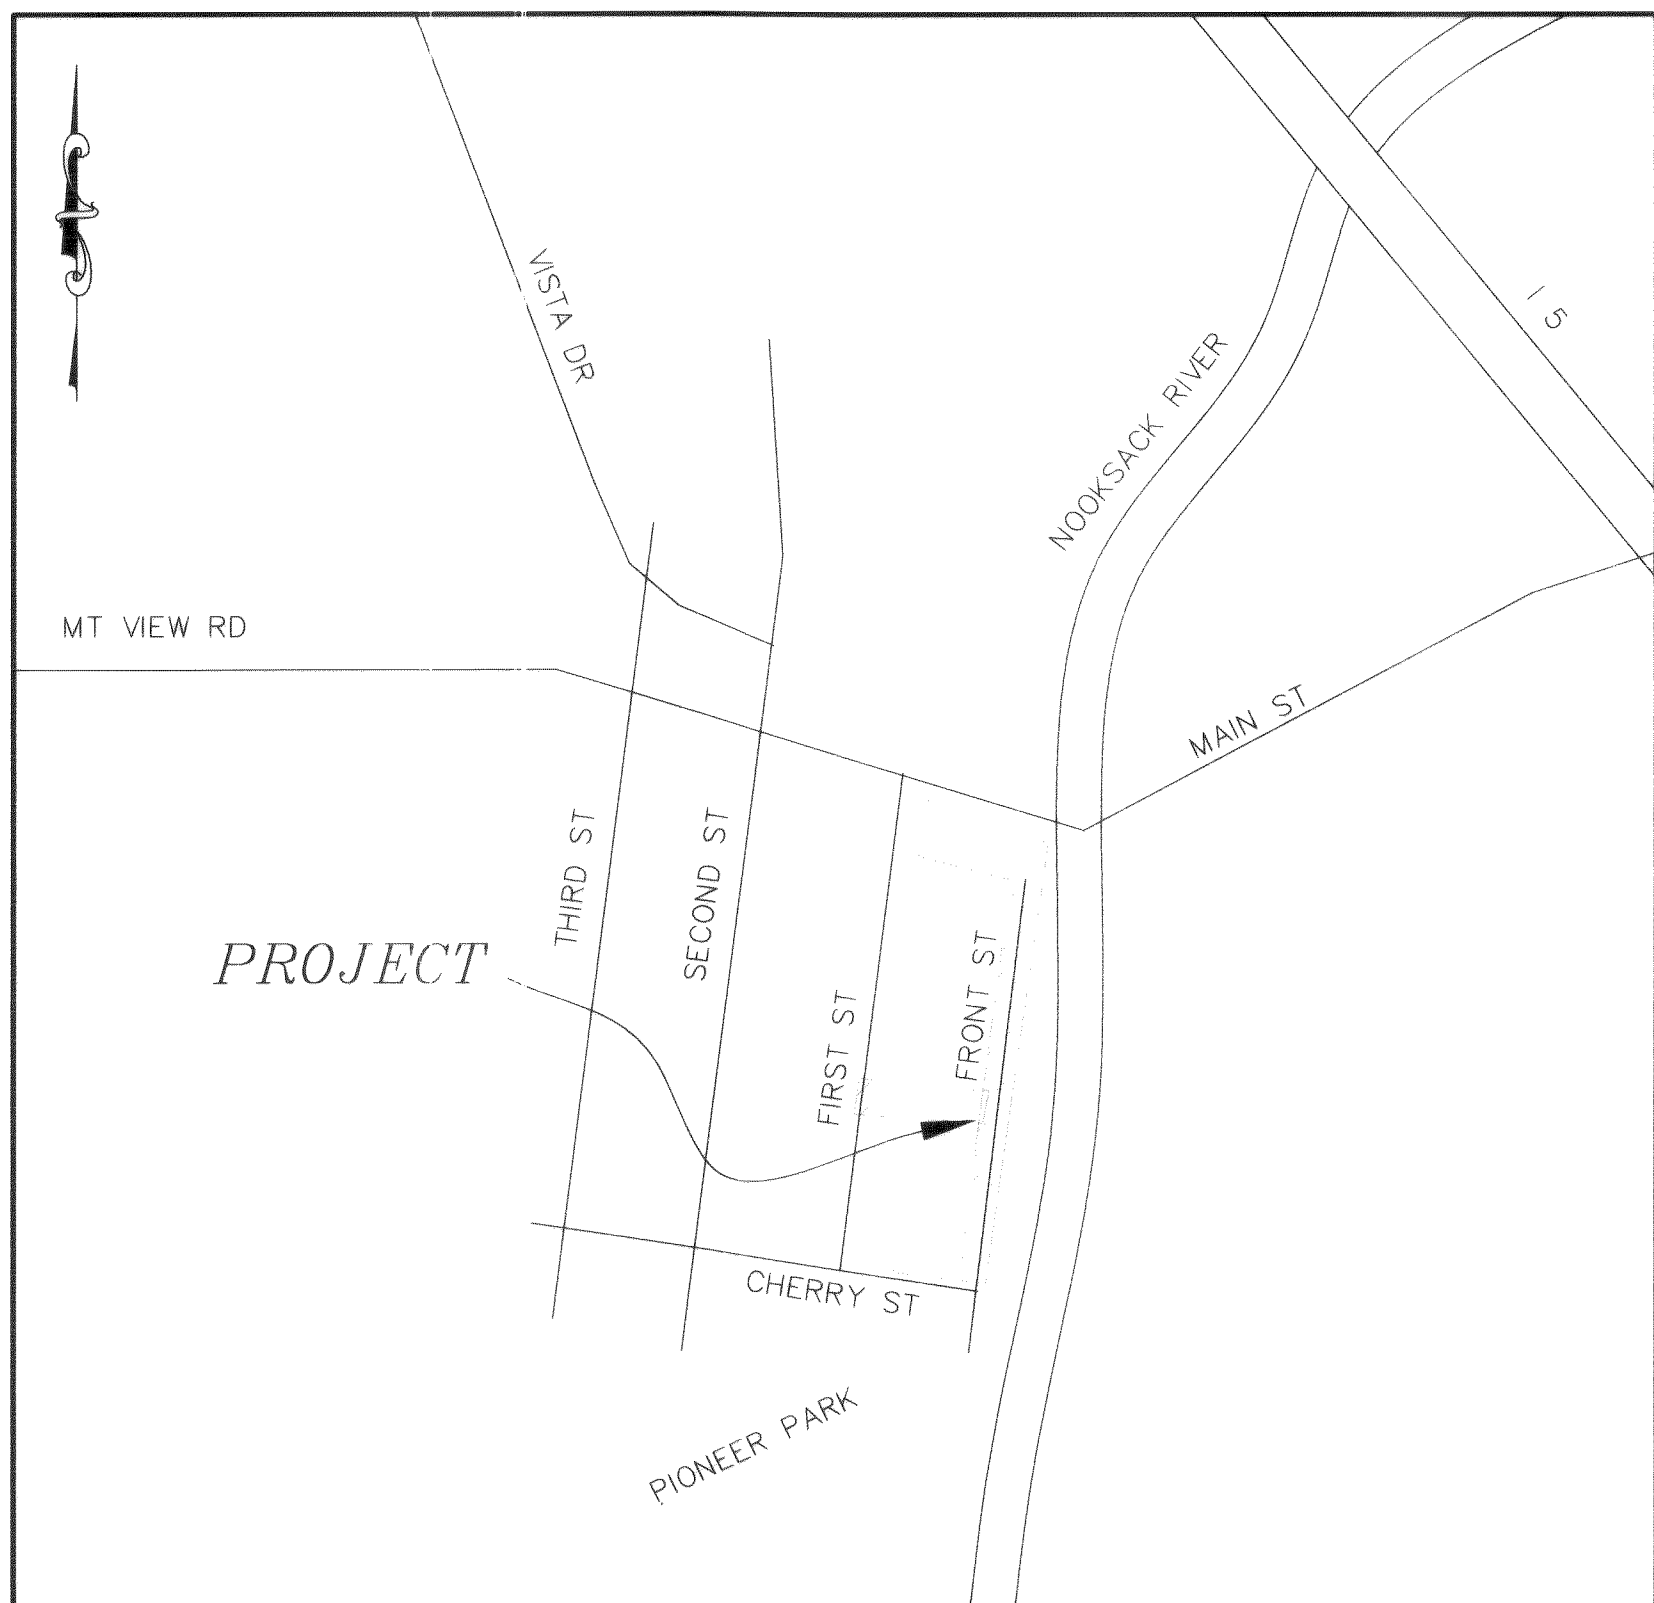

SHEET INDEX

- C1.) COVER SHEET
- C2.) CHERRY STREET IMPROVEMENTS
- C3.) FRONT STREET IMPROVEMENTS
- C4.) FRONT STREET IMPROVEMENTS
- C5.) MAPLE STREET IMPROVEMENTS
- C6.) EROSION CONTROL PLAN
- C7.) TYPICAL CROSS SECTIONS
- C8.) DETAILS AND GENERAL NOTES
- L1-L13) LANDSCAPE PLANS
- FL-01) FOUNTAIN LAYOUT
- FD-01) FOUNTAIN DETAILS
- I1-I7) IRRIGATION PLANS
- E1) ELECTRICAL PLAN - SOUTH
- E2) ELECTRICAL PLAN - NORTH
- E3) ELECTRICAL DETAILS
- C1) RIVER WALK PLACE PLANS

LEGEND

---	PROPOSED SAWCUT
=====	PROPOSED ROCKWALL
■	PROPOSED STORM DRAIN CATCH BASIN
---	PROPOSED STORM DRAIN
SD	PROPOSED STORM CLEANOUT
■	PROPOSED CATCH BASIN TYPE II
SS	PROPOSED SANITARY SEWER
●	PROPOSED SEWER MANHOLE
●	PROPOSED SEWER CLEANOUT
W	PROPOSED WATERMAIN
+	PROPOSED HYDRANT
+	PROPOSED WATER METER
+	PROPOSED WATER VALVE
+	PROPOSED REPAIR COUPLER
---	PROPOSED SIDEWALK
■	PROPOSED JBOX
---	PROPOSED CONDUIT

AS-BUILT NOTE

AS-BUILTS FOR ELECTRICAL, MECHANICAL, AND IRRIGATION COMPONENTS OF THESE PLANS HAVE BEEN SUPPLIED BY THE CONTRACTOR AND WERE INCLUDED IN OPERATION AND MAINTENANCE MANUALS SUBMITTED TO CITY STAFF. LOCATIONS OF STREET FURNITURE AND LANDSCAPING WERE ADJUSTED DURING CONSTRUCTION AND ARE NOT ACCURATELY SHOWN ON THESE DRAWINGS.

5-14-08

14328
PROFESSIONAL ENGINEERING
EXPIRES JUNE 15, 2008

DESIGNED BY
LL
DRAWN BY
LMC
CHECKED BY



REICHHARDT & EBE
ENGINEERING, INC.
CONSULTING ENGINEERS

PO Box 978 423 Front St., Ste 201
Lynden, Washington 98264

Ph (360) 354-3687
Fax (360) 354-0407



NO.	DATE	REVISION	BY


CITY OF FERNDALE
2095 MAIN STREET
FERNDALE, WA 98248

CENTENNIAL RIVERWALK
COVER SHEET

JOB# / DWG
05012 SP1
SCALE
H: N/A V: N/A


DATE
5-4-07
SHEET
C1 of C8

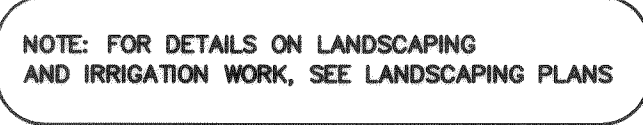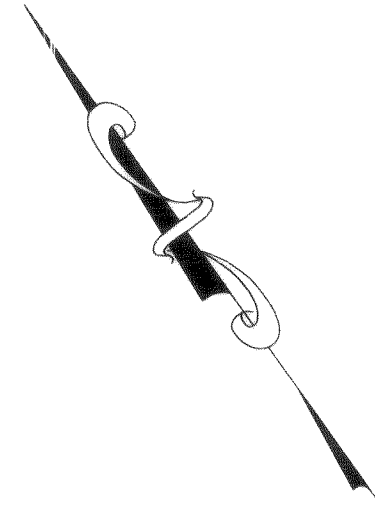


DESIGNED BY LL		REICHHARDT & EBE					CITY OF FERDALE	CENTENNIAL RIVERWALK	JOB# / DWG	DATE
DRAWN BY LMC		<i>ENGINEERING, INC.</i>					2095 MAIN STREET	CHERRY STREET IMPROVEMENTS	05012 SP1	5-4-07
CHECKED BY		CONSULTING ENGINEERS					FERDALE, WA 98246		SCALE	SHEET
		PO Box 978 423 Front St., Ste 201 Lynden, Washington 98264	Ph (360) 354-3687 Fax (360) 354-0407	NO.	DATE	REVISION	BY		H: 1" = 20' V: N/A	C2 of C8


00377.002 1.5.09 KR

00377.003 1:5:09 KR

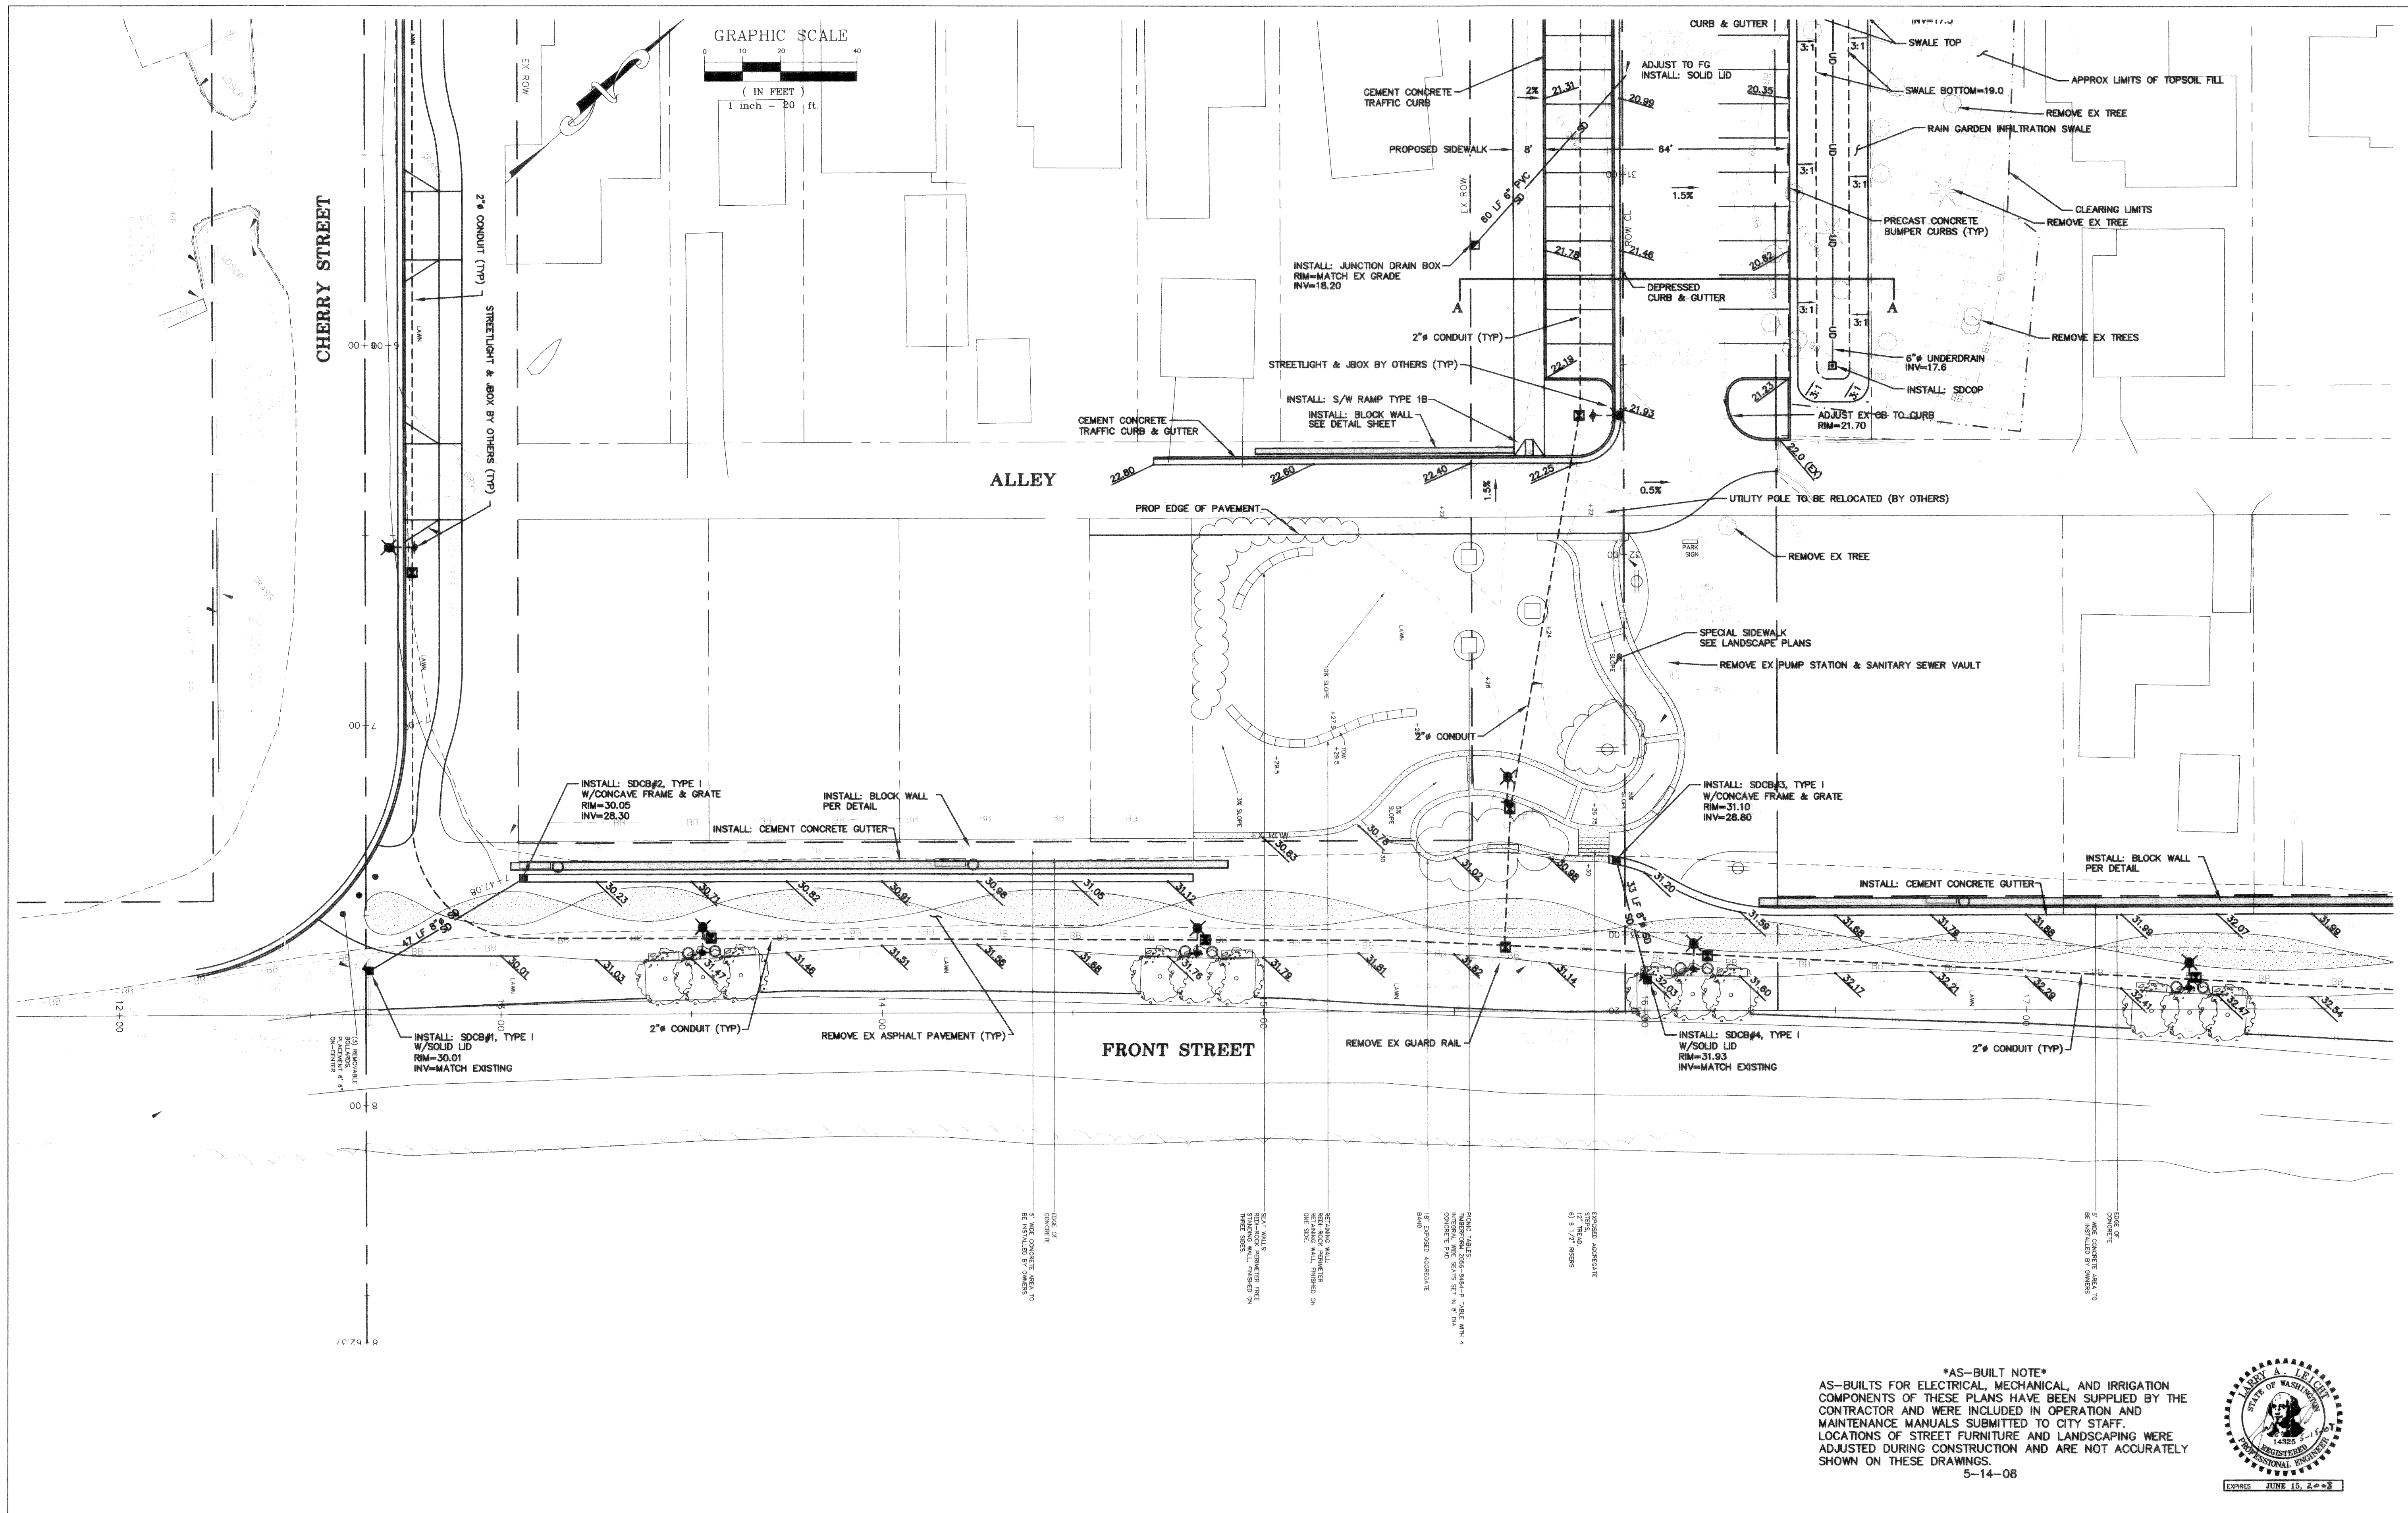


AS-BUILT NOTE
AS-BUILTS FOR ELECTRICAL, MECHANICAL, AND IRRIGATION COMPONENTS OF THESE PLANS HAVE BEEN SUPPLIED BY THE CONTRACTOR AND WERE INCLUDED IN OPERATION AND MAINTENANCE MANUALS SUBMITTED TO CITY STAFF. LOCATIONS OF STREET FURNITURE AND LANDSCAPING WERE ADJUSTED DURING CONSTRUCTION AND ARE NOT ACCURATELY SHOWN ON THESE DRAWINGS.
5-14-08

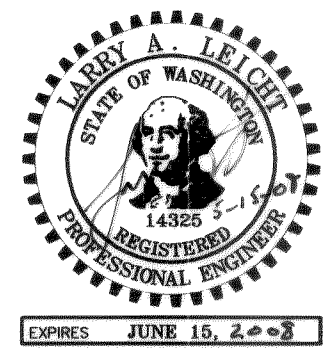


DESIGNED BY LL		 <div>REICHHARDT & EBE <i>ENGINEERING, INC.</i> <small>CONSULTING ENGINEERS</small> PO Box 978 423 Front St., Ste 201 Ph (360) 354-3687 Lynden, Washington 98264 Fax (360) 354-0407</div>	1 6-28-07 REVISE WALLS, GRADES		LL	CITY OF FERDALE 2095 MAIN STREET FERDALE, WA 98248	CENTENNIAL RIVERWALK FRONT STREET IMPROVEMENTS	JOB# / DWG 05012 SP1	DATE 6-27-07
DRAWN BY LMC			NO. DATE REVISION					SCALE H: 1"=20' V: N/A	SHEET C3 of C8
CHECKED BY									

00377.004 15.09.12

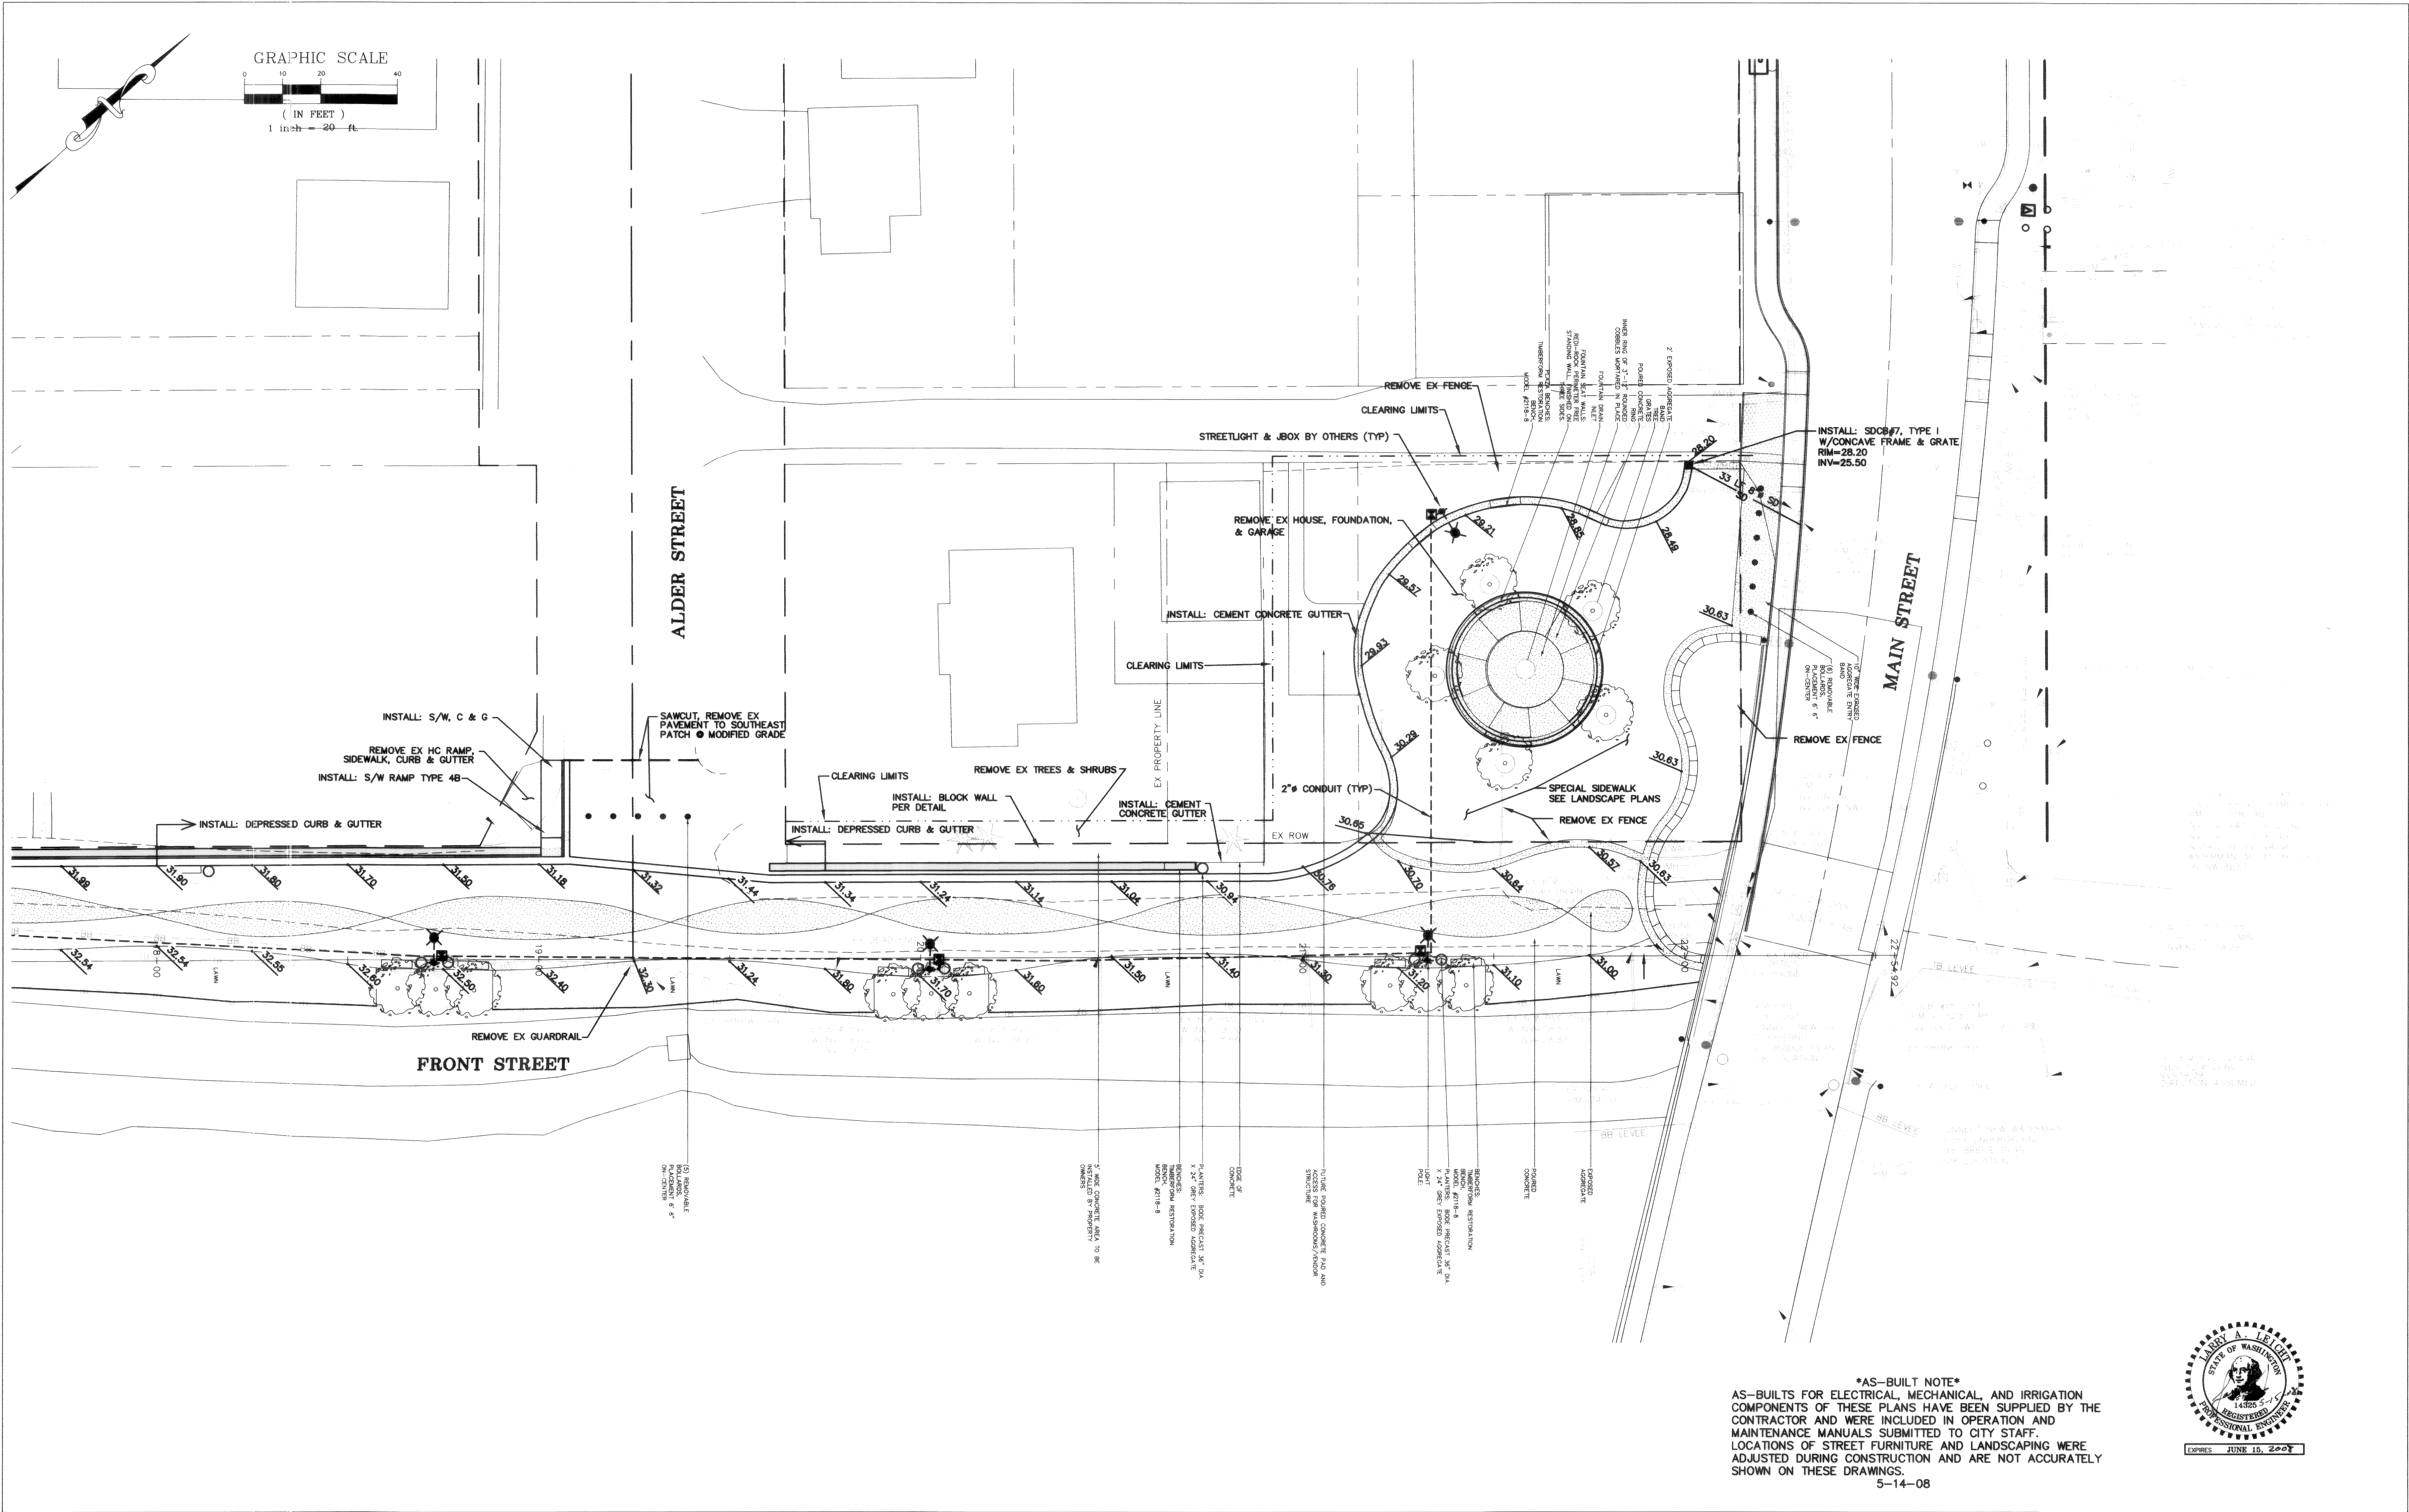



AS-BUILT NOTE
AS-BUILTS FOR ELECTRICAL, MECHANICAL, AND IRRIGATION COMPONENTS OF THESE PLANS HAVE BEEN SUPPLIED BY THE CONTRACTOR AND WERE INCLUDED IN OPERATION AND MAINTENANCE MANUALS SUBMITTED TO CITY STAFF. LOCATIONS OF STREET FURNITURE AND LANDSCAPING WERE ADJUSTED DURING CONSTRUCTION AND ARE NOT ACCURATELY SHOWN ON THESE DRAWINGS.
5-14-08




DESIGNED BY LL DRAWN BY LMC CHECKED BY	 REICHHARDT & EBE <i>ENGINEERING, INC.</i> CONSULTING ENGINEERS PO Box 978 423 Front St., Ste 201 Ph (360) 354-3687 Lynden, Washington 98264 Fax (360) 354-0407	1	6-28-07	REVISE WALLS, GRADES	LL	CITY OF FERNDALE 2095 MAIN STREET FERNDALE, WA 98248	CENTENNIAL RIVERWALK FRONT STREET IMPROVEMENTS	JOB# / DWG 05012 SP1	DATE 6-27-07
		NO.	DATE	REVISION	BY			SCALE H: 1"=20' V: N/A	SHEET C4 of C8

0037.005 1-5-09 KK

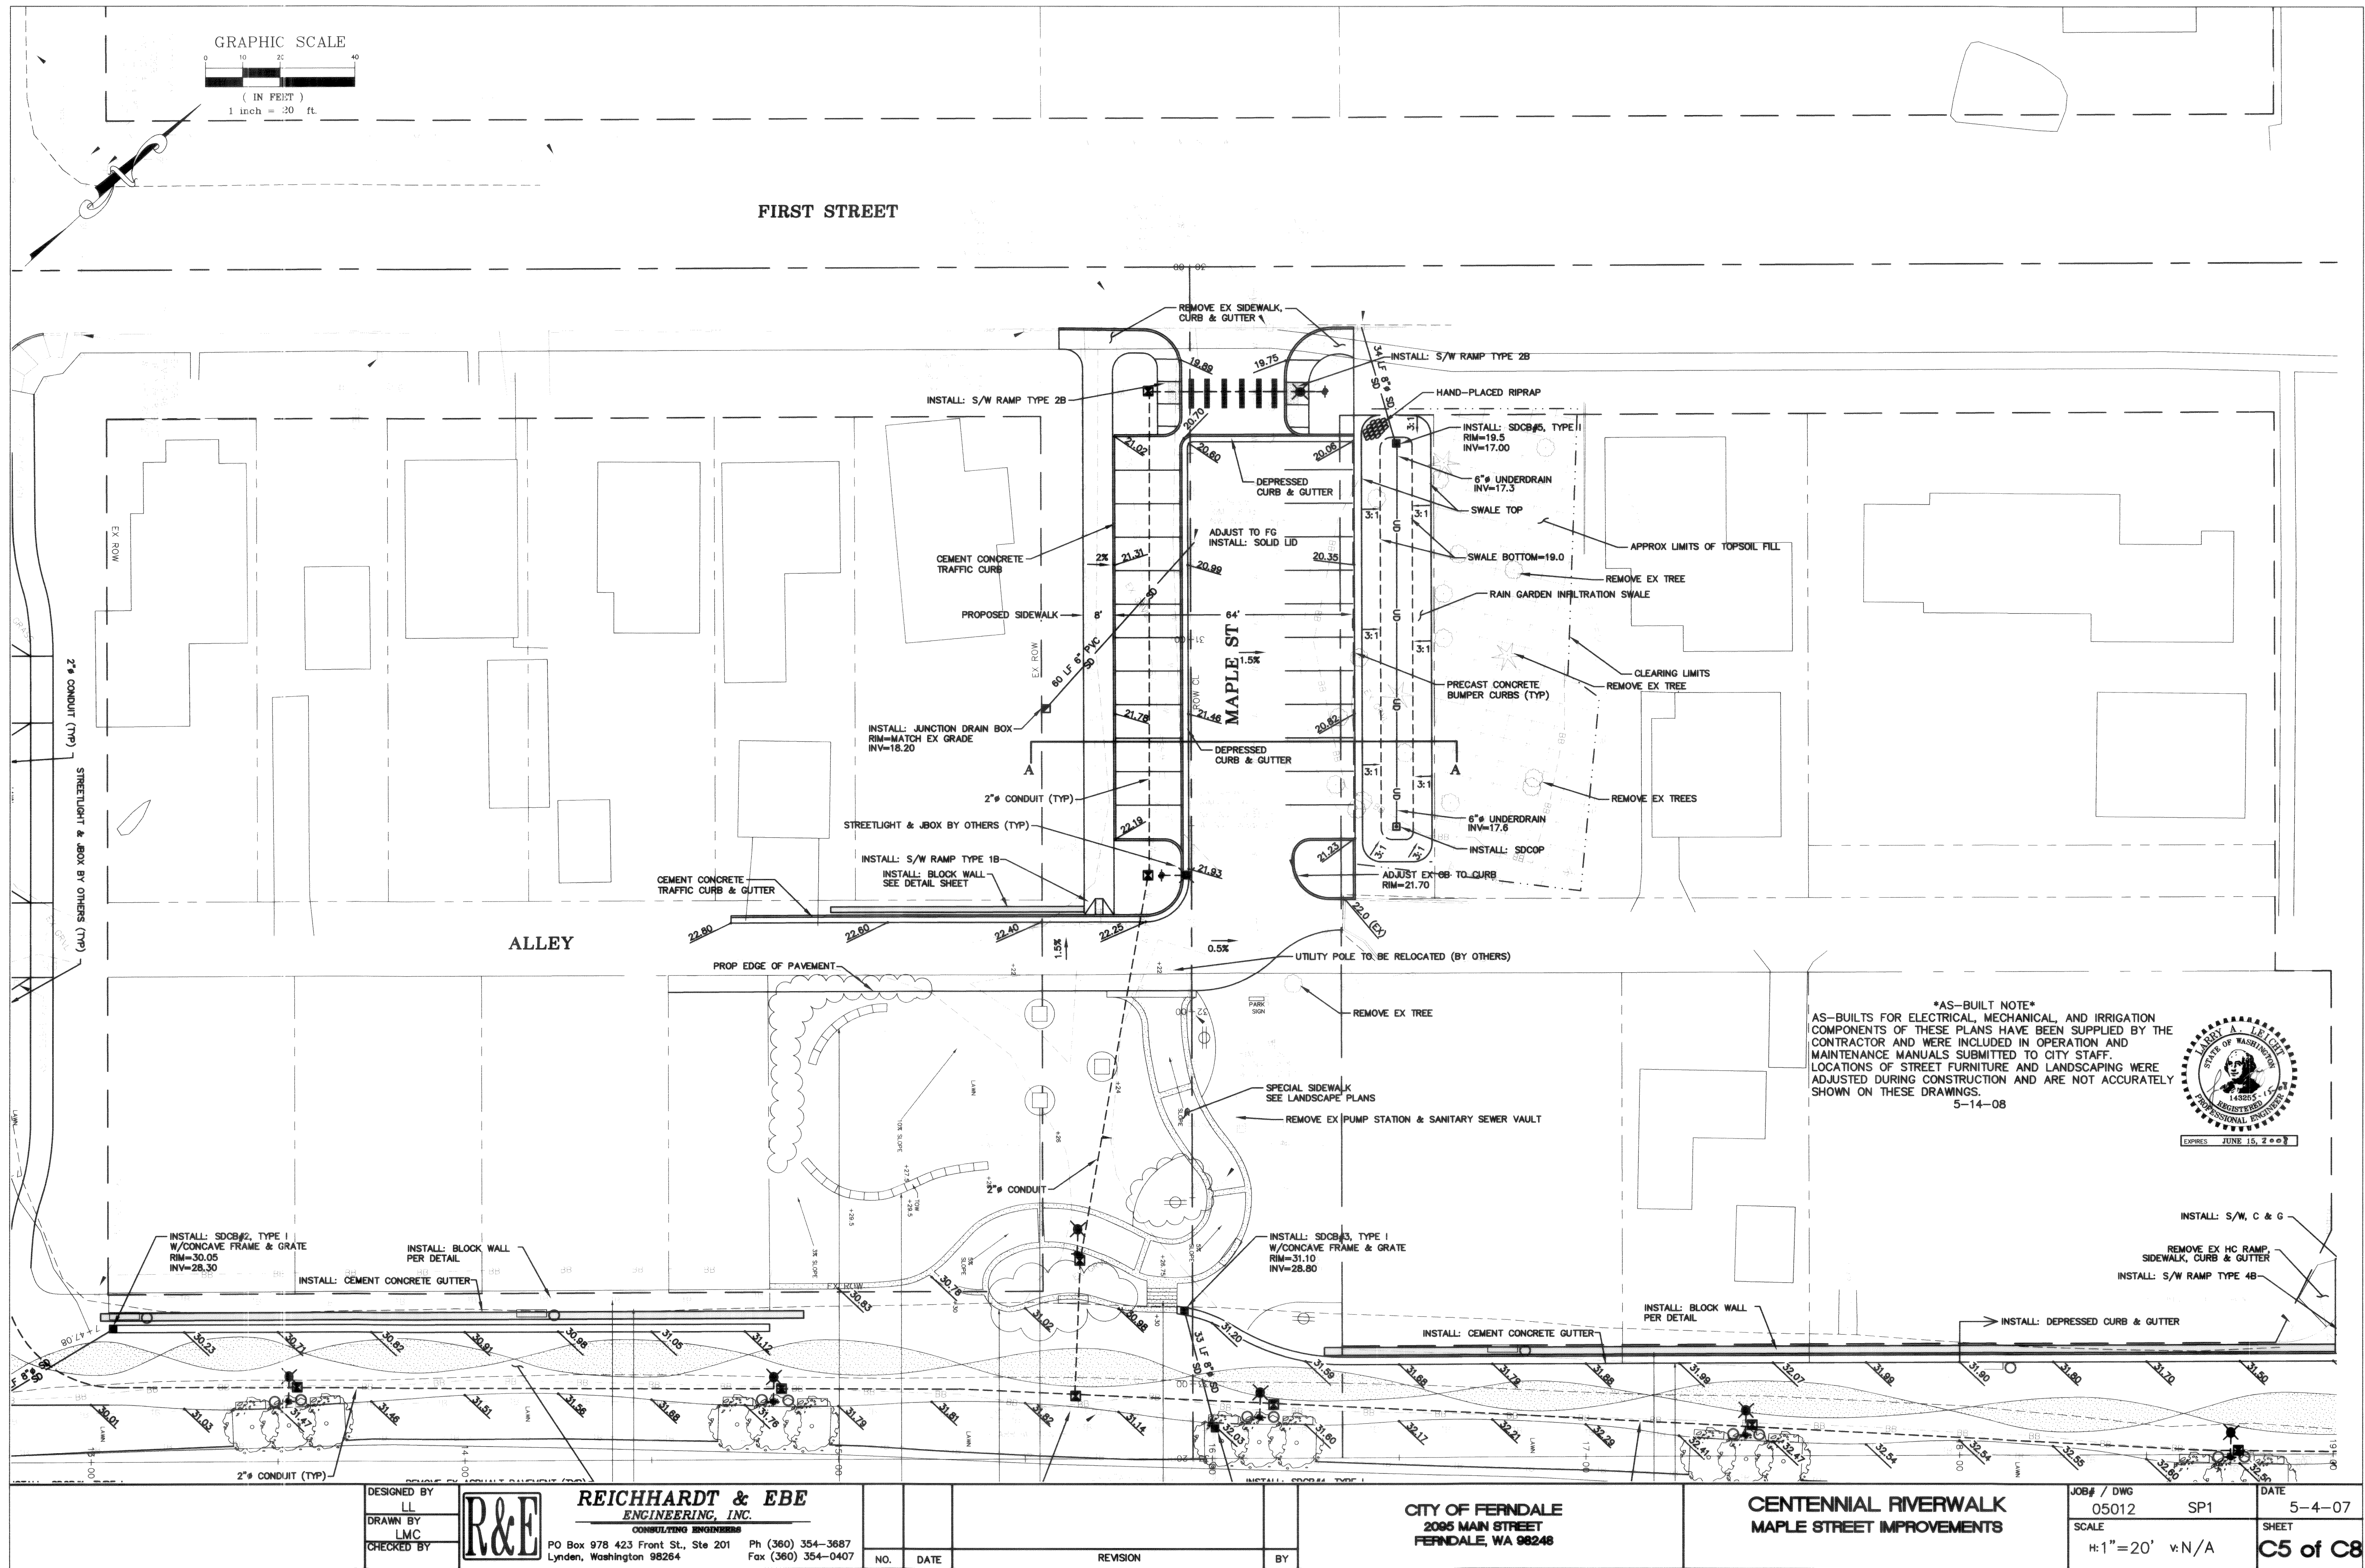


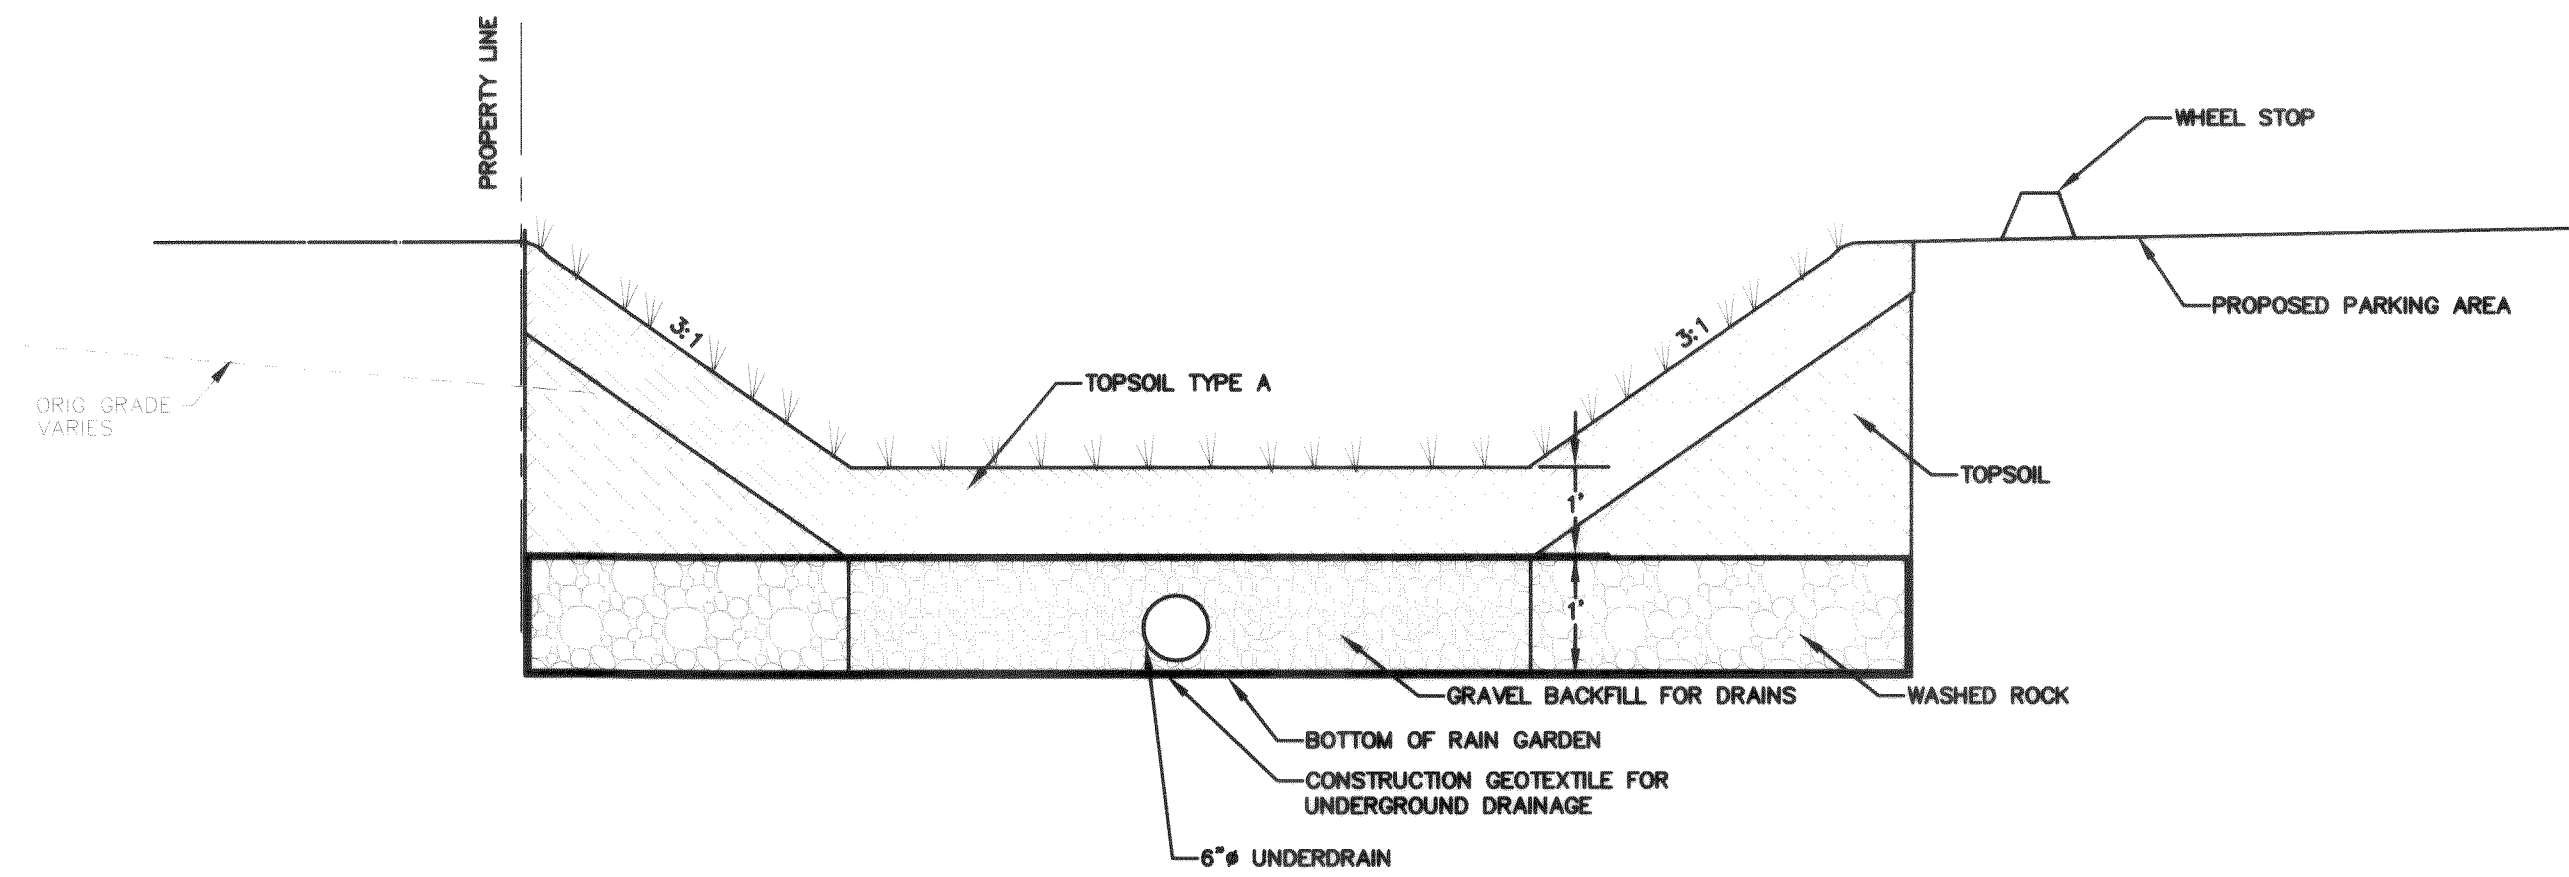


**RAIN GARDEN SECTION
CONCRETE RETAINING WALL DETAIL**
NTS

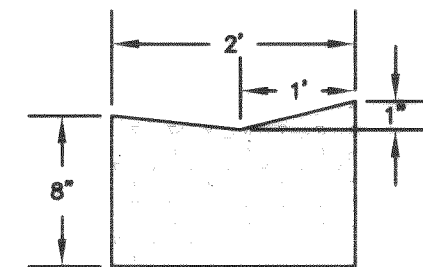


**CEMENT CONCRETE
GUTTER SECTION (TYP)**
NTS

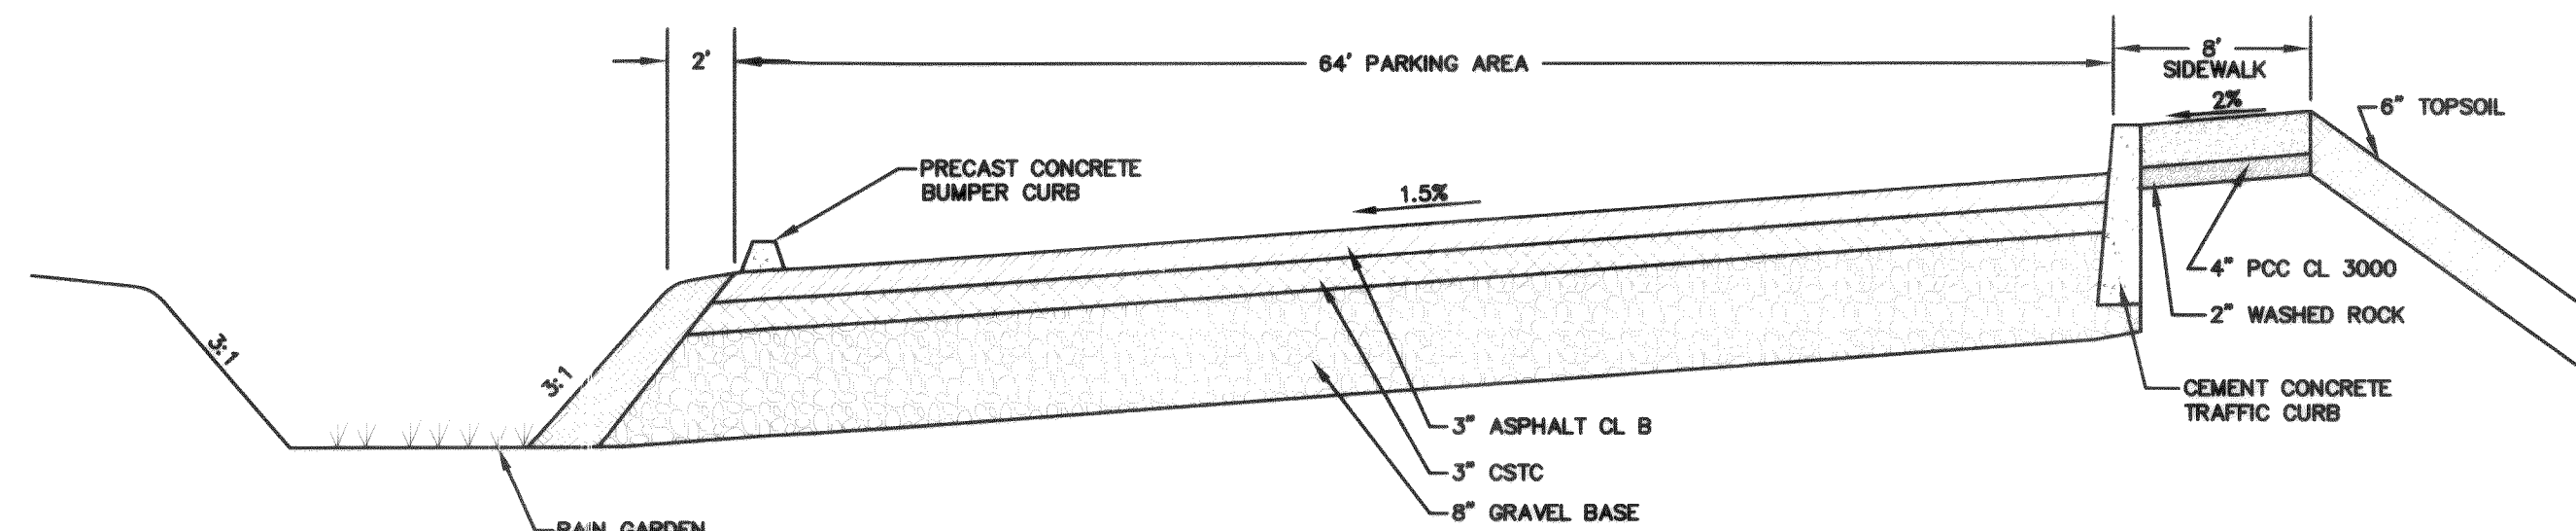


SECTION A-A
NTS

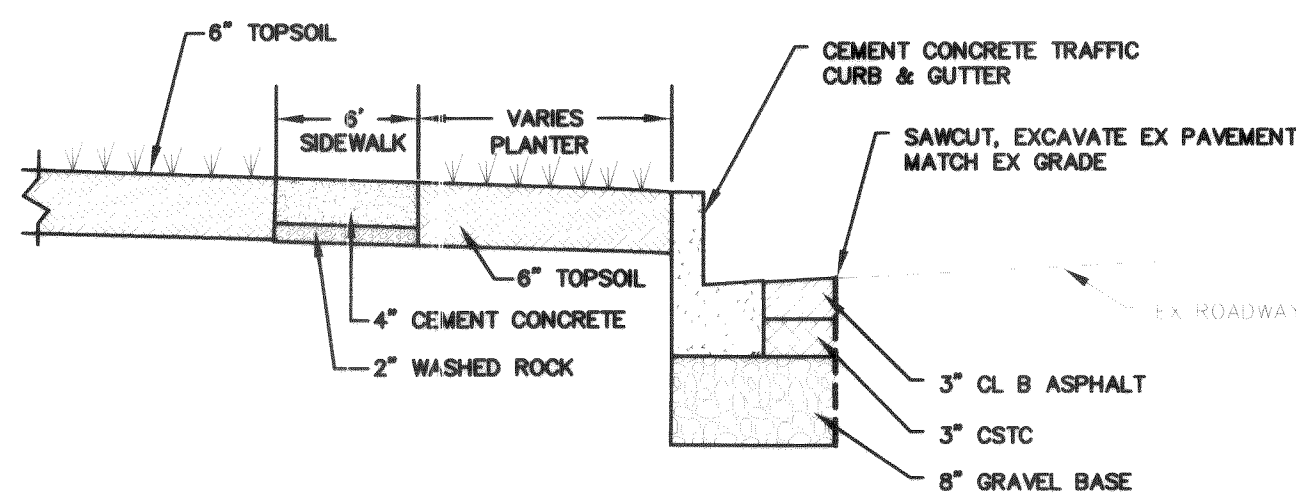


CHERRY STREET TYPICAL SECTION
NTS

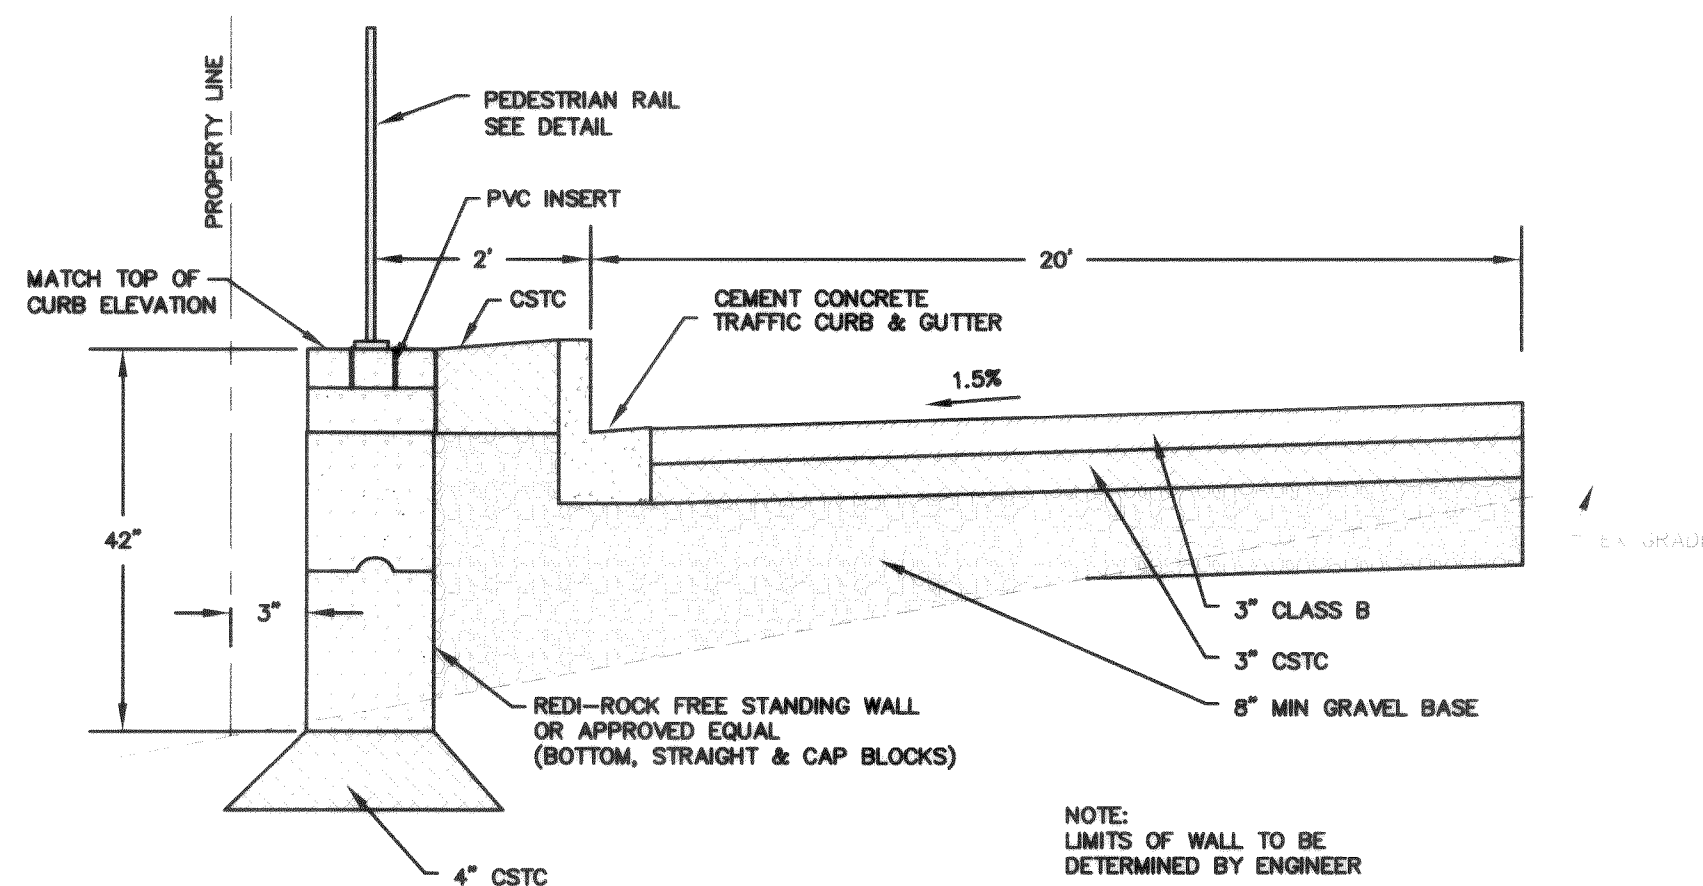


TYPICAL ALLEY SECTION
NTS

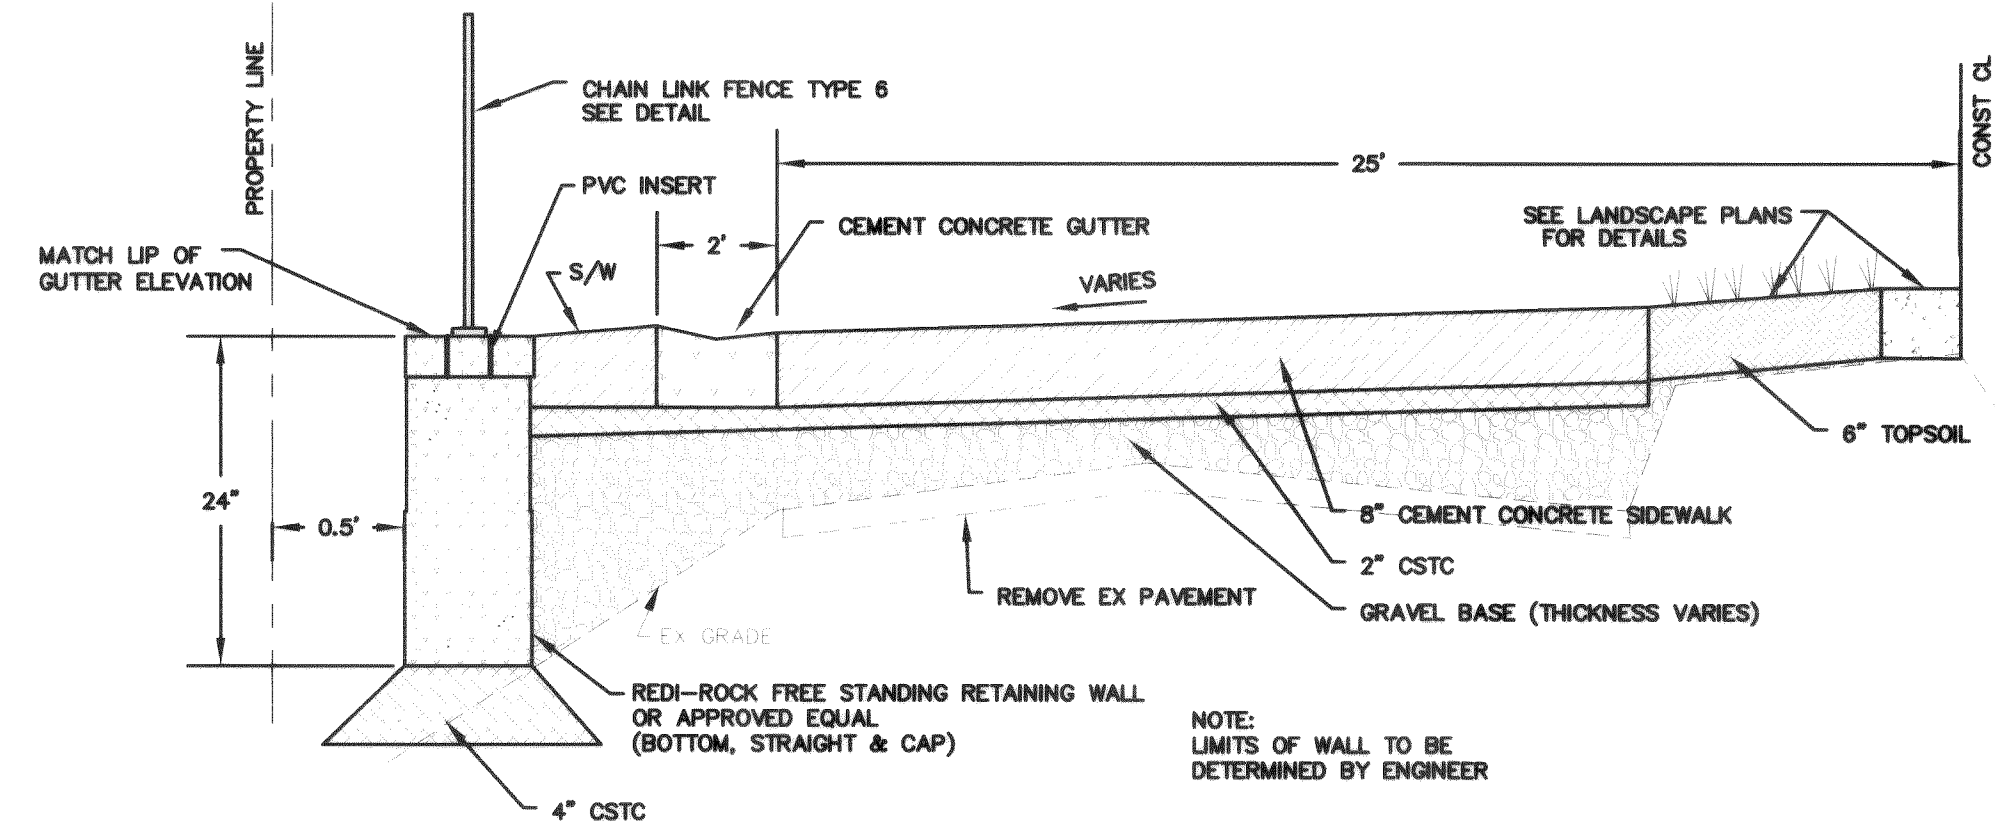

**RIVERWALK TYPICAL SECTION
STA 16+30 TO 19+00**
NTS

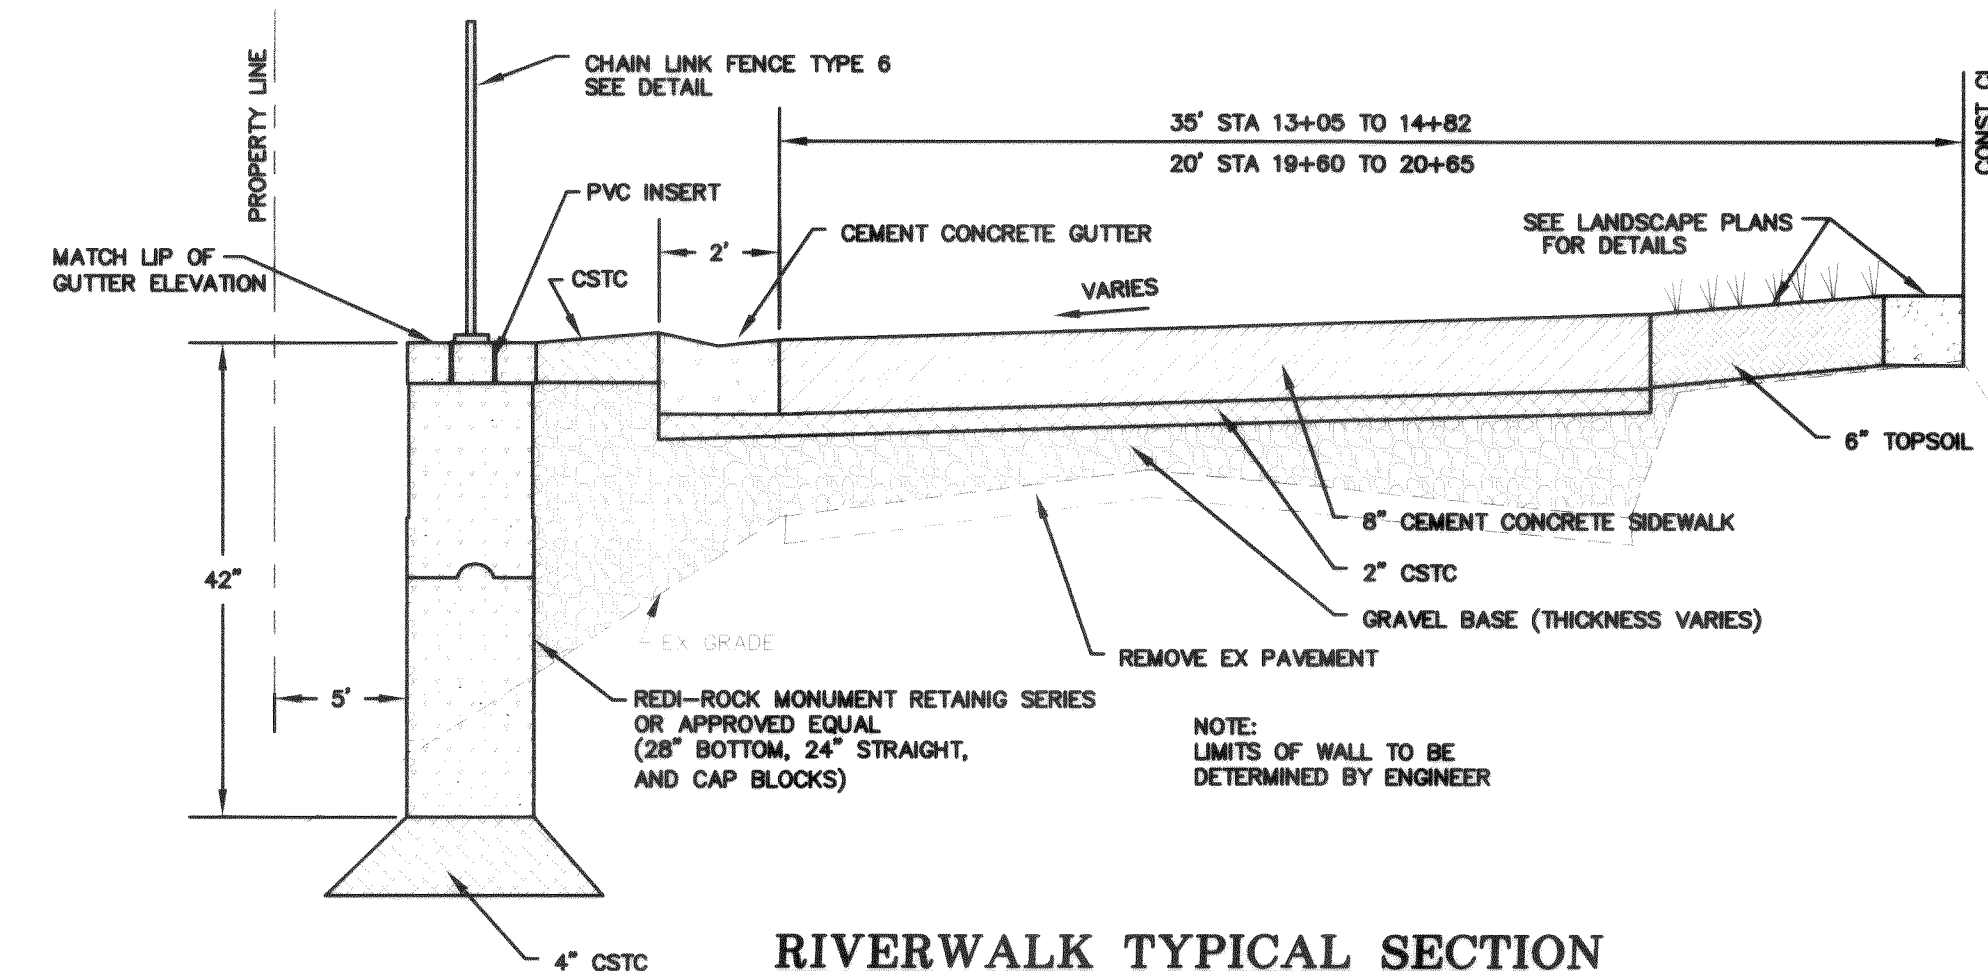


**RIVERWALK TYPICAL SECTION
STA 13+05 TO 14+82
STA 19+60 TO 20+65**
NTS

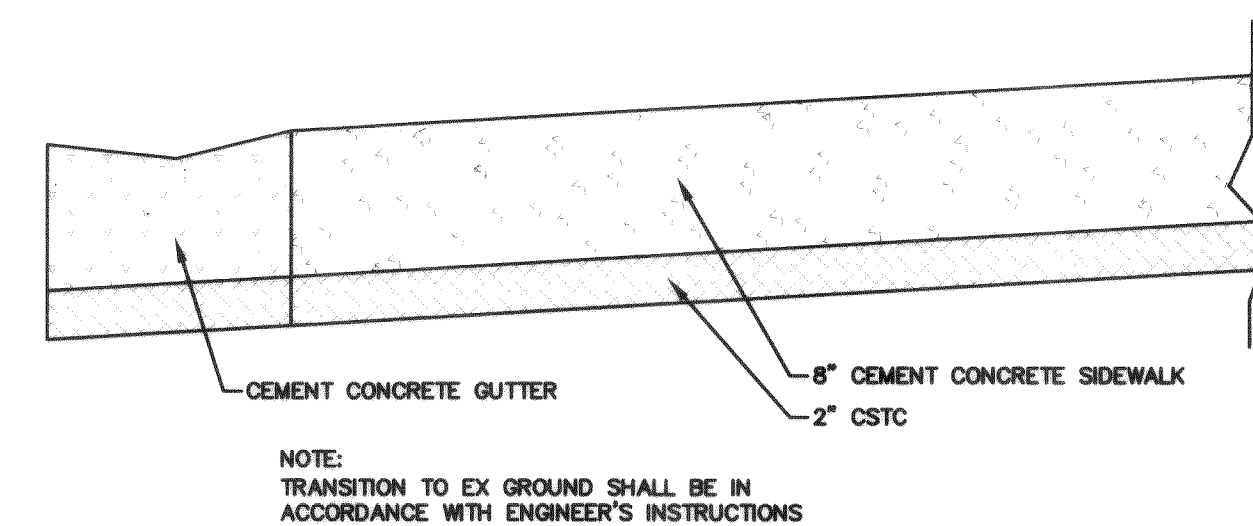


**RIVERWALK TYPICAL SECTION
STA 15+92 TO 17+10
STA 17+60 TO 18+86
STA 20+65 TO 21+25**
NTS

AS-BUILT NOTE
AS-BUILTS FOR ELECTRICAL, MECHANICAL, AND IRRIGATION COMPONENTS OF THESE PLANS HAVE BEEN SUPPLIED BY THE CONTRACTOR AND WERE INCLUDED IN OPERATION AND MAINTENANCE MANUALS SUBMITTED TO CITY STAFF. LOCATIONS OF STREET FURNITURE AND LANDSCAPING WERE ADJUSTED DURING CONSTRUCTION AND ARE NOT ACCURATELY SHOWN ON THESE DRAWINGS.

5-14-08

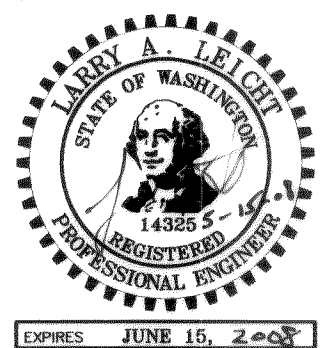

DESIGNED BY
LL
DRAWN BY
LMC
CHECKED BY

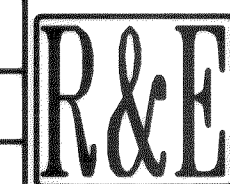

REICHARDT & EBE
ENGINEERING, INC.
CONSULTING ENGINEERS

PO Box 978 423 Front St., Ste 201
Lynden, Washington 98264

Ph (360) 354-3687
Fax (360) 354-0407

1 6-28-07 REVISE WALLS, GRADES

NO. DATE REVISION

LL

BY

CITY OF FERDALE
2095 MAIN STREET
FERDALE, WA 98248

**CENTENNIAL RIVERWALK
TYPICAL SECTIONS SHEET**


JOB# / DWG
05012 SP1
SCALE
H: N/A V: N/A

DATE
6-27-07
SHEET


C7 of C8

00377.007 1-5-09 R2

00377.008 15-09 KR

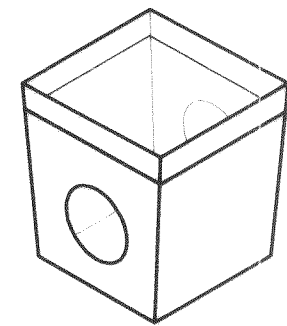


NOTE: PROVIDE RISER SECTIONS FOR 2' MIN. COVER
PROVIDE GRATE COVER TO ALLOW OVERLAND DRAINAGE
SLOPE FROM J-BOX TO SADDLE TO BE 2%

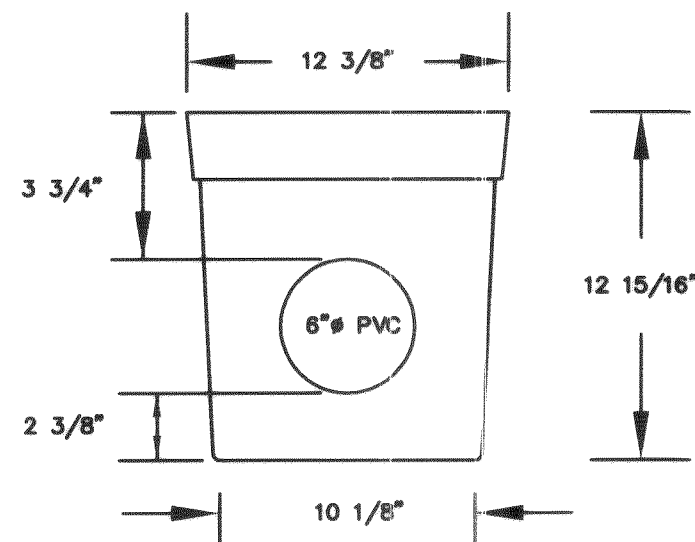

SPECIFICATION: NDS #1200,12003,12004, 12"x12" TAPERED CB OR EQUAL


JUNCTION DRAIN BOX DETAIL

NTS

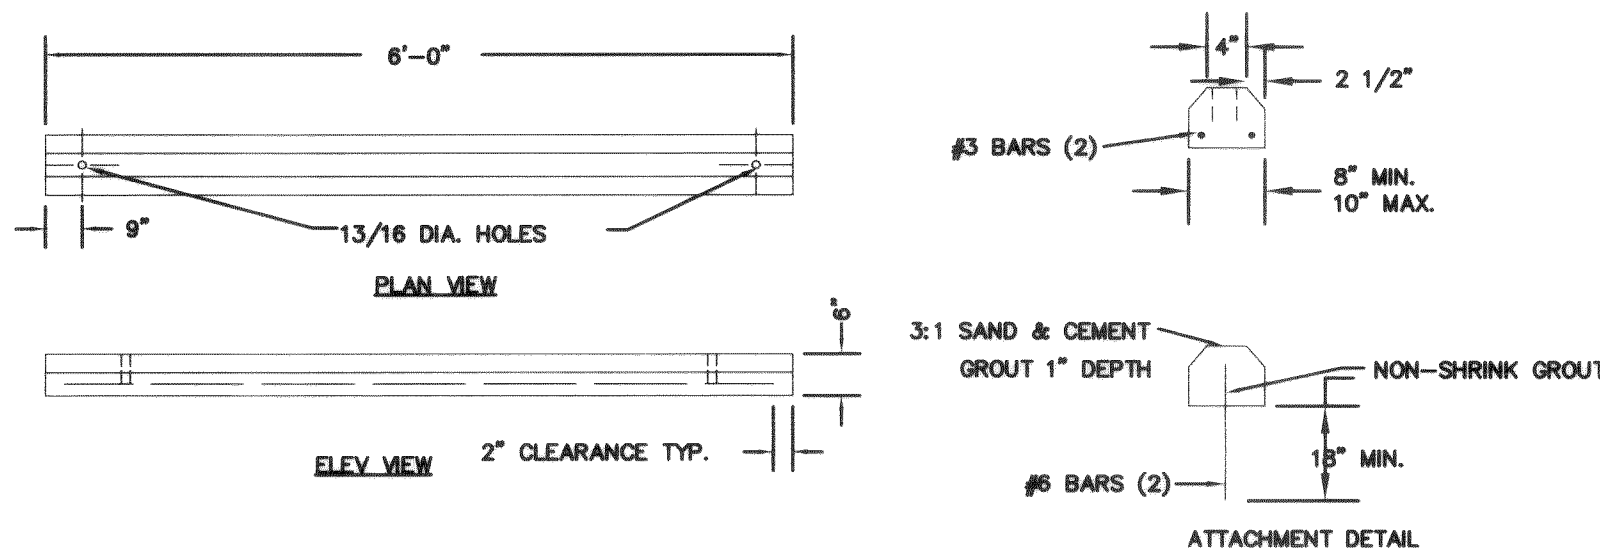



PRECAST CEMENT CONCRETE BUMPER CURB

NTS

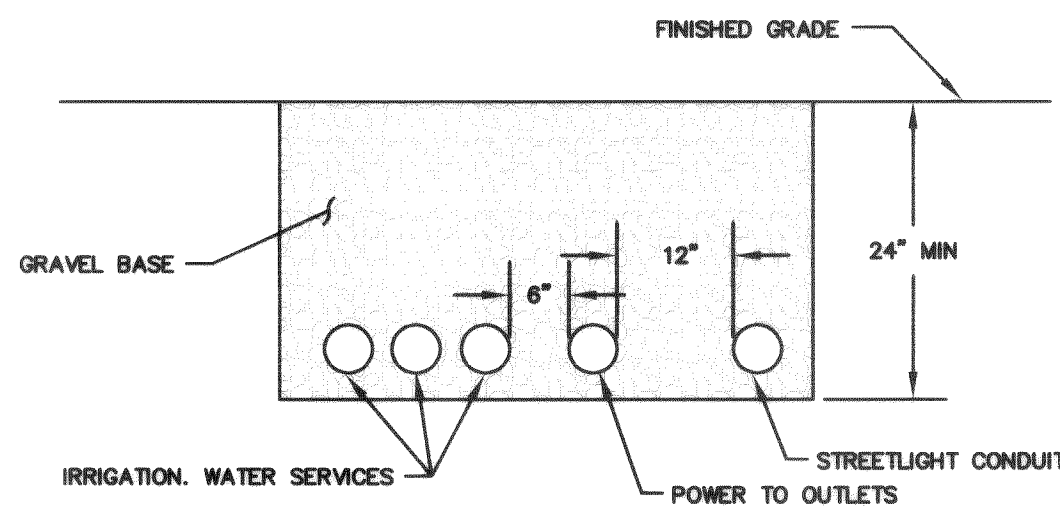


SHARED TRENCH DETAIL

NTS

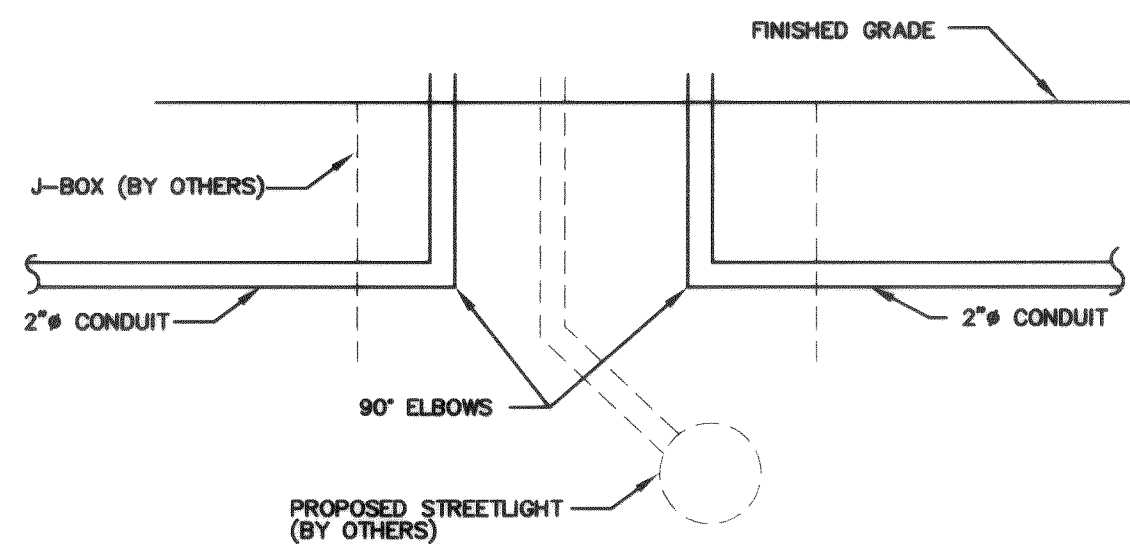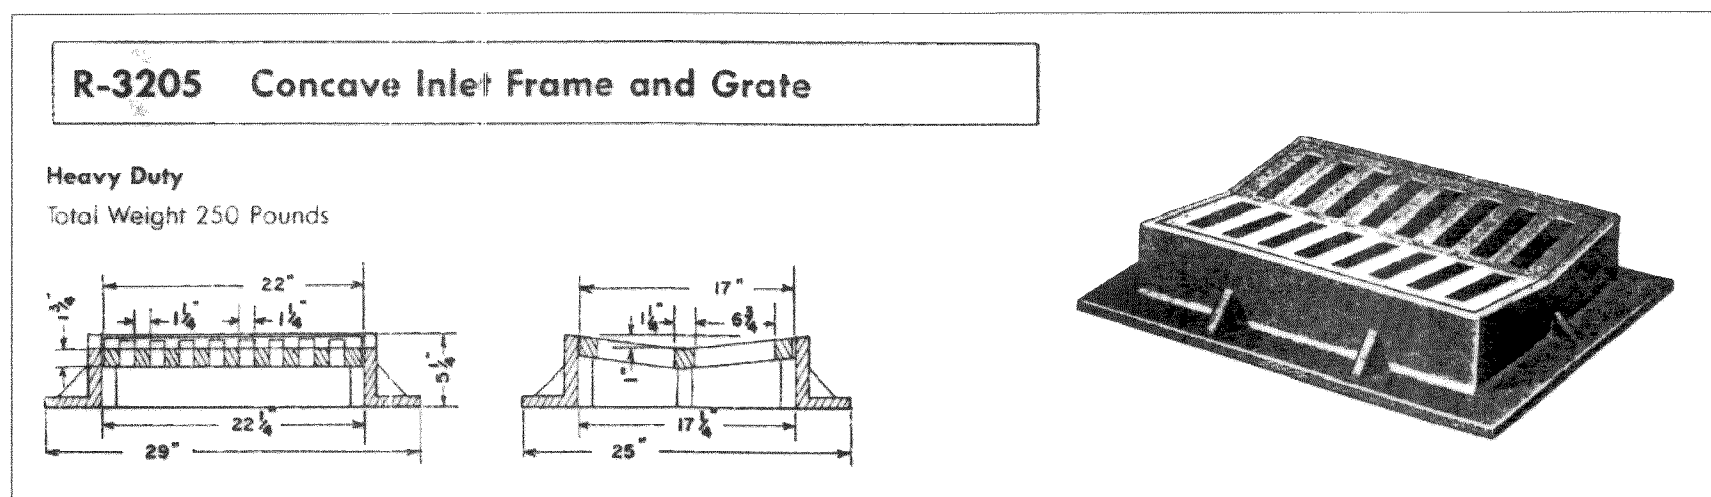


CONDUIT INSTALLATION @ J-BOX

NTS

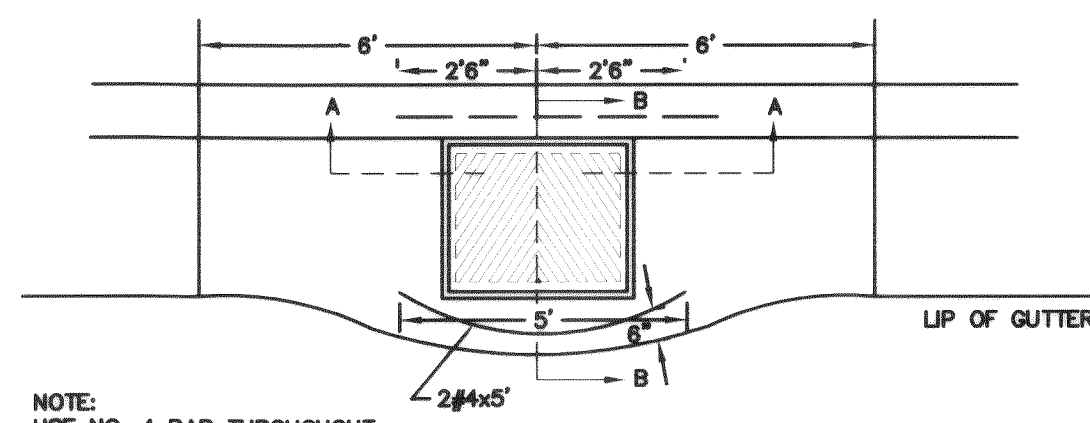


NOTE: USE NO. 4 BAR THROUGHOUT

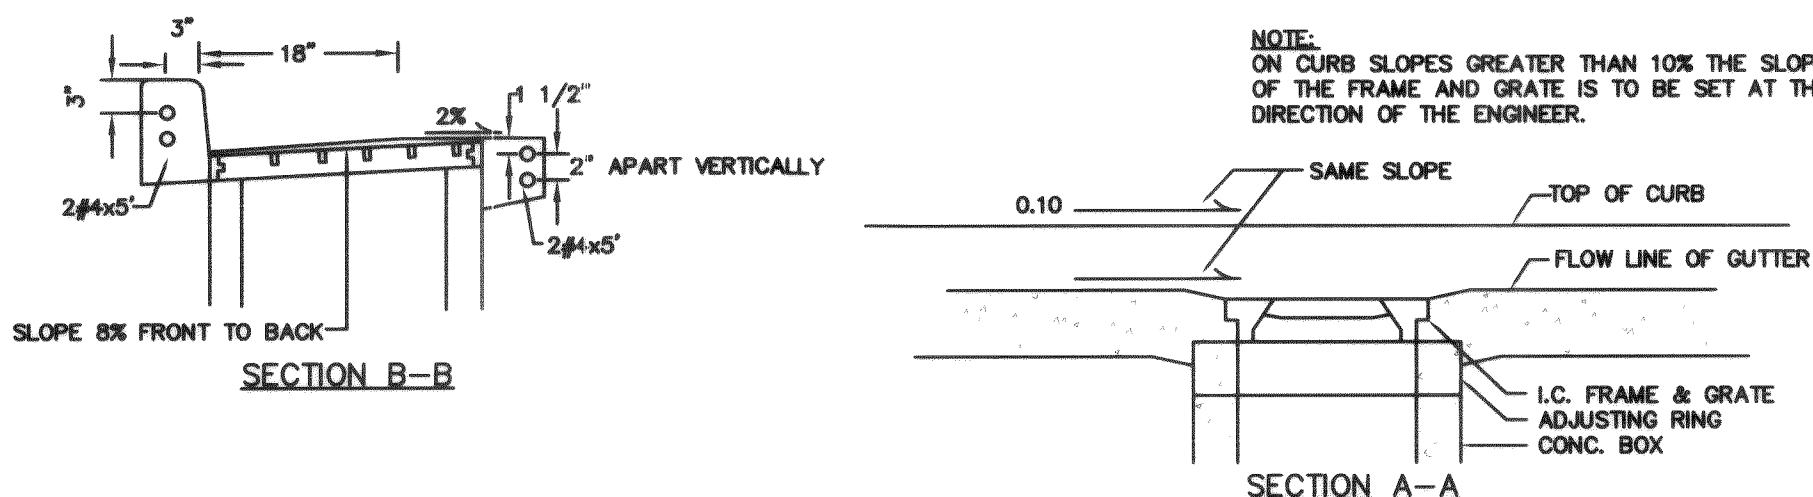

TYPICAL CATCH BASIN

NTS

TYPE	MEMBER													
	BRACE RAIL & TOP RAIL						LINE & BRACE POST						END, CORNER, & PULL POST	GATE POST
	ROUND	H-COLUMN	ROLL FORMED	ROUND	H-COLUMN	ROLL FORMED	ROUND	ROLL FORMED	ROUND	ROLL FORMED	ROUND	ROLL FORMED	ROUND	ROLL FORMED
	I.D. Pipe (Inches)	Weight Per Foot (Pounds)	Size (Inches)	Weight Per Foot (Pounds)	I.D. Pipe (Inches)	Weight Per Foot (Pounds)	Size (Inches)	Weight Per Foot (Pounds)	Size (Inches)	Weight Per Foot (Pounds)	I.D. Pipe (Inches)	Weight Per Foot (Pounds)	Size (Inches)	Weight Per Foot (Pounds)
6	1-1/4	2.27	1-1/4 x 1-5/8	1.35	1-5/8 x 1-1/4	1.35	2	3.65	2-1/4	4.0	1-5/8 x 1-7/8	2.34	2-1/2	5.79

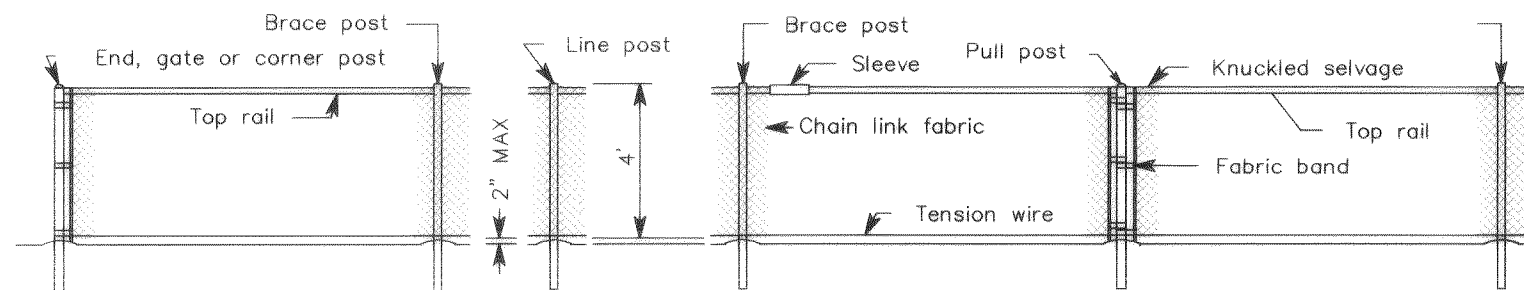


CHAIN LINK FENCE TYPE 6

NTS

AS-BUILT NOTE
AS-BUILTS FOR ELECTRICAL, MECHANICAL, AND IRRIGATION COMPONENTS OF THESE PLANS HAVE BEEN SUPPLIED BY THE CONTRACTOR AND WERE INCLUDED IN OPERATION AND MAINTENANCE MANUALS SUBMITTED TO CITY STAFF. LOCATIONS OF STREET FURNITURE AND LANDSCAPING WERE ADJUSTED DURING CONSTRUCTION AND ARE NOT ACCURATELY SHOWN ON THESE DRAWINGS.

5-14-08

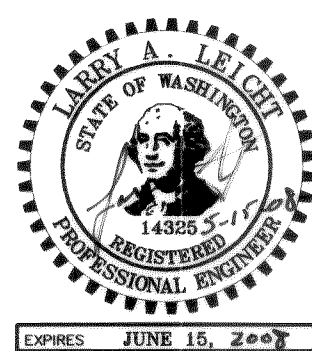

GENERAL NOTES

All work shall conform to the standard plans and specifications of the Washington State Department of Transportation (WSDOT) and City of Ferndale standards unless indicated otherwise by the contract documents.

Plug all culverts, sewers, and conduits prior to abandonment. Any pipe with less than two feet of proposed cover shall be removed.

The location of existing utilities shown is approximate. It is the responsibility of the Contractor to field verify these locations prior to construction.

The Contractor shall be responsible for contacting any and all utilities in the area prior to beginning a work on this project. The one-call number for underground utilities is 1-800-424-5555.

The Contractor shall notify residents and businesses 48 hours in advance of any work affecting access or service and shall minimize interruptions to driveways adjacent to the project.

Driveways shall not be closed more than 4 hours without owner's consent. Concrete pours shall be staggered such that access is provided whenever possible. Parking shall be provided on one side of the road whenever driveway access is limited.

Rain Garden excavation, grading, topsoil, and underdrain system shall be constructed as detailed in the Civil Drawings and specifications. Rain Garden work shall extend from the edge of the Maple Street parking lot to the north, west, and east limits of clearing.

All landscaping including landscaping in the Rain Garden and cleared area to the north shall be constructed as detailed in the Landscaping Drawings and specifications.

All irrigation and fountain installation shall be constructed as detailed in the Landscaping Drawings and specifications.

Electrical installation needed for outlets, enclosures, electrical services, panels, and enclosures shall be constructed as detailed in the Electrical Drawings and specifications. Streetlight conduit and streetlight junction boxes shall be constructed in accordance with the Civil Drawings and specifications.

The City will provide all construction staking on this project.

DESIGNED BY
LL
DRAWN BY
LMC
CHECKED BY



REICHHARDT & EBE
ENGINEERING, INC.
CONSULTING ENGINEERS

PO Box 978 423 Front St., Ste 201
Lynden, Washington 98264

Ph (360) 354-3687
Fax (360) 354-0407

NO.

DATE

REVISION

BY

CITY OF FERNDAL
2095 MAIN STREET
FERNDAL, WA 98248

CENTENNIAL RIVERWALK
DETAILS AND GENERAL NOTES

JOB# / DWG

05012

SP1

DATE

5-4-07

SCALE


H: N/A

V: N/A

SHEET

C8 of C8

0037.01 5.01 KR

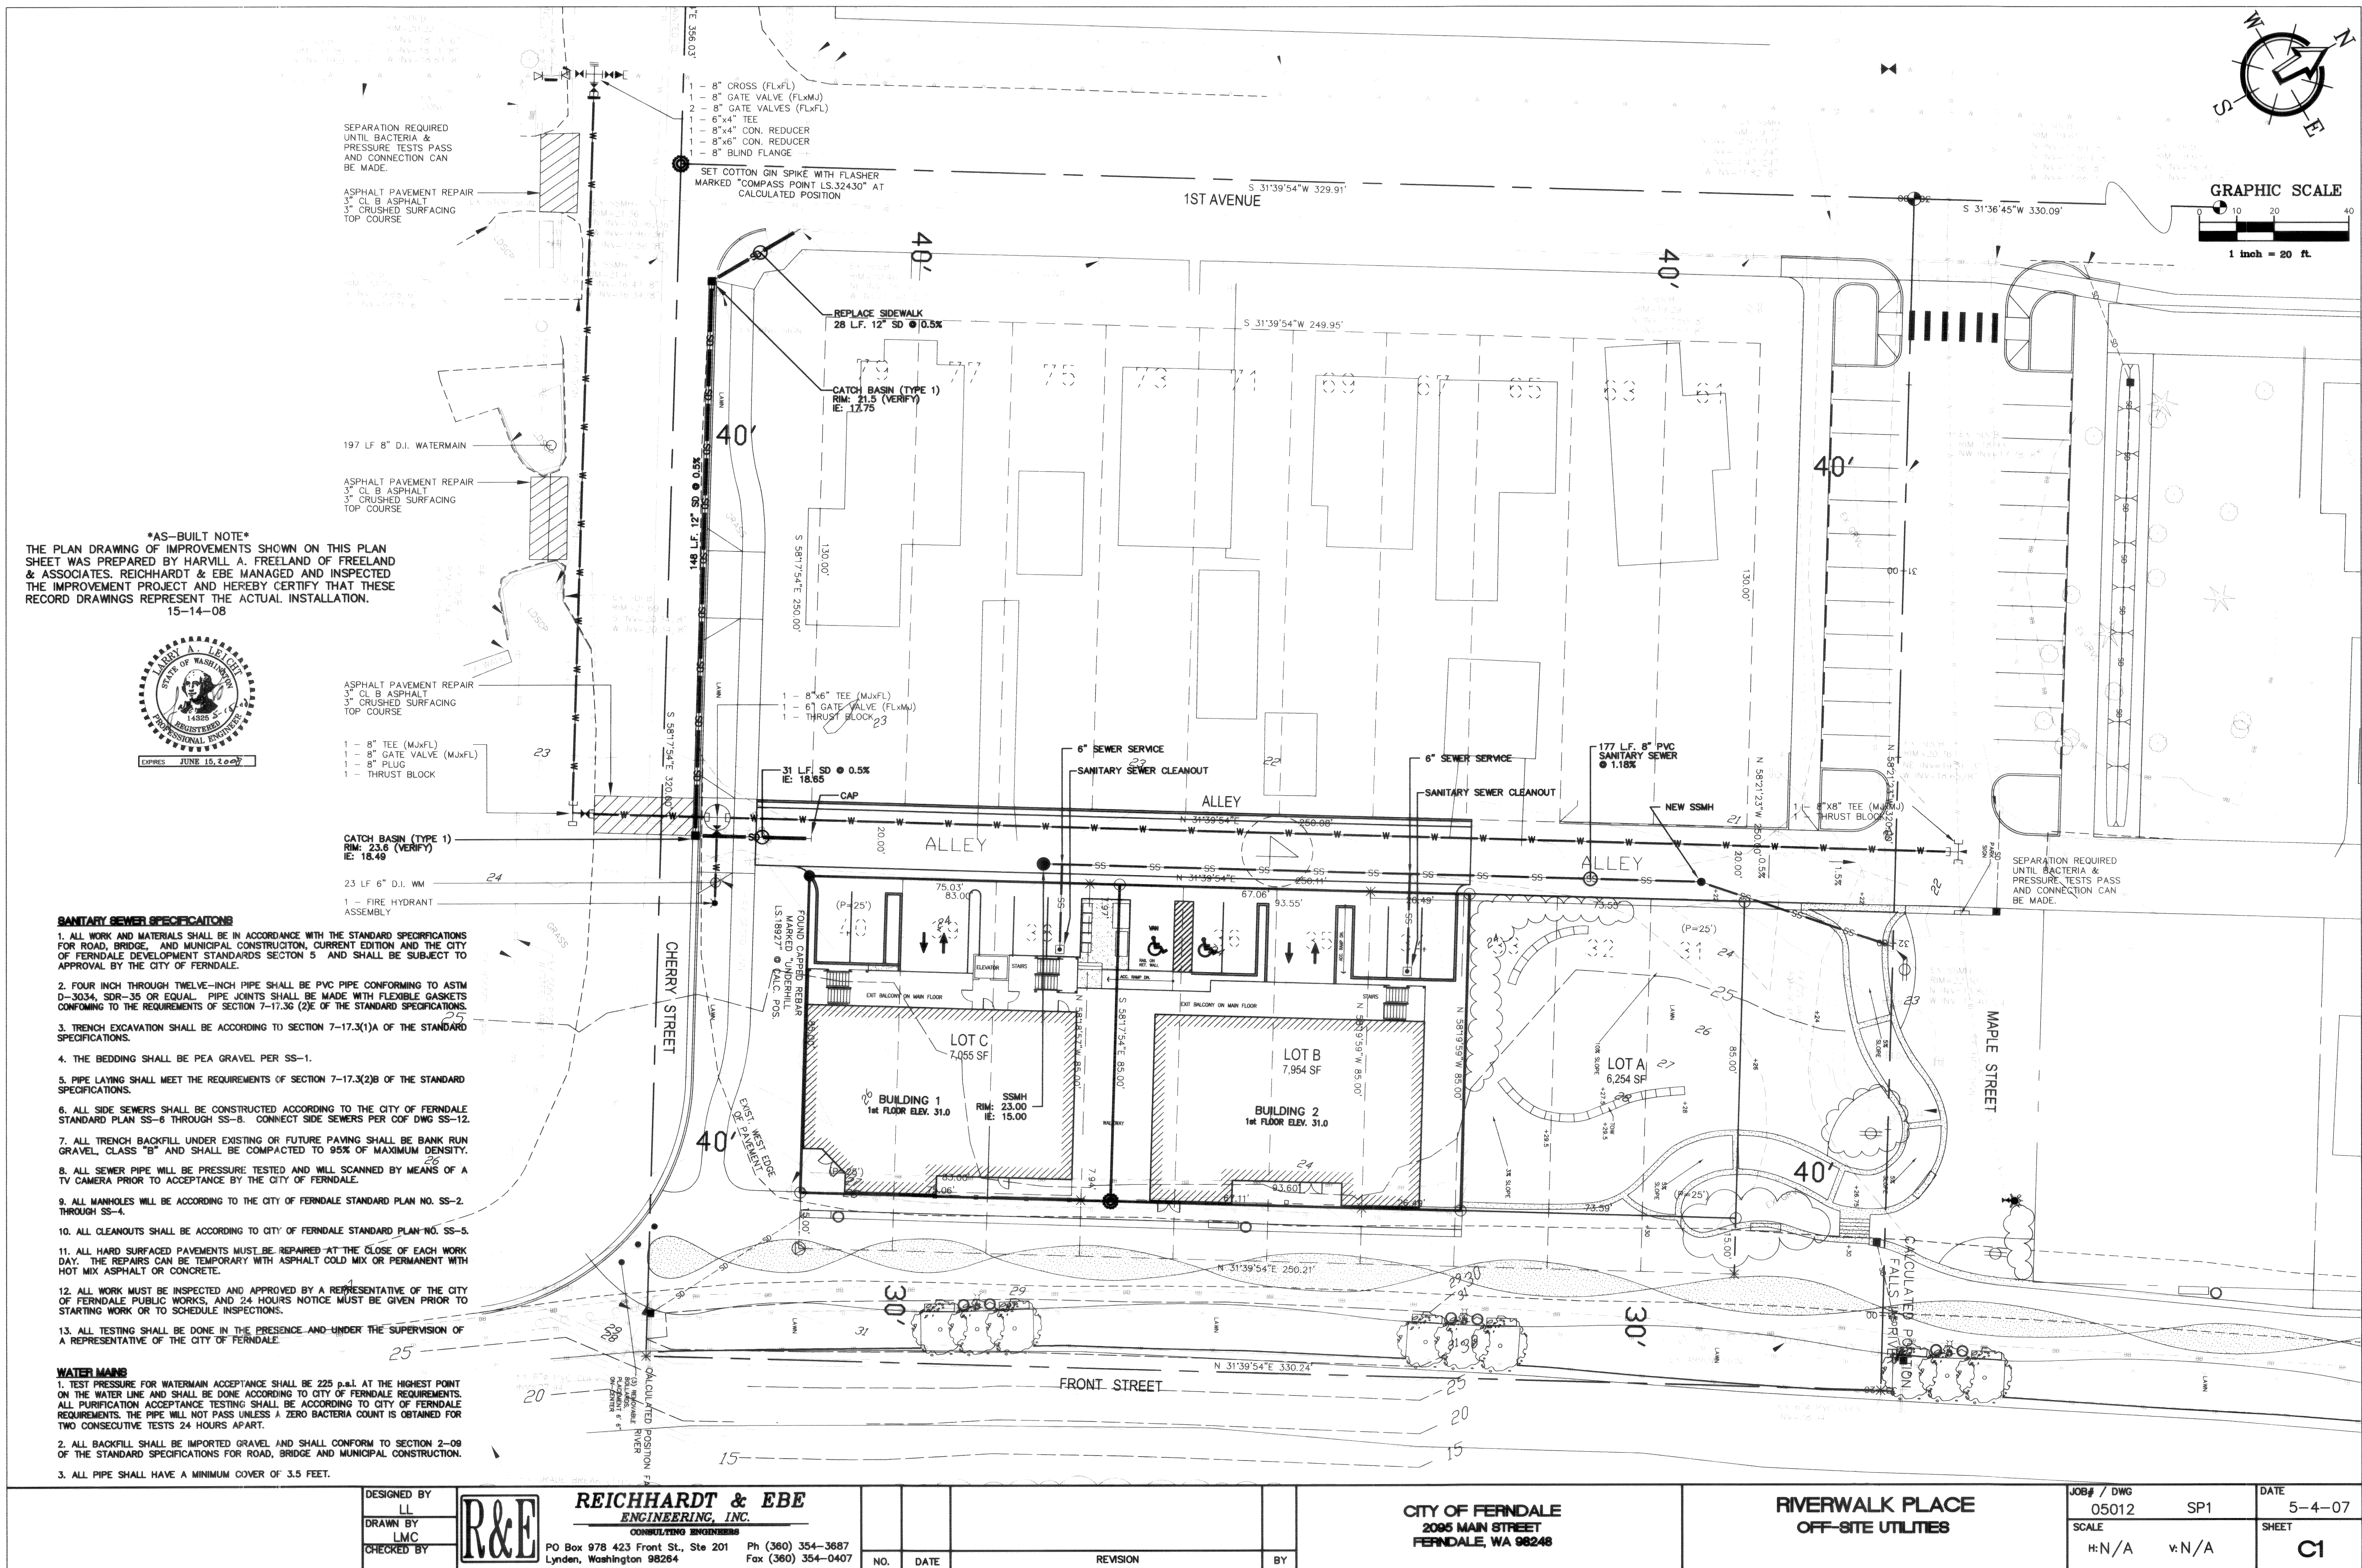

05/12/2008 3:11:48 PM PRELIM SITE PLAN, 5/15/2008 3:11:48 PM