
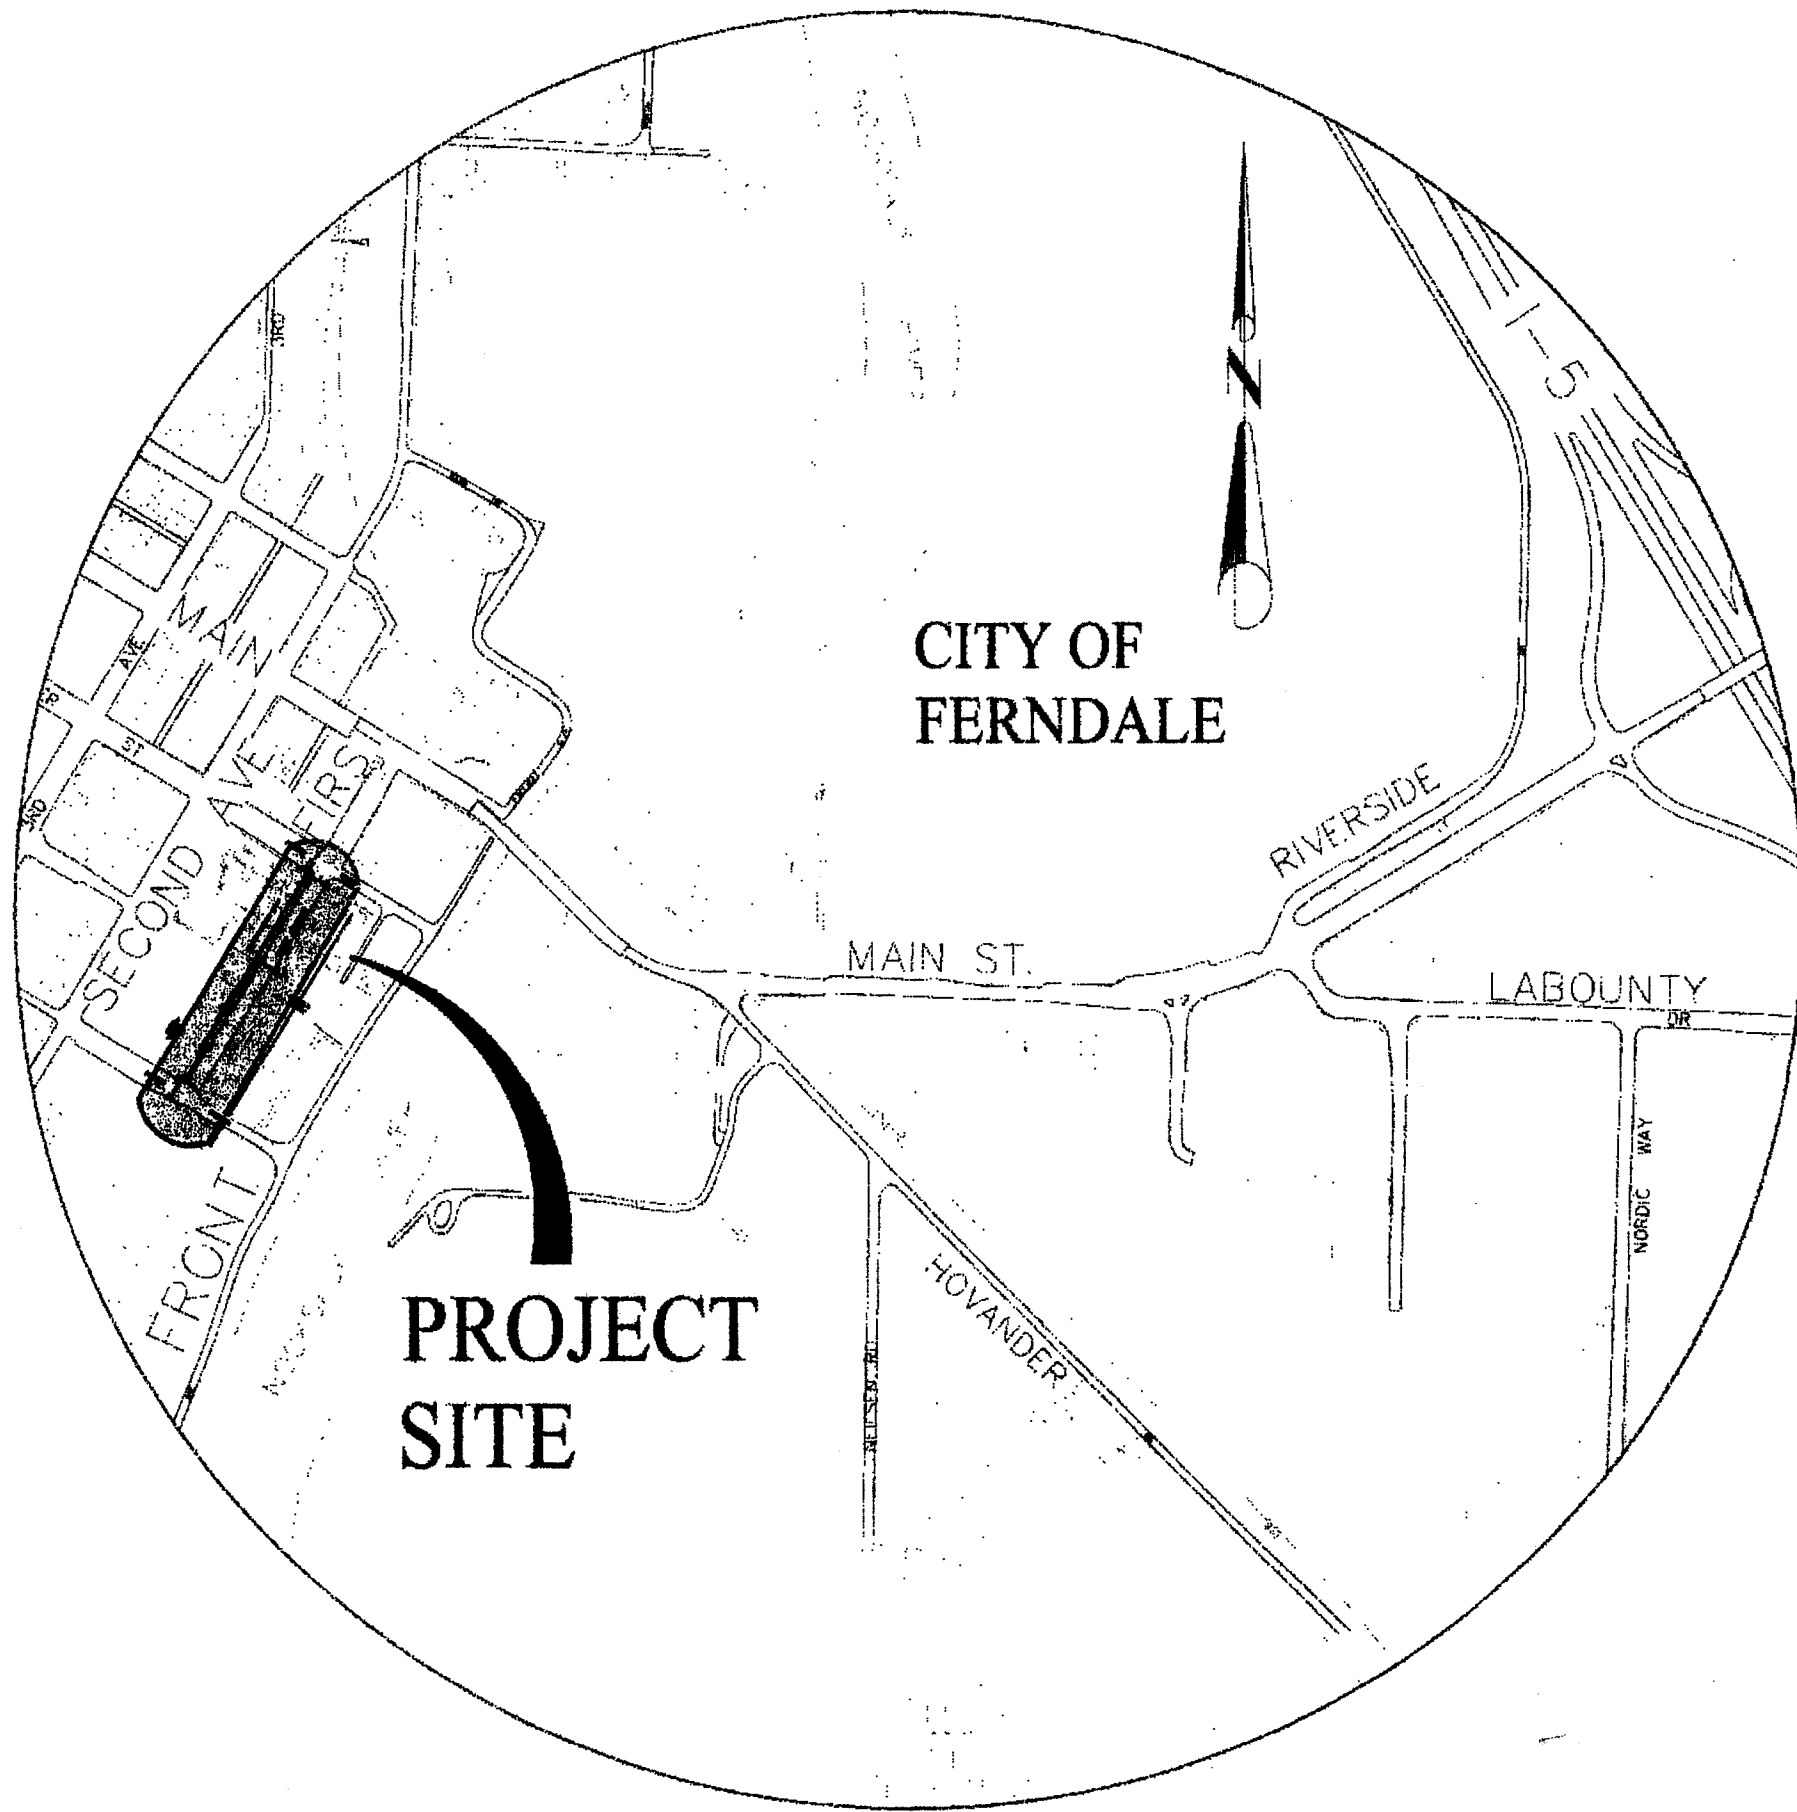


TOWNSHIP 39N, RANGE 2E, SECTION 29

CITY OF FERNDALE, WASHINGTON

FIRST AVENUE IMPROVEMENTS

ALDER TO CHERRY

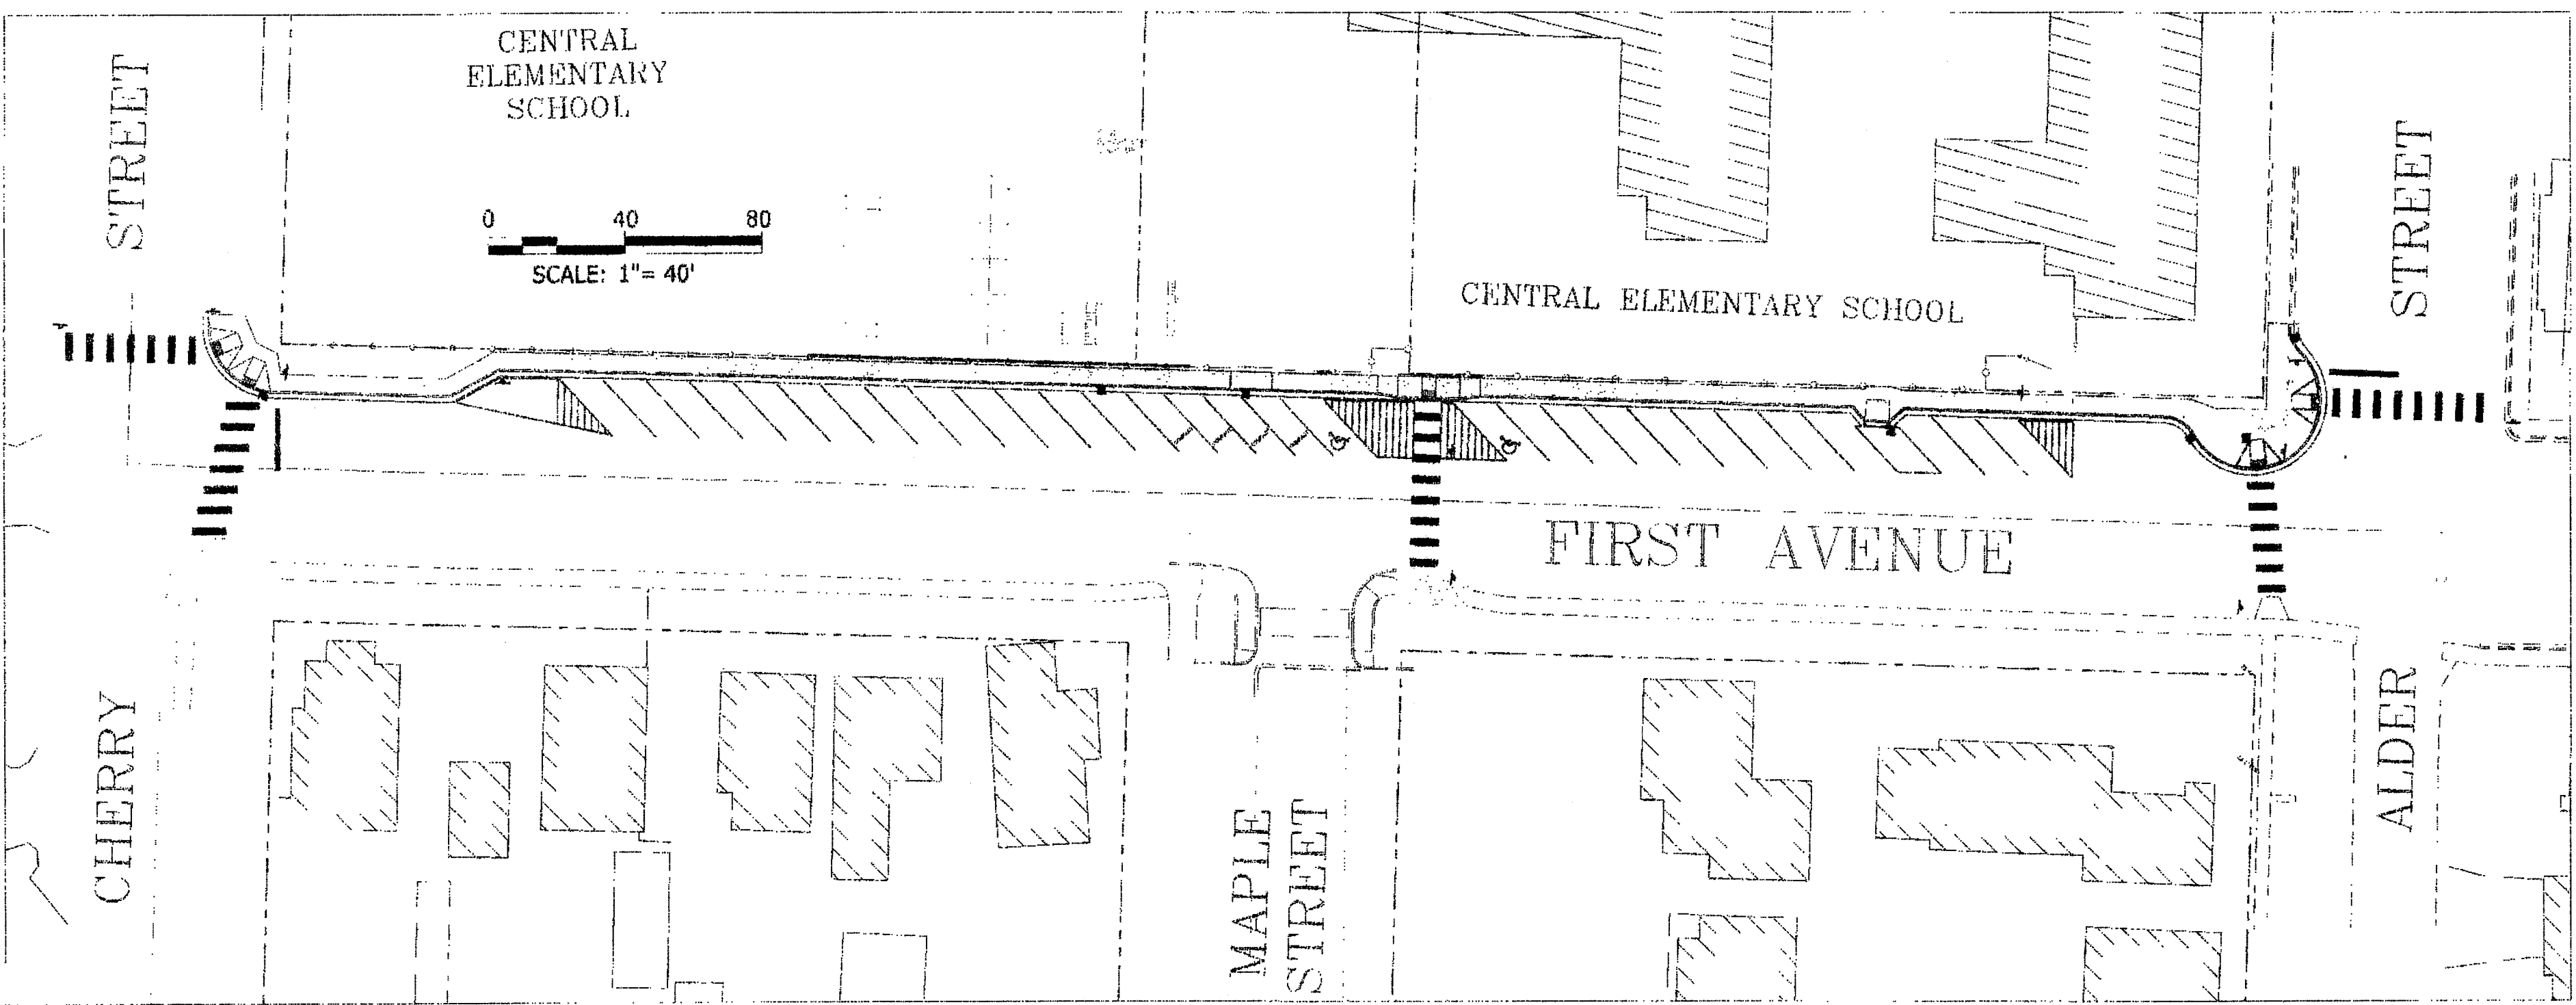

VICINITY MAP
SCALE: NTS

OWNER:
CITY OF FERNDALE
PUBLIC WORKS DEPARTMENT
2095 MAIN STREET
P.O. BOX 936
FERNDALE, WASHINGTON 98248
360.384.4006

PLAYGROUND IMPROVEMENTS
CENTRAL ELEMENTARY SCHOOL
MISCHA BURNETT, PRINCIPAL
5610 SECOND AVENUE
FERNDALE, WASHINGTON 98248
360.383.9600

DESIGN SURVEYOR:
PACIFIC SURVEY AND ENGINEERING INC
1812 CORNWALL AVENUE
BELLINGHAM, WASHINGTON 98225
360.671.7387

GEOLOGICAL SERVICES:
GEOTEST SERVICES, INC
741 MARINE DRIVE
BELLINGHAM, WASHINGTON 98225
360.733.7518

ELECTRICAL
PUGET SOUND ENERGY
360.766.5571

WHATCOM COUNTY HEALTH DEPARTMENT
509 GIRARD STREET
BELLINGHAM, WA 98225

CONSTRUCTION SURVEYOR:
COMPASS POINT SURVEY GROUP, INC.
523 FRONT STREET
LYNDEN, WASHINGTON 98264
360.354.8320

LEGEND:	PROPOSED
	ROAD CENTERLINE
	RIGHT OF WAY
	LOT LINE
	WATERLINE
	WATER SERVICE
	FENCE LINE
	WATER JOINT
	WATER VALVE
	FIRE HYDRANT
	STORM SEWER
	CATCHBASIN
	SIGN
	ROOF DRAIN CLEANOUT
	CEMENT CONCRETE
	ASPHALT CONCRETE

VOLUME / SURFACE DATA (S.F.)	
TOTAL DISTURBANCE AREA:	14,600 S.F.
IMPERVIOUS STREETS (PUBLIC):	9,800 S.F.
EARTHWORK CUT	509 C.Y.
FILL	7 C.Y.
ROAD & SIDEWALK	510 C.Y.
UTILITY SIGN-OFF [STATUS]	
(ELECTRICAL)	IN REVIEW
(TELEPHONE)	N/A
(CABLE)	N/A
(GAS)	N/A

SHEET NUMBER	SHEET INDEX
1	COVER SHEET
2	ROAD & DRAINAGE PLAN/PROFILE
3	ROAD & DRAINAGE PLAN/PROFILE
4	WATER IMPROVEMENT PLAN
5	DETAILS
6	DETAILS
7	DETAILS
8	STRIPING/SIGNAGE PLAN
9	PLAYGROUND IMPROVEMENTS

SURVEYOR'S CERTIFICATION
I CERTIFY THAT ON 07/30/09 A FIELD AS-BUILT SURVEY WAS PERFORMED AT FIRST AVENUE BY ME OR UNDER MY DIRECTION AND THAT DATA FROM THAT FIELD SURVEY, INCLUDING LOCATION SHOTS, INVERT MEASUREMENTS AND FIELD BOOK NOTES WERE USED IN PREPARATION OF THESE AS-BUILT PLANS. SAID FIELD SURVEY WORK MEETS OR EXCEEDS THE MINIMUM SURVEY STANDARDS AS PER WAC 332.130.001.

SURVEYOR NAME & LICENSE NUMBER
10/20/09
DATE




CALL TWO BUSINESS DAYS
BEFORE YOU DIG
WASHINGTON STATE ONE-CALL
1-800-424-5555
IT'S THE LAW! (RCW 19.122)

AS-BUILT
Drawing: ASBUILT5.dwg
Date: 10/16/09
Dir: GJ 39-02
Crd: 1ST-CON.crd

COMPASS POINT SURVEY GROUP INC.
523 FRONT STREET, LYNDEN WA. 98264
P.H. (360) 354 - 8320 FAX (360) 354 - 8321



DRAWN BY: CS
REVIEWED BY: SH
SHEET: 01 OF 09

003916.001 10-26-09 DD

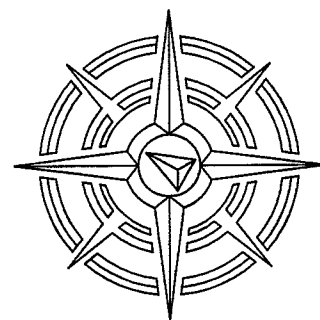

SHEET NOTES

- 1 AS-BUILT STORM SEWER PIPE, 12"Ø
- 2 AS-BUILT STORM SEWER PIPE, 15"Ø
- 3 AS-BUILT NEW PAVEMENT, TYP
- 4 AS-BUILT SIDEWALK RAMP (SEE TABLE)
- 5 AS-BUILT CONCRETE CURB, GUTTER AND SIDEWALK
- 6 AS-BUILT CHAIN LINK FENCE
- 7 AS-BUILT 12' WIDE SINGLE SWING LOCKING ACCESS GATE, - STA 13+17 TO STA. 13+29
- 8 AS-BUILT PEA GRAVEL BARRIER, SEE SHEET 9
- 9 AS-BUILT 12" PVC PIPE, COUPLE WITH EXISTING CONC PIPE.
USE FERNCO 5006RC COUPLER OR EQUAL.
CONTRACTOR TO VERIFY EXISTING PIPE MATERIAL AND PLAN ACCORDINGLY.
- 10 AS-BUILT CONCRETE VERTICAL CURB/BARRIER - STA 13+12 TO STA 14+07

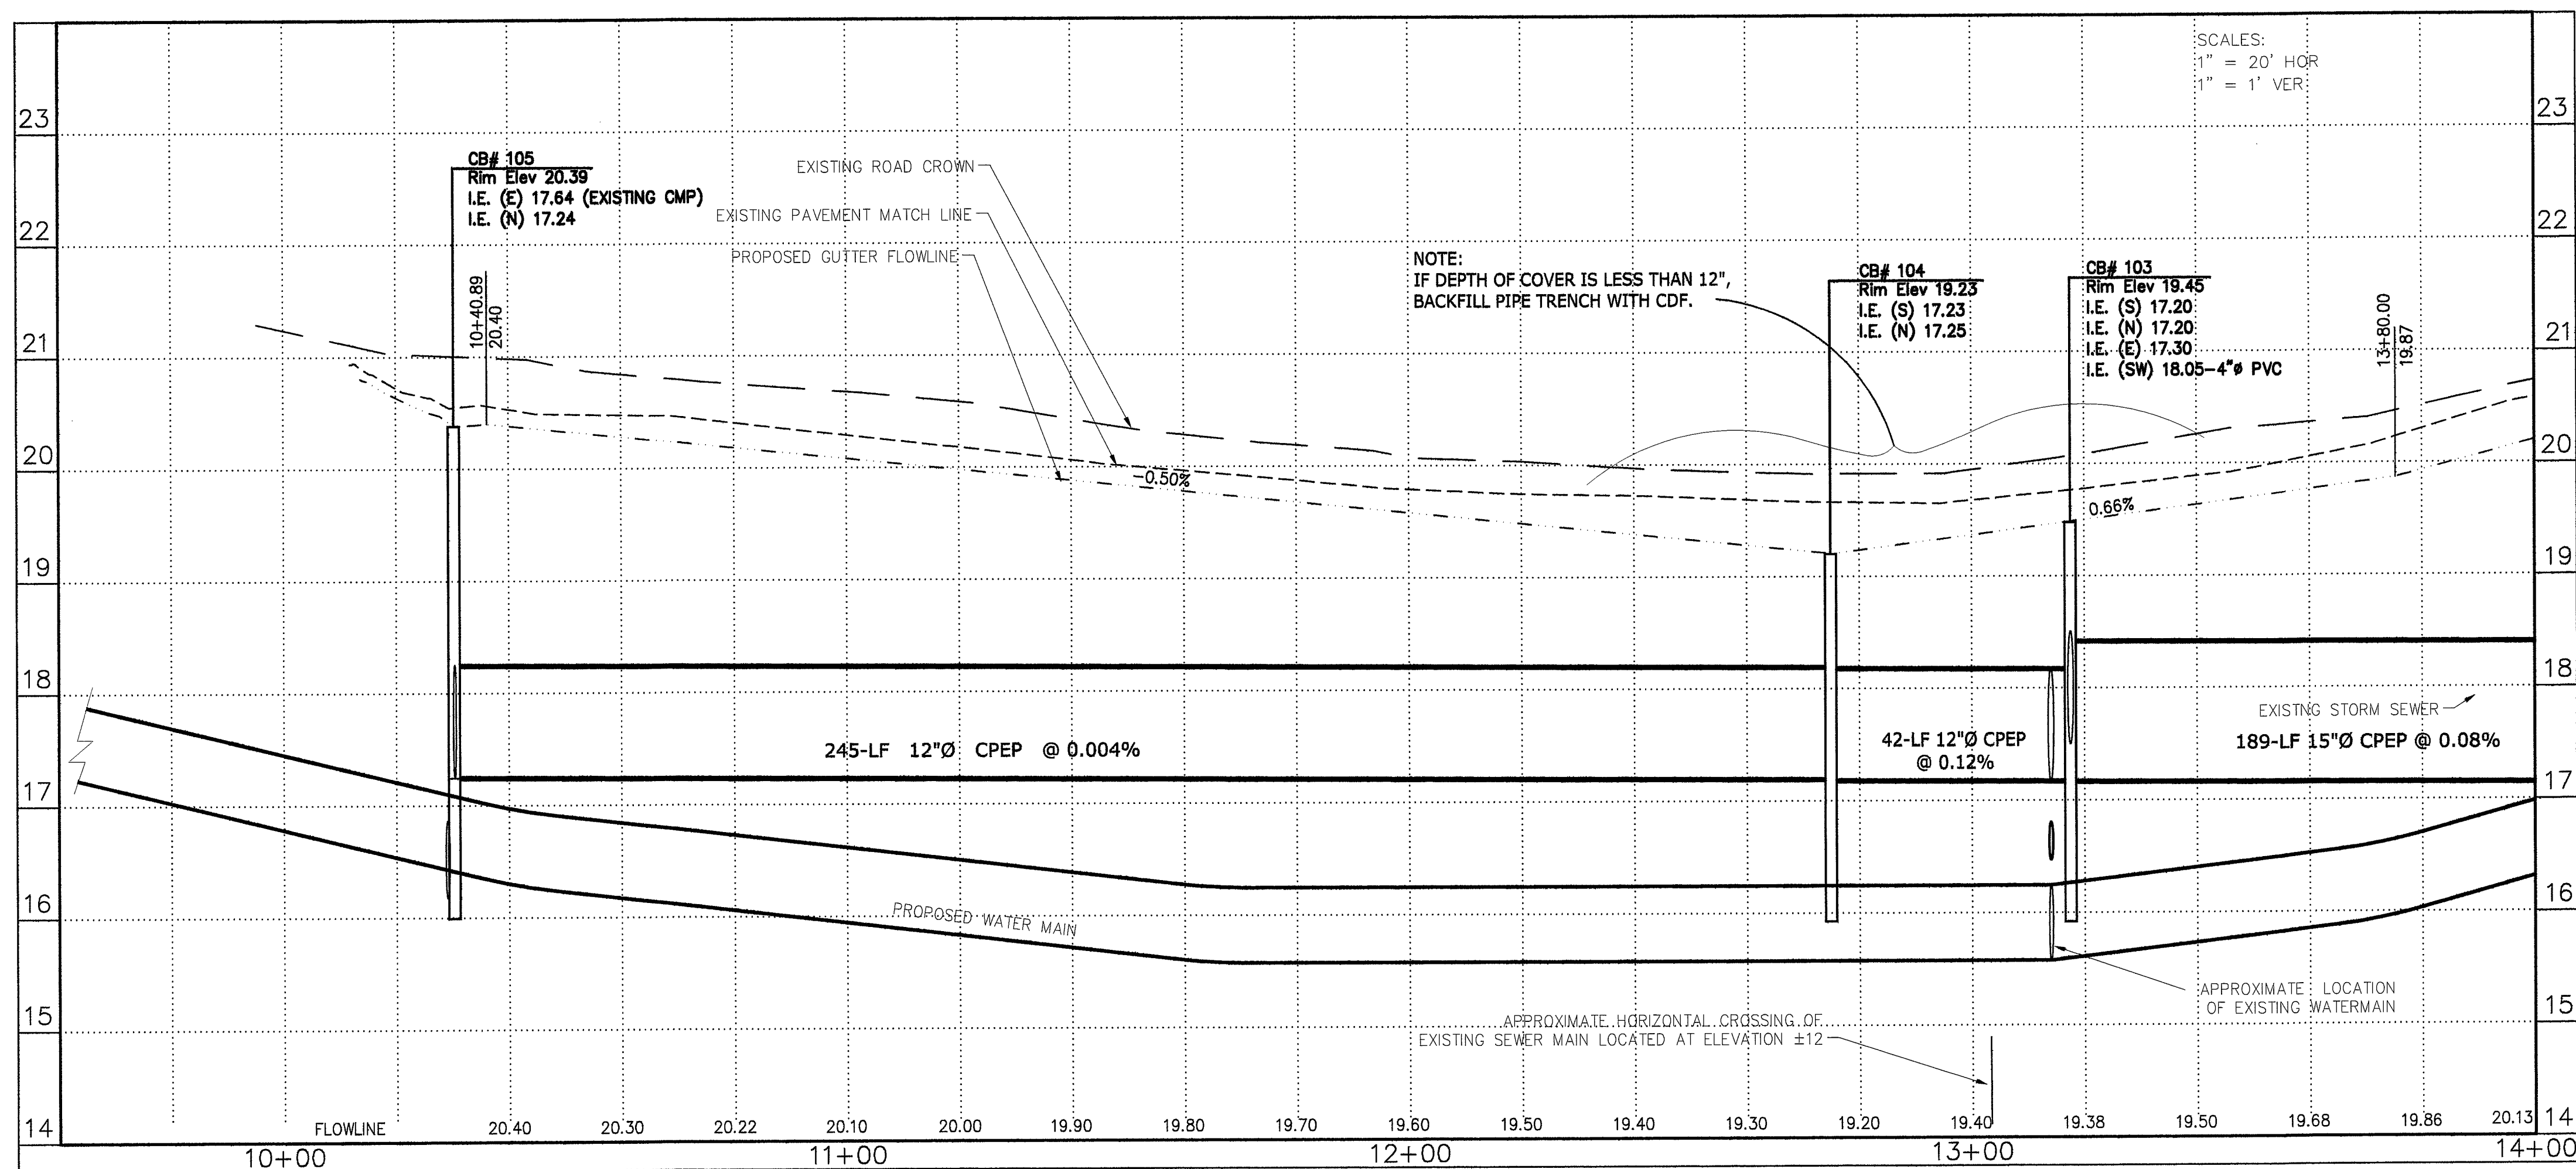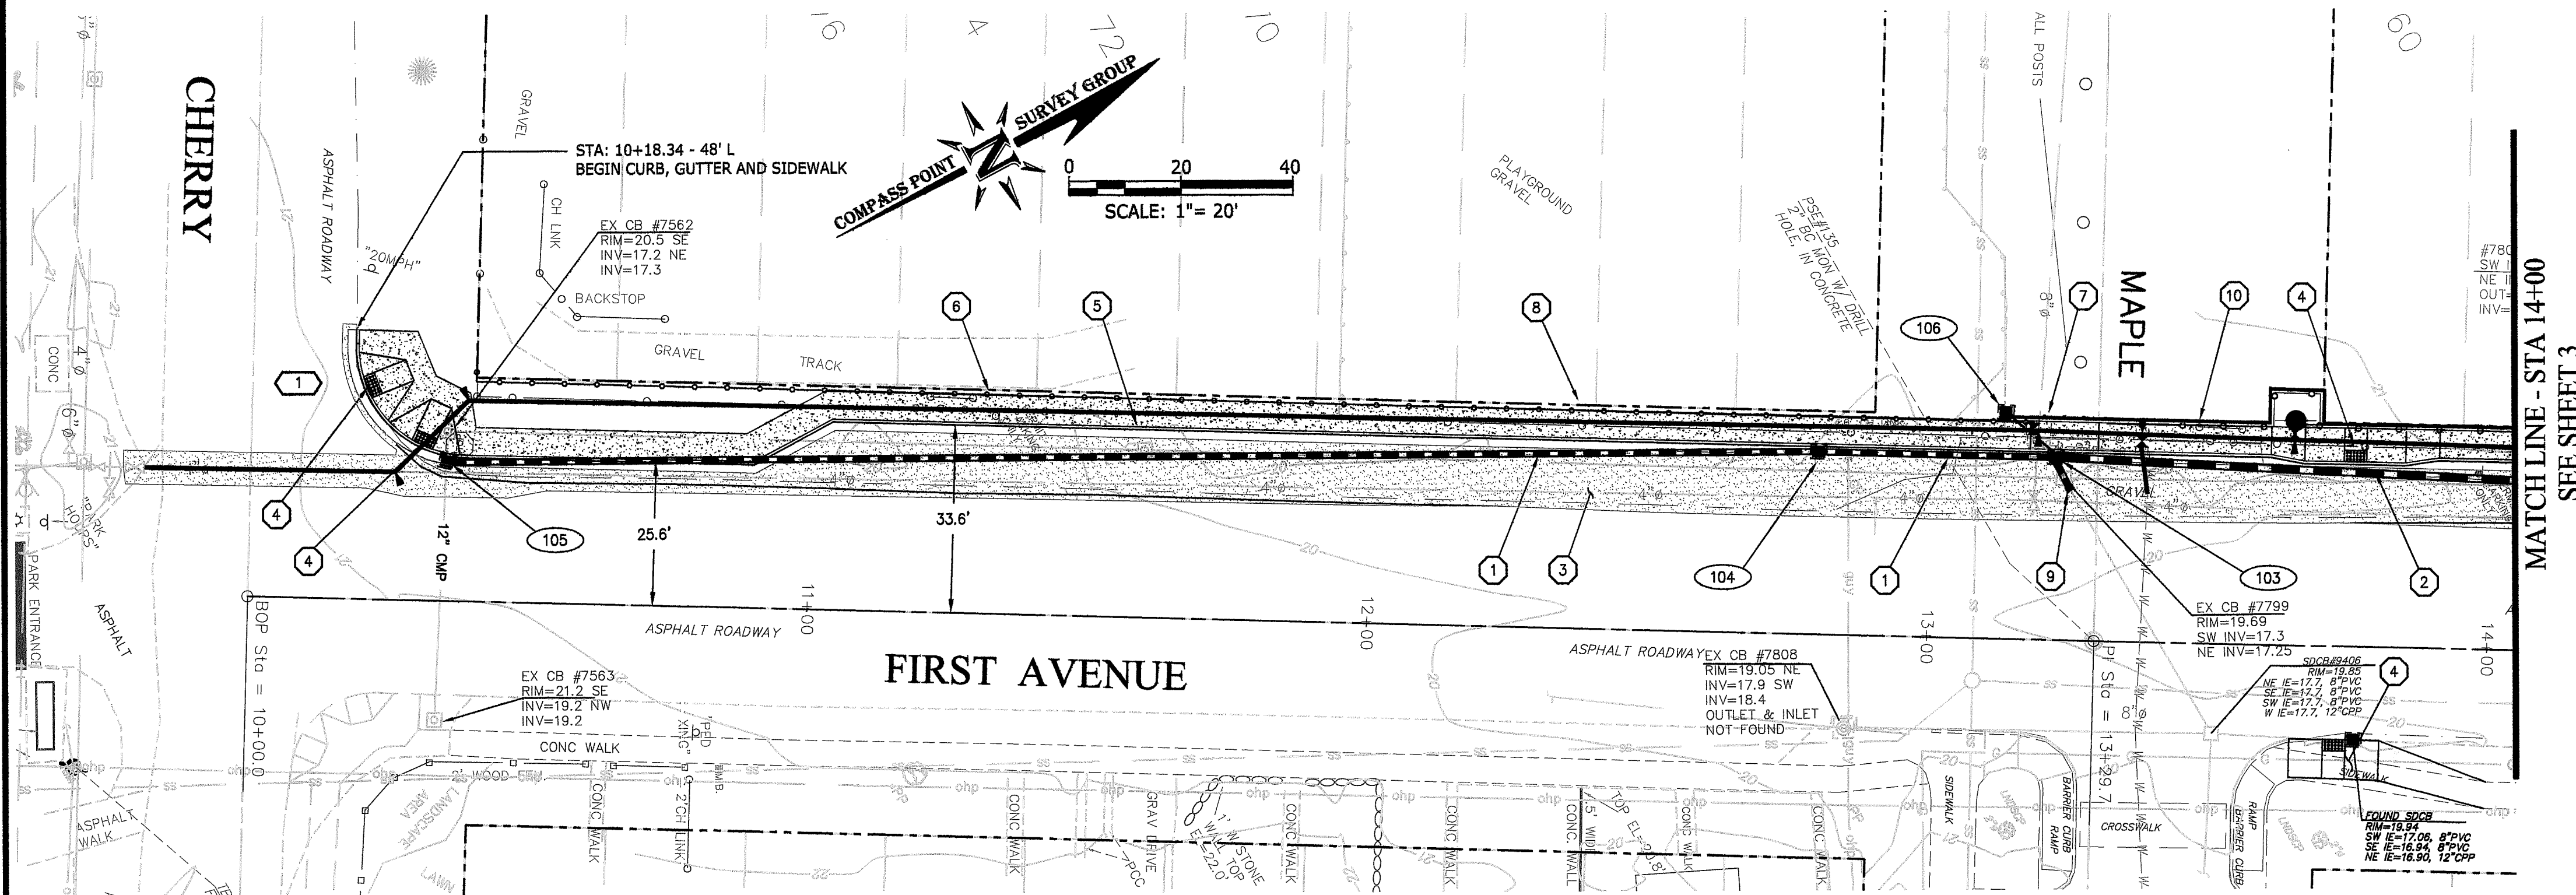

SIDEWALK RAMP LOCATION

TYPE	STATION - OFFSET (CENTER AT FACE OF CURB)	COMMENTS
TYPE 2	10+20.6-37.8' L	
TYPE 2	10+30.6-27.8' L	
TYPE 1	13+75.6-33.1' L	
TYPE 1	13+75.5-16.7' R	LANDING TO MATCH EXISTING SIDEWALK AS SHOWN

CATCH BASIN/INLET TABLE

NO.	TYPE	STATION - OFFSET (at face of curb)	COMMENTS
103	TYPE 1	13+22.2-33.6' L	
104	TYPE 1	12+79.8-33.6' L	
105	TYPE 1	10+35.3-25.9' L	
106		13+13.1-40.6' L	YARD DRAIN

CURB RETURN CURVE DATA

No.	RADIUS	DELTA	LENGTH
1	20	90°03'56"	31.44'

FLOWLINE OF CURB RETURN



NO.	DESCRIPTION	ELEV.
1	BCR Sta 10+18.40 -45.62 FT L	20.81
	1/4 Δ	20.78
	1/2 Δ	20.65
	3/4 Δ	20.50
	ECR Sta 10+38.40 -25.60 FT L	20.39


SURVEYOR'S CERTIFICATION

I CERTIFY THAT ON 07/30/09 A FIELD AS-BUILT SURVEY WAS PERFORMED AT FIRST AVENUE BY ME OR UNDER MY DIRECTION AND THAT DATA FROM THAT FIELD SURVEY, INCLUDING LOCATION SHOTS, INVERT MEASUREMENTS AND FIELD BOOK NOTES WERE USED IN PREPARATION OF THESE AS-BUILT PLANS. SAID FIELD SURVEY WORK MEETS OR EXCEEDS THE MINIMUM SURVEY STANDARDS AS PER WAC 332.130.000.


Scott G. Harkness
SURVEYOR NAME & LICENSE NUMBER

10/20/09
DATE

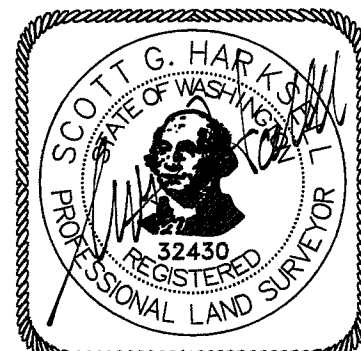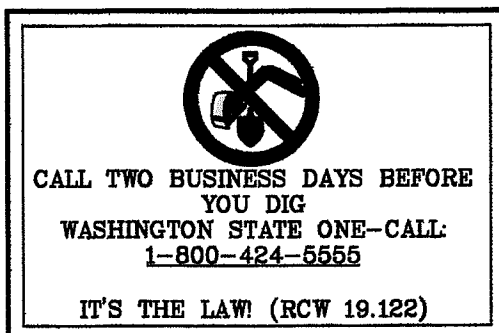

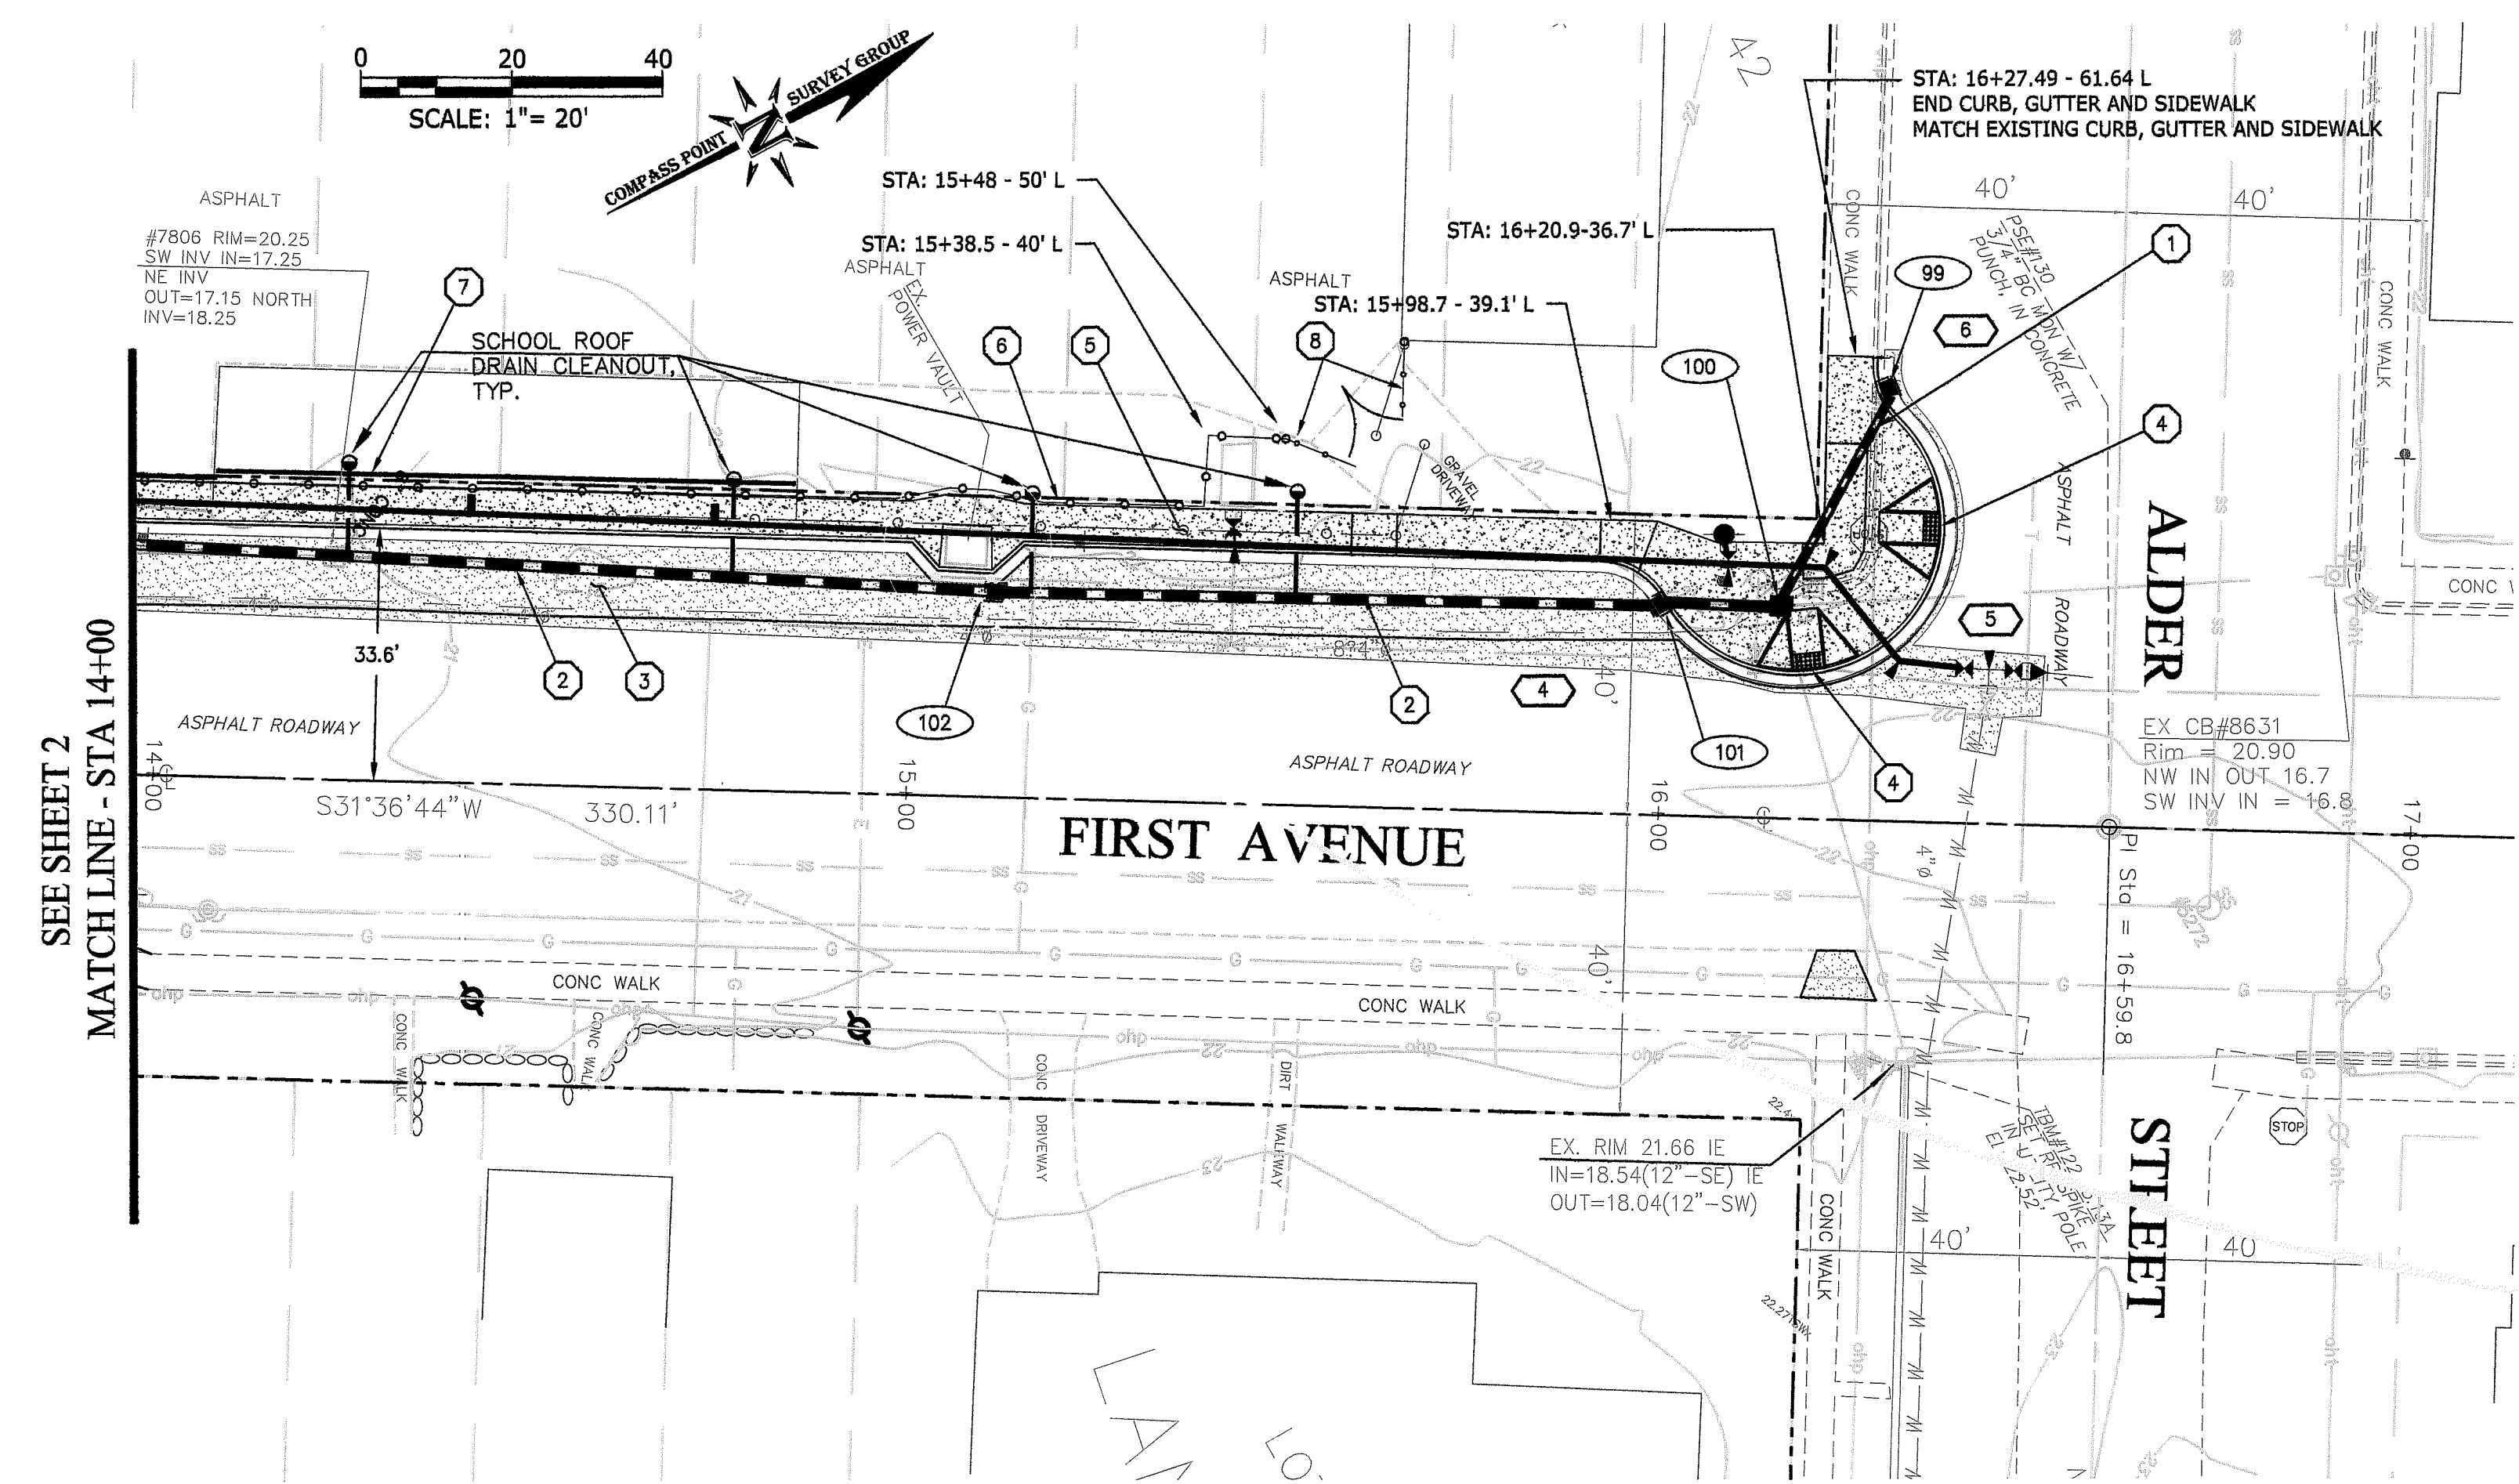

- SHEET NOTES:**
- AS-BUILT STORM SEWER PIPE, 12"Ø
 - AS-BUILT STORM SEWER PIPE, 15"Ø
 - AS-BUILT NEW PAVEMENT, TYP
 - AS-BUILT SIDEWALK RAMP (SEE TABLE)
 - AS-BUILT CONCRETE CURB, GUTER AND SIDEWALK
 - AS-BUILT CHAIN LINK FENCE
 - AS-BUILT PEA GRAVEL BARRIER
 - AS-BUILT 20' WIDE CHAIN LINK DOUBLE GATE, CONNECT TO EXISTING LOCATION ON NORTH END.

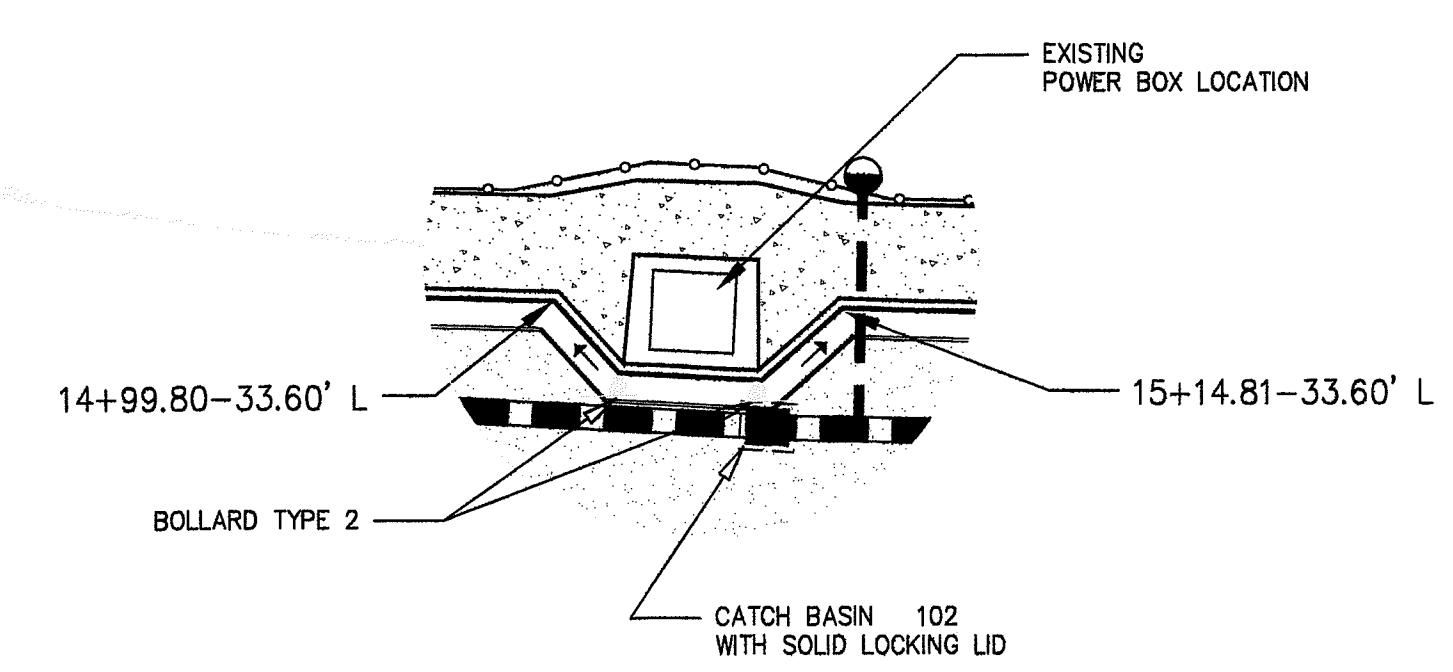


DETAIL AT POWER BOX

CALL TWO BUSINESS DAYS BEFORE YOU DIG
WASHINGTON STATE ONE-CALL
1-800-424-6555
IT'S THE LAW! (RCW 19.122)

CURB RETURN CURVE DATA			
No.	RADIUS	DELTA	LENGTH
4	10	58°49'47"	10.27'
No.	RADIUS	DELTA	LENGTH
5	20	197°50'05"	68.36'
No.	RADIUS	DELTA	LENGTH
6	10	50°11'15"	8.76'


SIDEWALK RAMP LOCATION		
TYPE	STATION - OFFSET (CENTER AT FACE OF CURB)	COMMENTS
TYPE 2	16+19.3 - 19.3' L	
TYPE 2	16+36.9 - 39.1' L	


CATCH BASIN TABLE			
NO.	TYPE	STATION - OFFSET (at face of curb)	COMMENTS
99	TYPE 1	16+28.1 - 57.2' L	
100	TYPE 1	16+15.5 - 28.3' L	CENTER OF STRUCTURE
101	TYPE 1	15+99.9 - 28.4' L	
102	TYPE 1	15+11.1 - 27.3' L	CENTER OF STRUCTURE

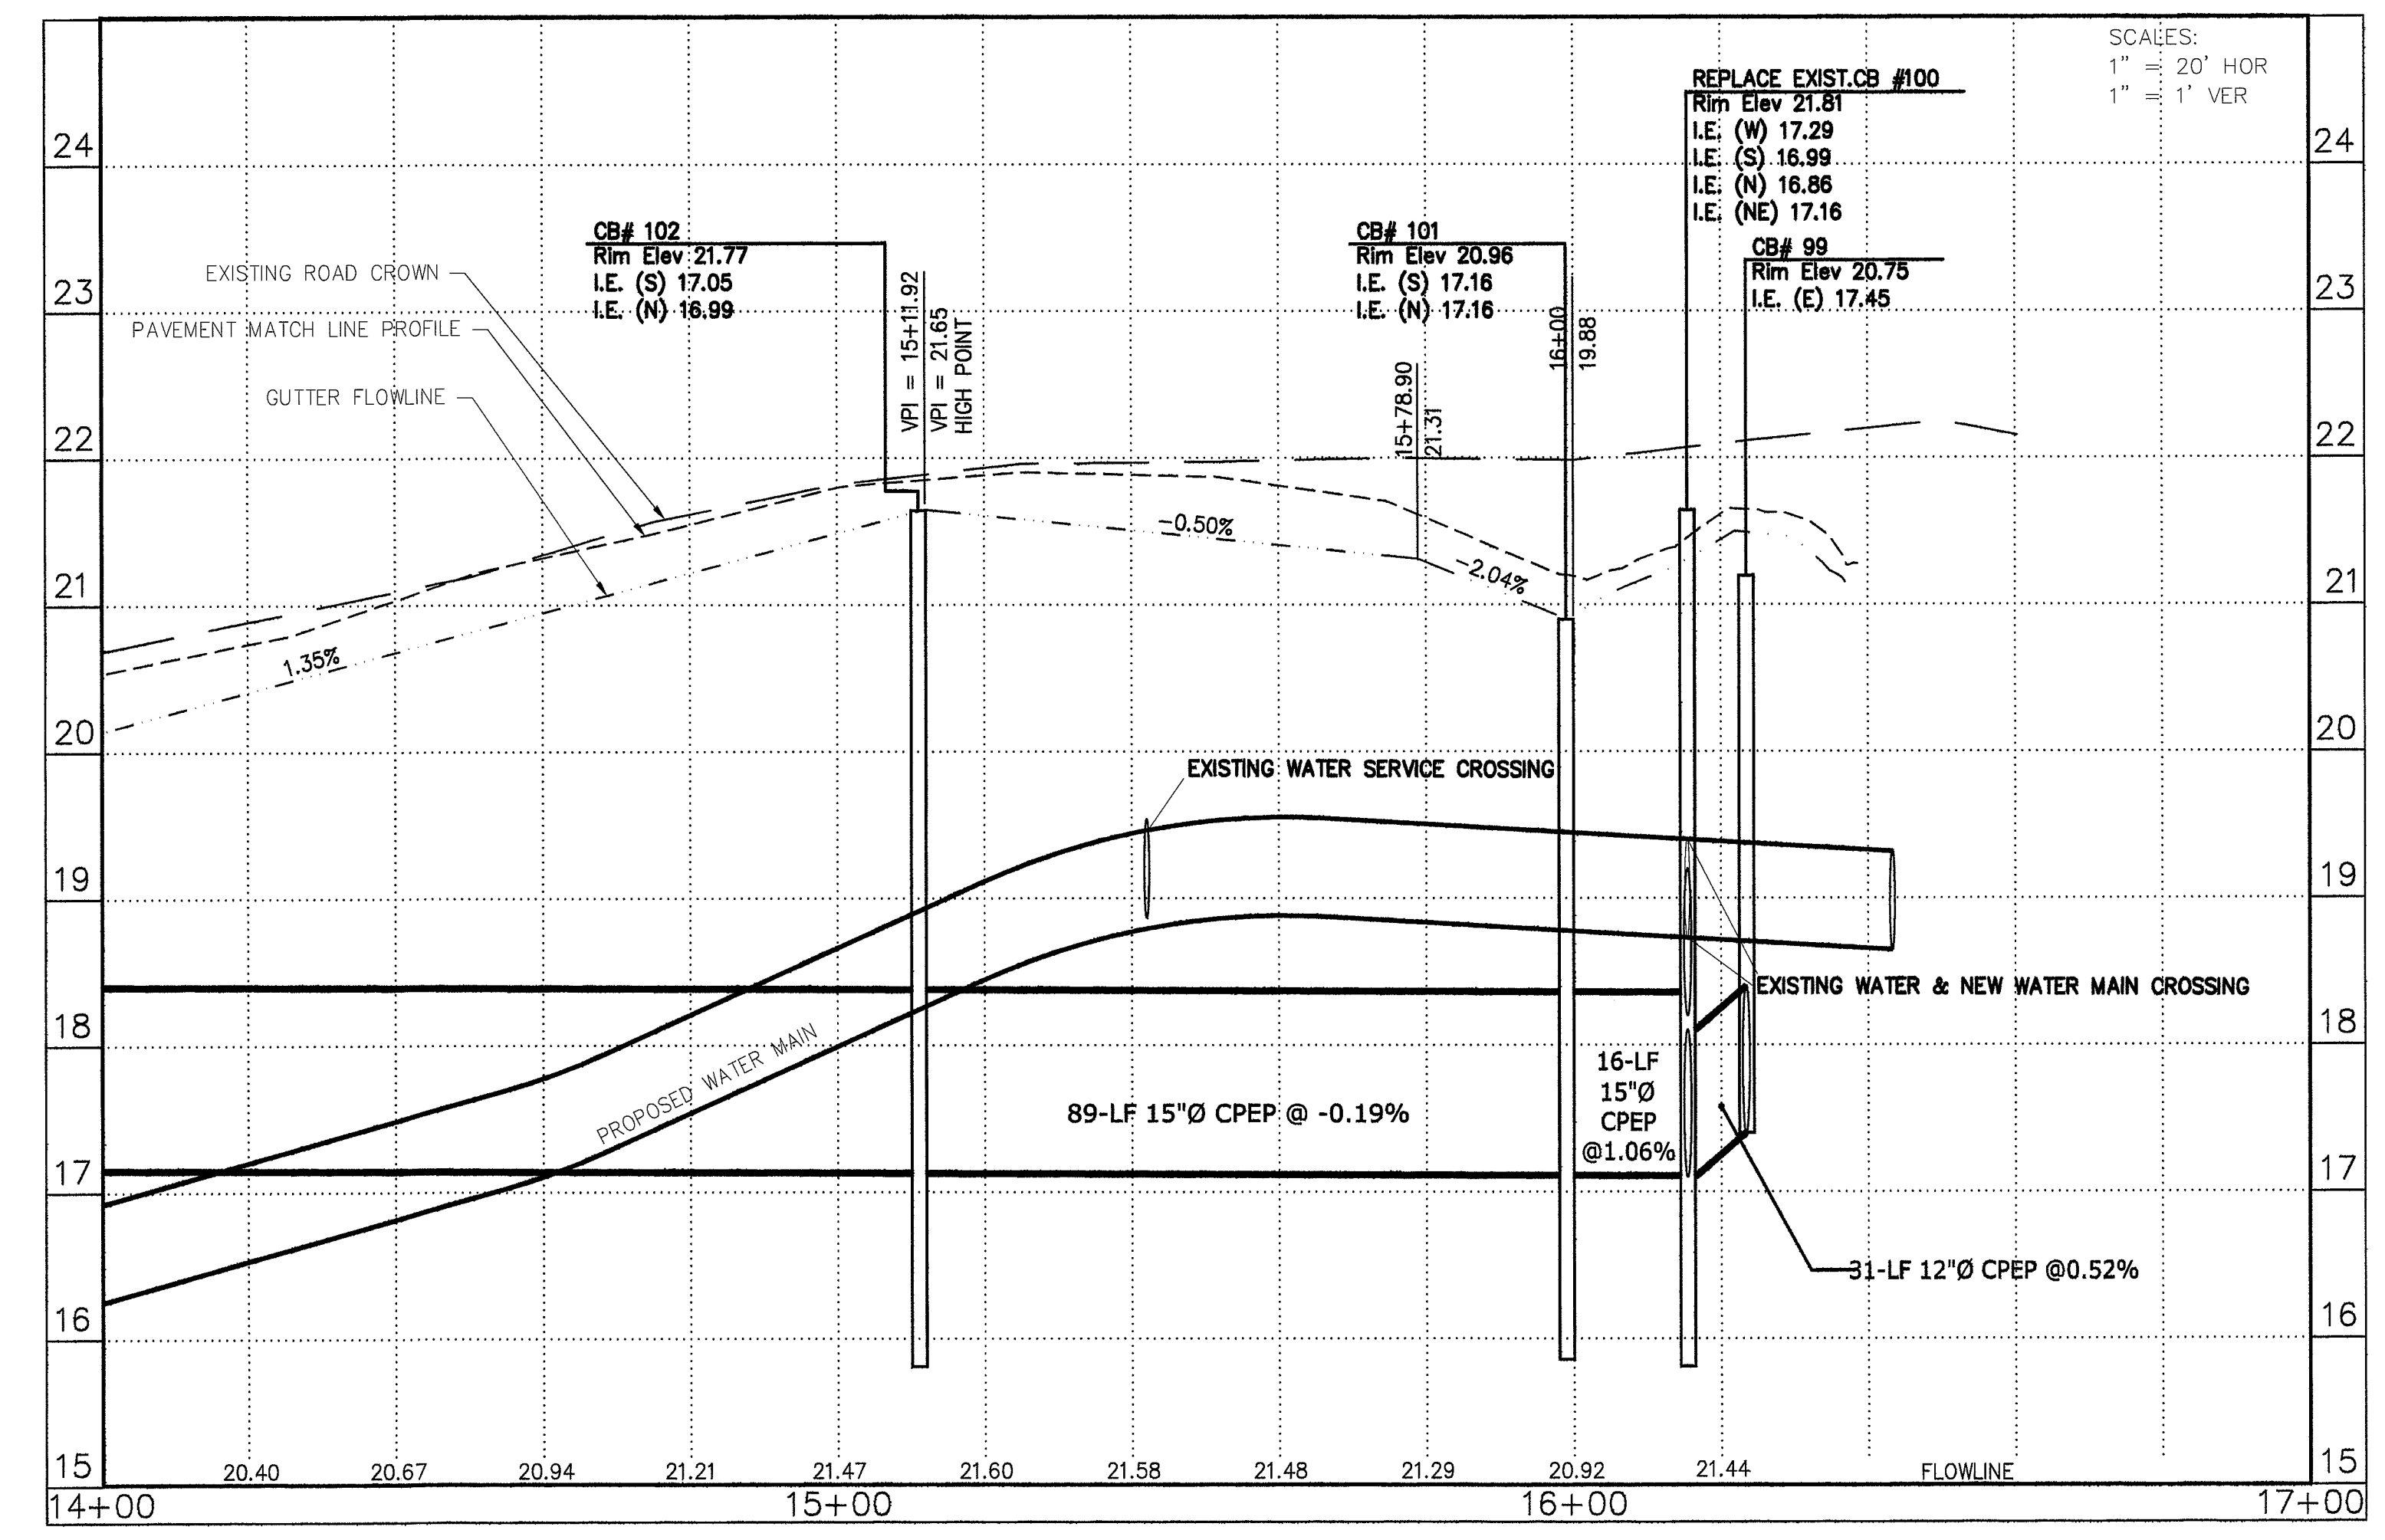

DESCRIPTION		ELEV.
BCR Sta 15+91.23 - 33.60 FT L		21.06
1/2 Δ		20.97
ECR Sta 15+99.79 - 28.77 FT L		21.91
DESCRIPTION		ELEV.
BCR Sta 15+99.79 - 28.77 FT L		21.91
1/8 Δ		21.09
2/8 Δ		21.25
3/8 Δ		21.50
4/8 Δ		21.46
5/8 Δ		21.23
6/8 Δ		21.15
7/8 Δ		21.04
ECR Sta 16+30.23 - 54.04 FT L		20.82
DESCRIPTION		ELEV.
BCR (Sta 16+30.23 - 54.04 FT L		20.82
1/2 Δ		20.74
ECR Sta 16+26.90 - 61.54 FT L		20.79

SURVEYOR'S CERTIFICATION
I CERTIFY THAT ON 07/30/09 A FIELD AS-BUILT SURVEY WAS PERFORMED AT FIRST AVENUE BY ME OR UNDER MY DIRECTION AND THAT DATA FROM THAT FIELD SURVEY, INCLUDING LOCATION SHOTS, INVERT MEASUREMENTS AND FIELD BOOK NOTES WERE USED IN PREPARATION OF THESE AS-BUILT PLANS. SAID FIELD SURVEY WORK MEETS OR EXCEEDS THE MINIMUM SURVEY STANDARDS AS PER WAC 332-130-000.
SURVEYOR NAME & LICENSE NUMBER: *Scott G. Harkness* 32430
DATE: 10/20/09

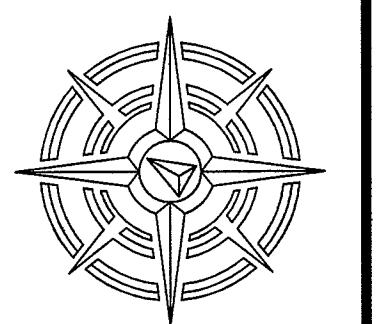

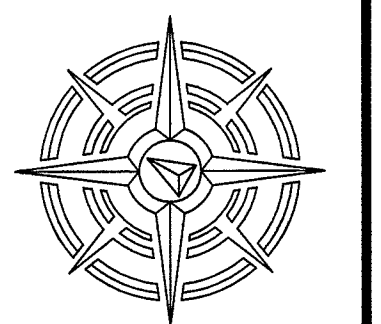

SHEET NOTES:

- STA: 9+80-22' L
CONNECT TO EXISTING 8" GATE VALVE, FLX&M;
INSTALL ANY BLOCKING OR RESTRAINTS
NECESSARY PER THE CITY OF FERNDALE
REQUIREMENTS.
- AS-BUILT 45° BEND STA: 10+26-22.9' L
W/ THRUST BLOCK PER CITY OF FERNDALE
DEVELOPMENT STANDARDS
- AS-BUILT 45° BEND STA: 10+39-35.9' L
W/ THRUST BLOCK PER CITY OF FERNDALE
DEVELOPMENT STANDARDS
- RECONNECT EXISTING WATER SERVICE VIA 1"
CORP STOP. APPROX. FIELD LOCATIONS
STA: ±11+02 1" SERVICE LINE TO NEW 1"
STA: ±11+48 ¾" SERVICE LINE TO NEW 1"
STA: ±11+72 ¾" SERVICE LINE TO NEW 1"
STA: ±12+27 ¾" SERVICE LINE TO NEW 1"
STA: ±14+41 ¾" SERVICE LINE TO NEW 1"
STA: ±15+73 ¾" SERVICE LINE TO NEW 1"
- STA: 13+18.6-26.9' L
REMOVE EXISTING HYDRANT, VALVE ON 2 TEES,
CAP TEES, REMOVE EXISTING 8" DIP
AS-BUILT NEW 8"x8" TEE ON END OF EXISTING
8" MAIN EXTENDING WEST ON MAPLE STREET.
1- 8" TEE
1- 8" VALVE & BLOCKING
1- 8" PLUG
W/ THRUST BLOCK PER CITY OF FERNDALE
DEVELOPMENT STANDARDS
- INSTALL 8" D.I.P.
- STA: 13+38.7-26.6 L
AS-BUILT
1- 8"x 8" TEE
1- 8" GATE VALVE
W/ THRUST BLOCK PER CITY OF FERNDALE
DEVELOPMENT STANDARDS
- STA: 15+42.5-36.8' L
AS-BUILT SERVICE TAP OR TEE & VALVE TO
MAINTAIN THE EXISTING SERVICE CONNECTION FOR
ELEMENTARY SCHOOL
W/ THRUST BLOCK PER CITY OF FERNDALE
DEVELOPMENT STANDARDS
- STA: 16+12.26-22.9 L
REMOVE EXISTING FIRE HYDRANT, VALVE AND
FITTINGS.
- STA: 16+43.3-20.5 L
INSTALL 8"x8"x4" TEE, CONNECT TO EXISTING 4"
VALVE-FL,
2- 8" VALVE
1- 8"x8"x4" TEE
1- 8"x4" REDUCER
W/ THRUST BLOCK PER CITY OF FERNDALE
DEVELOPMENT STANDARDS
- AS-BUILT 45° BEND STA: 16+21-33.5' L
W/ THRUST BLOCK PER CITY OF FERNDALE
DEVELOPMENT STANDARDS
- AS-BUILT 45° BEND STA: 16+31-21.4' L
W/ THRUST BLOCK PER CITY OF FERNDALE
DEVELOPMENT STANDARDS
- STA: 13+64.8 - 41' L
1- 8"x 6" TEE
1- FIRE HYDRANT ASSEMBLY (M & H 929)
W/ THRUST BLOCK PER CITY OF FERNDALE
DEVELOPMENT STANDARDS
- STA: 16+08 - 38' L
1- 8"x 6" TEE
1- FIRE HYDRANT ASSEMBLY (M & H 929)
W/ THRUST BLOCK PER CITY OF FERNDALE
DEVELOPMENT STANDARDS

SURVEYOR'S CERTIFICATION


I CERTIFY THAT ON 07/30/09 A FIELD AS-BUILT SURVEY WAS PERFORMED AT
FIRST AVENUE BY ME OR UNDER MY DIRECTION AND THAT DATA FROM THAT
FIELD SURVEY, INCLUDING LOCATION SHOTS, INVERT MEASUREMENTS AND FIELD
BOOK NOTES WERE USED IN PREPARATION OF THESE AS-BUILT PLANS. SAID
FIELD SURVEY WORK MEETS OR EXCEEDS THE MINIMUM SURVEY STANDARDS AS
PER WAC 332.130.090.

Scott G. Harter
SURVEYOR NAME & LICENSE NUMBER 32430

10/26/09
DATE



CALL TWO BUSINESS DAYS BEFORE
YOU DIG
WASHINGTON STATE ONE-CALL:
1-800-424-5555
IT'S THE LAW! (RCW 19.122)

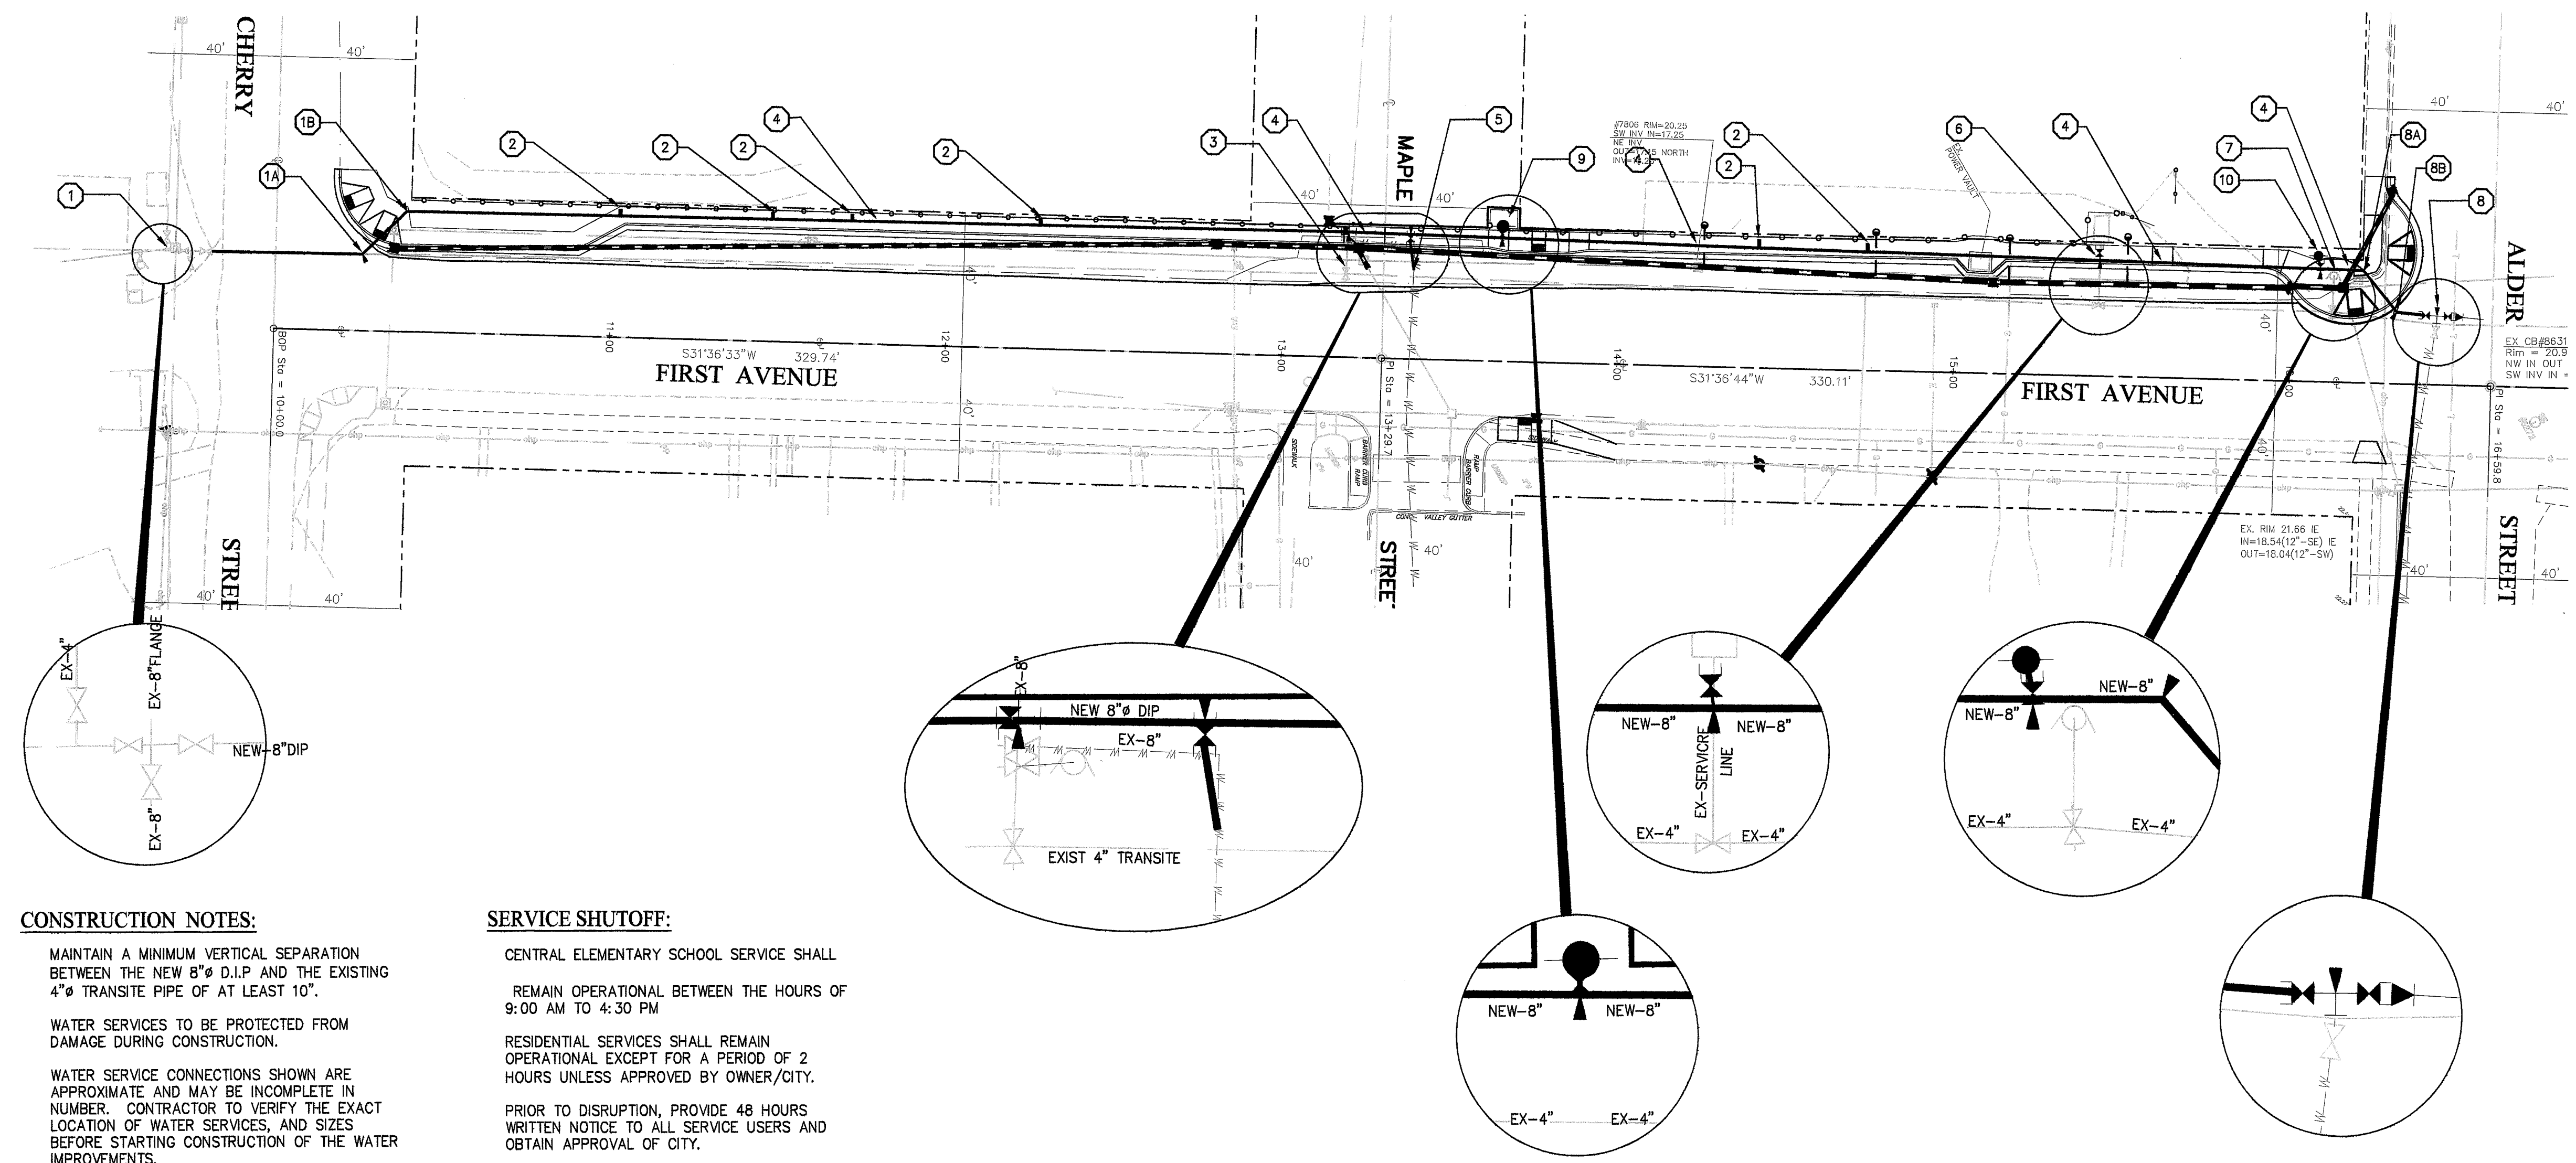

CONSTRUCTION NOTES:

MAINTAIN A MINIMUM VERTICAL SEPARATION
BETWEEN THE NEW 8" D.I.P. AND THE EXISTING
4" TRANSITE PIPE OF AT LEAST 10".

WATER SERVICES TO BE PROTECTED FROM
DAMAGE DURING CONSTRUCTION.

WATER SERVICE CONNECTIONS SHOWN ARE
APPROXIMATE AND MAY BE INCOMPLETE IN
NUMBER. CONTRACTOR TO VERIFY THE EXACT
LOCATION OF WATER SERVICES, AND SIZES
BEFORE STARTING CONSTRUCTION OF THE WATER
IMPROVEMENTS.


SERVICE SHUTOFF:

CENTRAL ELEMENTARY SCHOOL SERVICE SHALL
REMAIN OPERATIONAL BETWEEN THE HOURS OF
9:00 AM TO 4:30 PM

RESIDENTIAL SERVICES SHALL REMAIN
OPERATIONAL EXCEPT FOR A PERIOD OF 2
HOURS UNLESS APPROVED BY OWNER/CITY.


PRIOR TO DISRUPTION, PROVIDE 48 HOURS
WRITTEN NOTICE TO ALL SERVICE USERS AND
OBTAIN APPROVAL OF CITY.

ALL VALVE TURN ONS AND FLUSH OPERATION
TO BE DONE BY CITY

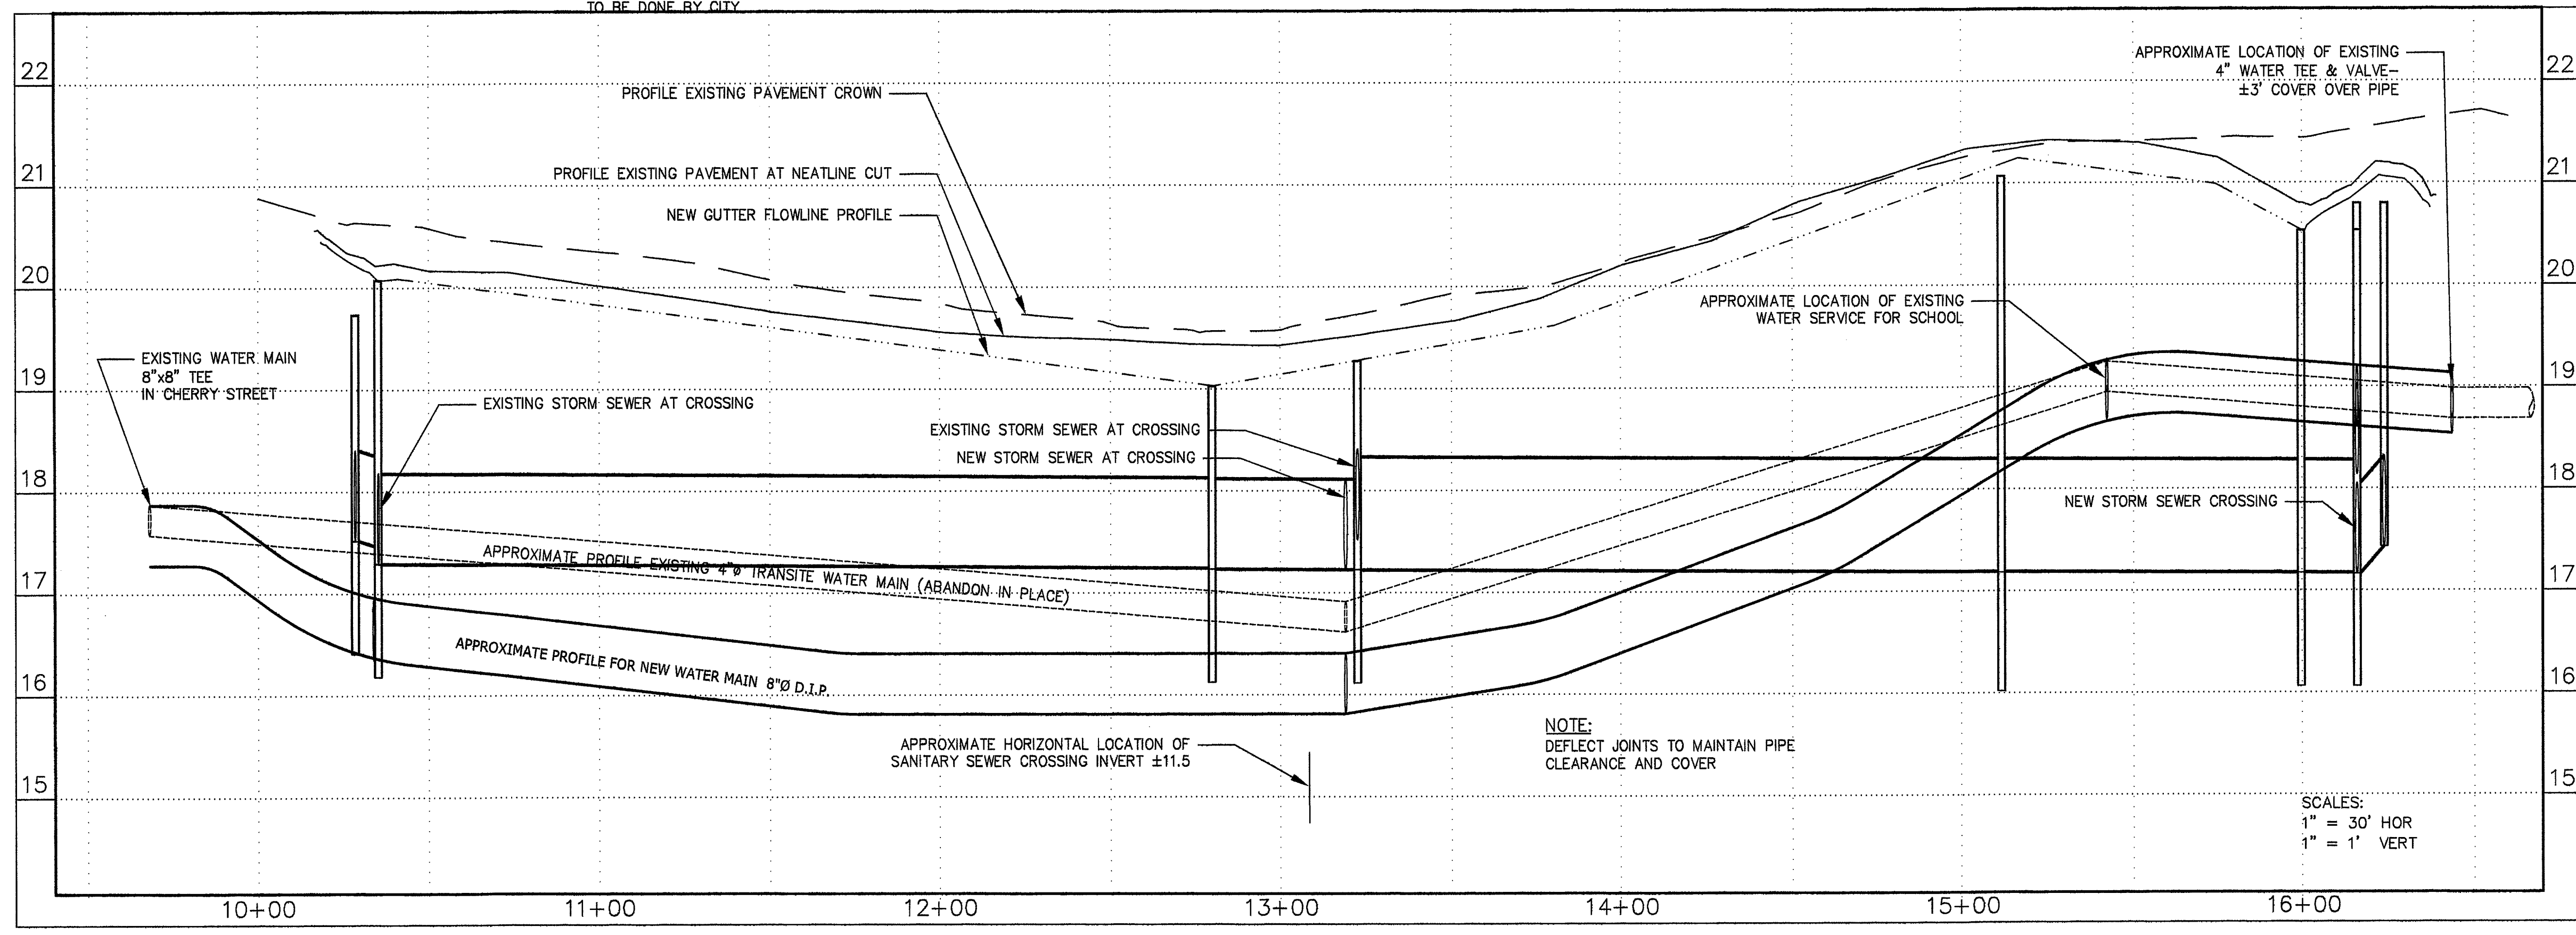


SCALES:
1" = 30' HOR
1" = 1' VERT

NOTE:
DEFLECT JOINTS TO MAINTAIN PIPE
CLEARANCE AND COVER

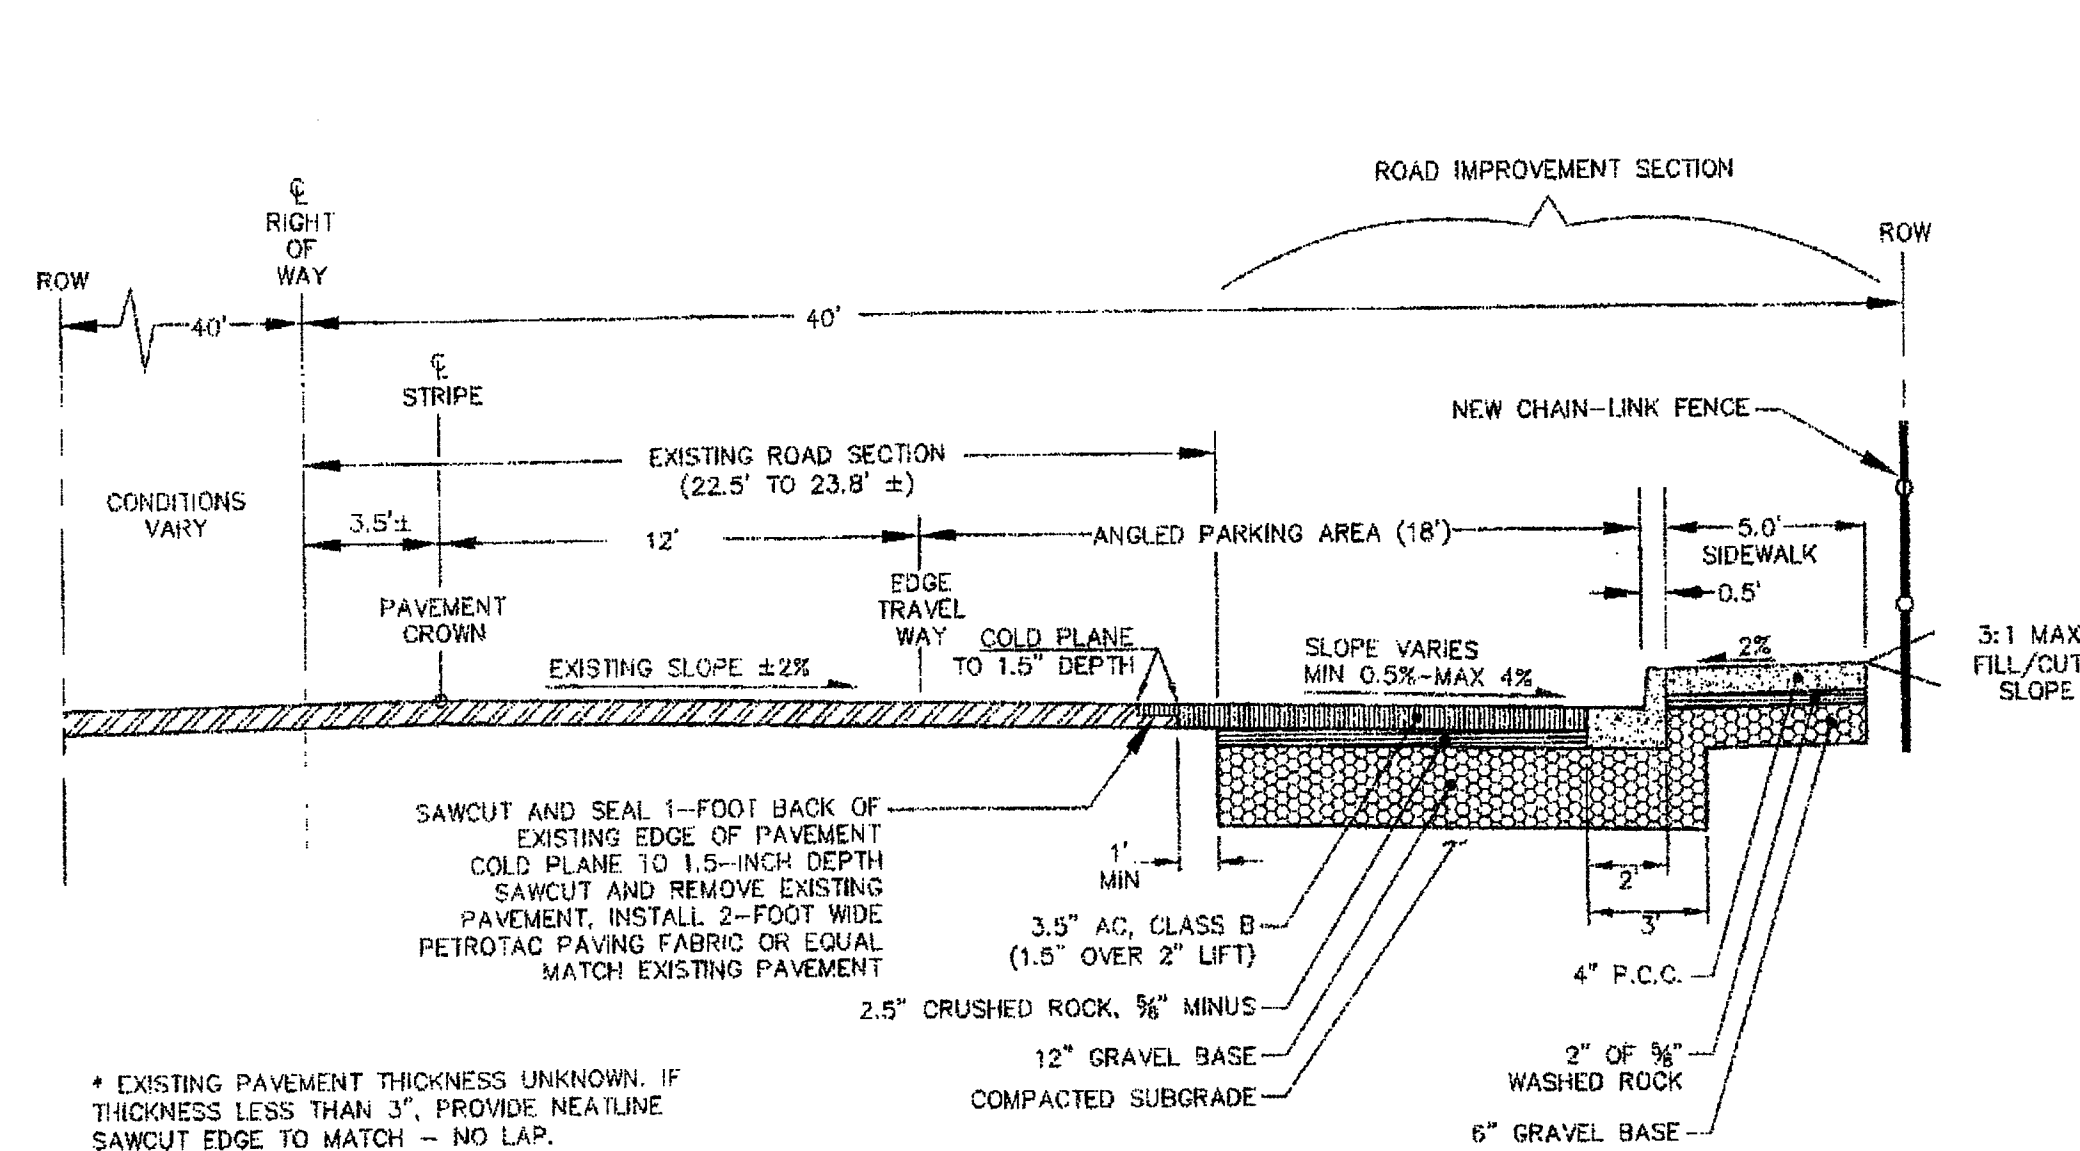

FIRST STREET
CROSS SECTION (TYP)
NTS

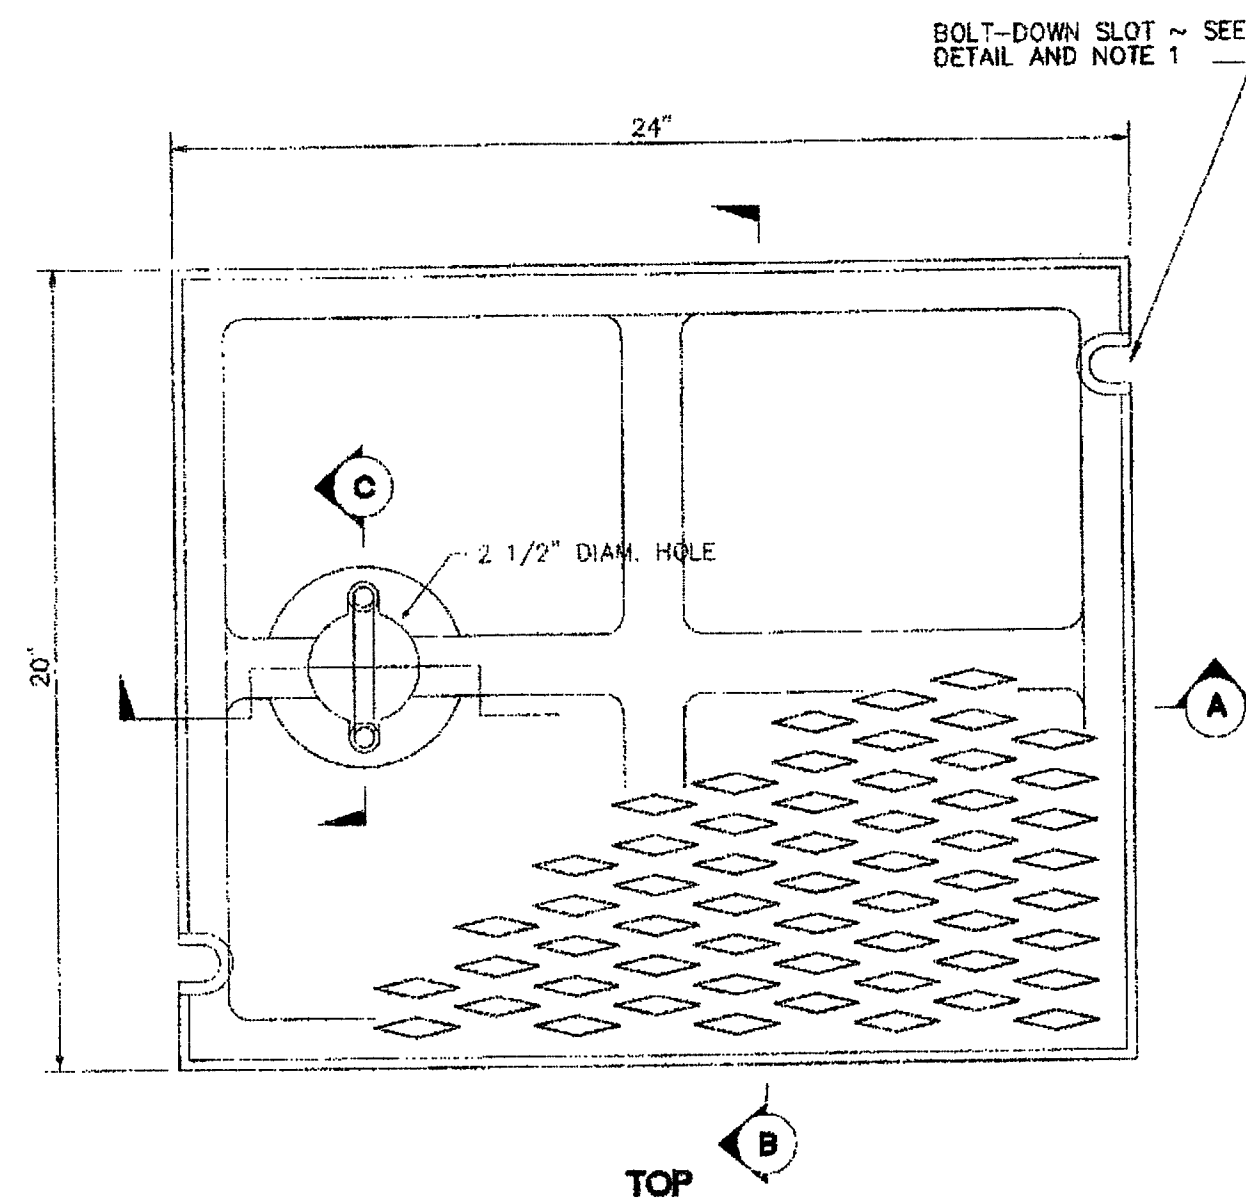


SECTION A


DETAIL - RECTANGULAR SOLID METAL COVER

NOTES


1. When bolt-down covers are specified in the Contract, provide two slots in the cover that are vertically aligned with the holes in the frame. Location of bolt-down slots varies among different manufacturers.
2. Alternative reinforcing designs are acceptable in lieu of the rib design.
3. Refer to Standard Specification 9-05.15(2) for additional requirements.
4. For frame details, see Standard Plan B-30.10.

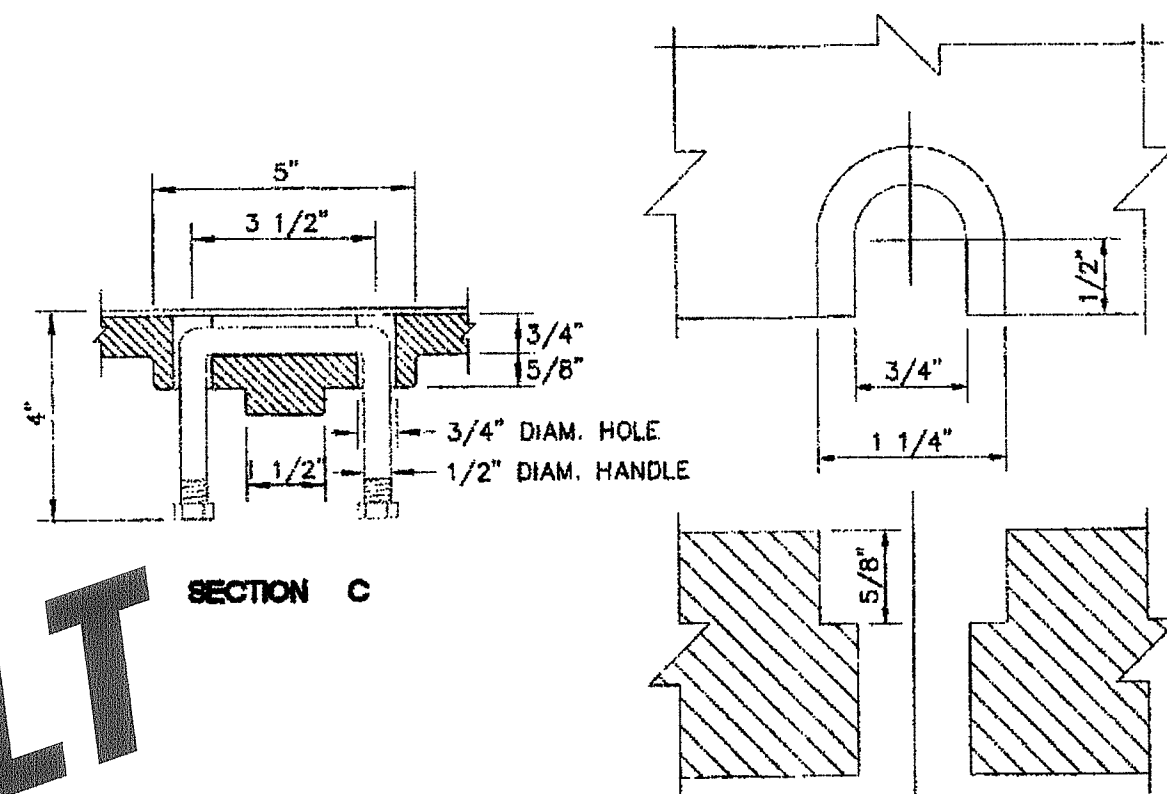

BOLT-DOWN SLOT DETAIL
SEE NOTE 1

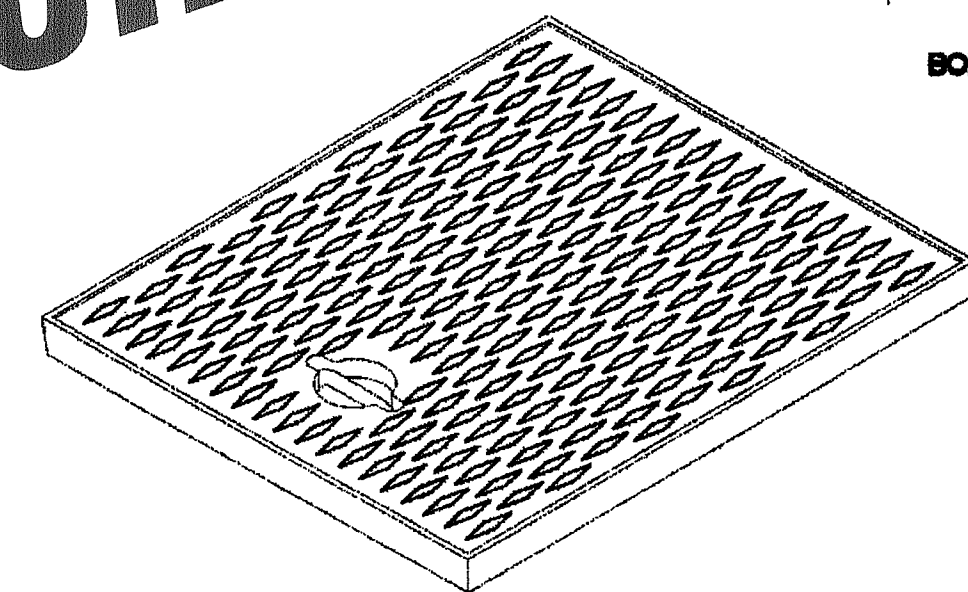


FOR REFERENCE ONLY - NOT AS-BUILT

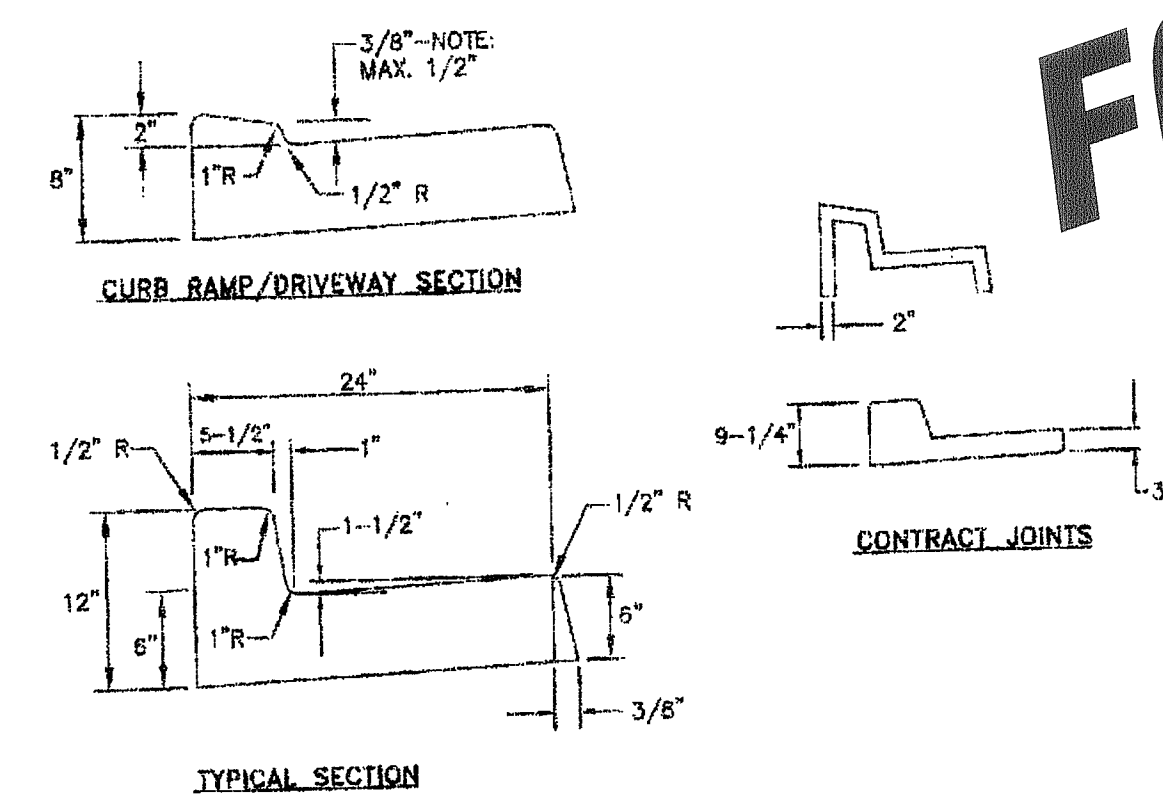

- GENERAL NOTES
1. CONTRACTION JOINTS OF ONE OF THE TYPES SHOWN ABOVE TO BE PLACED 10' O.C. JOINTS MUST COMPLETELY SEVER THE STRUCTURE TO THE POINTS SHOWN. JOINTS MAY BE MADE BY INSERTING MINIMUM 3/16" BITUMINOUS FILLER DUMMY JOINTS. JOINTS SHALL BE CLEANED AND EGGED.
 2. 3/4" EXPANSION JOINTS TO BE PLACED AT DRIVEWAY SECTIONS, CURB RETURNS, CURB RAMPS, & COLD JOINTS OR A MAXIMUM OF 80' O.C. EXPANSION JOINTS SHALL PROTRUDE 1" BELOW THE BOTTOM OF GUTTER.
 3. CONCRETE SHALL BE CEMENT CONCRETE "CLASS 3000".
 4. FINISHED WORK SHALL NOT VARY MORE THAN 1/8" IN GRADE AND 1/4" IN ALIGNMENT WHEN CHECKED WITH A 10' STRAIGHT EDGE.
 5. EXPOSED SURFACES SHALL BE BRUSHED WITH A FIBER HAIR BRUSH.
 6. WHITE PIGMENTED OR TRANSPARENT CURING COMPOUND SHALL BE APPLIED AS OUTLINED IN THE STANDARD SPECIFICATIONS.
 7. FURTHER REQUIREMENTS SHALL BE AS SPECIFIED IN THE STANDARD SPECIFICATIONS.



NOT TO SCALE

JANUARY 2009

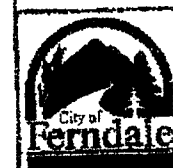

CITY OF FERDALE
CURB AND GUTTER

DETAIL
R-9

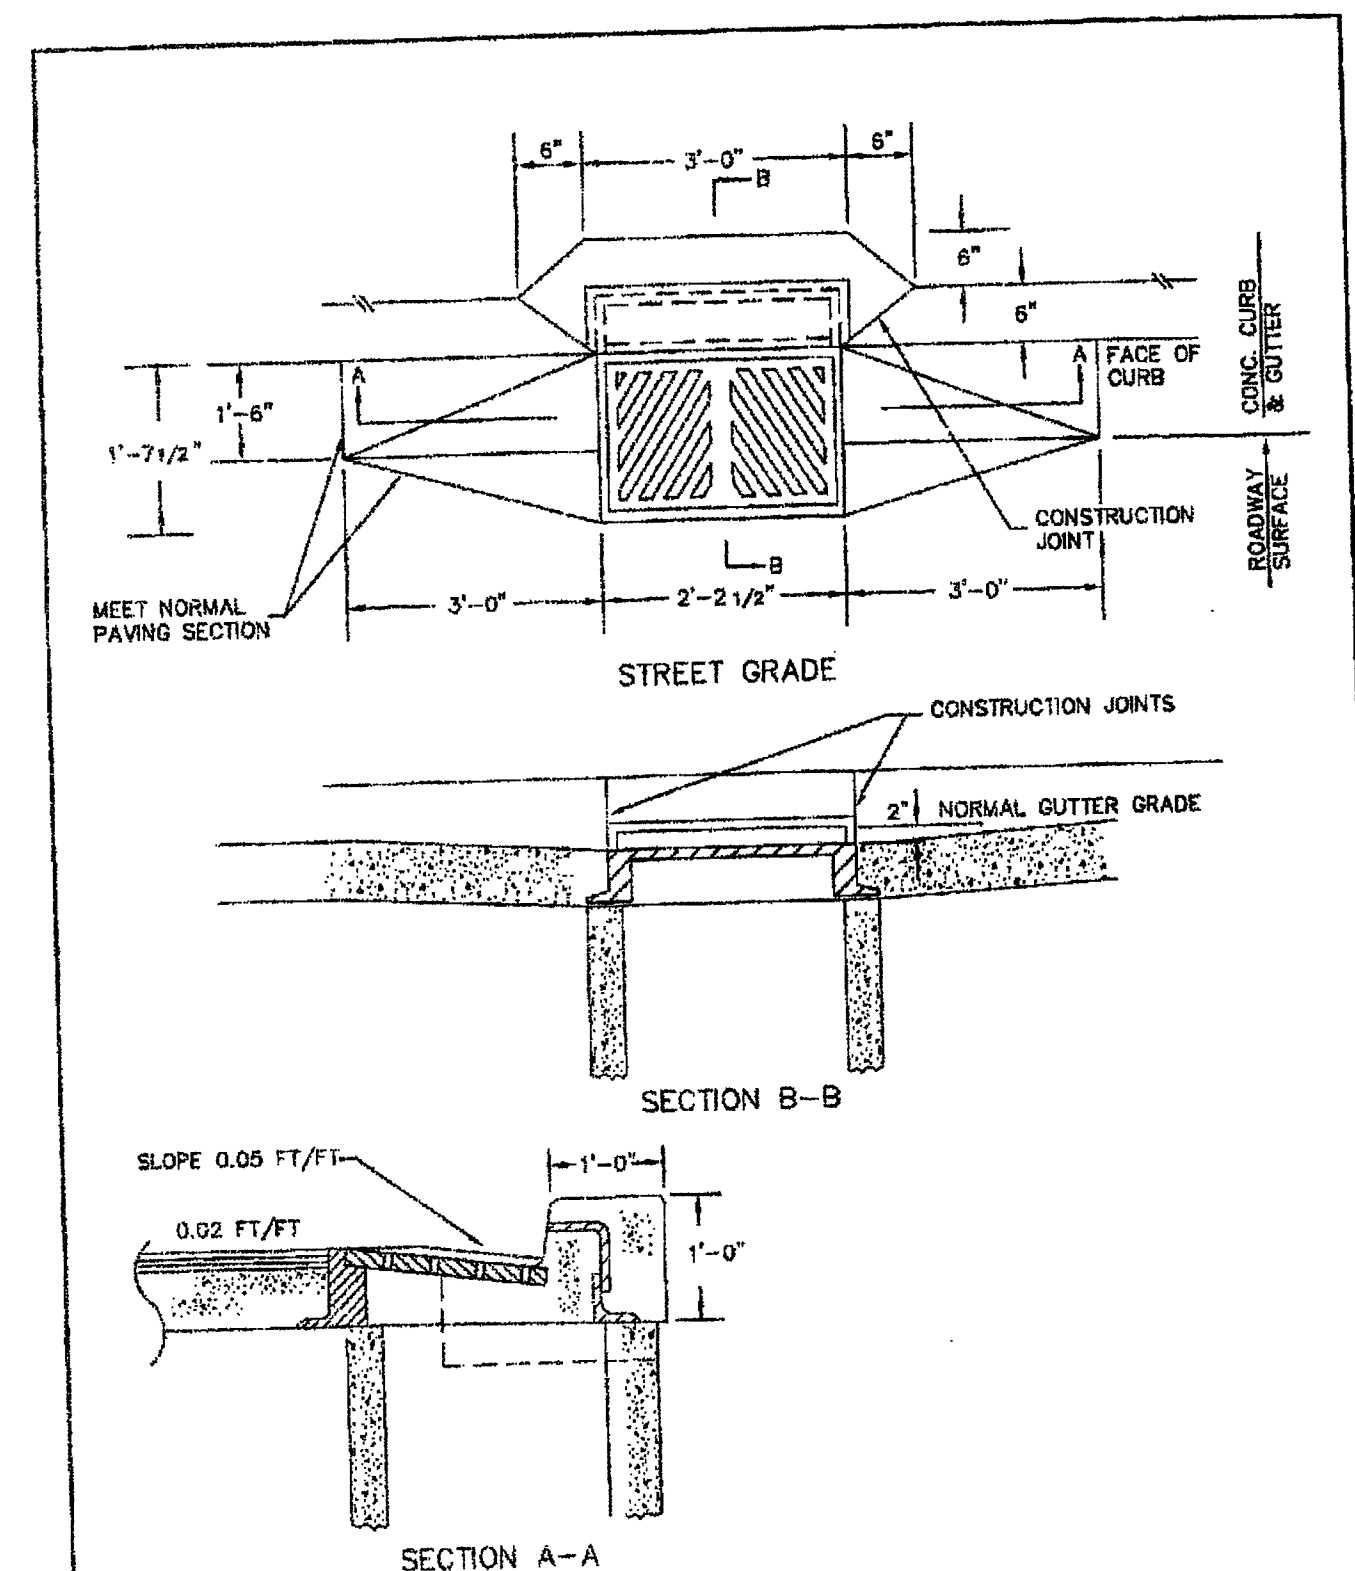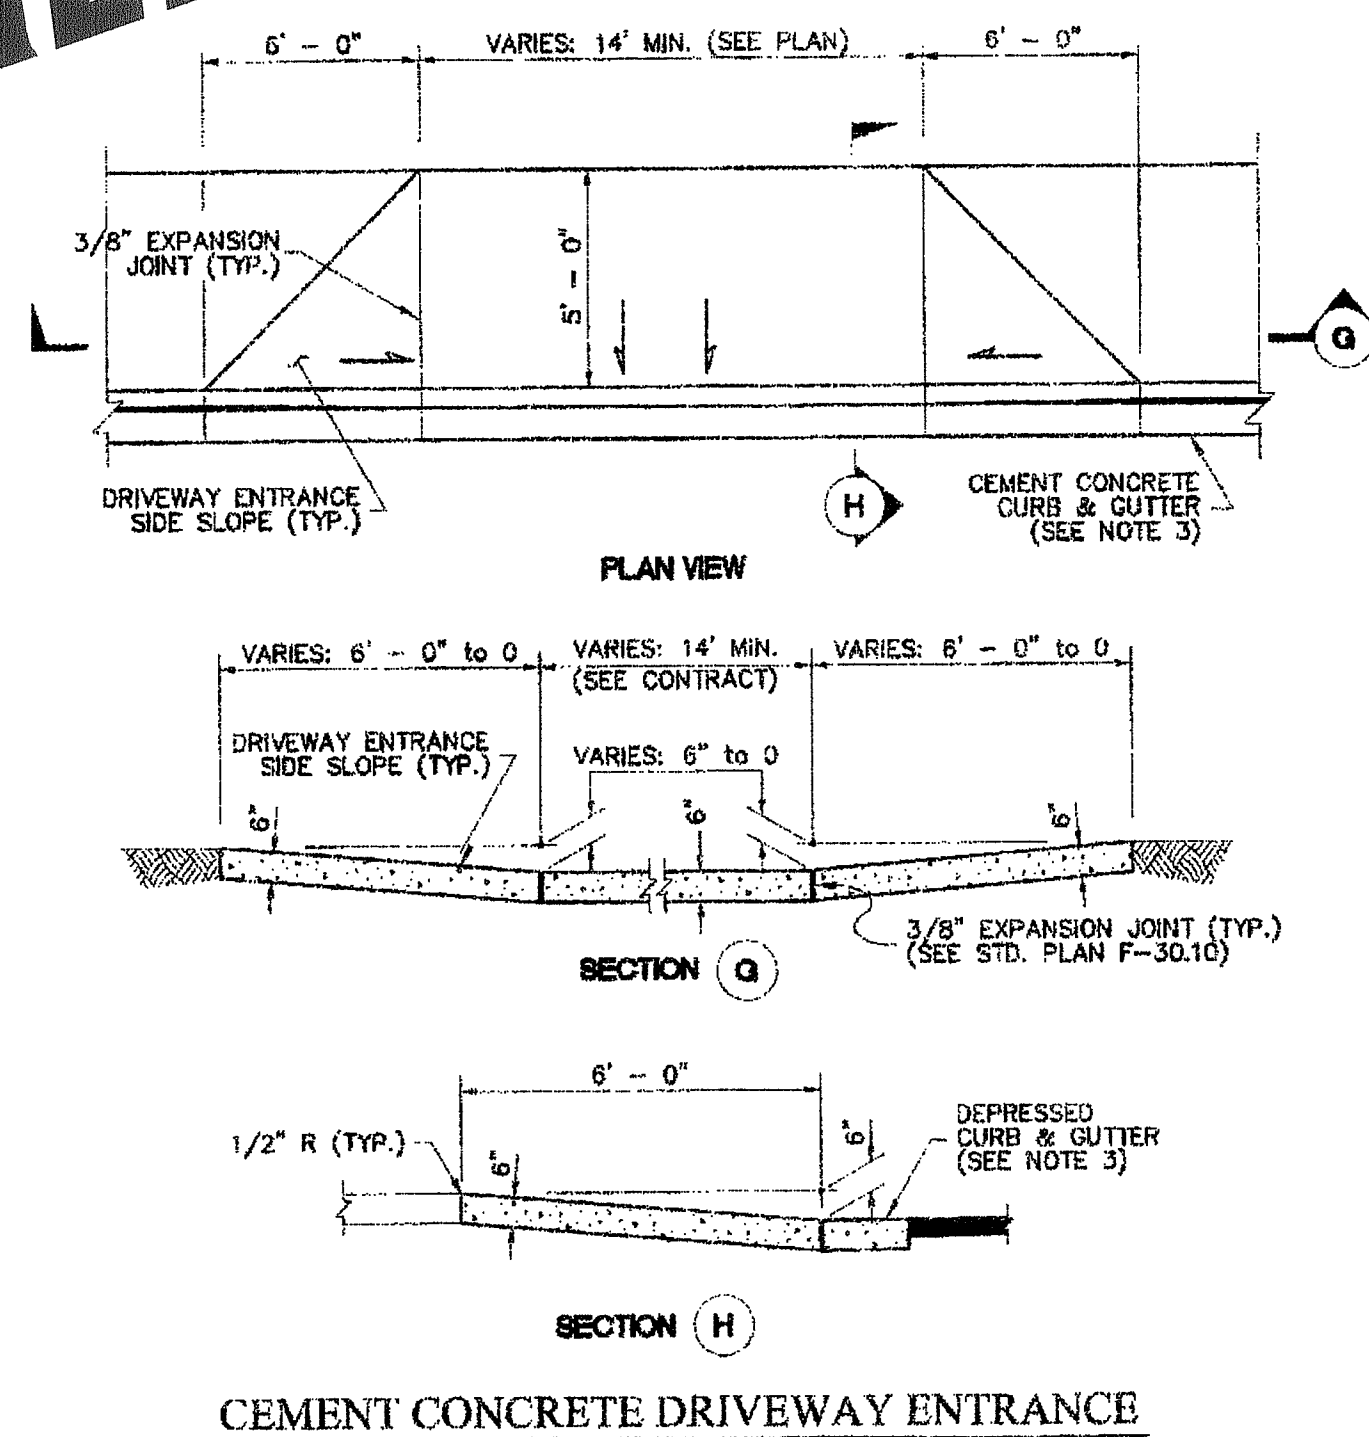

NOT TO SCALE

APRIL 2005



CITY OF FERDALE
THRU-CURB INLET FRAME & GRATE
WITH VERTICAL CURB INSTALLATION

DETAIL
ST-8

SURVEYOR'S CERTIFICATION

I CERTIFY THAT ON 07/30/09 A FIELD AS-BUILT SURVEY WAS PERFORMED AT FIRST AVENUE BY ME OR UNDER MY DIRECTION AND THAT DATA FROM THAT FIELD SURVEY, INCLUDING LOCATION SHOTS, INVERT MEASUREMENTS AND FIELD BOOK NOTES WERE USED IN PREPARATION OF THESE AS-BUILT PLANS. SAID FIELD SURVEY WORK MEETS OR EXCEEDS THE MINIMUM SURVEY STANDARDS AS PER WAC 332.130.000.

SURVEYOR NAME & LICENSE NUMBER: SCOTT G. HARKS 32430

DATE: 10/20/09



**CALL TWO BUSINESS DAYS
BEFORE YOU DIG**


WASHINGTON STATE ONE-CALL
1-800-424-5555

IT'S THE LAW! (RCW 19.122)

COMPASS POINT SURVEY GROUP INC.

523 FRONT STREET, LYNDEN WA. 98264







P.H. (360) 354 - 8320 FAX (360) 354 - 8321

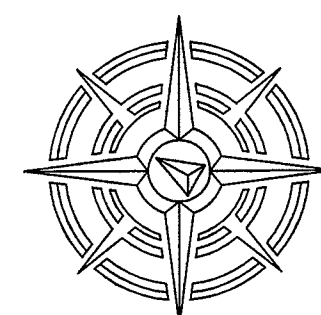

DRAWN BY: CS

REVIEWED BY: SH

SHEET: 05 OF 09

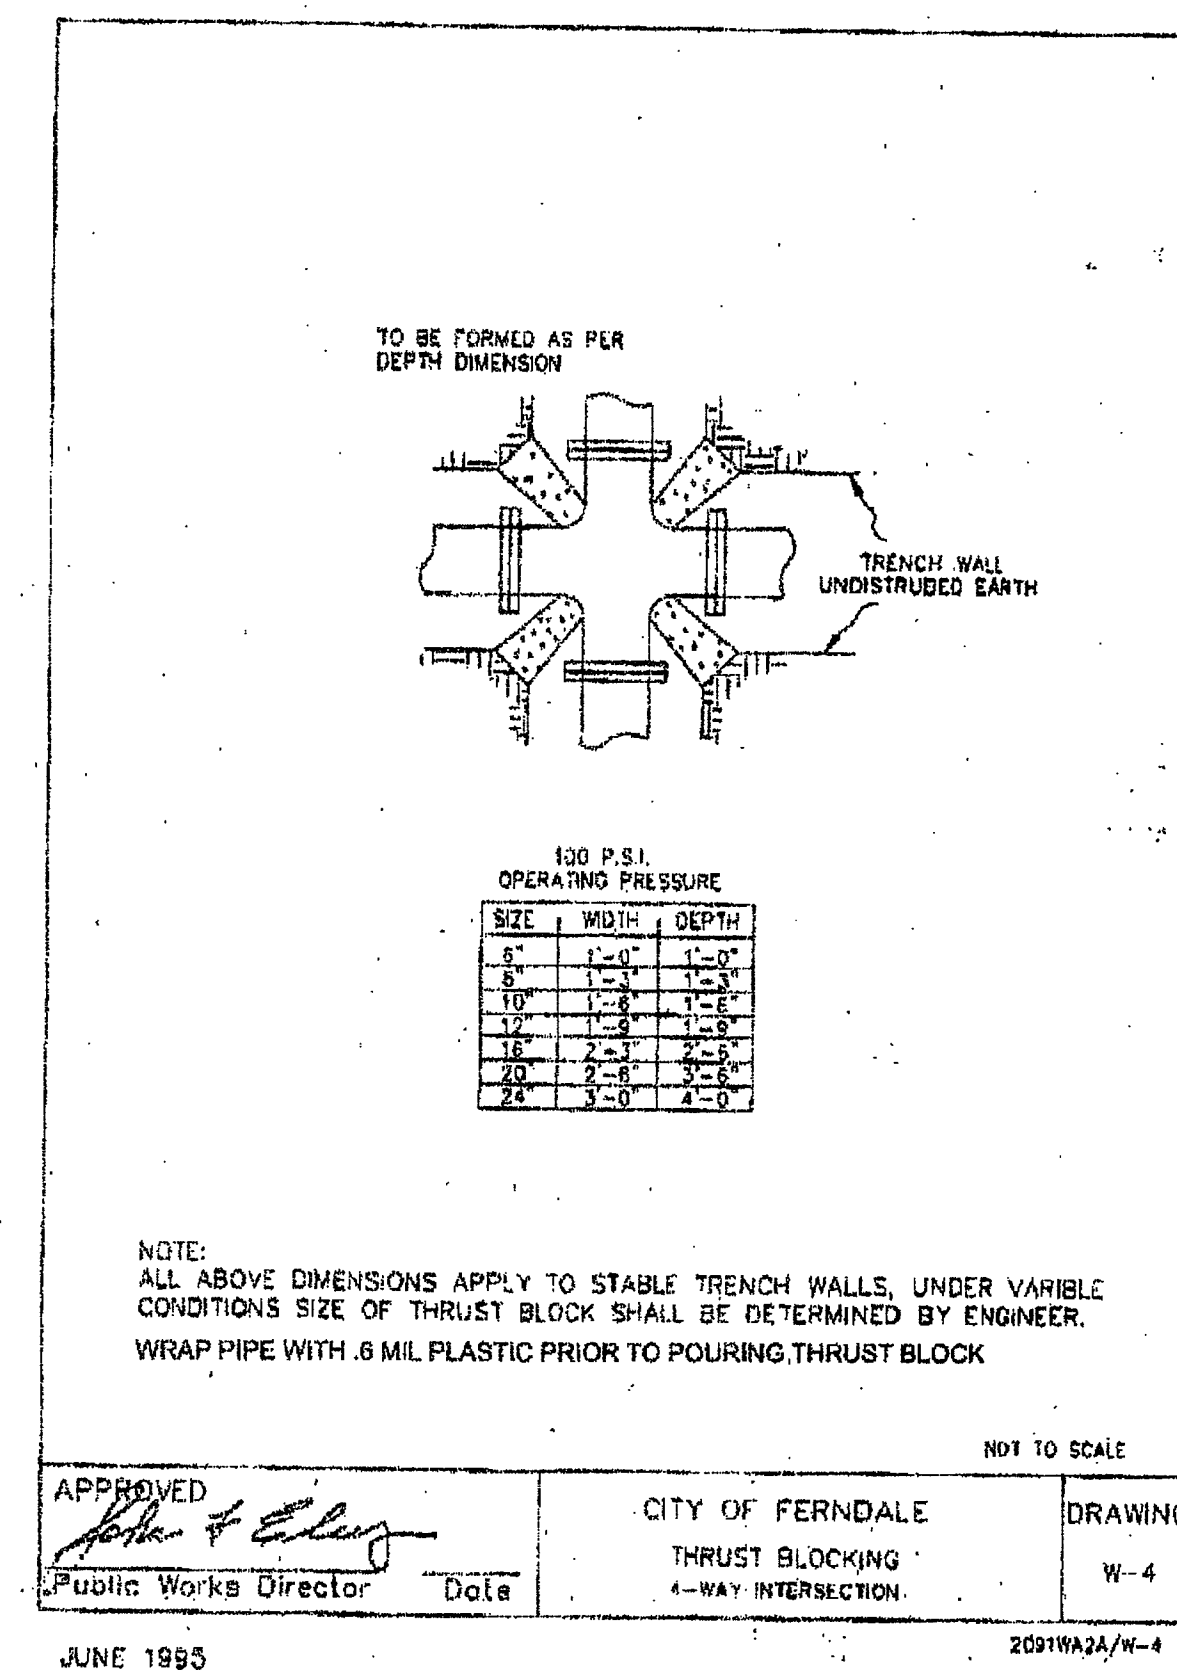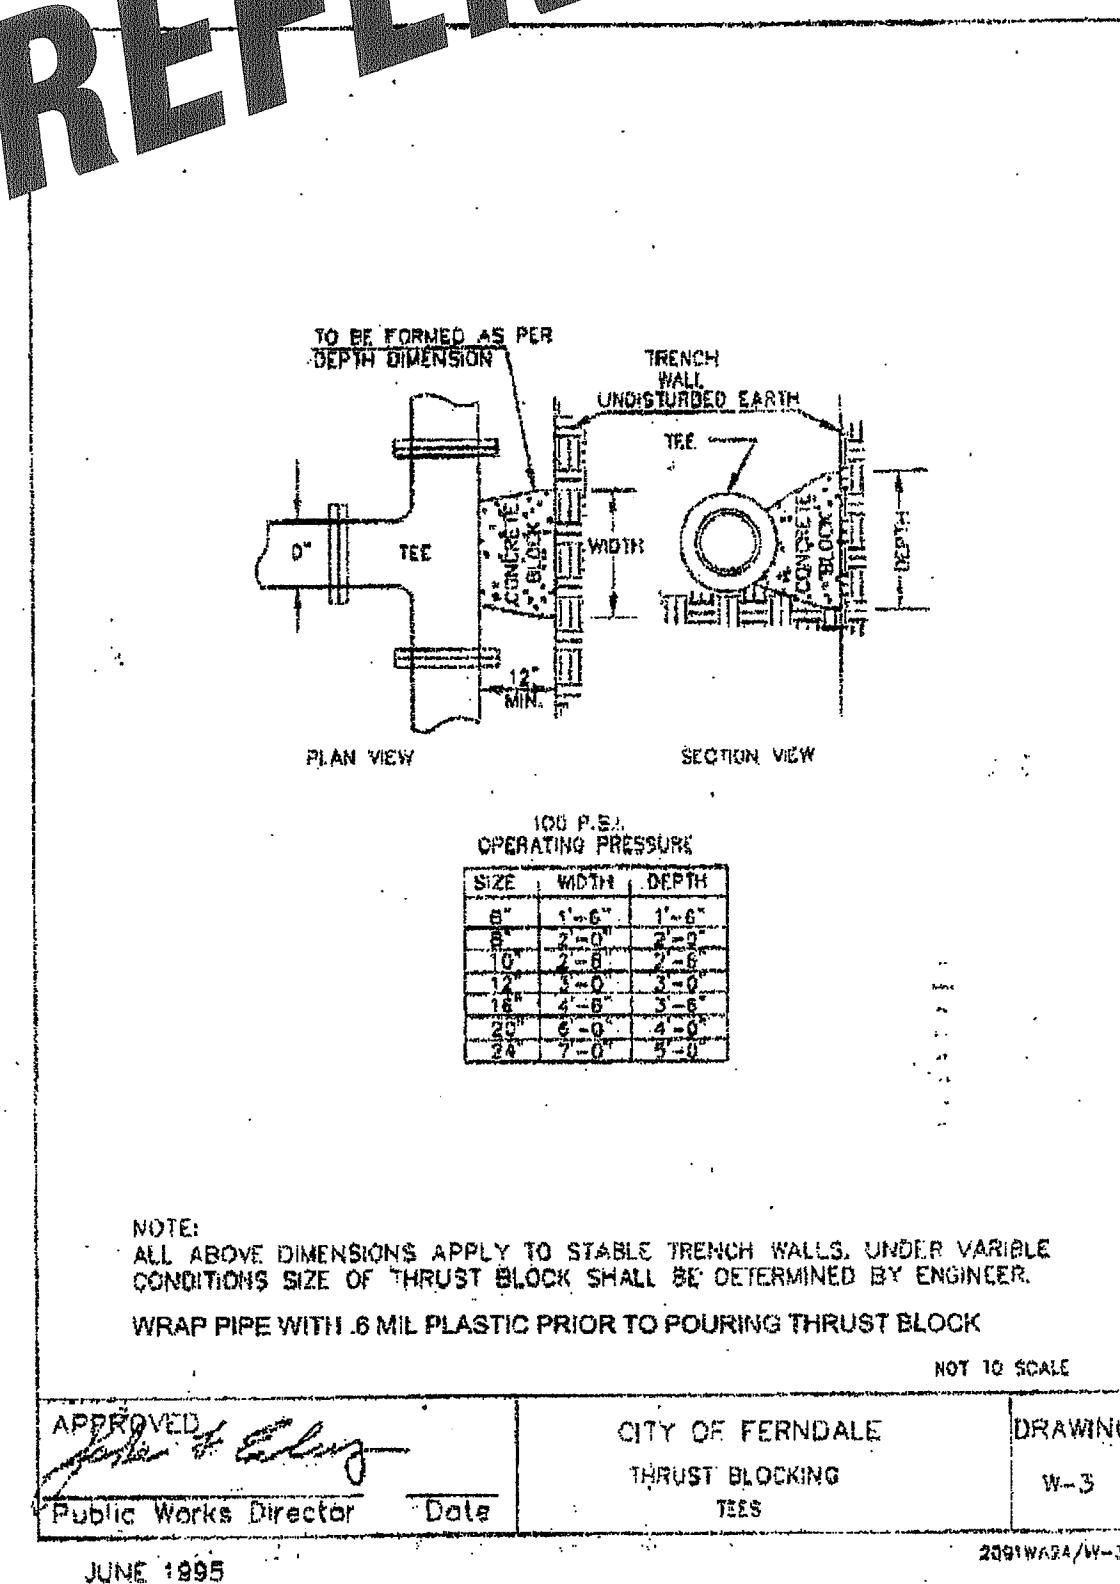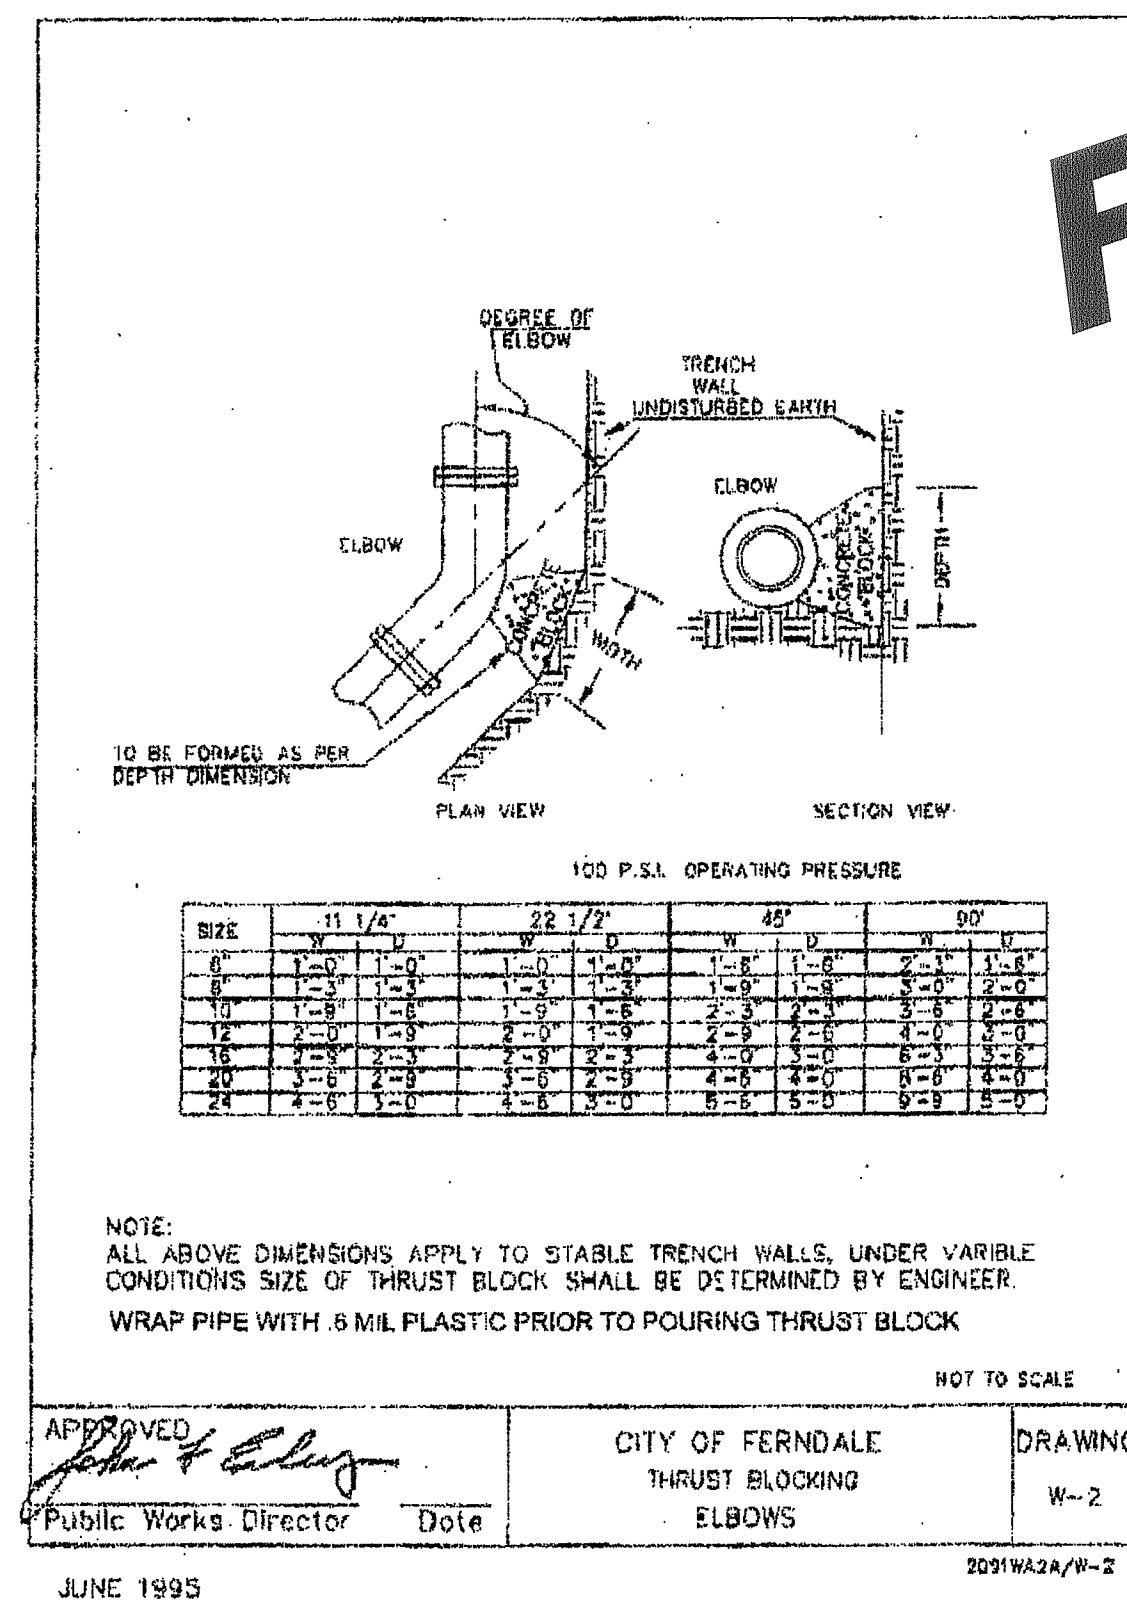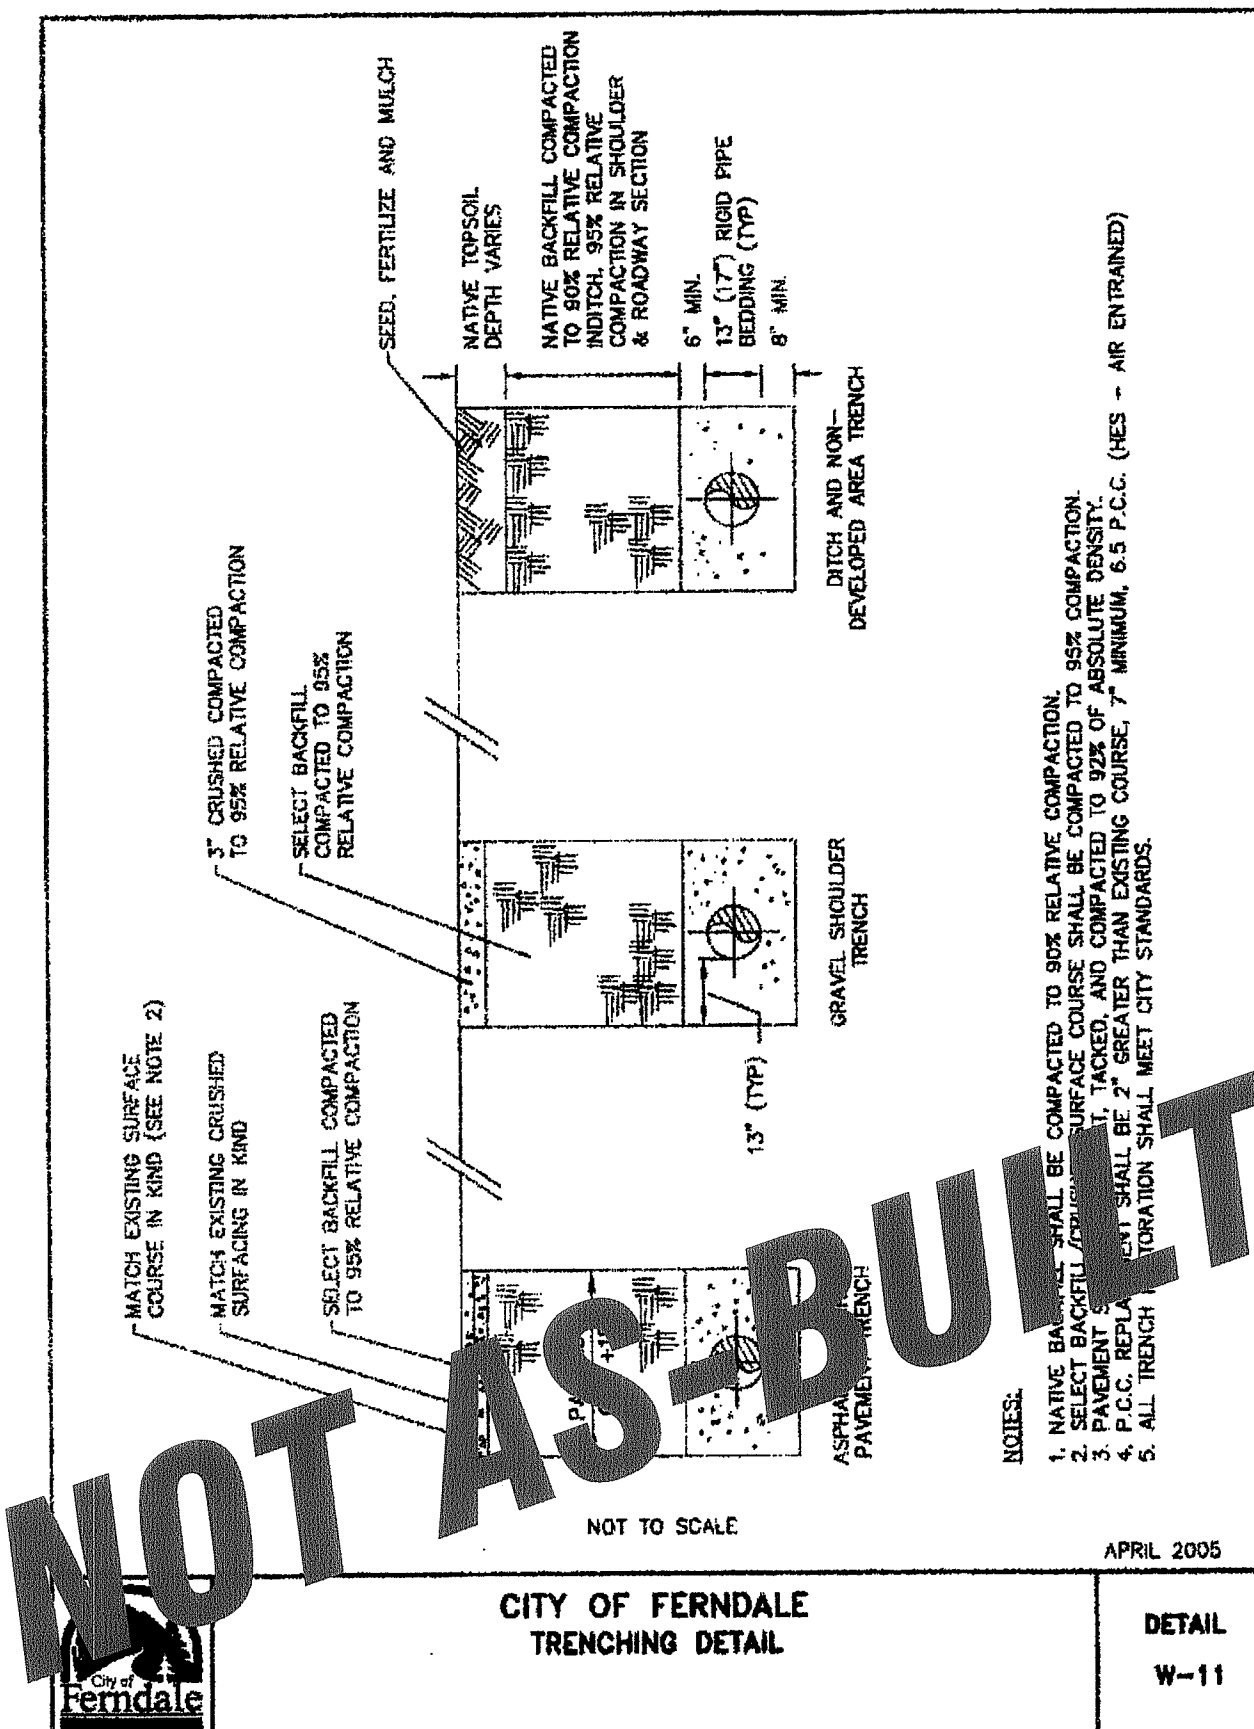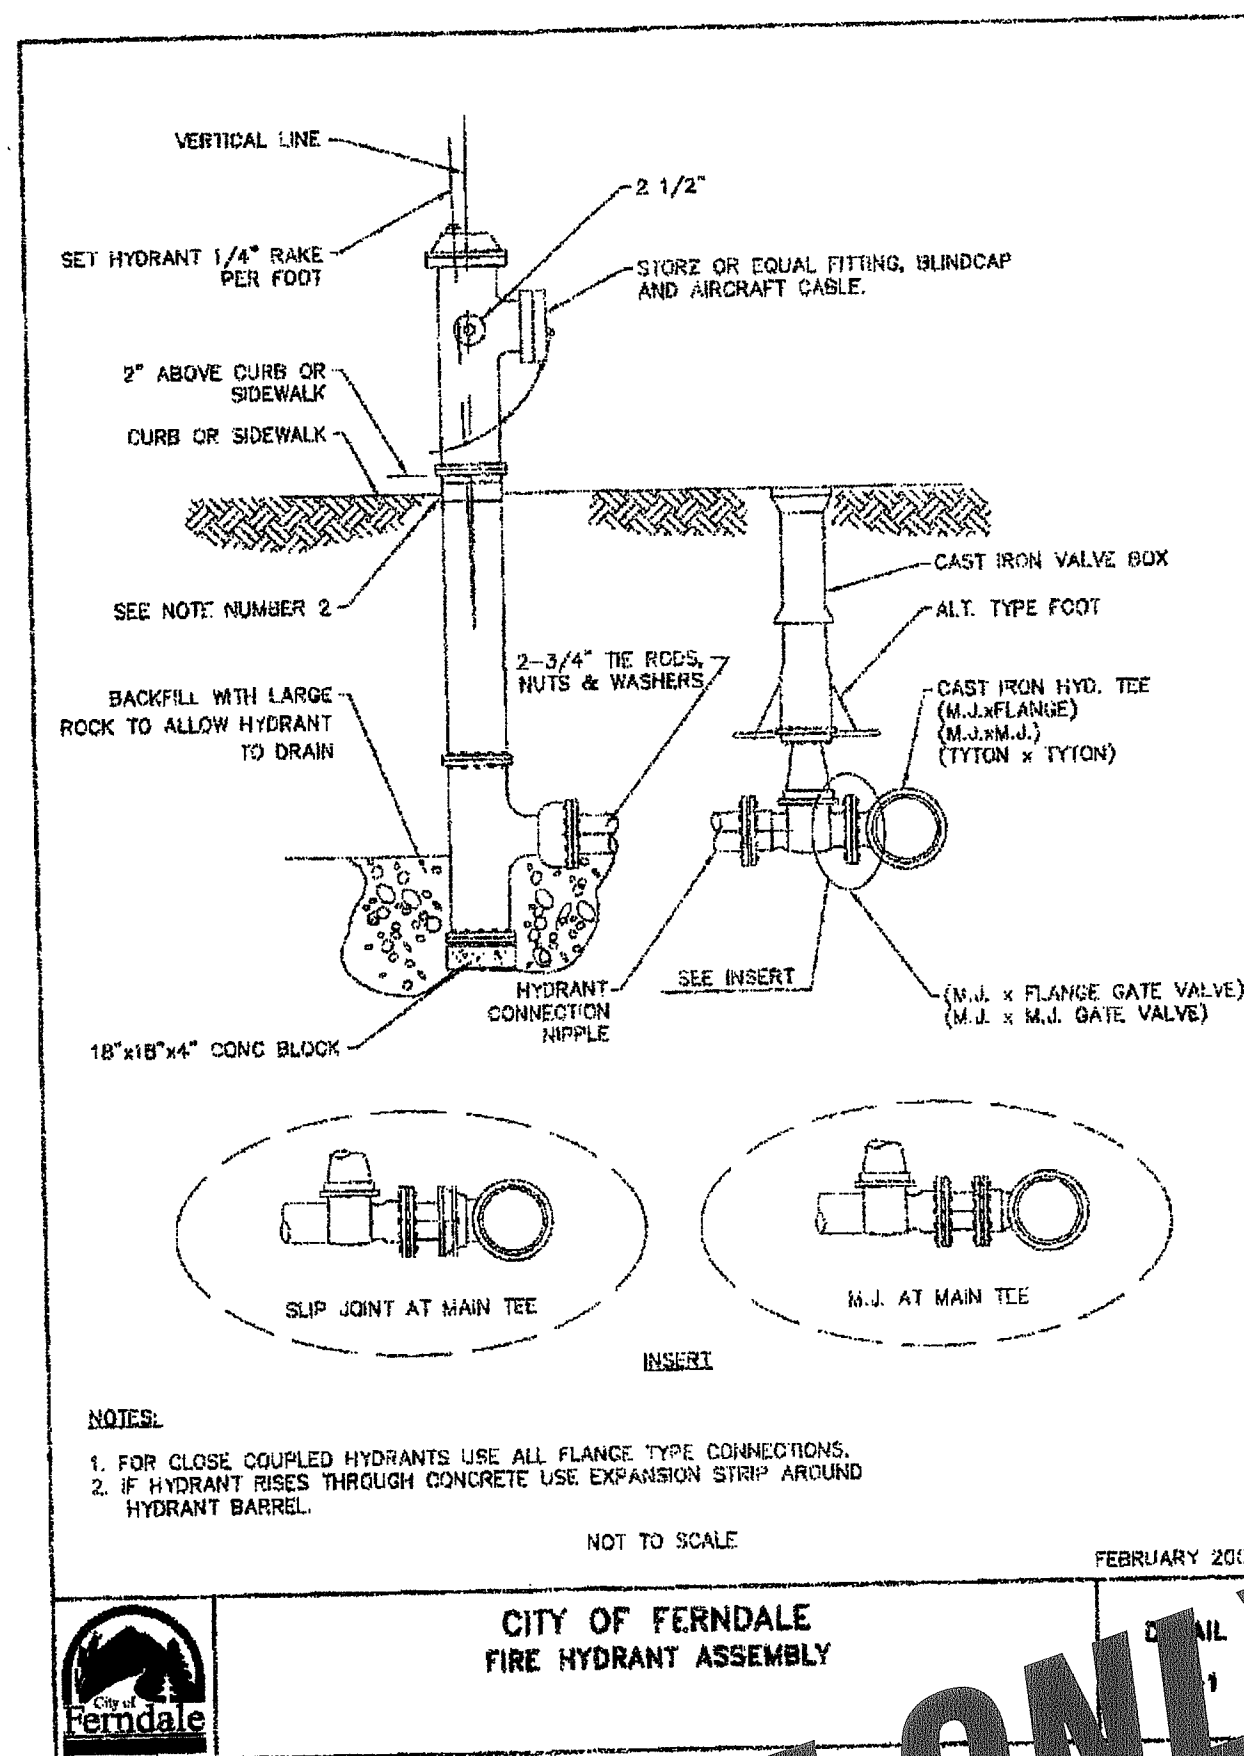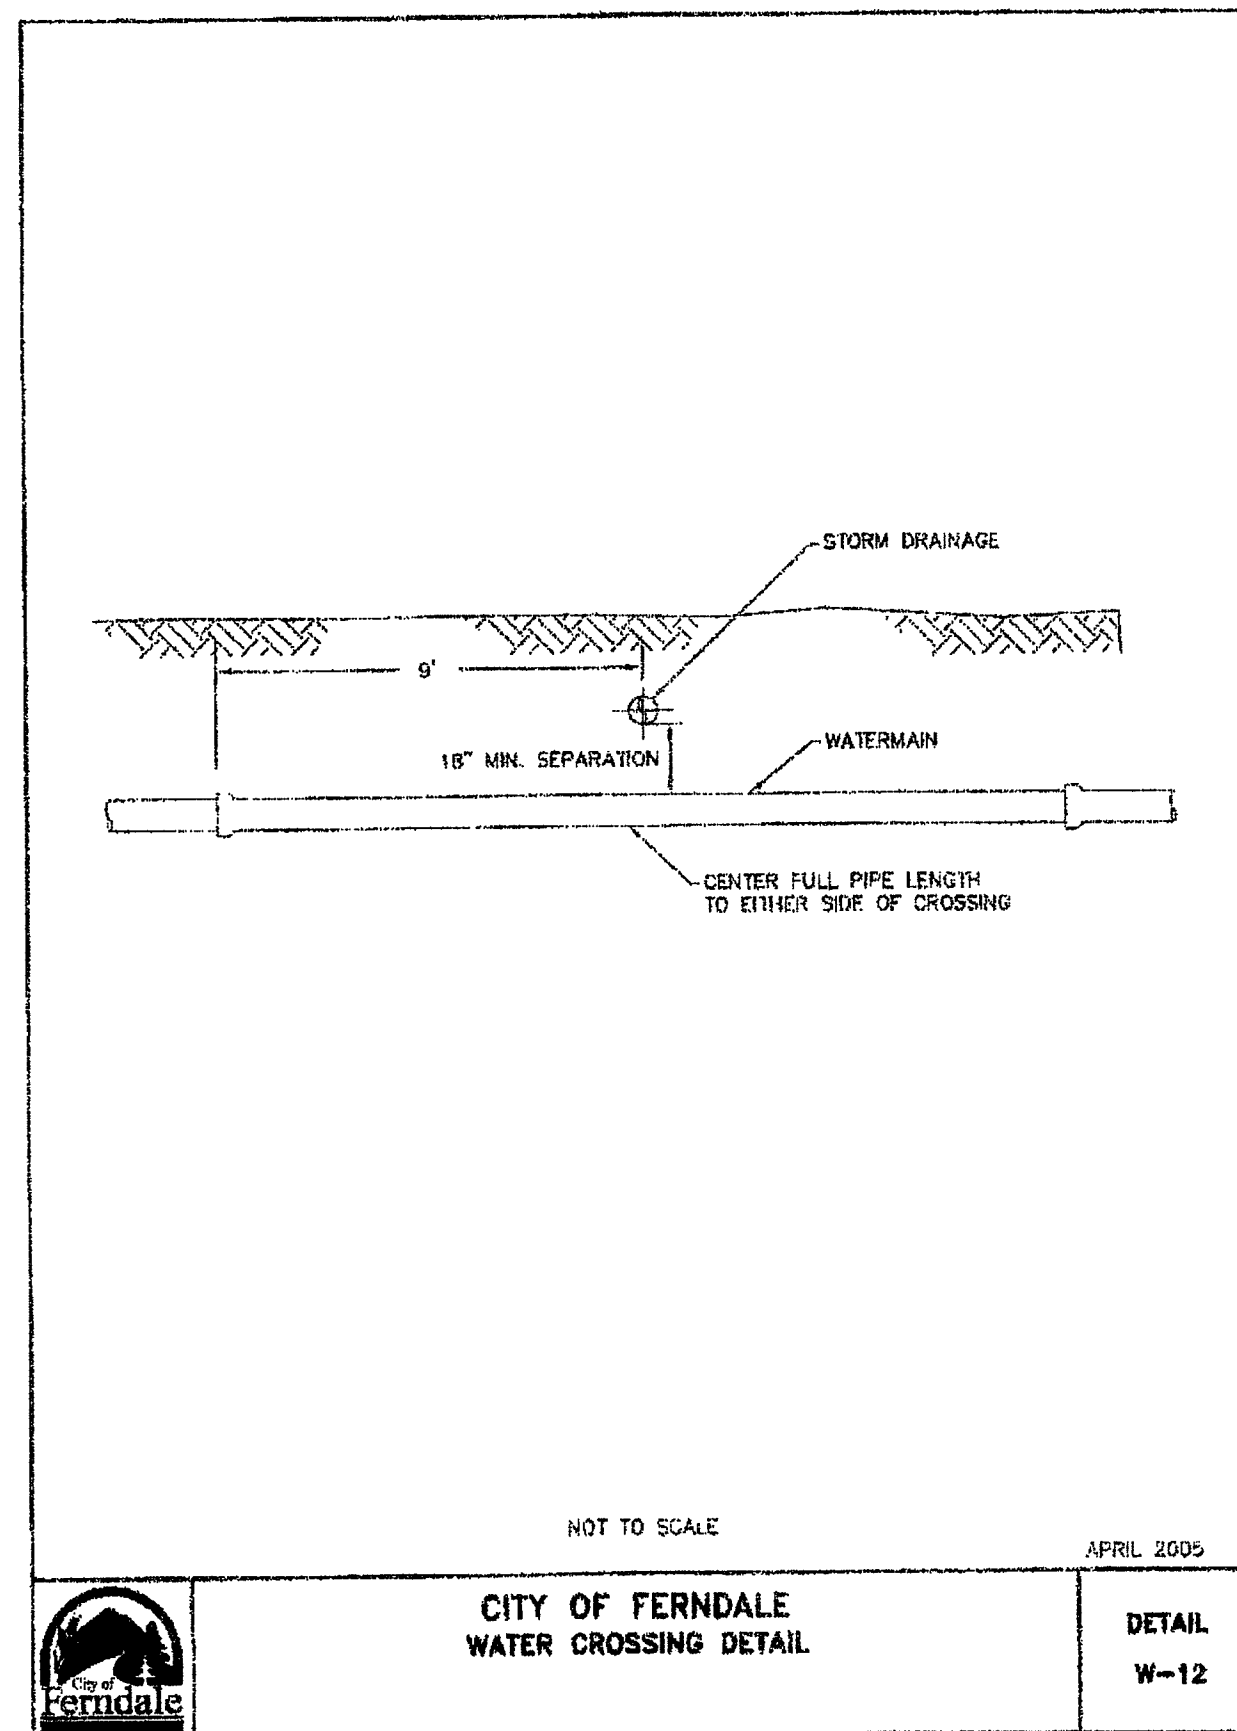

SURVEYOR'S CERTIFICATION

I CERTIFY THAT ON 07/30/09 A FIELD AS-BUILT SURVEY WAS PERFORMED AT FIRST AVENUE BY ME OR UNDER MY DIRECTION AND THAT DATA FROM THAT FIELD SURVEY, INCLUDING LOCATION SHOTS, INVERT MEASUREMENTS AND FIELD BOOK NOTES WERE USED IN PREPARATION OF THESE AS-BUILT PLANS. SAID FIELD SURVEY WORK MEETS OR EXCEEDS THE MINIMUM SURVEY STANDARDS AS PER WAC 332.130.090.

32430
SURVEYOR NAME & LICENSE NUMBER

DATE 10/20/09



CALL TWO BUSINESS DAYS
BEFORE YOU DIG
WASHINGTON STATE ONE-CALL
1-800-424-5555





IT'S THE LAW! (RCW 19.122)




COMPASS POINT SURVEY GROUP INC.

DRAWN BY: CS

REVIEWED BY: SH

SHEET: 06 OF 09

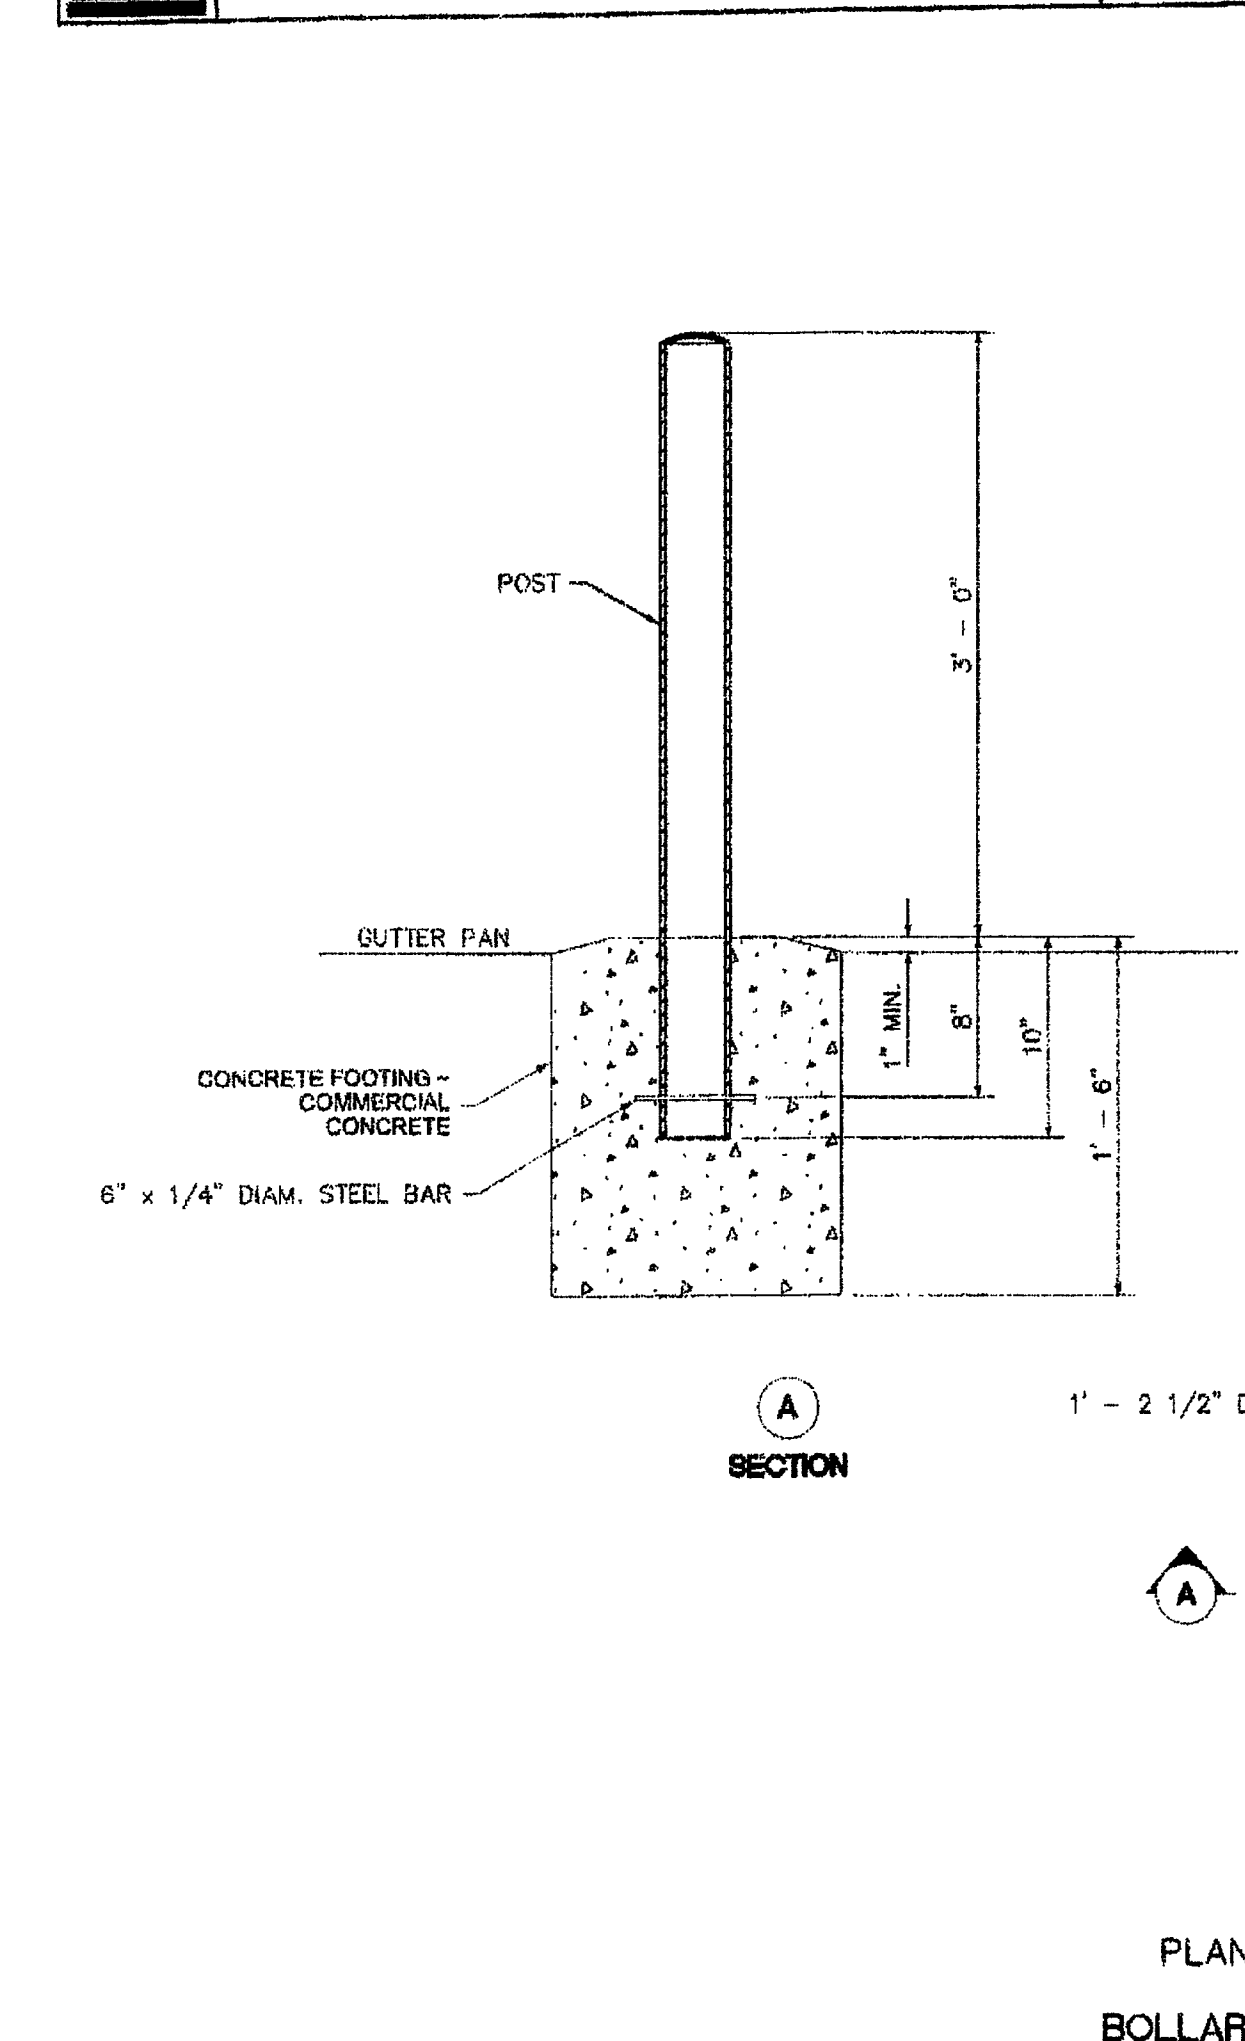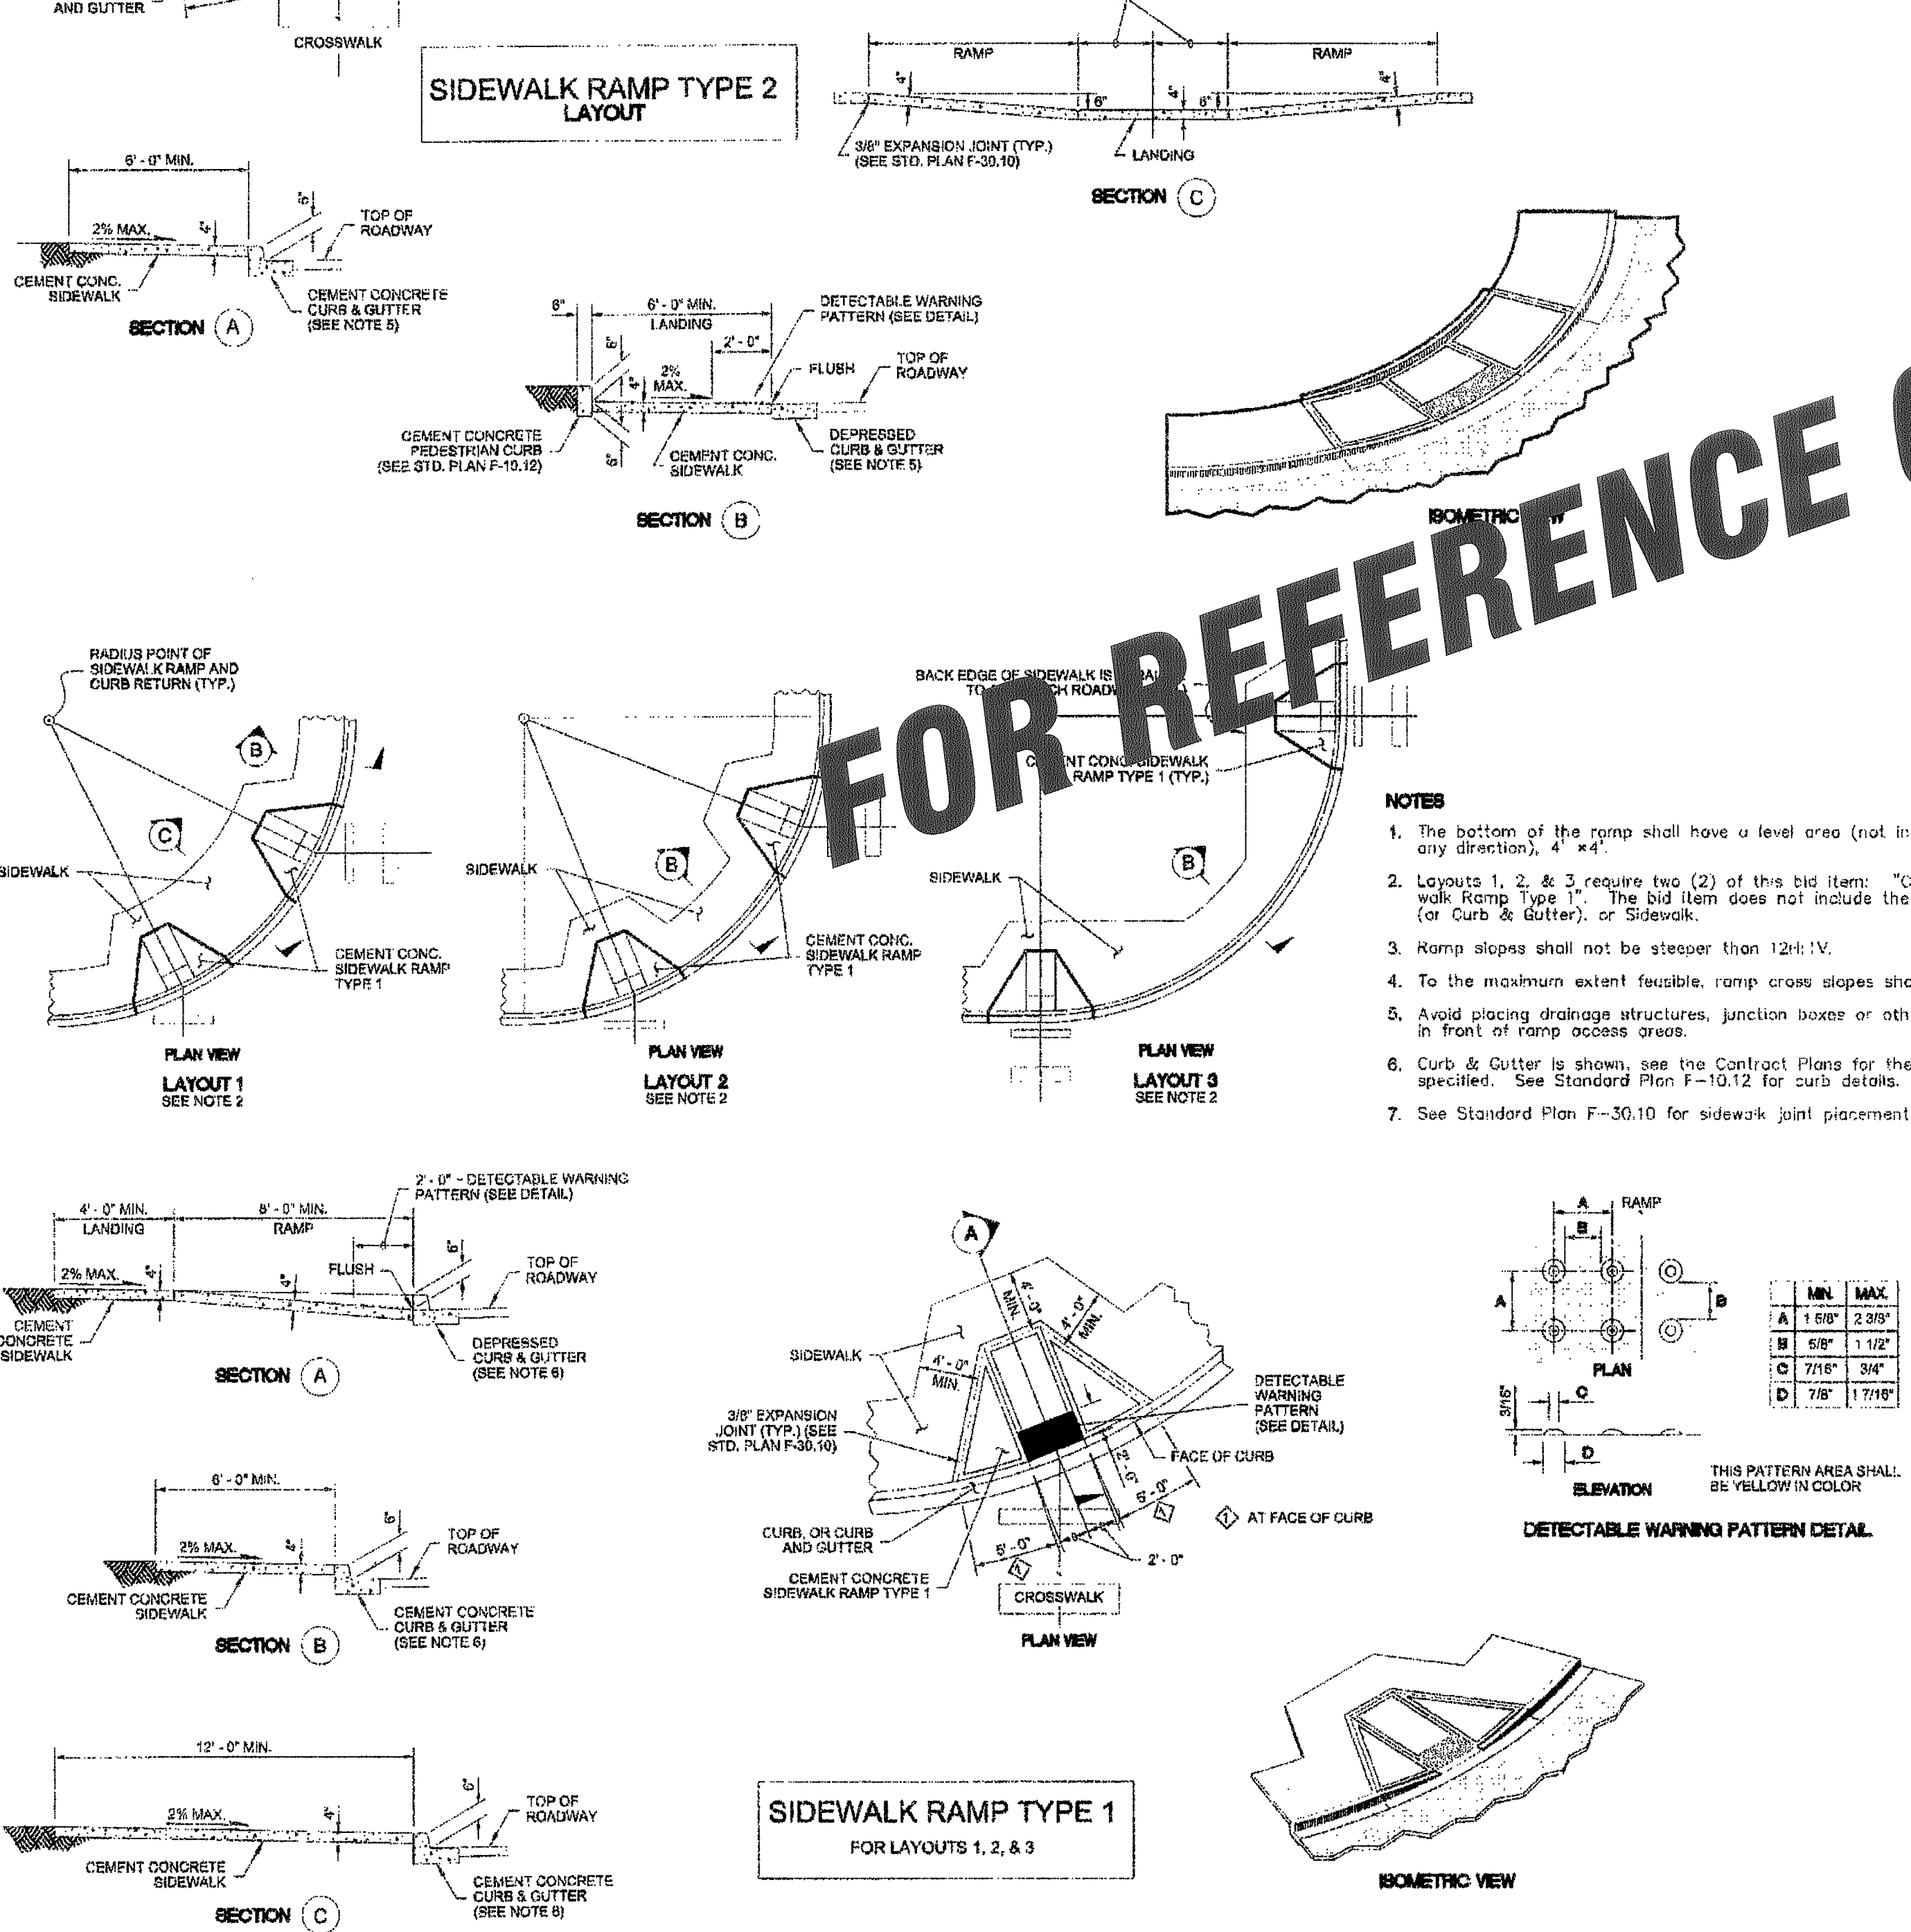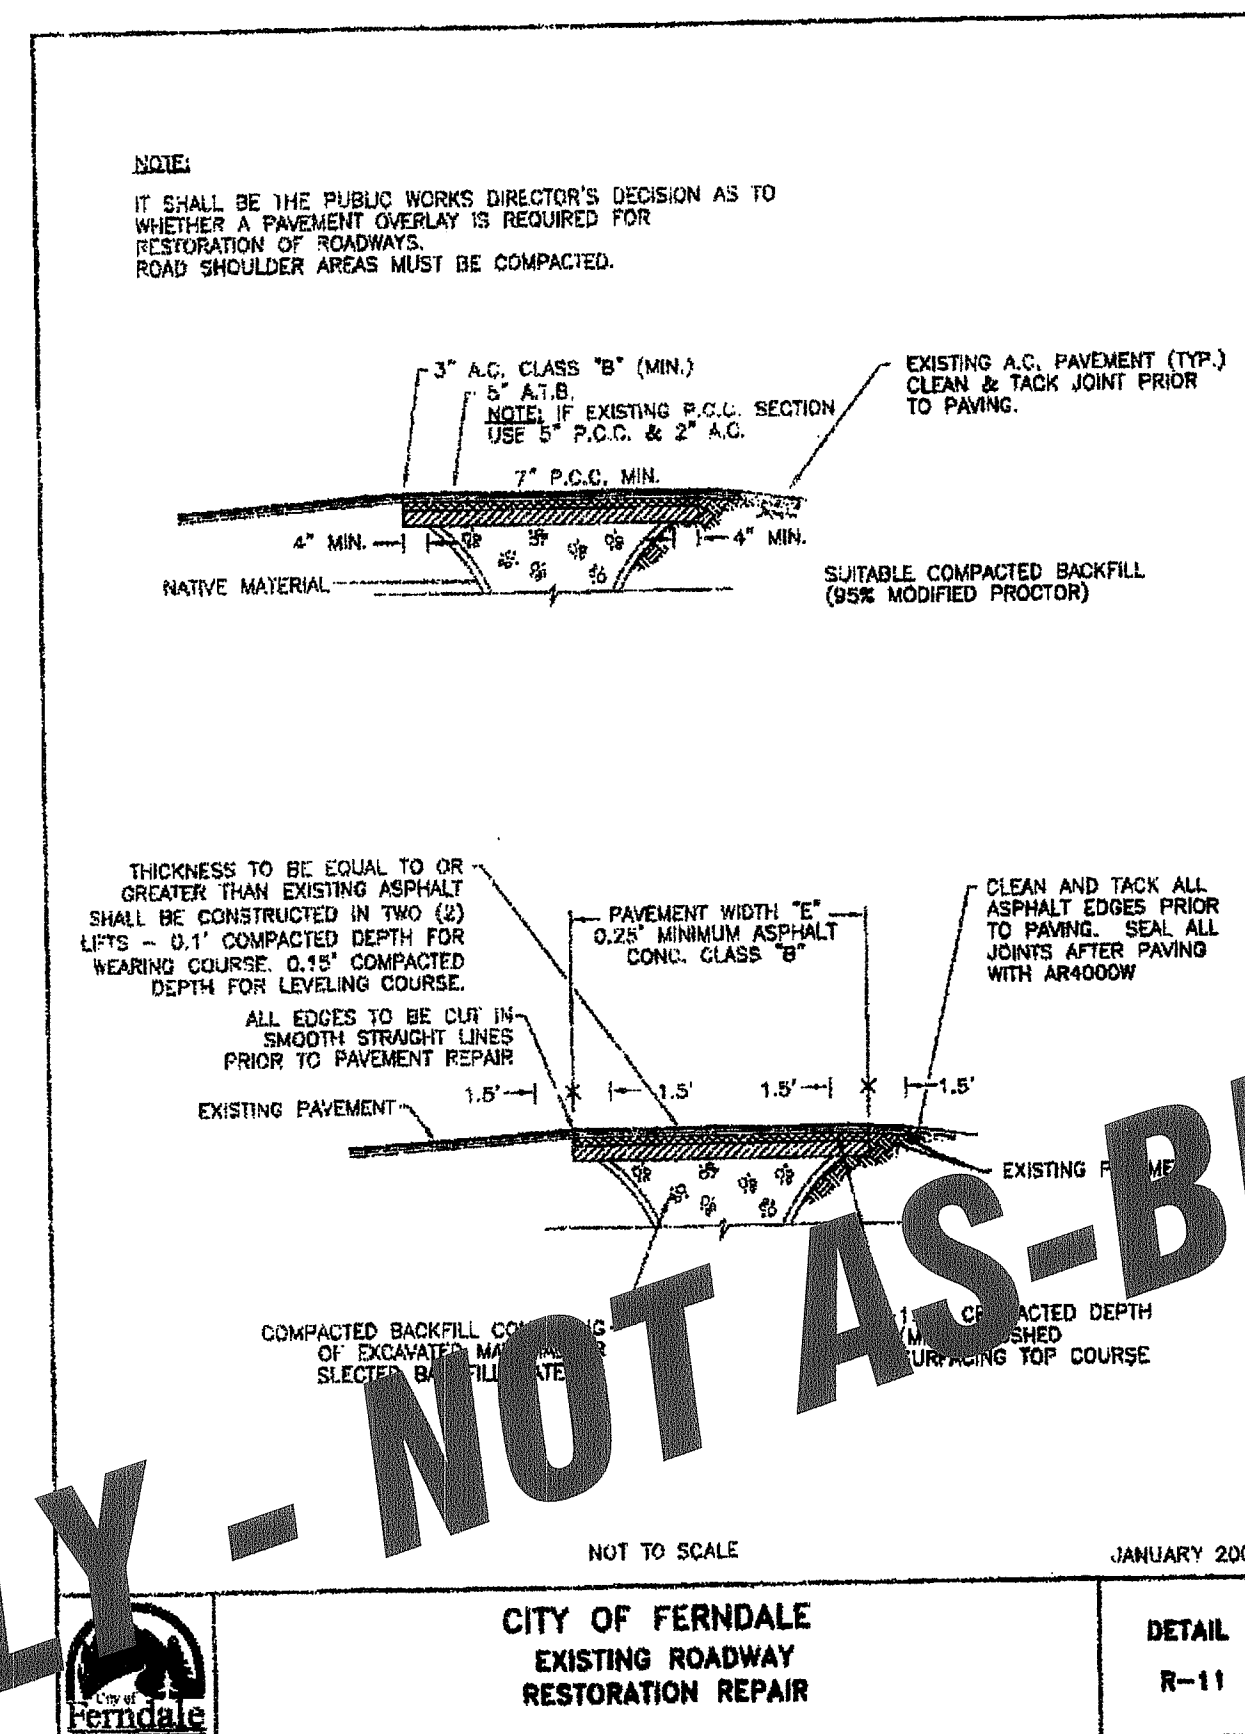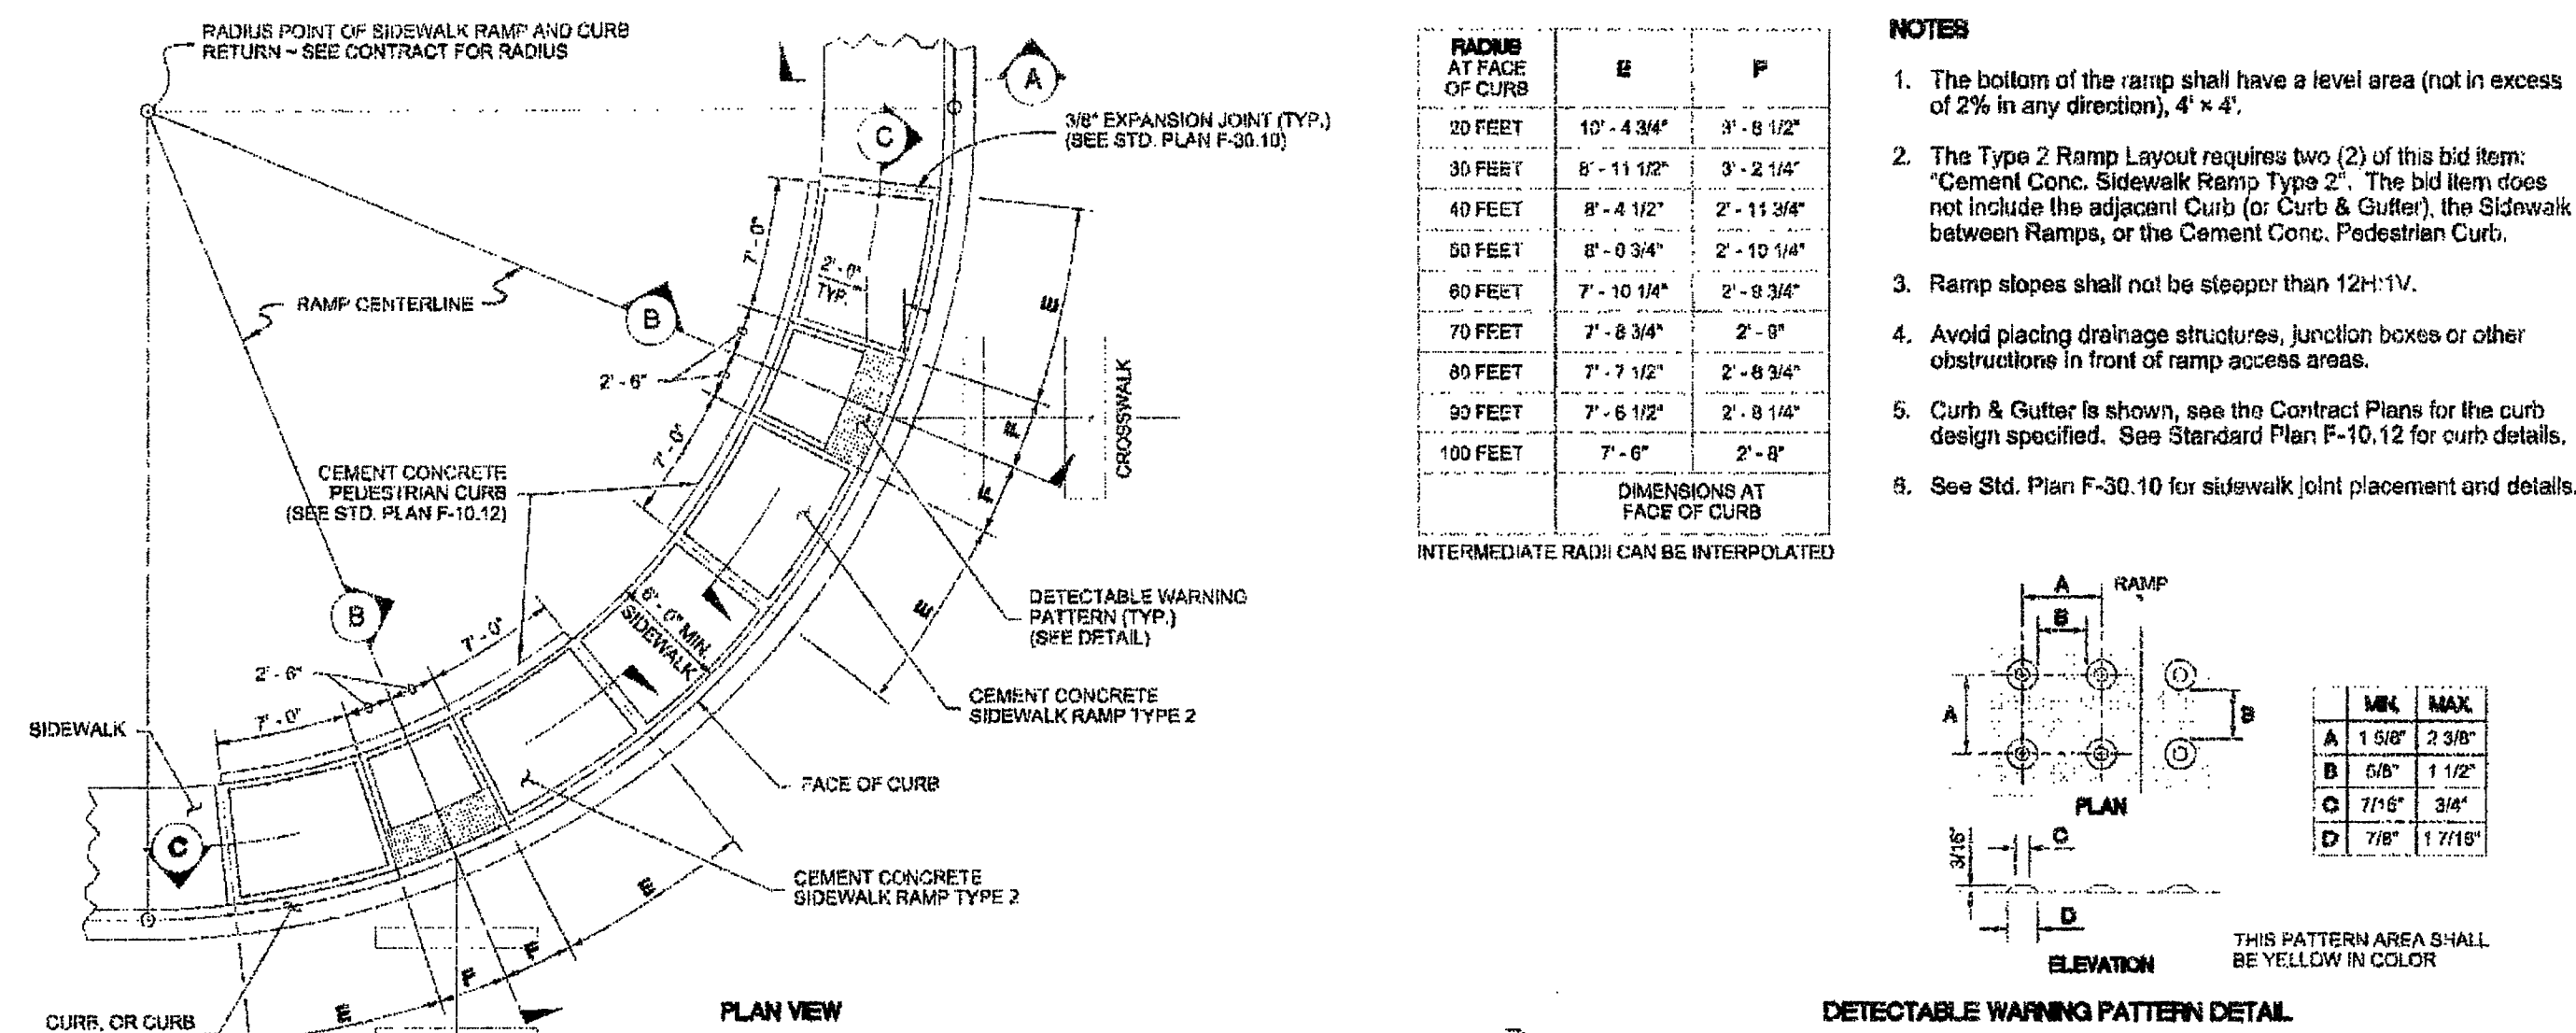


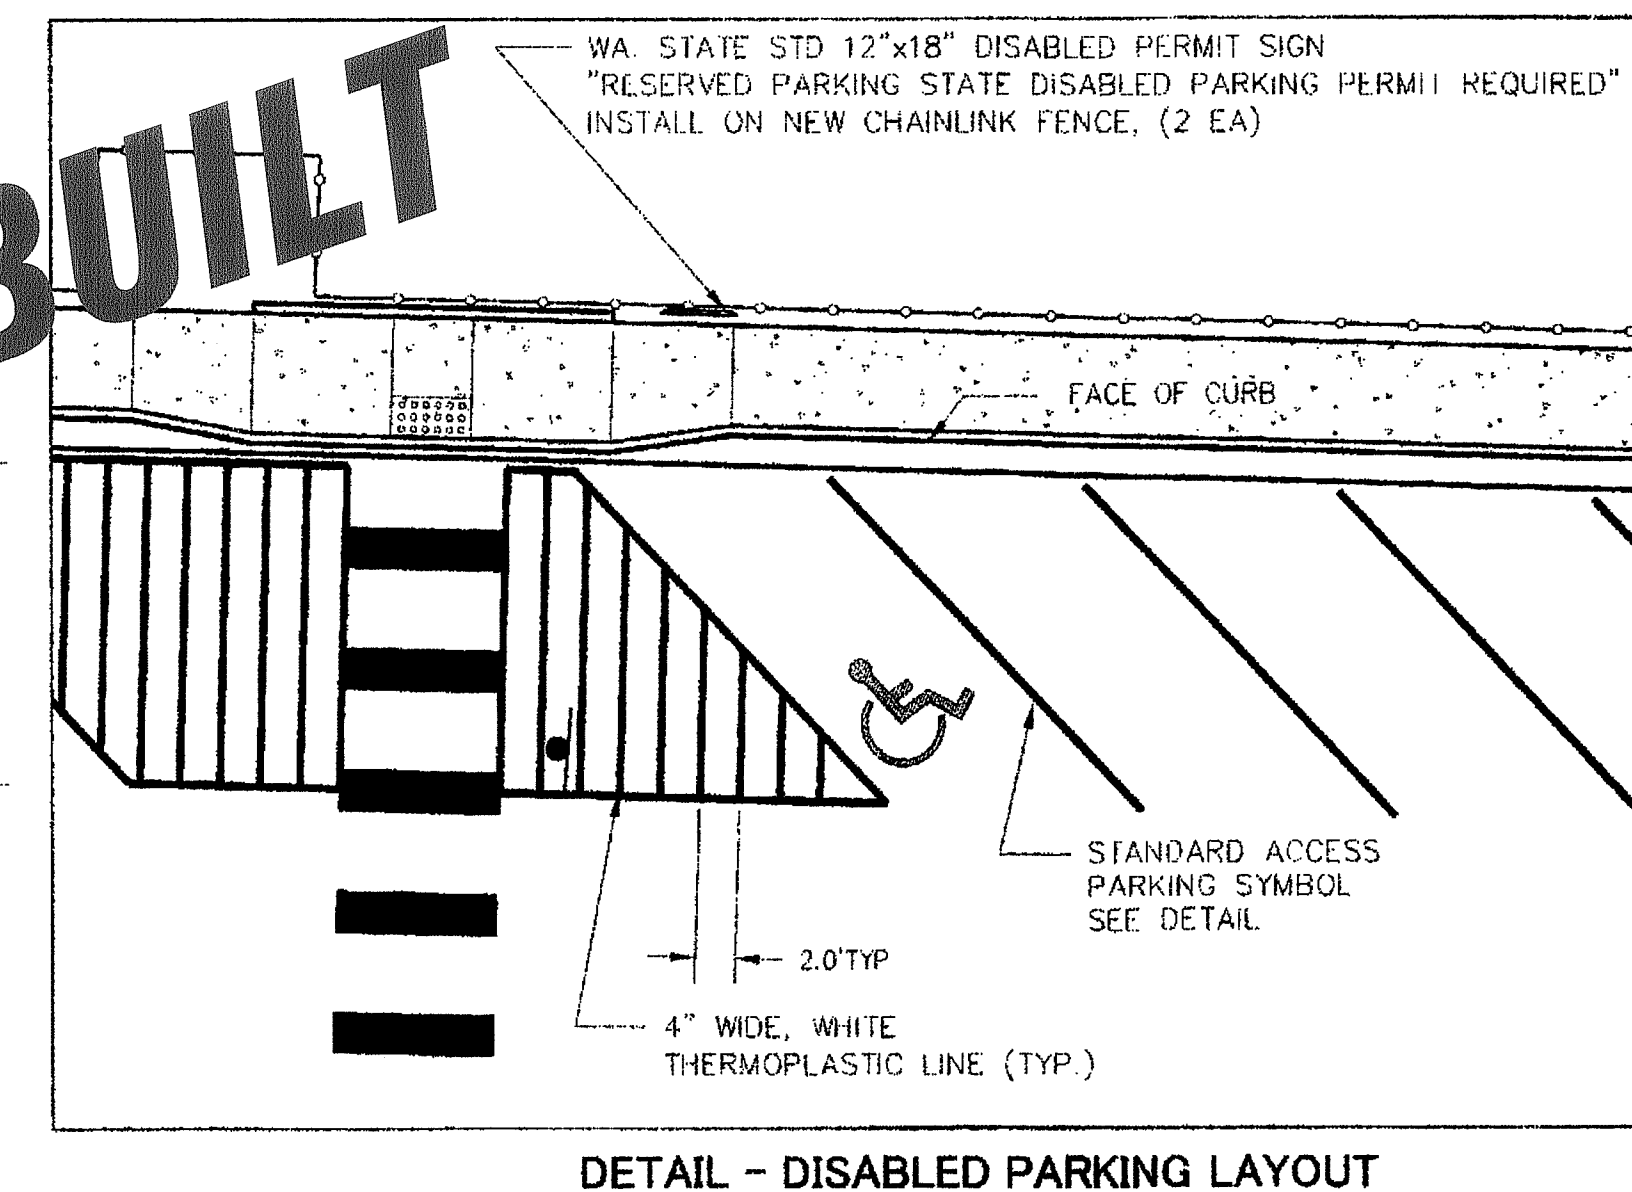
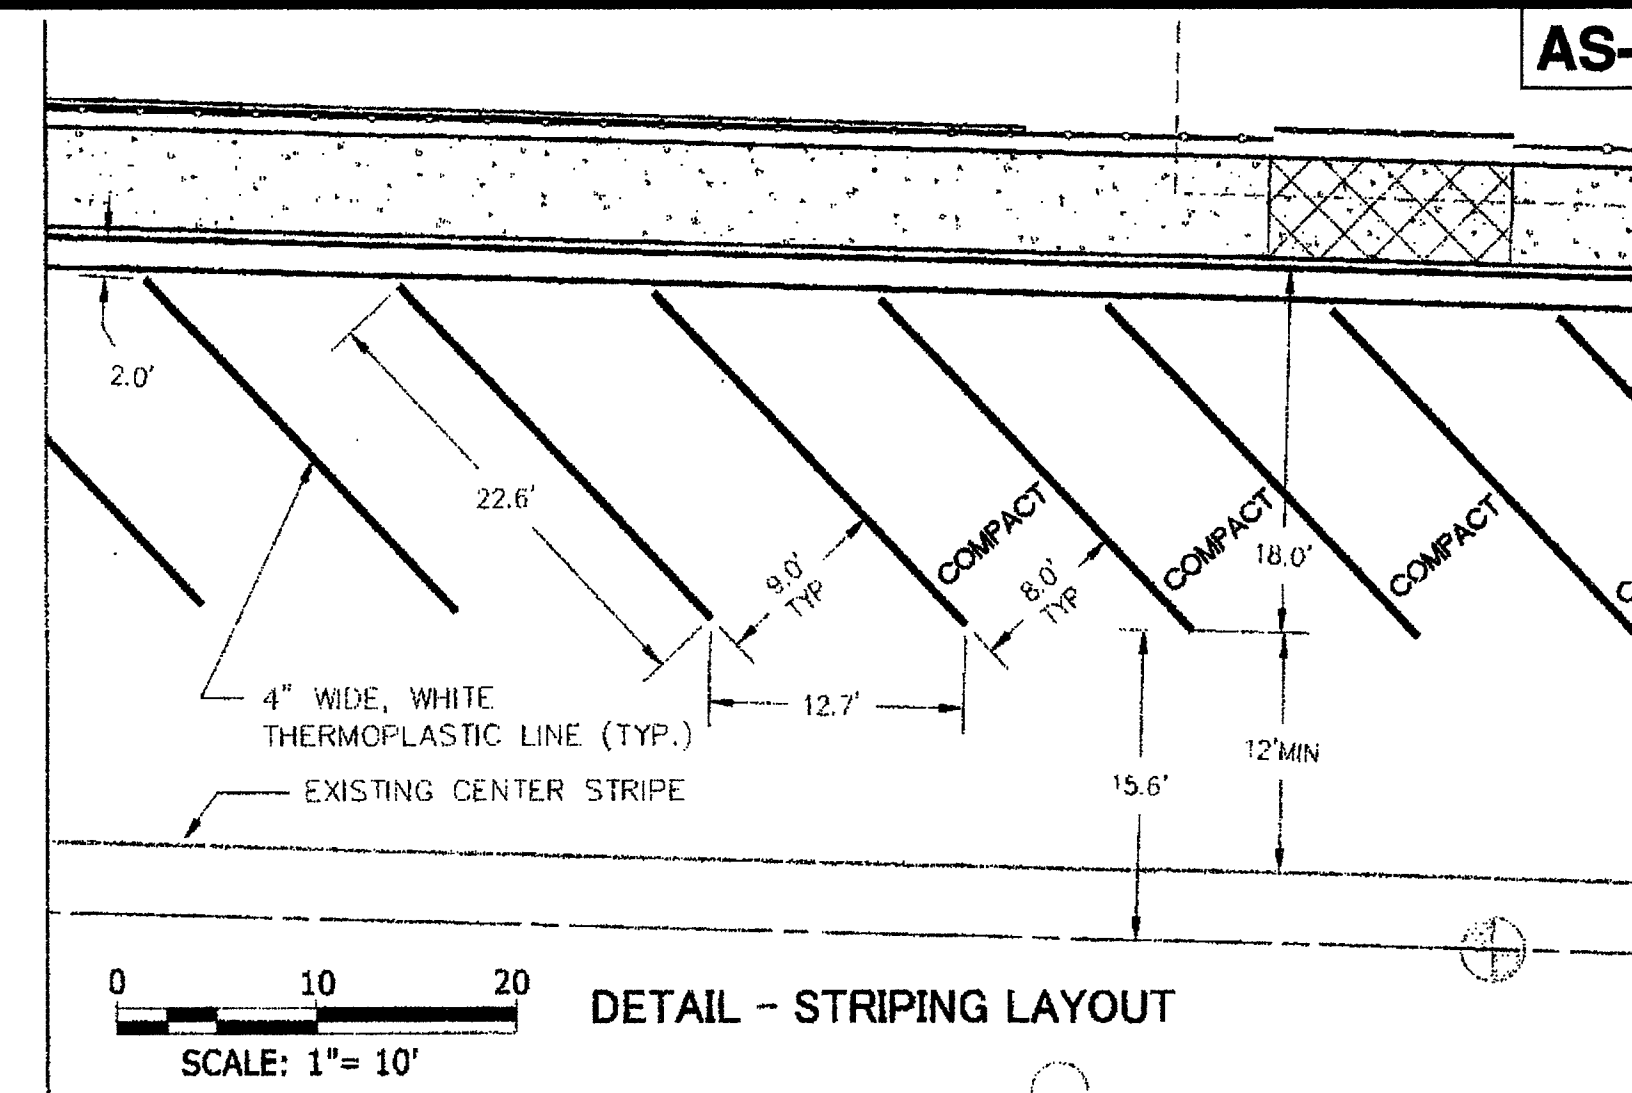
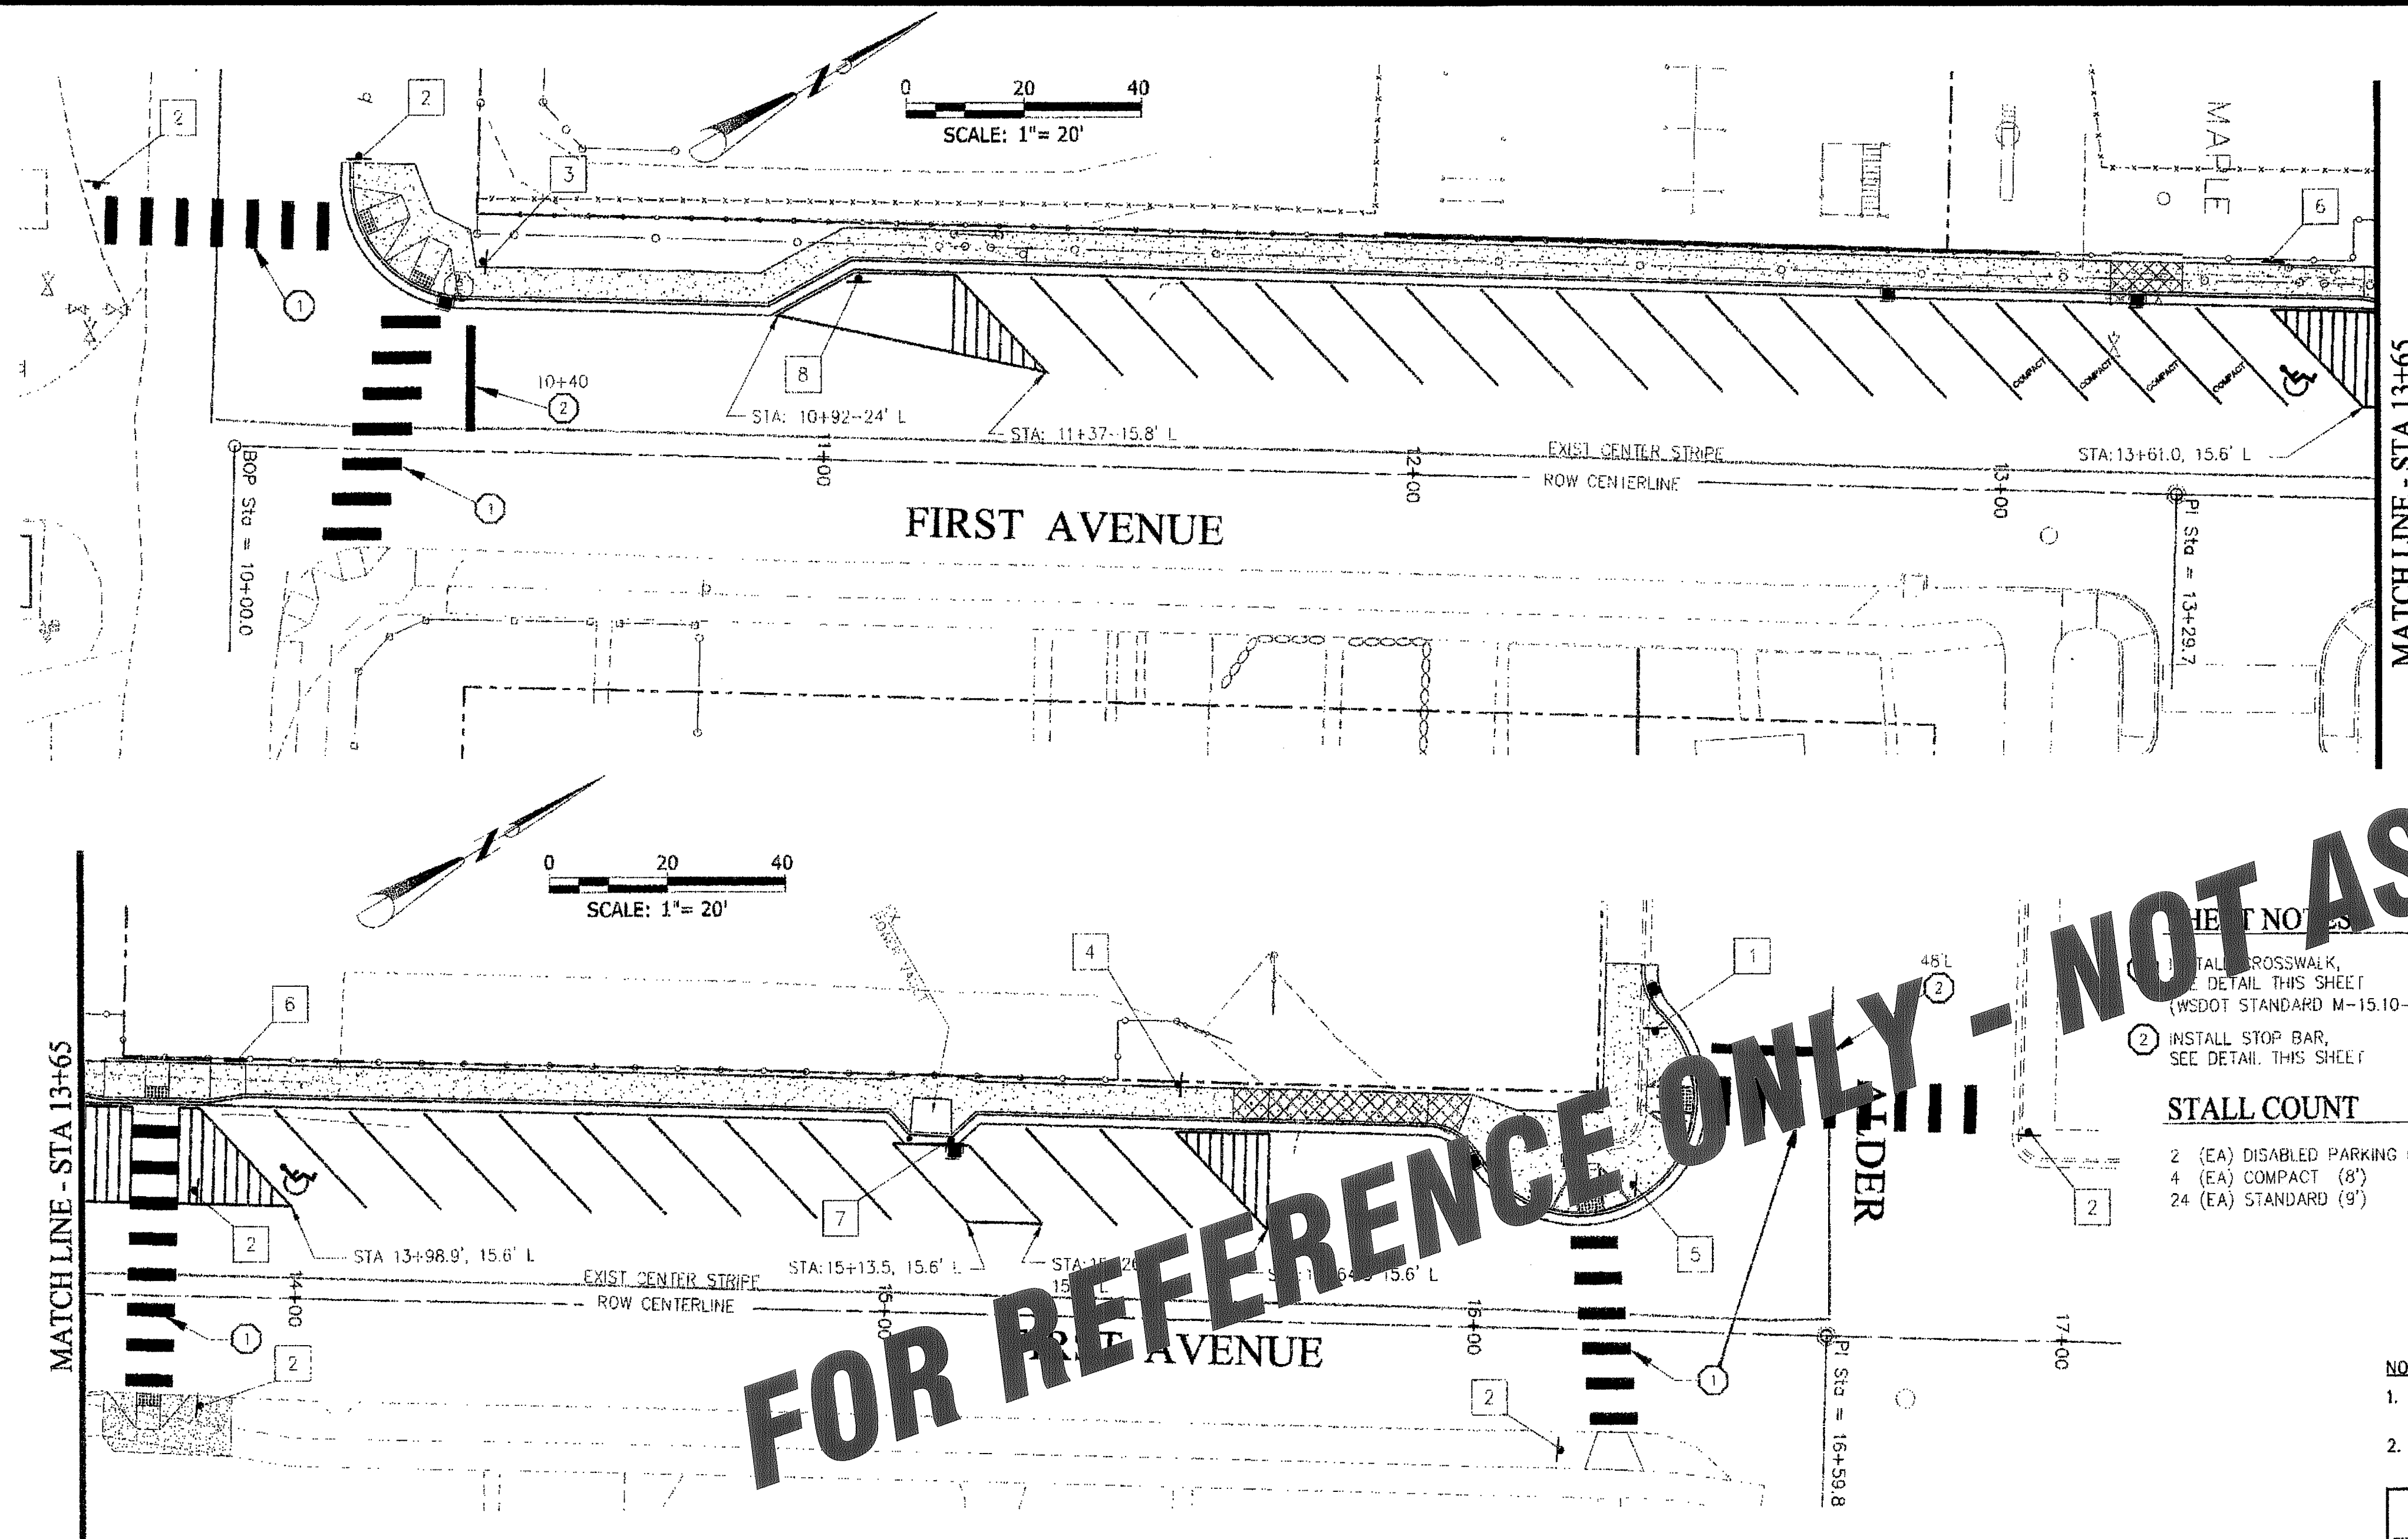


- NOTES:**
1. ALL SIGNS TO BE HIGH INTENSITY GRADE SIGN
 2. ALL SIGN POSTS INSTALLED IN A.C. PAVEMENT OR CONC. PAVEMENT SHALL BE INSTALLED IN SIGN POST SLEEVE, SEE DETAIL THIS SHEET.
- STALL COUNT**
- 2 (EA) DISABLED PARKING (9')
 - 4 (EA) COMPACT (8')
 - 24 (EA) STANDARD (9')

- NOTES:**
1. ALL SIGNS TO BE HIGH INTENSITY GRADE SIGN
 2. ALL SIGN POSTS INSTALLED IN A.C. PAVEMENT OR CONC. PAVEMENT SHALL BE INSTALLED IN SIGN POST SLEEVE, SEE DETAIL THIS SHEET.

SIGN TABLE

NO.	X	SIGN	COMMENTS
1		"STOP" R1-1, 30" x 30"	NEW SIGN, NEW POST (2" ROUND GALV.)
2		SCHOOL CROSSWALK WARNING SIGN, S1-1 & W16--7p	NEW SIGN, NEW POST (2" ROUND GALV.)
3		"STOP" AND "CHERRY STREET" / "1st AVENUE"	EXISTING -- RELOCATE
4		CA SR-4, 24" x 48"	EXISTING -- RELOCATE POLE AND SIGN
5		SCHOOL CROSSWALK WARNING SIGN, W16--7p	EXISTING -- RELOCATE, ADD W16--7P
6		"RESERVED PARKING" HANDICAP WA STATE STANDARD	NEW -- FENCE MOUNTED
7		"MOTORCYCLE PARKING ONLY", 12"x18"	NEW SIGN -- MOUNT ON BOLLARD
8		"MOTORCYCLE PARKING ONLY", 12"x18"	NEW SIGN -- NEW POST (2" ROUND GALV.)

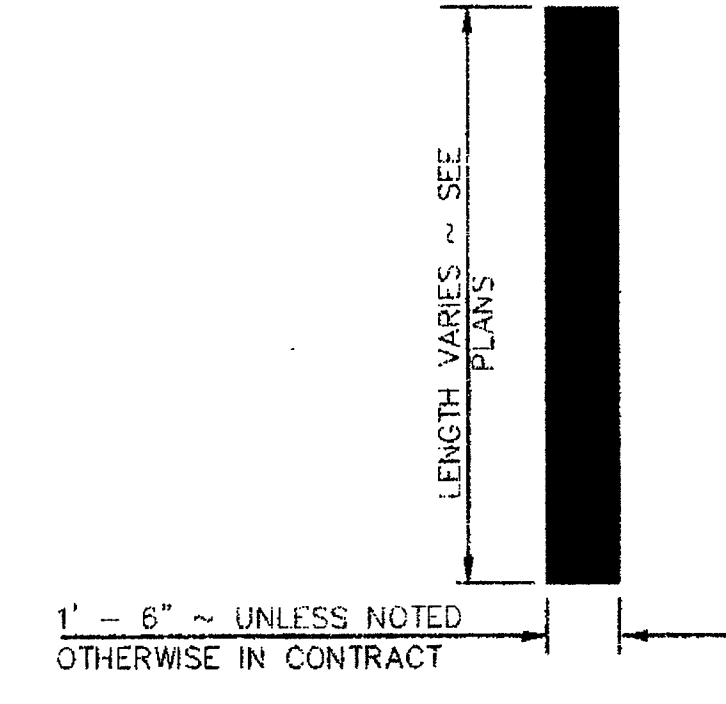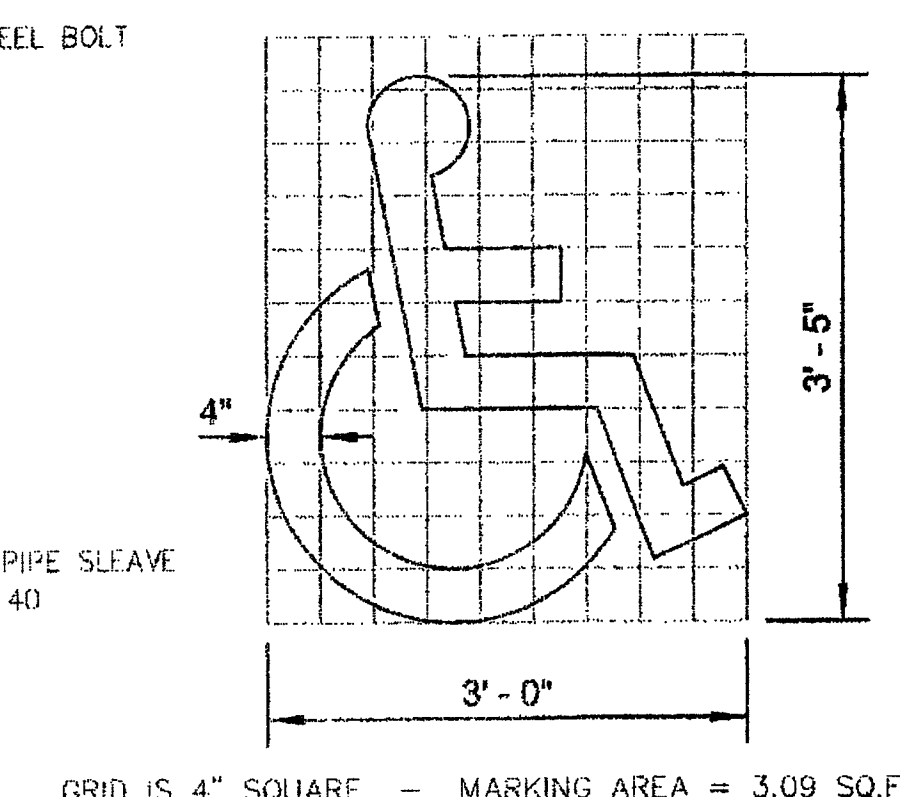
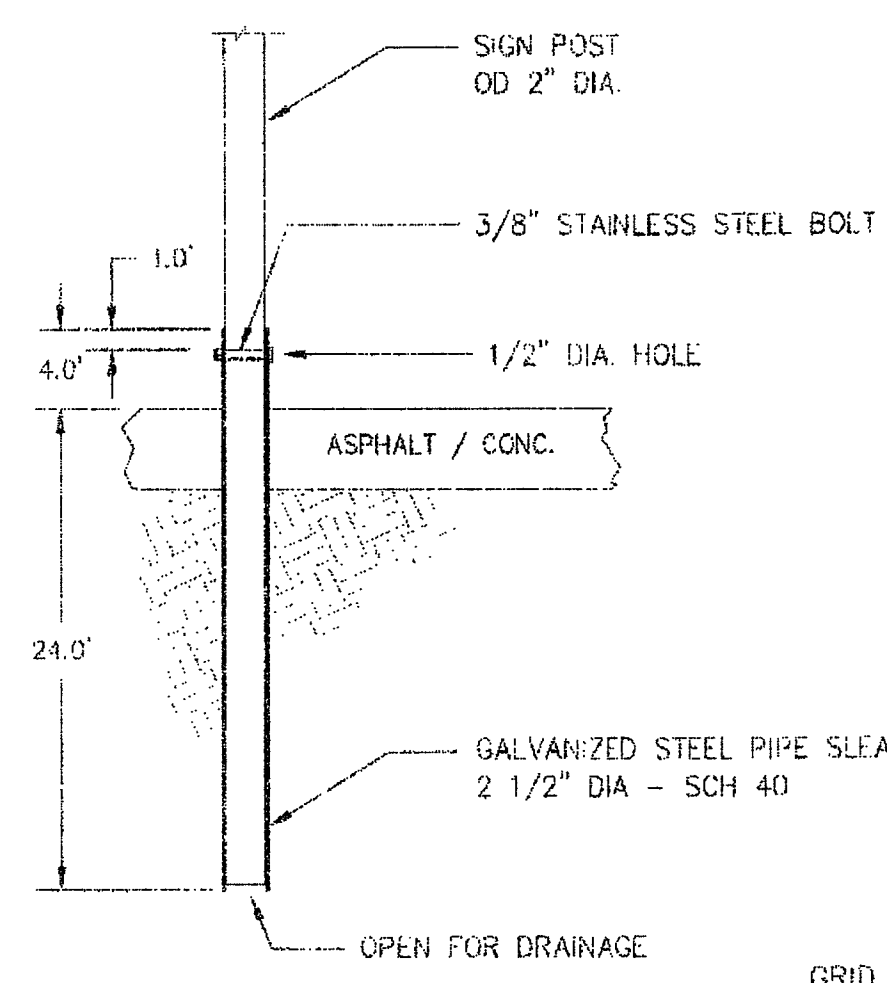
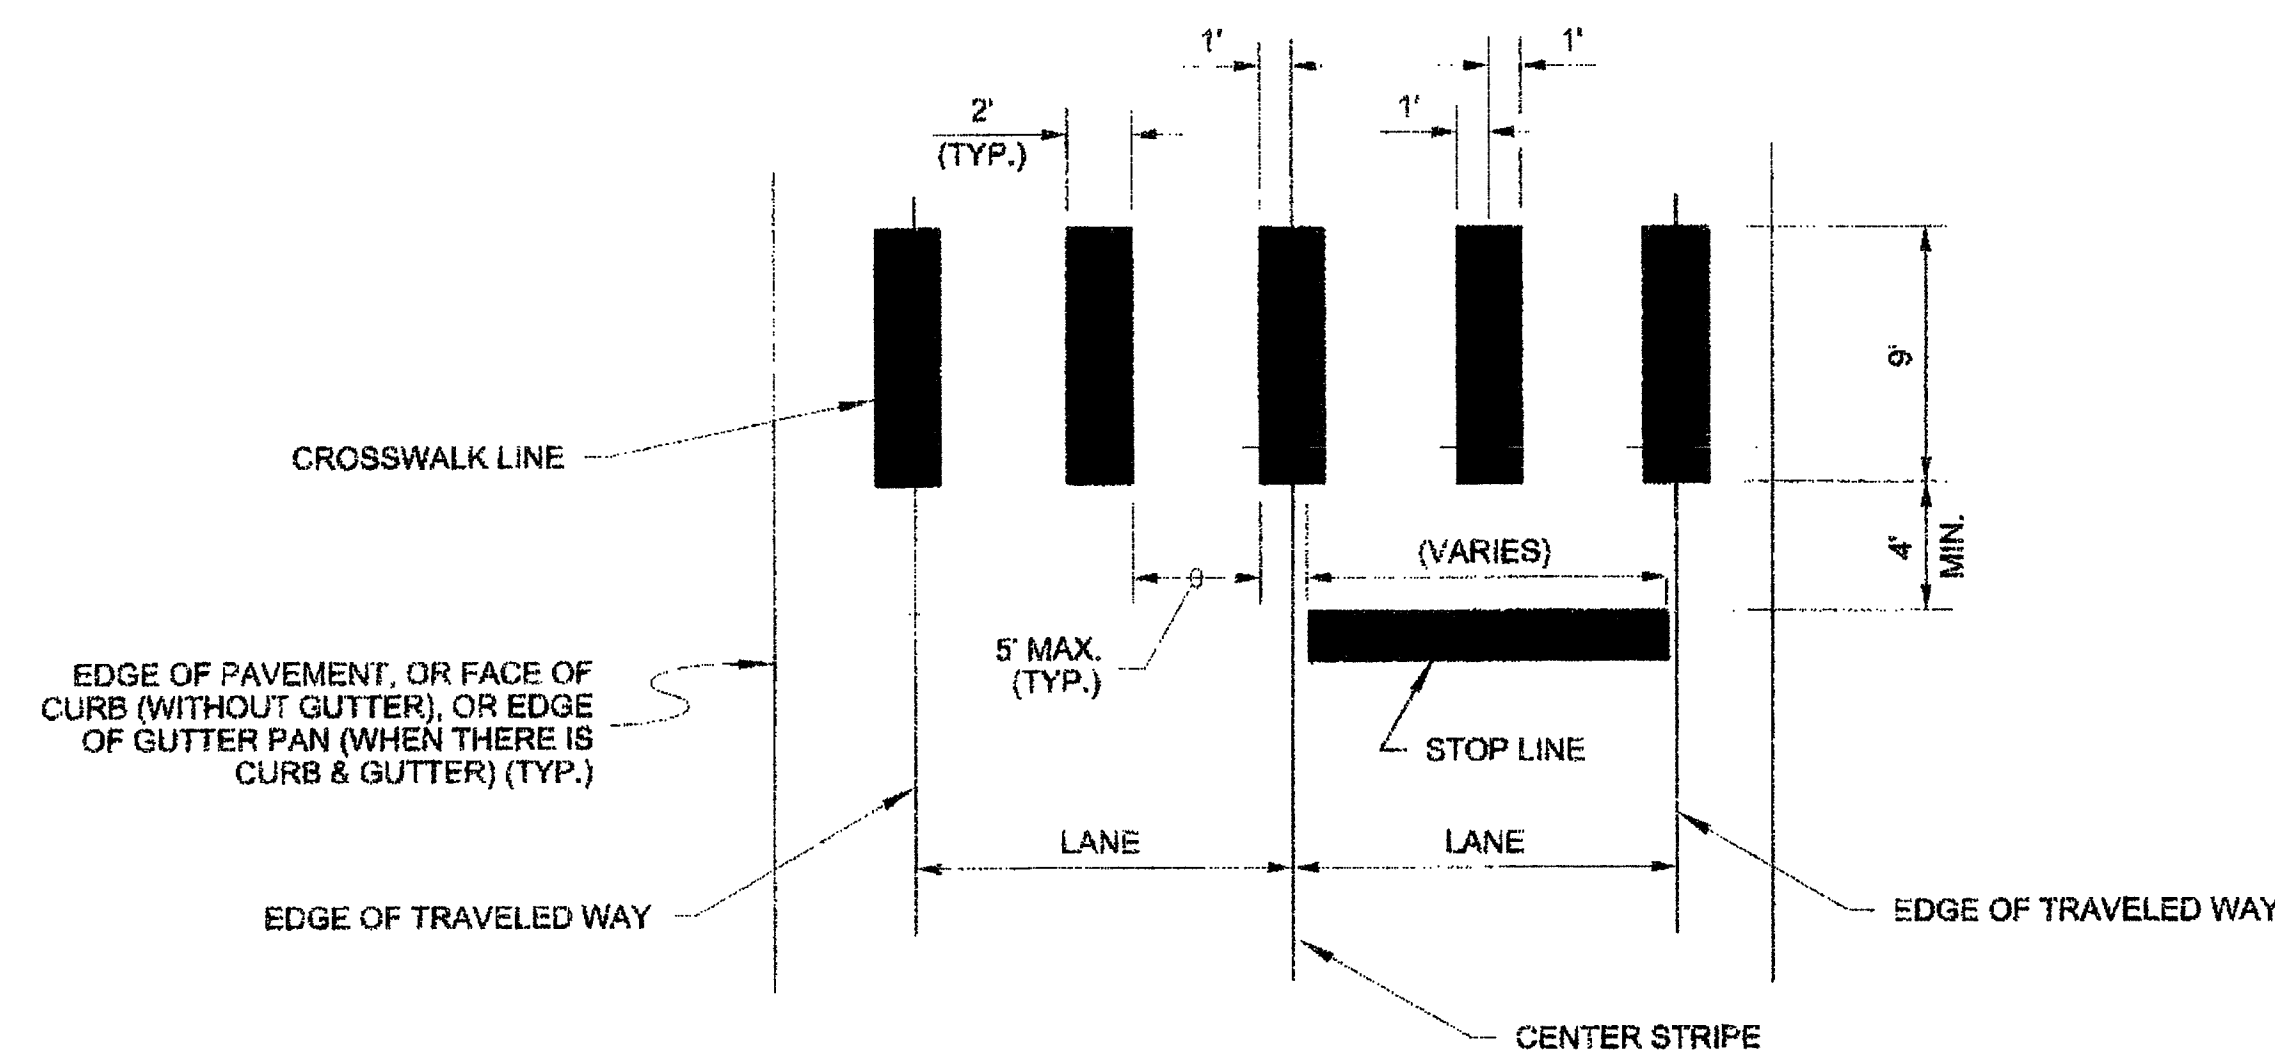


SURVEYOR'S CERTIFICATION

I CERTIFY THAT ON 07/30/09 A FIELD AS-BUILT SURVEY WAS PERFORMED AT FIRST AVENUE BY ME OR UNDER MY DIRECTION AND THAT DATA FROM THAT FIELD SURVEY, INCLUDING LOCATION SHOTS, INVERT MEASUREMENTS AND FIELD BOOK NOTES WERE USED IN PREPARATION OF THESE AS-BUILT PLANS. SAID FIELD SURVEY WORK MEETS OR EXCEEDS THE MINIMUM SURVEY STANDARDS AS PER WAC 332.00.090.


SURVEYOR NAME & LICENSE NUMBER: SCOTT B. HARLOW 37430 DATE: 10/21/09

CALL TWO BUSINESS DAYS BEFORE YOU DIG
WASHINGTON STATE ONE-CALL:
1-800-424-5555
IT'S THE LAW! (RCW 19.122)

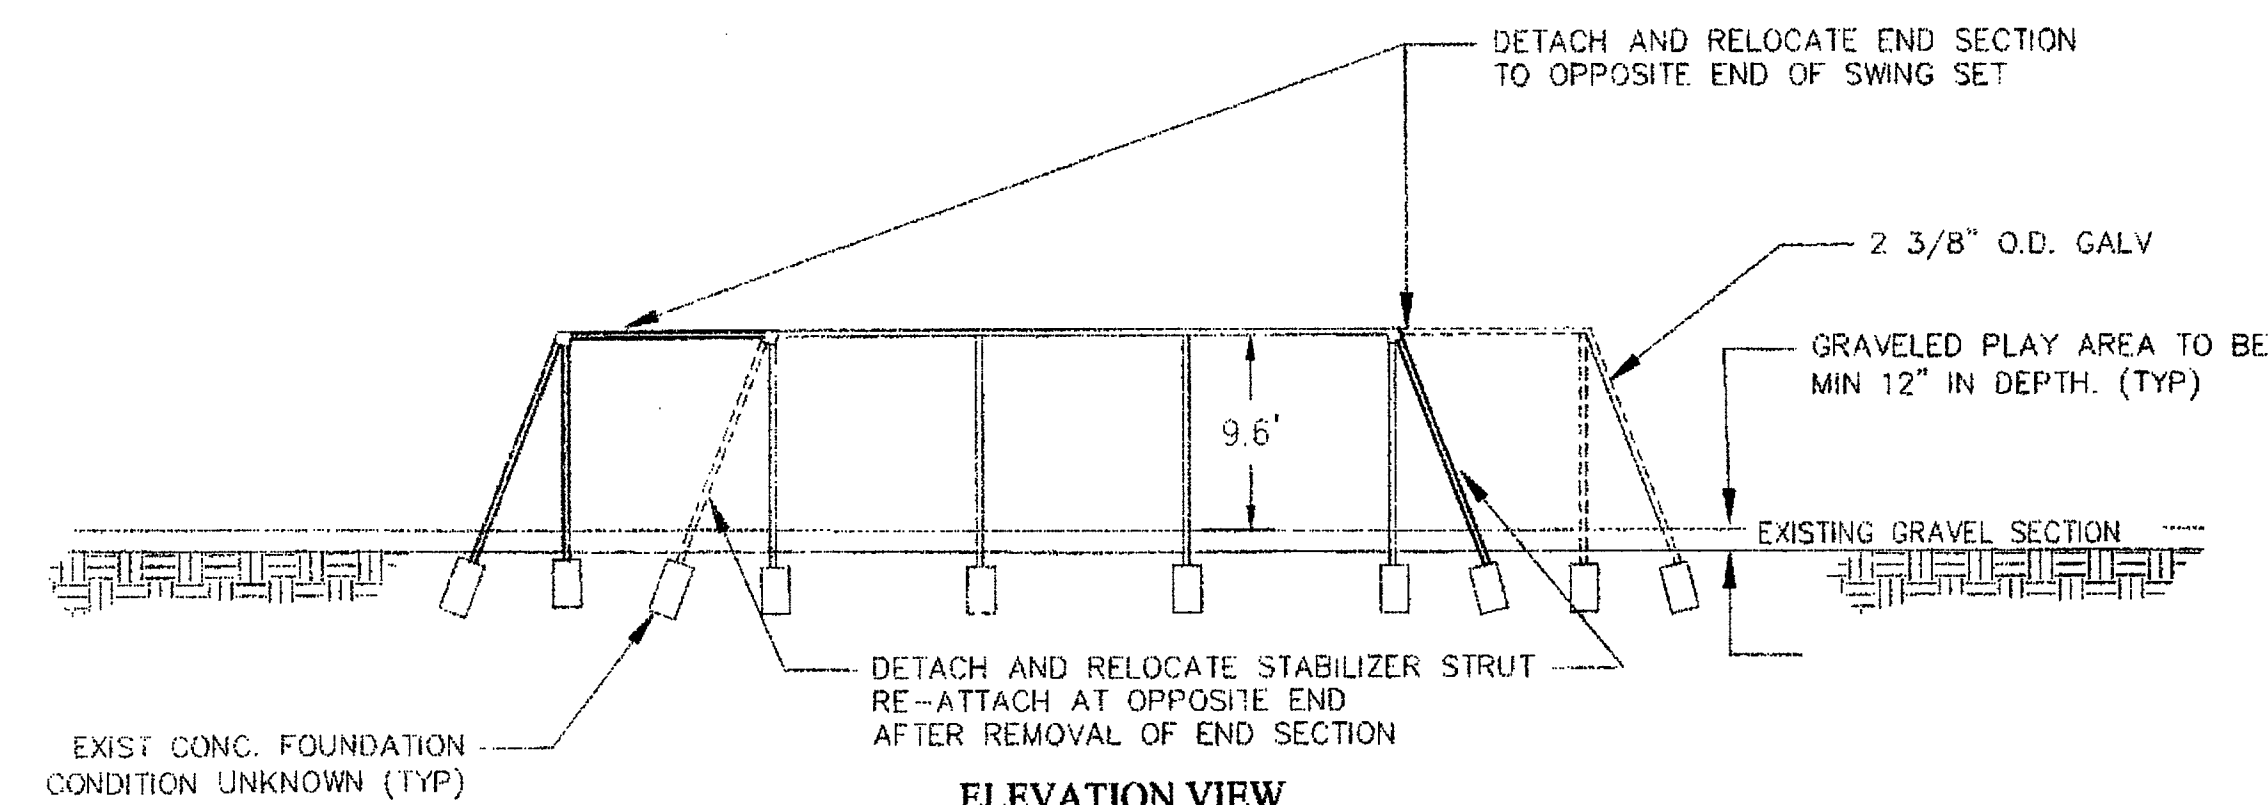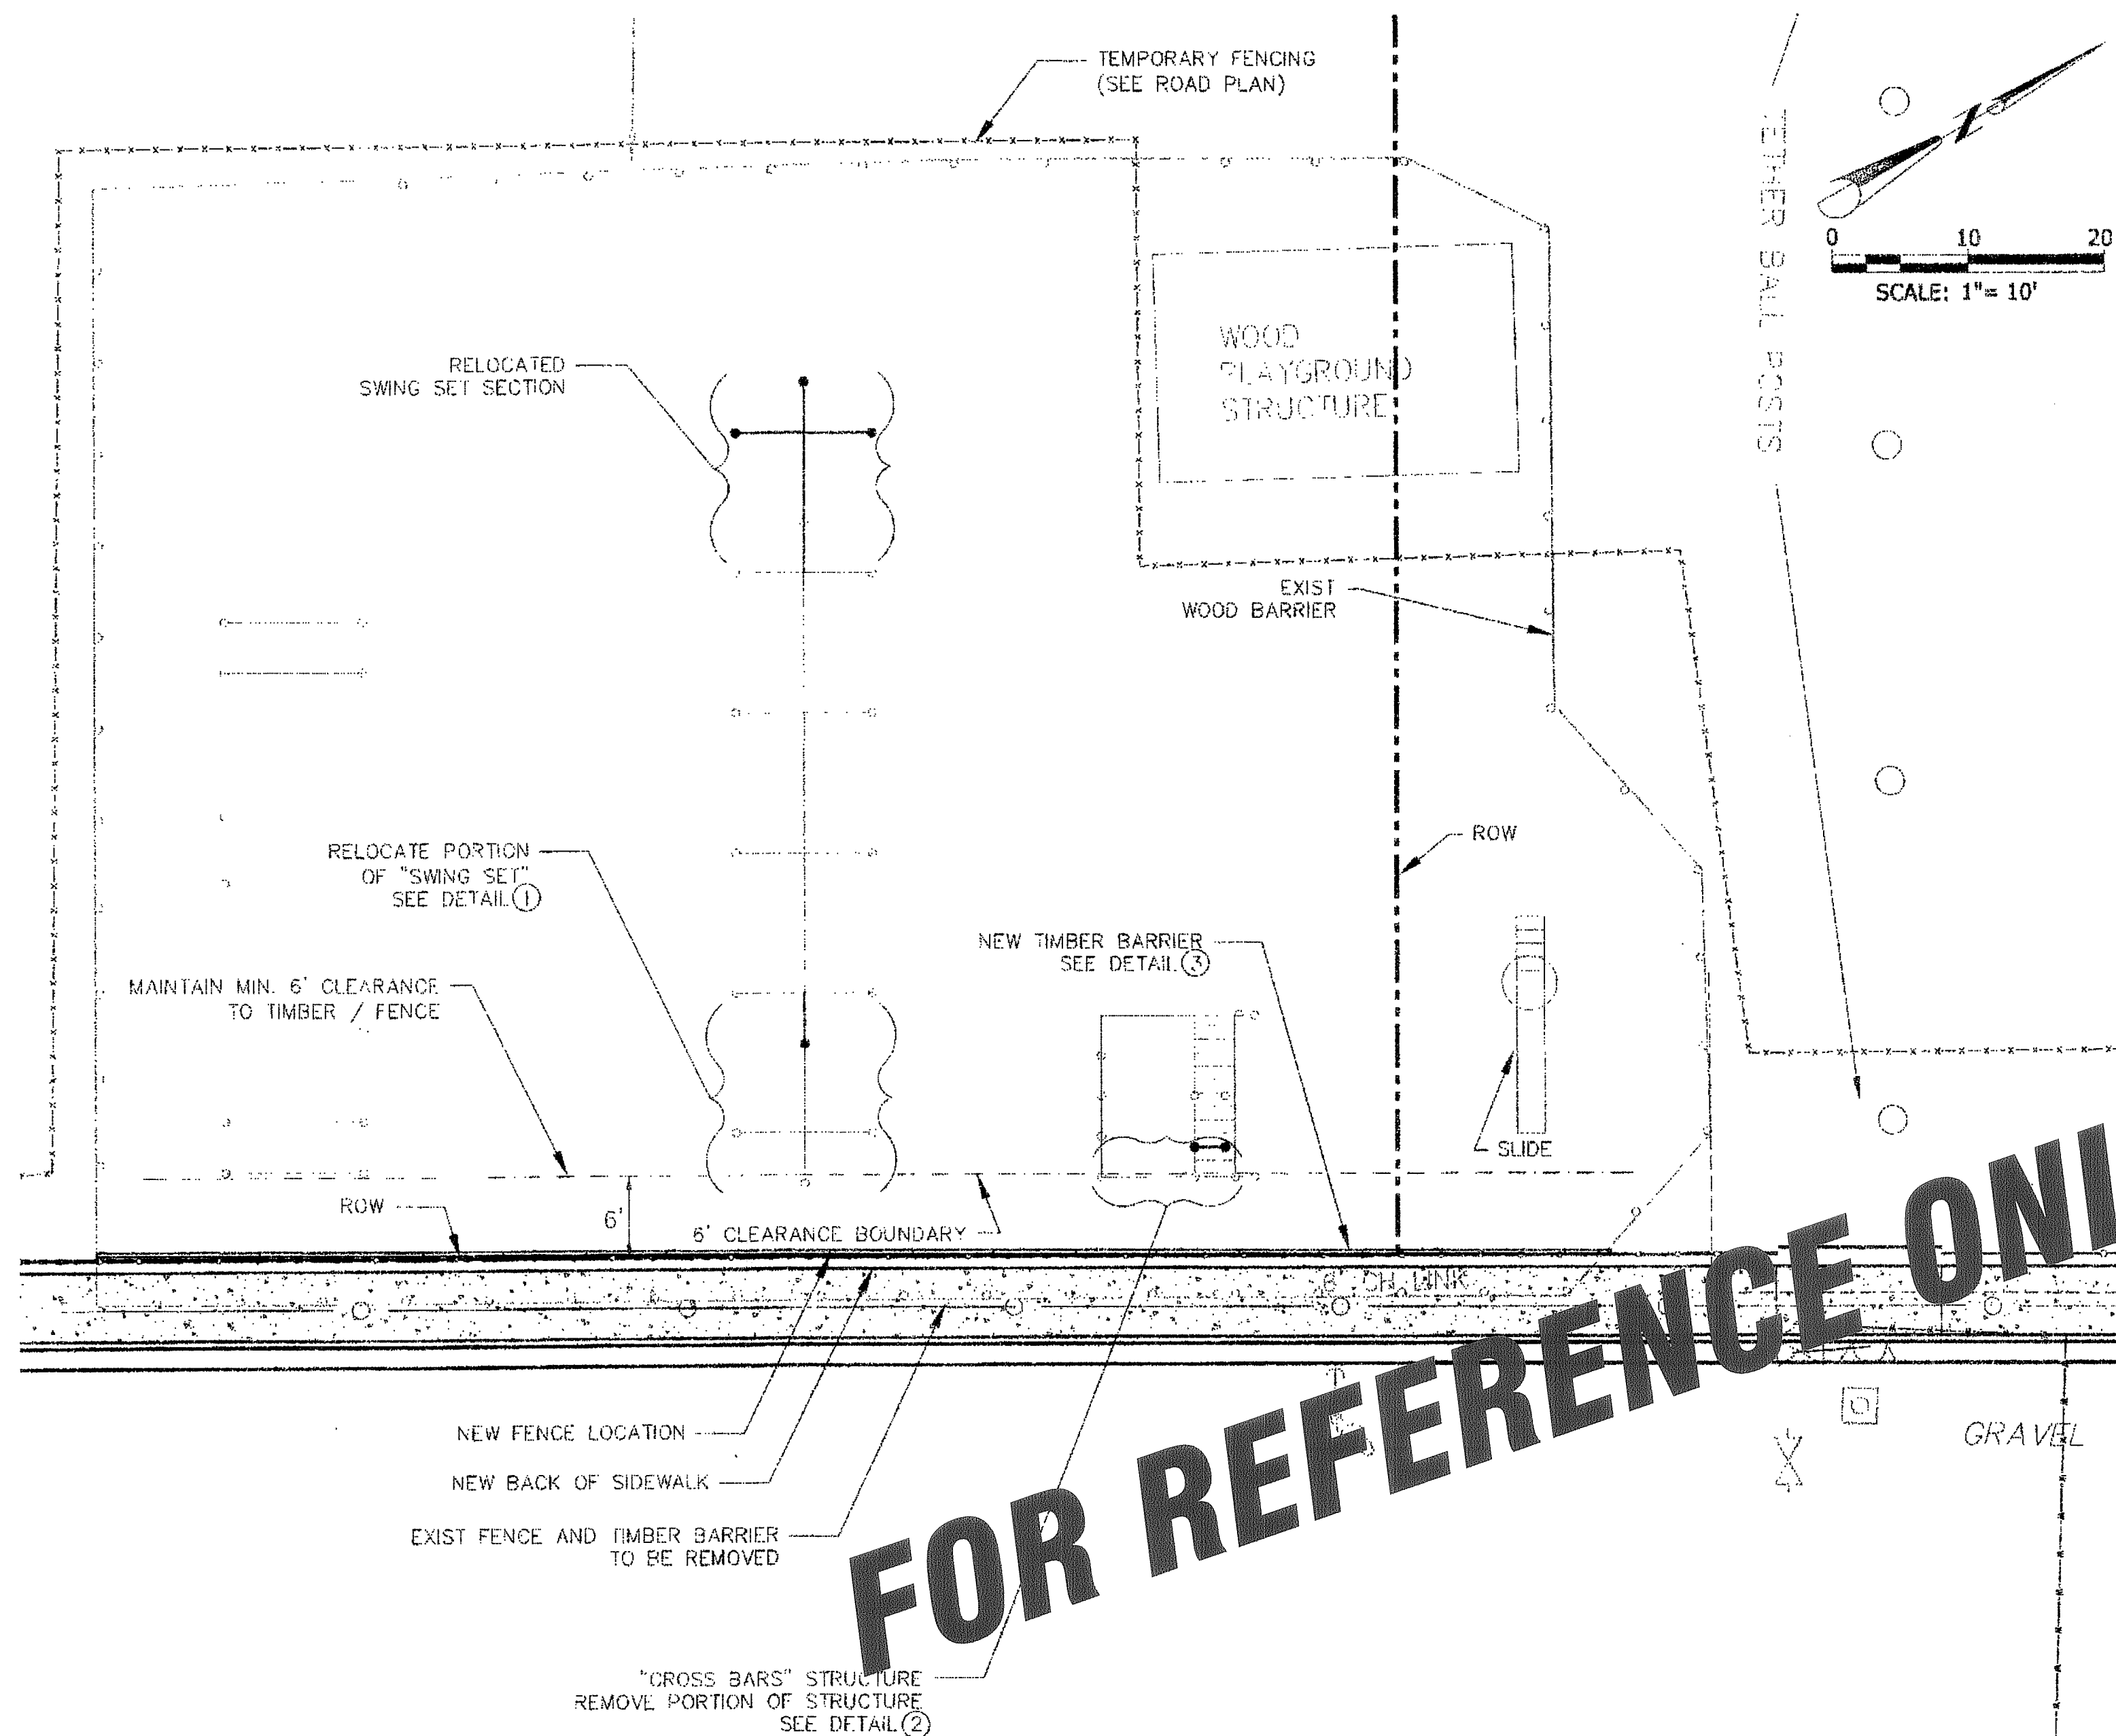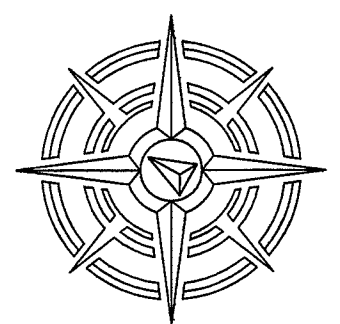

1 SWING SET

Scale: NTS

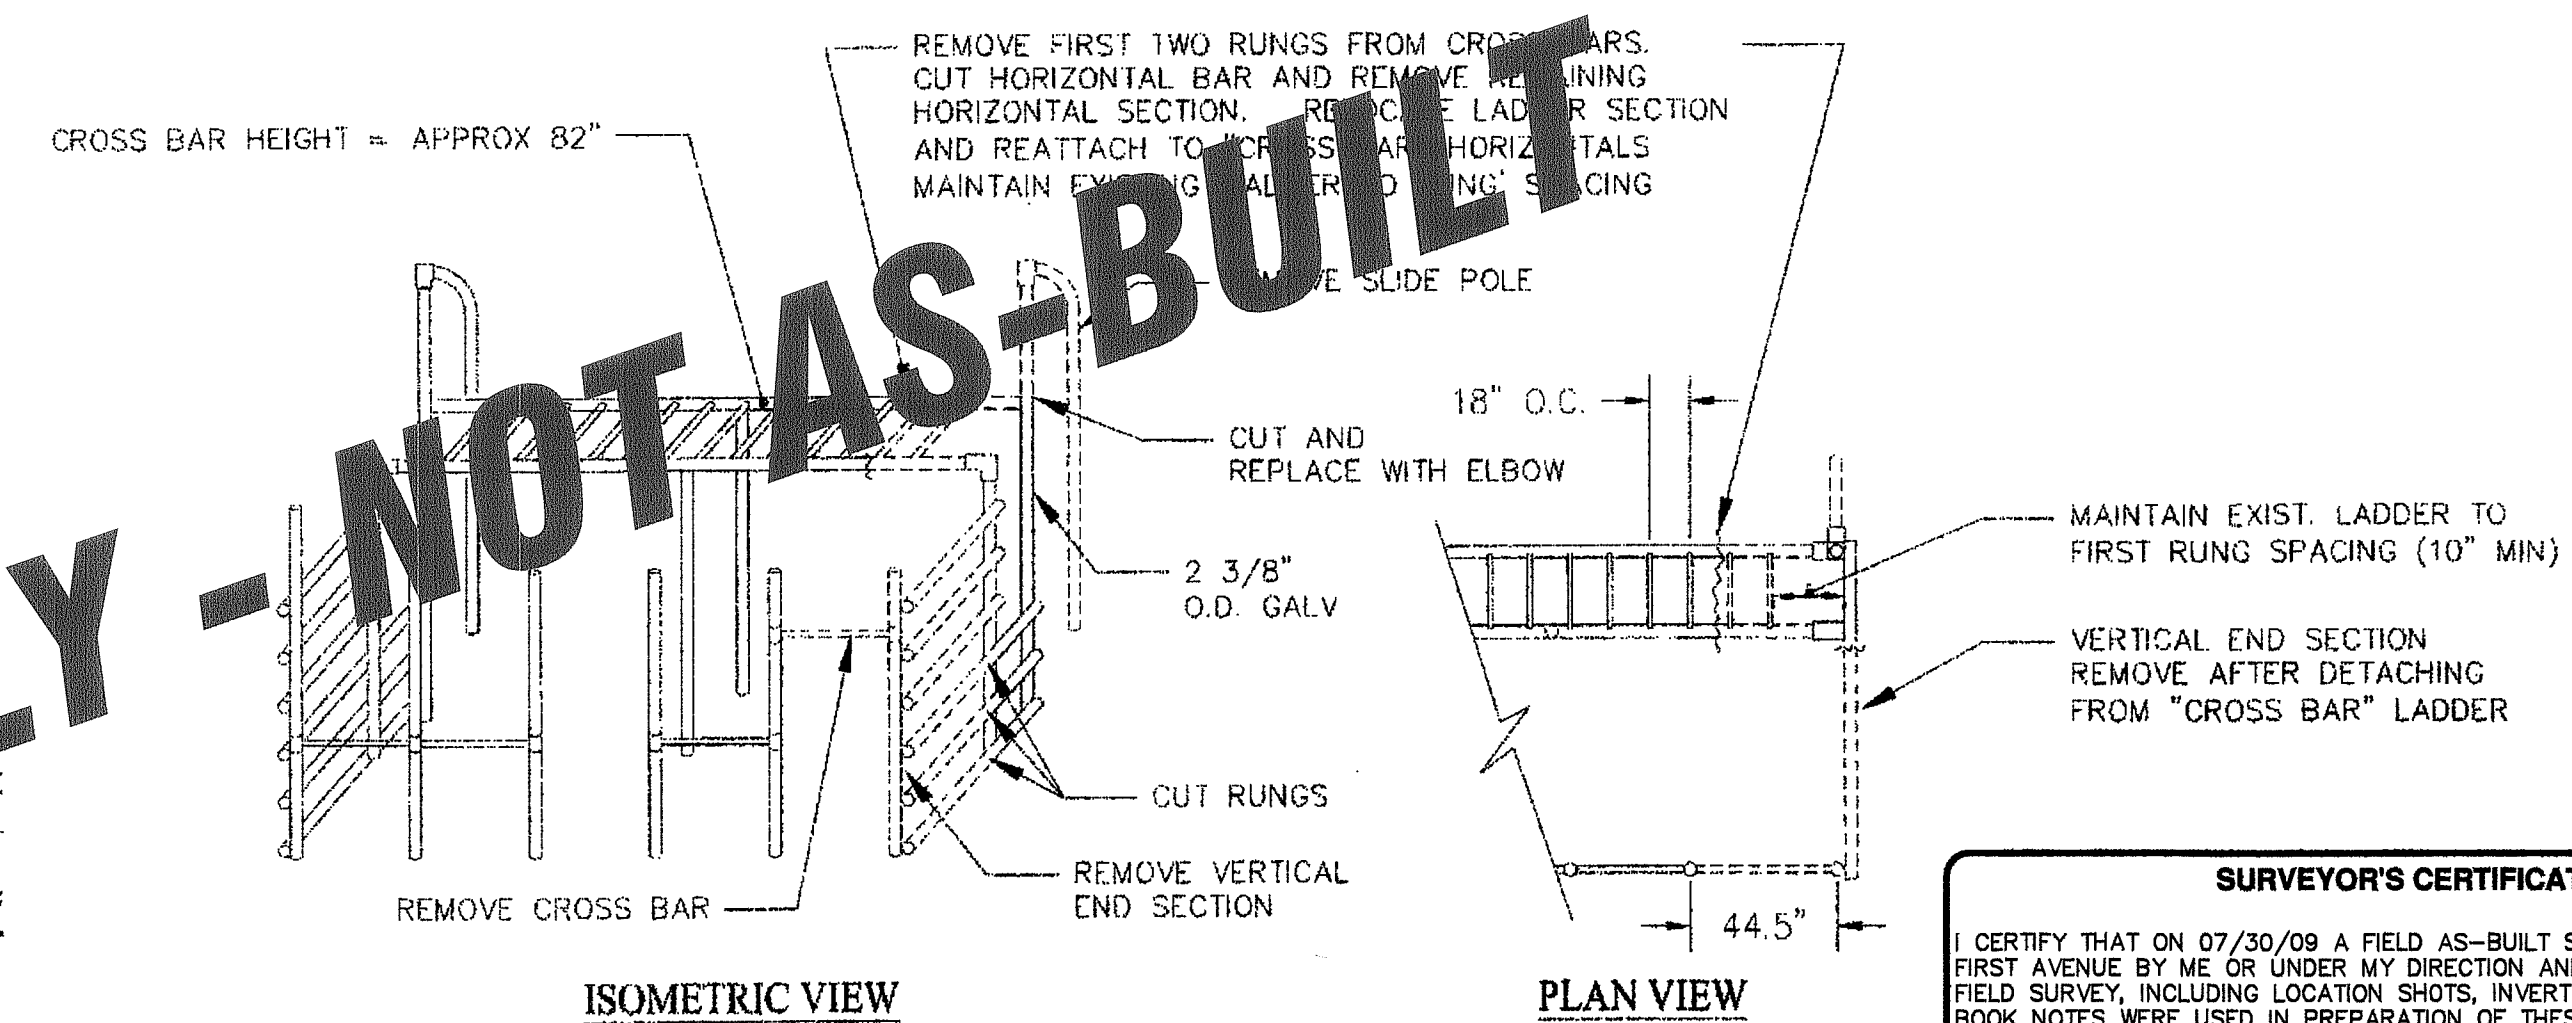

ISOMETRIC VIEW

PLAN VIEW


2 "CROSS BARS" DETAIL

Scale: NTS

SURVEYOR'S CERTIFICATION

I CERTIFY THAT ON 07/30/09 A FIELD AS-BUILT SURVEY WAS PERFORMED AT FIRST AVENUE BY ME OR UNDER MY DIRECTION AND THAT DATA FROM THAT FIELD SURVEY, INCLUDING LOCATION SHOTS, INVERT MEASUREMENTS AND FIELD BOOK NOTES WERE USED IN PREPARATION OF THESE AS-BUILT PLANS. SAID FIELD SURVEY WORK MEETS OR EXCEEDS THE MINIMUM SURVEY STANDARDS AS PER WAC 332.130.090.


Scott G. Harkins 32430 10/20/09
SURVEYOR NAME & LICENSE NUMBER DATE

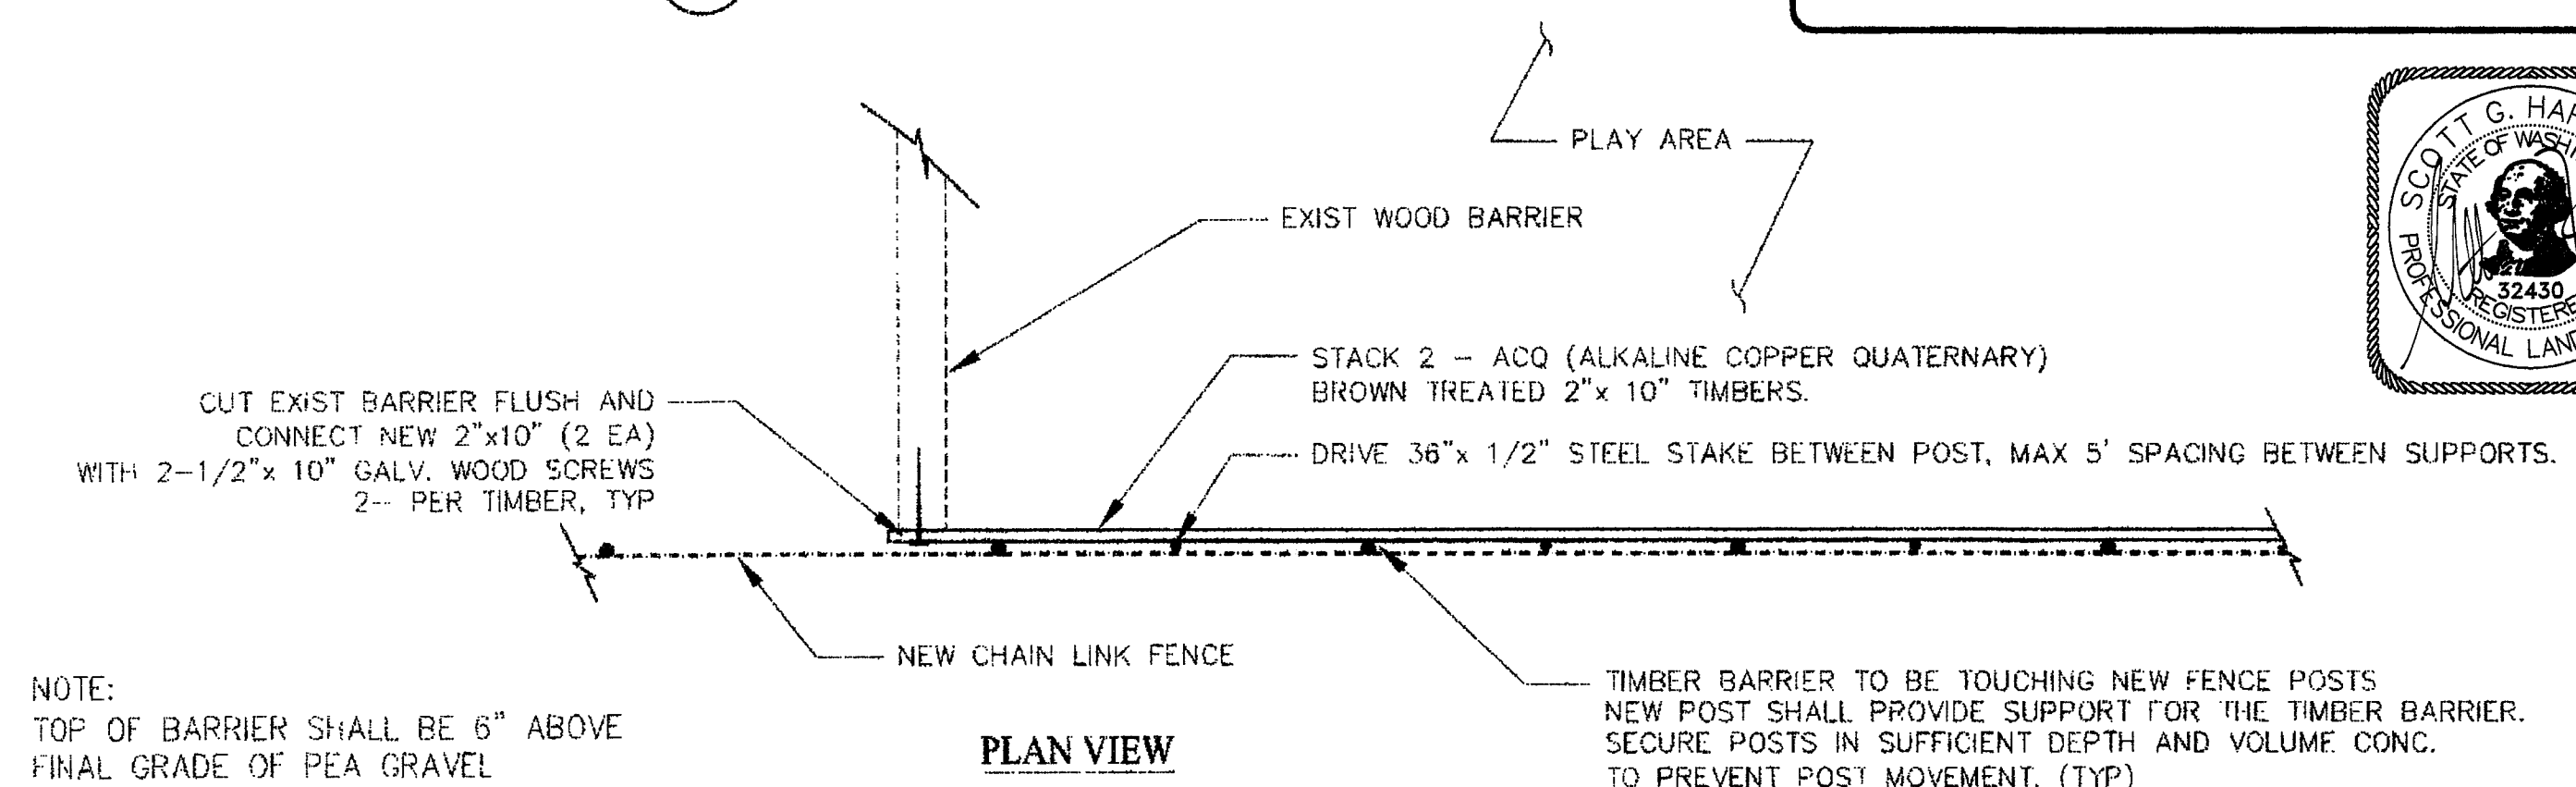

PLAN VIEW

NOTE:
TOP OF BARRIER SHALL BE 6\"/>

DETAIL APPLIES TO CONNECTION AT BOTH ENDS.

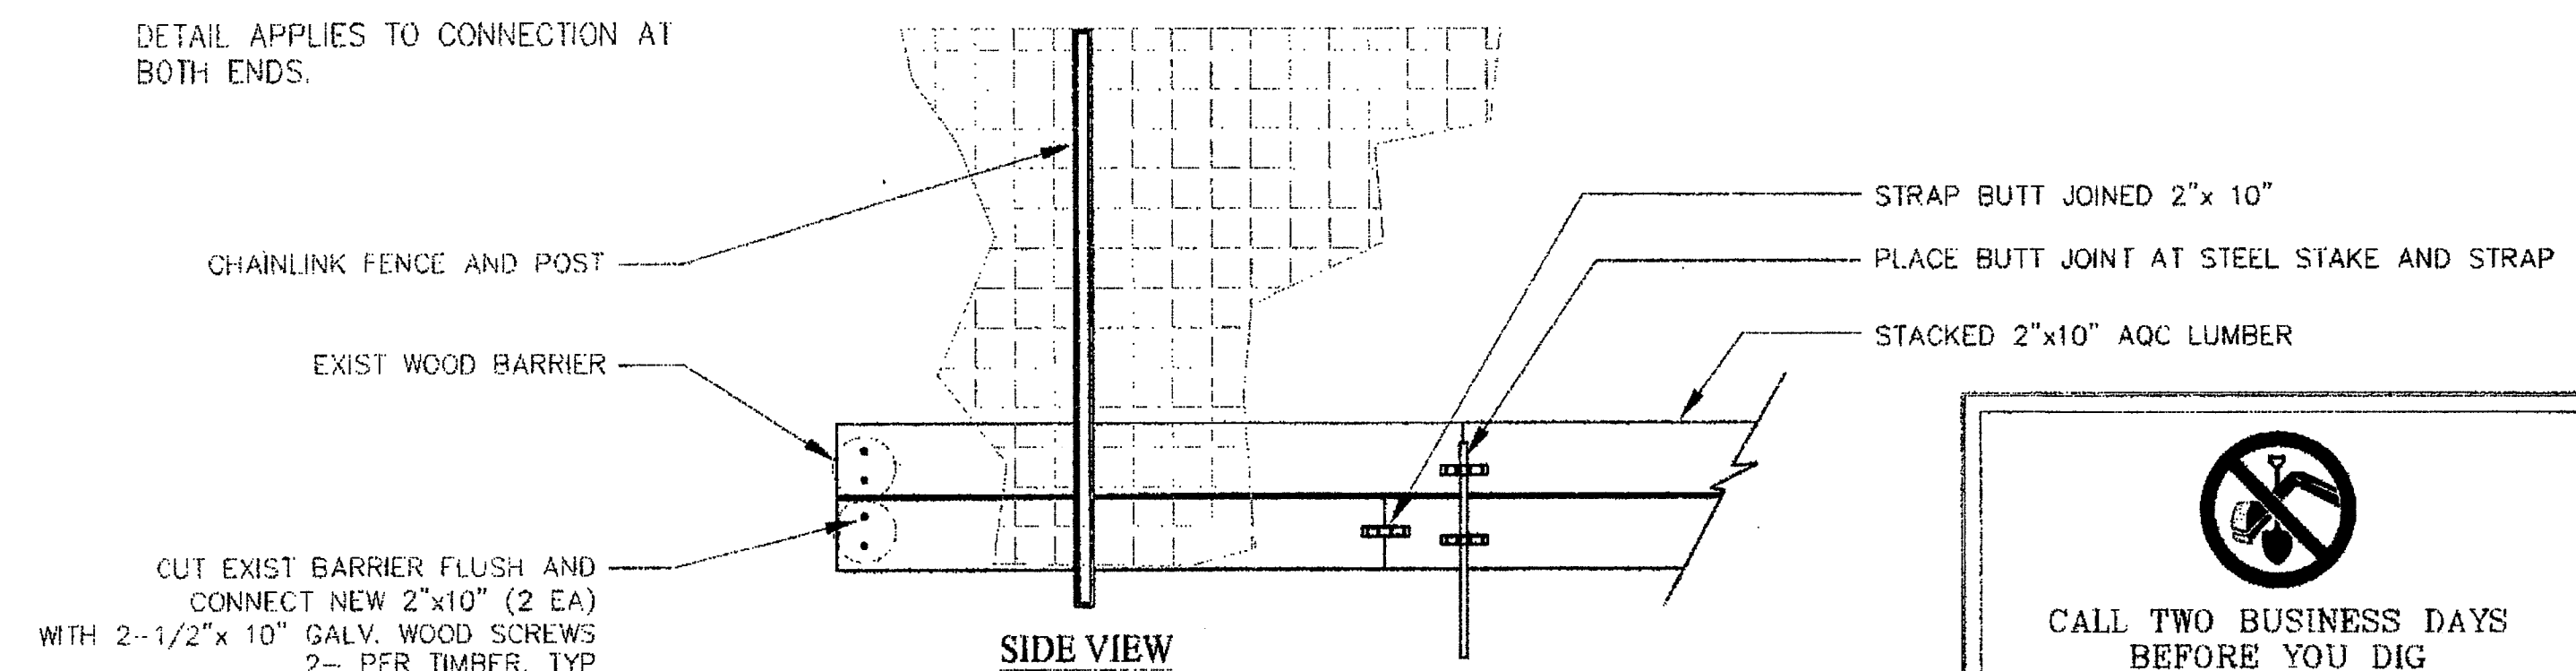

SIDE VIEW

3 TIMBER PEA GRAVEL BARRIER

Scale: NTS

CALL TWO BUSINESS DAYS BEFORE YOU DIG
WASHINGTON STATE ONE-CALL:
1-800-424-5555

IT'S THE LAW! (RCW 19.122)

INTENT OF IMPROVEMENTS:

RECONFIGURE EXISTING PLAY EQUIPMENT TO PROVIDE 6' MIN. CLEARANCE FROM NEWLY INSTALLED FENCE AND TIMBER BARRIER.

NOTES:

- CONTRACTOR SHALL NOTIFY CITY AND SCHOOL PRIOR TO PERFORMING WORK.
- MAINTAIN ORIGINAL CONC. FOUNDATIONS AND PRESERVE EXIST. PIPE.
- SET EXIST. CONC. FOUNDATION AND BACKFILL EXCAVATION WITH CONTROLLED DENSITY BACKFILL (CDF) 2-09.3 (1) E WSDOT STD SPEC. MIN 28 DAY STRENGTH = 100 psi.
- CDF SHALL NOT BE PLACED ABOVE TOP OF ORIGINAL CONC. FOUNDATION ELEVATION.
- NEW PIPE MATERIALS SHALL BE OF LIKE KIND AND GAUGE, GALVANIZED.
- ALL EXPOSED AND DISTURBED METAL SURFACES SHALL BE PAINTED ON IMPROVED STRUCTURES. SEE WSDOT SPEC. 9-08.2 FOR FORMULA A-9-73.
- ALL IMPROVED STRUCTURES SHALL BE FREE OF SHARP EDGES AND BURRS.
- MAINTAIN A 6' CLEARANCE FROM PLAY STRUCTURES TO NEW FENCE AND TIMBER BARRIER.
- TIMBER BARRIER TO BE TREATED WITH ACQ-B (ALKALINE COPPER QUATERNARY) ON ALL END CUTS.
- PRESERVE EXCAVATED PEA GRAVEL AND IMPORT MINIMUM 10 CU. YARDS OF CLEANED AND WASHED PEA GRAVEL IN PLAY AREA. GRADE TO A UNIFORM ELEVATION, MAINTAINING A MINIMUM DEPTH OF 12\"/>
- ALL IMPROVEMENTS SHALL MEET ASTM F 1487 - 07a SPECIFICATION FOR PLAYGROUND EQUIPMENT FOR PUBLIC USE.
- DEMOLISHED PIPE MATERIAL SHALL BE DELIVERED TO THE SCHOOL AFTER REMOVAL.
- THE CONTRACTOR SHALL FIELD VERIFY ALL DIMENSIONS AND CONDITIONS PRIOR TO BID. PAYMENT SHALL BE LUMP SUM, INCLUDING ALL LABOR, MATERIALS, AND EQUIPMENT FOR COMPLETION AS INTENDED AND SHOWN. THE CONTRACT PRICE SHALL INCLUDE ALL INCIDENTAL COSTS TO COMPLETE THE WORK.
- NO PUBLIC ACCESS THROUGH NEW FENCE.
- CONTRACTOR SHALL CONTACT CITY INSPECTOR AND WHATCOM COUNTY HEALTH DEPARTMENT (DOH) TWO WORKING DAYS IN ADVANCE PRIOR TO FINAL INSPECTION. (360) 676-6724. (DOH)