

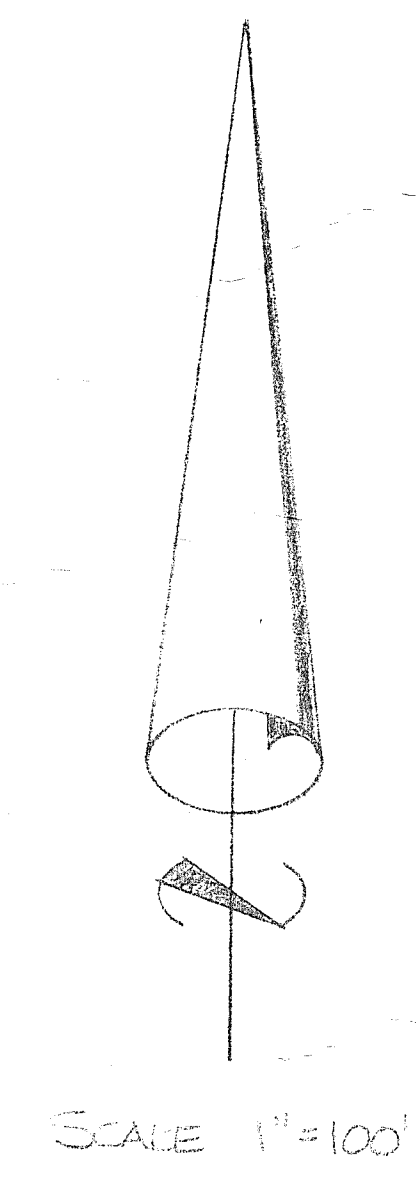
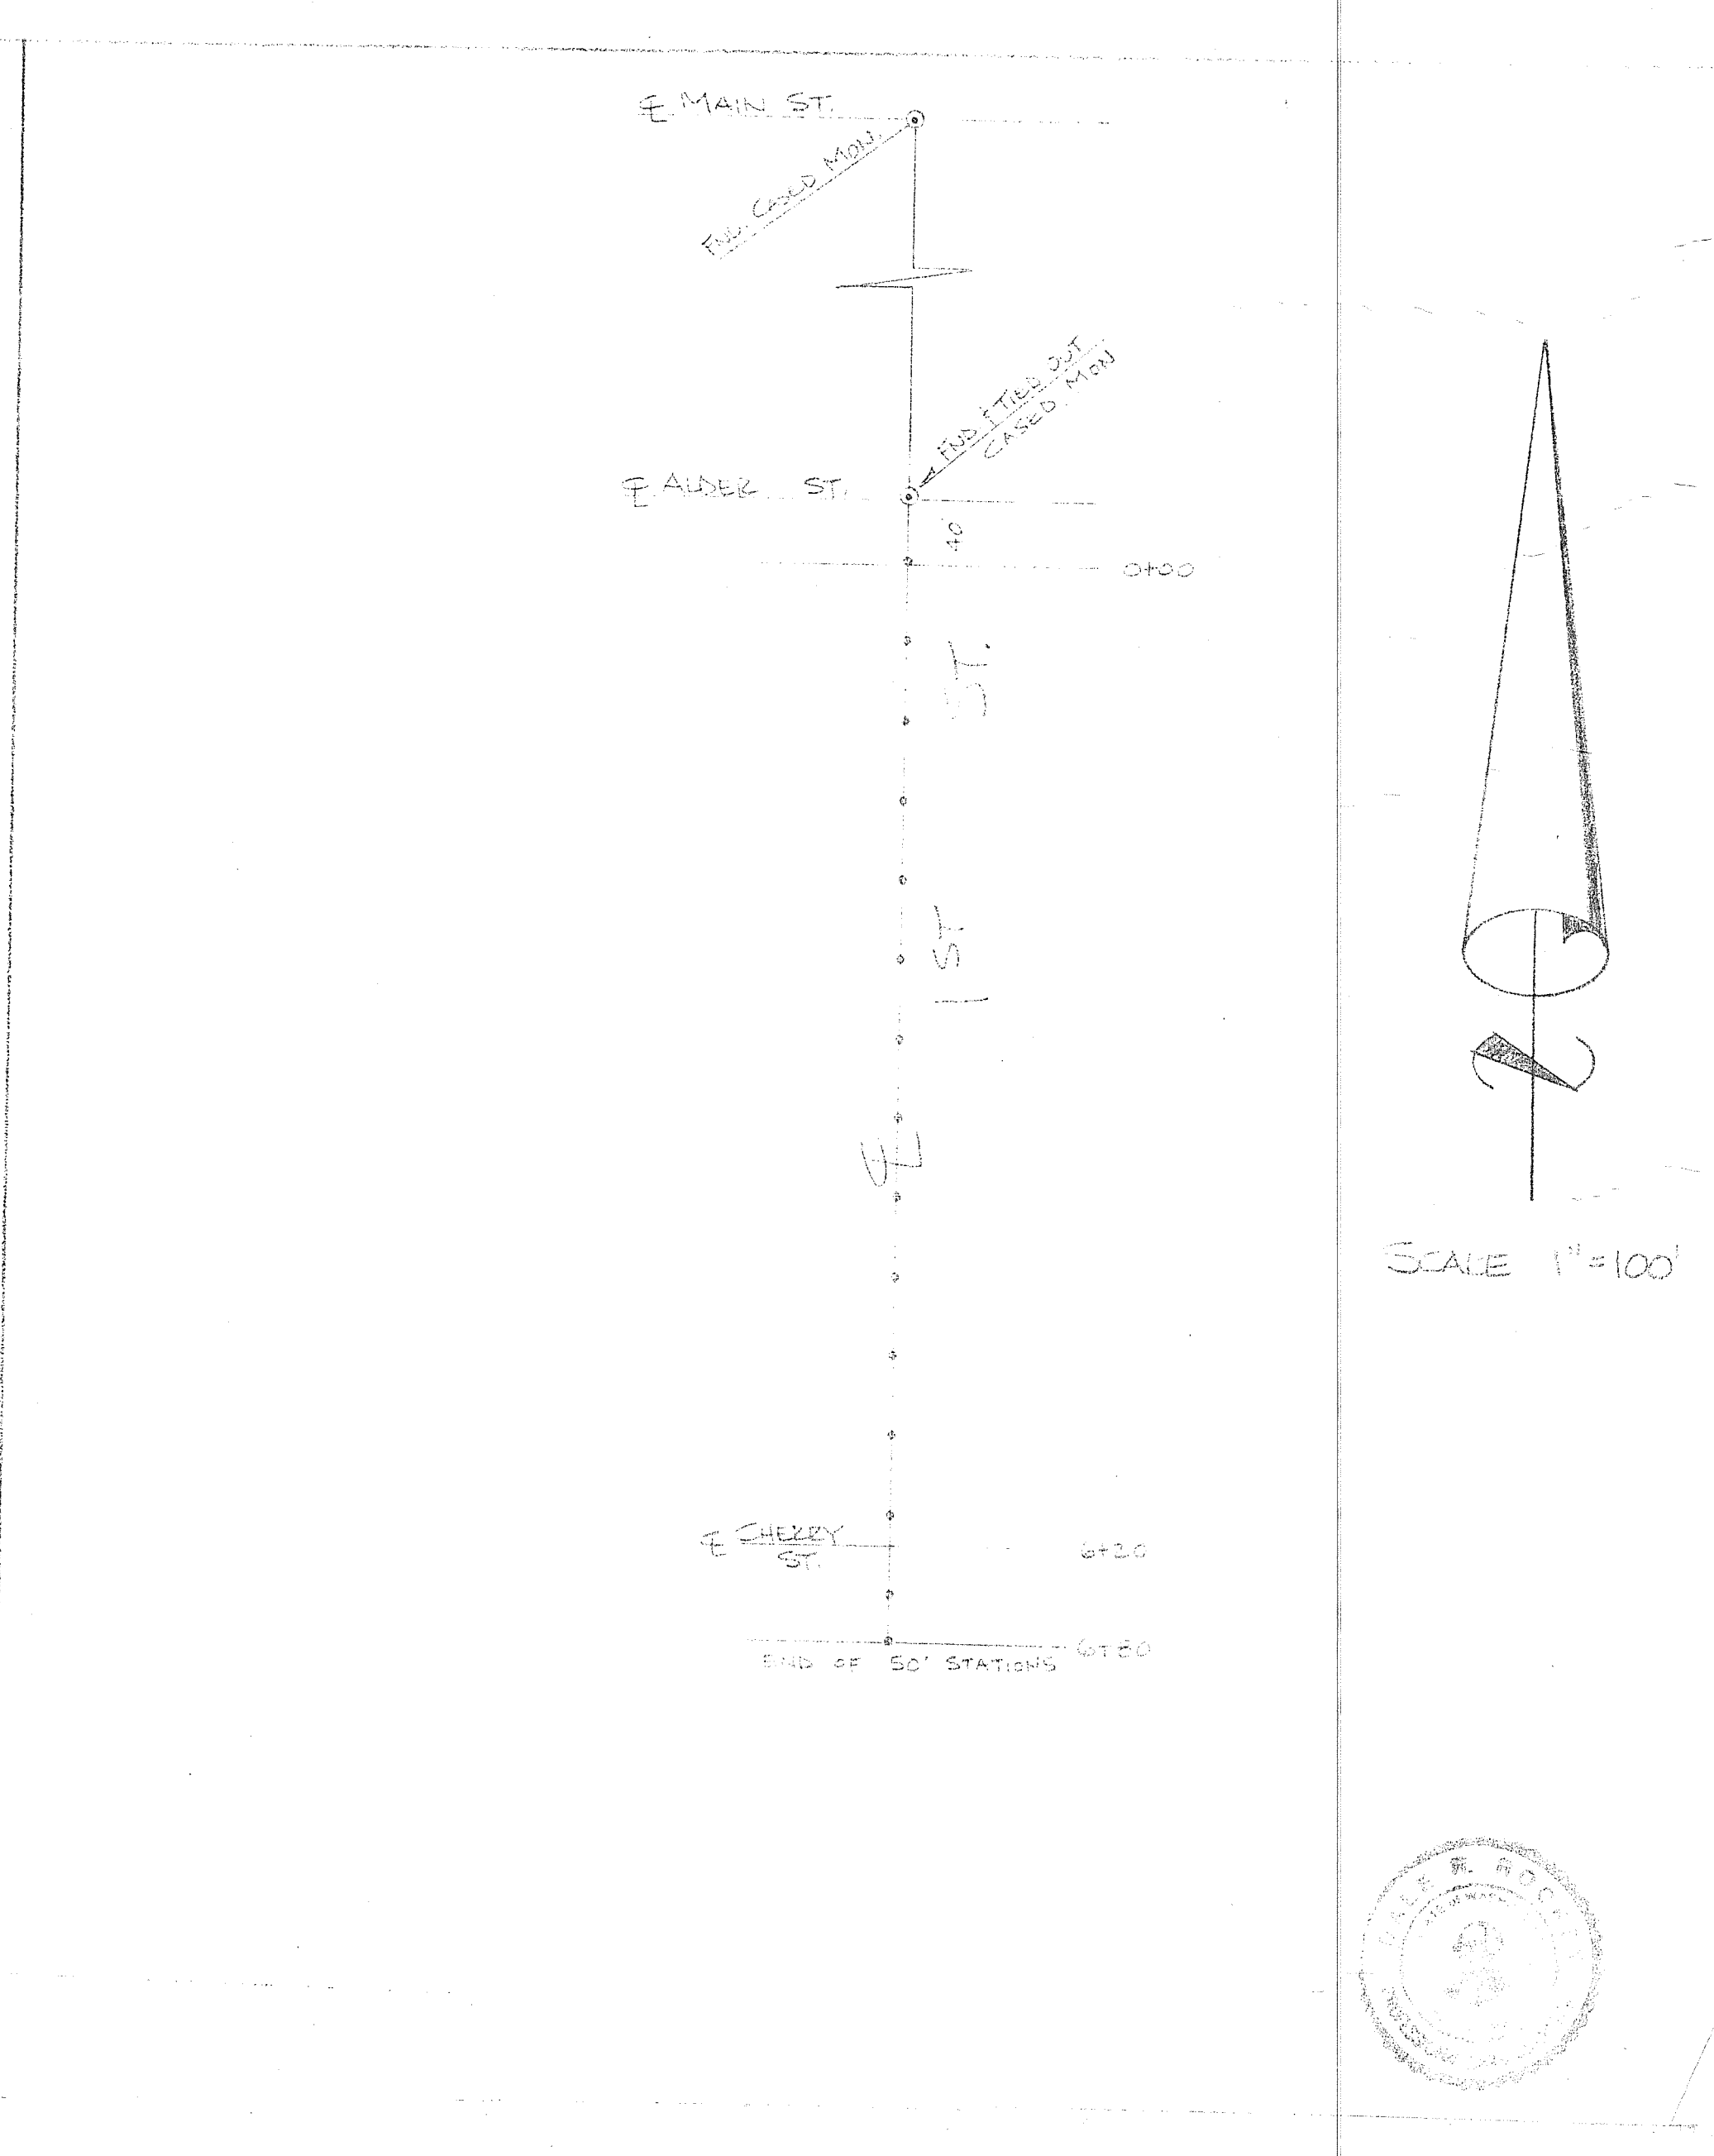
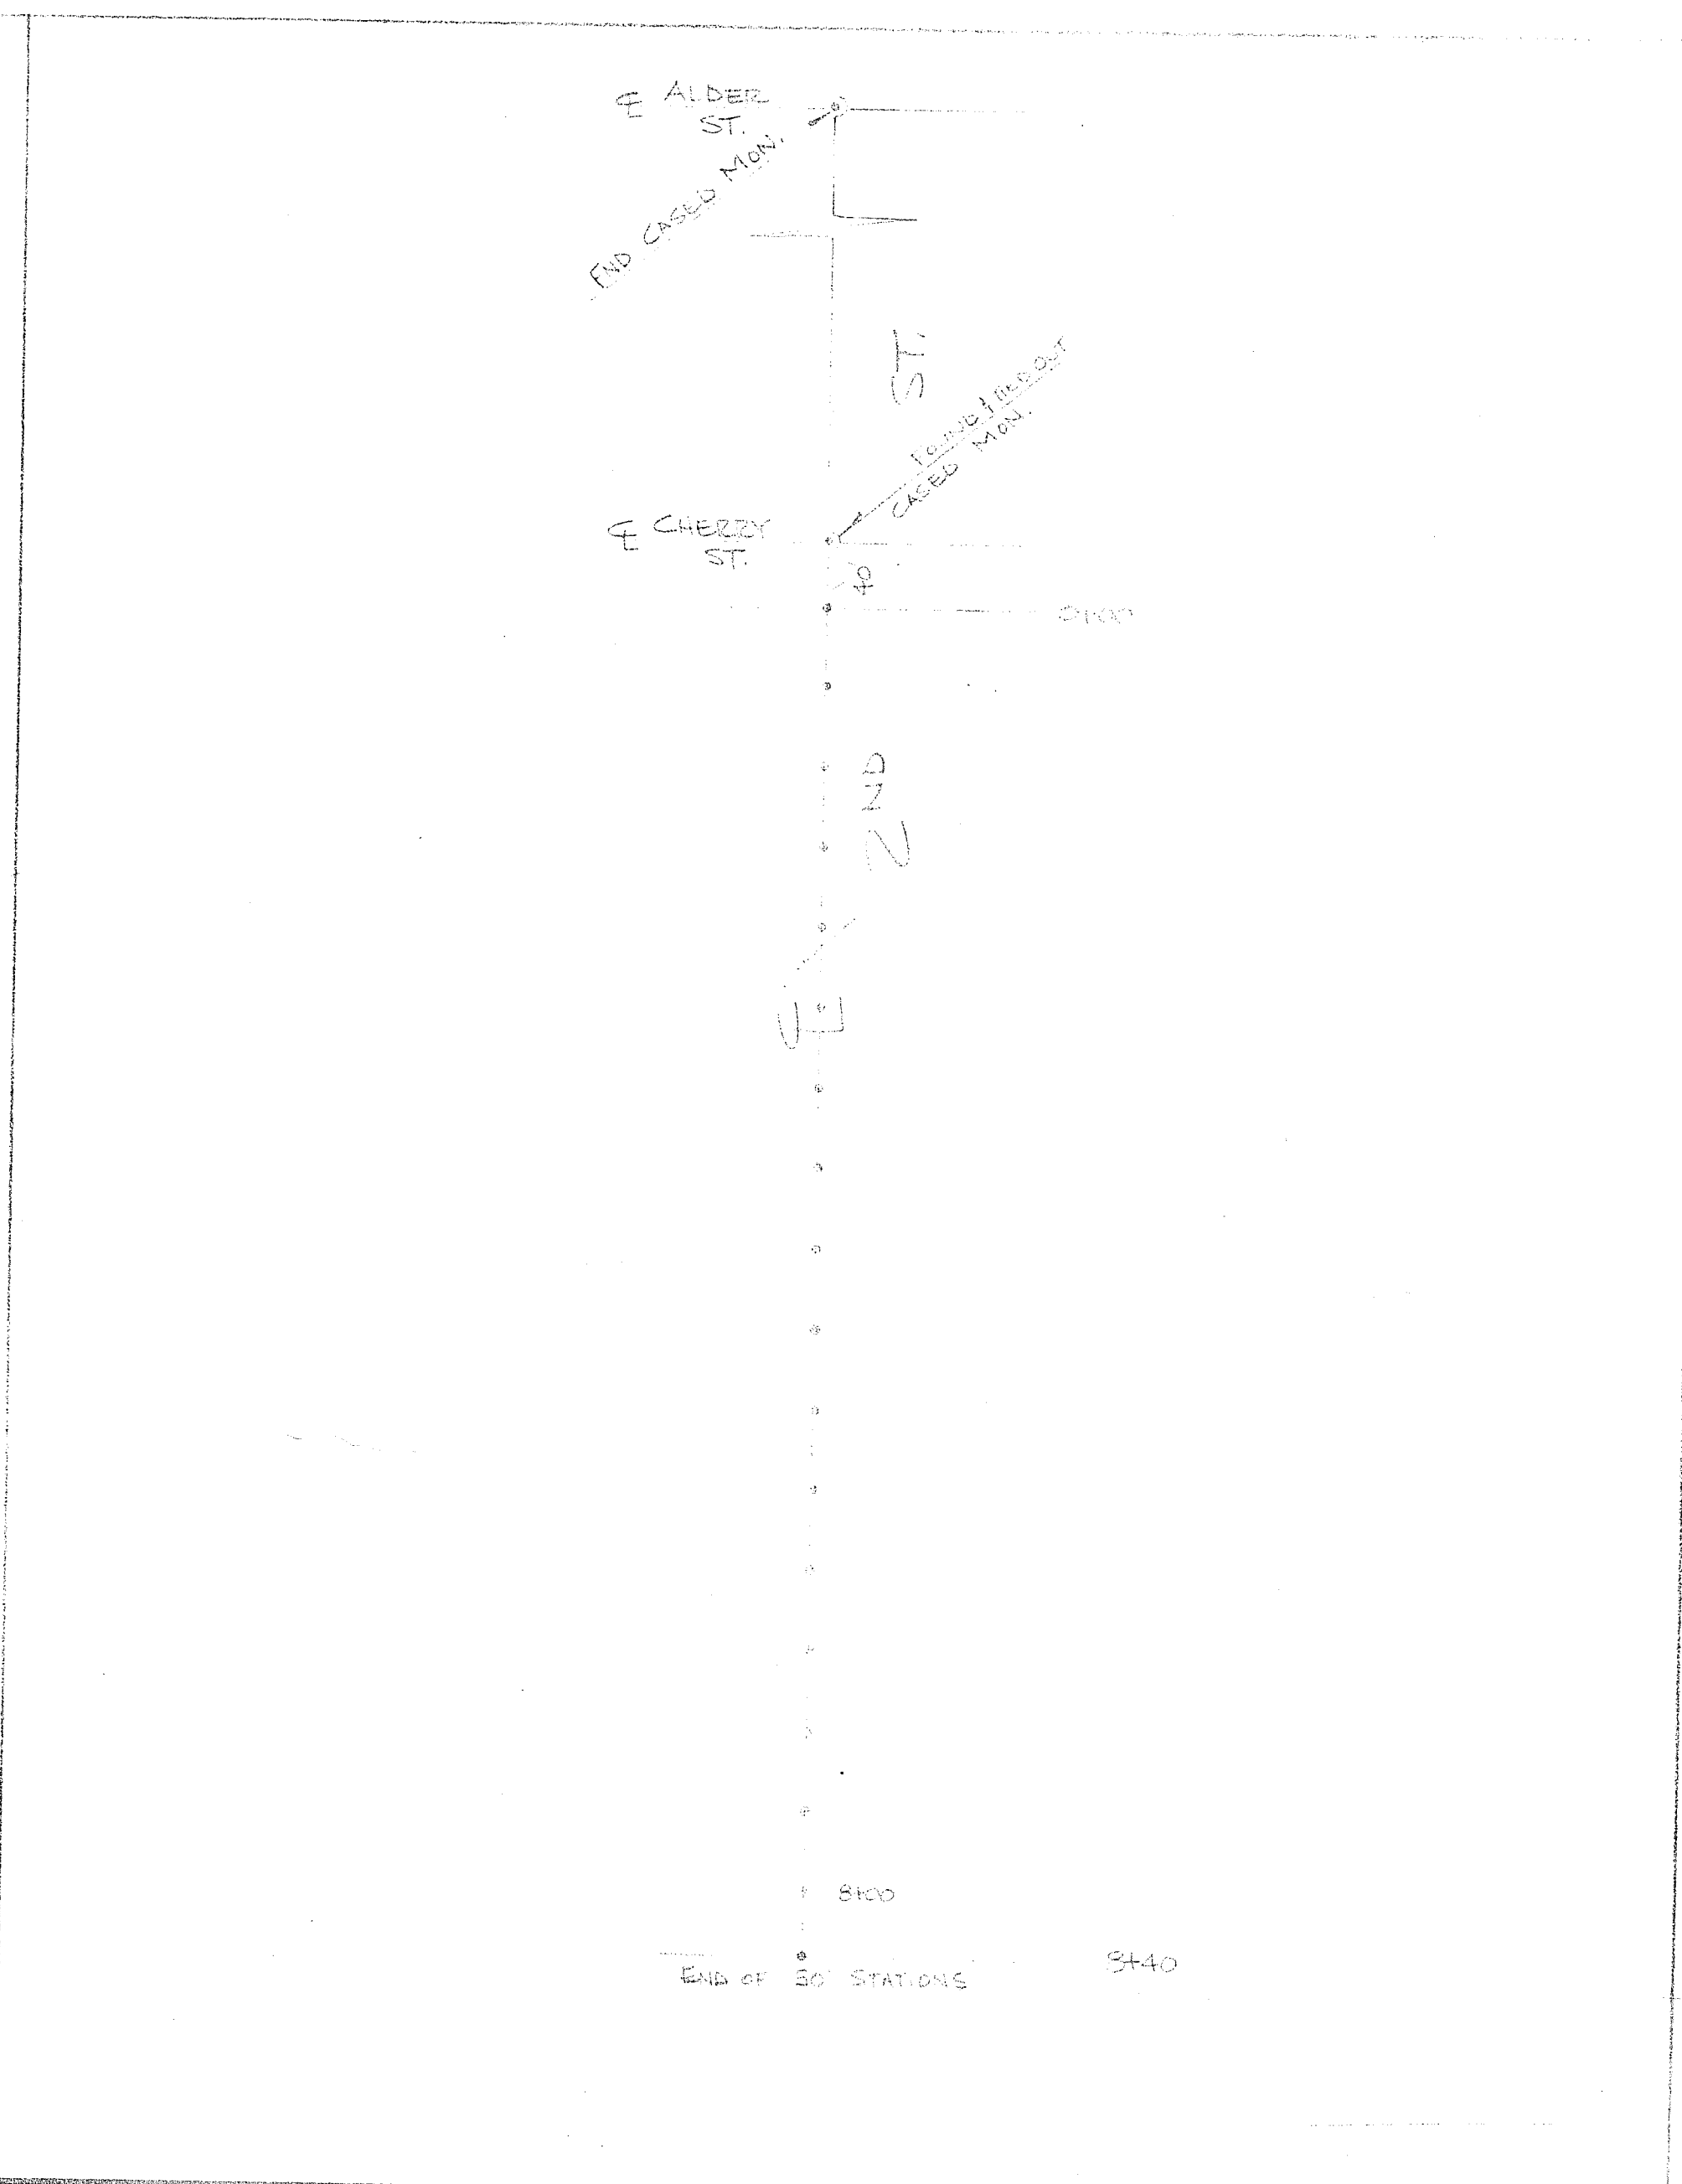
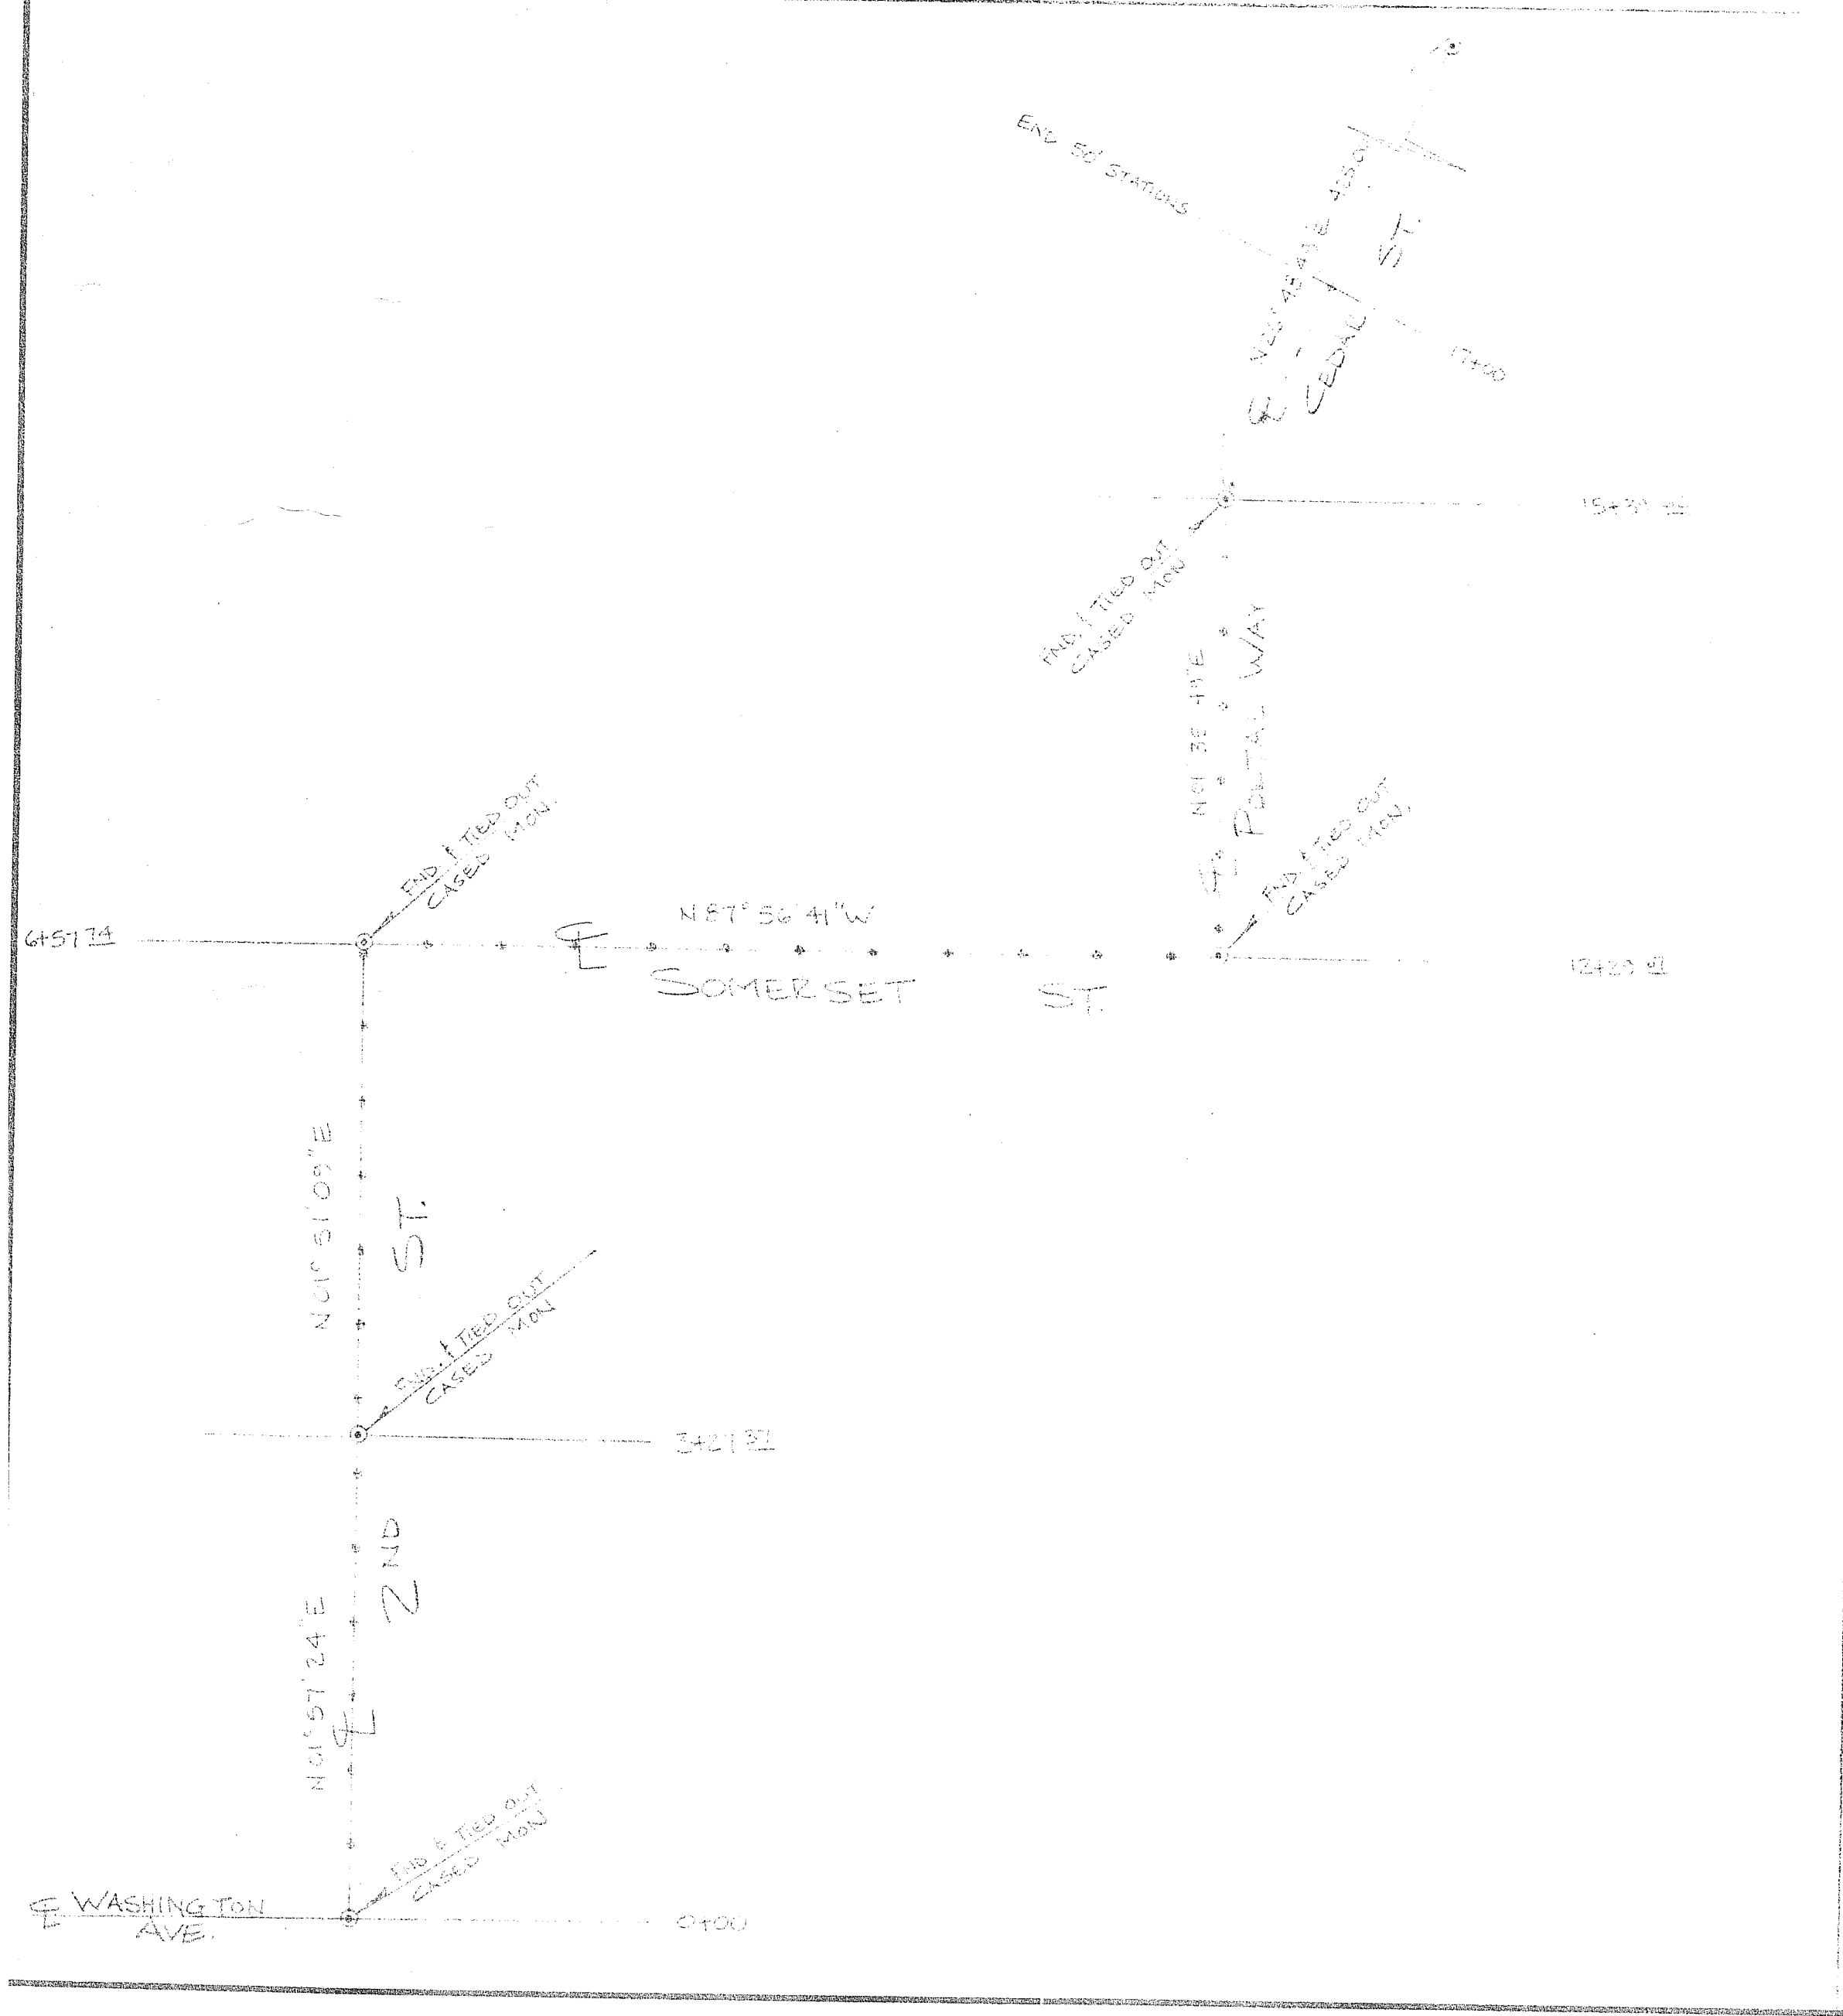


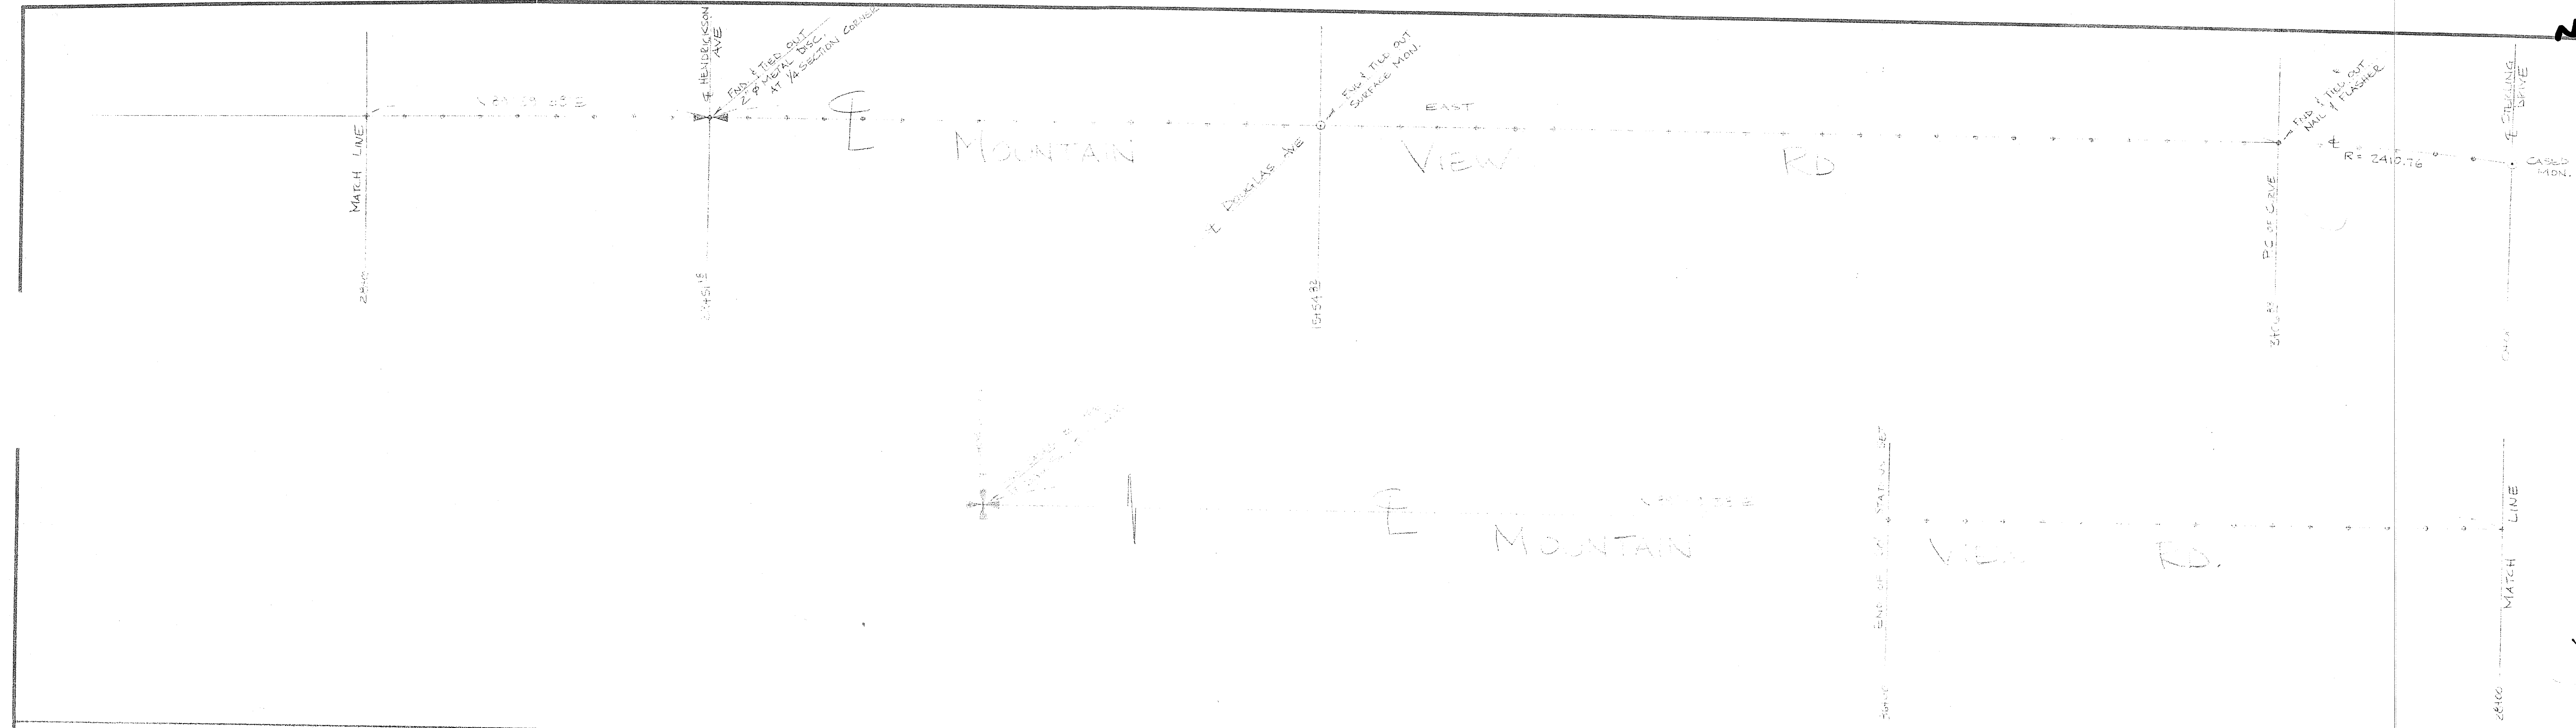

SCALE 1"=100'

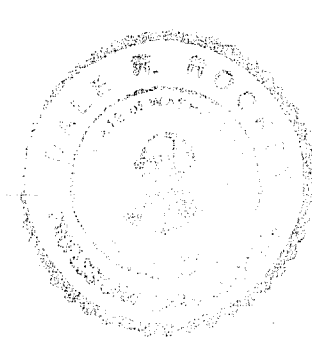

440.001 & 7/3/72






CONSTRUCTION SURVEYORS
N.W. INC.
 1500 I STREET
 BELLINGHAM, WASH. 98225
 206-733-3383
 206-384-0225

CITY OF FERDALE - CENTERLINE STATIONING
 (AT 50' INTERVALS) OF STREETS PROPOSED FOR OVERLAYMENT


SCALE 1"=100'
 DATE 7/3/72
 FIELD BOOK NO. 1
 DRAWN BY J. J.
 SHEET 1 OF 1

SURVEY: CITY OF FERDALE
 - 1ST, 2ND, 3RD, & NORTH ENTRY 1983

23	
24	
25	
26	in dining
27	
28	
29	in dining
30	
31	
32	
33	
34	
35	
36	
37	
38	
39	
40	

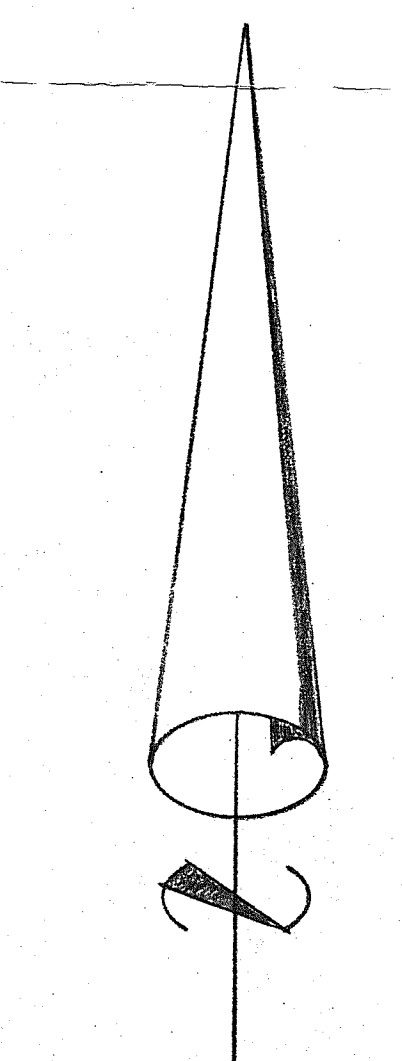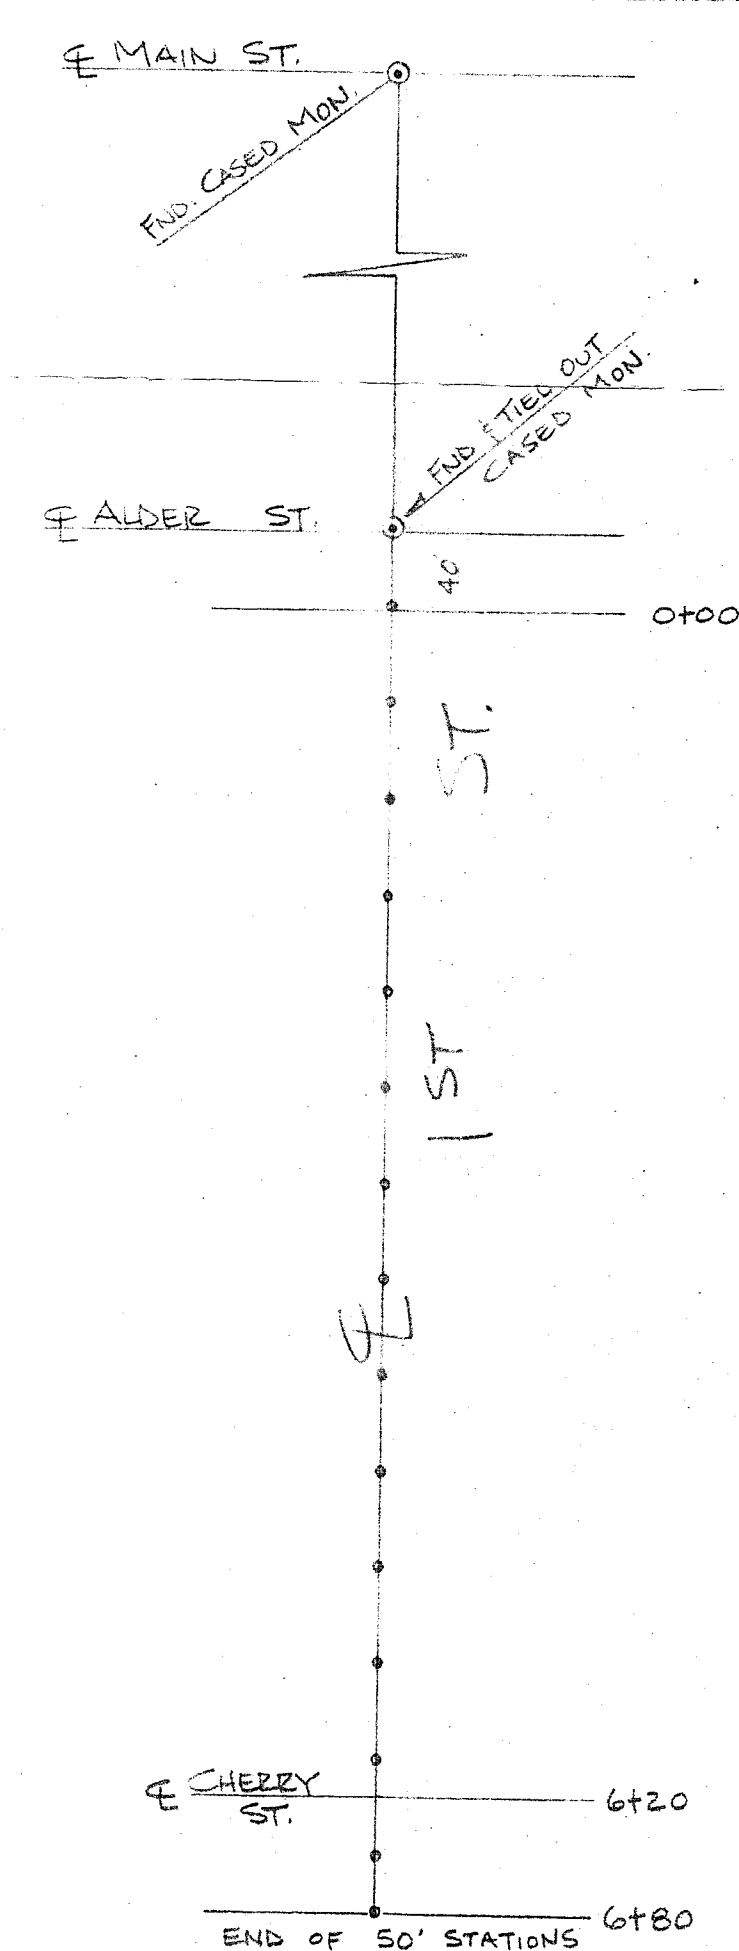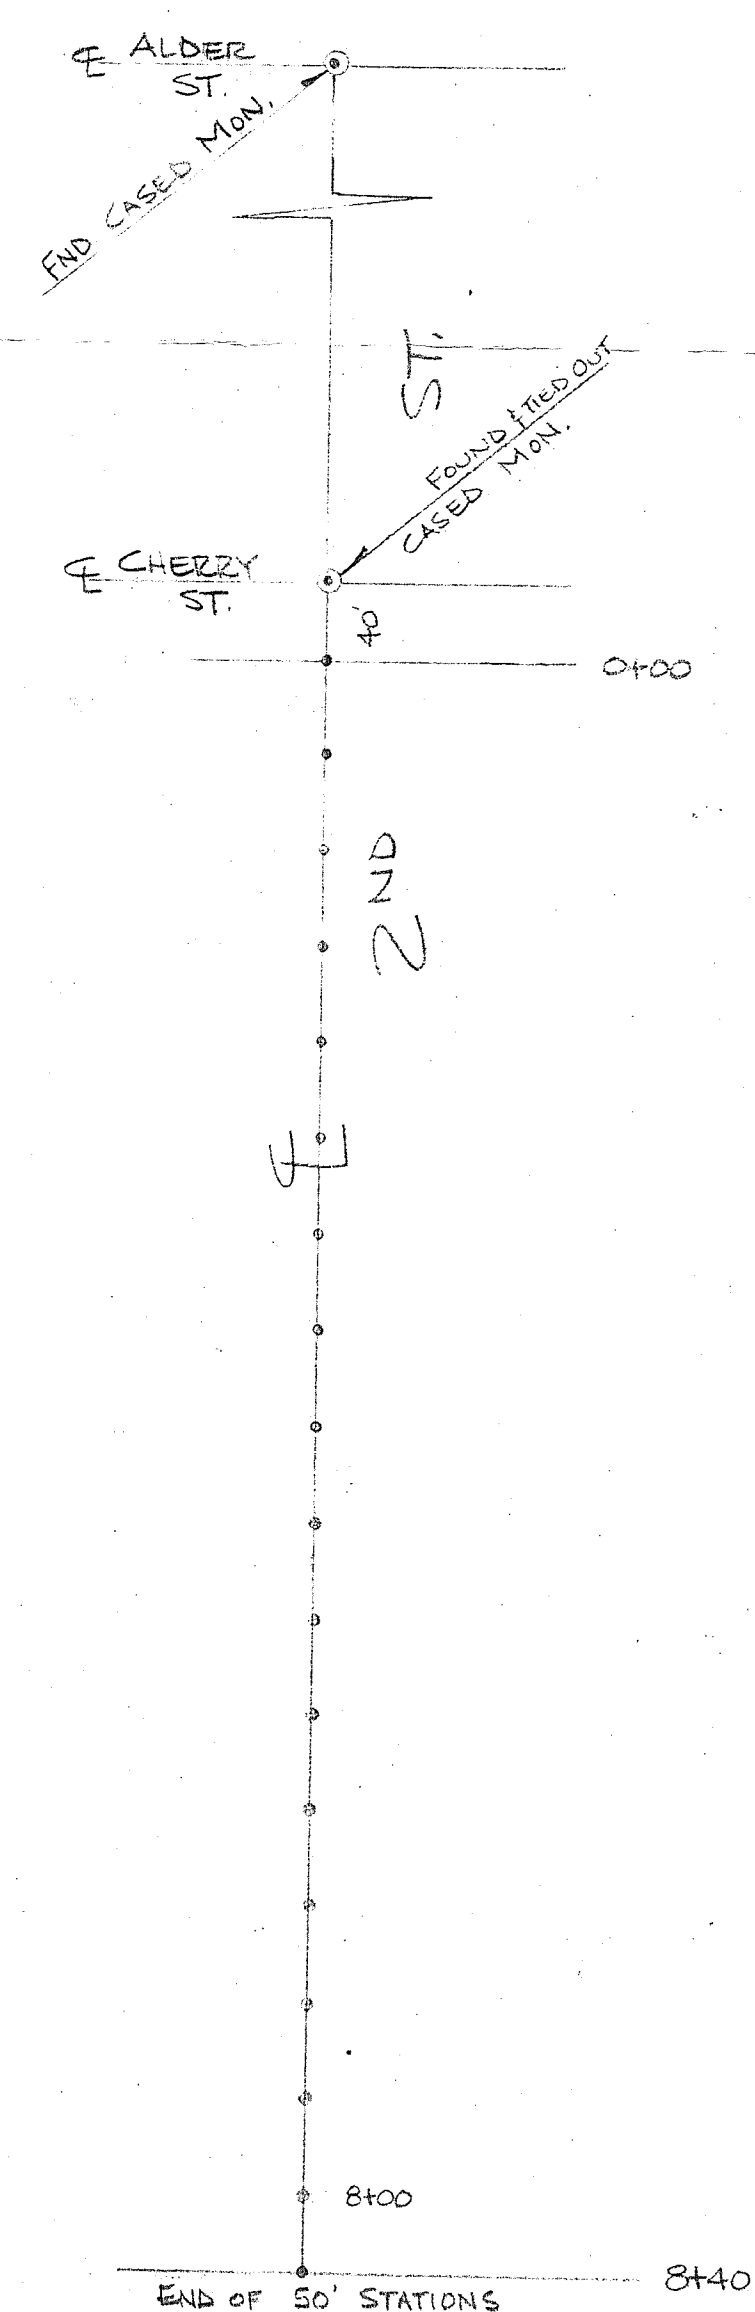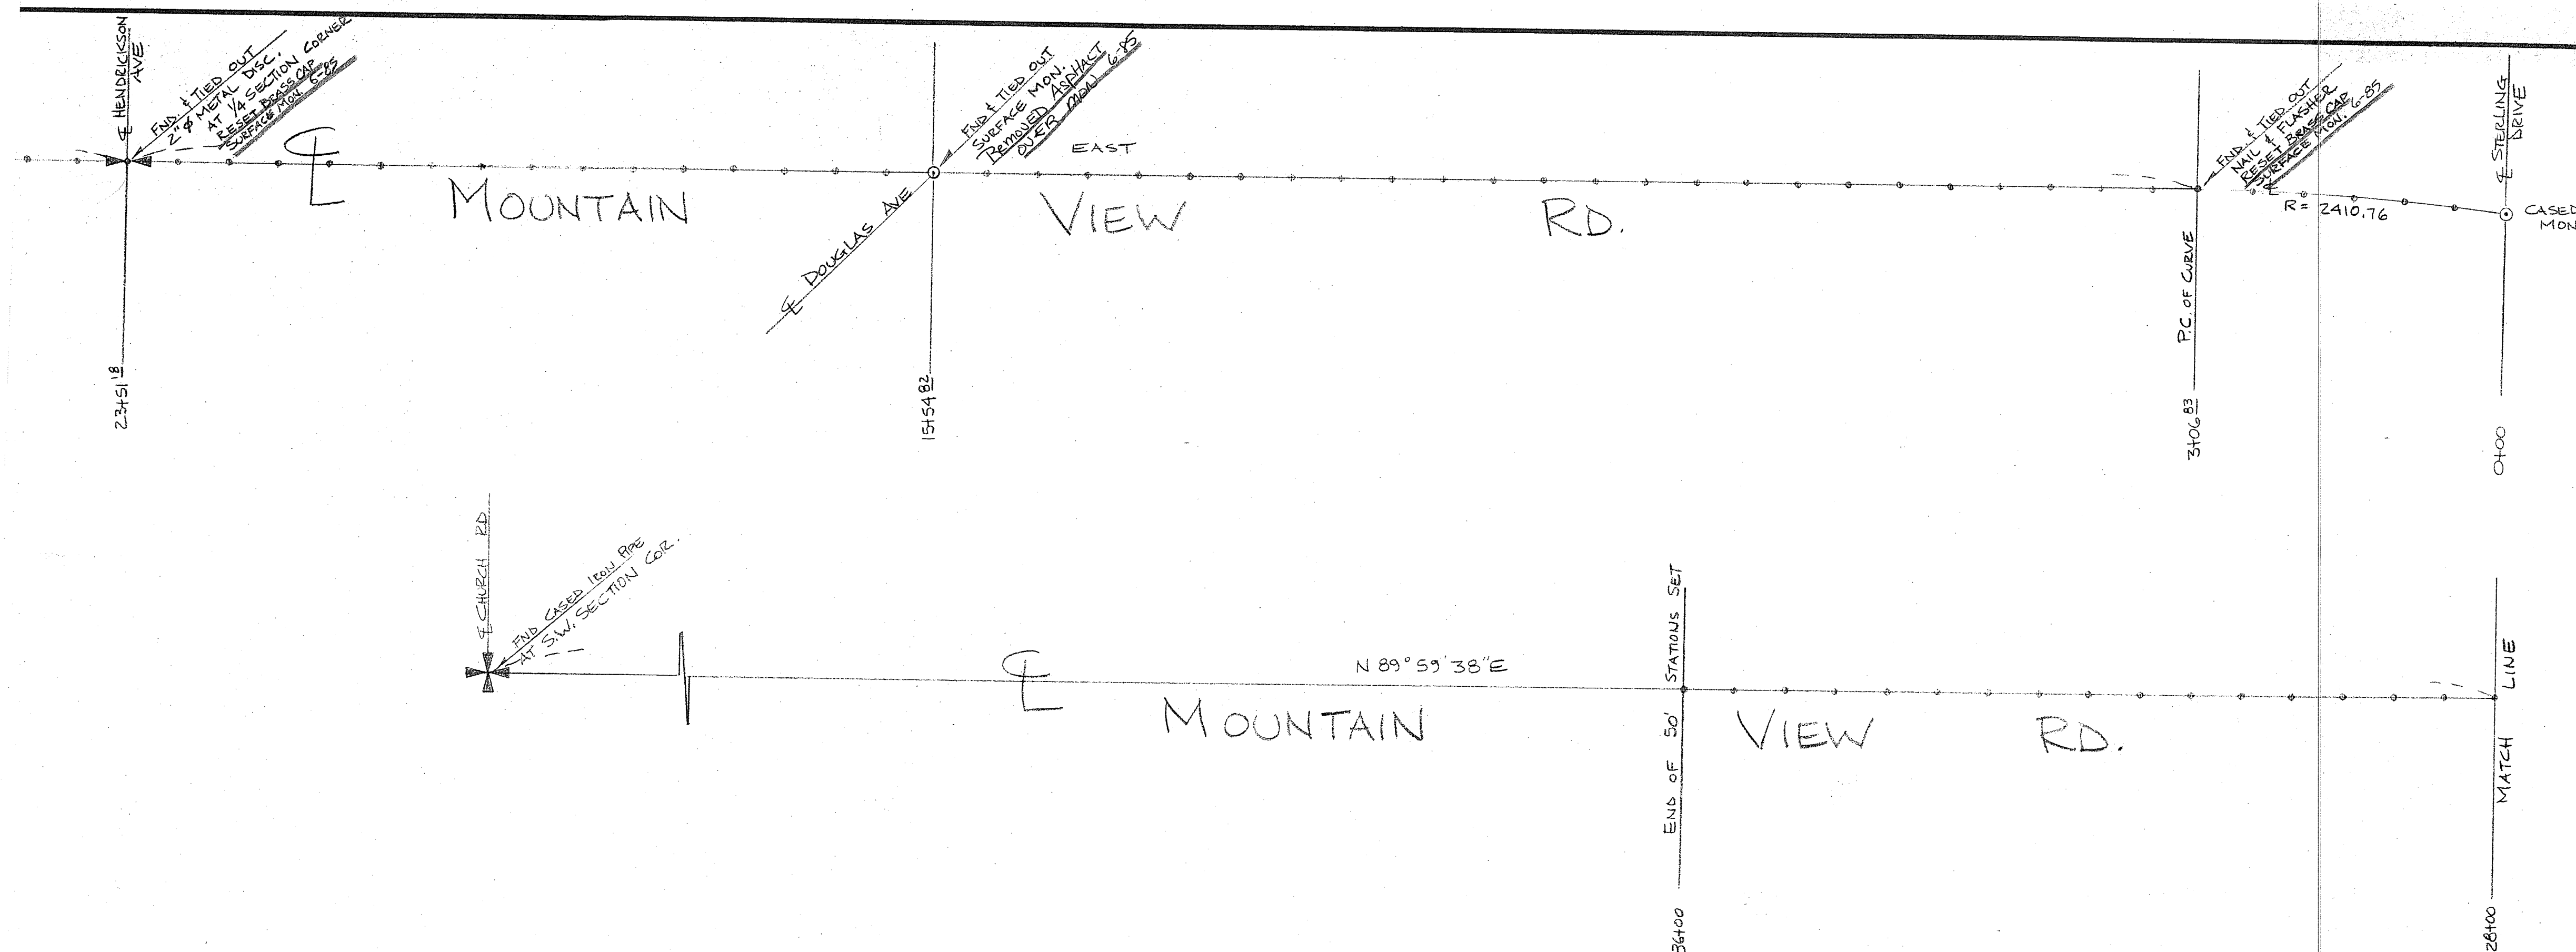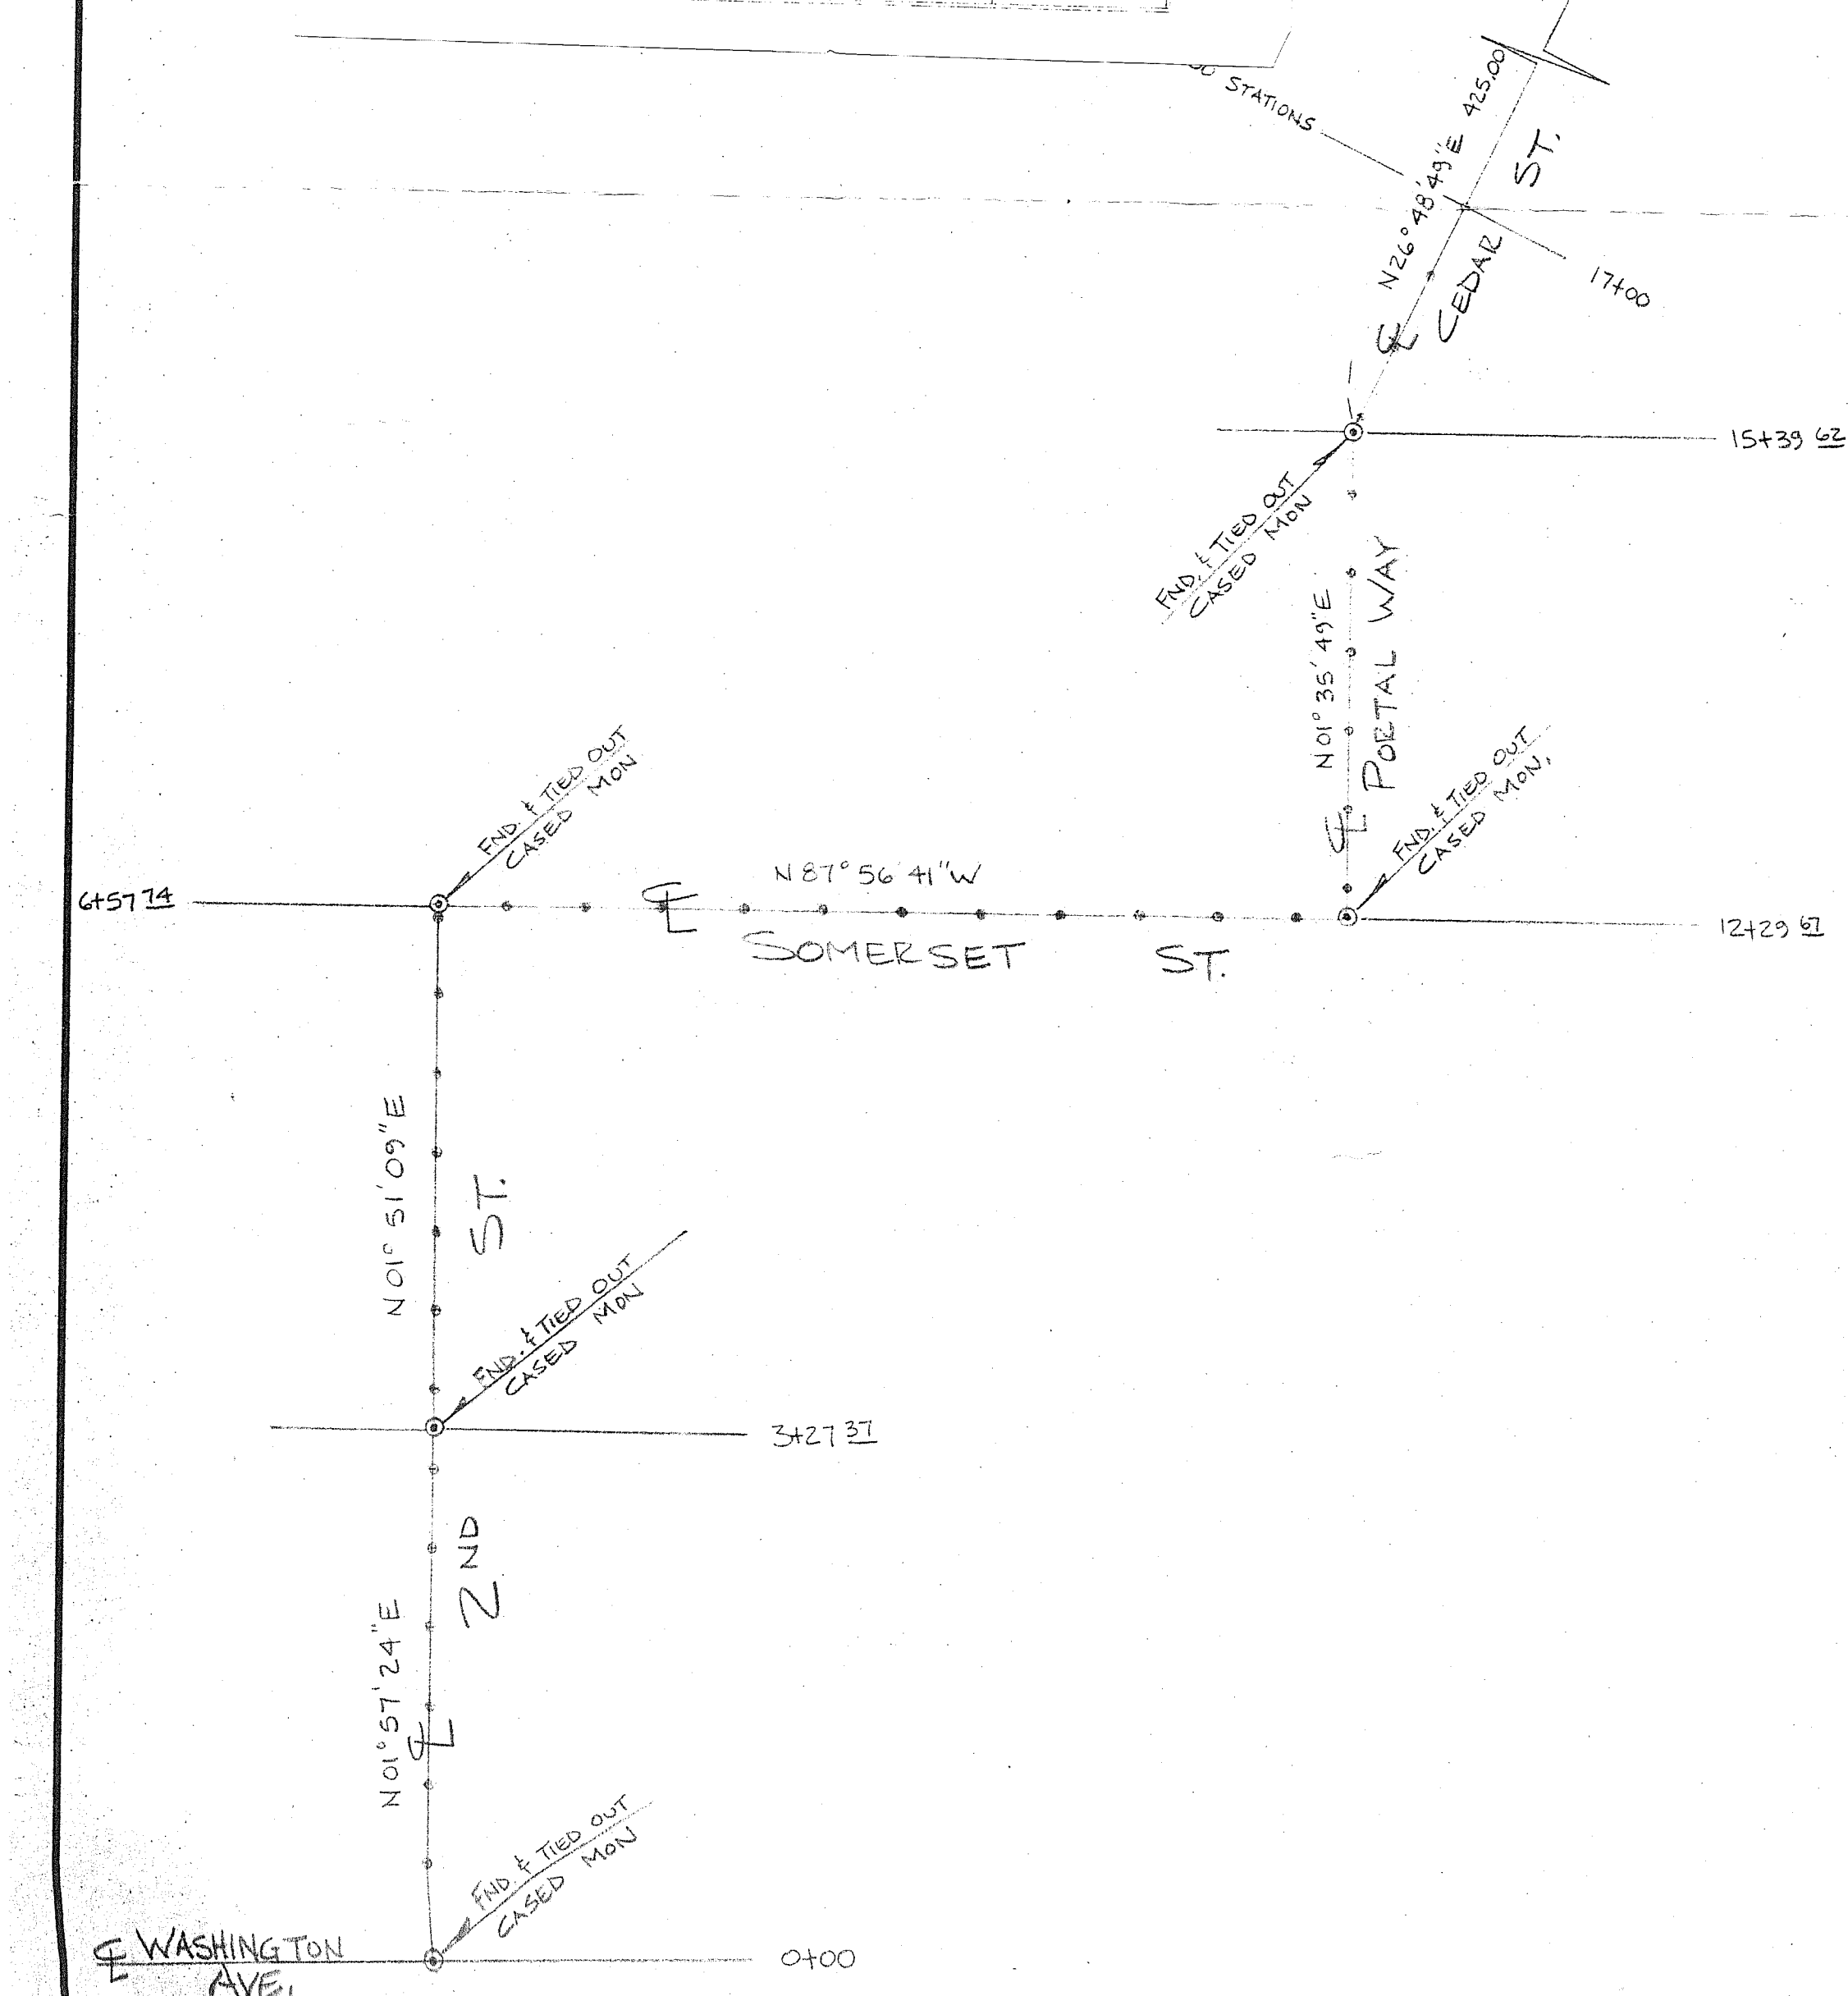

SCALE 1"=100'

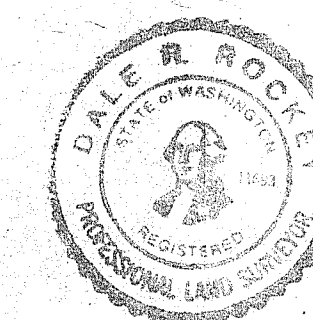

490.002 CC F/3/12

CONSTRUCTION SURVEYORS
N.W. INC.
1500 I STREET
206-733-3383
BELLINGHAM, WASH. 98225
206-384-0225

CITY OF FERDALE - CENTERLINE STATIONING
(AT 50' INTERVALS) OF STREETS PROPOSED FOR OVERLAYMENT

SCALE 1"=100'
DATE 6-14-83
FIELD BOOK 100 PAGE 24
DRAWN BY DNU
SHEET 1 OF 1

JOB NUMBER 837

Survey: Main Street, First, Second and Somerset