


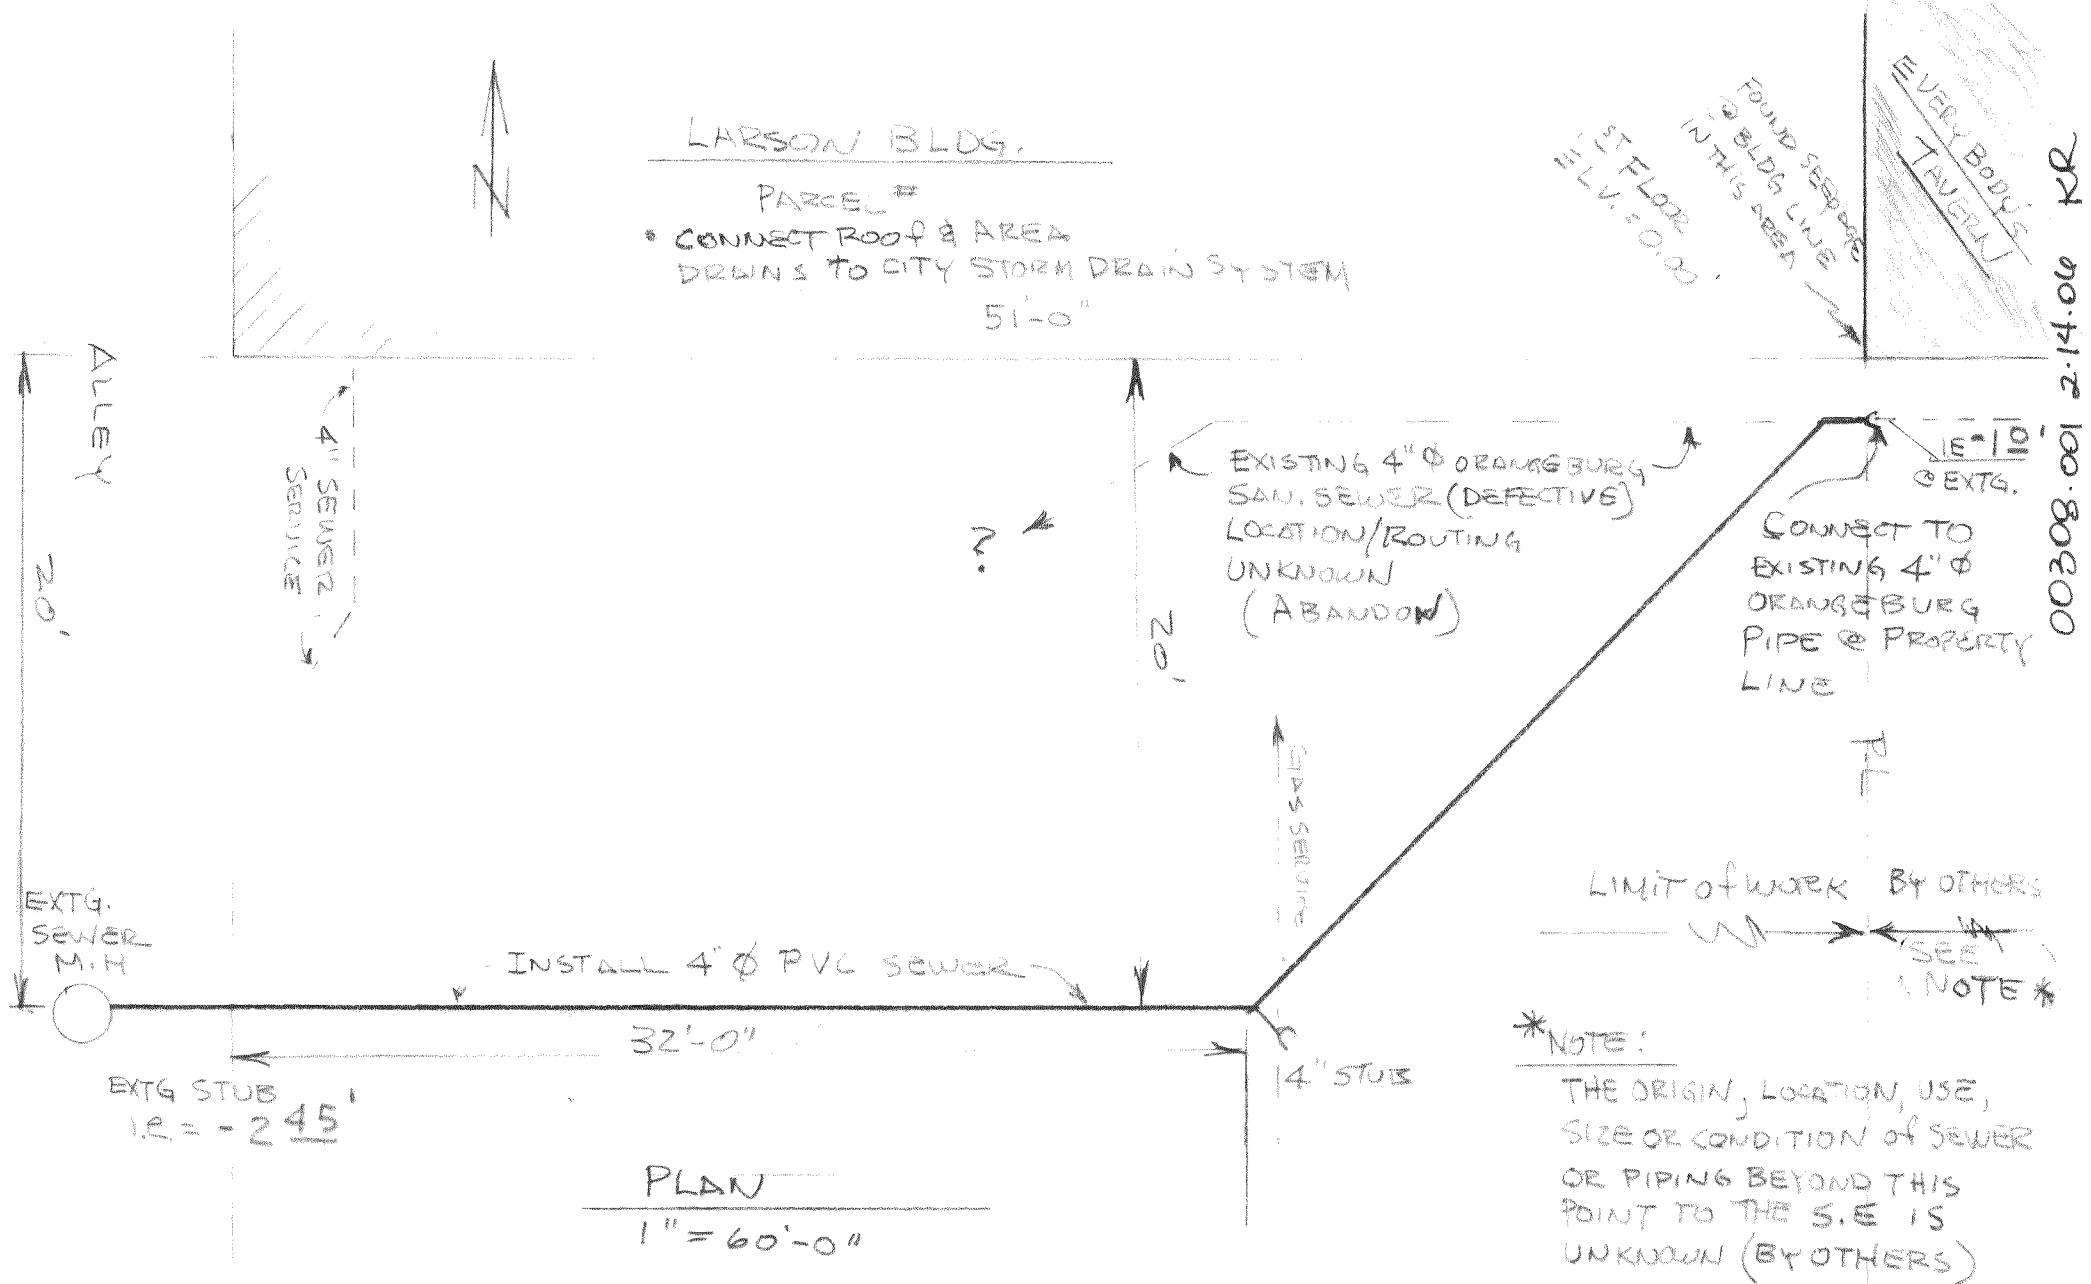

ACKNOWLEDGEMENT / APPROVAL HOWARD BROWNRIGG EVERY BODY'S TAVERN 4/4/00	CITY OF FERNDALE PERMIT # INSPECTED APPROVED C.C.P. <i>[Signature]</i>	4" SAN. SEWER REPLACEMENT 4-4-00	CONTRACTOR FRISBERG CONSTR.	SS-1
---	---	--	-----------------------------------	------

(MAIN STREET)