

10-24-05

LARSON
BAR & GRILL

BROWN RIG


Blw

MAIN ST

22-141 50 SHEETS
22-142 100 SHEETS
22-144 200 SHEETS



00329.001 9.13.06 KR

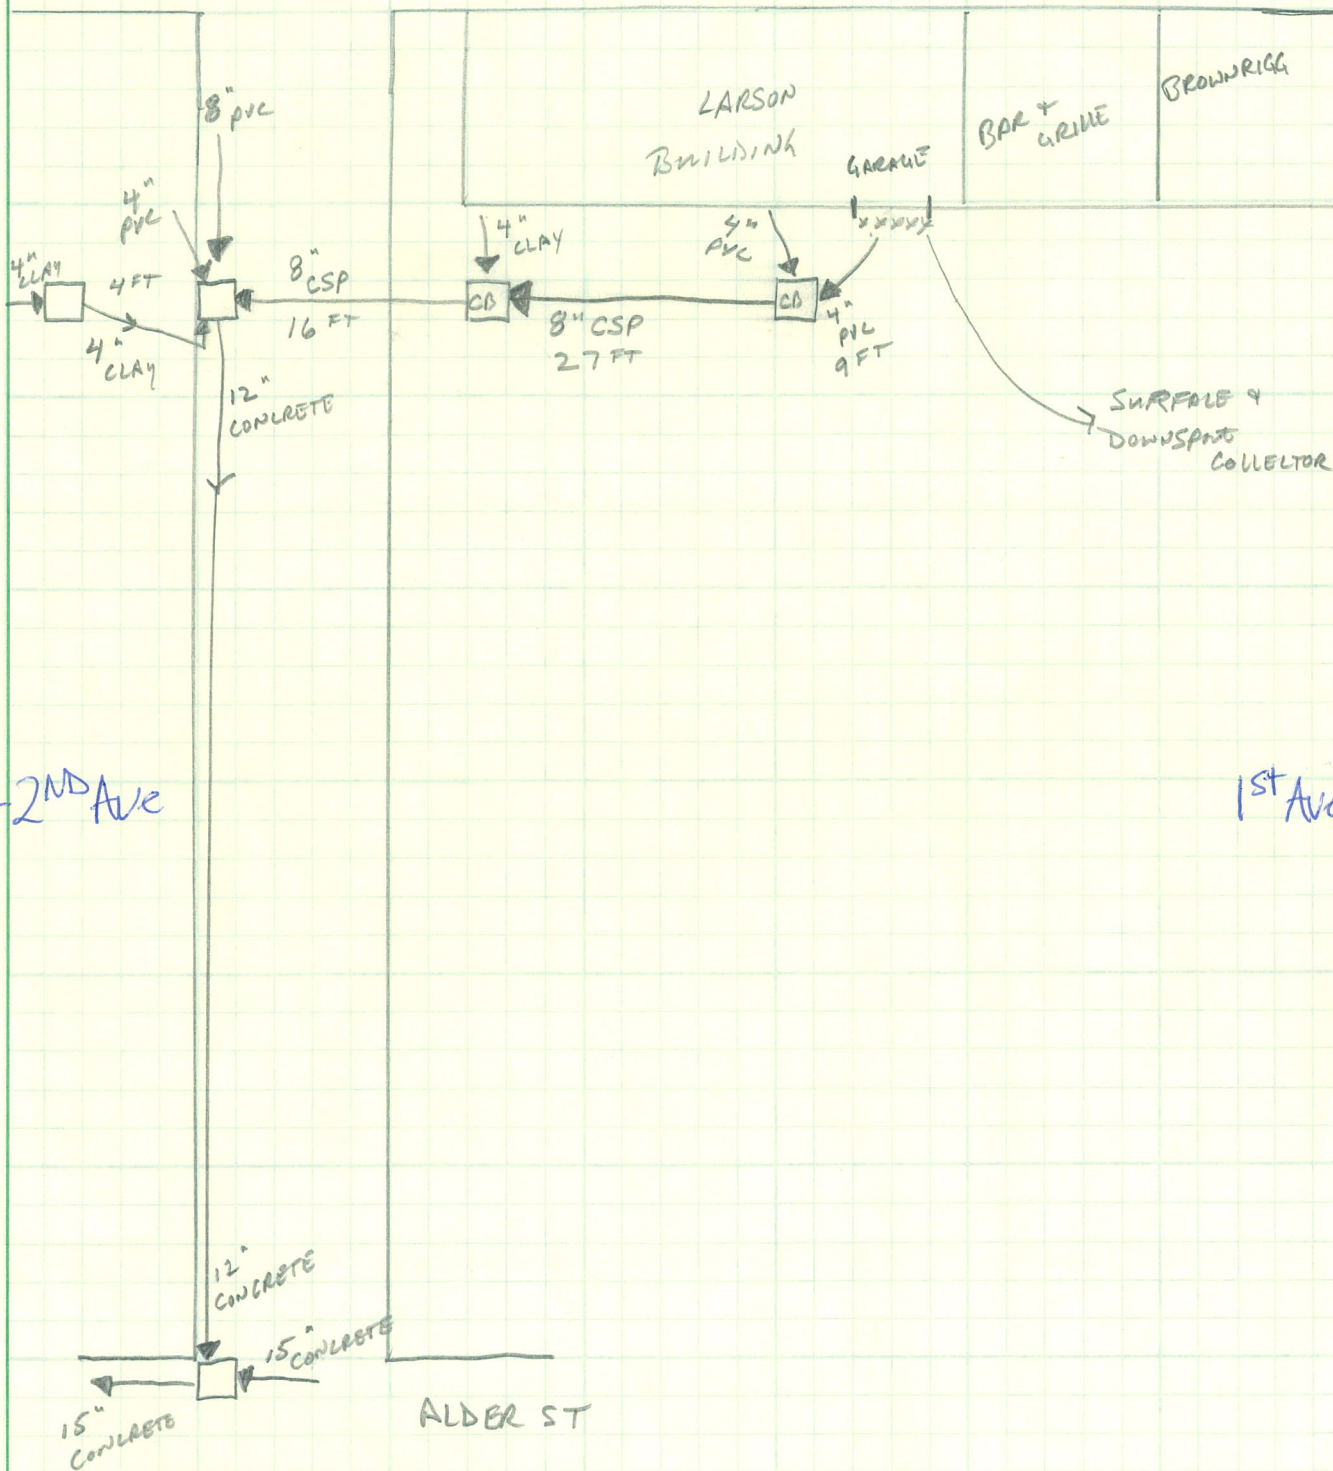

← 2ND Ave

1ST Ave →

12\"/>

ALDER ST

"15-BUILT"
ALLEY BETWEEN
ALDER & MAIN

NORTH ↑