


original

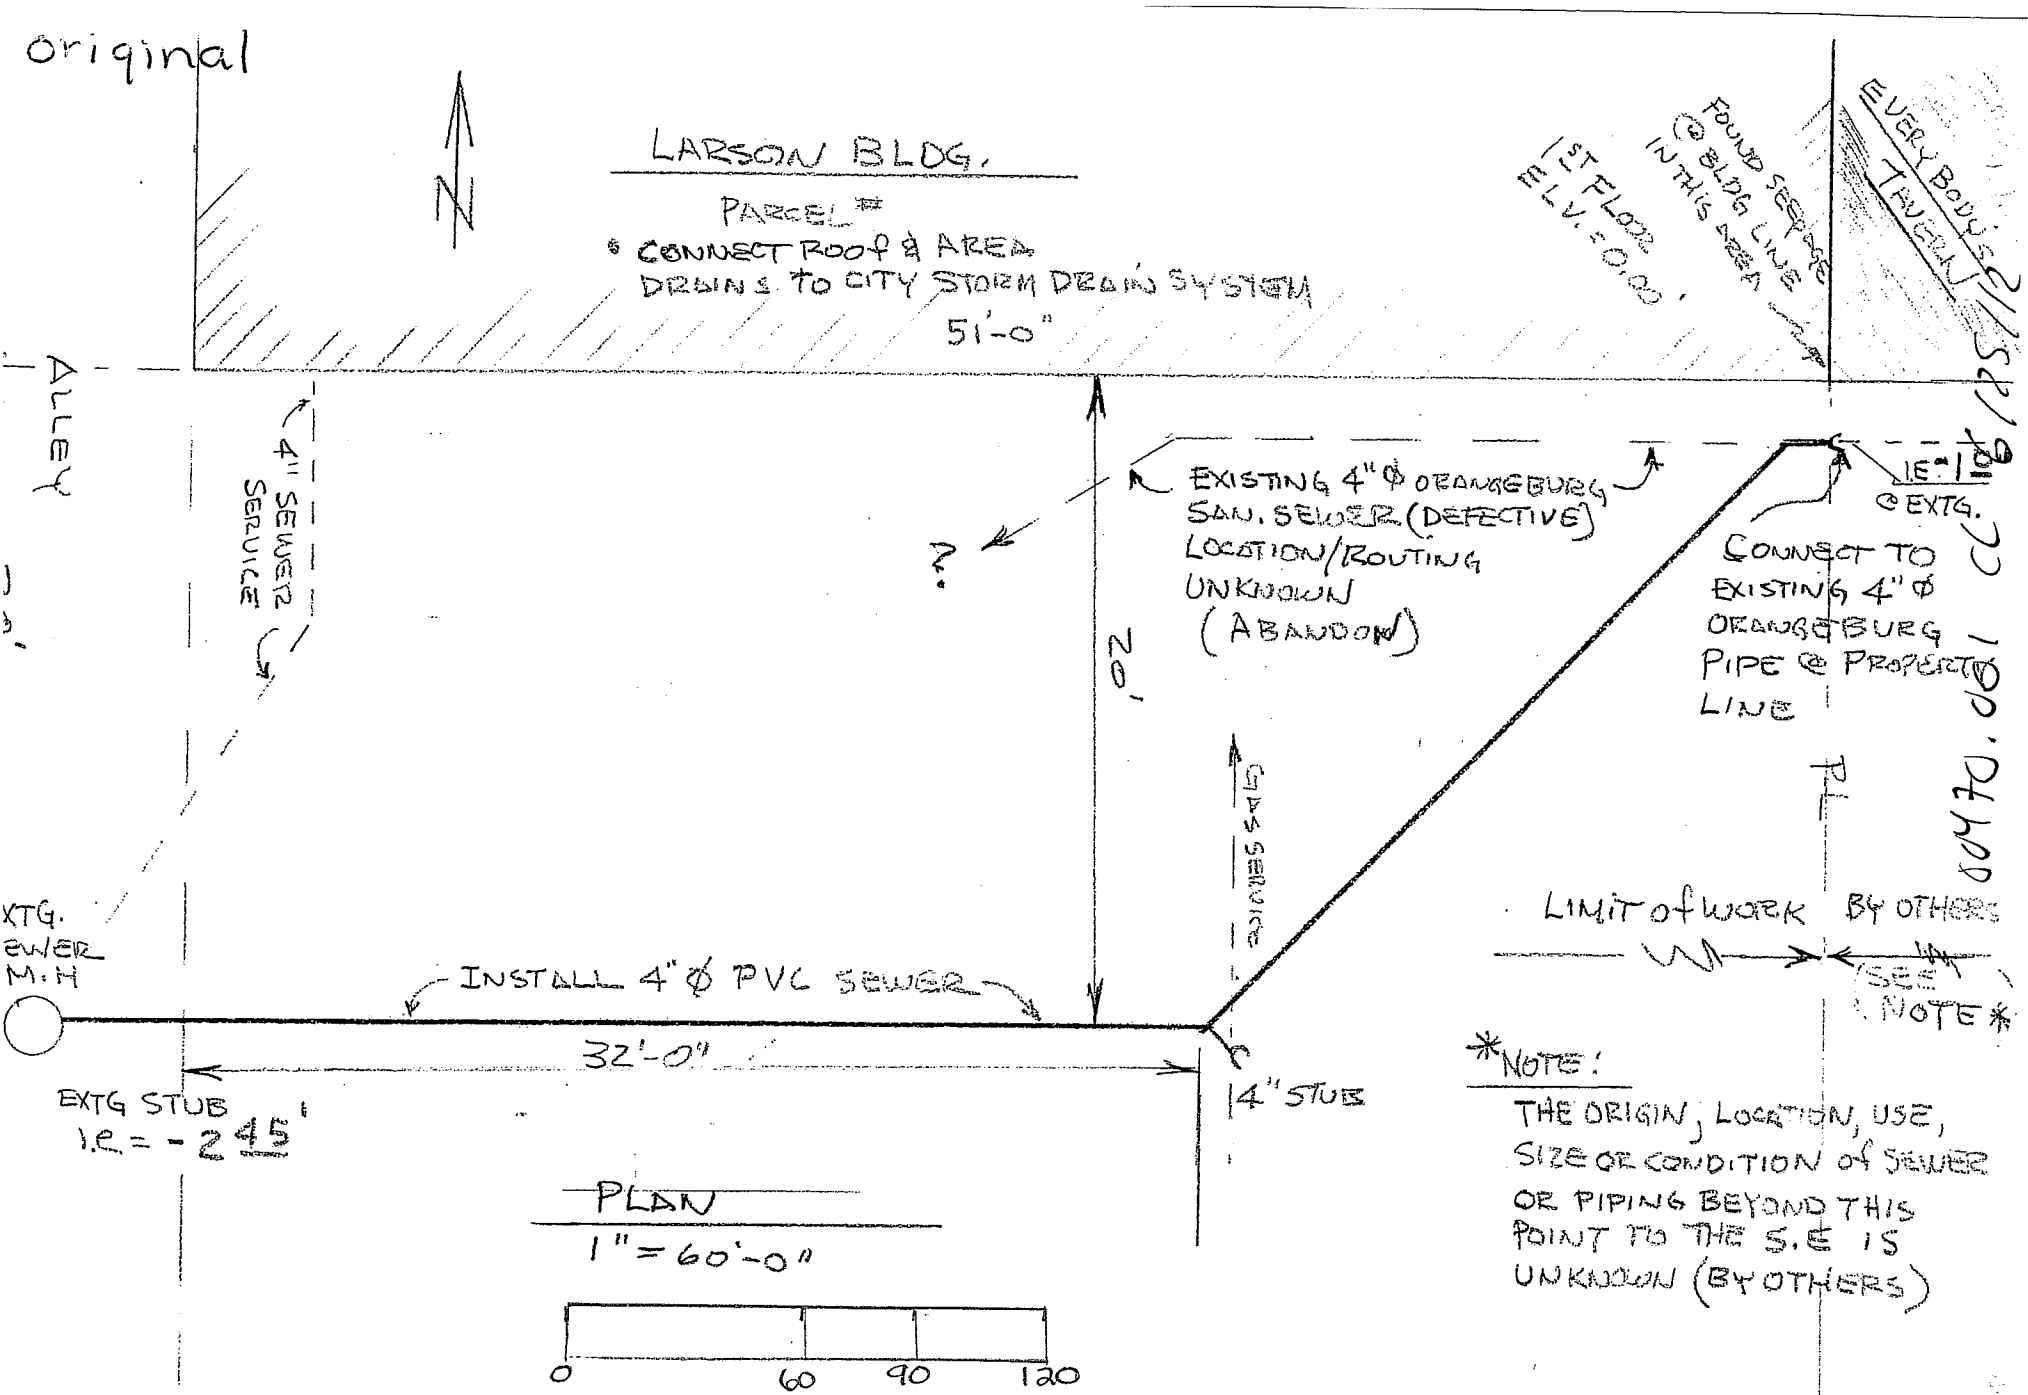


|                                                                   |                                                       |                                        |                                  |      |
|-------------------------------------------------------------------|-------------------------------------------------------|----------------------------------------|----------------------------------|------|
| KNOWLEDGEMENT / APPROVAL<br>OWNED BROWNING<br>EVERY BODY'S TAVERN | CITY OF FERNDALE<br>PERMIT #<br>INSPECTED<br>APPROVED | 4" SAN. SEWER<br>REPLACEMENT<br>4-4-00 | CONTRACTOR:<br>FEIBER<br>CONSTR. | SS-1 |
|                                                                   |                                                       |                                        |                                  |      |

LARSON BUILDING SEWER - MAINTENANCE


LARSON BUILDING SEWER  
MAIN STREET

14

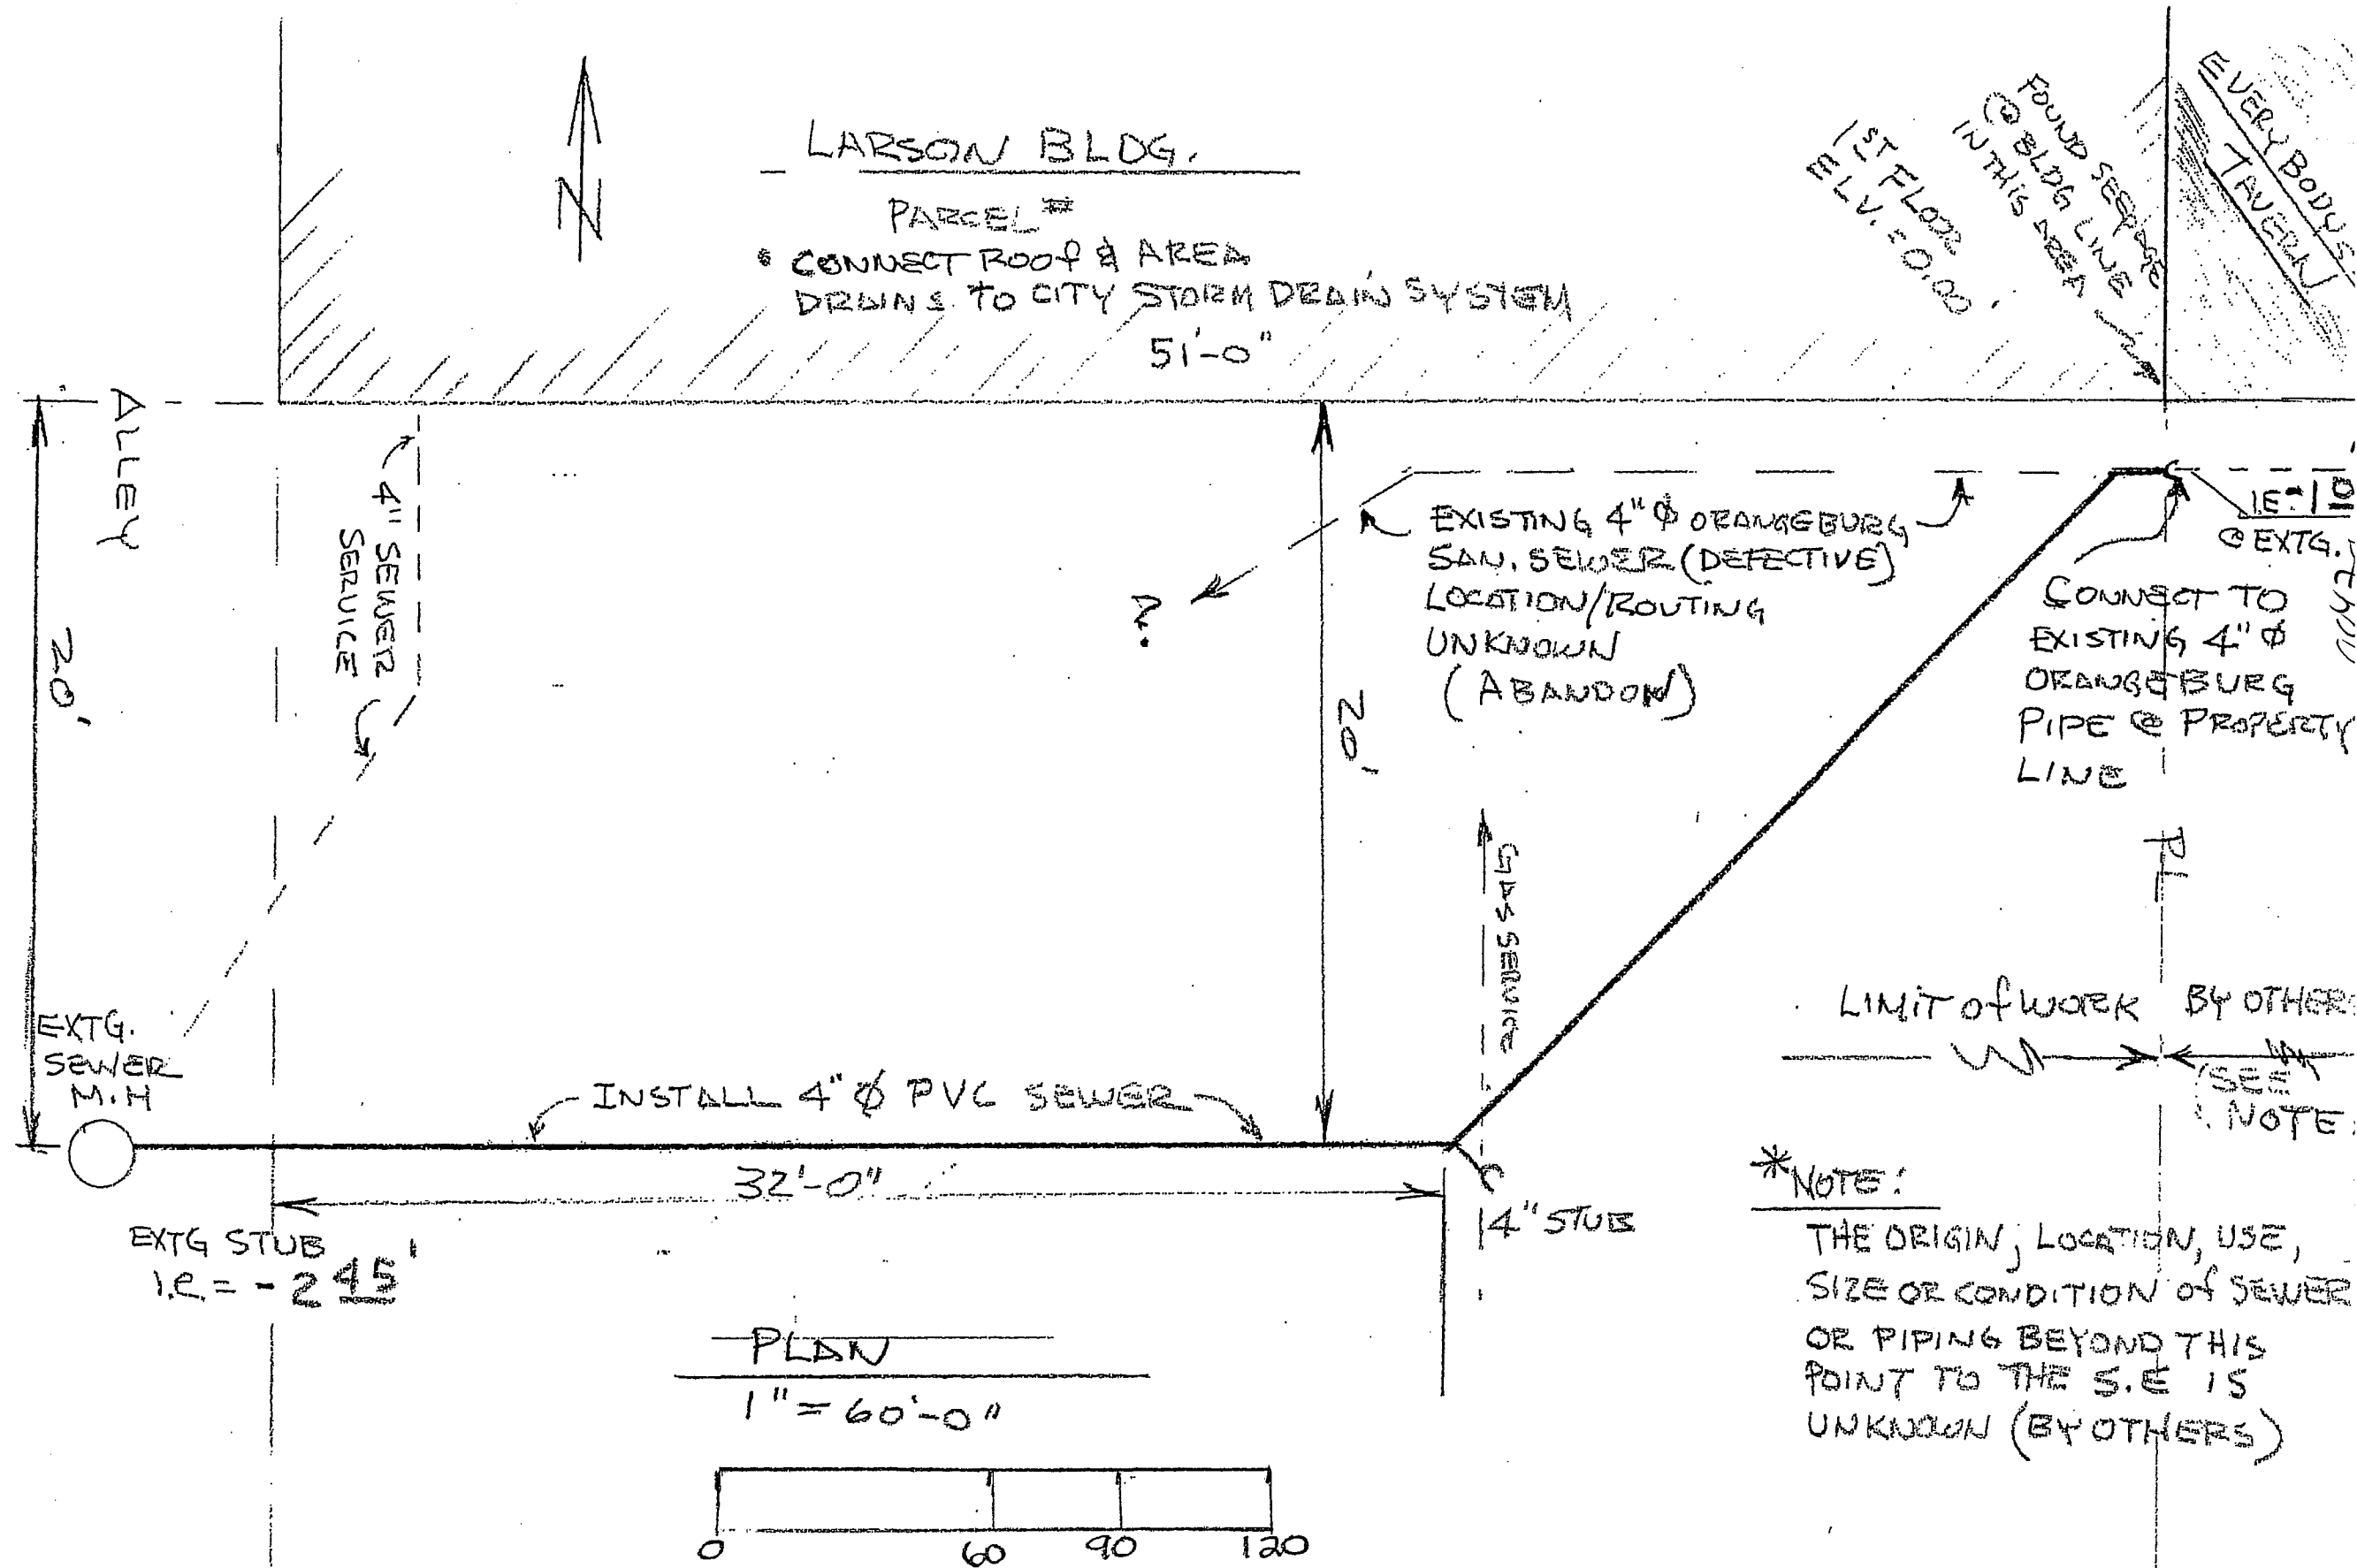

|                                                                                                             |                                                                                           |                                        |                                     |      |
|-------------------------------------------------------------------------------------------------------------|-------------------------------------------------------------------------------------------|----------------------------------------|-------------------------------------|------|
| <u>ACKNOWLEDGEMENT / APPROVAL</u><br>HOWARD BROWNING<br>EVERY BODY'S TAVERN<br><i>[Signature]</i><br>4/4/00 | <u>CITY OF FERNDALE</u><br>PERMIT #<br>INSPECTED<br>APPROVED<br>CCP<br><i>[Signature]</i> | 4" SAN. SEWER<br>REPLACEMENT<br>4-4-00 | CONTRACTOR:<br>FRIEDRICH<br>CONSTR. | SS-1 |
|-------------------------------------------------------------------------------------------------------------|-------------------------------------------------------------------------------------------|----------------------------------------|-------------------------------------|------|

LARSON BUILDING SEWER - MAIN STREET

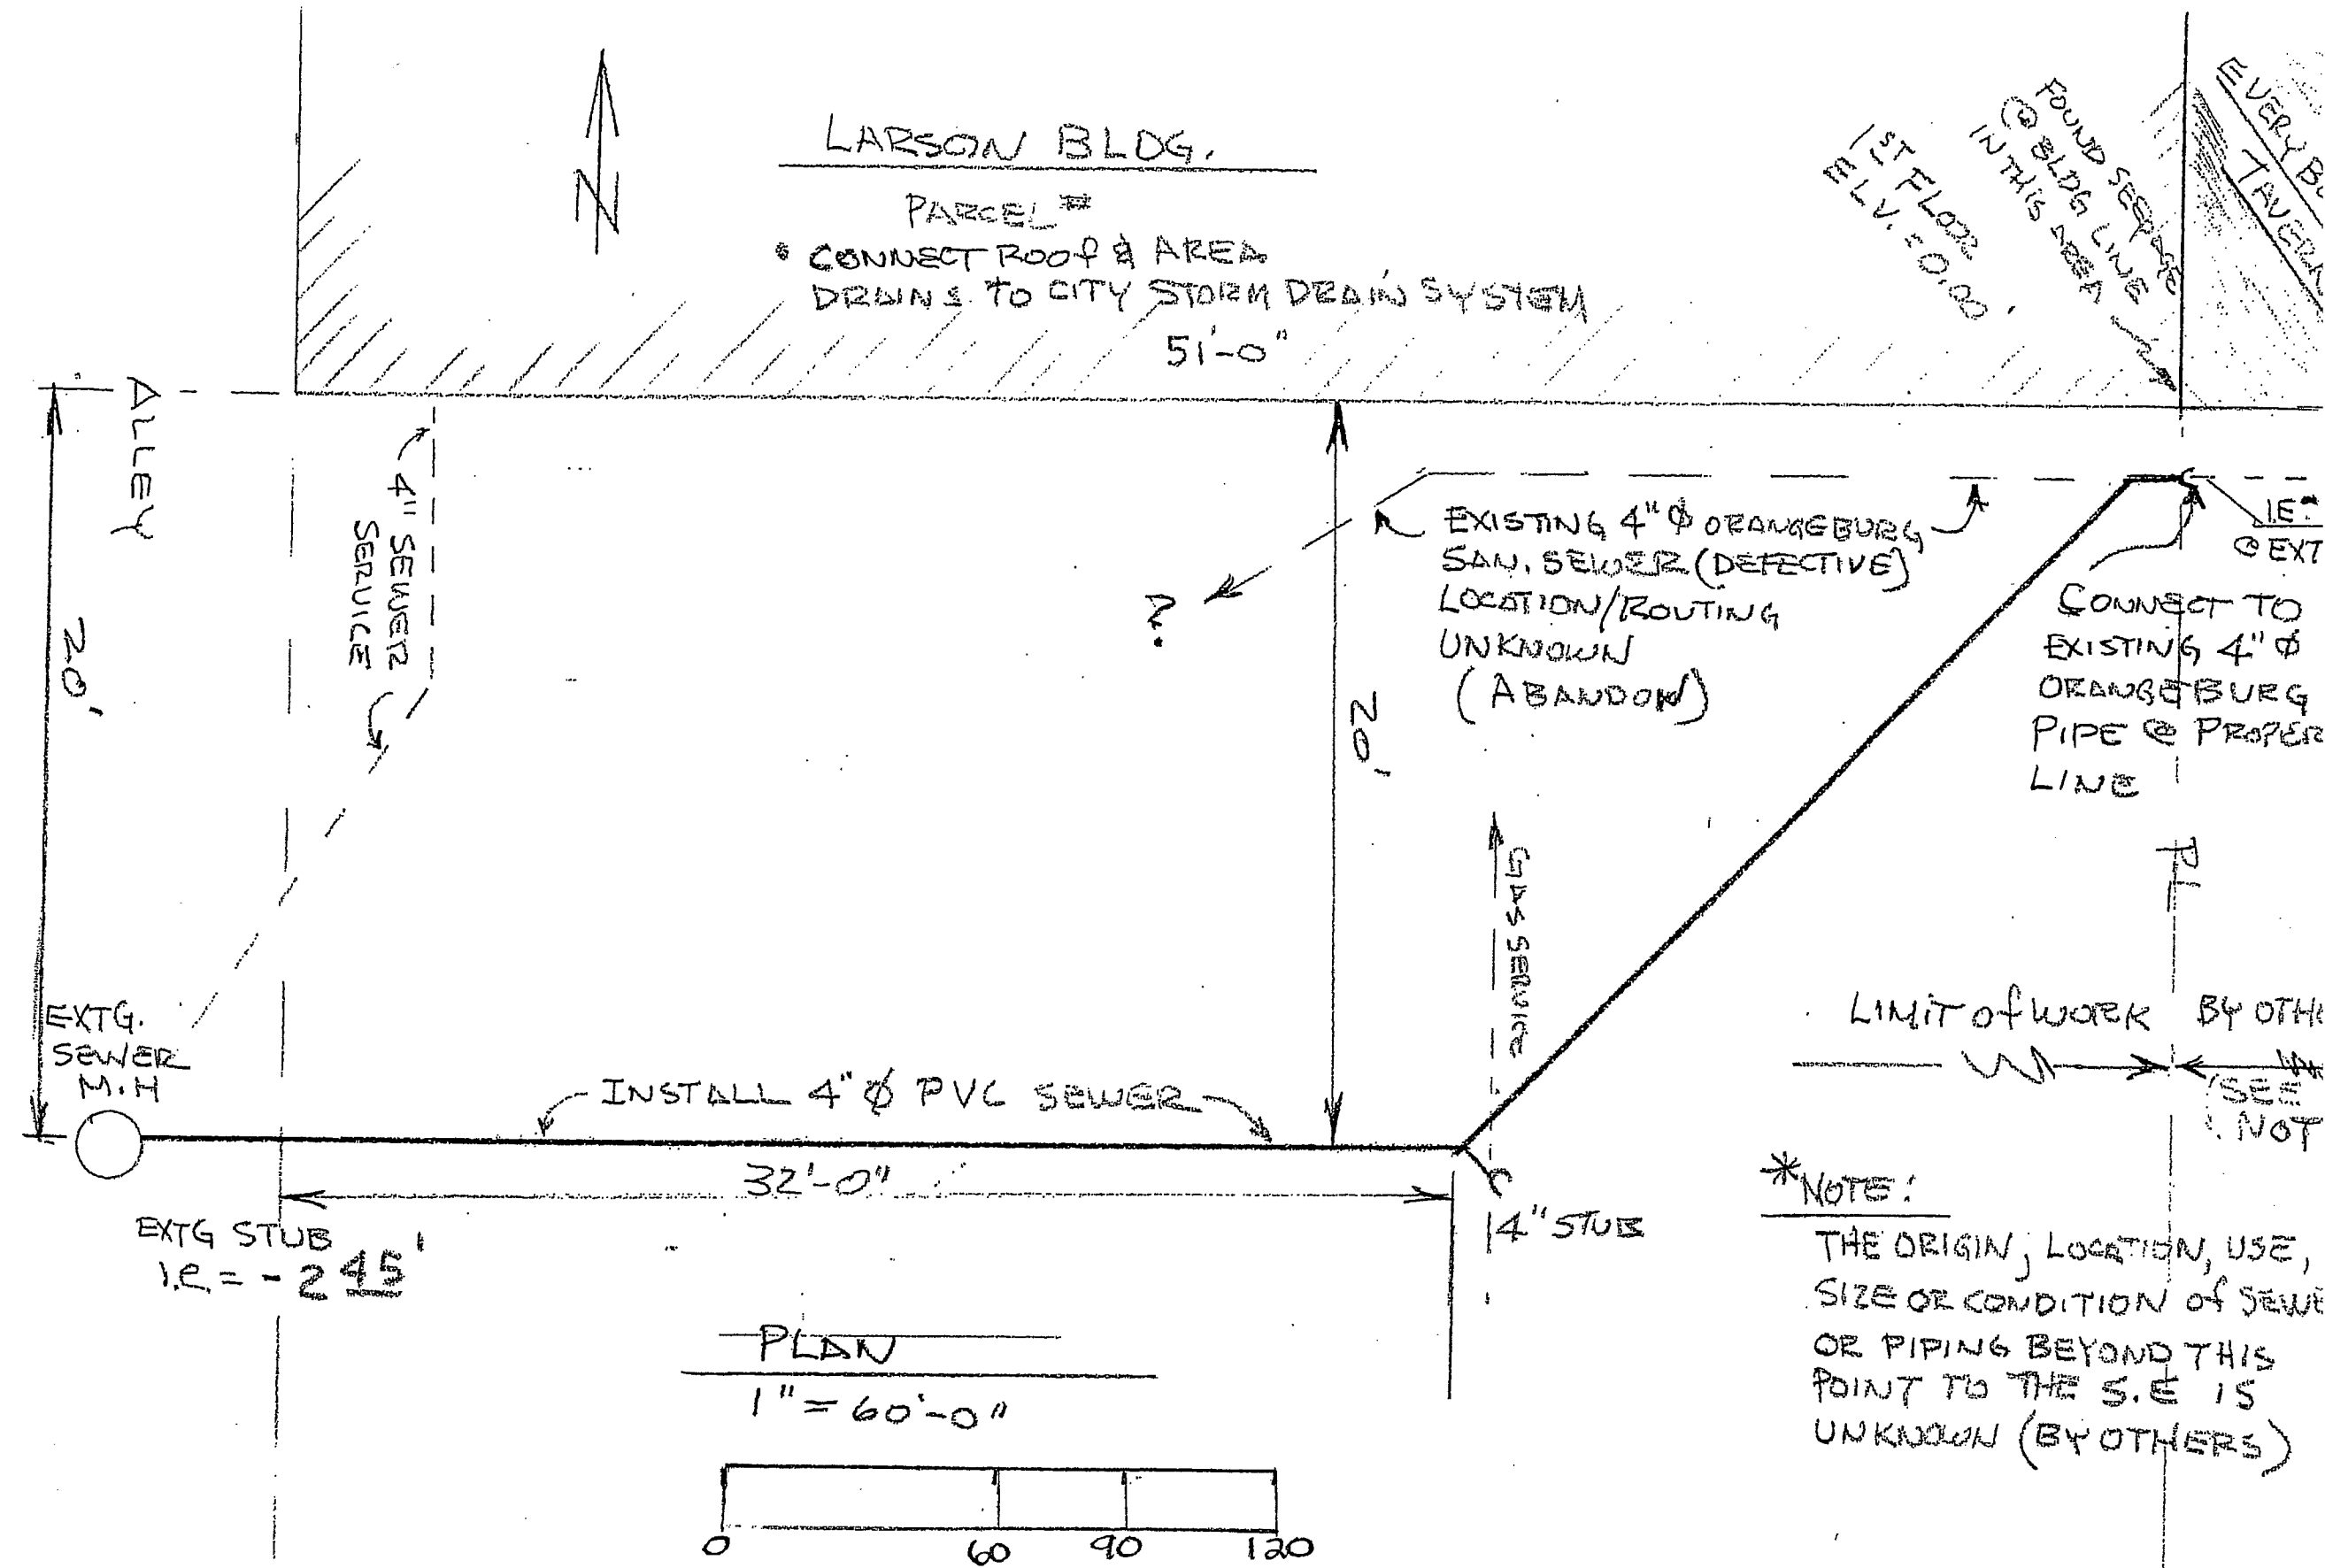

|                            |                  |                           |             |
|----------------------------|------------------|---------------------------|-------------|
| ACKNOWLEDGEMENT / APPROVAL | CITY OF FERNDALE | 4" SAN. SEWER REPLACEMENT | CONTRACTOR: |
| HOWARD BROWNING            | PERMIT #         |                           | FEIBER      |
| EVERY BODY'S TAVERN        | INSPECTED        |                           | CONSTR      |
| 4/4/00                     | APPROVED         | 4-4-00                    | SS.         |

115

LARSON BUILDING SEWER - MAIN STREET