


**WATER MAIN NOTE:**  
THE CITY OF FERNDALE WILL REQUIRE A HOLD HARMLESS AGREEMENT TO BE LOCATED LESS THAN 20' FROM THE EXISTING WATER MAINS. THE CITY OF FERNDALE WILL NOT BE RESPONSIBLE FOR DAMAGES TO BUILDINGS OR OTHER STRUCTURES NECESSARY TO CORRECT SUCH DAMAGES.

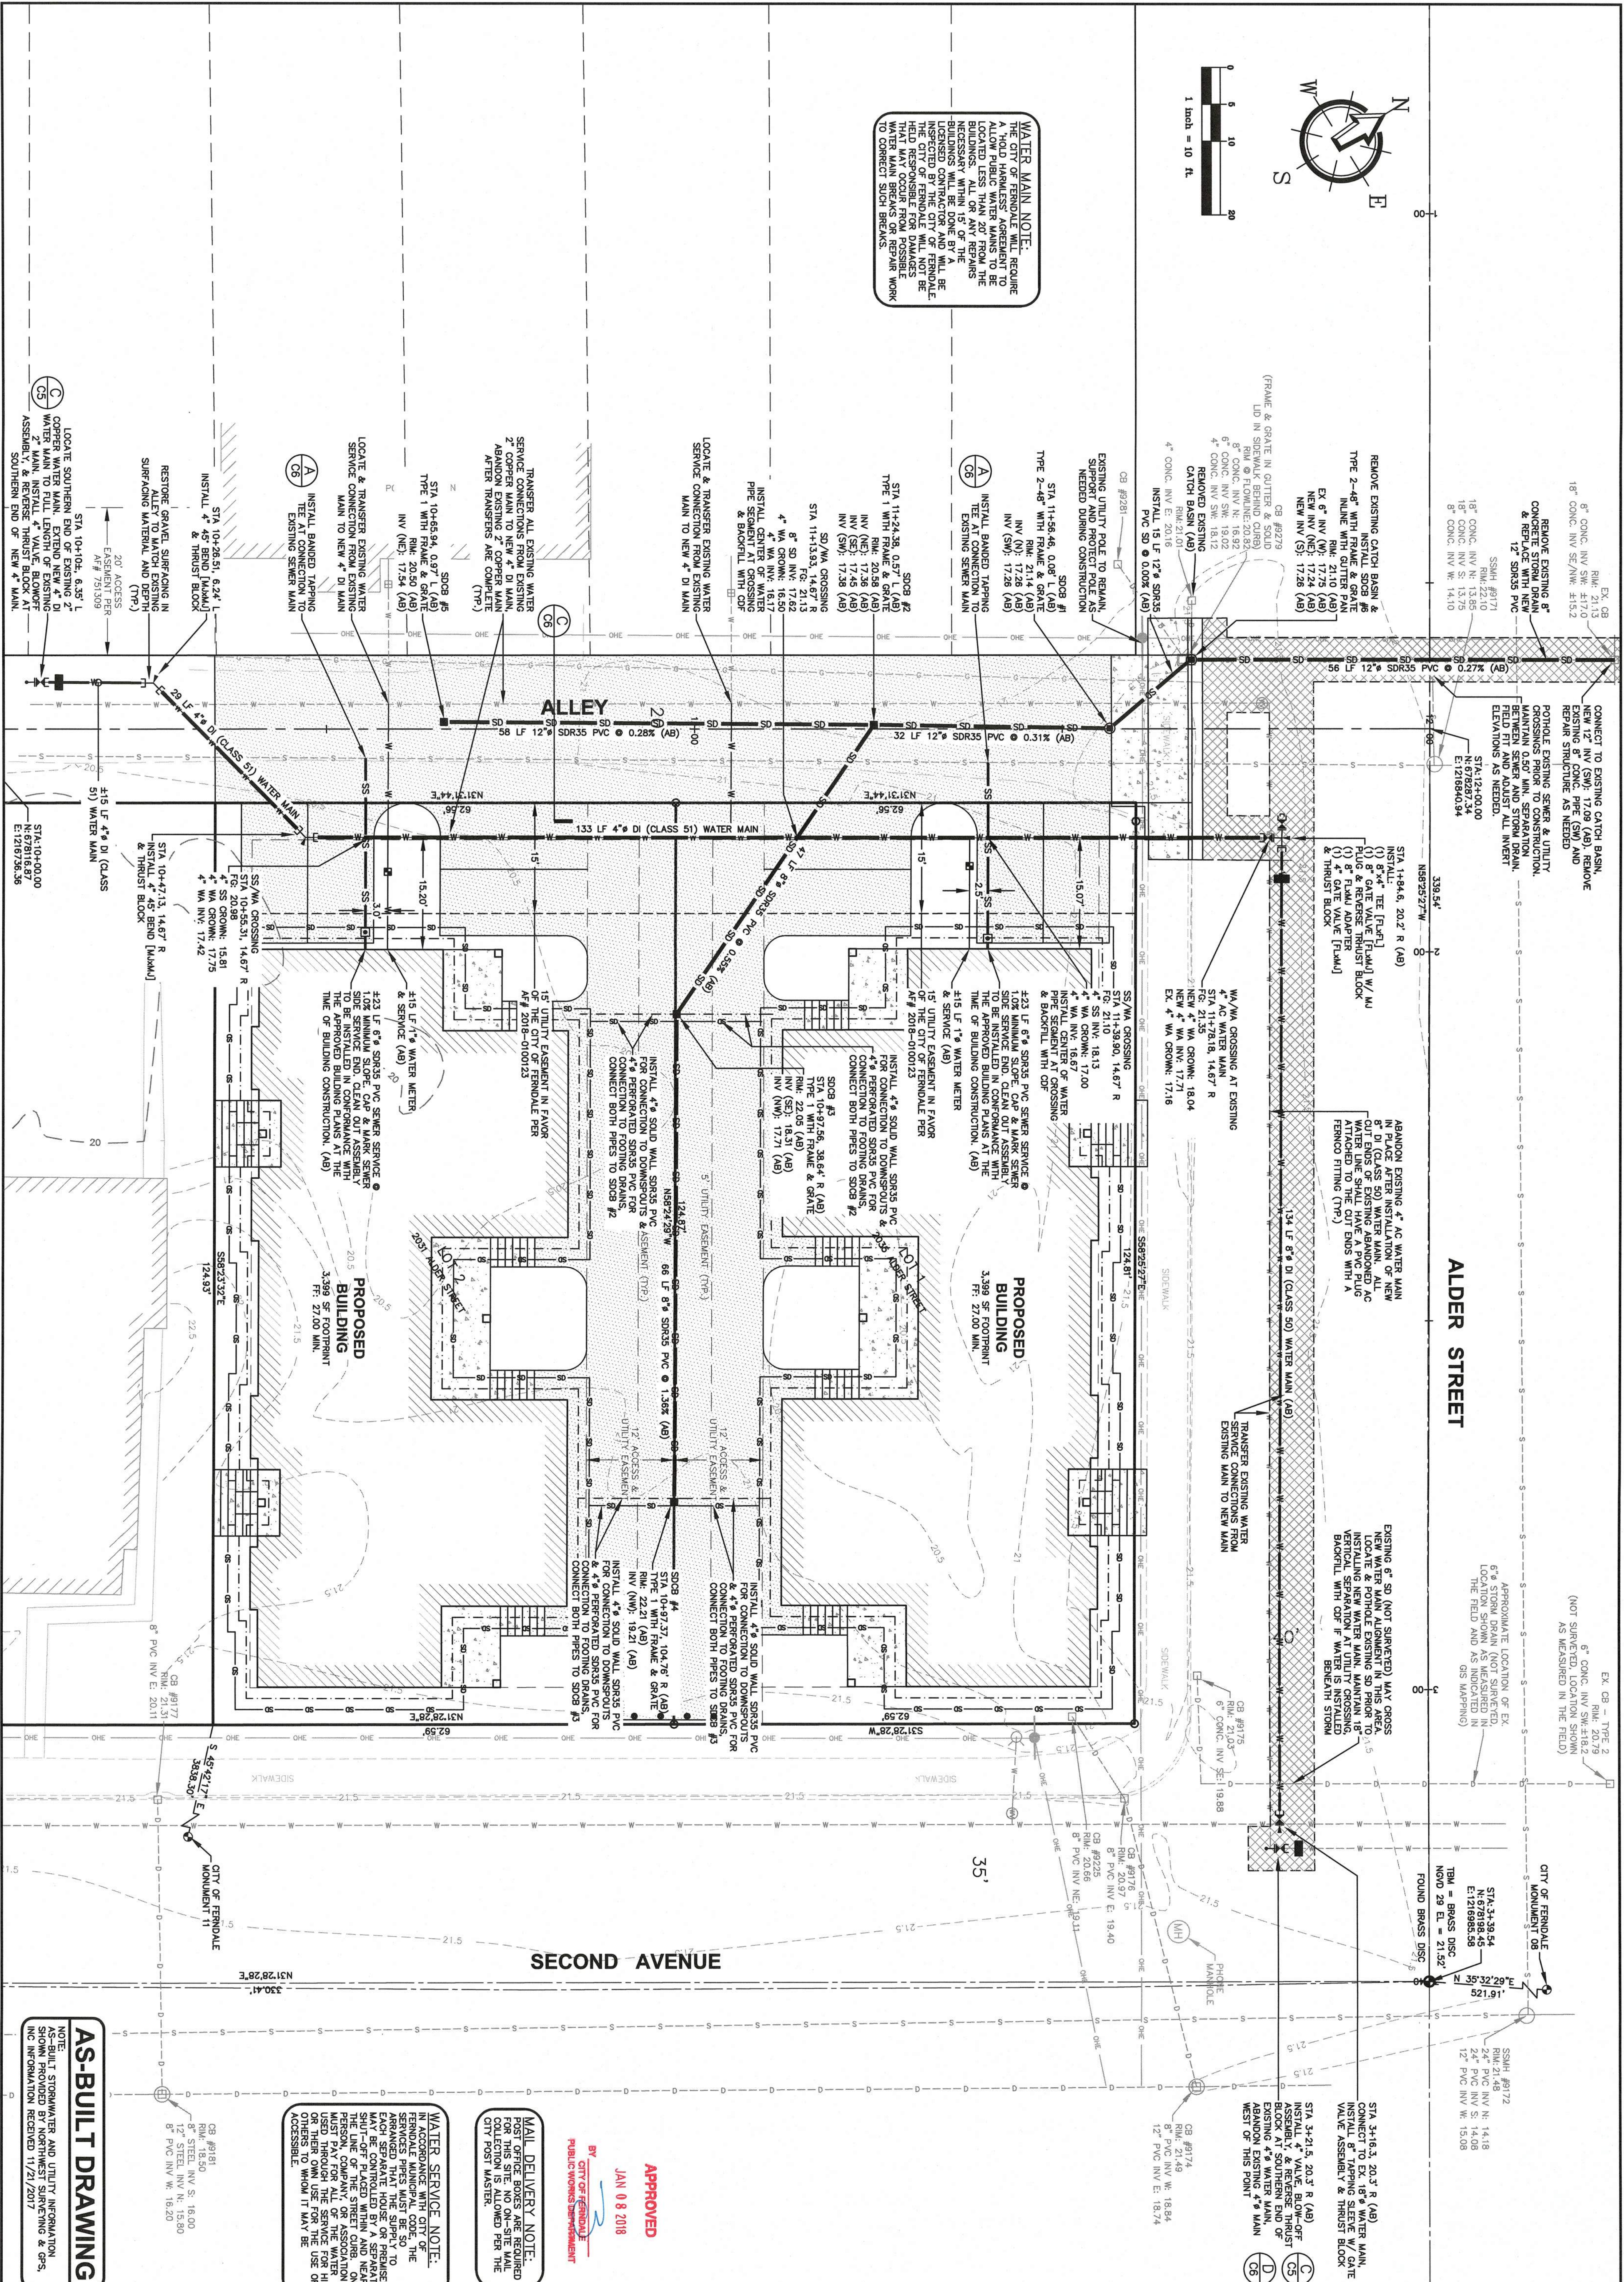

200 West Chicago Street, Suite 200  
Birmingham, AL 35203  
T: 205.663.1403  
F: 205.663.1401

BY:	DATE:	DESCRIPTION:
MOB	09-15-2017	RELOCATE WA & SD IN ALLEY TO AVOID CONFLICTS
MOB	09-15-2017	PERVIOUS ASPHALT IN LIEU OF PERVIOUS CONCRETE

CLIENT:  
**FERNDALE ASSOCIATES, LLC**  
1292 W AXTON ROAD  
FERNDALE, WA 98248  
  
CALL BEFORE YOU DIG  
FOR BURIED UTILITY LOCATIONS  
1-800-424-5555

PROJECT LOCATION:  
**2031 & 2035 ALDER STREET  
MULTI-FAMILY SITE PLAN**  
2031 & 2035 ALDER STREET  
FERNDALE, WA 98248

DRAWING #:  
18092AB2.DWG

DESIGNED BY:  
MDB

DRAWN BY:  
MDB

CHECKED BY:  
JPS

SHEET CONTENTS:  
**SITE UTILITY PLAN**

**AS-BUILT DRAWING**

NOTE: THIS IS A STRIPWATER AND UTILITY INFORMATION DRAWING. IT IS NOT A FINAL AS-BUILT DRAWING. IT IS PROVIDED FOR INFORMATIONAL PURPOSES ONLY. THE INFORMATION IS NOT TO BE USED FOR ANY OTHER PURPOSES WITHOUT THE WRITTEN CONSENT OF FREELAND & ASSOCIATES.

DATE: 01-05-2016  
JOB #: 16092  
SCALE: 1"=10'  
VERT: N/A



DATE: 01-05-2016  
JOB #: 16092  
SCALE: 1"=10'  
VERT: N/A

**WATER SERVICE NOTE:**  
IN ACCORDANCE WITH CITY OF FERNDALE ORDINANCE NO. 11.01, THE WATER SERVICE PIPES MUST BE SO LOCATED THAT THE SUPPLY TO THE BUILDING IS NOT INTERRUPTED IN THE EVENT OF A STREET CLOSURE. THE LINE OF THE STREET CLOSURE MUST BE PLACED WITHIN AND NEAR THE LINE OF THE STREET CLOSURE. THE WATER SERVICE PIPES MUST BE USED THROUGH THE SERVICE FOR HIS OFFENSES WHEN IT MAY BE ACCESSIBLE.

**MAIL DELIVERY NOTE:**  
POST OFFICE BOXES ARE REQUIRED FOR THIS SITE. NO ON-SITE MAIL CITY POST MASTER.

**APPROVED**  
JAN 08 2018  
CITY OF FERNDALE  
PUBLIC WORKS DEPARTMENT



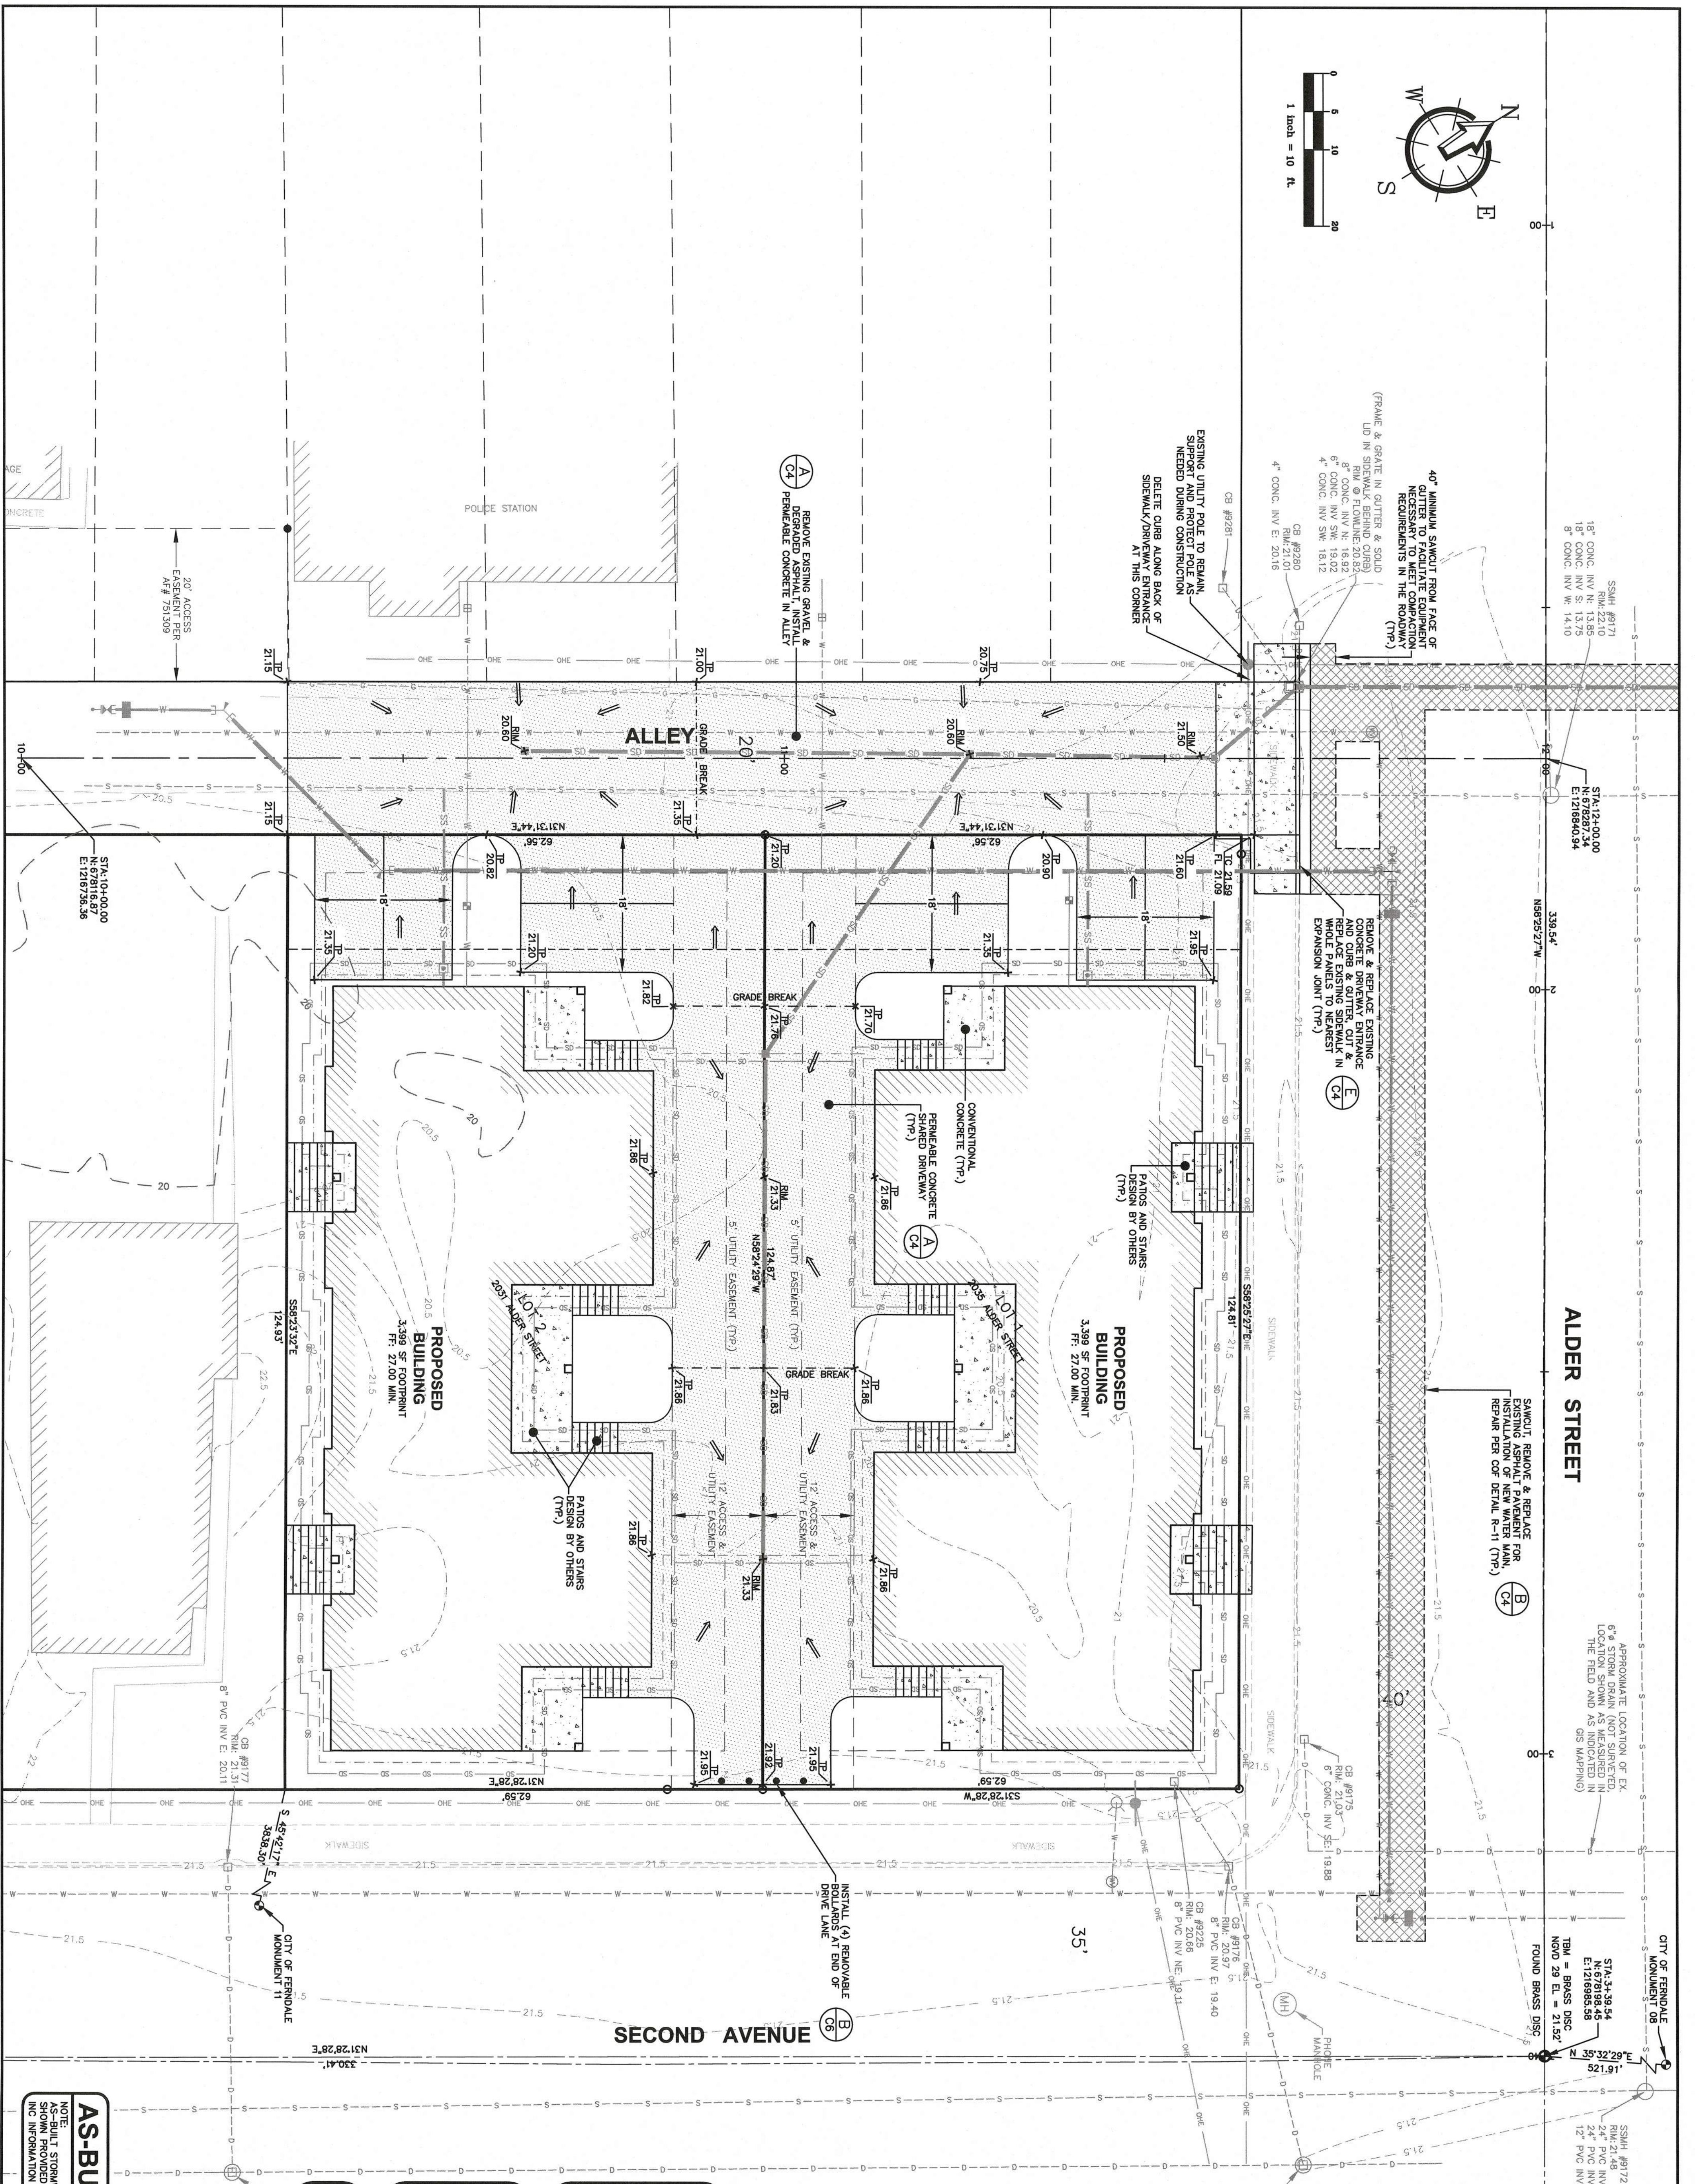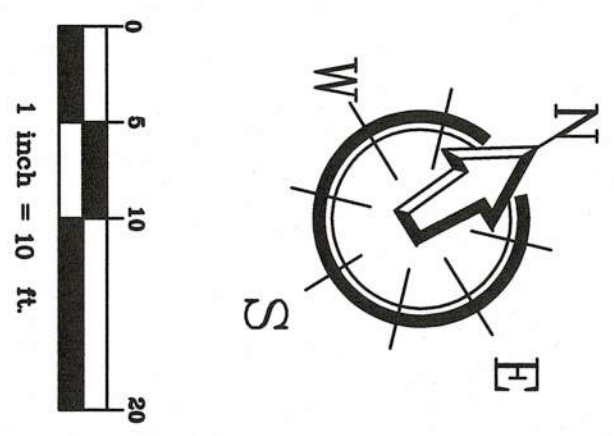

## AS-BUILT DRAWING

**NOTE:**  
AS-BUILT STORMWATER AND UTILITY INFORMATION  
SHOWN PROVIDED BY NORTHWEST SURVEYING & GPS,  
INC INFORMATION RECEIVED 11/21/2017

**CITY OF FERRIDALE  
PUBLIC WORKS DEPARTMENT**

JAN 08 2018

**APPROVED**

**GRADING NOTE:**  
SITE GRADING SHALL BE COMPLETED IN ACCORDANCE WITH APPENDIX J OF THE 2015 INTERNATIONAL BUILDING CODE.

IN ORDER TO CERTIFY THE PROJECT, THE ENGINEER OF RECORD AND/OR A LICENSED GEOTECHNICAL ENGINEER MUST BE PRESENT ON SITE TO INSPECT AND APPROVE MATERIALS USED AND PLACEMENT AND CONSTRUCTION OF THE PROPOSED LOW IMPACT DEVELOPMENT (LID) MATERIALS IN THE ALLEY AND IN THE SHARED DRIVEWAY.

**DEVELOPMENT (LID). NOTE:**

1. THE CITY OF FERNDALE WILL NOT BE RESPONSIBLE FOR REPLACEMENT OR REPAIRS NEEDED FOR THE PERMEABLE PAYMENT DUE TO MAINTENANCE OF PUBLIC UTILITIES IN THE PUBLIC ALLEY.
2. ALL MAINTENANCE FOR THE PERMEABLE PAYMENT IN PUBLIC RIGHT OF WAY WILL BE THE SOLE RESPONSIBILITY OF THE PROPERTY OWNER AT 2031 & 2035 ALDER STREET.

**SHEET  
CONTENTS:**

## SITE GRADING PLAN

PROJECT LOCATION:  
**2031 & 2035 ALDER STREET**  
**MULTI-FAMILY SITE PLAN**  
2031 & 2035 ALDER STREET  
FERNDAL, WA 98248

DRAWING #: 16092AB2.DWG	DRAWN BY: MDB
DESIGNED BY: MDB	CHECKED BY: JPS

CLIENT:

**FERNDALE  
ASSOCIATES, LLC**


1292 W AXTON ROAD  
FERNDALE, WA 98248

CALL BEFORE YOU DIG  
FOR BURIED UTILITY LOCATIONS  
1-800-424-5555


[illegible]

BY:	
MD	
MD	

220 West Champion Street, Suite 200  
Bellevue, WA 98005  
t. 360.650.1400  
f. 360.650.1401

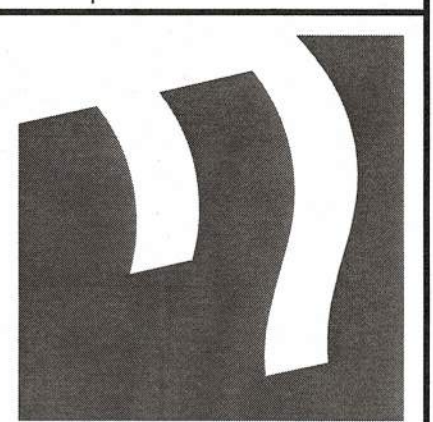



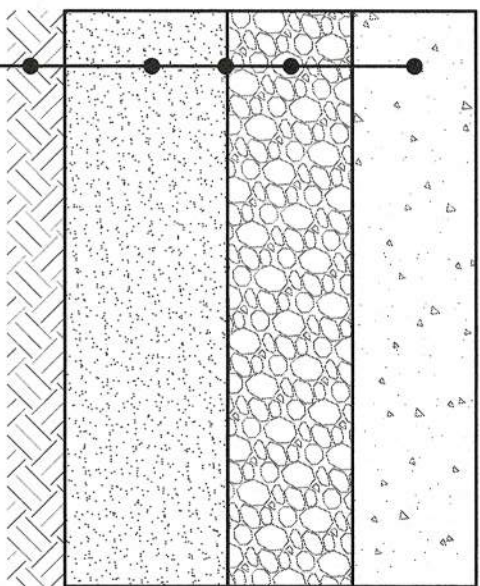

- NOTES:
1. ALL DEPTHS REPRESENT COMPACTED DEPTHS.
  2. CONTROL JOINTS SHALL BE 1/4" DEPTH OF SLAB.
  3. ALL CONSTRUCTION JOINTS SHALL BE DOWELED.
- 6" PERMEABLE CONCRETE W/ FIBER MESH REINFORCEMENT (NO MESH 850 OR EQUAL)
- 4" PERMEABLE BALLAST PER WDOT 8-03.9(2) COMPACTED TO 95% MAX DENSITY, MODIFIED PROCTOR
- 12" MINIMUM DEPTH SAND LAYER, EXTEND AS NEEDED TO REACH SUITABLE SUBGRADE (SEE AMENDED SAND SPECIFICATIONS)
- EXISTING SUBGRADE

SAND SPECIFICATION	
U.S. SIEVE NUMBER	PERCENT PASSING
6	70 - 100
16	40 - 90
30	25 - 75
60	5 - 25
100	2 - 10
200	< 2

#### GENERAL INSTALLATION NOTES


1. AFTER GRADING, THE EXISTING SUBGRADE SHALL NOT BE COMPACTED OR SUBJECTED TO EXCESSIVE CONSTRUCTION EQUIPMENT TRAFFIC.
2. IMMEDIATELY BEFORE BASE, AGGREGATE, AND ASPHALT PLACEMENT, REMOVE ANY ACCUMULATION OF FINE MATERIAL FROM EROSION WITH LIGHT EQUIPMENT, AND SCARIFY SOIL TO A MINIMUM DEPTH OF 6 INCHES.
3. EROSION AND INTRODUCTION OF SEDIMENT SHALL BE STRICTLY CONTROLLED DURING AND AFTER CONSTRUCTION TO PREVENT CLOGGING OF THE VOID SPACES IN THE BASE MATERIAL AND PERMEABLE SURFACE.
4. WRAP EACH LAYER OF THE INFILTRATION TRENCHES WITH AN APPROVED, NON-WOVEN FILTER FABRIC ACCORDING TO THE MANUFACTURER'S SPECIFICATIONS. FILTER FABRIC SHALL BE STAPLED TO THE SUBGRADE AT 12" MAX. SPACING. STAPLES SHALL BE PLACED TO PREVENT MIGRATION OF FINES FROM THE DENSELY GRADED BASE TO THE OPEN GRADED BASE MATERIAL. MAINTAIN PROPER COMPACTION AND AVOID DIFFERENTIAL SETTLING. OVERLAP ADJACENT STRIPS OF FABRIC AT LEAST 24 INCHES.

#### AMENDED SAND/SOIL SPECIFICATIONS:

1. LONG-TERM INFILTRATION RATE SHALL BE 2.0 IN/HR.
2. CATION EXCHANGE CAPACITY (CEC) OF THE TREATMENT SOIL MUST BE GREATER THAN OR EQUAL TO 17 MEQ/100 GMS DRY SOIL (USED AS A GUIDE). THE TREATMENT SOIL MUST BE TESTED FOR EXPECTED POLLUTANT LOADINGS, PARTICULARLY HEAVY METALS AND LOADING CAPACITY DETERMINATION FOR THE TARGET POLLUTANTS THAT IS ACCEPTED BY THE LOCAL JURISDICTION.
3. TREATMENT SOIL, RETAINED ON A U.S. SIEVE SHALL CONTAIN NOT MORE THAN 0.20 PERCENT BY WEIGHT OF WOOD WASTE.
4. WASTE FILL MATERIALS SHOULD NOT BE USED AS INFILTRATION FILL MEDIA NOR SHOULD MEDIA BE PLACED OVER UNCONTROLLED OR NON-ENGINEERED FILL SOILS.
5. SOIL AMENDMENTS MAY BE ADDED TO NATIVE SOIL IN ORDER TO OBTAIN THE REQUIRED INFILTRATION RATE AND CATION EXCHANGE CAPACITY. AMENDMENTS SHALL BE ADDED TO NATIVE SOILS PER RECOMMENDATIONS IN BMP TS.13 IN VOLUME V OF THE DEPARTMENT OF TRANSPORTATION'S MANAGEMENT MANUAL FOR WESTERN WASHINGTON, 2005 EDITION. AMENDMENTS TO NATIVE SOILS SHOULD MEET THE GRADING REQUIREMENTS FOR IMPORTED SAND BELOW.
6. MATERIAL TO BE USED FOR STORMWATER TREATMENT SHALL BE REMOVED AND APPROVED BY A LICENSED GEOTECHNICAL PROFESSIONAL (I.E. ENGINEER OR ENGINEERING GEOLOGIST) PRIOR TO INSTALLATION. THE GEOTECHNICAL PROFESSIONAL SHALL CERTIFY THAT THE STORMWATER TREATMENT MATERIAL MEETS INFILTRATION RATE, CEC CAPACITY, AND DRINKING WATER REQUIREMENTS AS DETERMINED IN THESE SPECIFICATIONS.


### A PERVIOUS CONCRETE PAVEMENT

DRAWN BY: LISA CYFORD

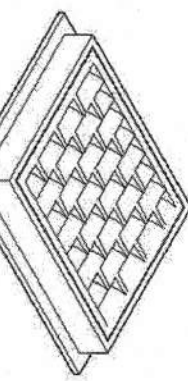


NOTE:  
INSTALL HERRINGBONE REINFORCEMENT (NOT VANE)

#### FRAME AND VANE GRATE

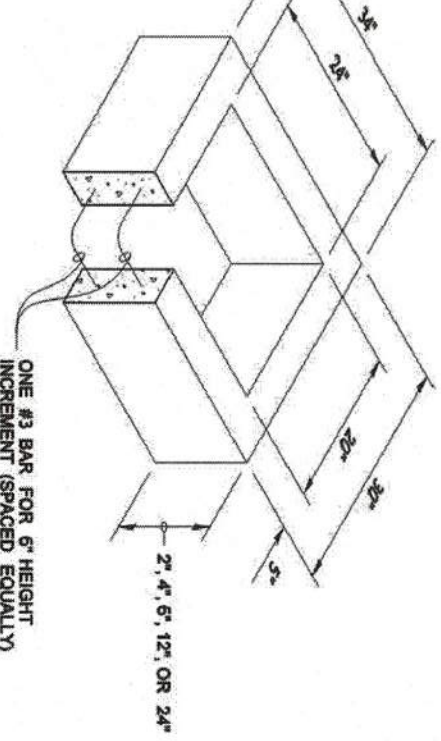


ONE #3 BAR FOR 6" HEIGHT INCREMENT (SPACED EQUALLY)

#### RECTANGULAR ADJUSTMENT SECTION

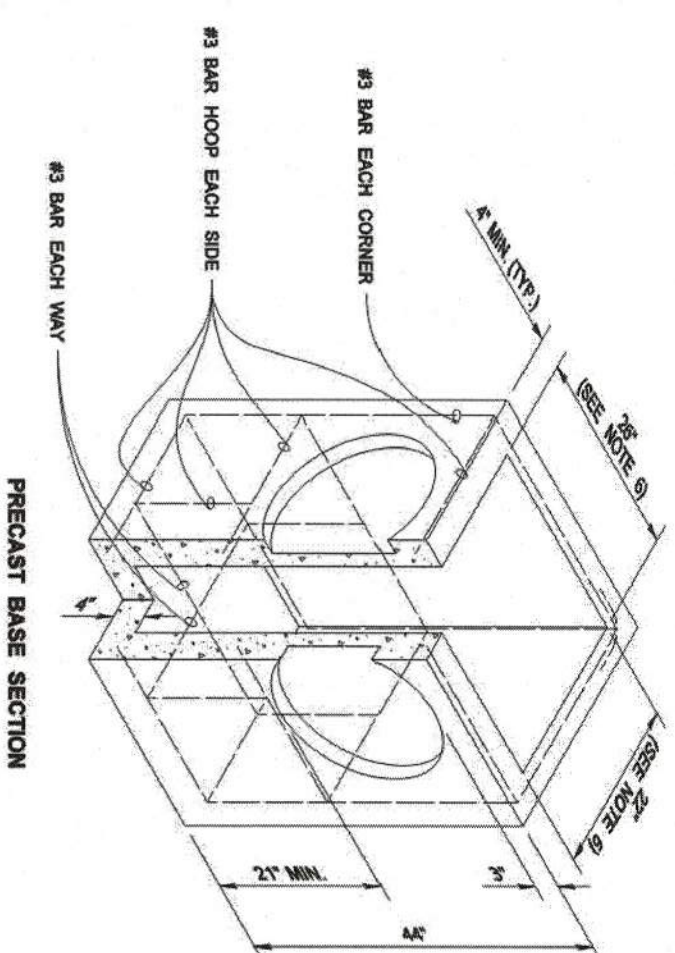

#### PRECAST BASE SECTION

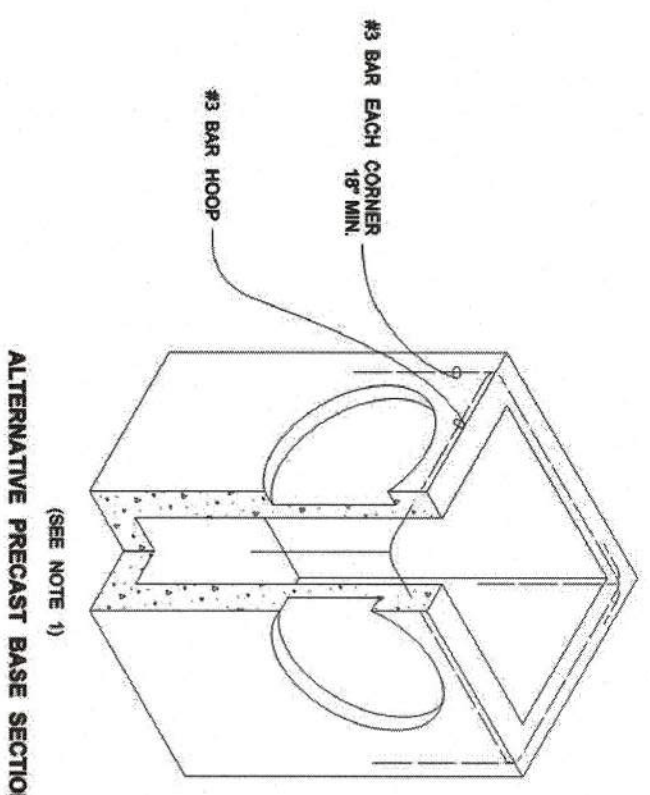

#### ALTERNATIVE PRECAST BASE SECTION

PIPE ALLOWANCES	
PIPE MATERIAL	MAXIMUM DIAMETER
IMPERFORATED OR FLUID CONCRETE	12"
ALL METAL PIPE	15"
CS-90 # (STD. SPEC. 36.52.20)	12"
CS-90 # (STD. SPEC. 36.52.21)	15"
CS-90 # (STD. SPEC. 36.52.22)	15"

\* CORROLATED POLYETHYLENE STORM SEWER PIPE

- NOTES
1. As acceptable alternatives to the notes shown in the PRECAST BASE SECTION, these (based according to the Standard Specifications), or who must have a minimum area of (12 square inches per foot shall be used for the PRECAST BASE SECTION. Who must shall not be placed in the knickdown.
  2. The knickdown diameter shall not be greater than 20". Knickdowns shall have a wall thickness of 2" minimum to 2.5" maximum. Provide a 1.5" minimum gap between the knickdown wall and the outside of the pipe.
  3. The maximum depth from the finished grade to the lowest pipe invert shall be 6'.
  4. The frame and grate may be installed with the large down, or integrally cast into the adjustment section with flange up.
  5. The Precast Base Section may have a rounded floor, and the walls may be sloped at a rate of 1:24 or steeper.
  6. The opening shall be measured at the top of the Precast Base Section.
  7. All pickup holes shall be grouted full after the basin has been placed.

**CATCH BASIN TYPE 1**

STANDARD PLAN B-5-20-01


SHEET 1 OF 1 SHEET

APPROVED FOR PUBLICATION

Pasco Bickelich III 06-16-11

Washington State Department of Transportation


DRAWN BY: FERN LIDDELL

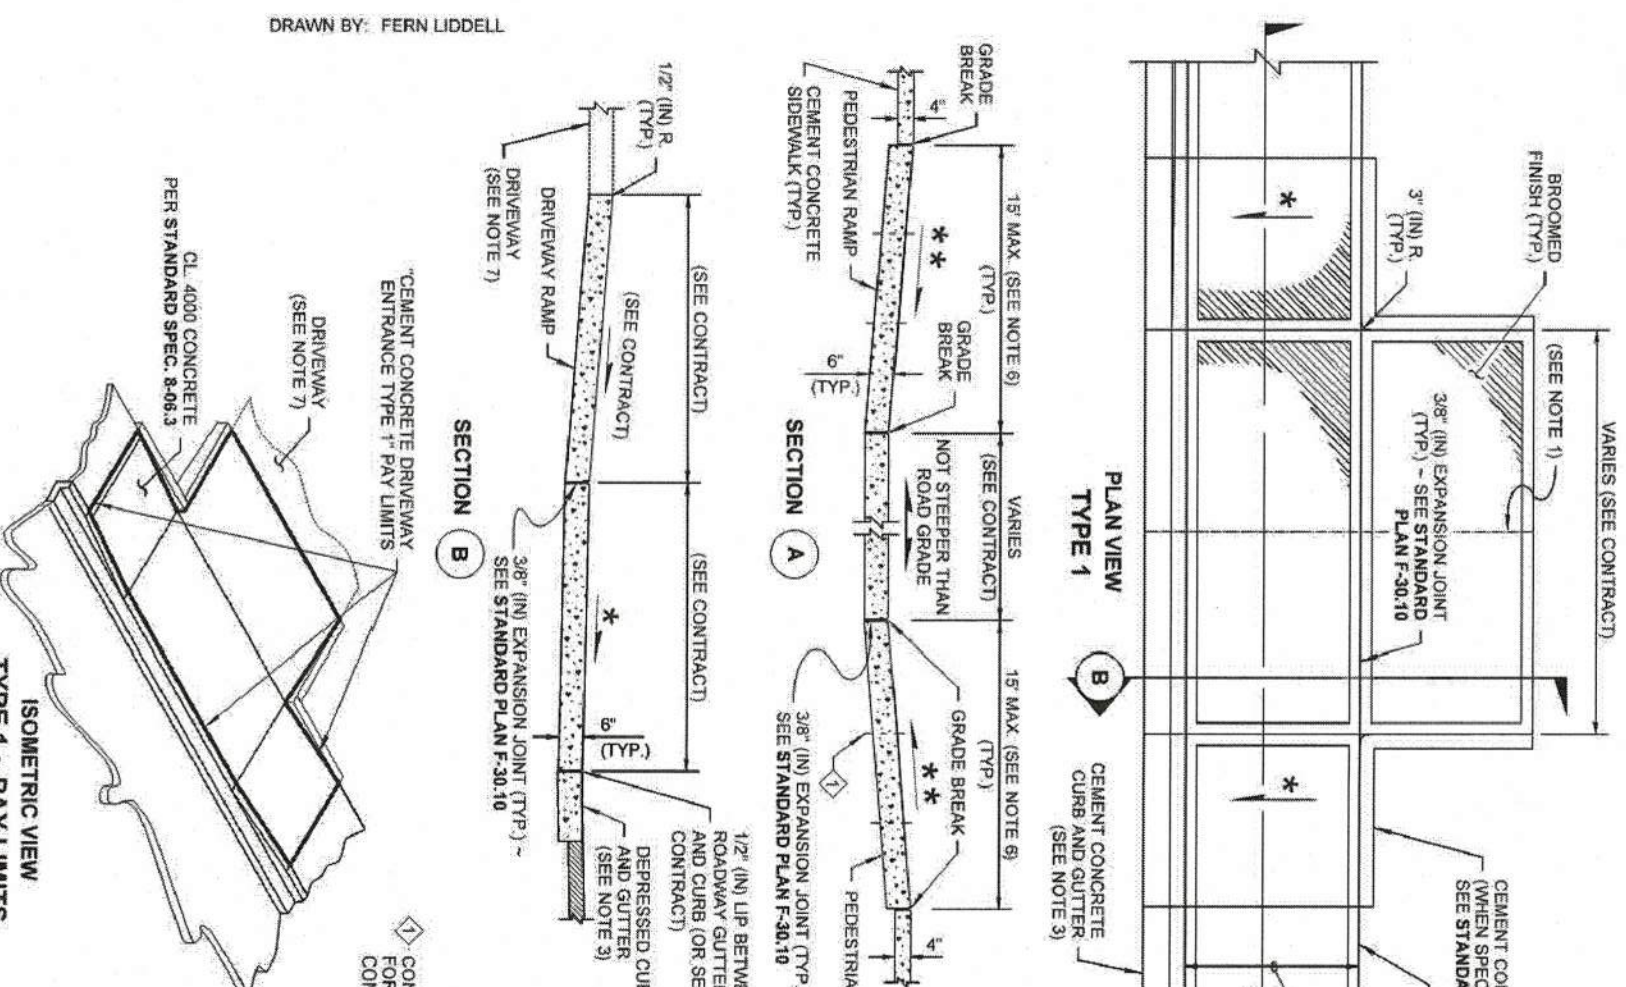


#### ISOMETRIC VIEW

#### ISOMETRIC VIEW

### B PAVEMENT REPAIR

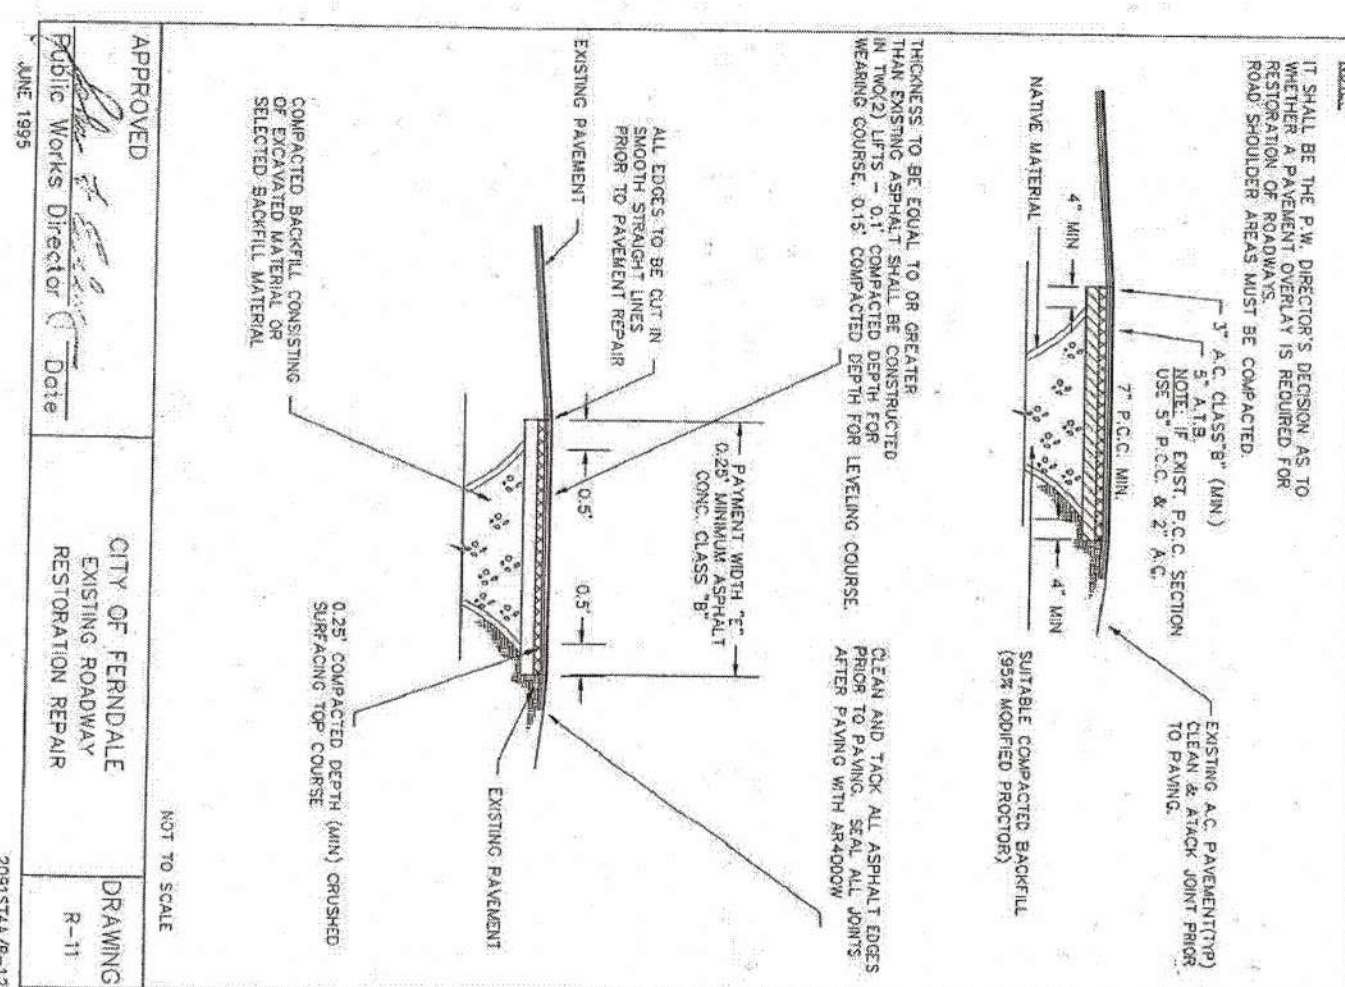

### C PIPE BEDDING

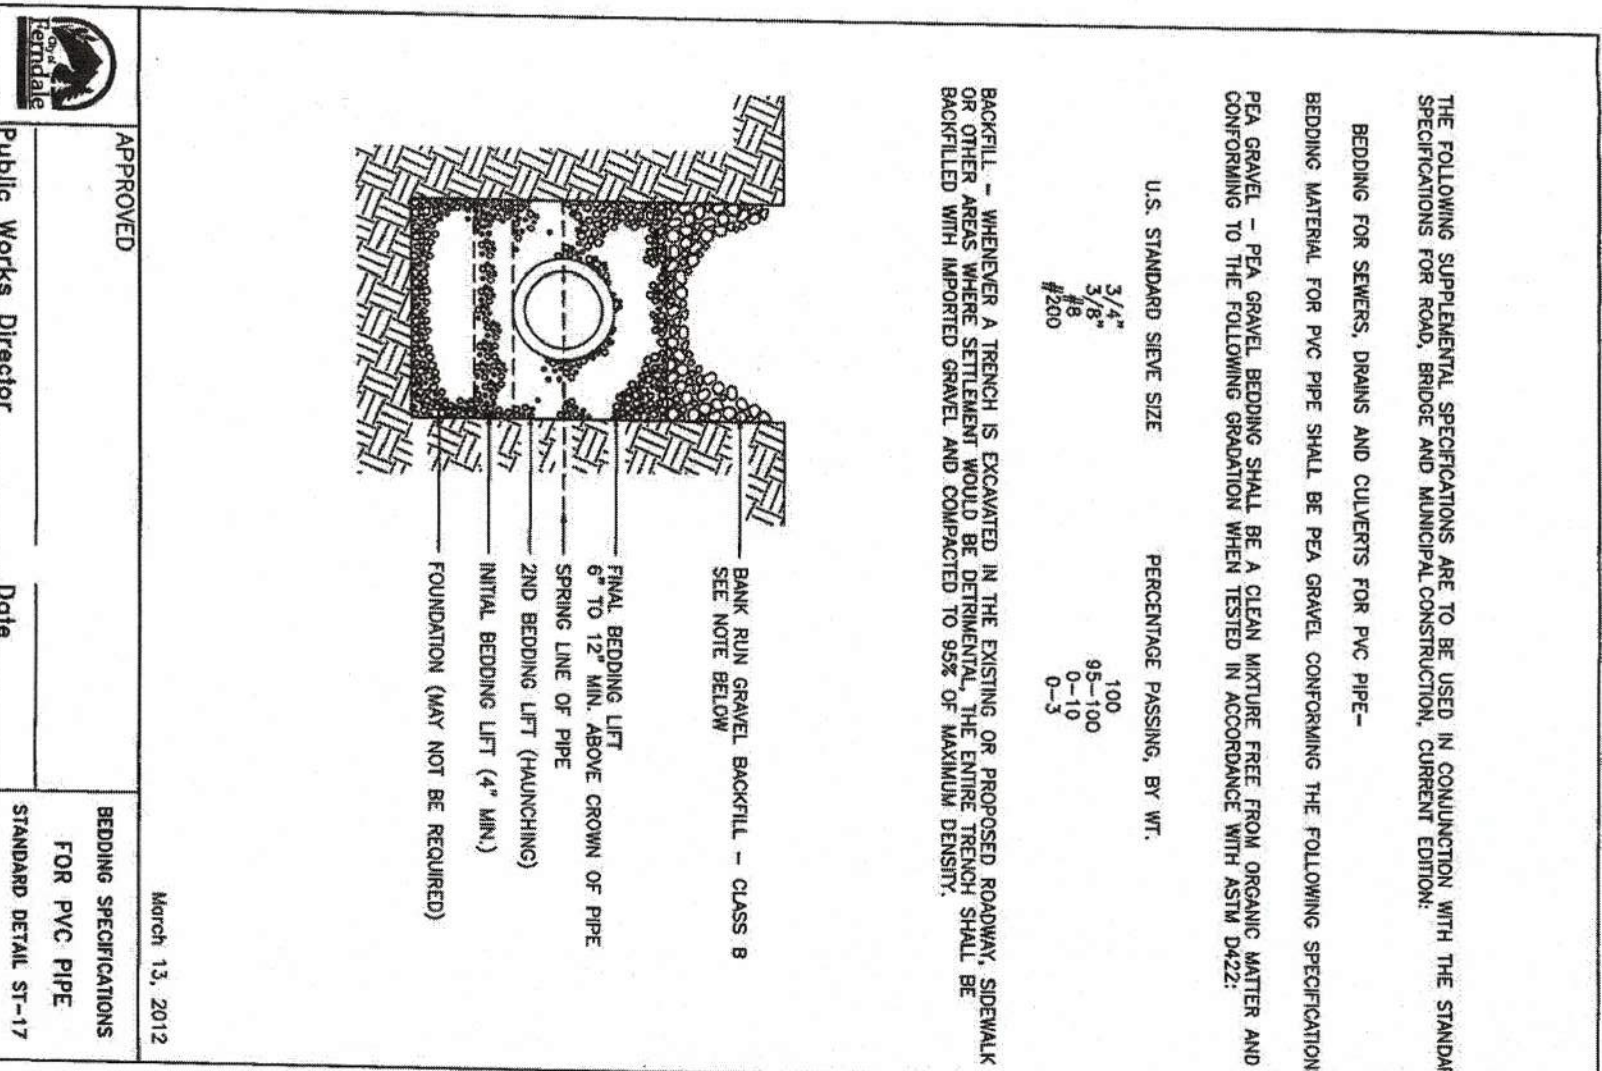

**AS-BUILT DRAWING**

NOTE: ALL STORMWATER AND UTILITY INFORMATION SHOWN PROVIDED BY NORTHWEST SURVEYING & GPS, INC. INFORMATION RECEIVED 11/21/2017

APPROVED FOR PUBLICATION

STANDARD PLAN B-80-10-04

SHEET 1 OF 2 SHEETS

APPROVED FOR PUBLICATION

STANDARD PLAN B-80-10-04

SHEET 1 OF 2 SHEETS






# THRUST BLOCKING @ ELBOWS




## THRUST BLOCKING @ TEES

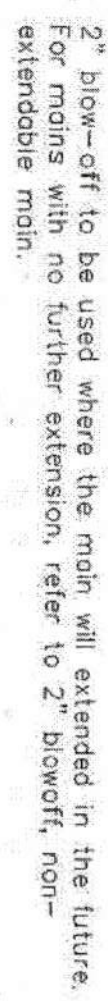

**WATER MAIN BLOW-OFF**




# UTILITY CROSSING AT WATER MAIN

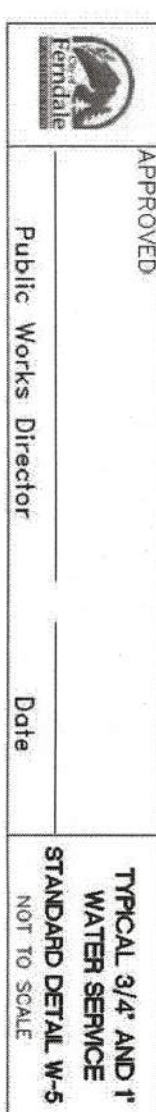


**F** TYPICAL WATER SERVICE  
mts



**G** **CONCRETE METER BOX**  
nts

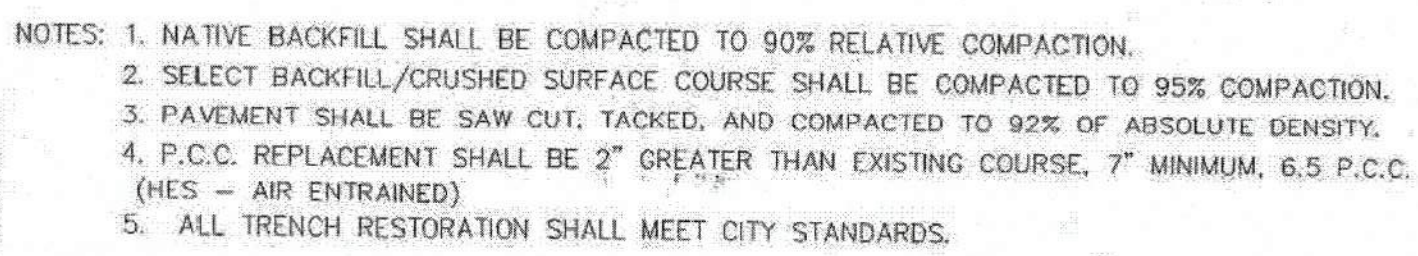

## D<sub>nl</sub> WATER TRENCHING


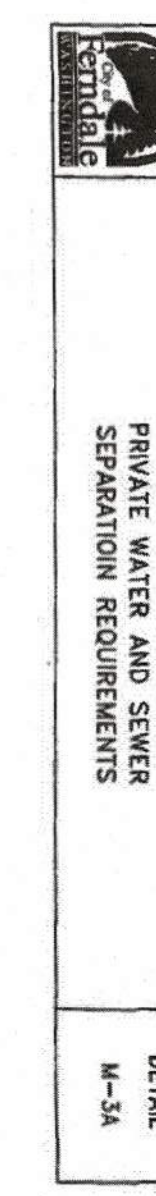


# UTILITY SERVICE SEPARATION REQUIREMENTS







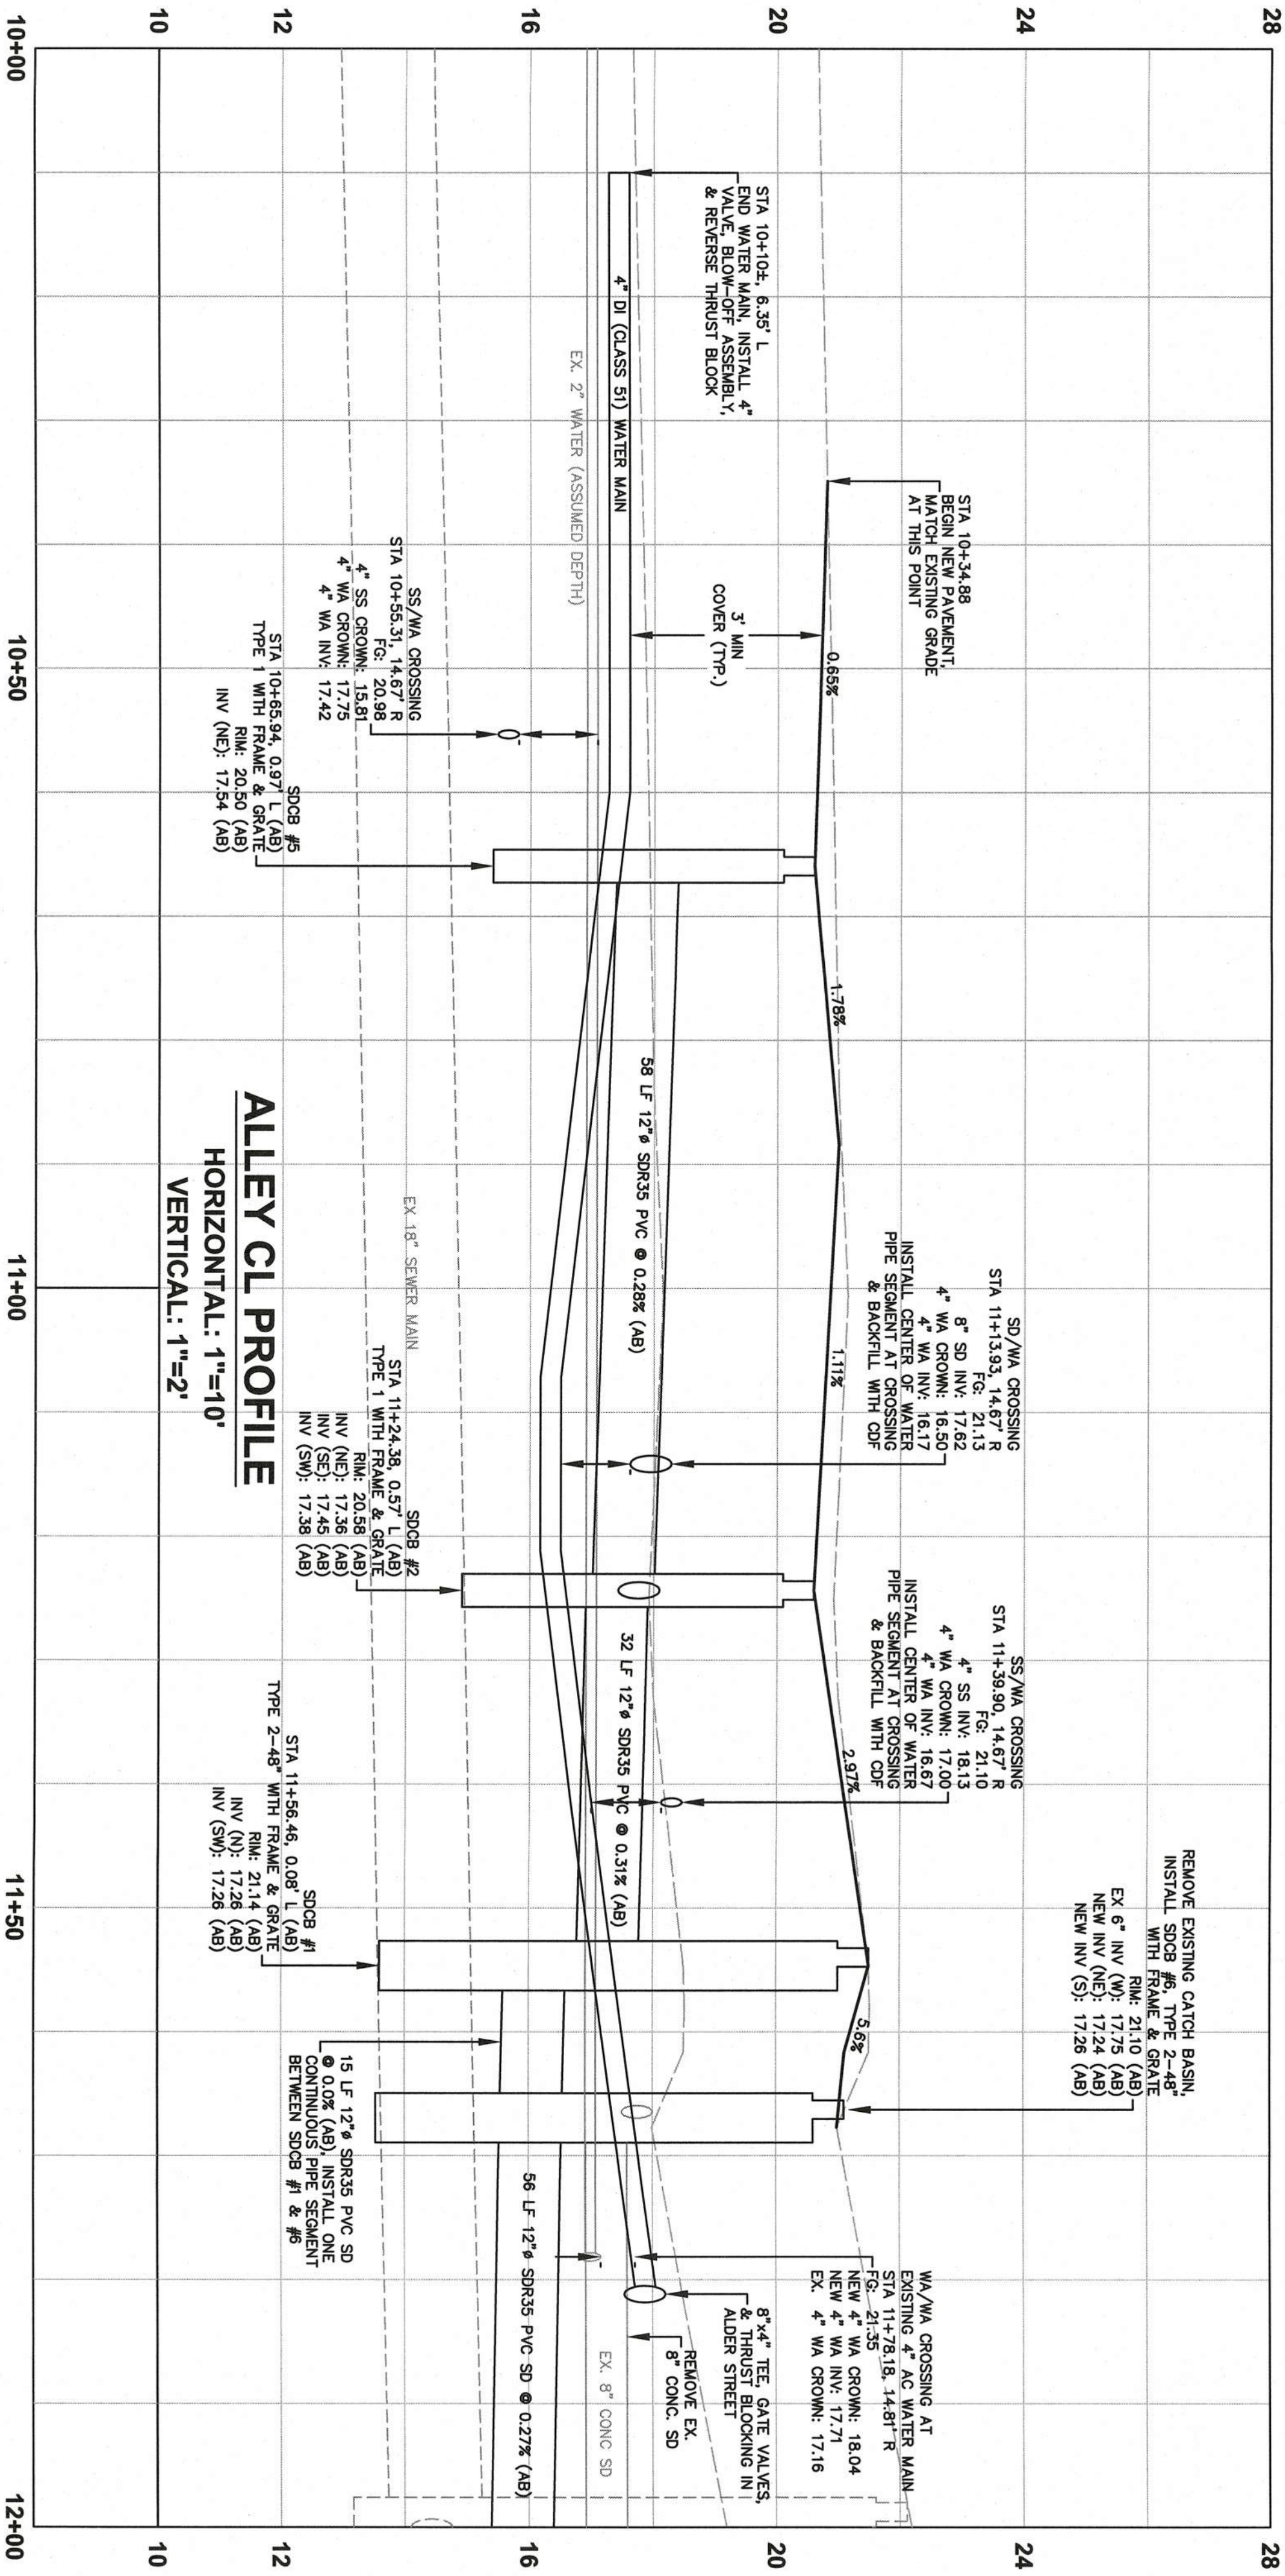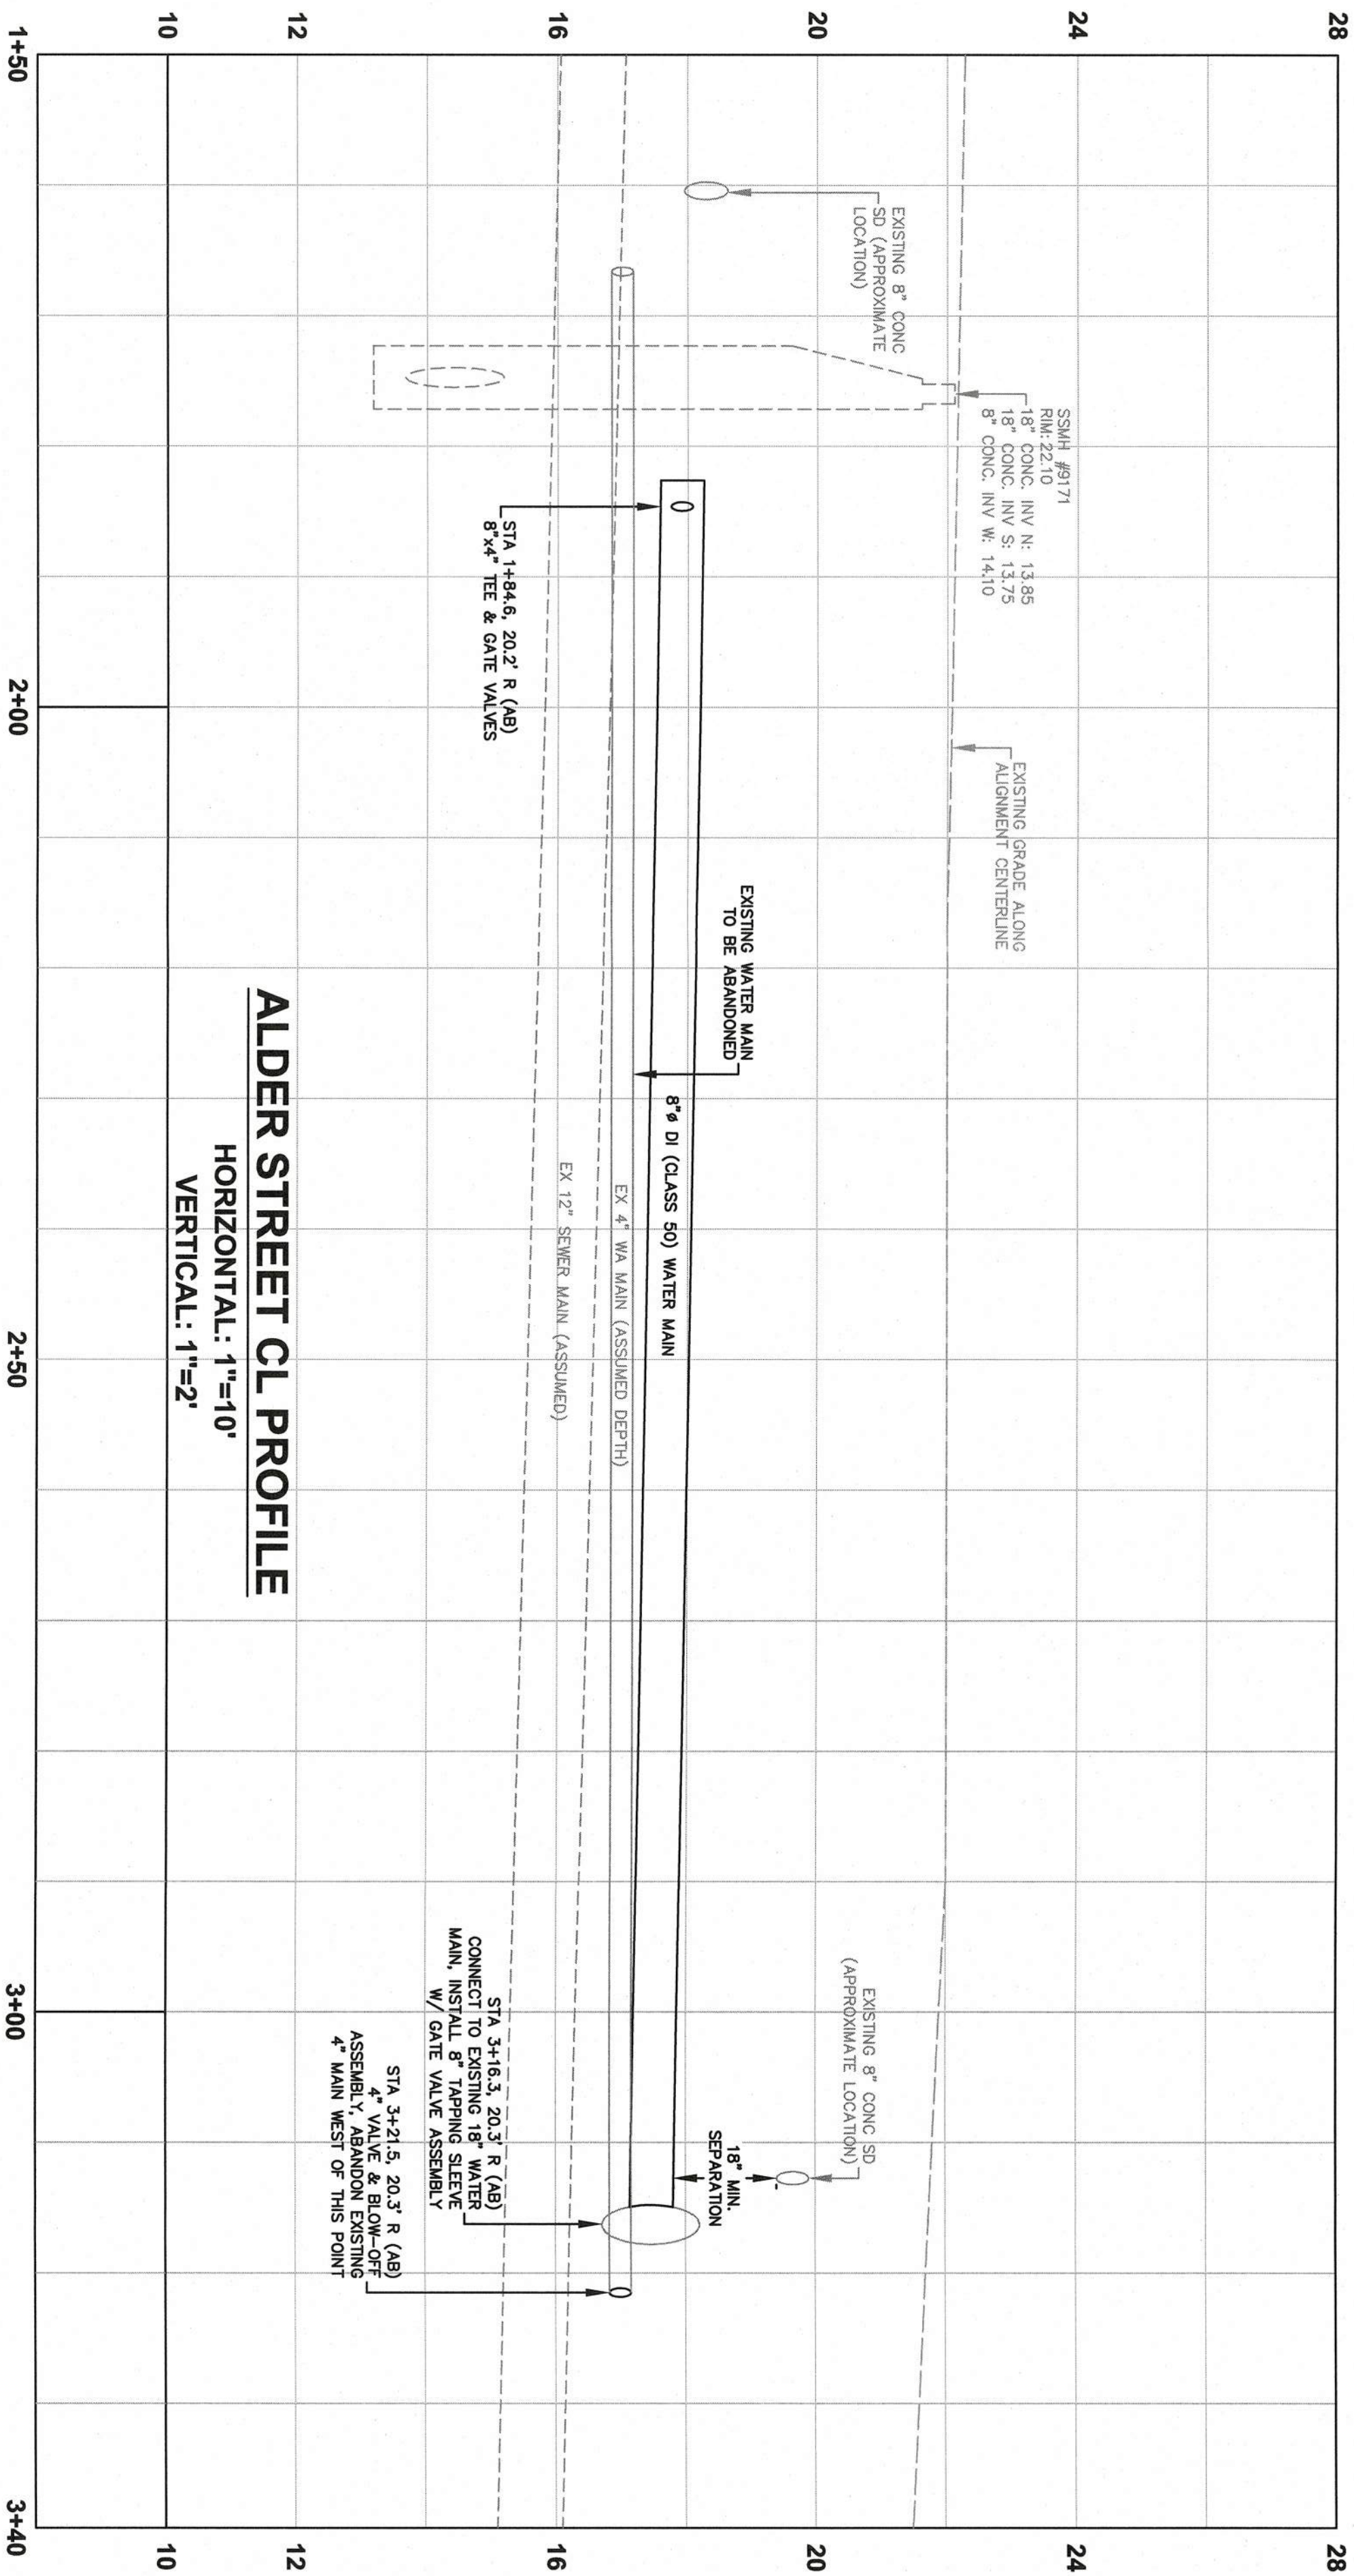

200 West Champion Street, Suite 200 | 98003-1408  
Bellevue, WA 98003  
F & ASSOCIATES

BY: MDB

REV:	DATE:	DESCRIPTION:
1	09-15-2017	RELOCATE WA & SD IN ALLEY TO AVOID CONFLICTS
2	09-15-2017	PERVIOUS ASPHALT IN LIEU OF PERVIOUS CONCRETE

CLIENT:

**FERNDALE ASSOCIATES, LLC**  
1292 W AXTON ROAD  
FERNDALE, WA 98248

CALL BEFORE YOU DIG  
FOR BURIED UTILITY LOCATIONS  
1-800-424-5555

PROJECT LOCATION:  
**2031 & 2035 ALDER STREET  
MULTI-FAMILY SITE PLAN**  
2031 & 2035 ALDER STREET  
FERNDALE, WA 98248

DRAWING #: 16092AB2.DWG  
DESIGNED BY: MDB  
DRAWN BY: MDB  
CHECKED BY: JPS

SHEET CONTENTS:

**WATER MAIN PROFILES**

APPROVED

JAN 0 8 2018

BY: CITY OF FERNDALE  
PUBLIC WORKS DEPARTMENT



**AS-BUILT DRAWING**

NOTE: ALL STORMWATER AND UTILITY INFORMATION SHOWN PROVIDED BY NORTHWEST SURVEYING & GPS. INC INFORMATION RECEIVED 11/21/2017

JOB #: 16092  
SCALE: HORIZ: 1"=10'  
VERT: 1"=2'

DATE: 01-05-2018  
SHEET: C7









201 Main Campus Street, Suite 200 • 380.663.1468  
Bellingham, WA 98225 • 360.693.1041  
**FREELAND & ASSOCIATES**

BY:	DATE:	DESCRIPTION:
MDB	08-15-2017	RELOCATE WA & SD IN ALLEY TO AVOID CONFLICTS
MDB	08-15-2017	PERVIOUS ASPHALT IN LIEU OF PERVIOUS CONCRETE

CLIENT: **FERNDALE ASSOCIATES, LLC**  
1292 W AXTON ROAD  
FERNDALE, WA 98248  
**CALL BEFORE YOU DIG**  
FOR BURIED UTILITY LOCATIONS  
1-800-424-5555

PROJECT LOCATION: <b>2031 &amp; 2035 ALDER STREET MULTI-FAMILY SITE PLAN</b> 2031 & 2035 ALDER STREET FERNDALE, WA 98248	DRAWN BY: MDB
DRAWING #: 160922AB2.DWG	CHECKED BY: JPS
DESIGNED BY: MDB	

SHEET CONTENTS:  
**TEMPORARY EROSION CONTROL NOTES & DETAILS**

1616

16092

01-05-2018

C9

1616

16092

01-05-2018



C9

1616

16092

01-05-2018

C9

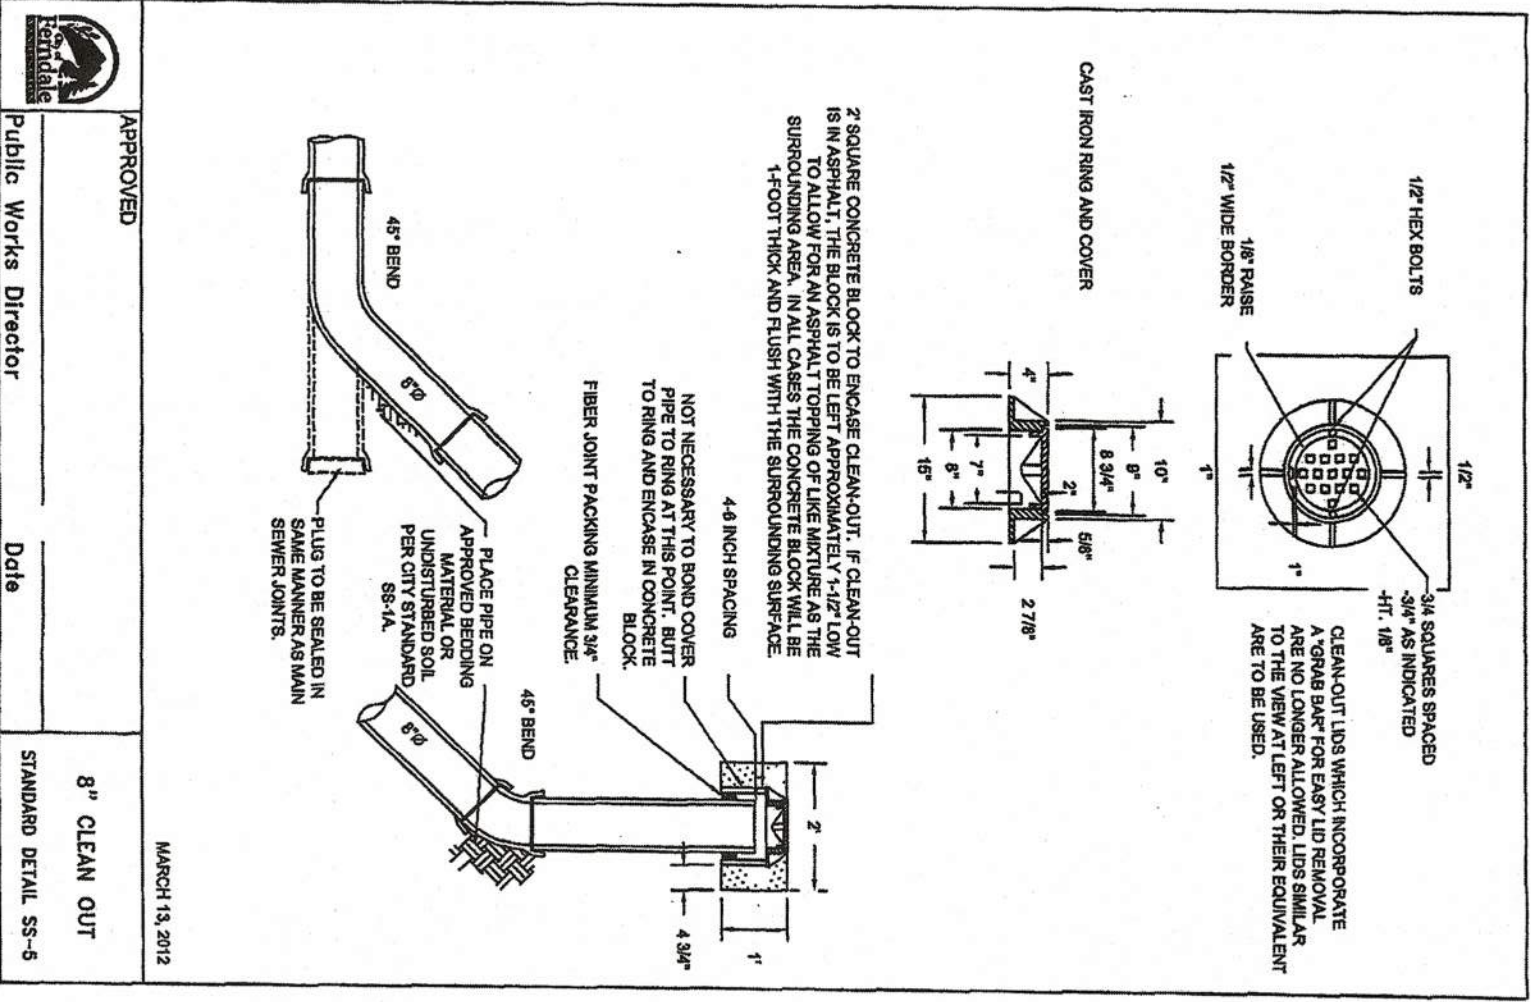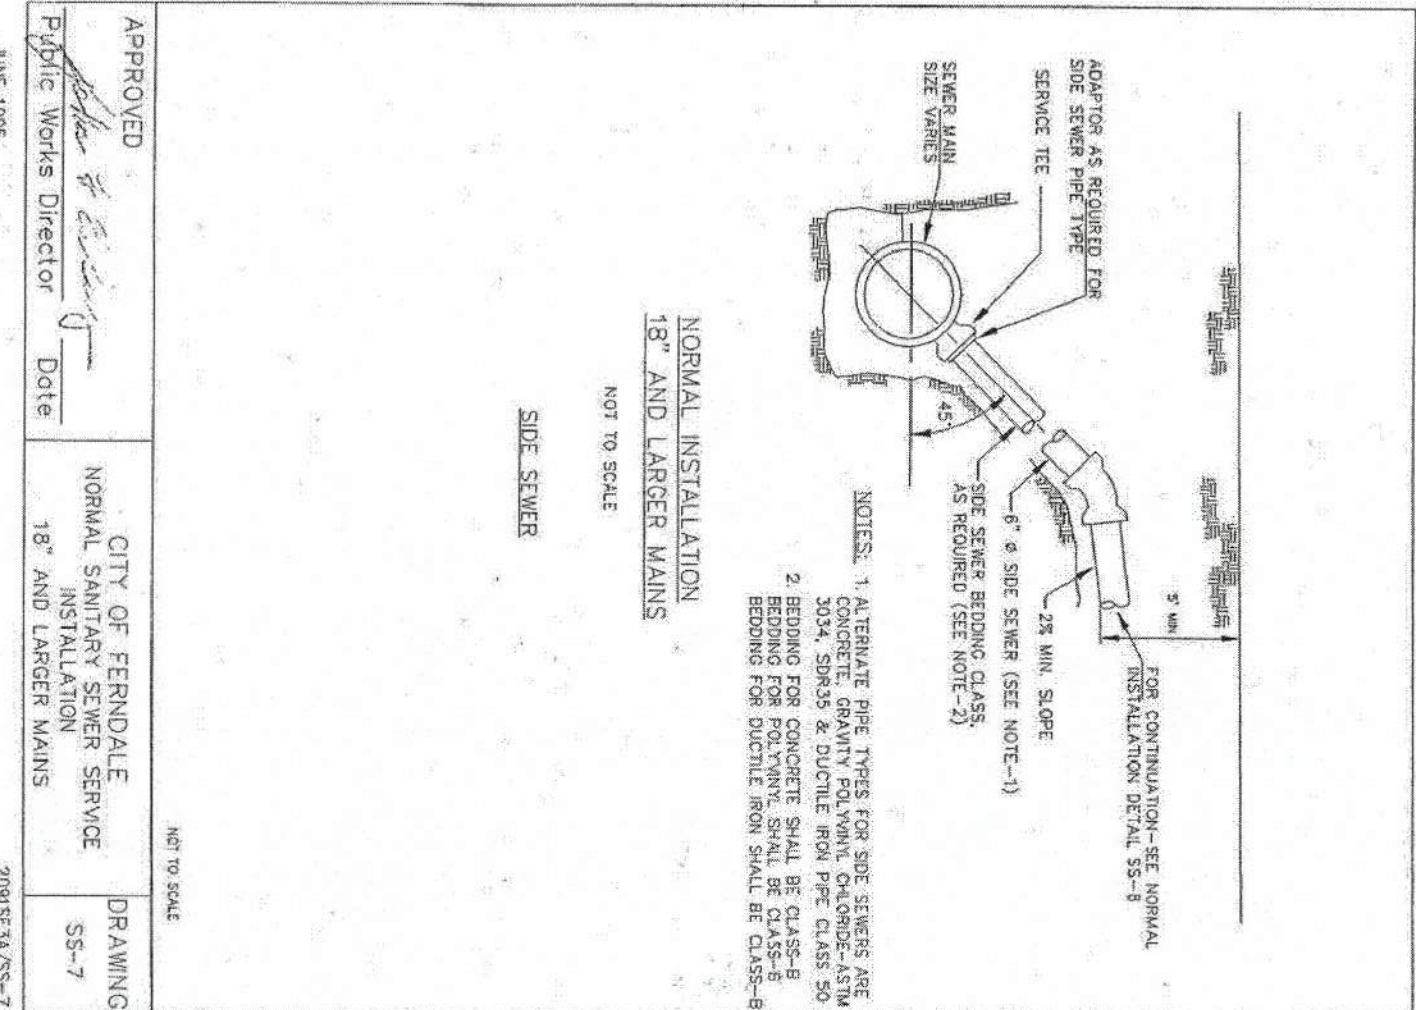


**SEWER SERVICE**

**GRAVITY SEWER CLEAN OUT**

**SAWCUTTING**

**SILT FENCE**

**INLET PROTECTION**

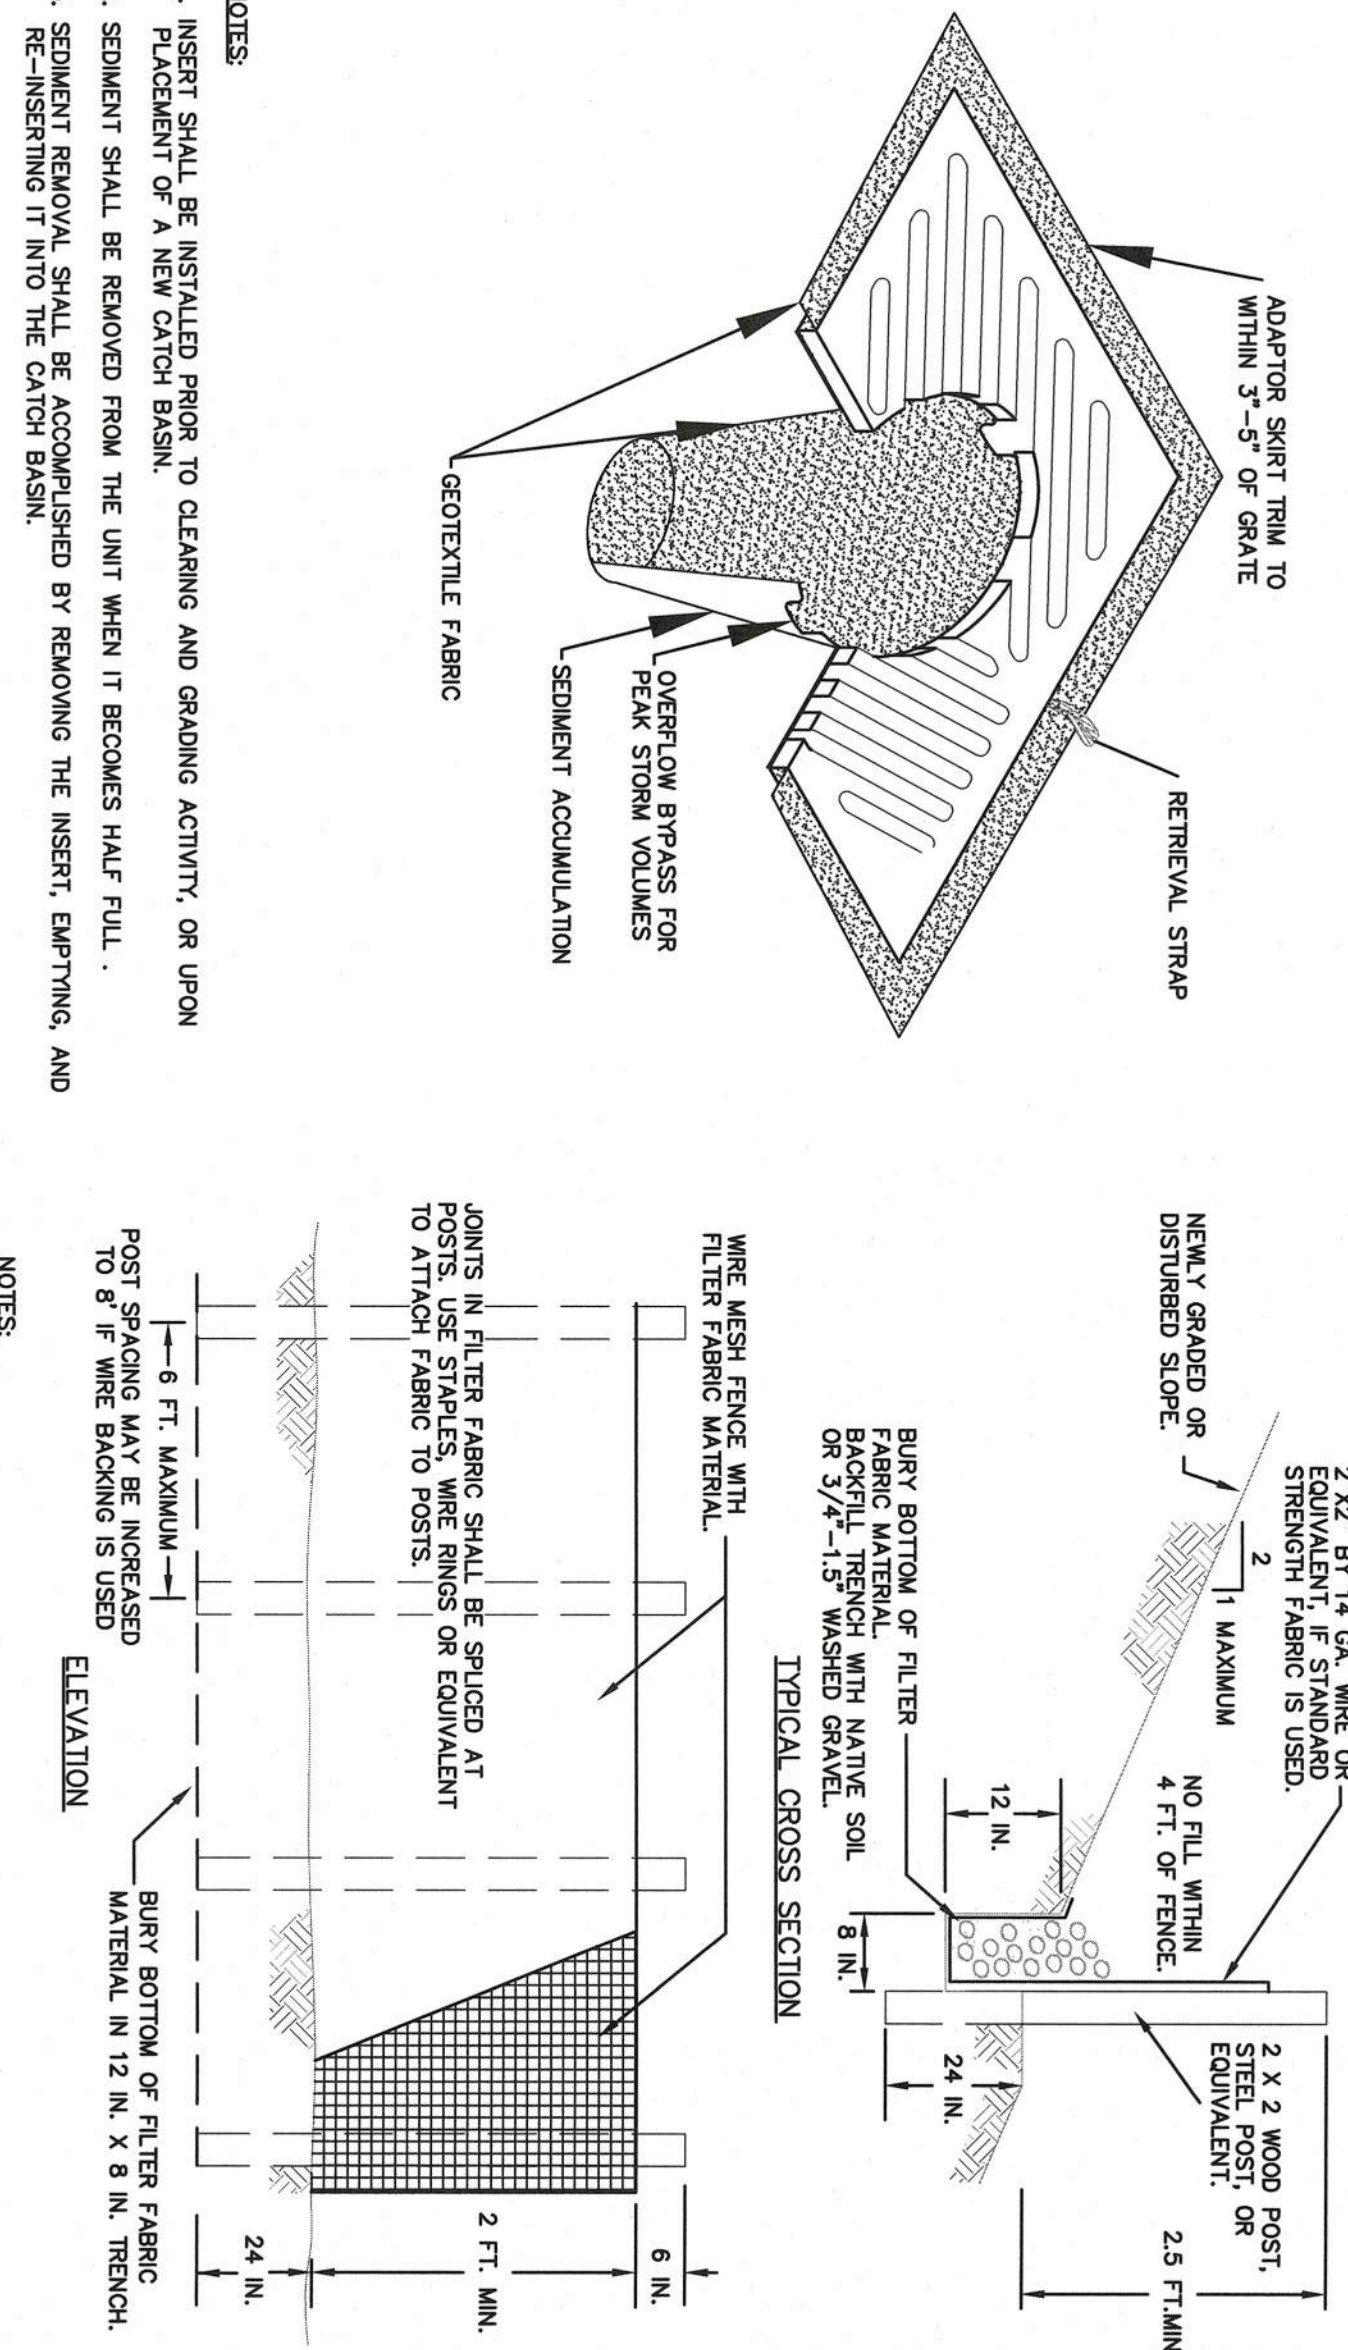

**BMP C152: Sawcutting and Surfacing Pollution Prevention**

**Purpose**

Sawcutting and surfacing operations generate slurry and process water that can contain oil, grease, and other pollutants. If not properly managed, these materials can violate the water quality standards in the receiving water body. This BMP is designed to minimize and eliminate process water and slurry created through sawcutting or surfacing from entering waters of the State.

Utilize these management practices anytime sawcutting or surfacing operations take place. Sawcutting and surfacing operations include, but are not limited to, the following:

- Sawing
- Coring
- Grinding
- Roughening
- Hydro-demolition
- Bridge and road surfacing
- Vacuum slurry and cuttings during cutting and surfacing operations.
- Slurry and cuttings shall not remain on permanent concrete or asphalt pavement overnight.
- Slurry and cuttings shall not drain to any natural or constructed water body.
- Do not allow process water generated during hydro-demolition, surface roughening or similar operations to drain to any natural or constructed drainage conveyance including stormwater systems.
- Dispose process water in a manner that does not violate ground water or surface water quality standards.
- Handle and dispose cleaning waste material and demolition debris in a manner that does not cause contamination of water. Dispose of accepting material from a pick-up sweeper at an appropriate disposal site.

**Inspection and Maintenance**

Continually monitor operations to determine whether slurry, cuttings, or process water could enter waters of the state. If inspections show that a violation could occur, immediately implement preventive measures such as berms, barriers, secondary containment, and vacuum trucks.

**Conditions of Use**

Volume II - Construction Stormwater Pollution Prevention - August 2012  
4-44

**STORMWATER POLLUTION PREVENTION PLAN**

**ELEMENT #1: MARK CLEARING LIMITS**

CLEARING LIMITS ARE LOCATED WITHIN A FULLY CLEARED SITE. THE EXISTING PARCEL IS COMPLETELY COVERED AND MAINTAINED WITH LAWN, WHILE THE ADJACENT ALLEY IS FINISHED WITH GRAVEL SURFACING. PROPOSED DEVELOPMENT WILL DEVELOP THE ENTIRE PARCEL AND ALLEY FRONTAGE.

**ELEMENT #2: ESTABLISH CONSTRUCTION ACCESS**

CONSTRUCTION VEHICLES WILL ACCESS THE SITE FROM ADJACENT PUBLIC STREETS (I.e. ALDER STREET AND SECOND AVENUE). A TYPICAL CONSTRUCTION ENTRANCE IS SPECIFIED IN THE ALLEY WHERE IT CONNECTS TO ALDER STREET. ALL CONSTRUCTION EQUIPMENT (EXCAVATORS, TRUCKS, ETC.) WILL REMAIN WITHIN THE SITE. CONSTRUCTION TRAFFIC THAT WILL ROUTINELY LEAVE THE SITE (I.E. WORK TRUCKS, PERSONAL VEHICLES) WILL BE REQUIRED TO TURN RIGHT ONTO ALDER STREET AND BE REQUIRED TO STOP AT THE END OF EACH DAY. SEDIMENT TRANSPORT TO ROADS FROM THE SITE SHALL BE PREVENTED BY THE USE OF SEDIMENT CONTROLLED SEDIMENT DISPOSAL AREA ON SITE OR REMOVED OFF SITE AND DISPOSED AT AN APPROVED FILL SITE. IF STREET WASHING IS NEEDED, IT WILL ONLY OCCUR AFTER SEDIMENT HAS BEEN REMOVED AS DESCRIBED. THE RESULTING WASH WASTEWATER WOULD THEN BE CONTROLLED BY PUMPING IT BACK ON SITE. ALL CONSTRUCTION ACCESS POINTS WILL BE RESTORED TO PROPOSED CONDITIONS.

WASHINGTON STATE DEPARTMENT OF ECOLOGY BMPs CONSIDERED FOR ELEMENT #2 INCLUDE:

- BMP C105: STABILIZED CONSTRUCTION ENTRANCE - OPTIONAL
- BMP C106: STREET WASHING
- BMP C107: STREET WASHING
- BMP C108: STREET WASHING
- BMP C753: STREET WASHING
- BMP C



